



WOOD GUARD RAIL REQUIRED

Cul. Sta.	Left	Right
534100	24	24
534190	24	24
544158	24	24

NEW CAST IRON PIPE CULVERTS REQUIRED

Sta.	Diam.	Length	Conc. A	Steel
534100	18"	48'	18c.y.	75"
534190	18"	48'	18c.y.	111"
540158	18"	45'	18c.y.	54"
544158	18"	42'	18c.y.	75"

FED. ROAD DIST. NO.	STATE	FILE NO.	FILE YEAR	SHEET NO.	TOTAL SHEETS
9	VT.	105-D	1931	9	47

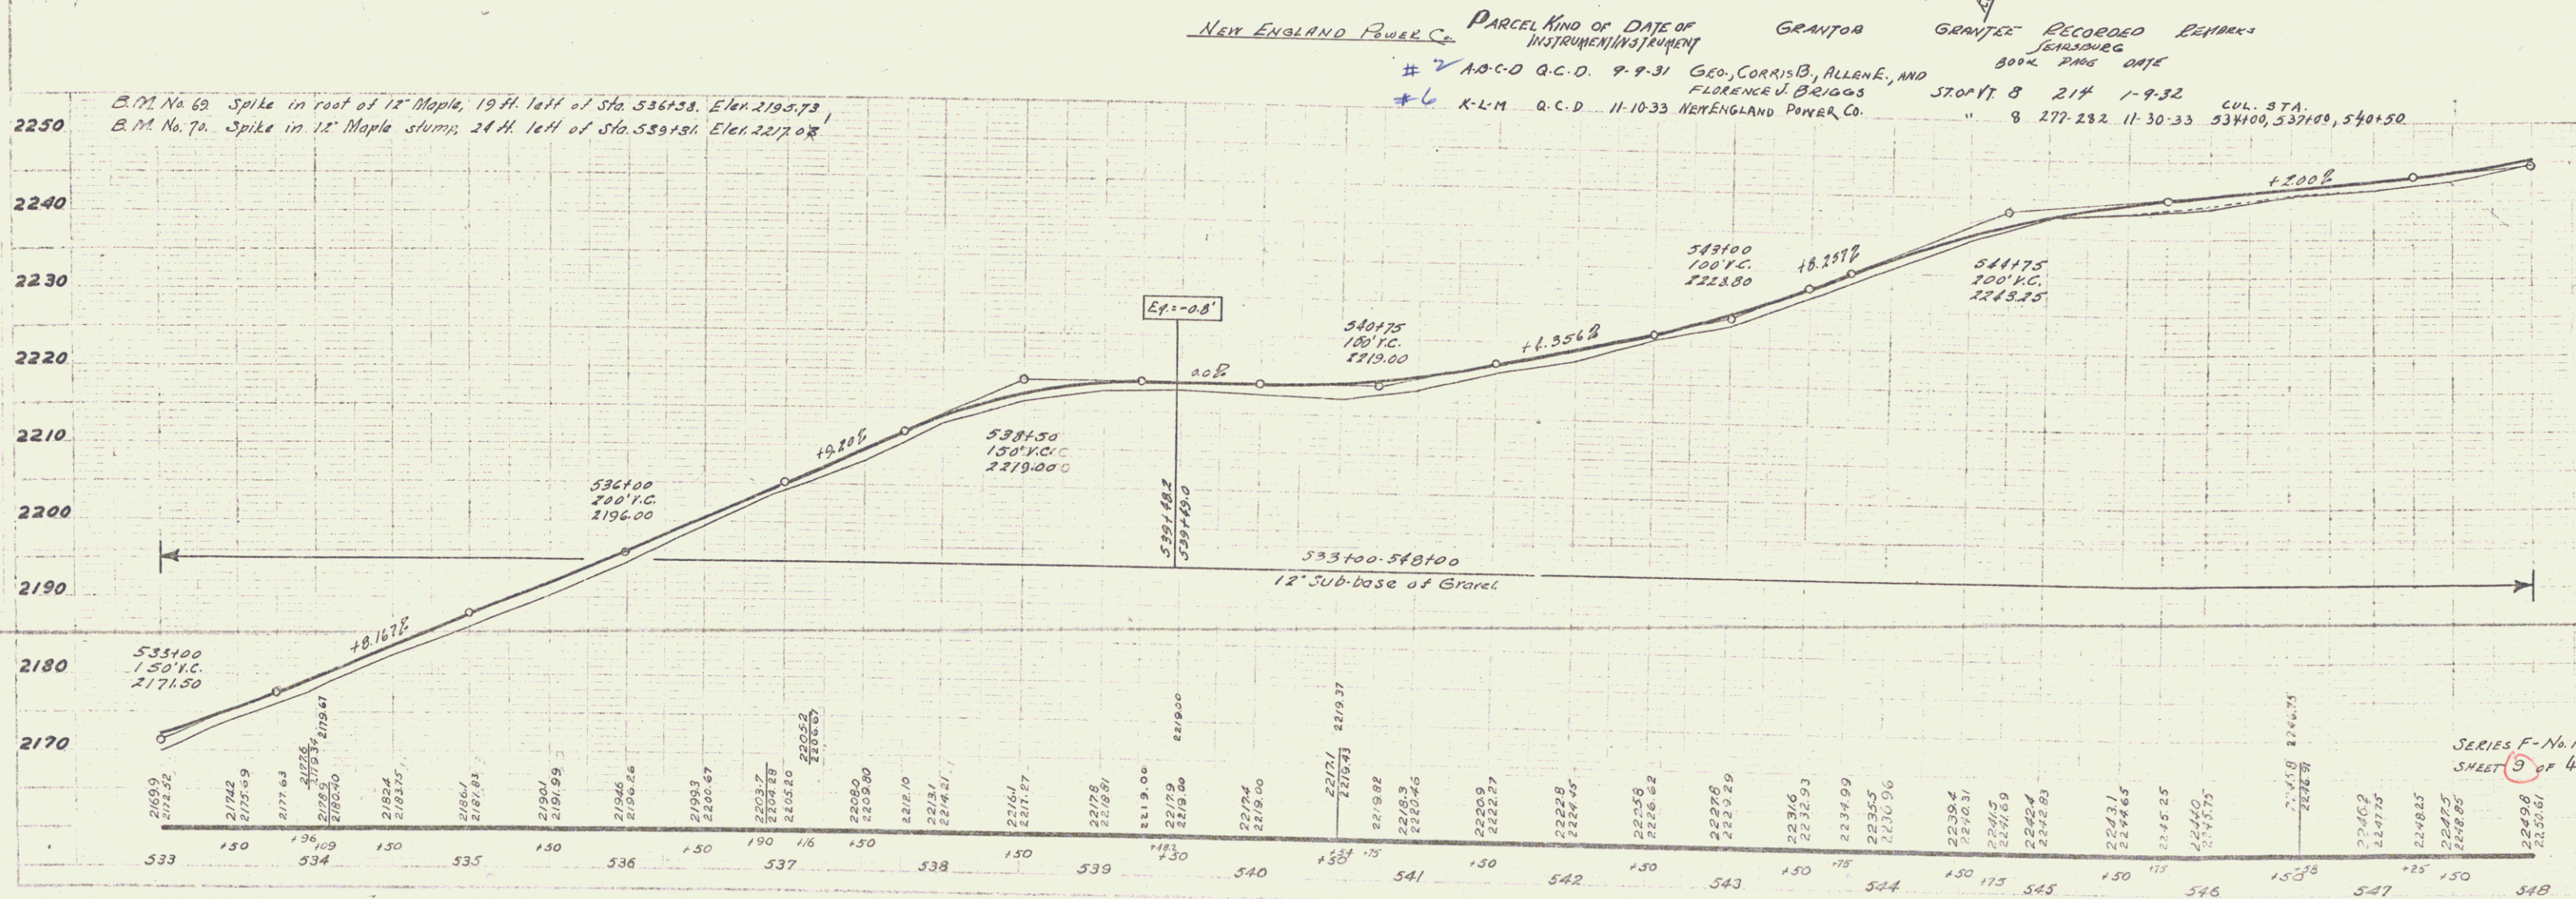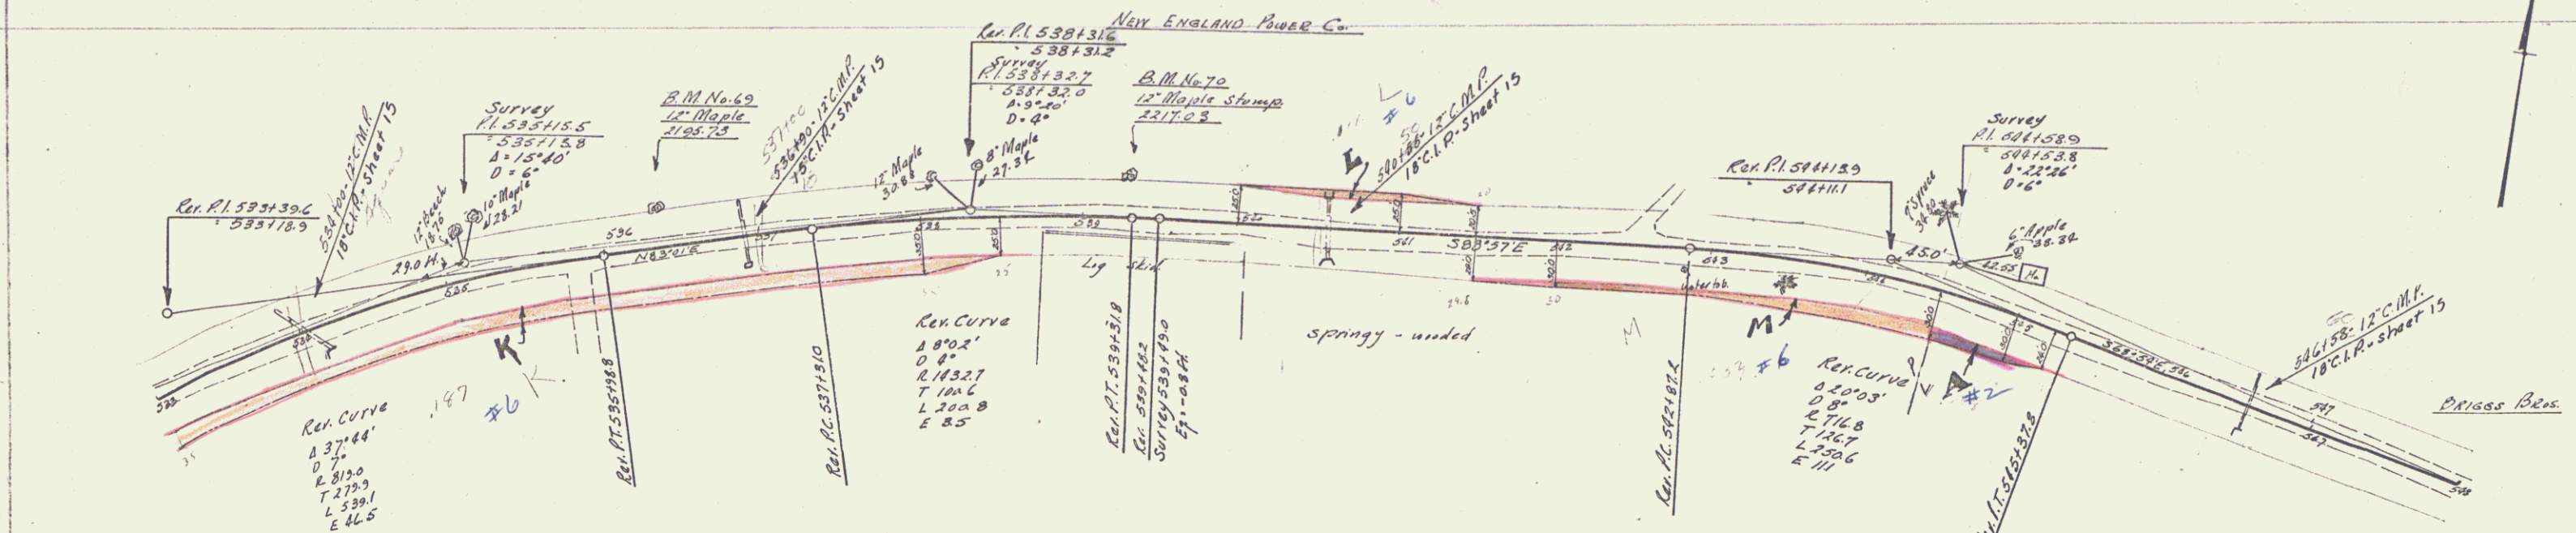

SERIES F-16.105-D
SHEET 9 of 47