


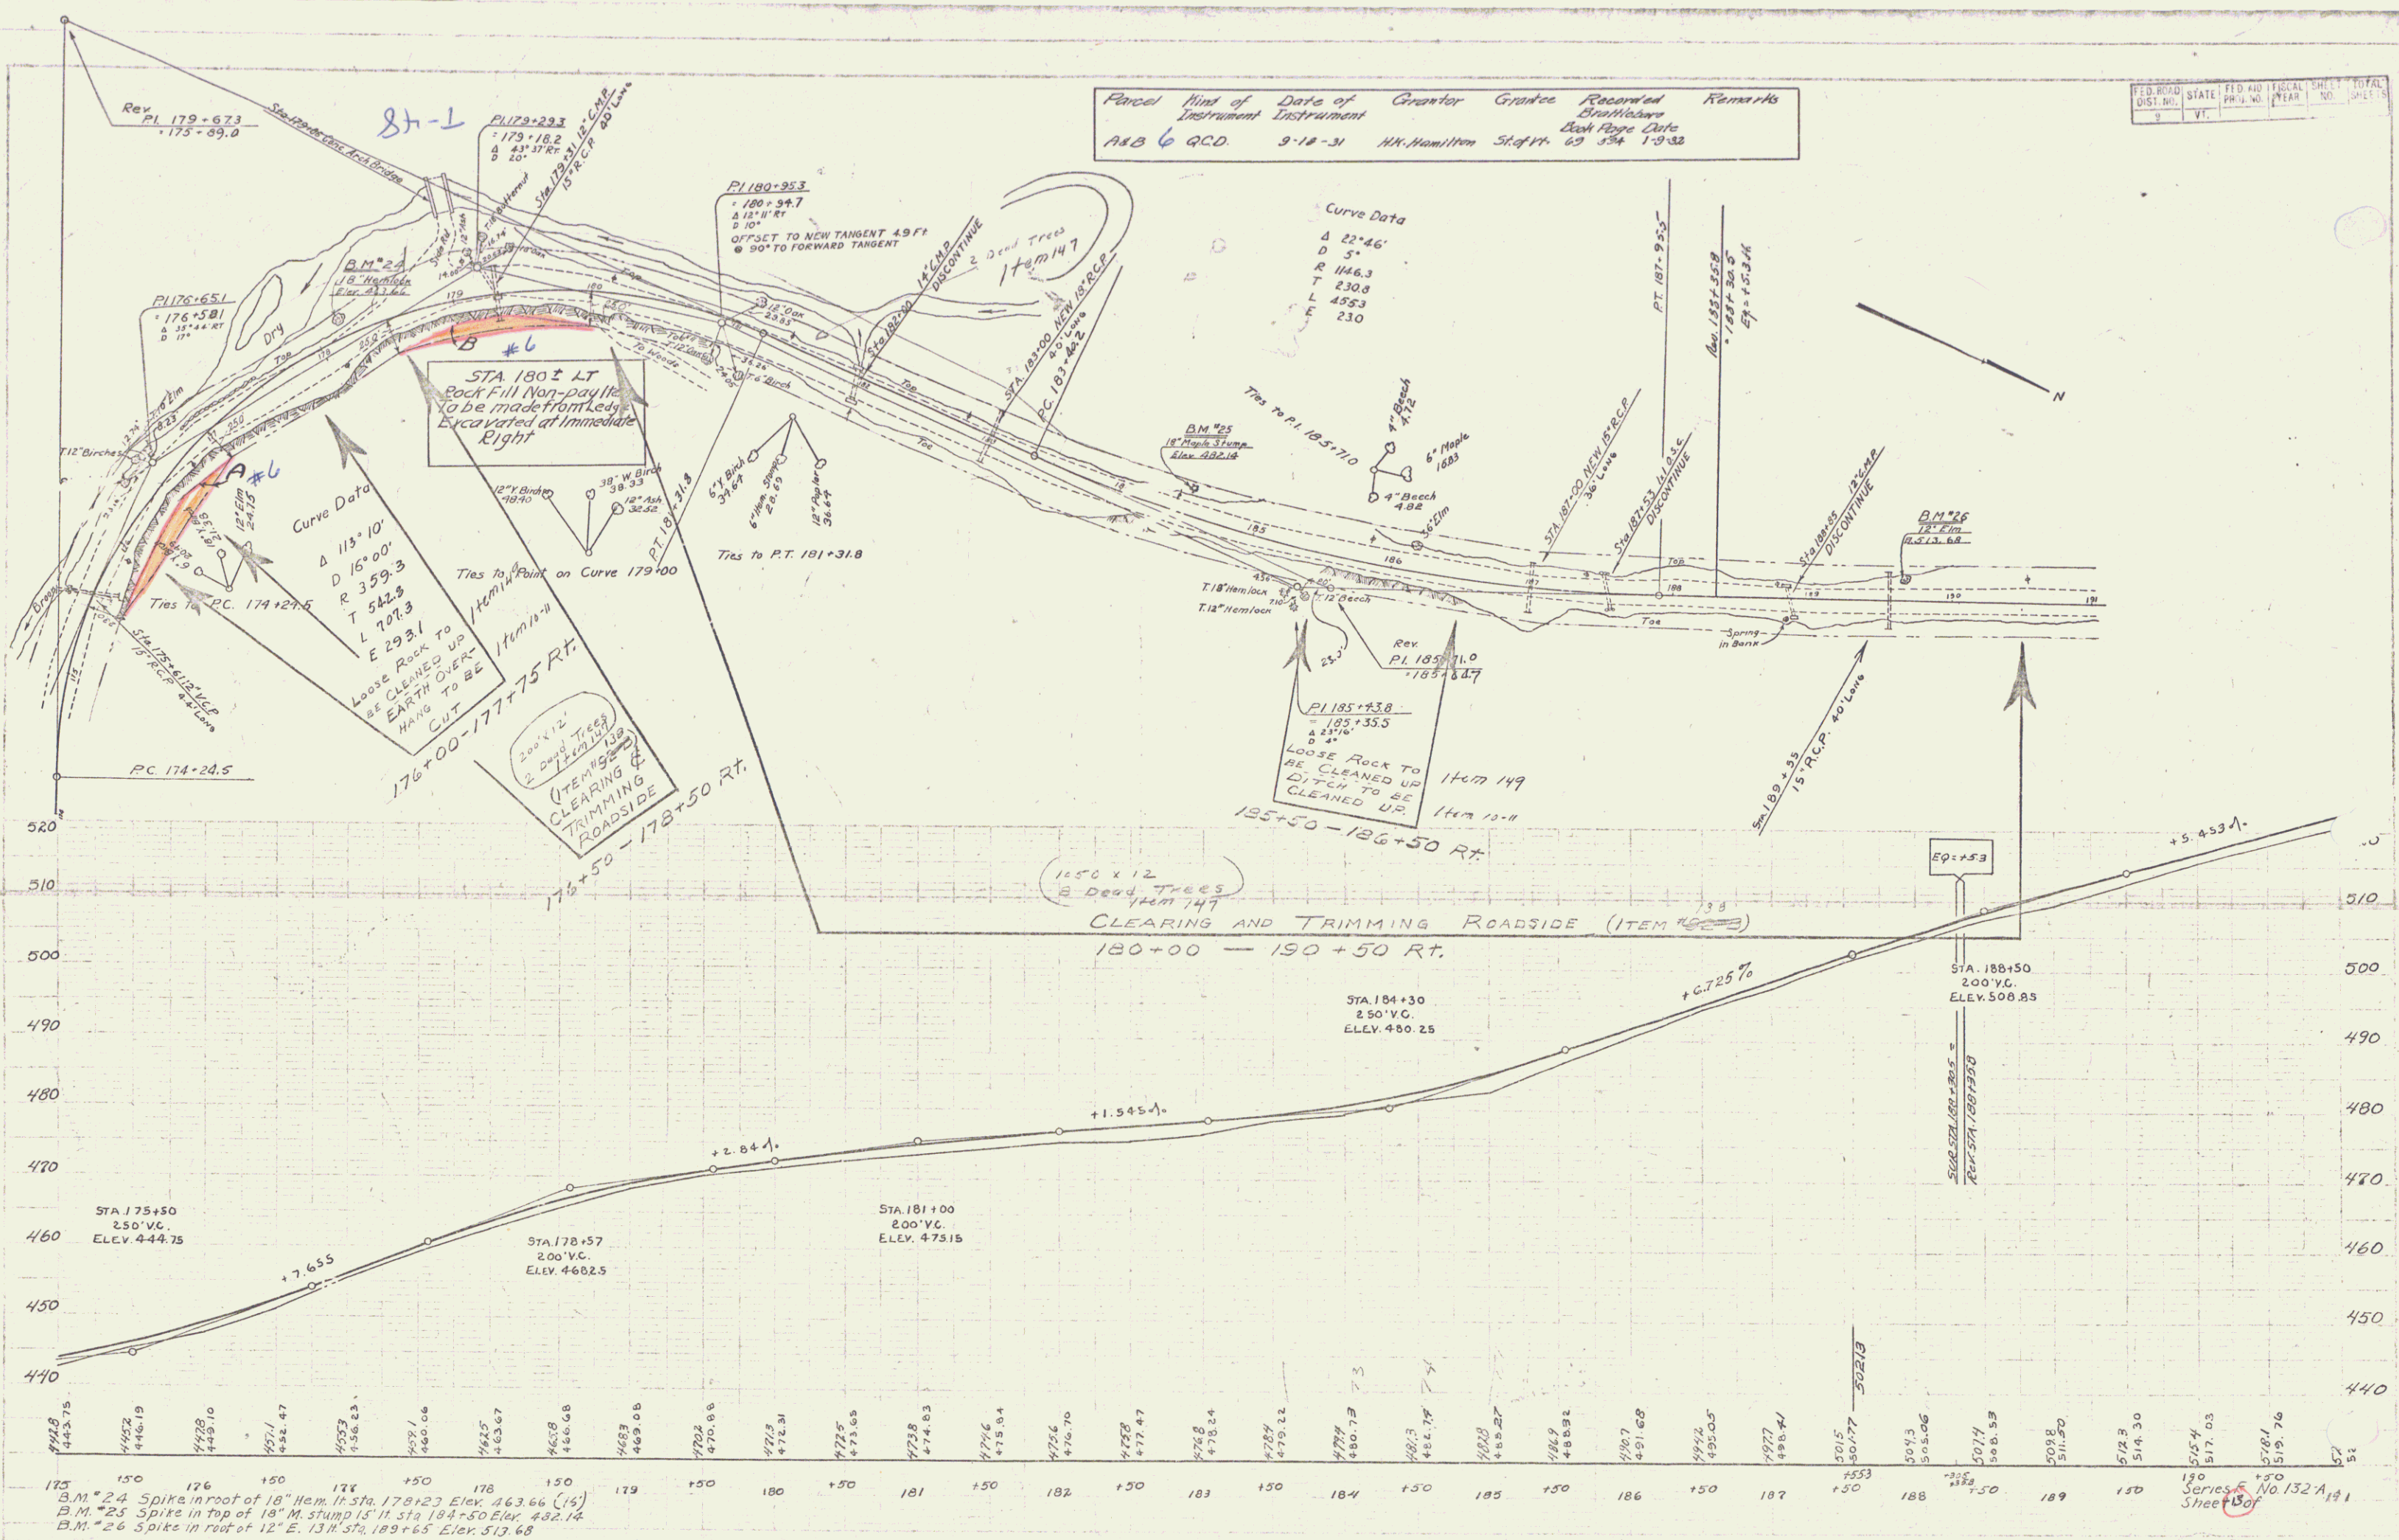

Parcel	Hint of Instrument	Date of Instrument	Grantor	Grantee	Recorded	Remarks
A&B 6 QCD		9-18-31	HH Hamilton	State of Va	60 534 1-9-32	

FED. ROAD DIST. NO.	STATE	FED. AID PROJ. NO.	FISCAL YEAR	SHEET NO.	TOTAL SHEETS
9	VI				

C.E. Williams
S.E. Williams
Aug. 1931

H.H. Boyer
Aug. 1931

Series No. 132 A 1
Sheet 13