
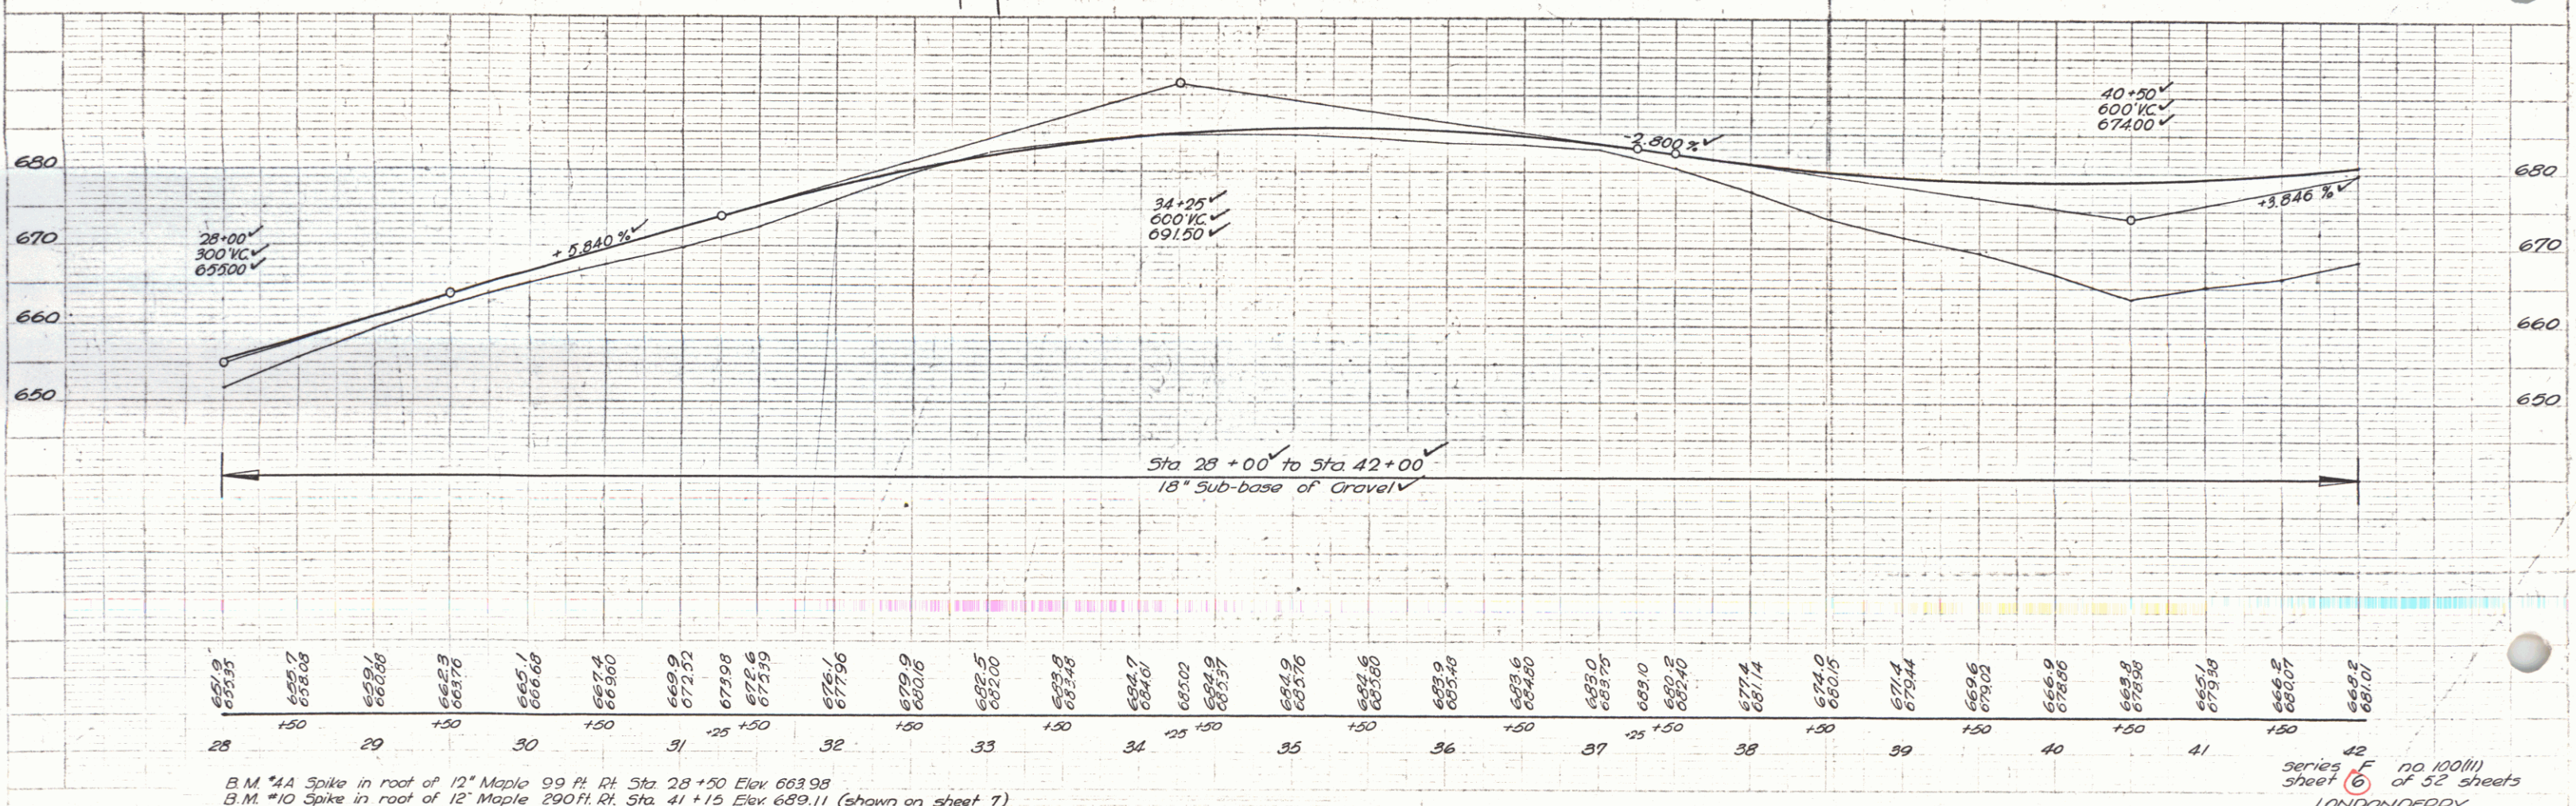


PARCEL INSTRUMENT DATE GRANTOR GRANTEE RECORDED LONDON DERRY REMARKS
 #2 A-B W.D.Q.E. 7-28-47 ARNOLD TAYLOR ST. OF VT. 26 215 8-11-47 #2 B on Sh. 7

FED. ROAD STATE DIST. NO. 1000(11) 1947 6 52

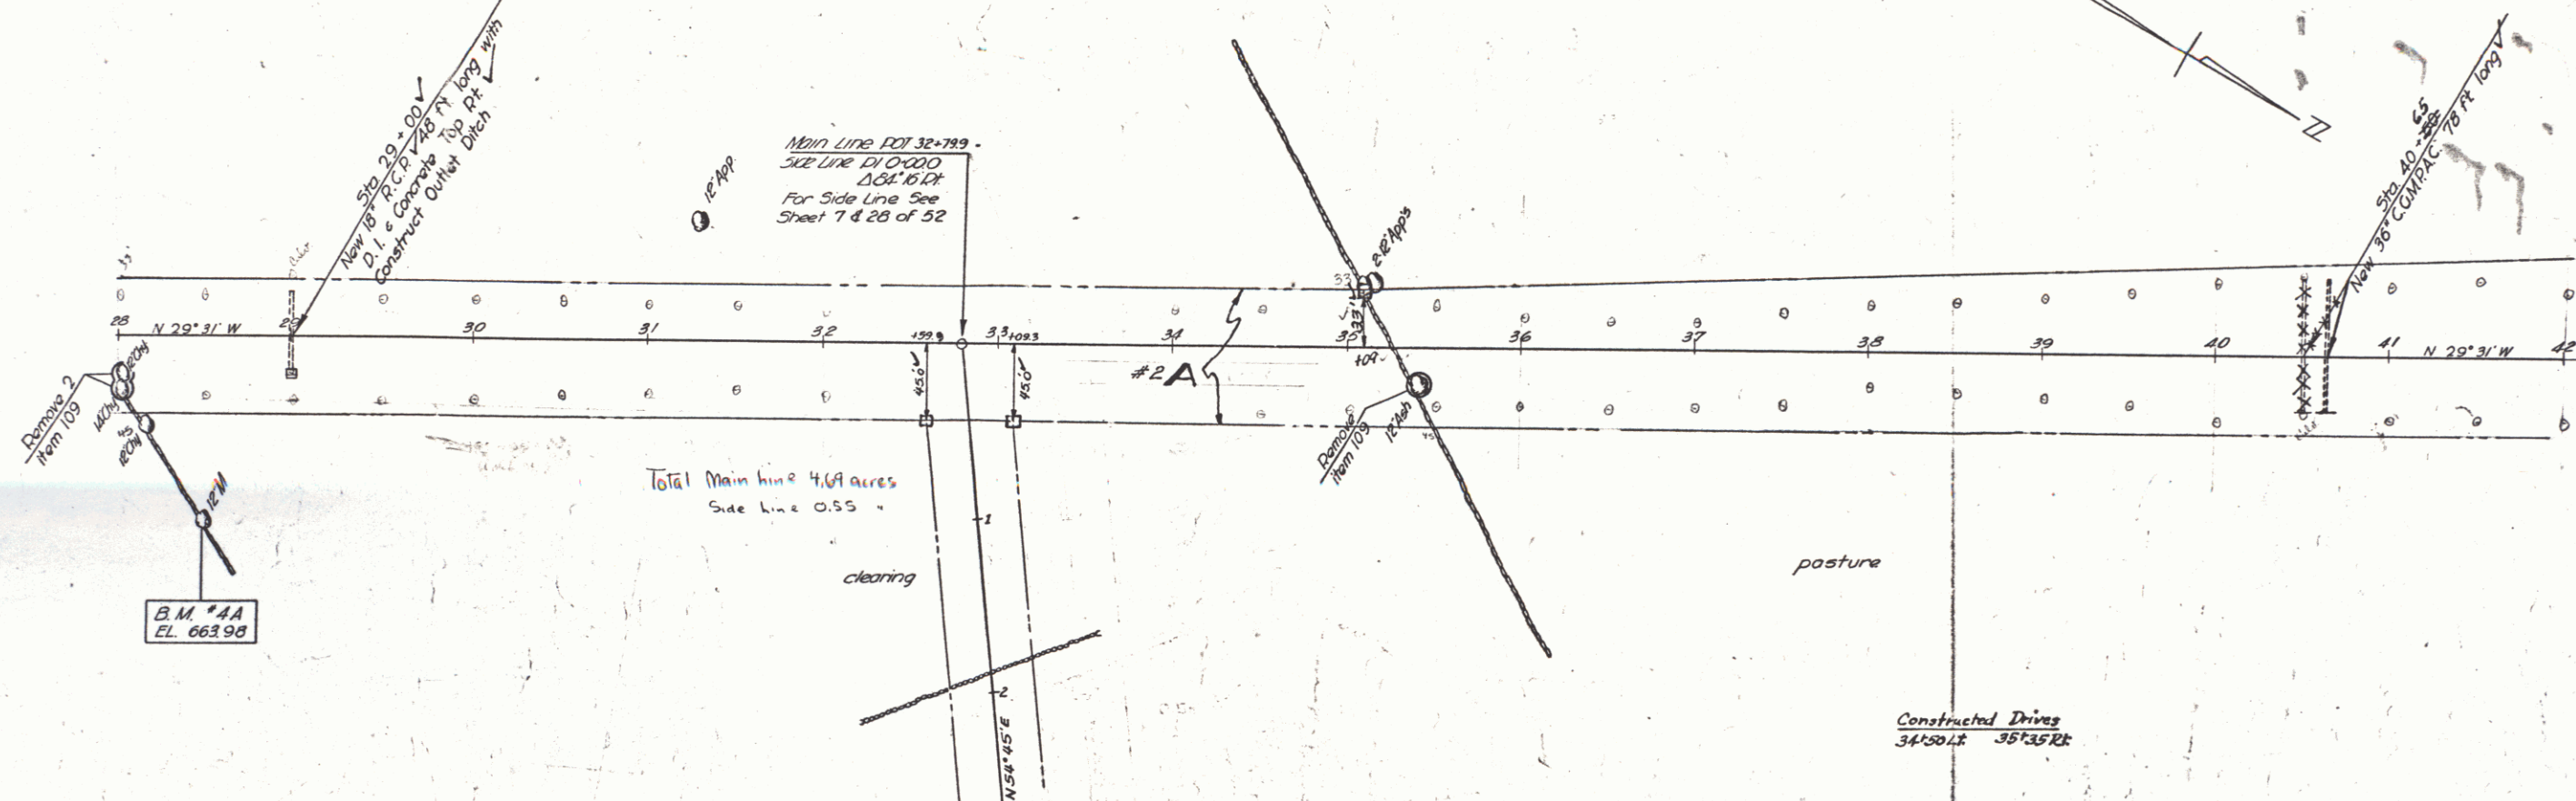

B.M. 4A Spike in root of 12" Maple 99 ft. Rt. Sta. 28+50 Elev 663.98
 B.M. 10 Spike in root of 12" Maple 290 ft. Rt. Sta. 41+15 Elev 689.11 (shown on sheet 7)

Series F no 100(11) of 52 sheets LONDON DERRY