


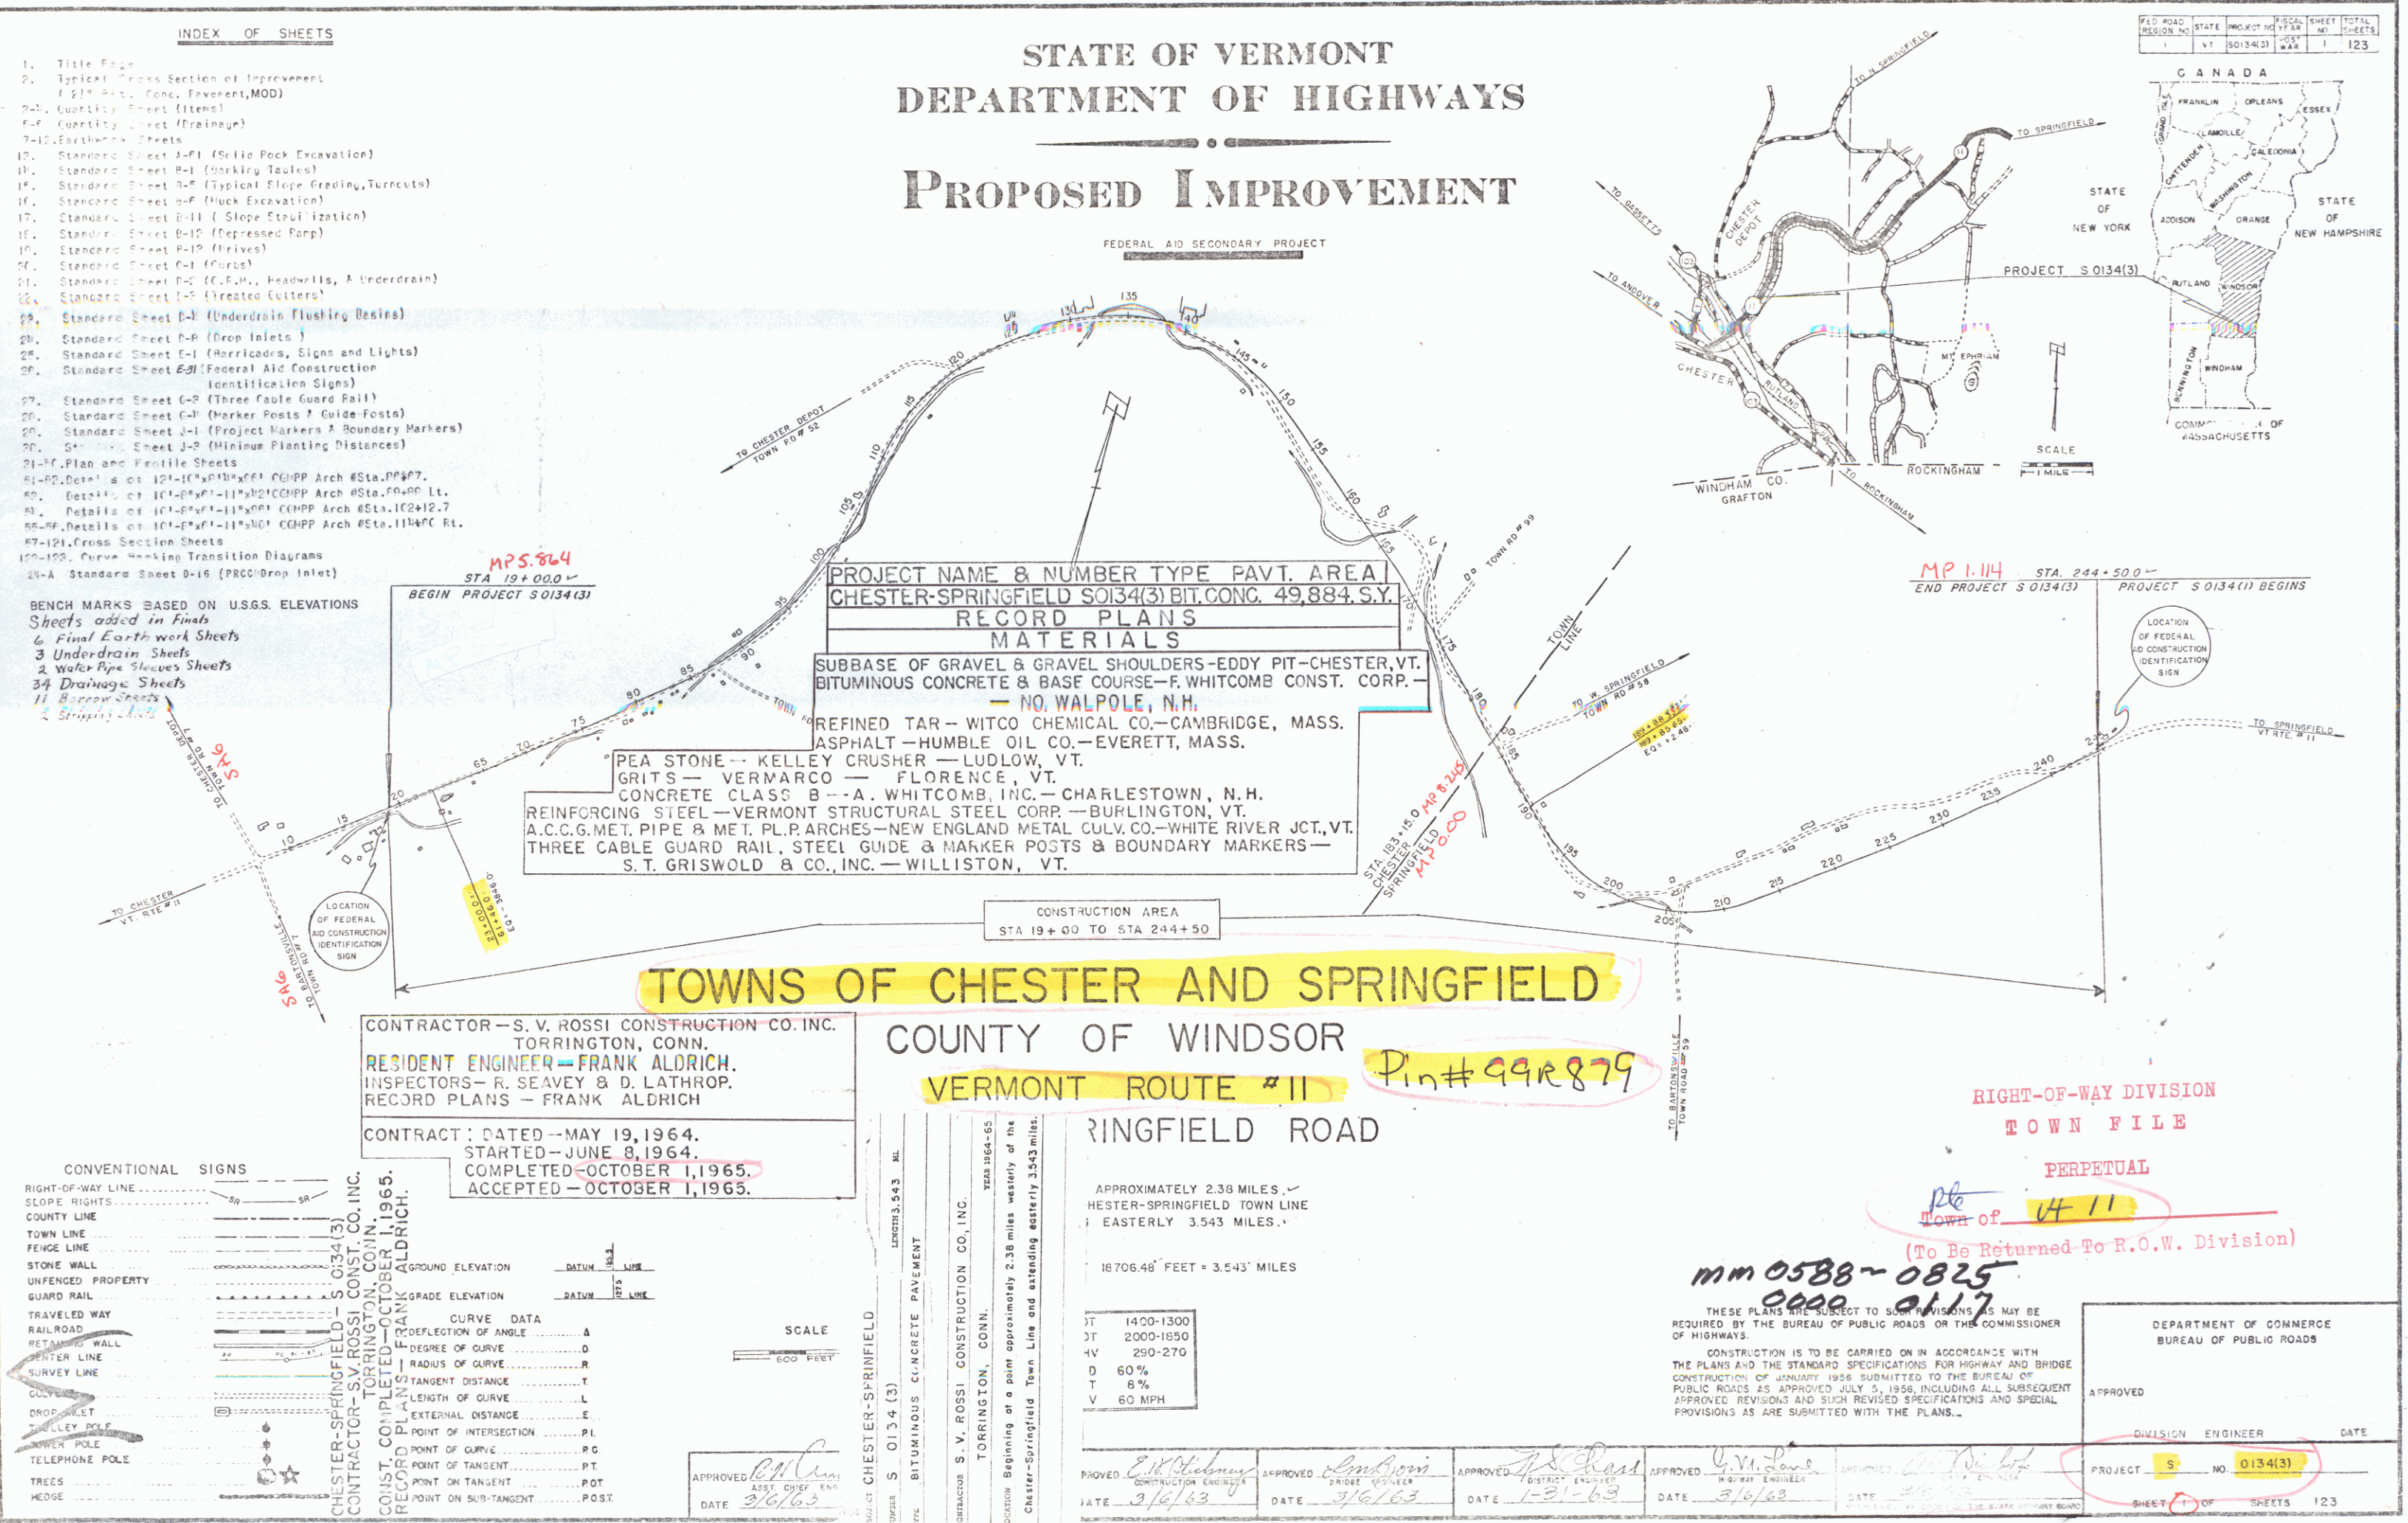

- INDEX OF SHEETS
1. Title Page
 2. Typical Cross Section of Improvement
 3. Quantity Sheet (Items)
 4. Quantity Sheet (Drainage)
 5. Earthwork Sheets
 6. Standard Sheet A-1 (Solid Rock Excavation)
 7. Standard Sheet B-1 (Sinking Tables)
 8. Standard Sheet B-2 (Typical Slope Grading, Turnouts)
 9. Standard Sheet B-3 (Typical Excavation)
 10. Standard Sheet B-4 (Slope Stabilization)
 11. Standard Sheet B-5 (Expressed Ramp)
 12. Standard Sheet B-6 (Driveway)
 13. Standard Sheet C-1 (Curbs)
 14. Standard Sheet C-2 (C.F.M., Headwalls, & Underdrain)
 15. Standard Sheet C-3 (Treated Cutters)
 16. Standard Sheet D-1 (Underdrain Flushing Basins)
 17. Standard Sheet D-2 (Drop Inlets)
 18. Standard Sheet E-1 (Hazardous Signs and Lights)
 19. Standard Sheet E-2 (Federal Aid Construction Identification Signs)
 20. Standard Sheet G-2 (Three Rail Guard Rail)
 21. Standard Sheet G-3 (Marker Posts & Guide Posts)
 22. Standard Sheet J-1 (Project Markers & Boundary Markers)
 23. Standard Sheet J-2 (Minimum Planting Distances)
 24. Plan and Profile Sheets
 25. Details of 12" x 12" x 12" C.H.P.P. Arch #Sta. 19+00
 26. Details of 12" x 12" x 12" C.H.P.P. Arch #Sta. 19+00
BENCH MARKS BASED ON U.S.G.S. ELEVATIONS
Sheets added in final
4 Final Earthwork Sheets
3 Underdrain Sheets
2 Water Pipe Slopes Sheets
34 Drainage Sheets
11 Bridge Sheets
2 Striping Sheets

CONTRACTOR - S. V. ROSSI CONSTRUCTION CO. INC.
TORRINGTON, CONN.
RESIDENT ENGINEER - FRANK ALDRICH
INSPECTORS - R. SEAVEY & D. LATHROP
RECORD PLANS - FRANK ALDRICH
CONTRACT DATED - MAY 19, 1964.
STARTED - JUNE 8, 1964.
COMPLETED - OCTOBER 1, 1965.
ACCEPTED - OCTOBER 1, 1965.

PROJECT NAME & NUMBER TYPE PAVT. AREA
CHESTER-SPRINGFIELD 50134(3) BIT. CONC. 49,884 S.Y.
RECORD PLANS
MATERIALS
SUBBASE OF GRAVEL & GRAVEL SHOULDERS - EDDY PIT - CHESTER, VT.
BITUMINOUS CONCRETE & BASE COURSE - F. WHITCOMB CONST. CORP. -
NO. WALPOLE, N.H.
REFINED TAR - WITCO CHEMICAL CO. - CAMBRIDGE, MASS.
ASPHALT - HUMBLE OIL CO. - EVERETT, MASS.
PEA STONE - KELLEY CRUSHER - LUDLOW, VT.
GRITS - VERMARCO - FLORENCE, VT.
CONCRETE CLASS B - A. WHITCOMB, INC. - CHARLESTOWN, N.H.
REINFORCING STEEL - VERMONT STRUCTURAL STEEL CORP. - BURLINGTON, VT.
A.C.C.G. MET. PIPE & MET. PL. ARCHES - NEW ENGLAND METAL CULV. CO. - WHITE RIVER JCT., VT.
THREE CABLE GUARD RAIL, STEEL GUIDE & MARKER POSTS & BOUNDARY MARKERS -
S.T. GRISWOLD & CO. INC. - WILLISTON, VT.

CONSTRUCTION AREA
STA 19+00 TO STA 244+50

TOWNS OF CHESTER AND SPRINGFIELD
COUNTY OF WINDSOR
VERMONT ROUTE #11

SPRINGFIELD ROAD
RINGFIELD ROAD

APPROXIMATELY 2.38 MILES.
HESTER-SPRINGFIELD TOWN LINE
EASTERLY 3.543 MILES.
18706.48 FEET = 3.543 MILES

CONTRACTOR - S. V. ROSSI CONSTRUCTION CO. INC.
TORRINGTON, CONN.
RECORD PLANS - FRANK ALDRICH

CONTRACT DATED - MAY 19, 1964.
STARTED - JUNE 8, 1964.
COMPLETED - OCTOBER 1, 1965.
ACCEPTED - OCTOBER 1, 1965.

