

INDEX OF SHEETS	
SHEET NO.	DESCRIPTION
1.	Title Sheet
2.	Typical Sections
3.	Quantity Sheet (Earthworks, Drainage & Items)
4.	Plan & Profile
5-18.	Bridge Series 100
19-21.	Cross Sections
16.	Standard C-1
17.	Standard D-4
18.	Standard D-16
19.	Standard G-3
20.	Standard G-4
21.	Standard SCB-DE-65
22.	Standard SB-21-56

(To Be Returned to R.O.W. Division)
 Town of Winhall
 PERMIT
 RIGHT-OF-WAY DIVISION


STATE OF VERMONT DEPARTMENT OF HIGHWAYS PROPOSED IMPROVEMENT

TOWN OF WINHALL
 COUNTY OF BENNINGTON
VERMONT ROUTES 11 & 30
MANCHESTER-LONDONDERRY ROAD

Pin# 992894

BEGINNING AT A POINT ON VERMONT ROUTE 11, APPROXIMATELY
 2.386 MILE EASTERLY OF THE INTERSECTION OF VERMONT ROUTES 11
 AND 30, AND EXTENDING SOUTHWESTERLY 0.085 MILES

LENGTH OF PROJECT 450 FT = 0.085 MILES

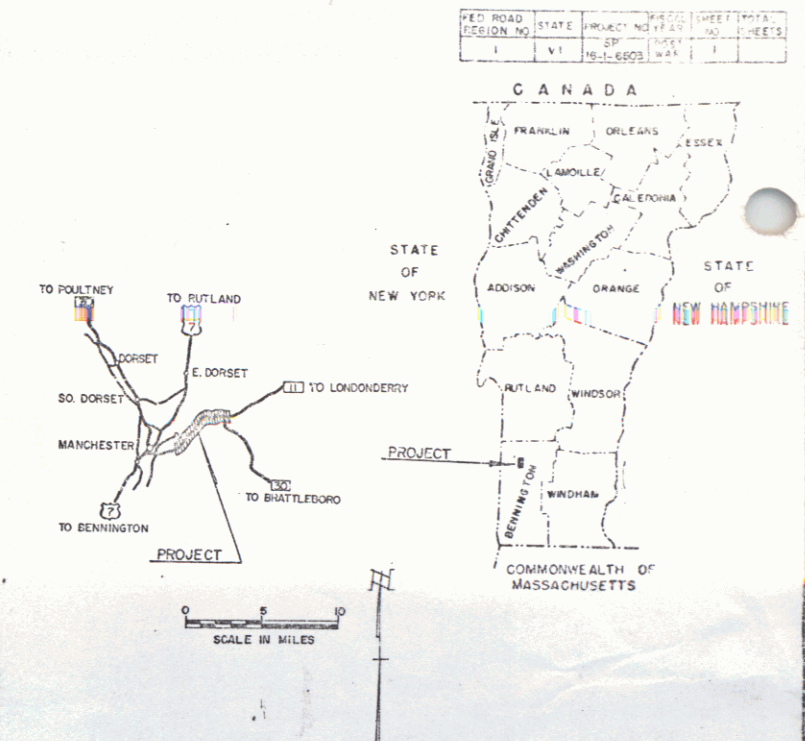

CONVENTIONAL SIGNS	
COUNTY LINE	---
TOWN LINE	---
FENCE LINE	---
STONE WALL	---
UNFENCED PROPERTY	---
GUARD RAIL	---
TRAVELED WAY	---
RAILROAD	---
RETAINING WALL	---
CENTER LINE	---
SURVEY LINE	---
CULVERT	---
DROP INLET	---
TROLLEY POLE	---
POWER POLE	---
TELEPHONE POLE	---
TREES	---
HEDGE	---

CURVE DATA	
DEFLECTION OF ANGLE	Δ
DEGREE OF CURVE	D
RADIUS OF CURVE	R
TANGENT DISTANCE	T
LENGTH OF CURVE	L
EXTERNAL DISTANCE	E
POINT OF INTERSECTION	PI
POINT OF CURVE	P.C.
POINT ON TANGENT	P.T.
POINT ON SUB-TANGENT	POST



THESE PLANS ARE SUBJECT TO SUCH REVISIONS AS MAY BE
 REQUIRED BY THE BUREAU OF PUBLIC ROADS OR THE COMMISSIONER
 OF HIGHWAYS.
 CONSTRUCTION IS TO BE CARRIED ON IN ACCORDANCE WITH
 THESE PLANS AND THE STANDARD SPECIFICATIONS FOR HIGHWAY AND BRIDGE
 CONSTRUCTION DATED APRIL, 1964, AS APPROVED BY THE BUREAU OF
 PUBLIC ROADS ON OCTOBER 12, 1964, INCLUDING ALL SUBSEQUENT
 APPROVED REVISIONS AND SUCH REVISED SPECIFICATIONS AND SPECIAL
 PROVISIONS AS ARE INCORPORATED IN THESE PLANS.

APPROVED <i>[Signature]</i> DATE 8/2/66	APPROVED <i>[Signature]</i> DATE 8/1/66	APPROVED <i>[Signature]</i> DATE 8-11-66	APPROVED <i>[Signature]</i> DATE 8-1-66	APPROVED <i>[Signature]</i> DATE 8/1/66	APPROVED <i>[Signature]</i> DATE 8/2/66	DEPARTMENT OF COMMERCE BUREAU OF PUBLIC ROADS PROJECT <u>SC</u> NO. <u>018-1-6503 S.P.</u> SHEET <u>17</u> OF <u>22</u> SHEETS
--	--	---	--	--	--	---


STEARNS R. JENKINS - 126 11

POOR ORIGINAL COPY

GREEN MOUNTAIN NATIONAL FOREST
UNITED STATES DEPT. OF AGRICULTURE
PARCEL #1B-12.8 A±
STATIONS 491+93-543+08
SLOPE PRS. STA. 510+40-511+21 RT- 75 DFT.
529+31-535+75 LK- 0.45 A±
536+72-537+64 LK- 211 DFT.


GREEN MOUNTAIN NATIONAL FOREST
UNITED STATES DEPT. OF AGRICULTURE
PARCEL #1A - 33A*
STATIONS 480+00-491+71
DRIVE 485+60 RT.

POOR ORIGINAL COPY


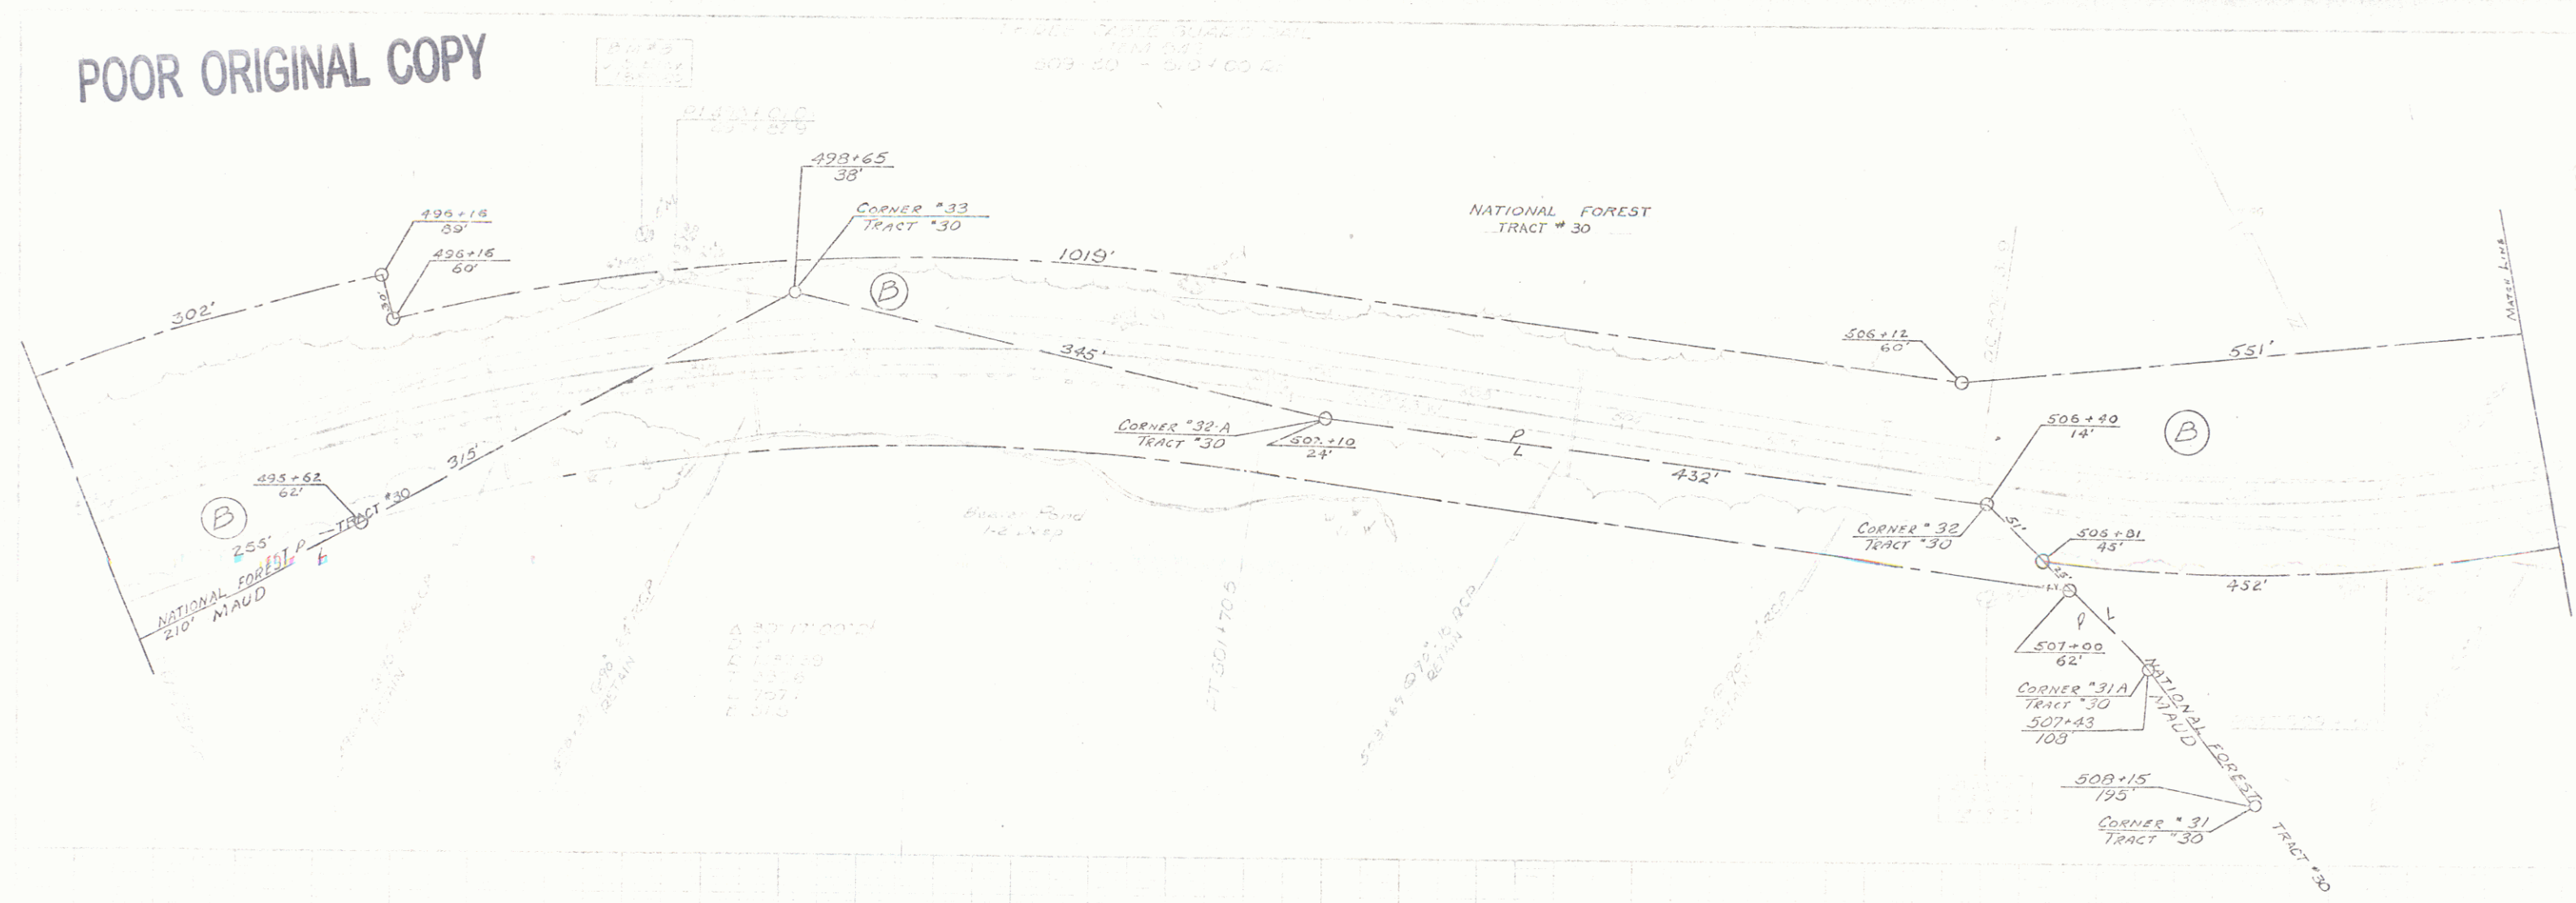


PLAN
 DATE: 1/15/66
 DRAWN BY: J. E. HARRIS
 CHECKED BY: J. E. HARRIS
 NO. OF WALS CHECKED: 1

PROFILE
 DATE: 1/15/66
 DRAWN BY: J. E. HARRIS
 CHECKED BY: J. E. HARRIS
 NO. OF WALS CHECKED: 1

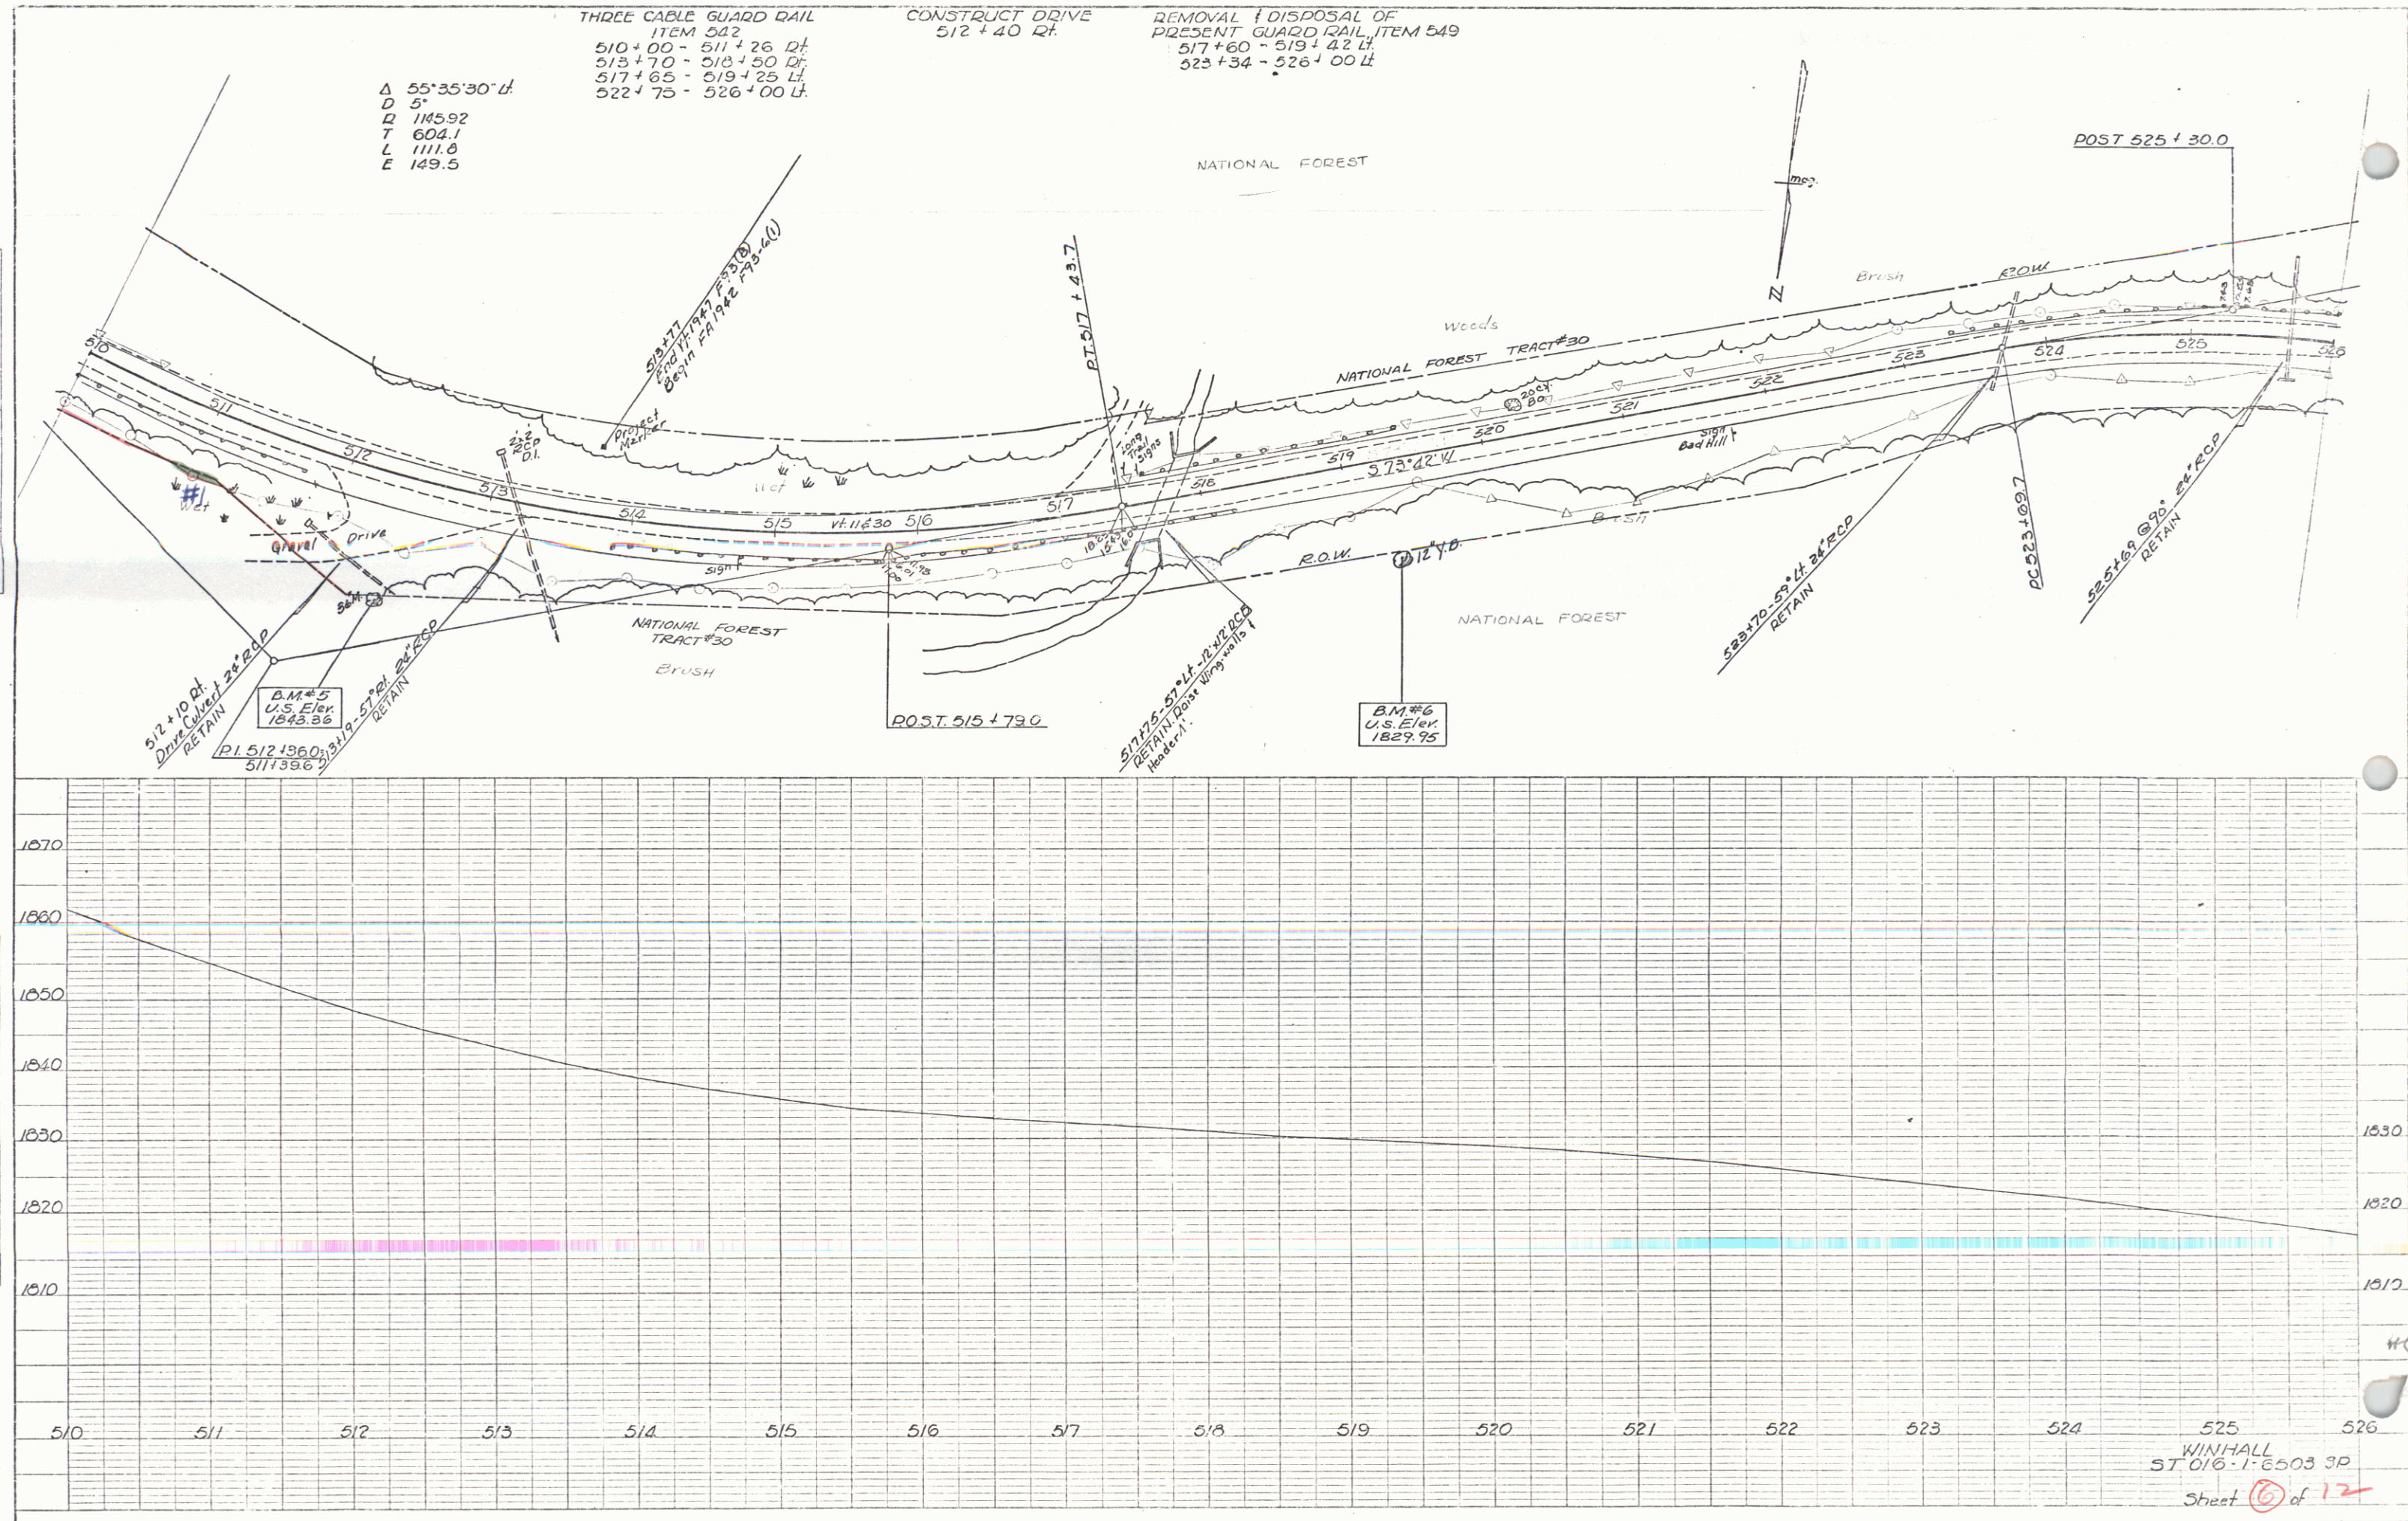


POOR ORIGINAL COPY

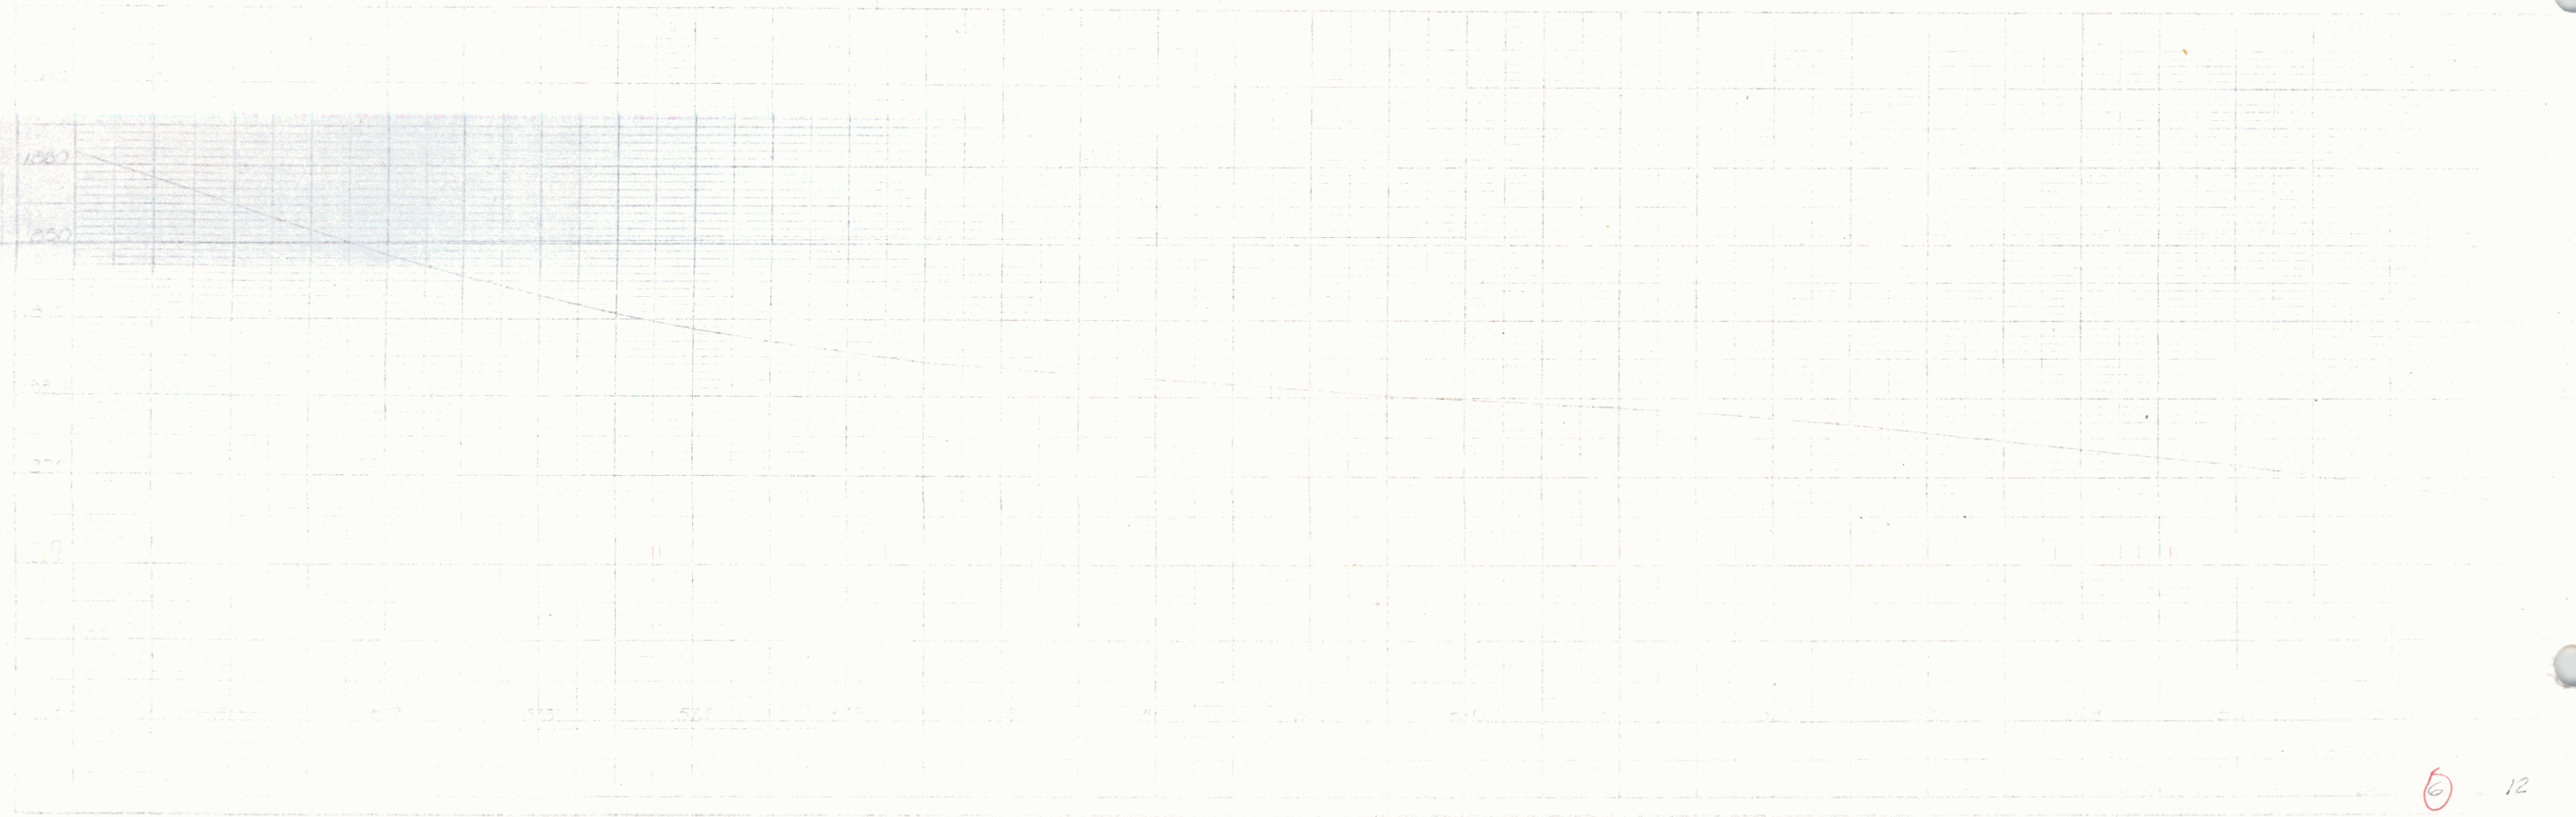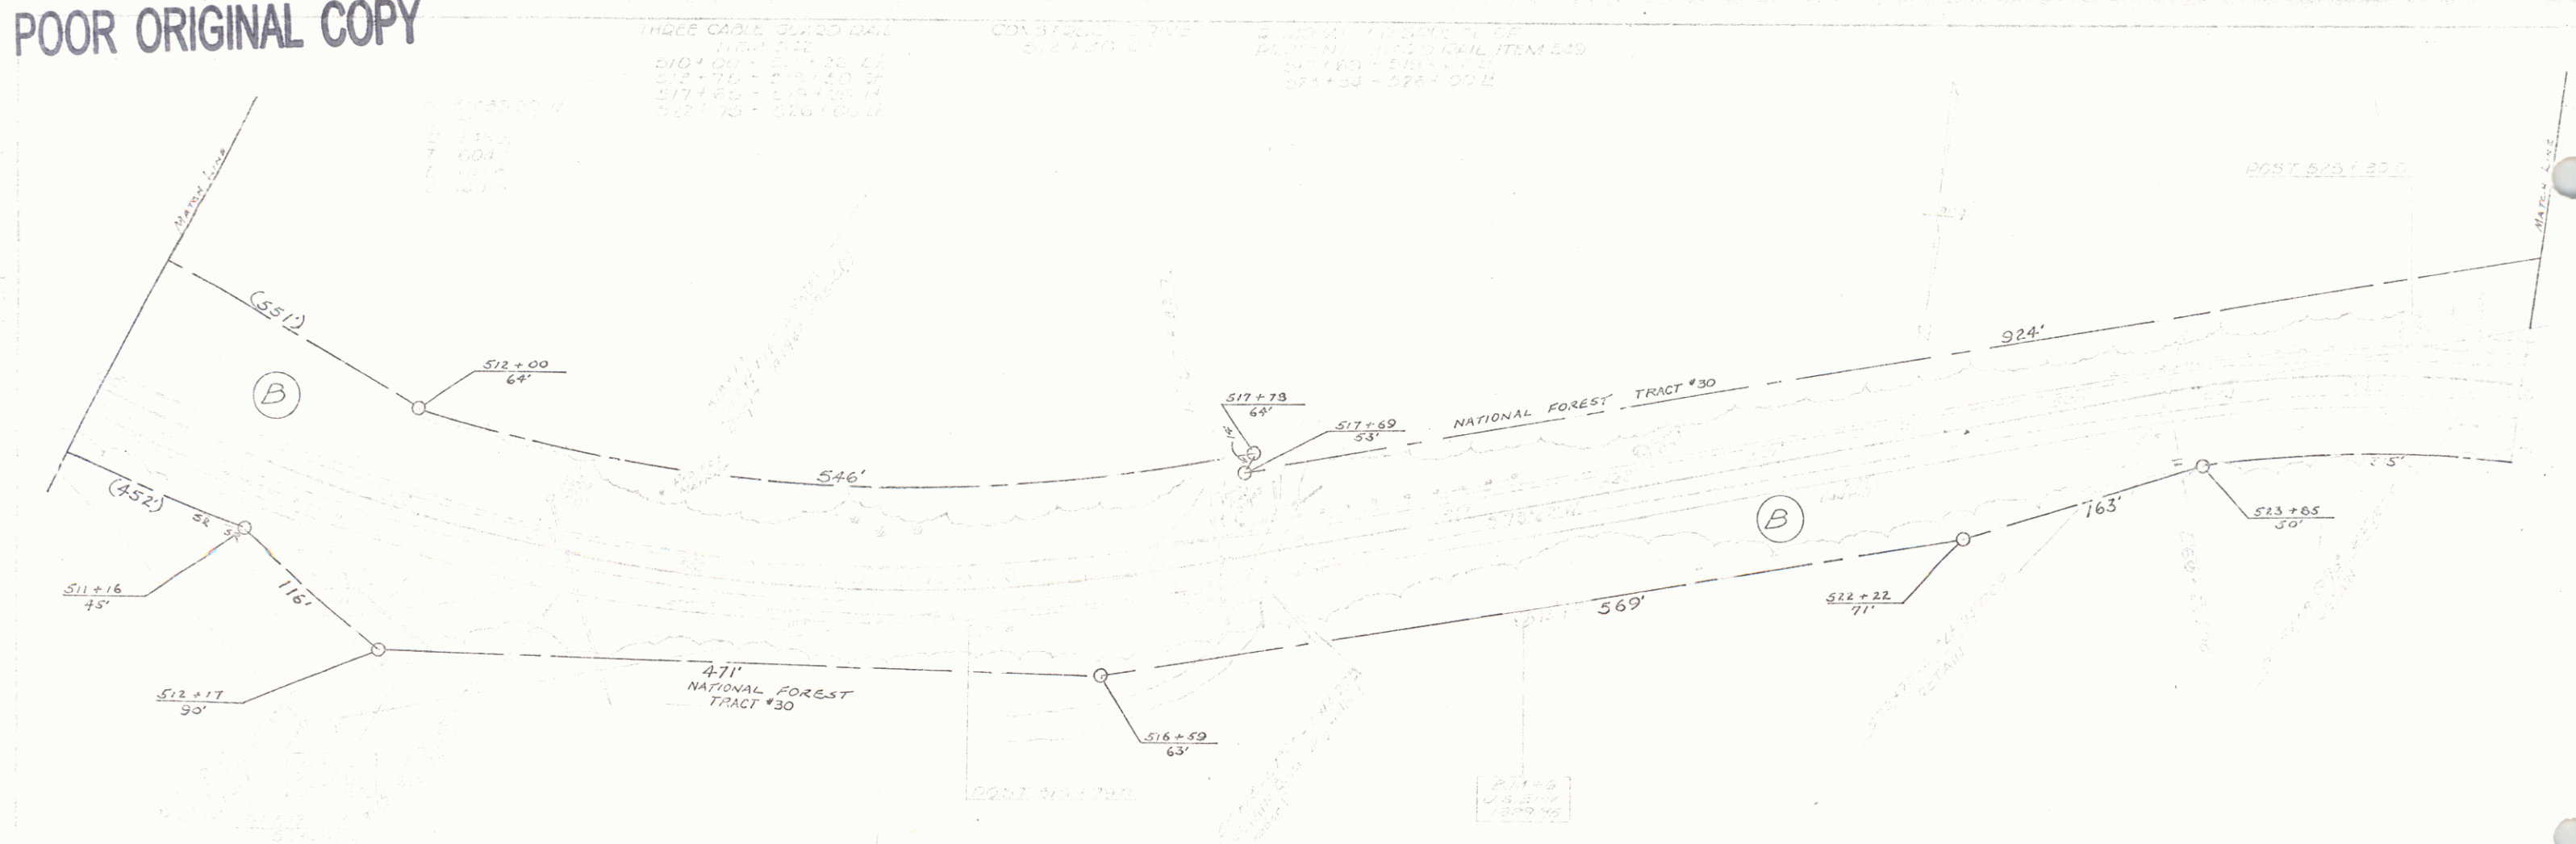


PLAN	DATE	BY
NO.		
NOTED	DATE	BY
CHANGED		
BY		


PROFILE	DATE	BY
NO.		
NOTED	DATE	BY
CHANGED		
BY		

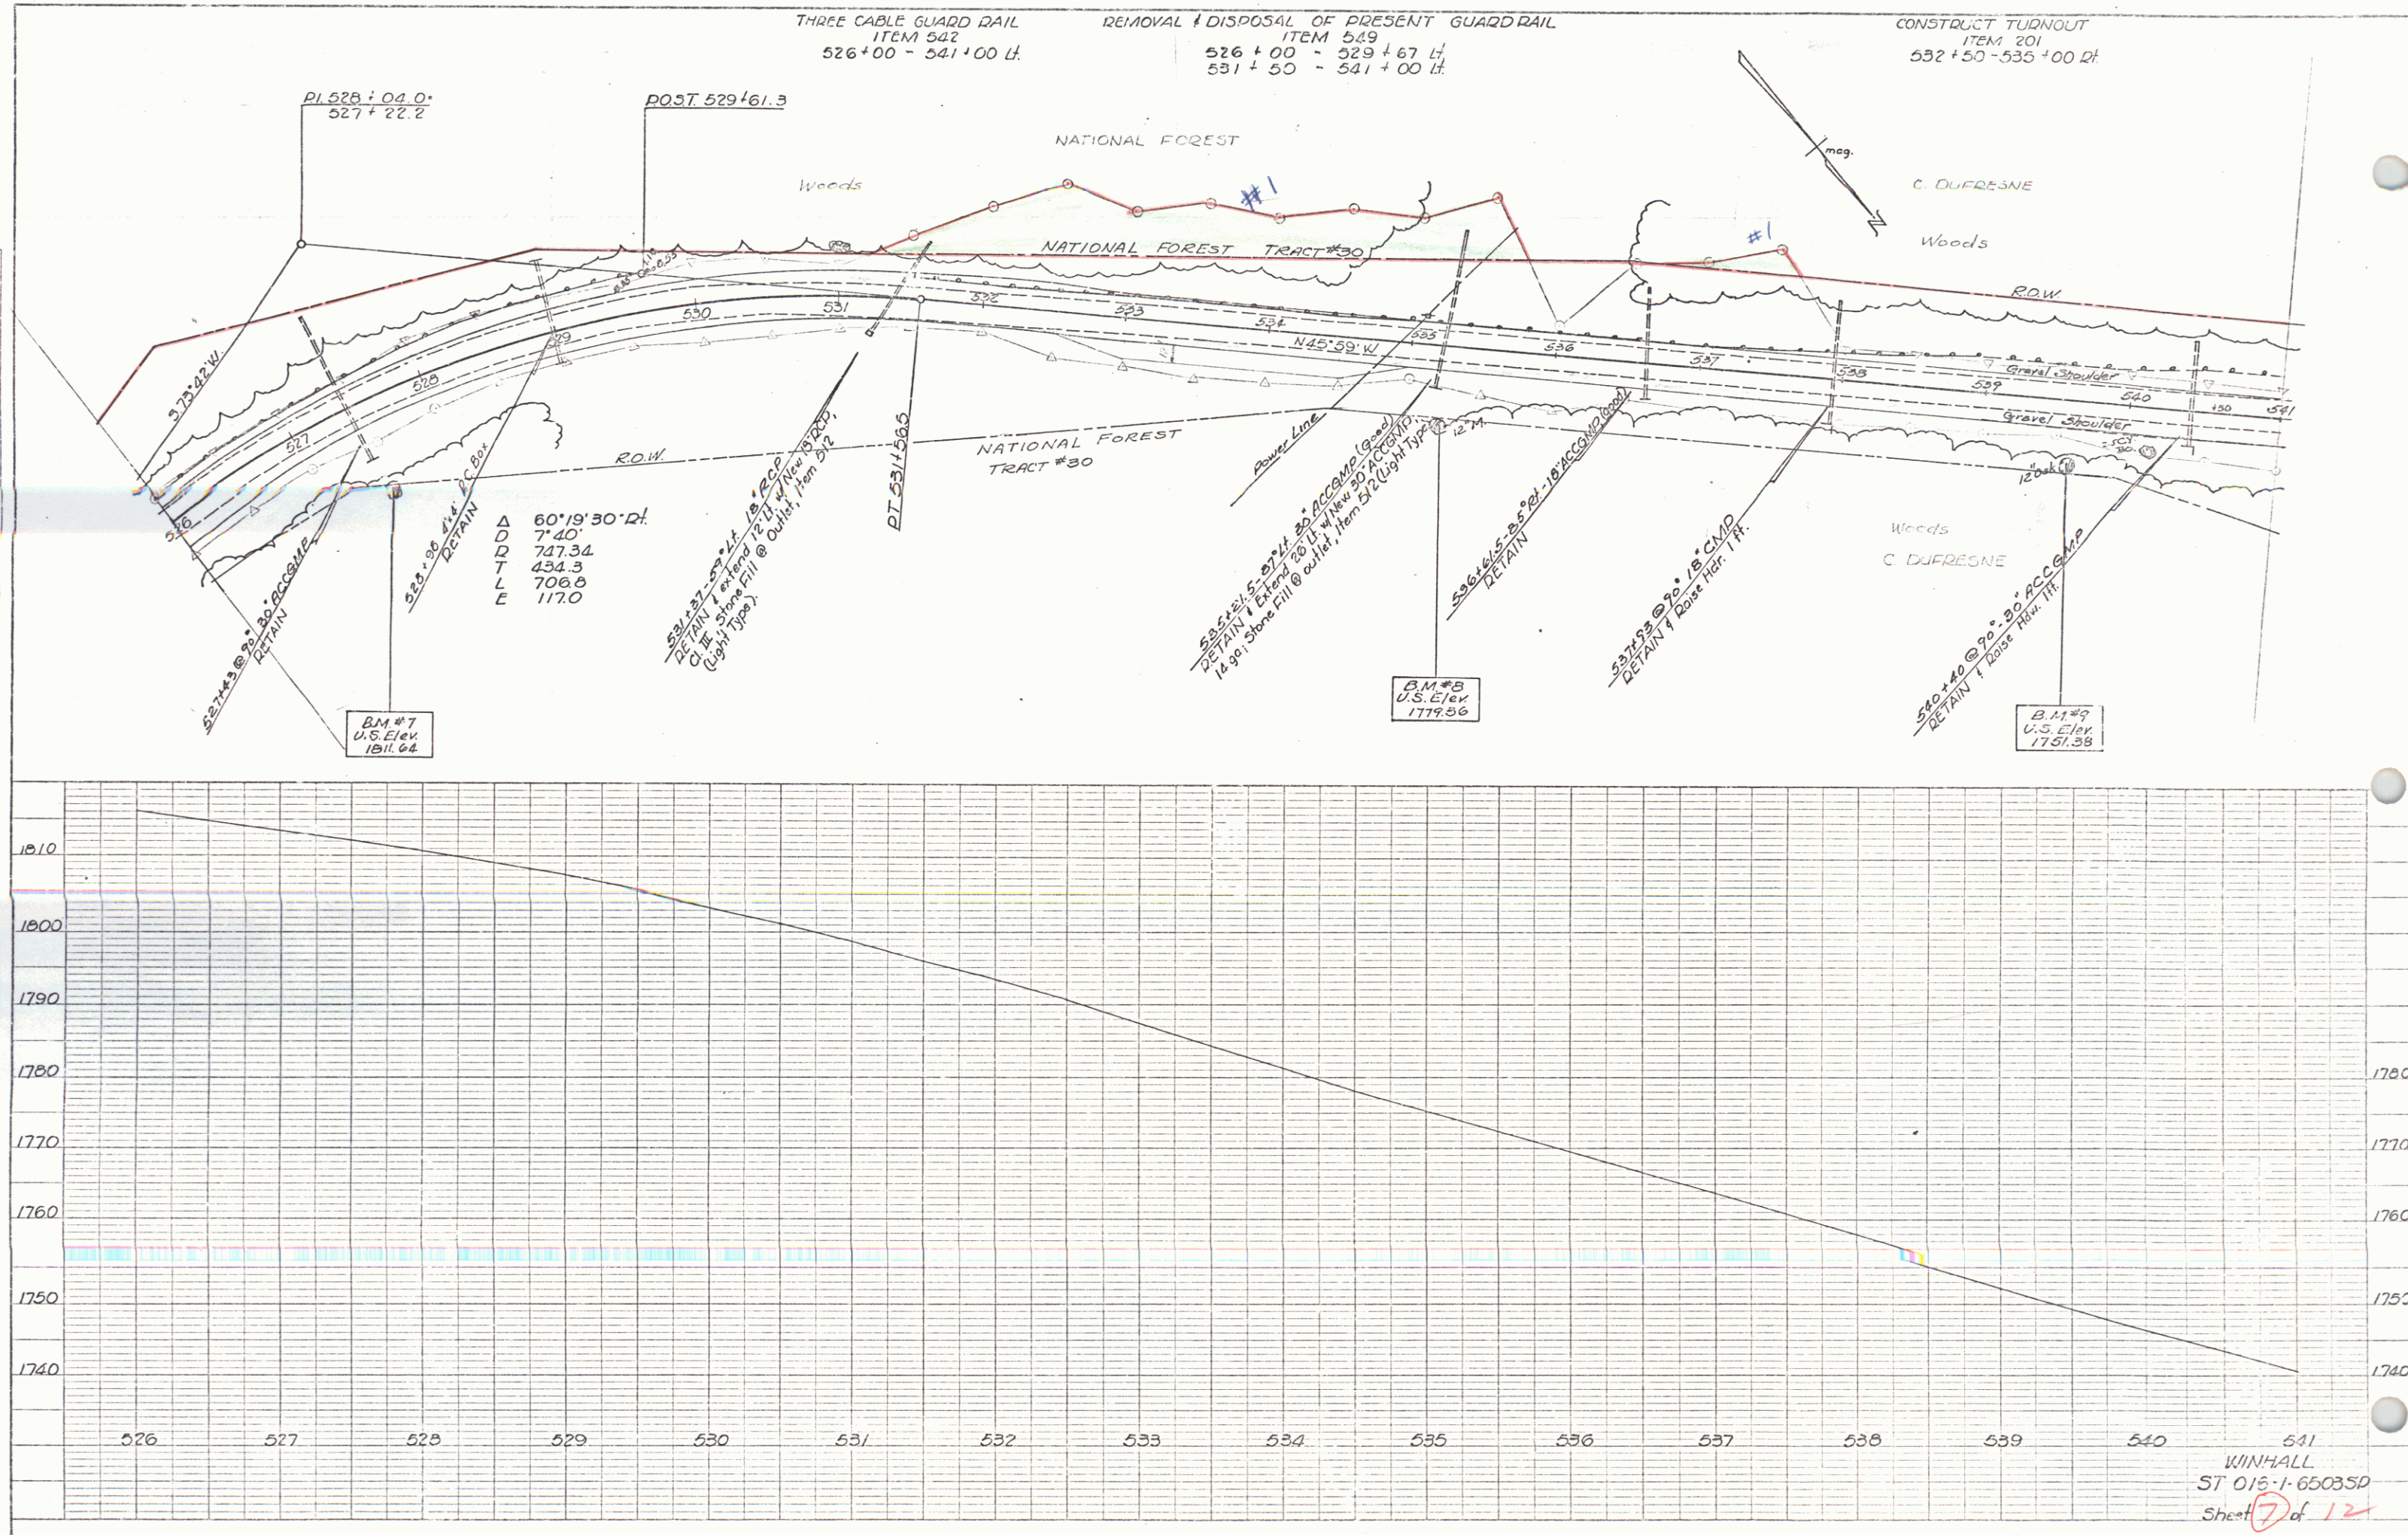

POOR ORIGINAL COPY

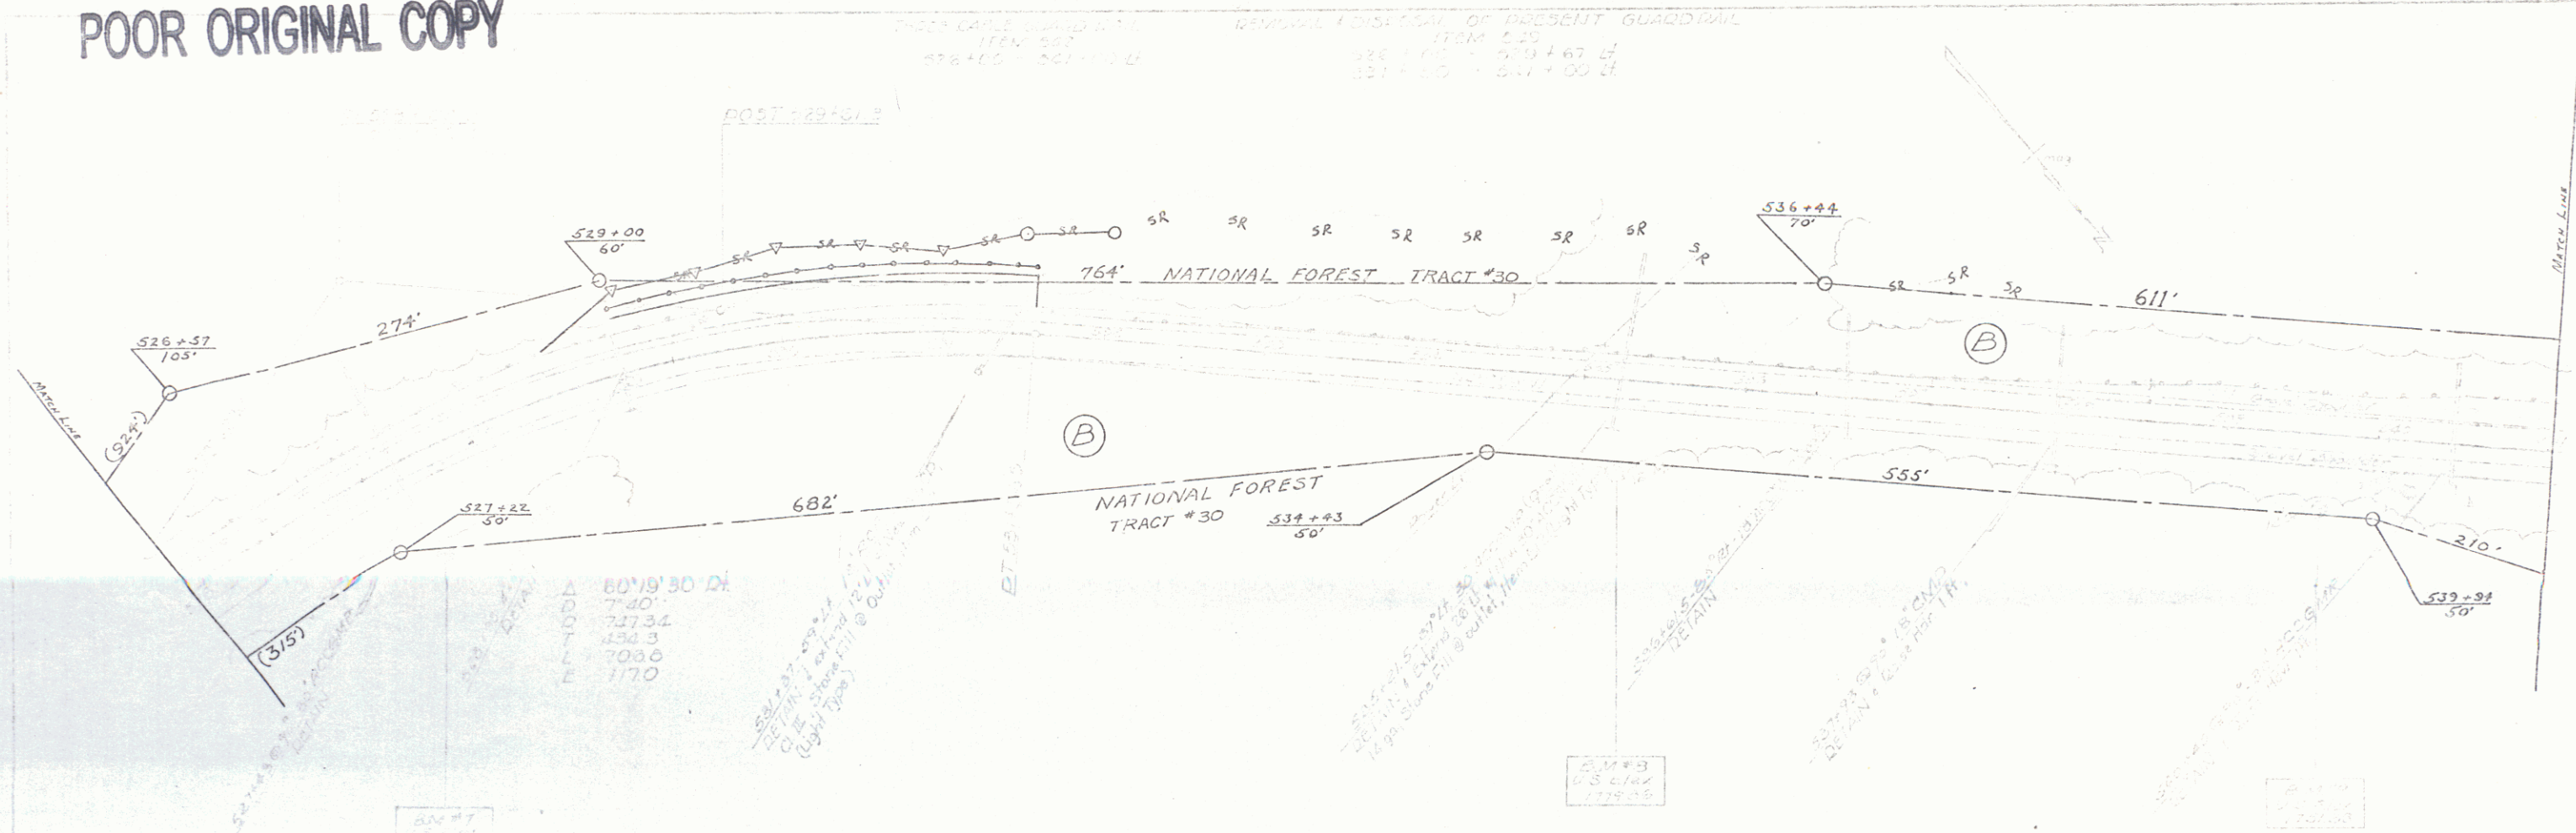


POOR ORIGINAL COPY

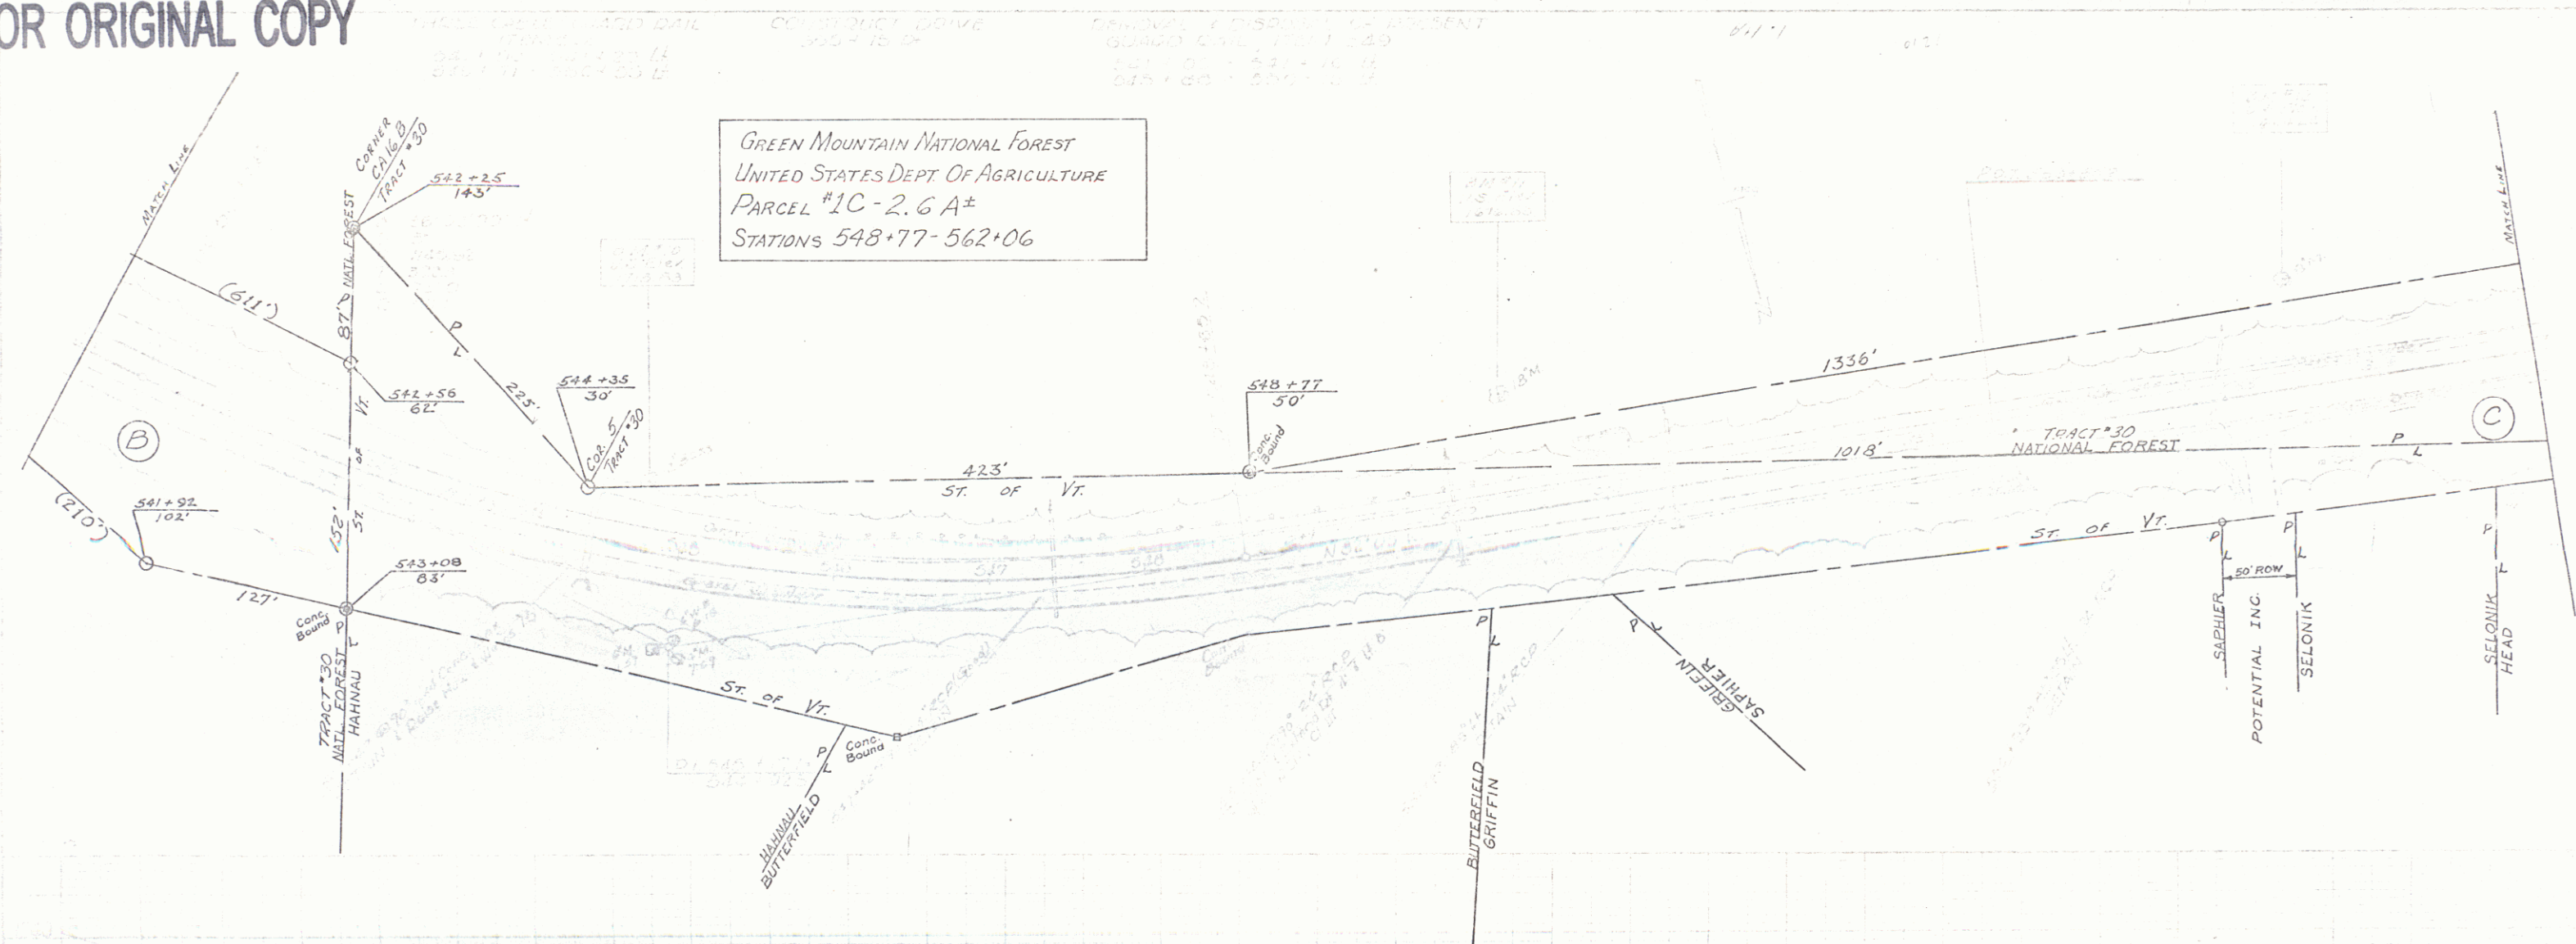

POOR ORIGINAL COPY

GREEN MOUNTAIN NATIONAL FOREST
UNITED STATES DEPT OF AGRICULTURE
PARCEL 1D 405A±
STATIONS - 576+00 - 597+10 ±

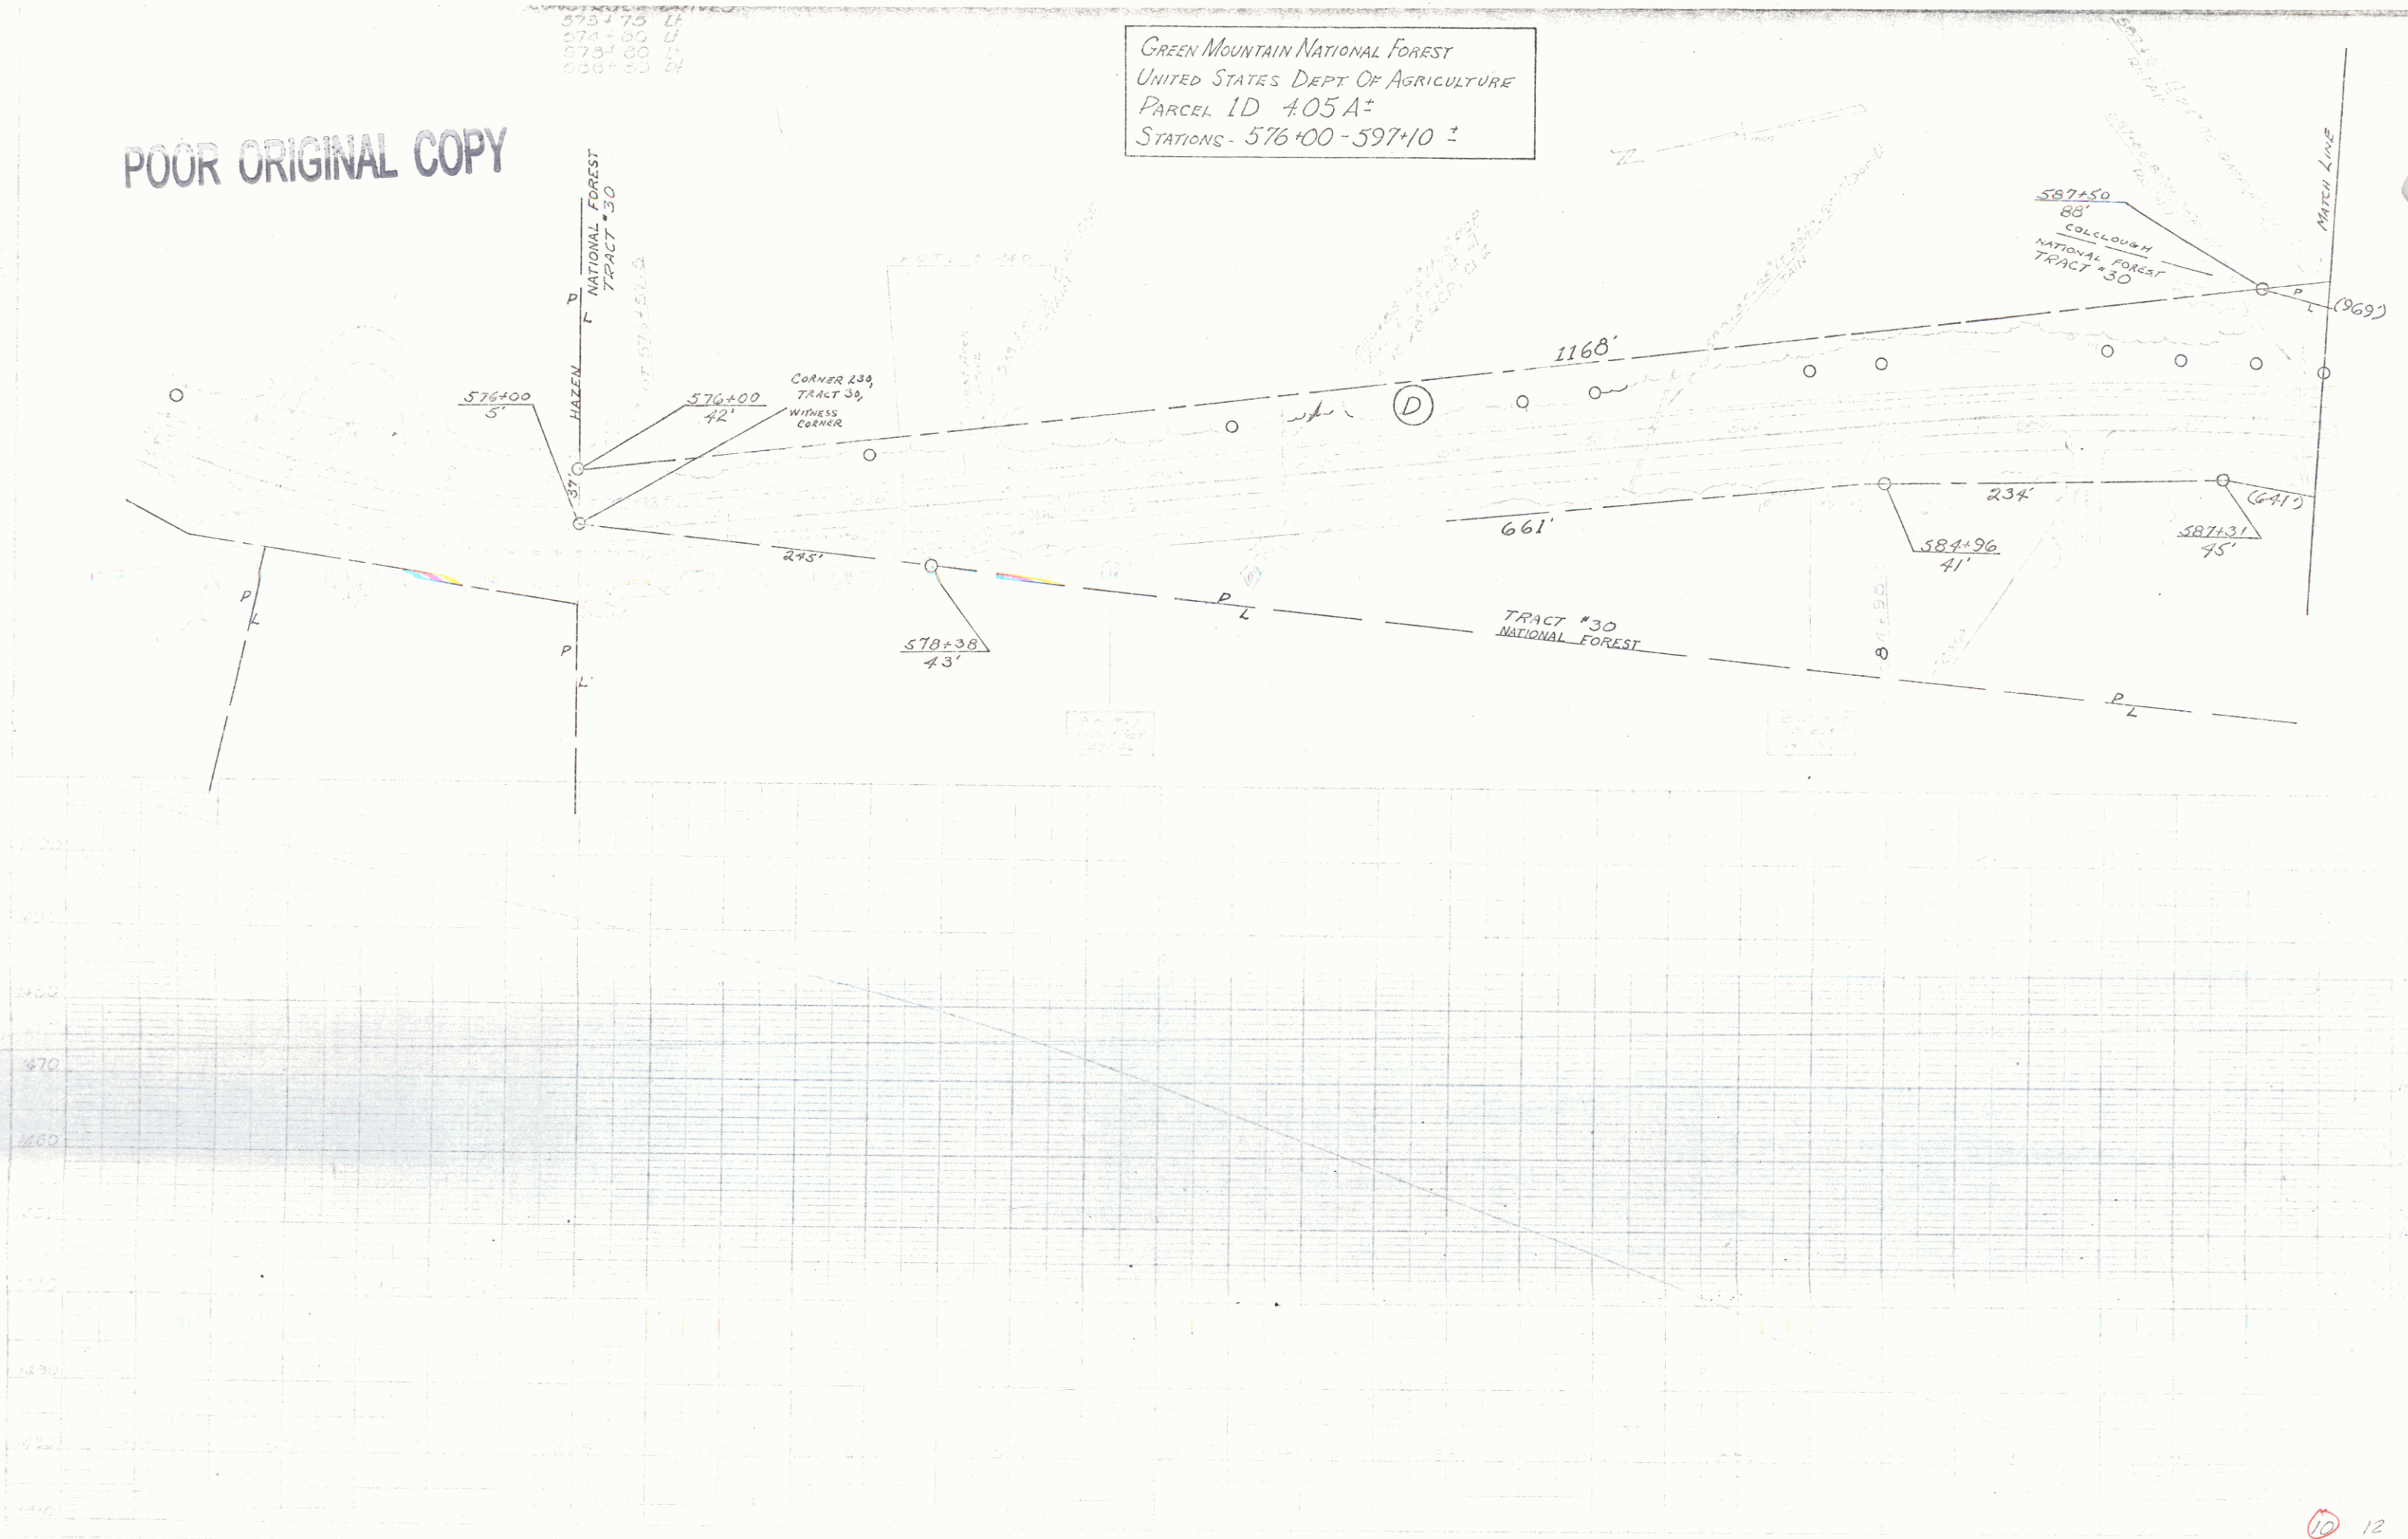

PLAN	DATE	1/12
	BY	W. H. HARRIS
	NOTED	
	NO.	

PROFILE	DATE	1/12
	BY	W. H. HARRIS
	NOTED	
	NO.	



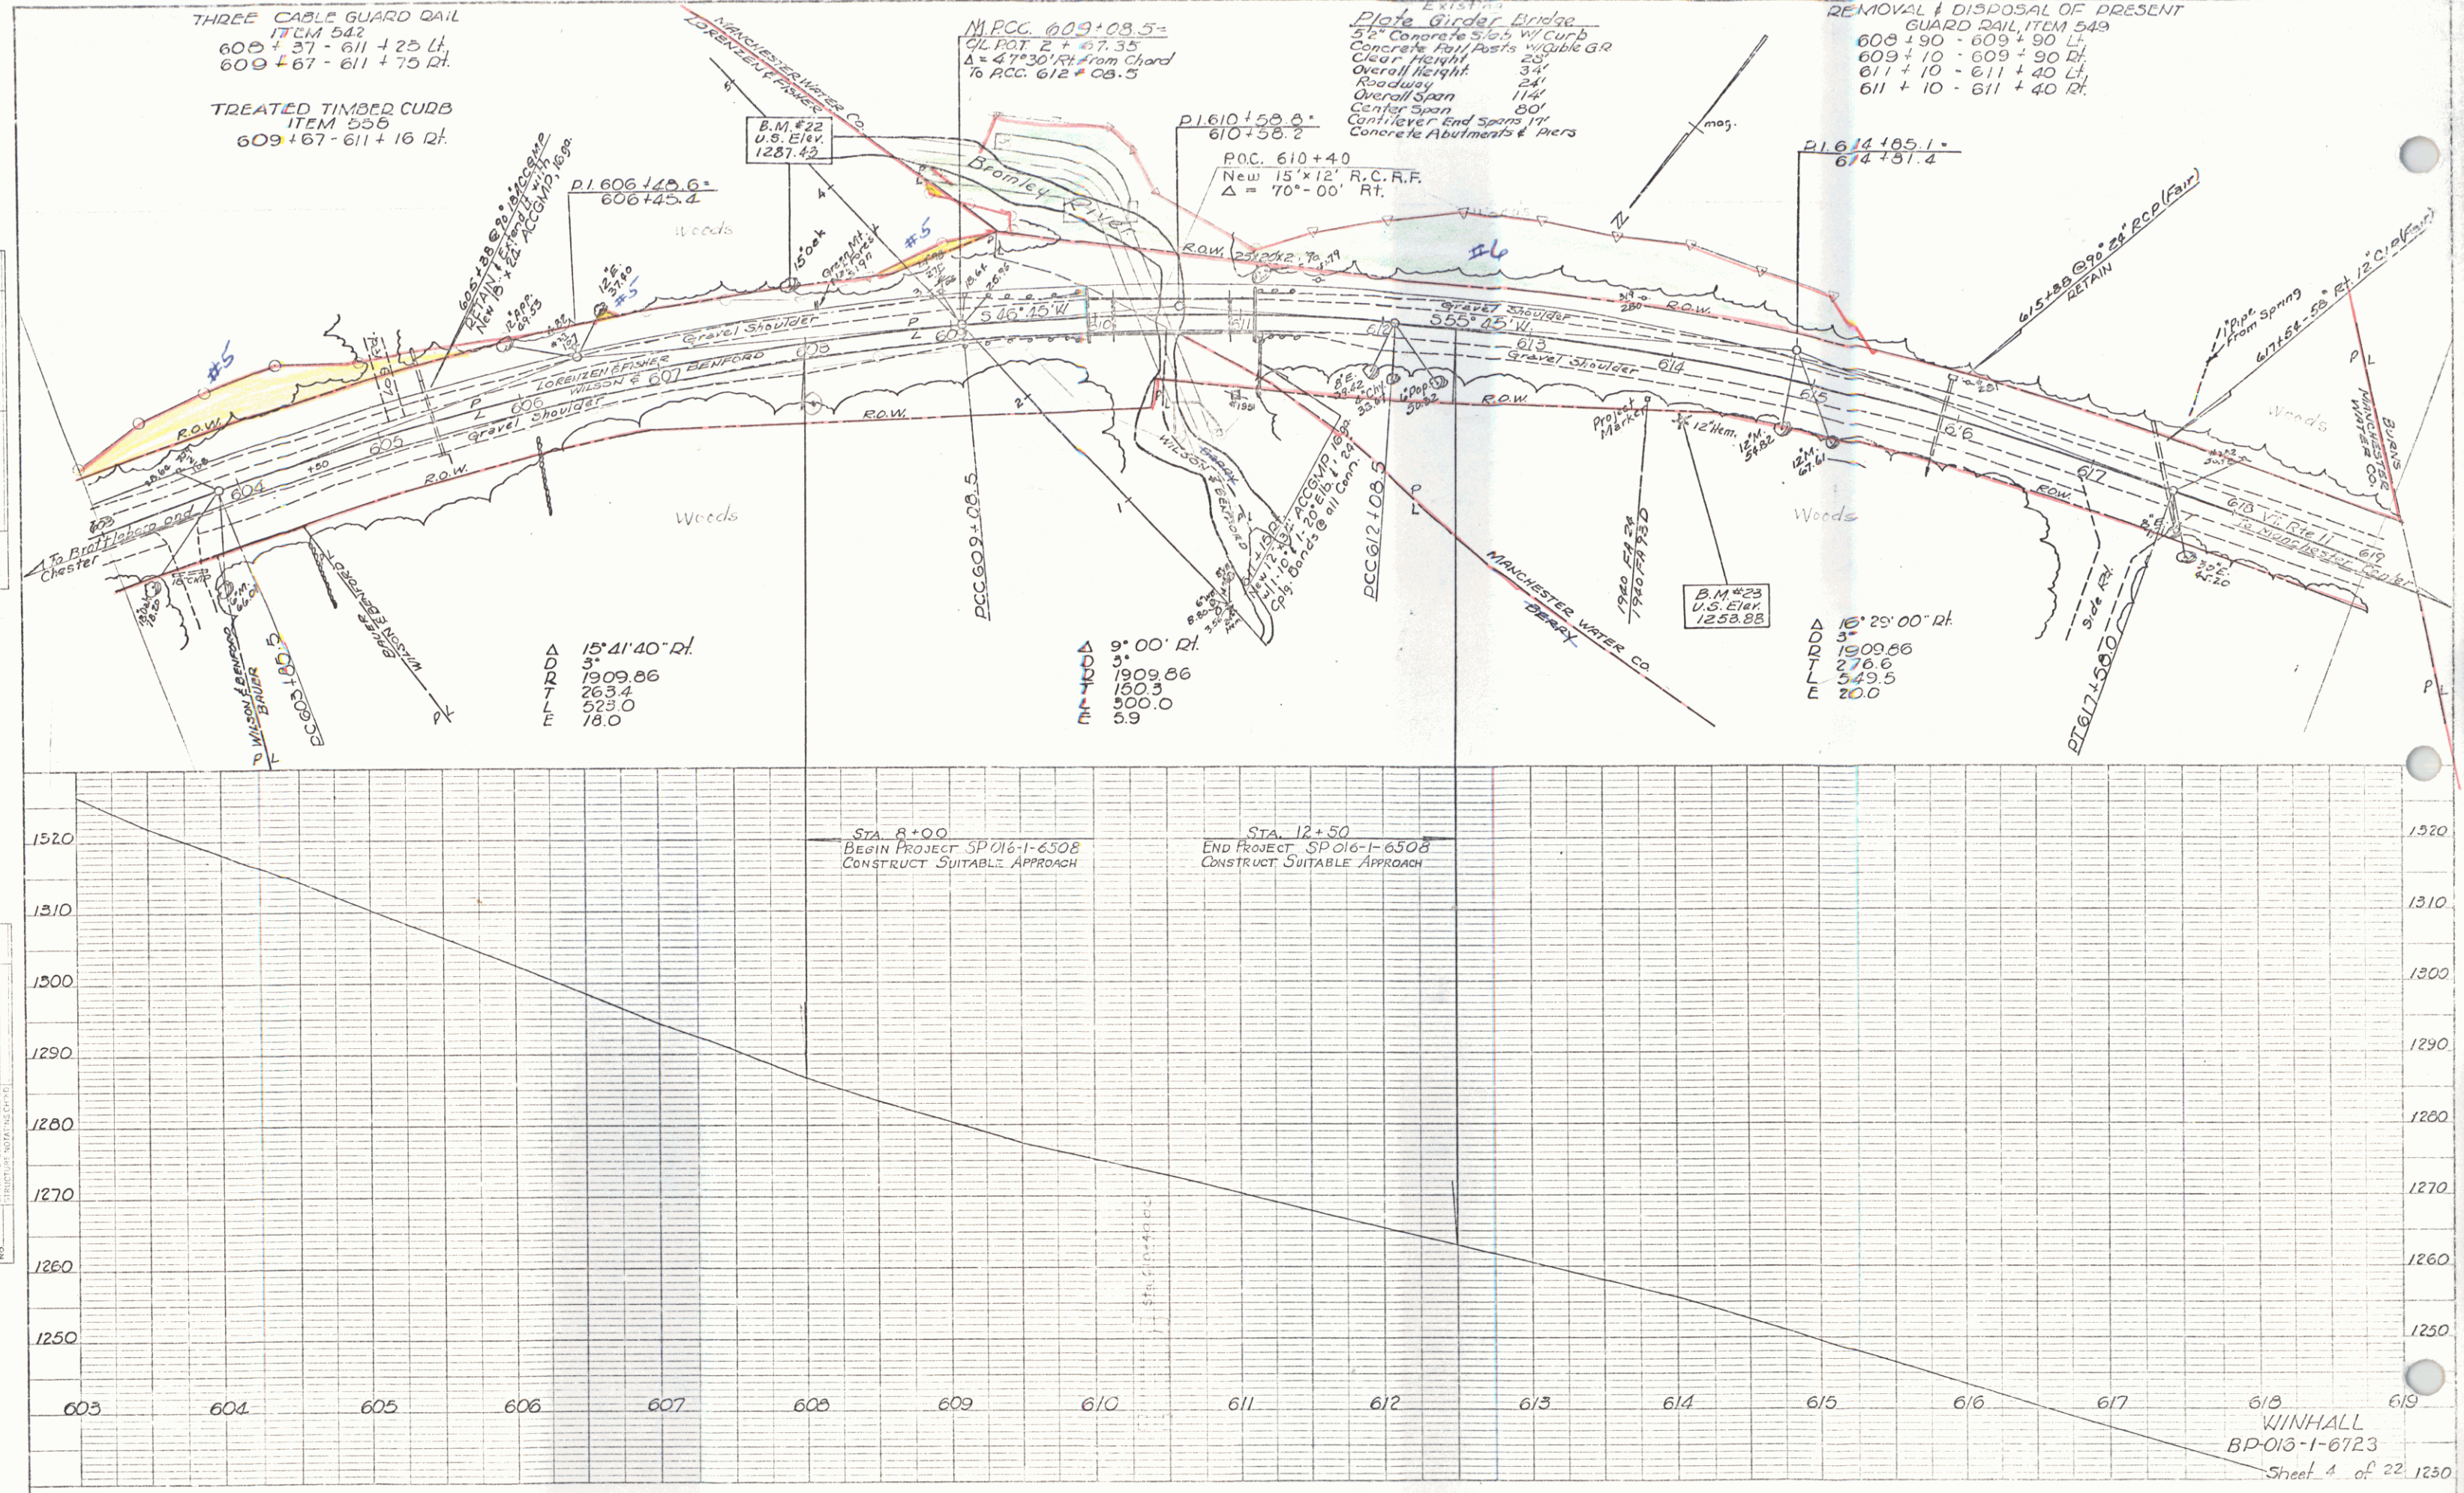


PLATE 1, PLAN PROFILE
HARRIS & HARRIS CO.

POOR ORIGINAL COPY

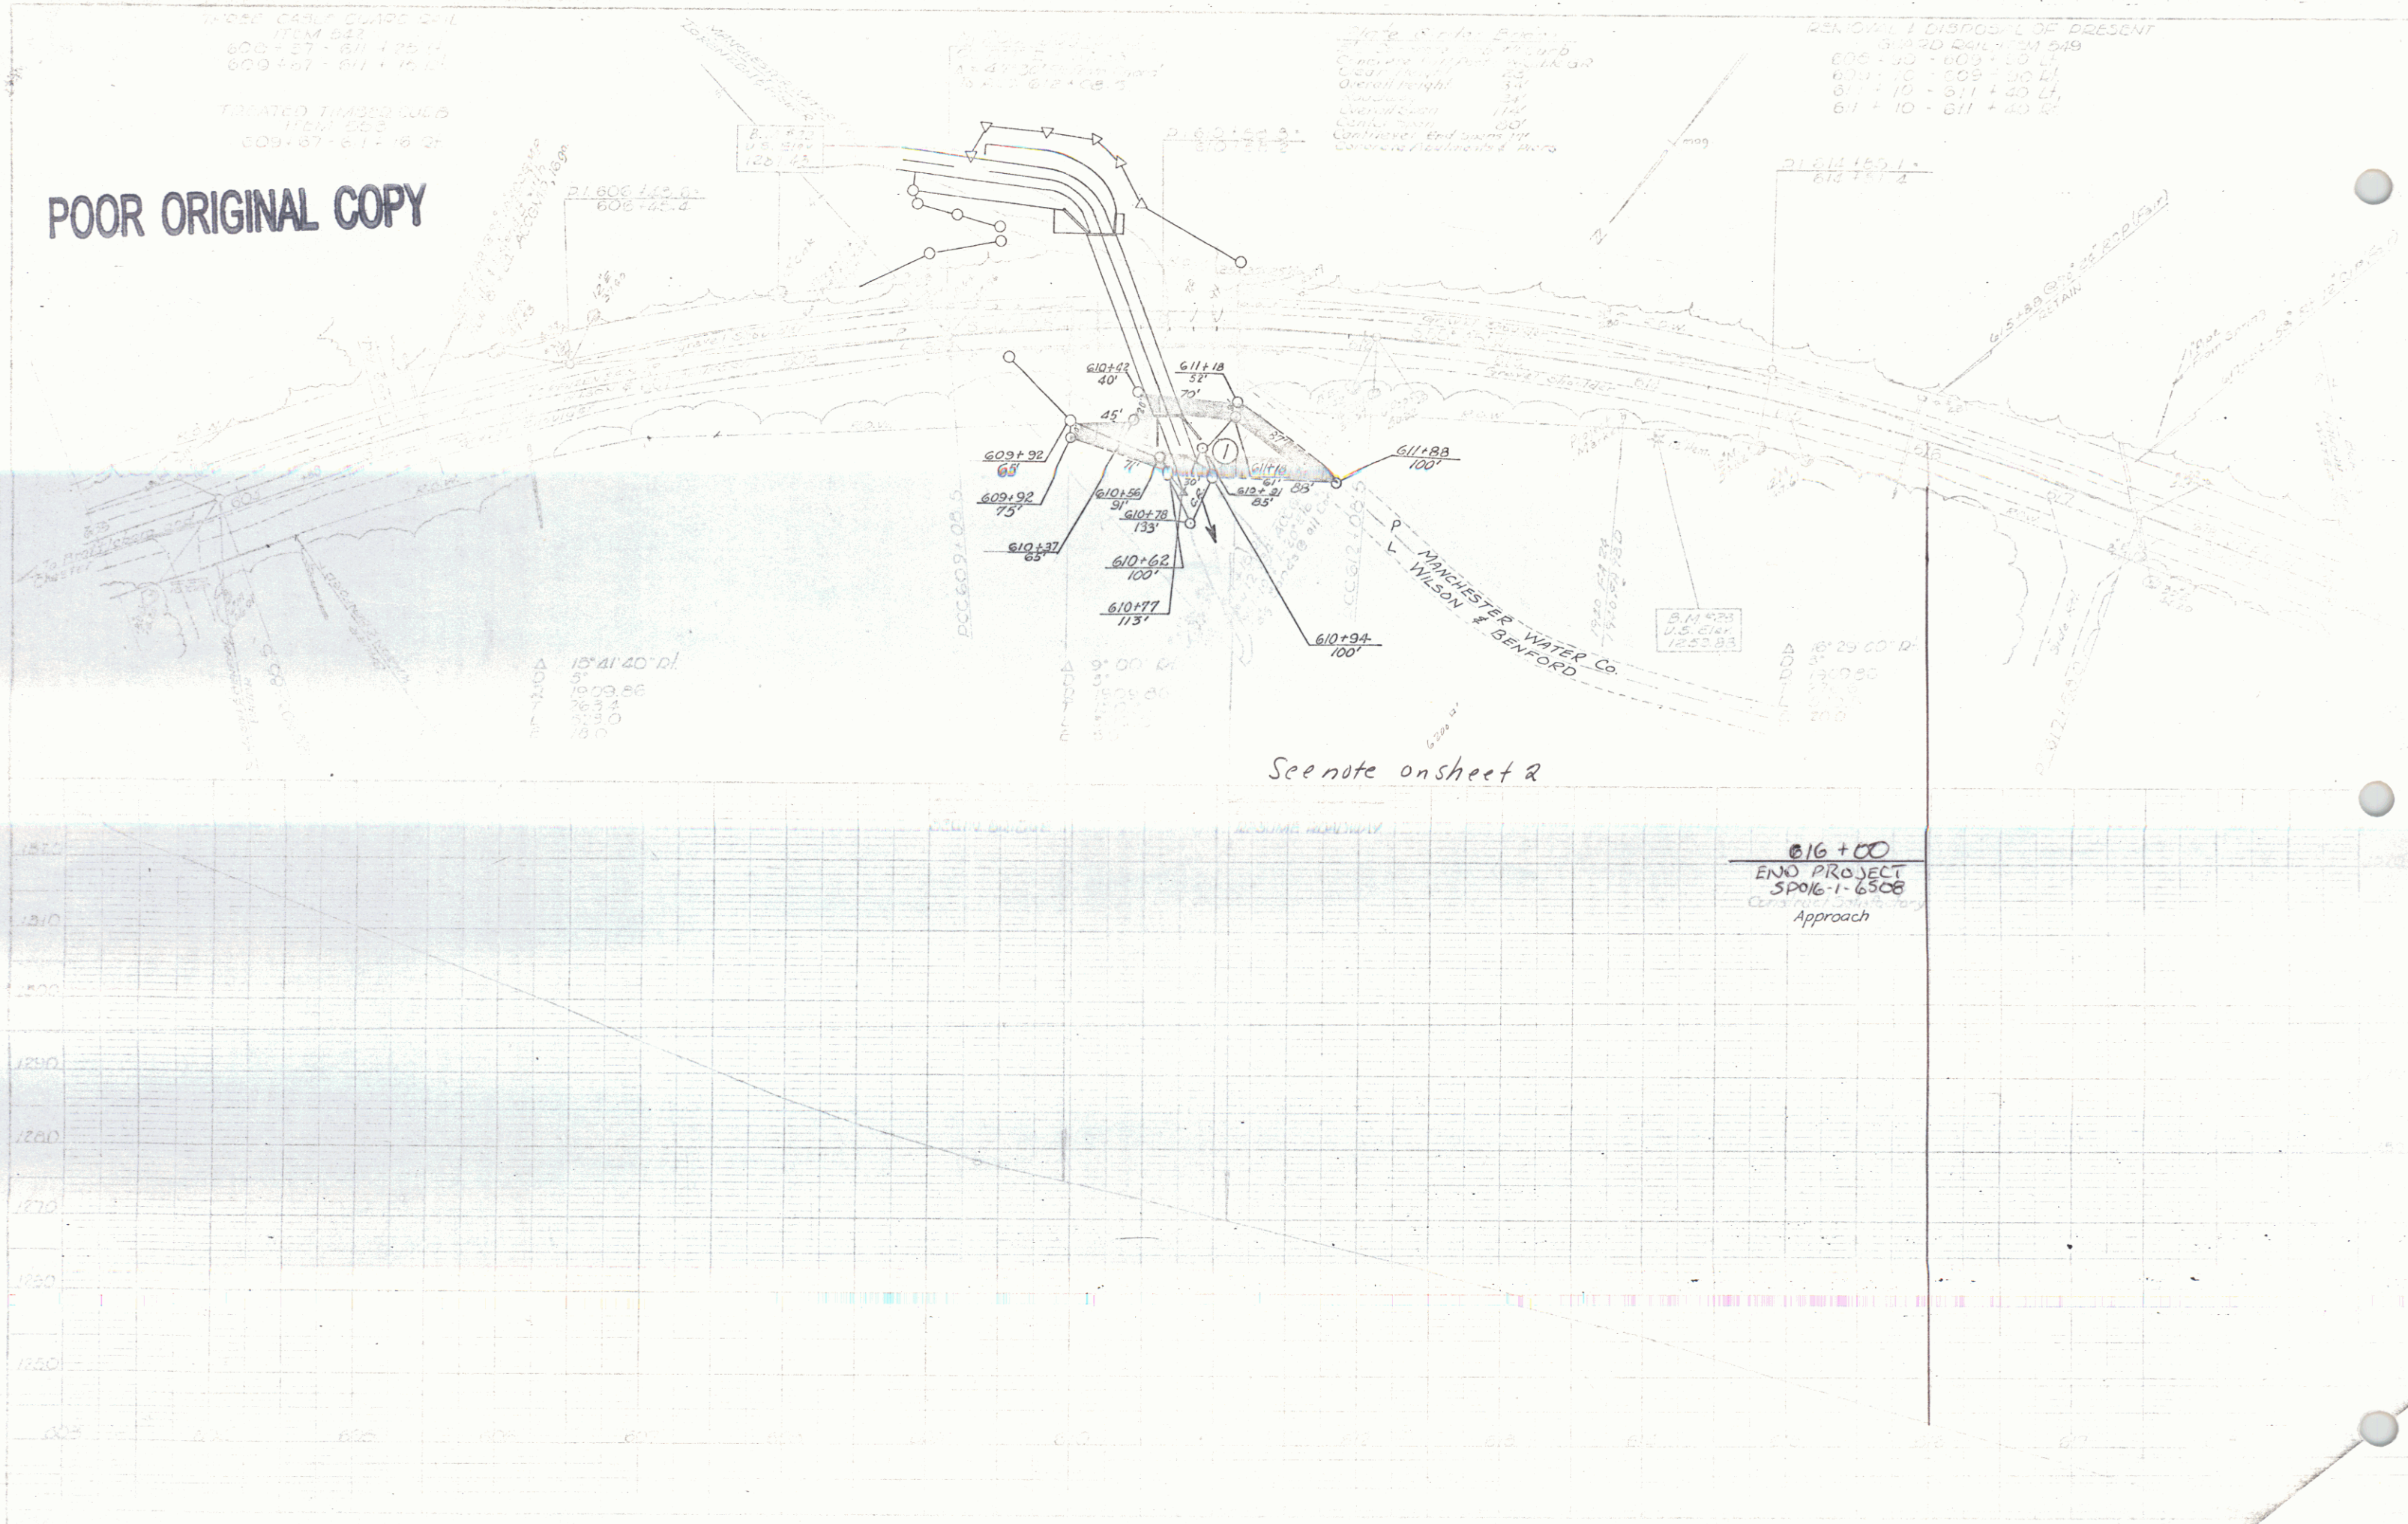

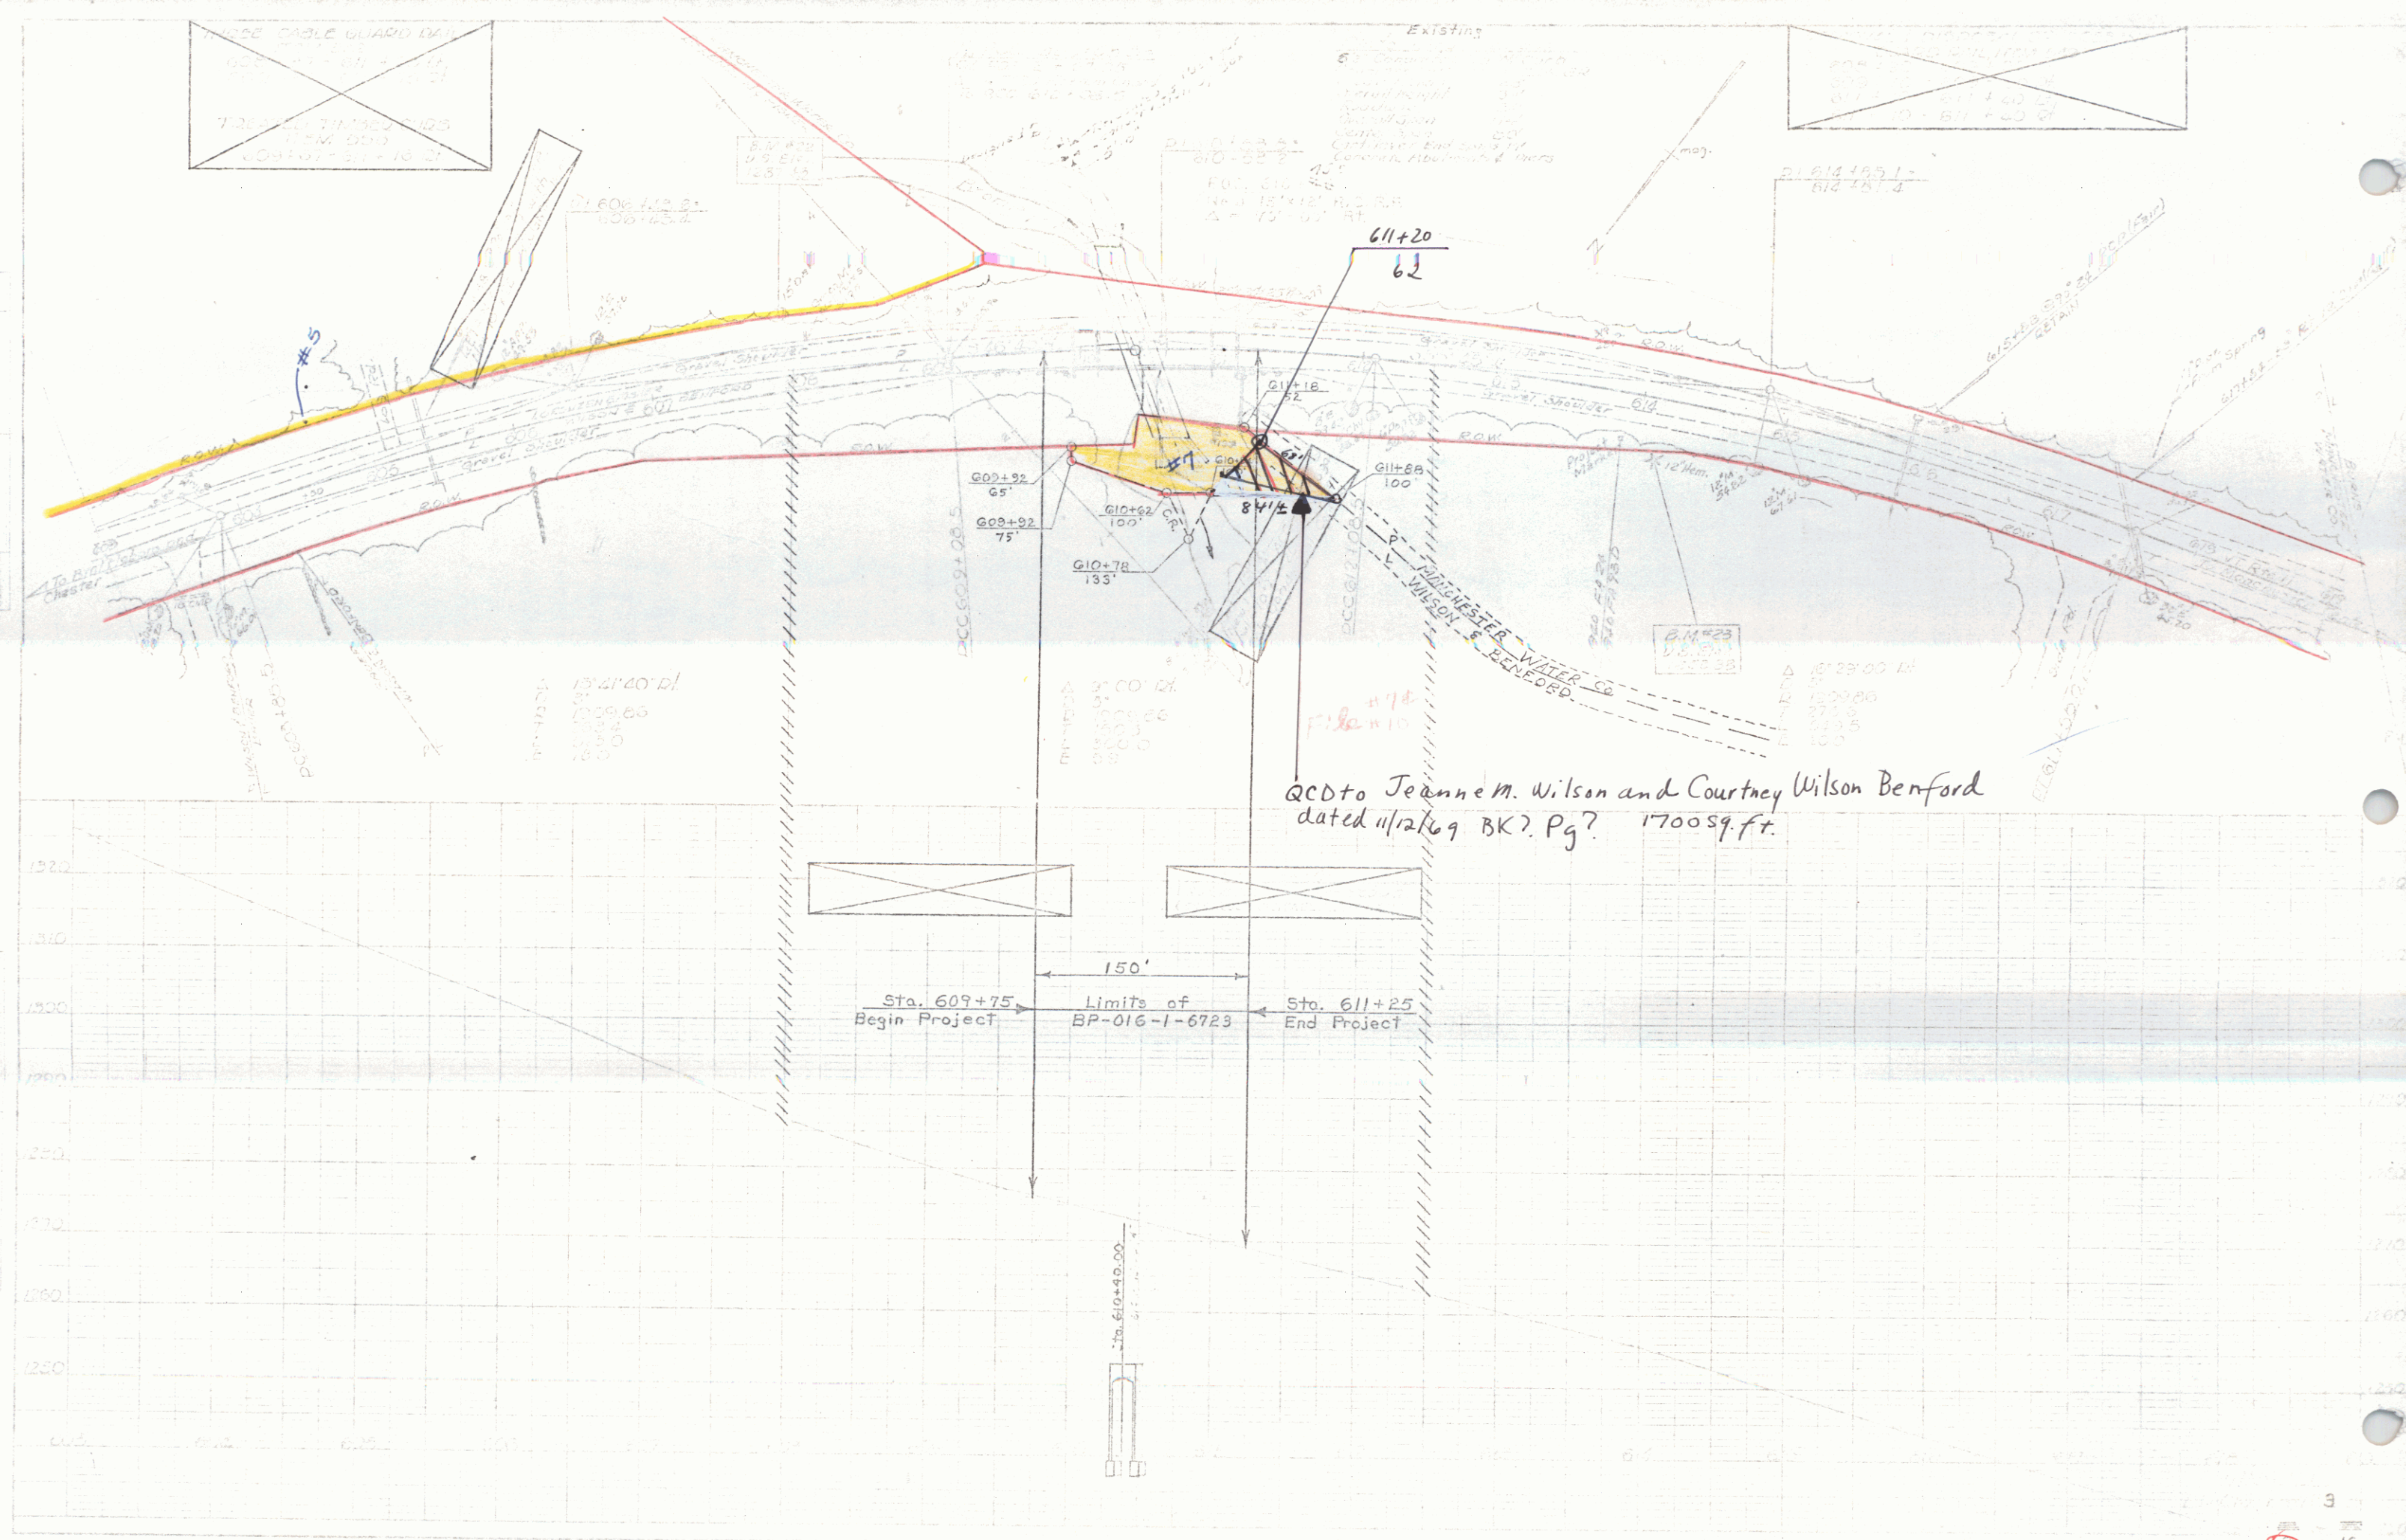

3
16

PLAN	DATE	11/11/11
	BY	James J. Smith
	CHECKED	Chris M.
	NOTED	
NOTE: ROAD ALIGNMENT CHECKED BY: JTS		

PROFILE	DATE	11/11/11
	BY	James J. Smith
	CHECKED	Chris M.
	NOTED	
NOTE: ROAD ALIGNMENT CHECKED BY: JTS		


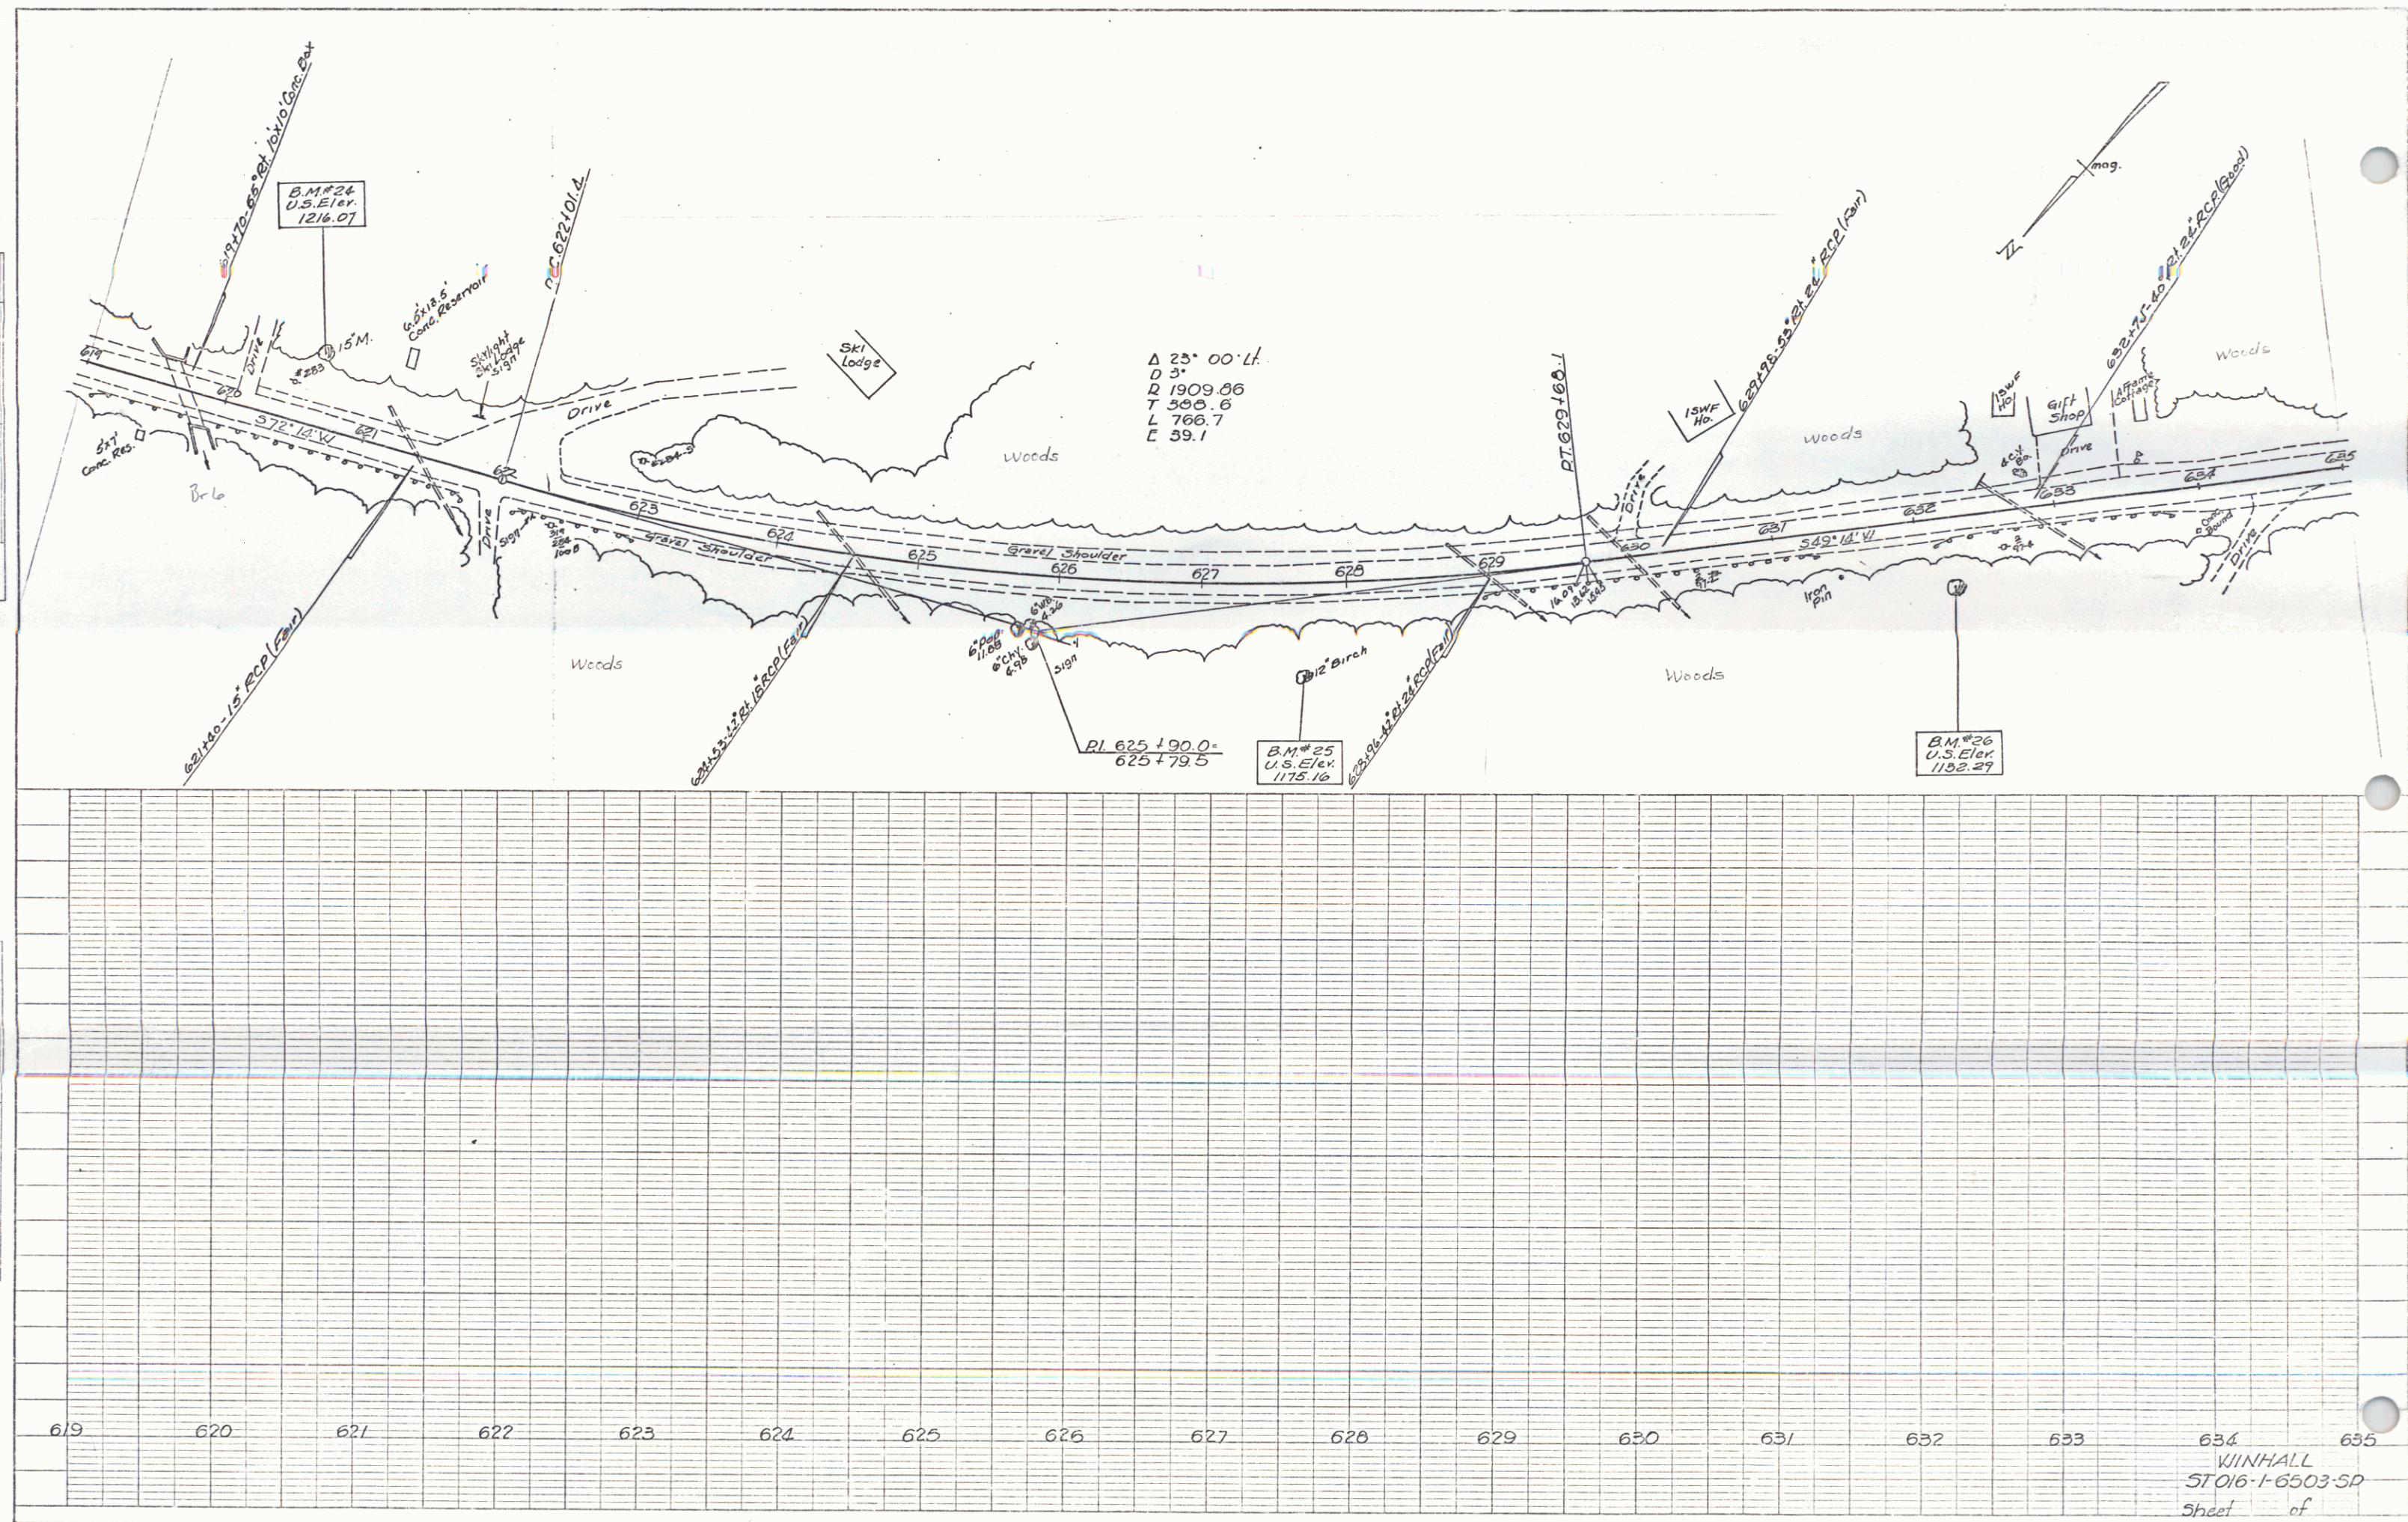


PLATE 1, PLAN PROFILE
 KELP & EDGAR CO.

WINHALL
 ST016-1-6503-SP
 Sheet of

PLAN	DATE	10/27
	PROJECT	Amelia, Perry, and 11th
	NOTE BOOK	10/27
	RT. OF WAY CHECKED	

PROFILE	DATE	10/27
	PROJECT	Amelia, Perry, and 11th
	NOTE BOOK	10/27
	RT. OF WAY CHECKED	

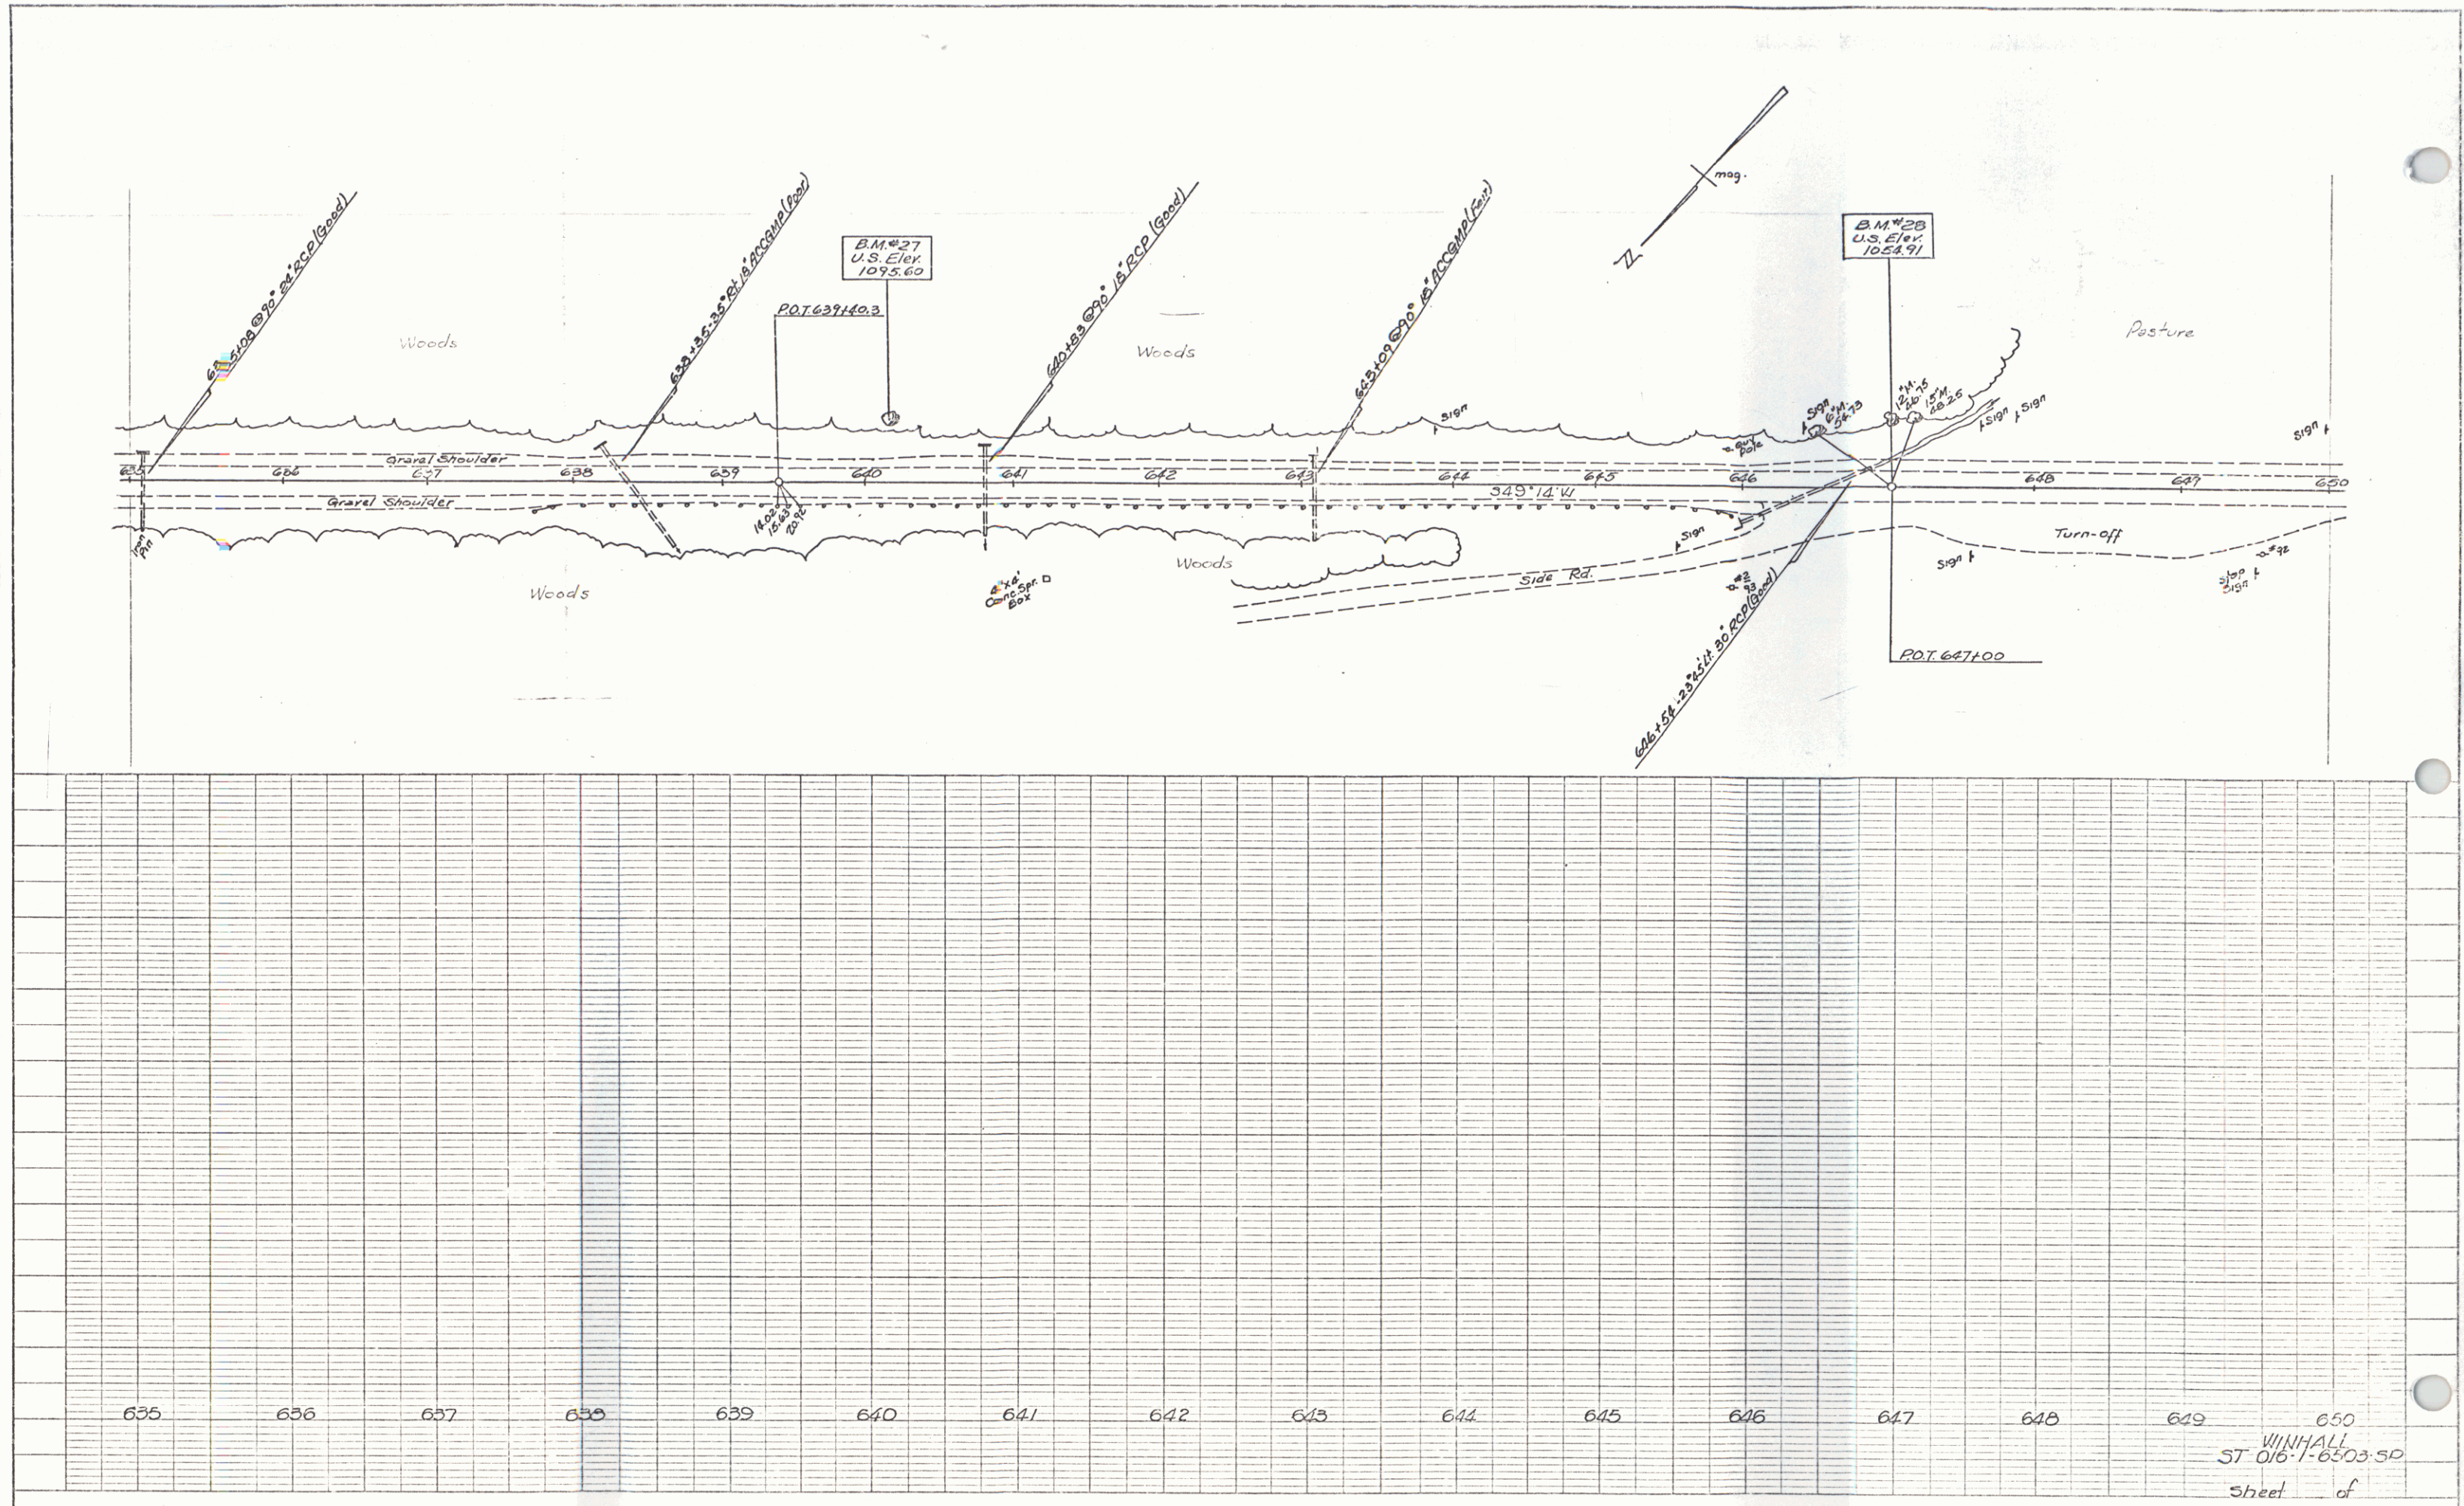

K&E PLATE 1, RAN-PHOLE
FIDEL & TUCKER CO.
48 7012 IMPERIAL™ TYPING CLIPPER 3000

WINHALL
ST 016-1-6303-50
Sheet of

PLAN	SUBMITTED	DATE
	APPROVED	DATE
	REVISIONS	
	NO.	

PROFILE	DATE
	BY
	NO.
	NO.

