

SHEET NO.	1	TITLE PAGE	
"	"	2 CROSS-SECTION OF IMPROVEMENT	
"	"	3 BANKING AND WIDENING TABLES	
"	4-10	PLAN AND PROFILE	
"	11	STD. STRUCT. SHEET	S-28, PIPE CUL.
"	12	"	S-30, GUARD RAIL
"	13	"	S-30A, BOUNDARY
"	14	"	SC-2-4, BARREL, 4
"	15	"	SCW-4, WINGS, 4
"	16	"	S-40, BARRICADE
"	17	"	S-41, TYPICAL GUT
"	18	DETAILS, 12 X 12 R.C. BOX	STA. 517 + 56
"	20-63	CROSS SECTIONS.	

S-28, APRIL 26, 1941.
S-30, MAY 12, 1941.
S-30A, APRIL 19, 1941.
S-40, SEPT. 5, 1940.

RIGHT-OF-WAY DIVISION
TOWN FILE
PERMITAL

PLAN AND PROFILE OF PROPOSED STATE HIGHWAY



FEDERAL AID PROJECT

TOWN OF WINHALL

VERMONT ROUTE 11


BEGINNING AT A POINT 13,632.5 FEET NORTHEASTERLY
OF THE MANCHESTER-WINHALL TOWN LINE, AND
EXTENDING SOUTHWESTERLY 1.517 MILES, TO THE
EASTERLY END OF THE F.H. 2-A. PROJECT.

LENGTH OF PROJECT—8013.4 FT. = 1.517 MI.

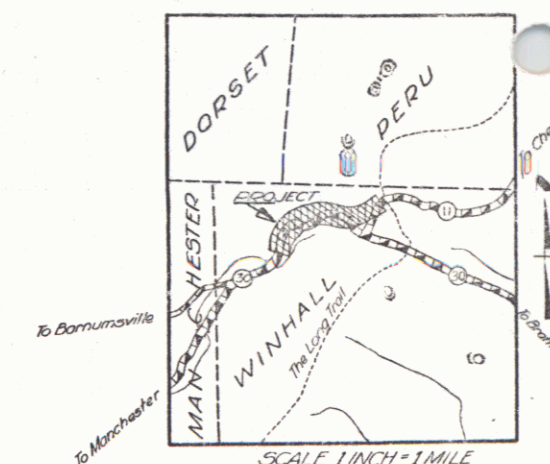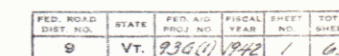

RECORD PLANS

By
E. O. Webster Feb. 1943

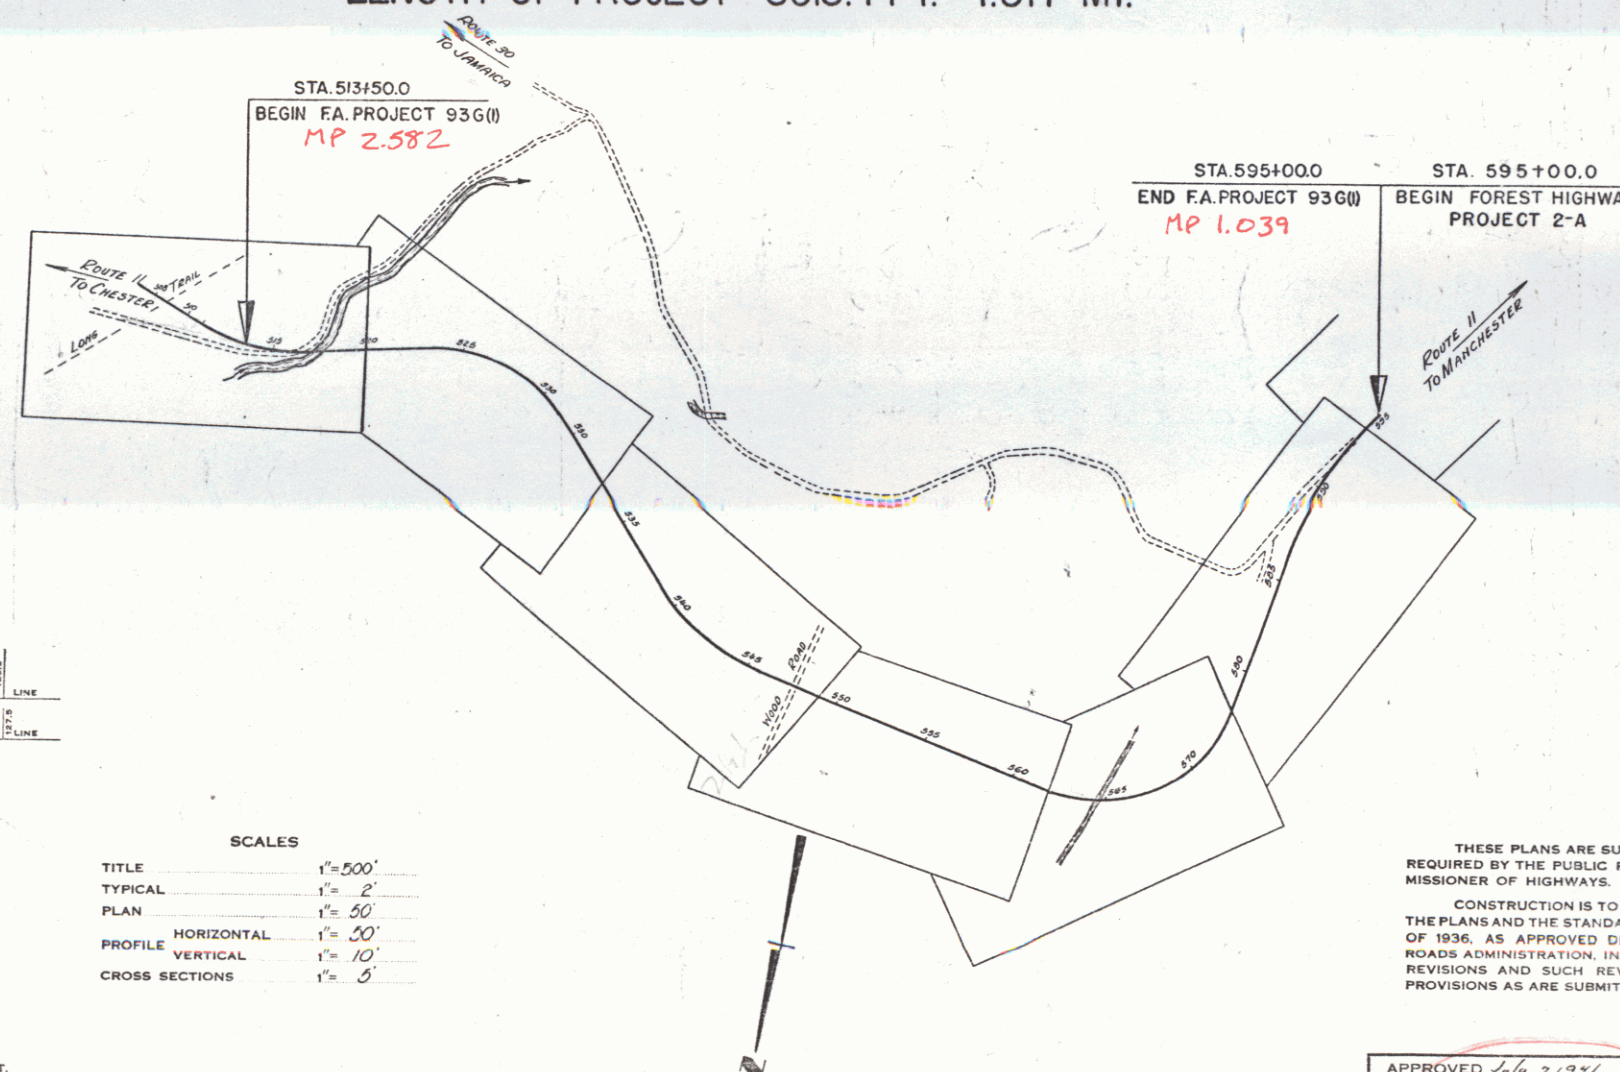

APPROVED: July 7, 1961
H. E. Langust
COMMISSIONER OF HIGHWAYS

SUBMITTED BY ORDER OF THE STATE HIGHWAY BOARD

Project No. FAP 936(1)

RECOMMENDED FOR APPROVAL

APPROVE

THESE PLANS ARE SUBJECT TO SUCH REVISIONS AS MAY BE
REQUIRED BY THE PUBLIC ROADS ADMINISTRATION OR THE COM-
MISSIONER OF HIGHWAYS.

CONSTRUCTION IS TO BE CARRIED ON IN ACCORDANCE WITH THE PLANS AND THE STANDARD ROAD AND BRIDGE SPECIFICATIONS OF 1936, AS APPROVED DECEMBER 29TH, 1936 BY THE PUBLIC ROADS ADMINISTRATION, INCLUDING ALL SUBSEQUENT APPROVED REVISIONS AND SUCH REVISED SPECIFICATIONS AND SPECIAL PROVISIONS AS ARE SUBMITTED WITH THE PLANS.

APPROVED *July 21*
A. J. R...
ROAD ENGINEER

APPROVED _____

SERIES F.A.P. NO. 93611/FILED
SHEET 1 OF 63

DIST. #1 PLANS