

TS

CON OF IMPROVEMENT 2 1/2" CRUSHED GRAVEL MIXED IN PLACE SURFACE COURSE WITH CUTBACK ASPHALT AND PRIME COAT OF REFINED "TAB" ITEMS 26, 30 & 31

- BOX STA 460+39
BOX STA 491+83
SHEET S-28 PIPE CULVERTS
SC 2-4 4X4 RC BOX
SCW-4 4X4 RC BOX
S-30 GUARD RAIL
S-30-A BOUNDARY MARKERS
S-40 BARRICADES SIGNS AND LIGHTS
S-41 ROUNDING OF SLOPES

SHEETS APPROVED
ENGINEER

- 4-26-41
5-12-41
4-19-41
9-5-40

STATE OF VERMONT
STATE HIGHWAY DEPARTMENT

PLAN AND PROFILE OF PROPOSED
STATE HIGHWAY

FEDERAL AID PROJECT

TOWN OF WINHALL


ROUTE 11

PERU-MANCHESTER ROAD

BEGINNING AT THE PERU WINHALL TOWN LINE AND EXTENDING WESTERLY 1.553 MILES

LENGTH PROJECT: 8200 FEET = 1.553 MILES

Pin# 99R 896

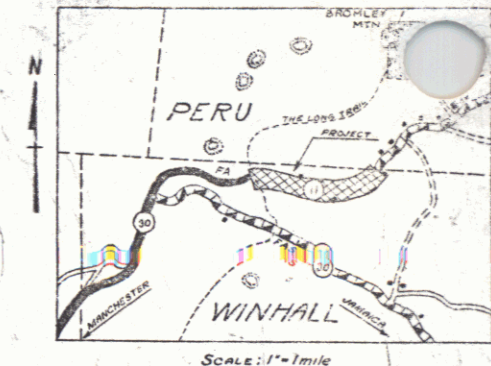


RECORD PLANS

Prepared by- R.C. Armer, Mar. 1949

Res. Engr.- E.H. Stickney

& E.W. Carley

(To Be Returned to R.O.W. Division)
Town of Winhall
PERMANENT
TOWN FILE
RIGHT-OF-WAY DIVISION

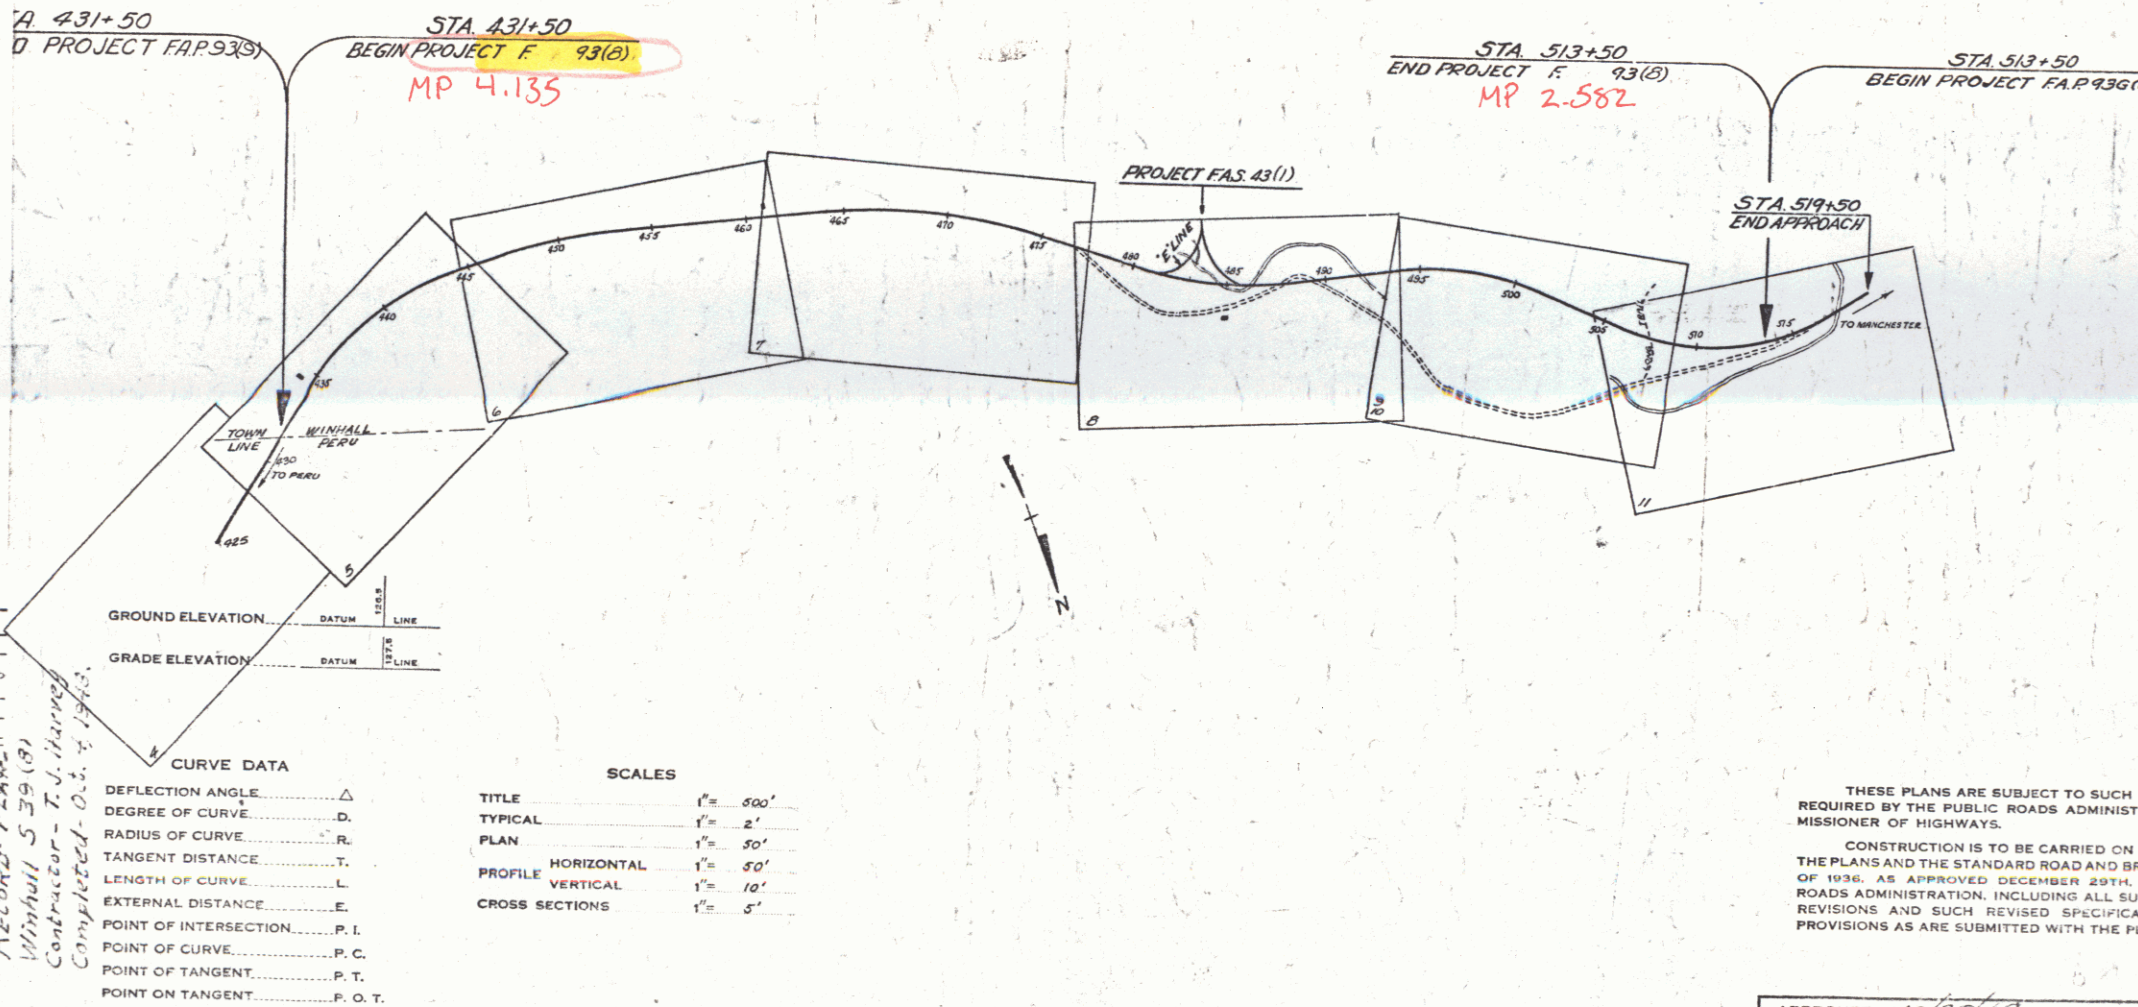

Record File
Winhall S 39 (a)
Contractor - R.C. Armer
Completed - 0.3. 4 1949

- CURVE DATA
- | | |
|-----------------------|----------|
| DEFLECTION ANGLE | Δ |
| DEGREE OF CURVE | D |
| RADIUS OF CURVE | R |
| TANGENT DISTANCE | T |
| LENGTH OF CURVE | L |
| EXTERNAL DISTANCE | E |
| POINT OF INTERSECTION | P. I. |
| POINT OF CURVE | P. C. |
| POINT OF TANGENT | P. T. |
| POINT ON TANGENT | P. O. T. |

- SCALES
- | | |
|--------------------|-----------|
| TITLE | 1" = 400' |
| TYPICAL | 1" = 2' |
| PLAN | 1" = 50' |
| PROFILE HORIZONTAL | 1" = 50' |
| PROFILE VERTICAL | 1" = 10' |
| CROSS SECTIONS | 1" = 5' |

THESE PLANS ARE SUBJECT TO SUCH REVISIONS AS MAY BE REQUIRED BY THE PUBLIC ROADS ADMINISTRATION OR THE COMMISSIONER OF HIGHWAYS.

CONSTRUCTION IS TO BE CARRIED ON IN ACCORDANCE WITH THE PLANS AND THE STANDARD ROAD AND BRIDGE SPECIFICATIONS OF 1936, AS APPROVED DECEMBER 29TH, 1936, BY THE PUBLIC ROADS ADMINISTRATION, INCLUDING ALL SUBSEQUENT APPROVED REVISIONS AND SUCH REVISED SPECIFICATIONS AND SPECIAL PROVISIONS AS ARE SUBMITTED WITH THE PLANS.

APPROVED: October 22, 1945
H. H. August
COMMISSIONER OF HIGHWAYS
SUBMITTED BY ORDER OF THE STATE HIGHWAY BOARD

RECOMMENDED FOR APPROVAL

DISTRICT ENGINEER
PUBLIC ROADS ADMINISTRATION
FEDERAL WORKS AGENCY

APPROVED

DISTRICT ENGINEER
PUBLIC ROADS ADMINISTRATION
FEDERAL WORKS AGENCY

APPROVED: 10/25/45
A. H. Howat
ROAD ENGINEER

APPROVED: 10/25/45
H. H. August
DISTRICT HIGHWAY COMMISSIONER

SERIES F-1 NO 93(B) FILED
SHEET 1 OF 3