

- 2 TYPICAL CROSS-SECTION OF IMPROVEMENT (USABLE FOR USE OF REPAIRS FOR WITH 400 STONE, 400 STONE)
- 3 BANKING AND WEEDING TABLE
- 4 PLAN AND PROFILE
- 11 STANDARD STRUCTURE SHEET S-28 PIPE CULVERTS
- 12 S-29 WOOD GUARD RAIL
- 13 S-30A STATE OR FEDERAL AD MARKERS
- 14 S-30B SUPERROAD, SHIELD & LIGHTS
- 15 S-31 TYPICAL GRADINGS
- 16-33 CROSS SECTIONS

STANDARD STRUCTURE SHEETS APPROVED BY
THE CHIEF ENGINEER, VERMONT STATE DEPT. OF HIGHWAYS

S-28 APR. 28, 1941
S-30 NOV. 10, 1947
S-30A APR. 19, 1941
S-40 DEC. 18, 1945

STATE OF VERMONT STATE HIGHWAY DEPARTMENT



PLAN AND PROFILE OF PROPOSED STATE HIGHWAY

SECONDARY PROJECT

TOWN OF GRANVILLE Pin # 992900

VERMONT ROUTE 12A

RANDOLPH-ROXBURY-NORTHFIELD ROAD
BEGINNING AT THE BRAINTREE-GRANVILLE TOWN
LINE AND EXTENDING 8906.6 FEET NORTHERLY
TO THE GRANVILLE-ROXBURY LINE
LENGTH OF PROJECT 8906.6 FEET=1.687 MILES

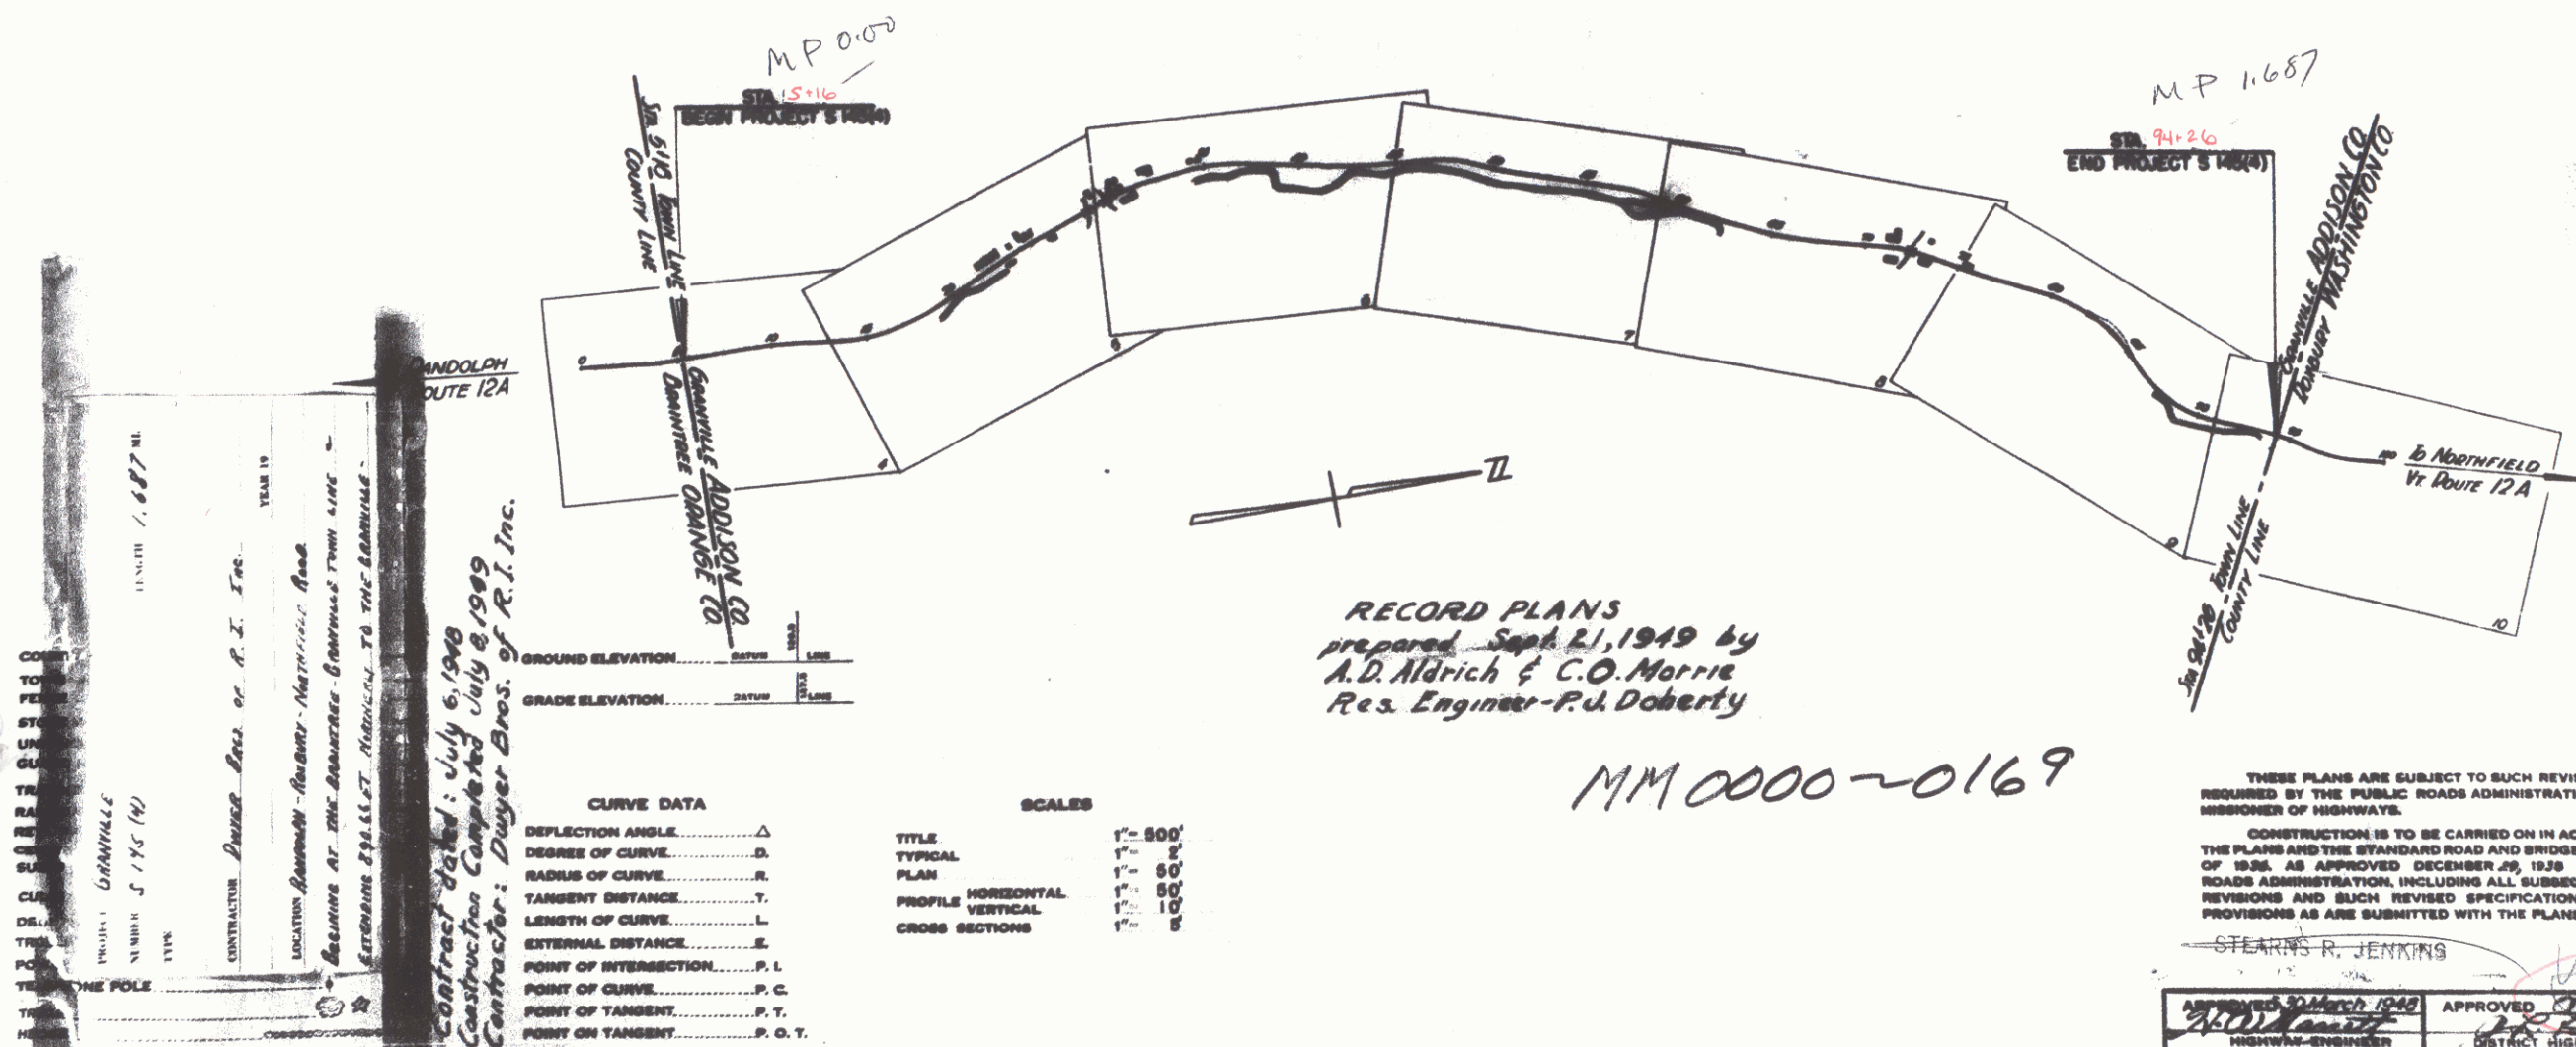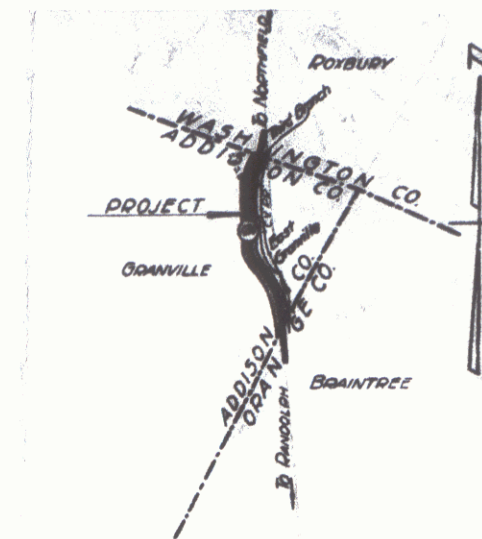

RECORD PLANS
prepared Sept. 21, 1949 by
A.D. Aldrich & C.O. Morris
Res. Engineer-P.D. Doherty

MM 0000-0169

APPROVED: 30 March 1949
H.E. Sargent
COMMISSIONER OF HIGHWAYS
SUBMITTED BY ORDER OF THE STATE HIGHWAY BOARD

Project No. S 145(4)

THESE PLANS ARE SUBJECT TO SUCH REVISIONS AS MAY BE
REQUIRED BY THE PUBLIC ROADS ADMINISTRATION OR THE COM-
MISSIONER OF HIGHWAYS.

CONSTRUCTION IS TO BE CARRIED ON IN ACCORDANCE WITH
THE PLANS AND THE STANDARD ROAD AND BRIDGE SPECIFICATIONS
OF 1938, AS APPROVED DECEMBER 29, 1938 BY THE PUBLIC
ROADS ADMINISTRATION, INCLUDING ALL SUBSEQUENT APPROVED
REVISIONS AND SUCH REVISED SPECIFICATIONS AND SPECIAL
PROVISIONS AS ARE SUBMITTED WITH THE PLANS.

STEARN R. JENKINS


APPROVED: 30 March 1949
APPROVED: 30 March 1949
DISTRICT HIGHWAY COMMISSIONER

SERIES 5 NO. 145(4) FILED
SHEET 1 OF 33

TREES
○ = Remove, Item 109

STA	POS
9+75	RT
10+25	LT

FED. ROAD STATE 9 FISCAL YEAR 1999 1999 4 33

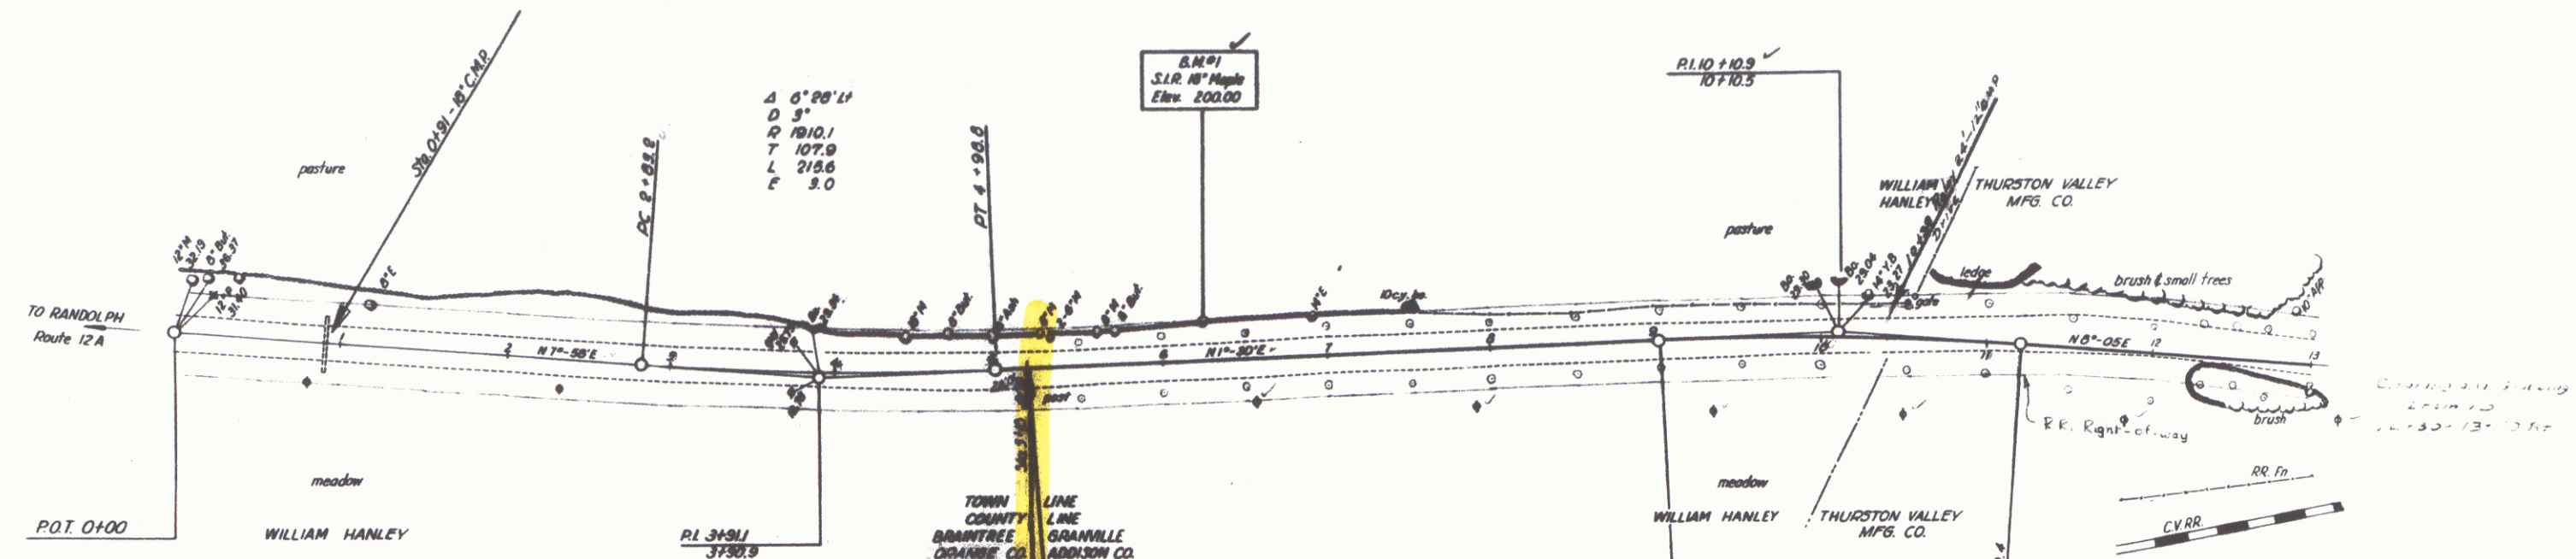


MULCH Item 622
To be placed on all earth slopes

STA	STA	POS
9+75	9+75	RT
10+25	10+25	LT
10+75	10+75	RT
11+25	11+25	LT

Federal Aid Marker ☒
Boundary Markers ☒ (None U.S.A.)

20
200
190


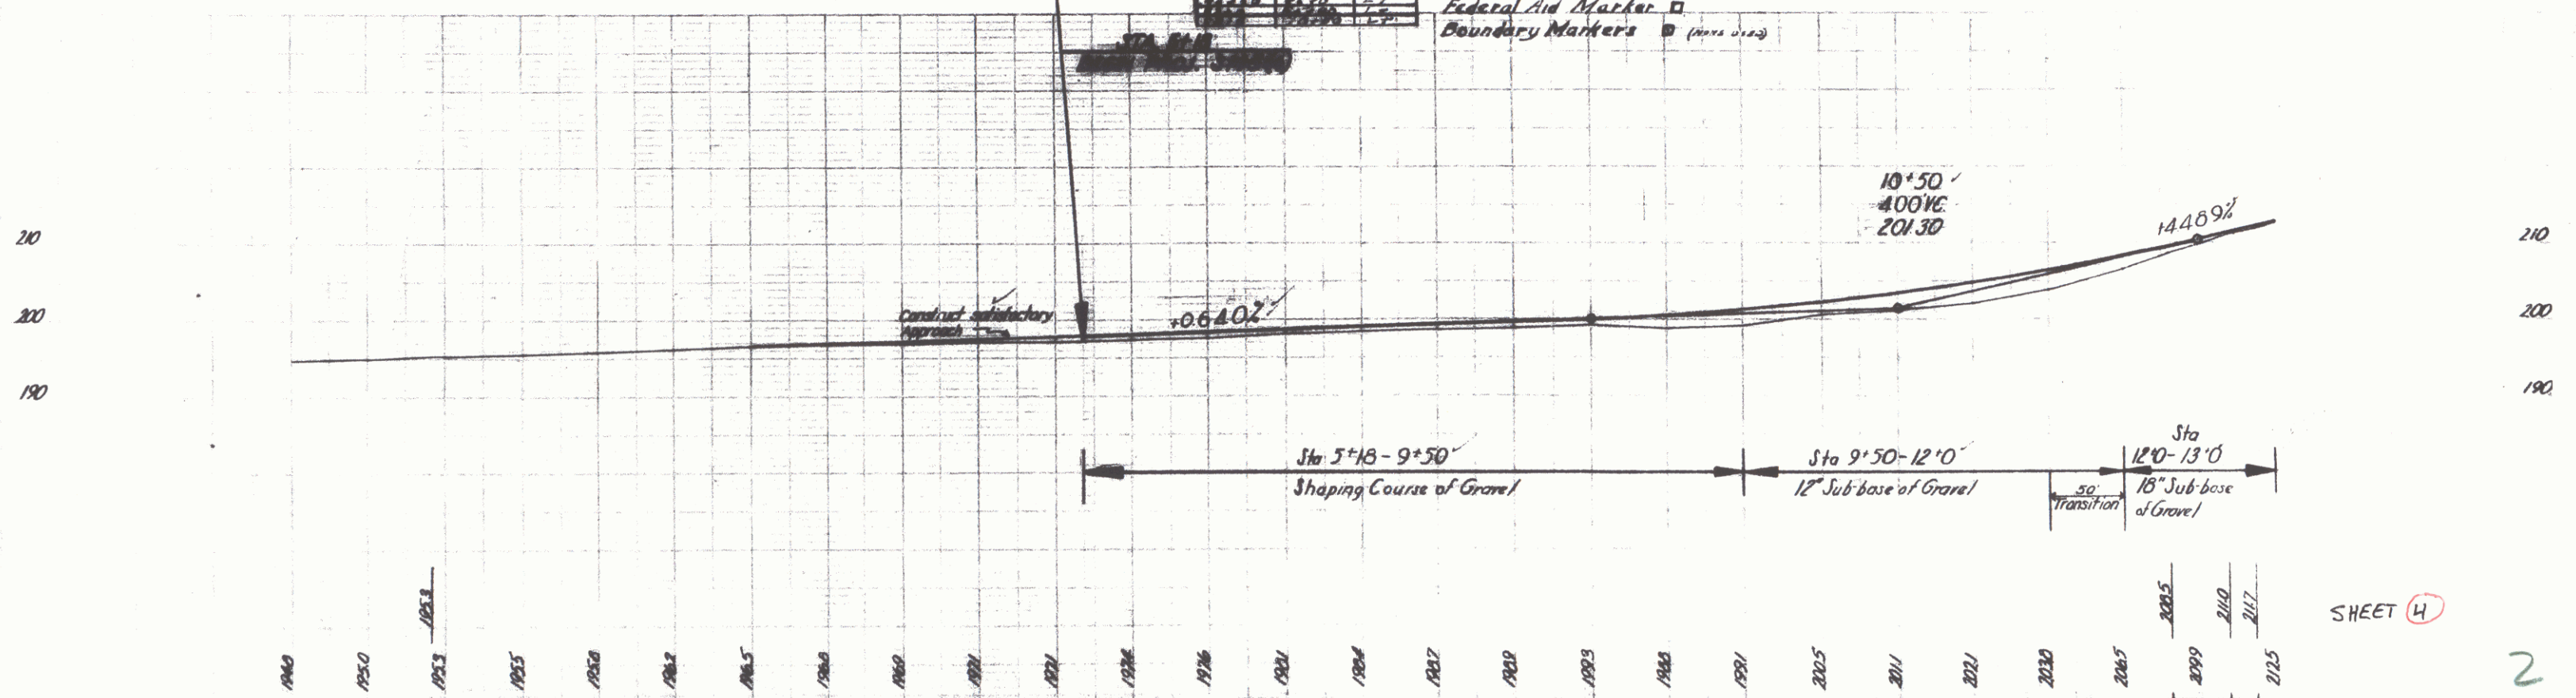


SHEET 4


TREES
O = Remove, then 103


Drives Constructed	
STA	POS
46+70	LT

FID ROAD 3
DIS NO 1400
PROJ NO 1547
YEAR 7
SHEET 33

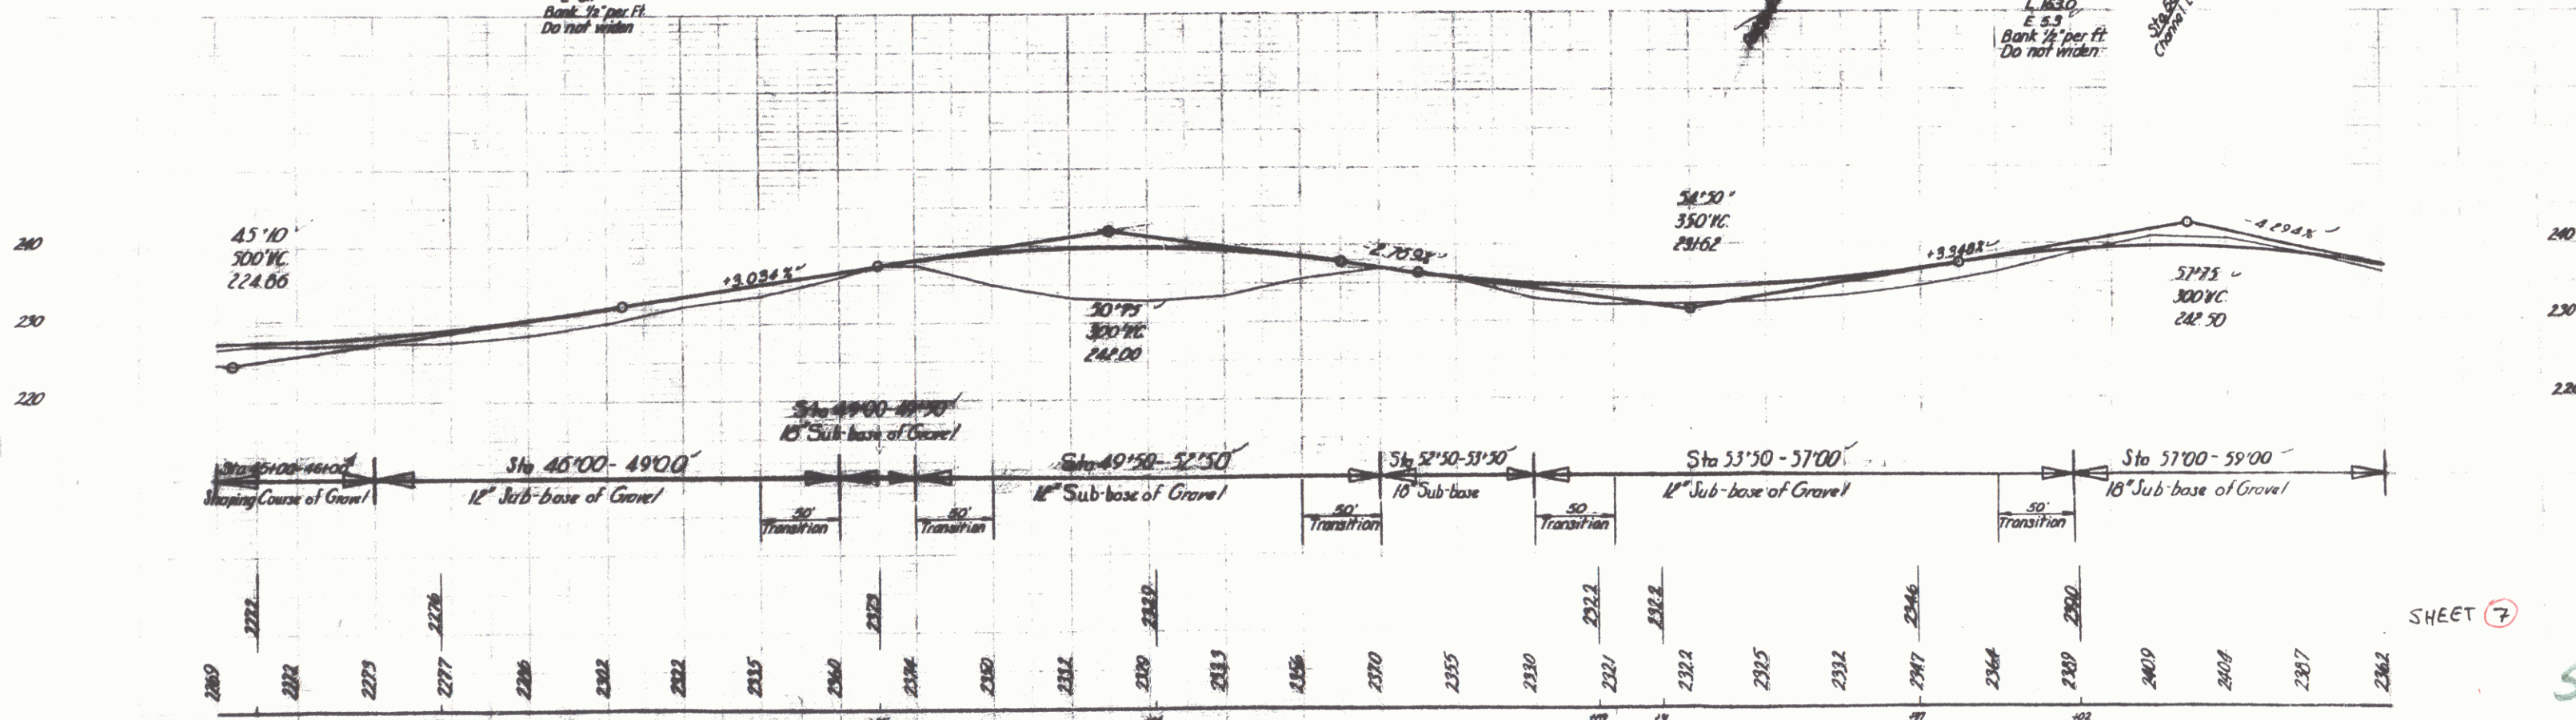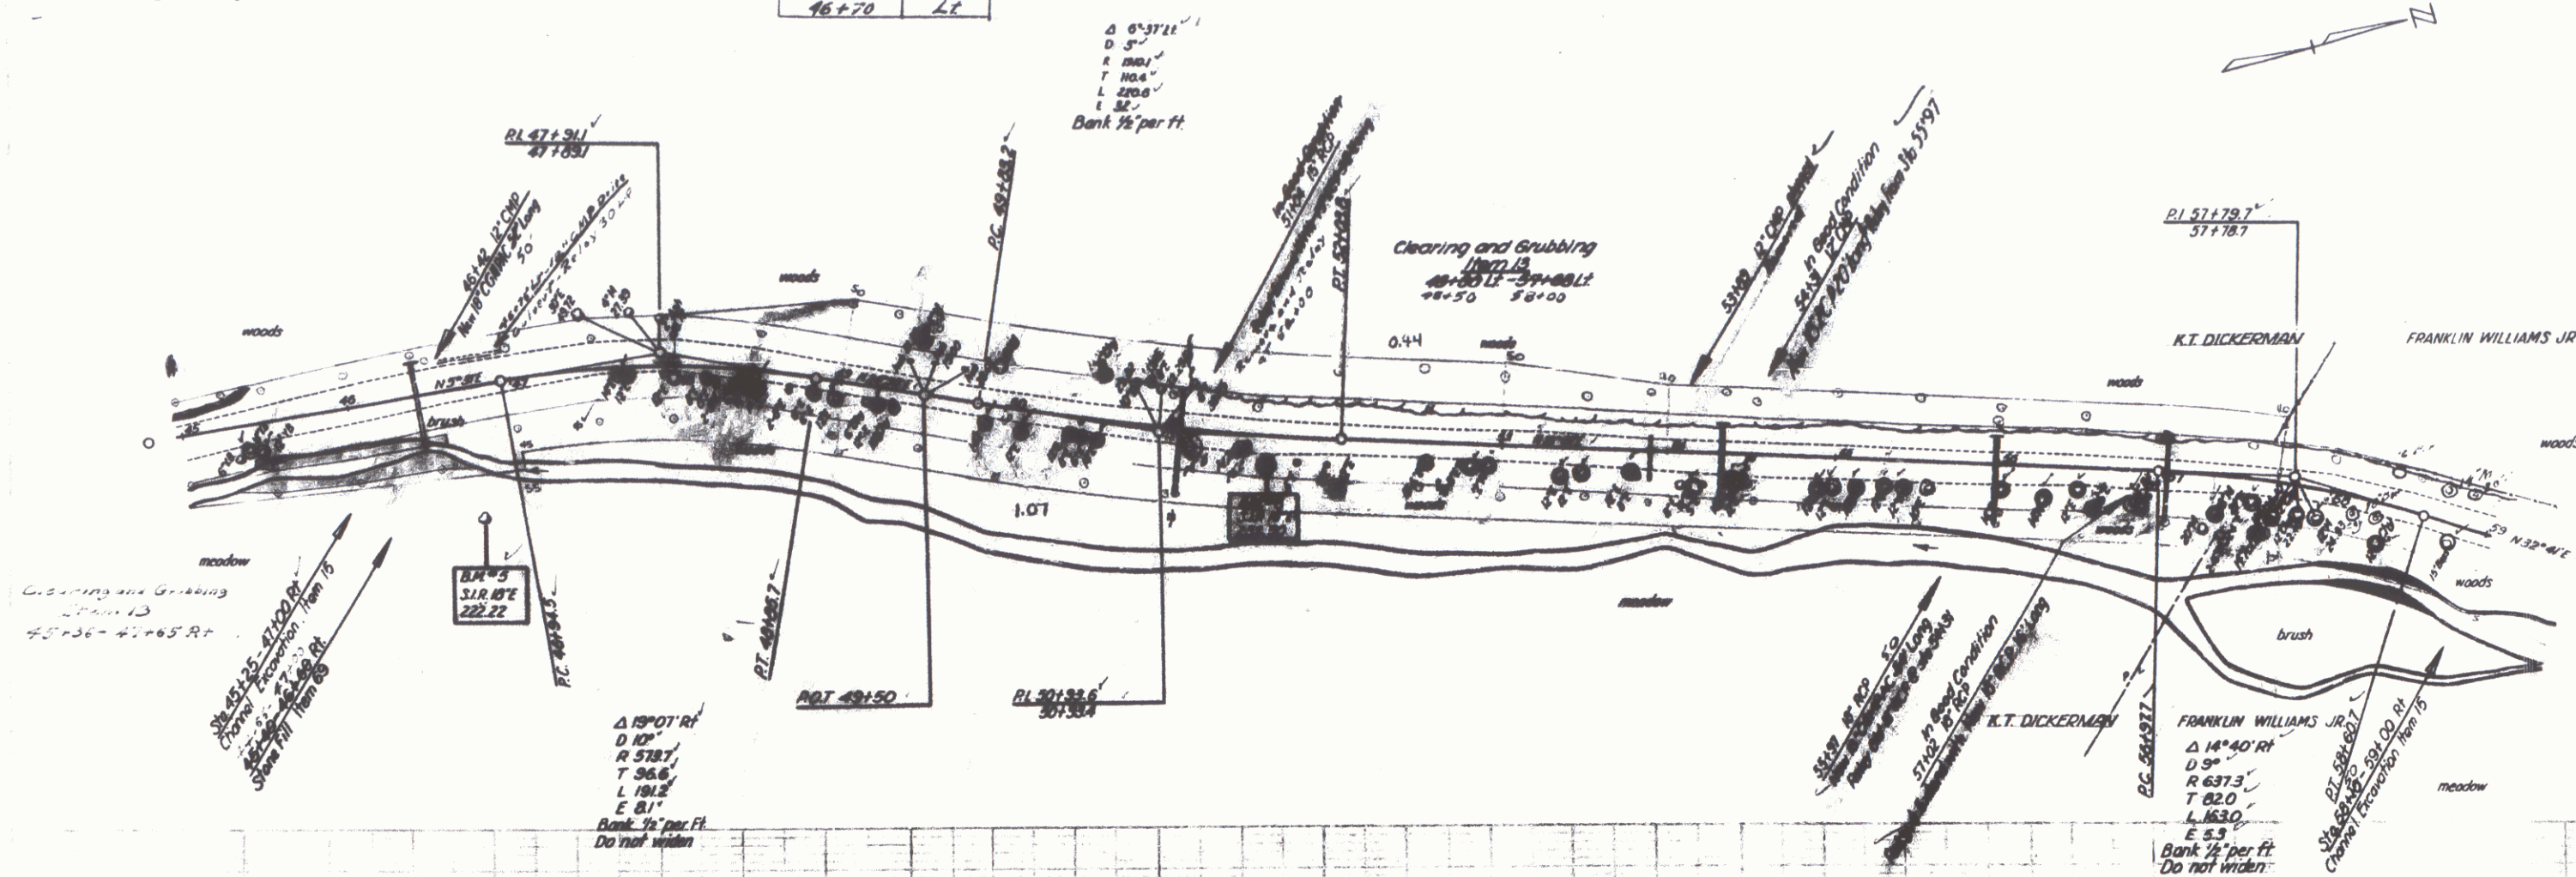

SHEET 7

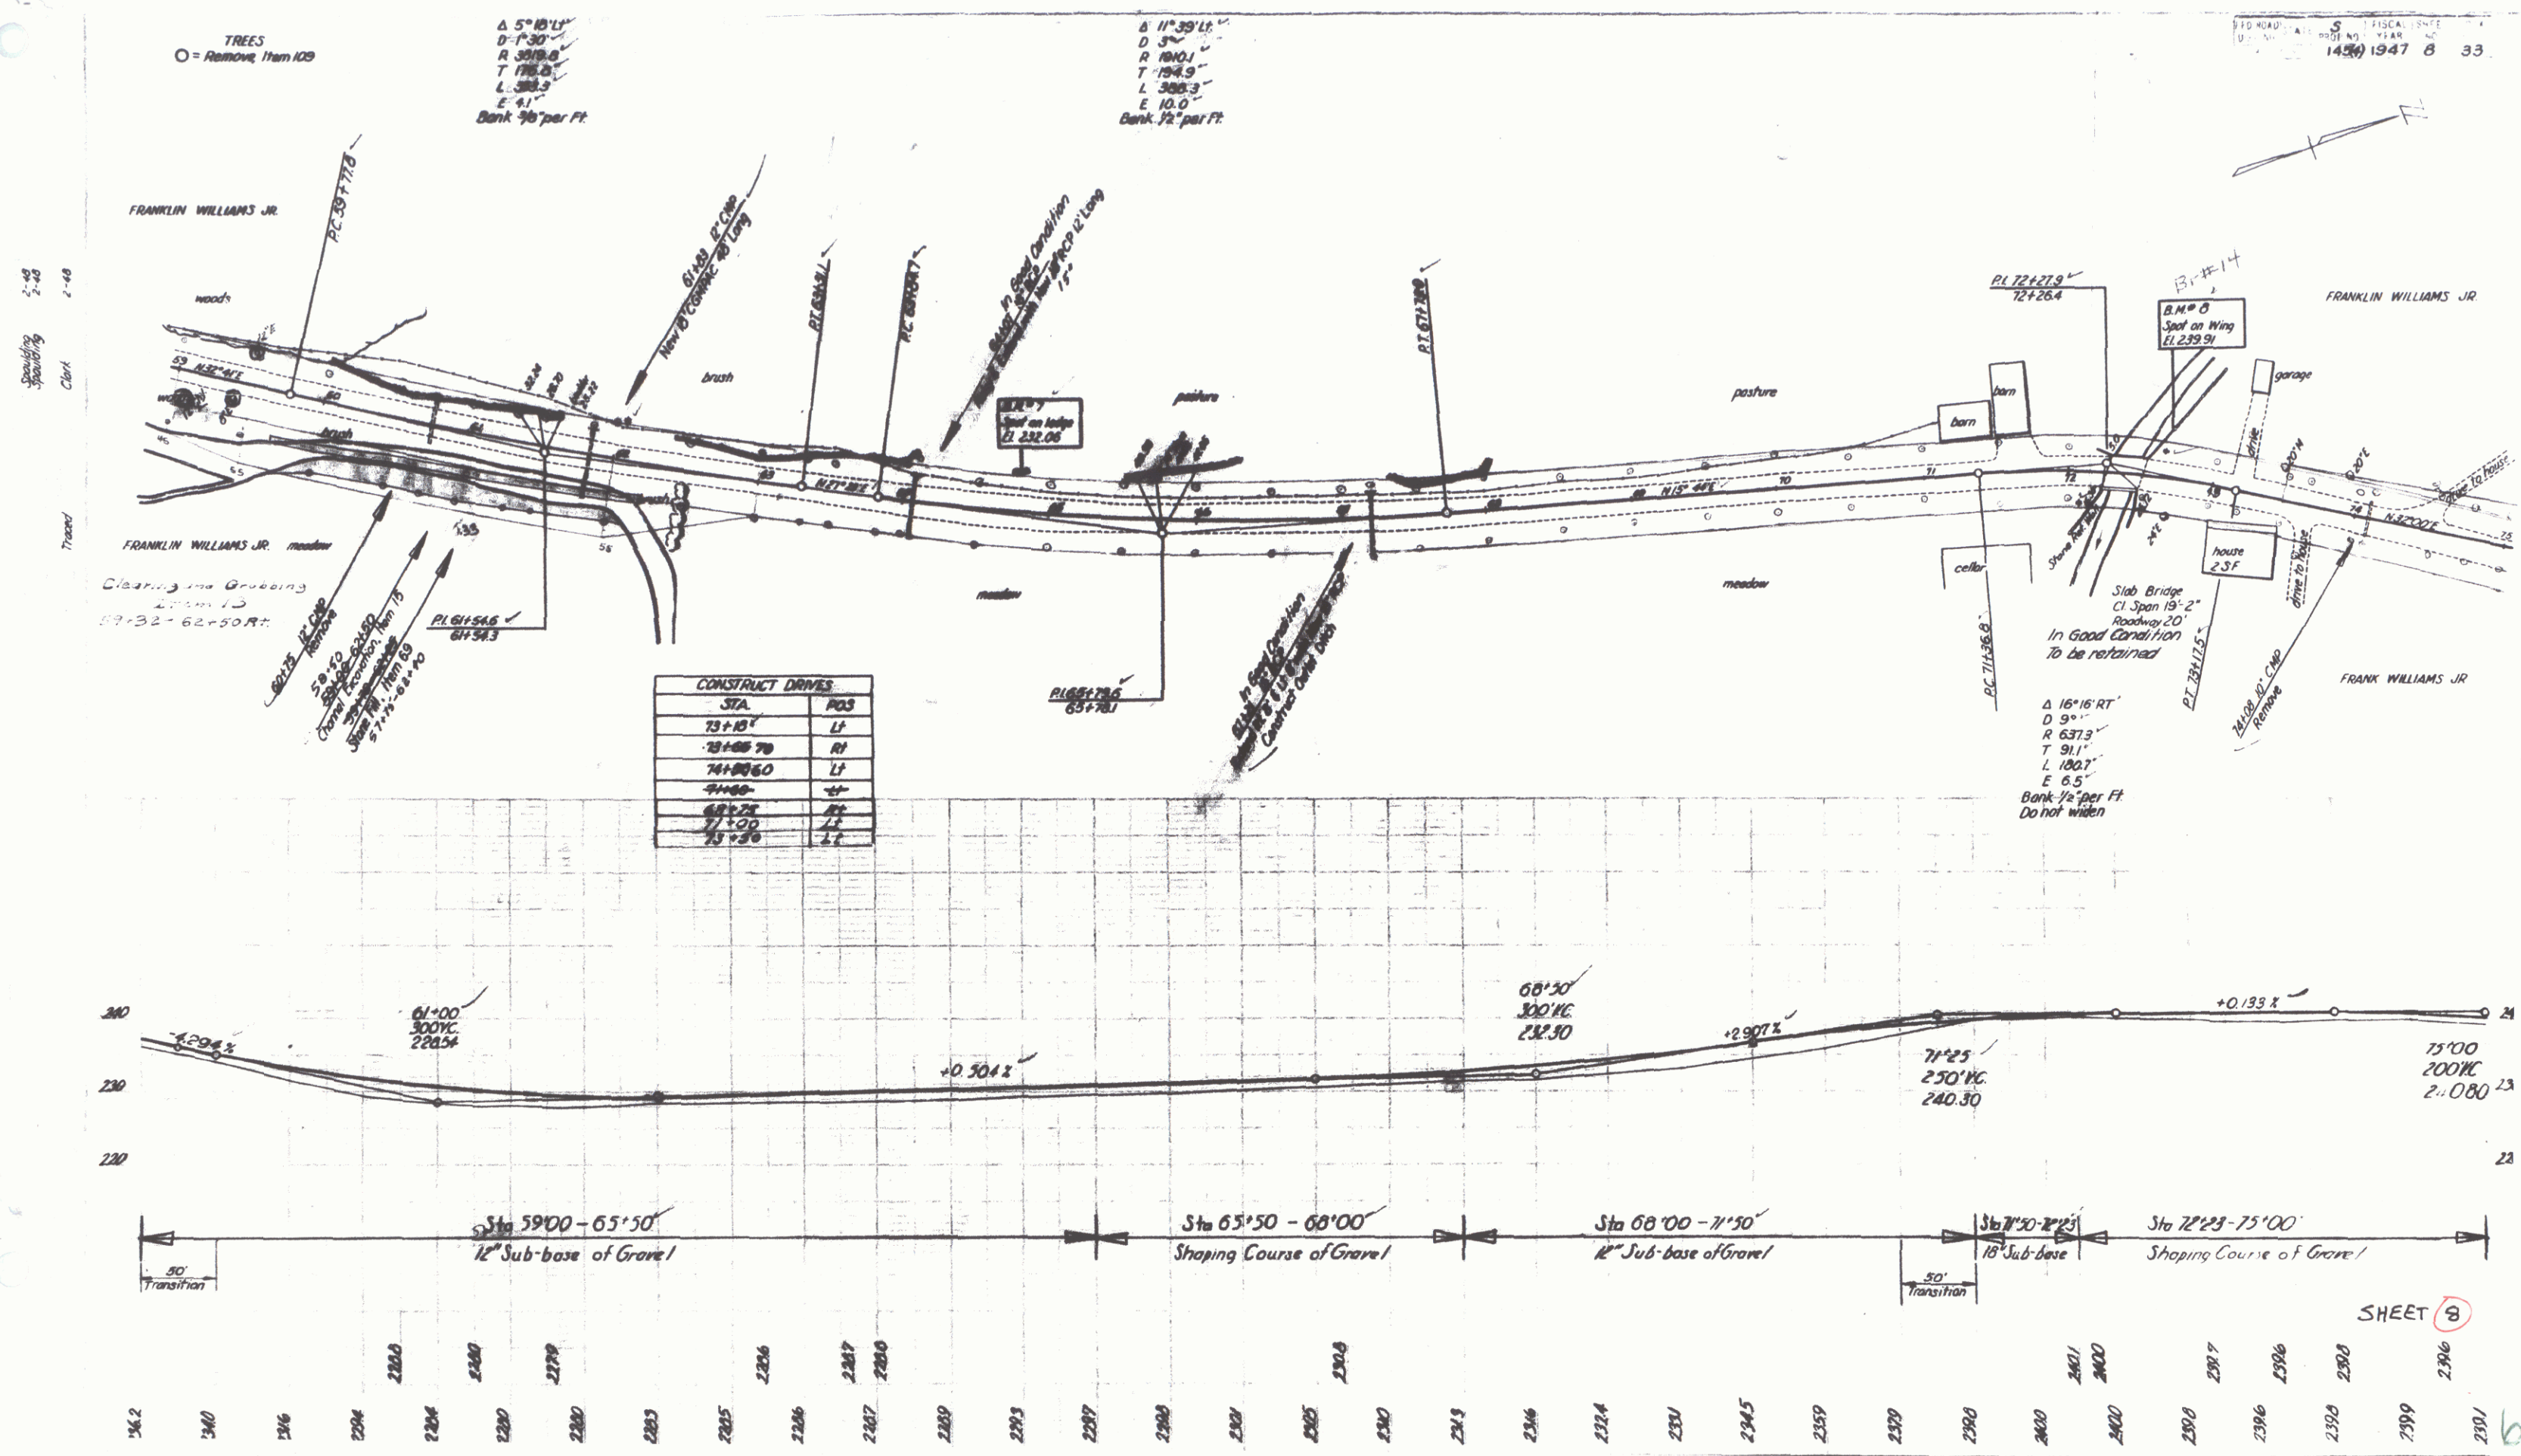

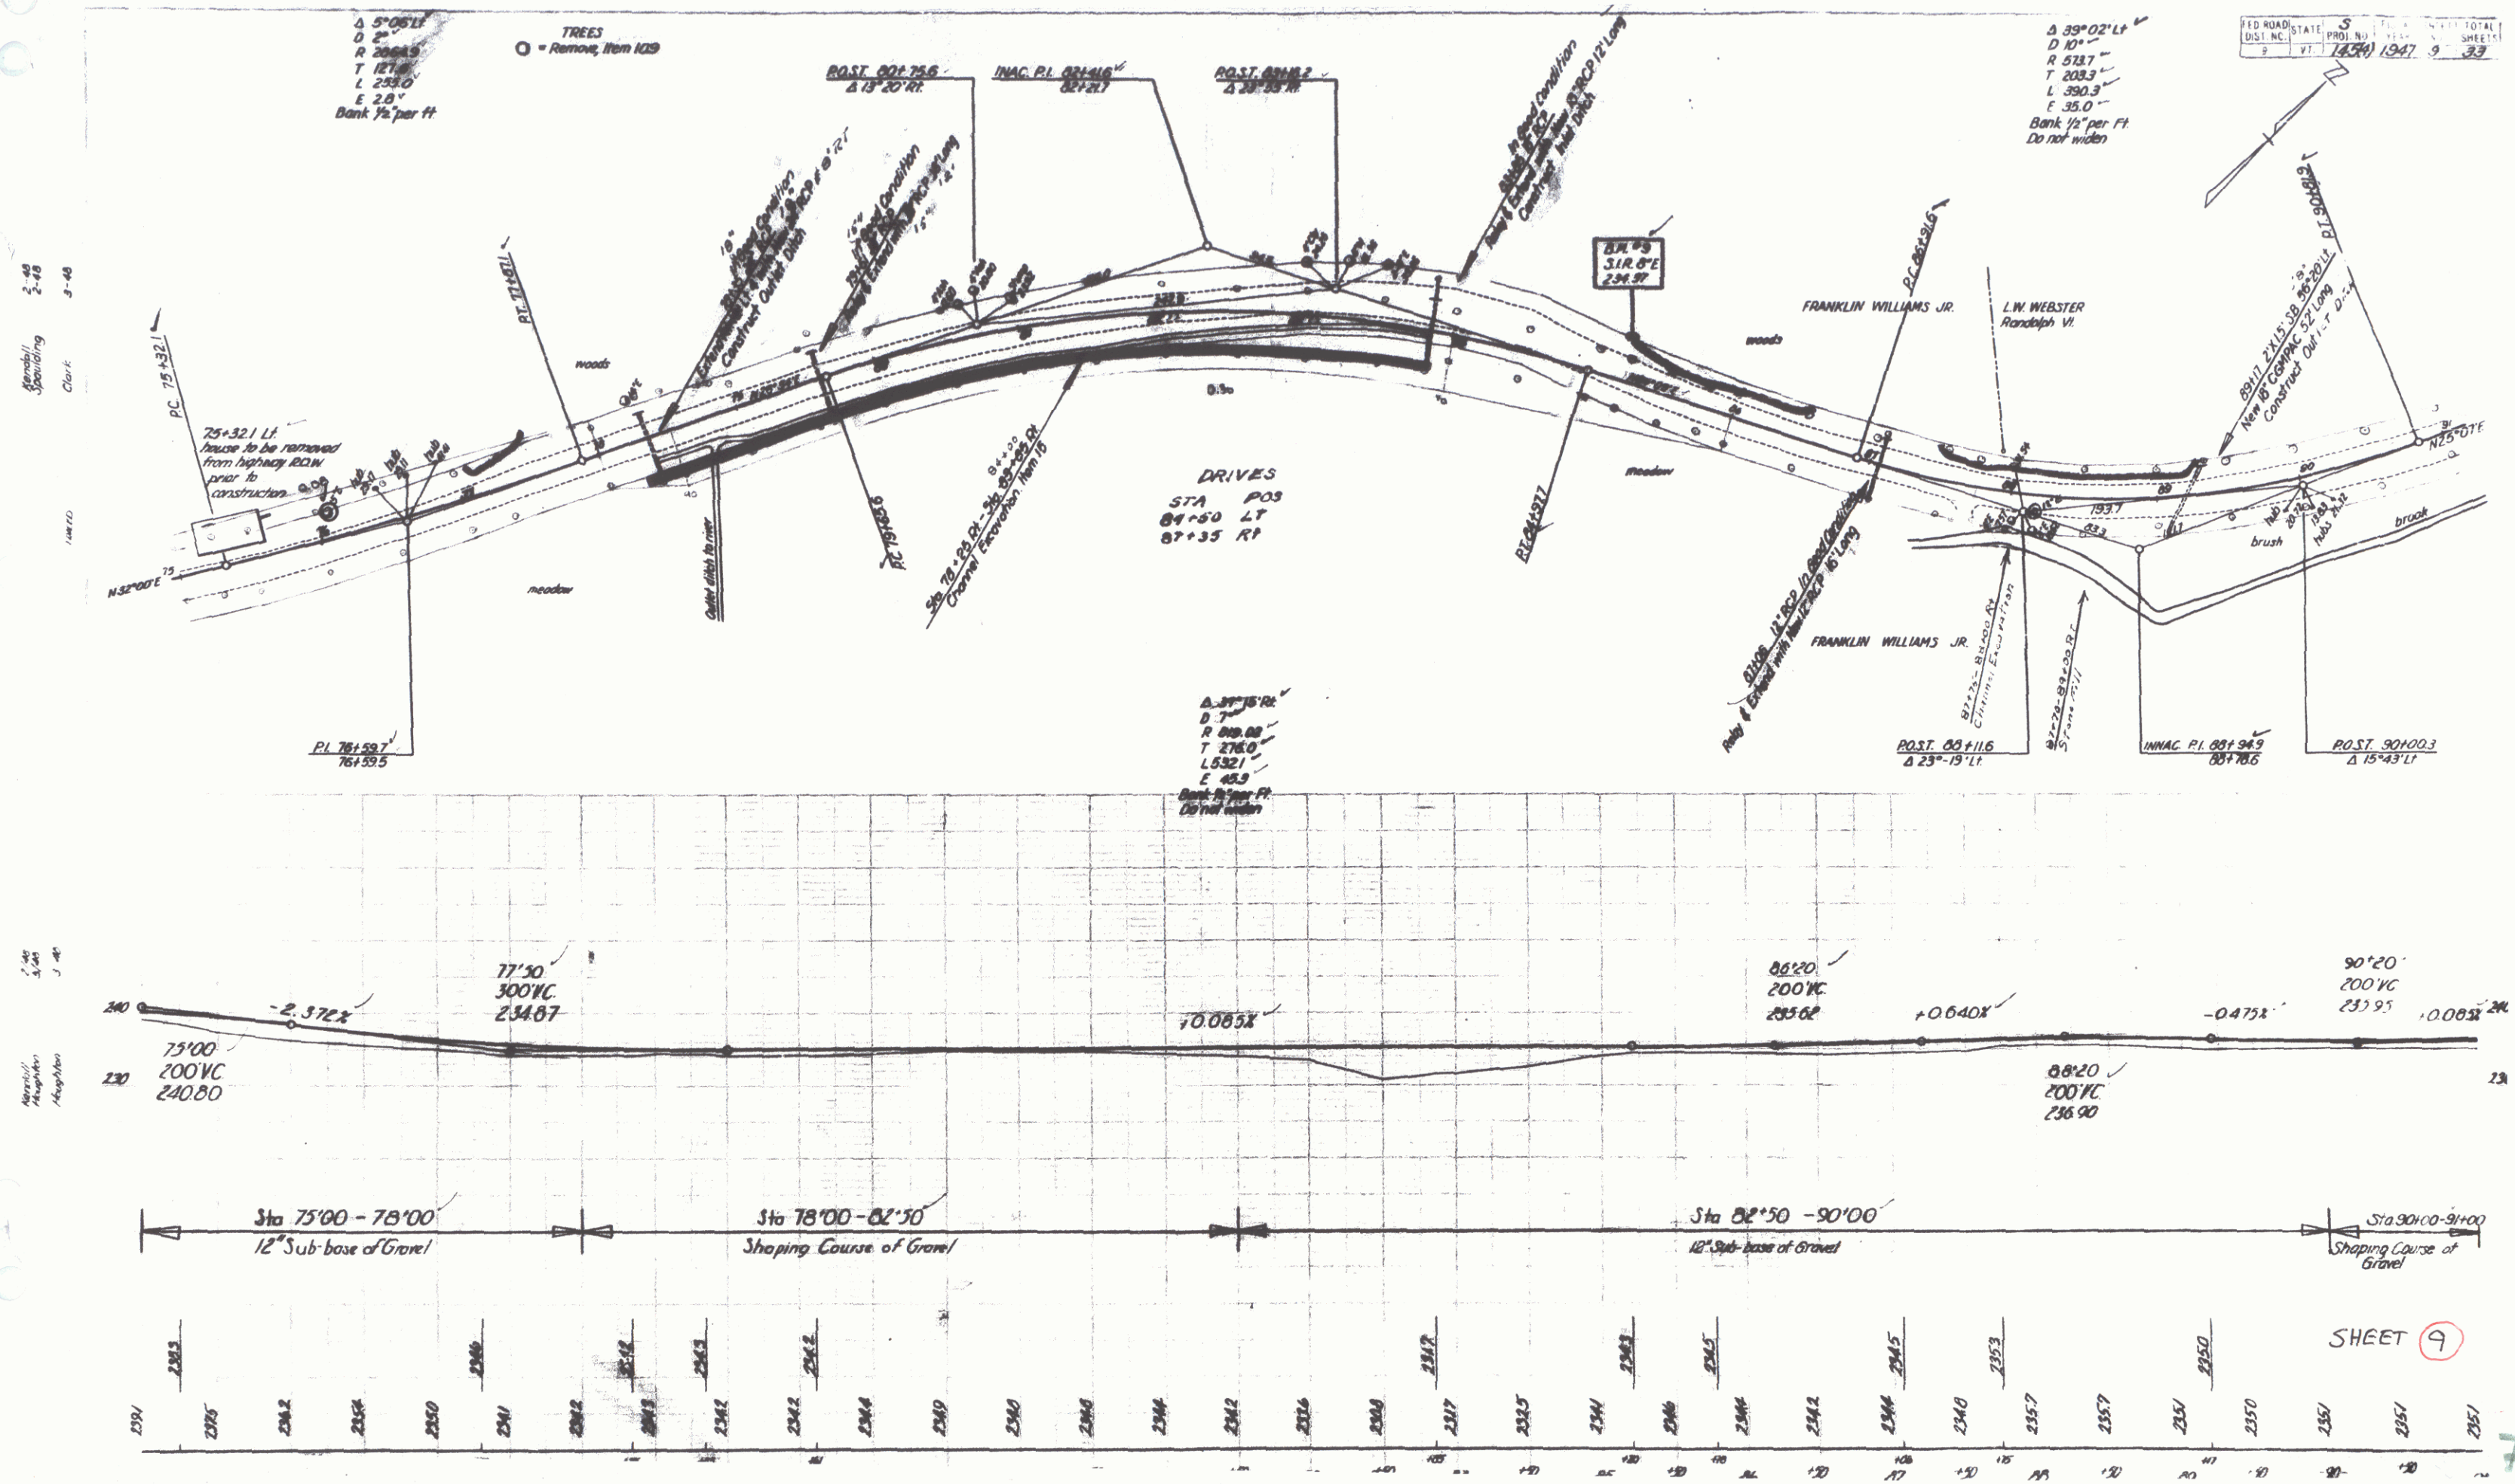

TREES
○ = Remove, Item 109

Δ 10°48'12"
D 7°
R 888.02
T 132.8
L 289.0
E 8.8

EST. ROAD	STATE	PROJ. NO.	YEAR	SHEET NO.	TOTAL SHEETS
VI.	VT.	1234	1947	10	33

2.40
2.40
J.40

Amount
Sawdust
Chest

1.000

2.40
2.40
J.40

Amount
Regravel
Height

250


240

230

250

240

230

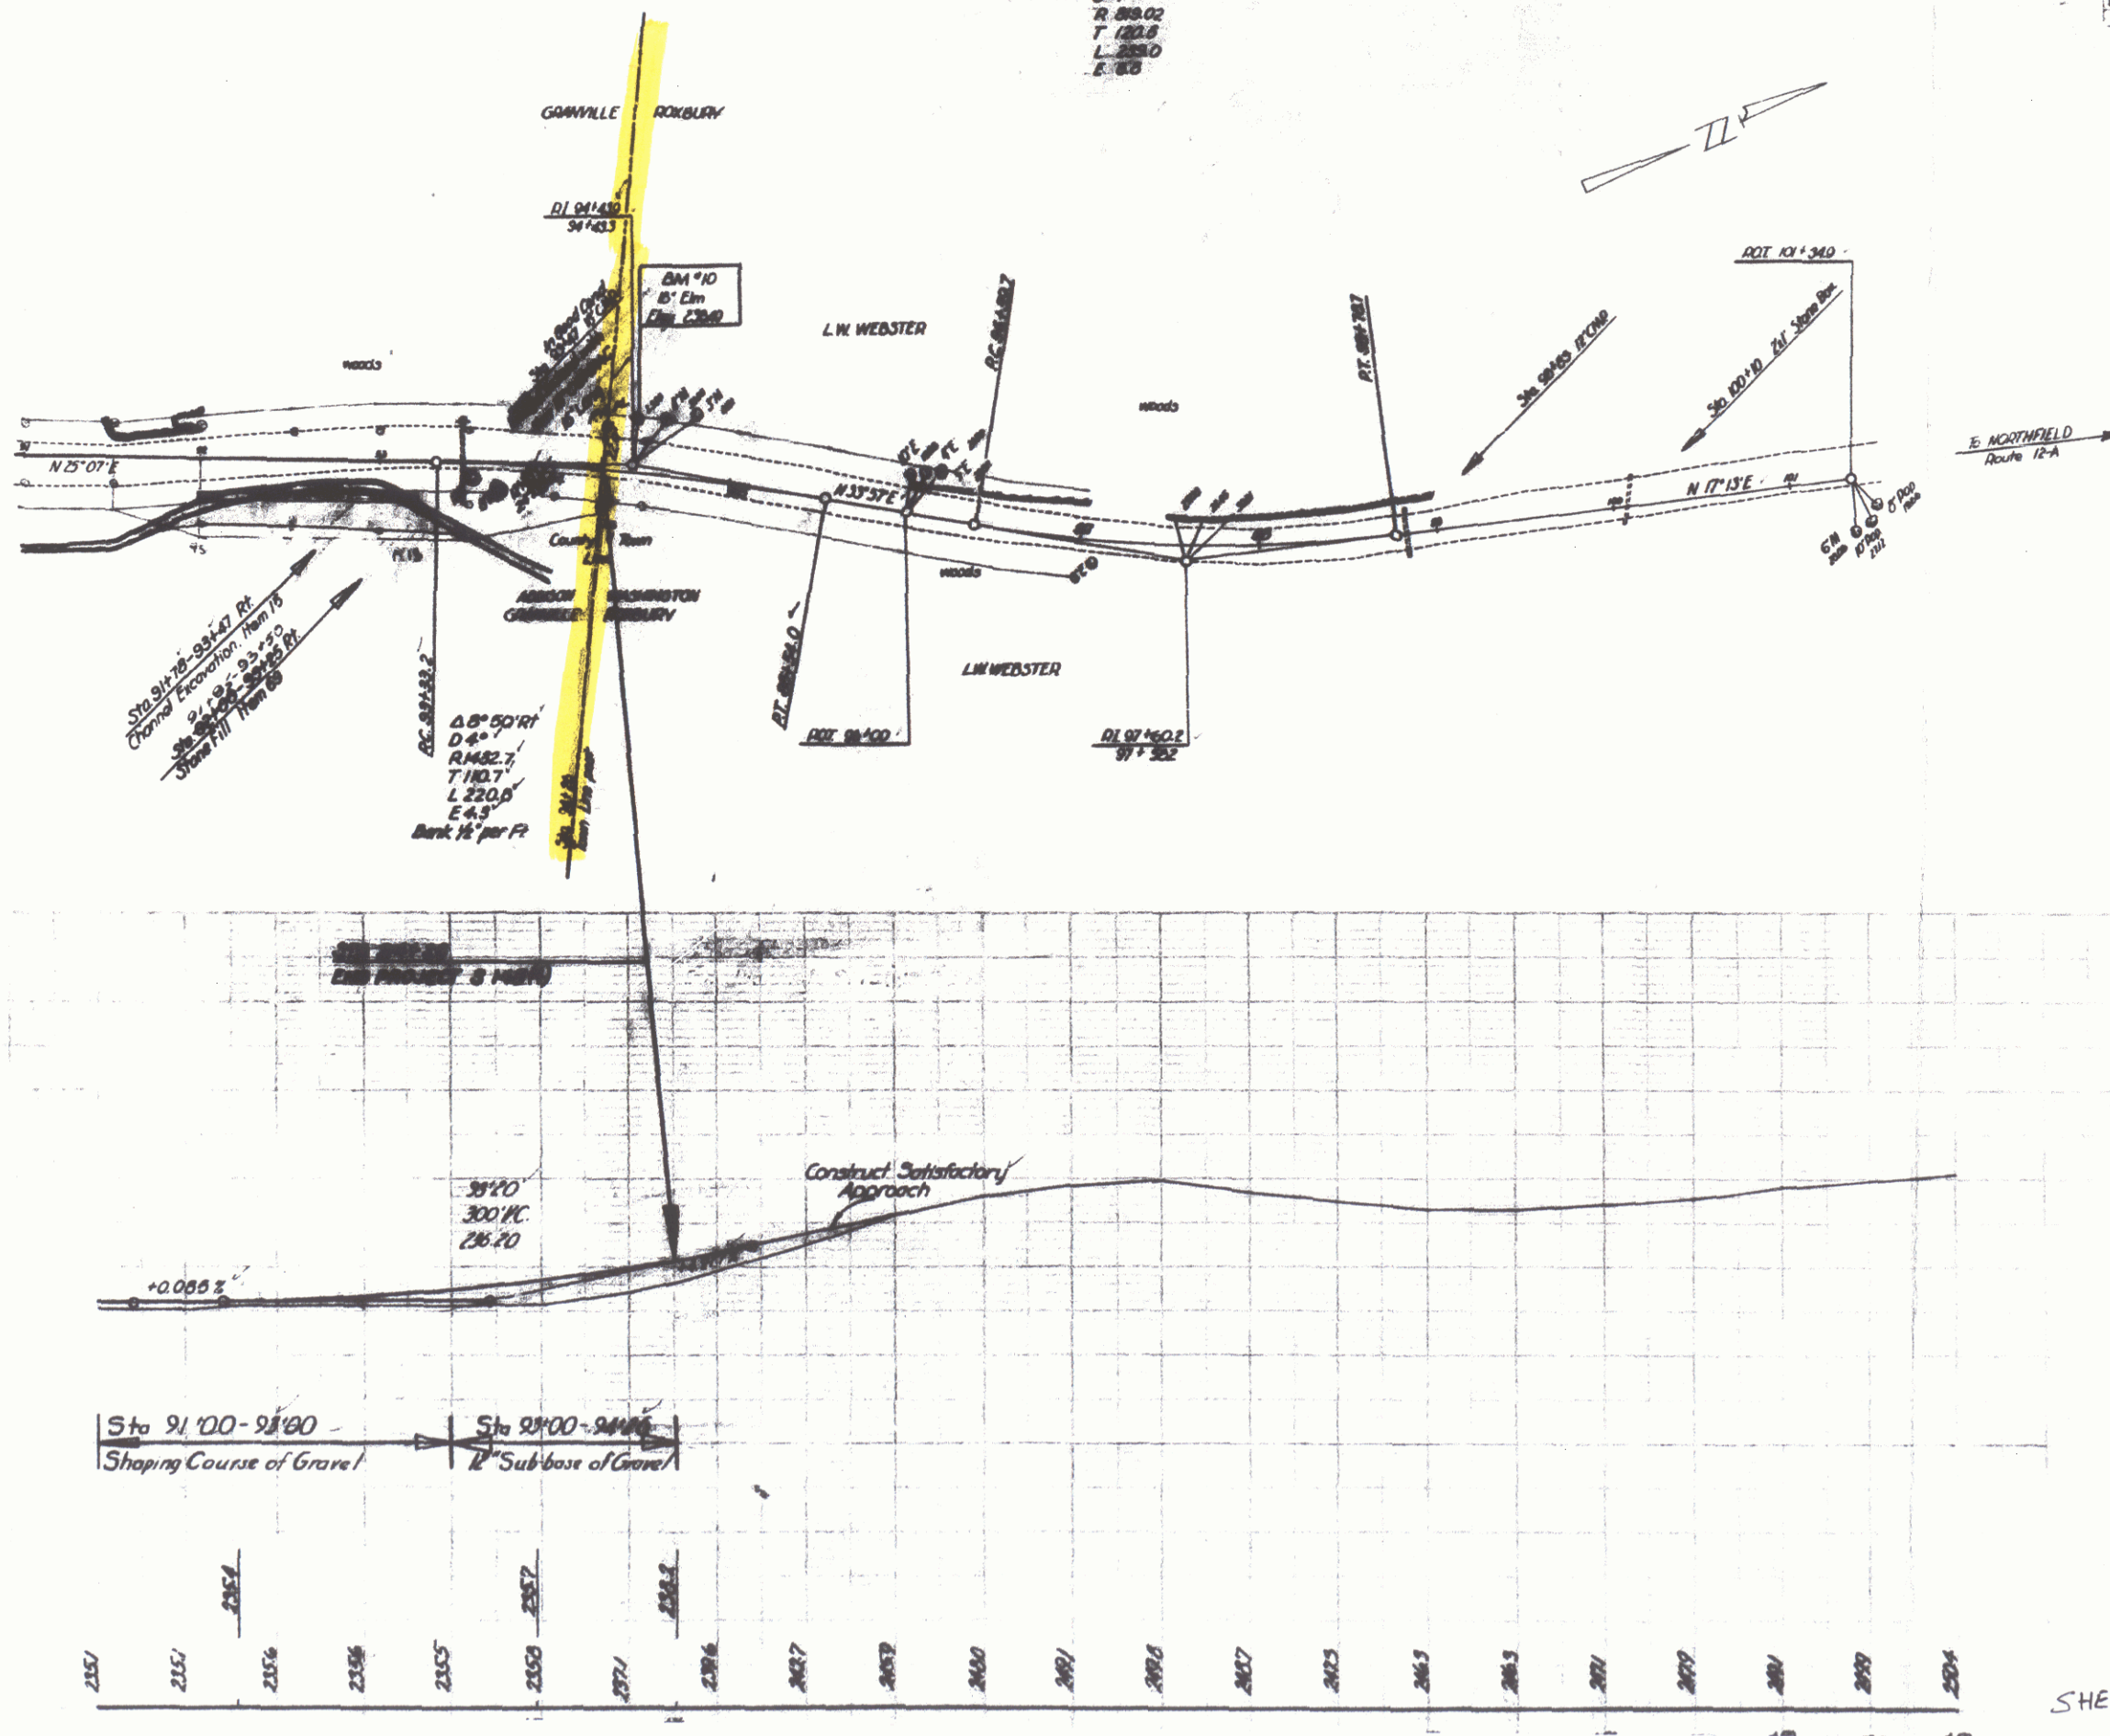

SHEET 10

8