


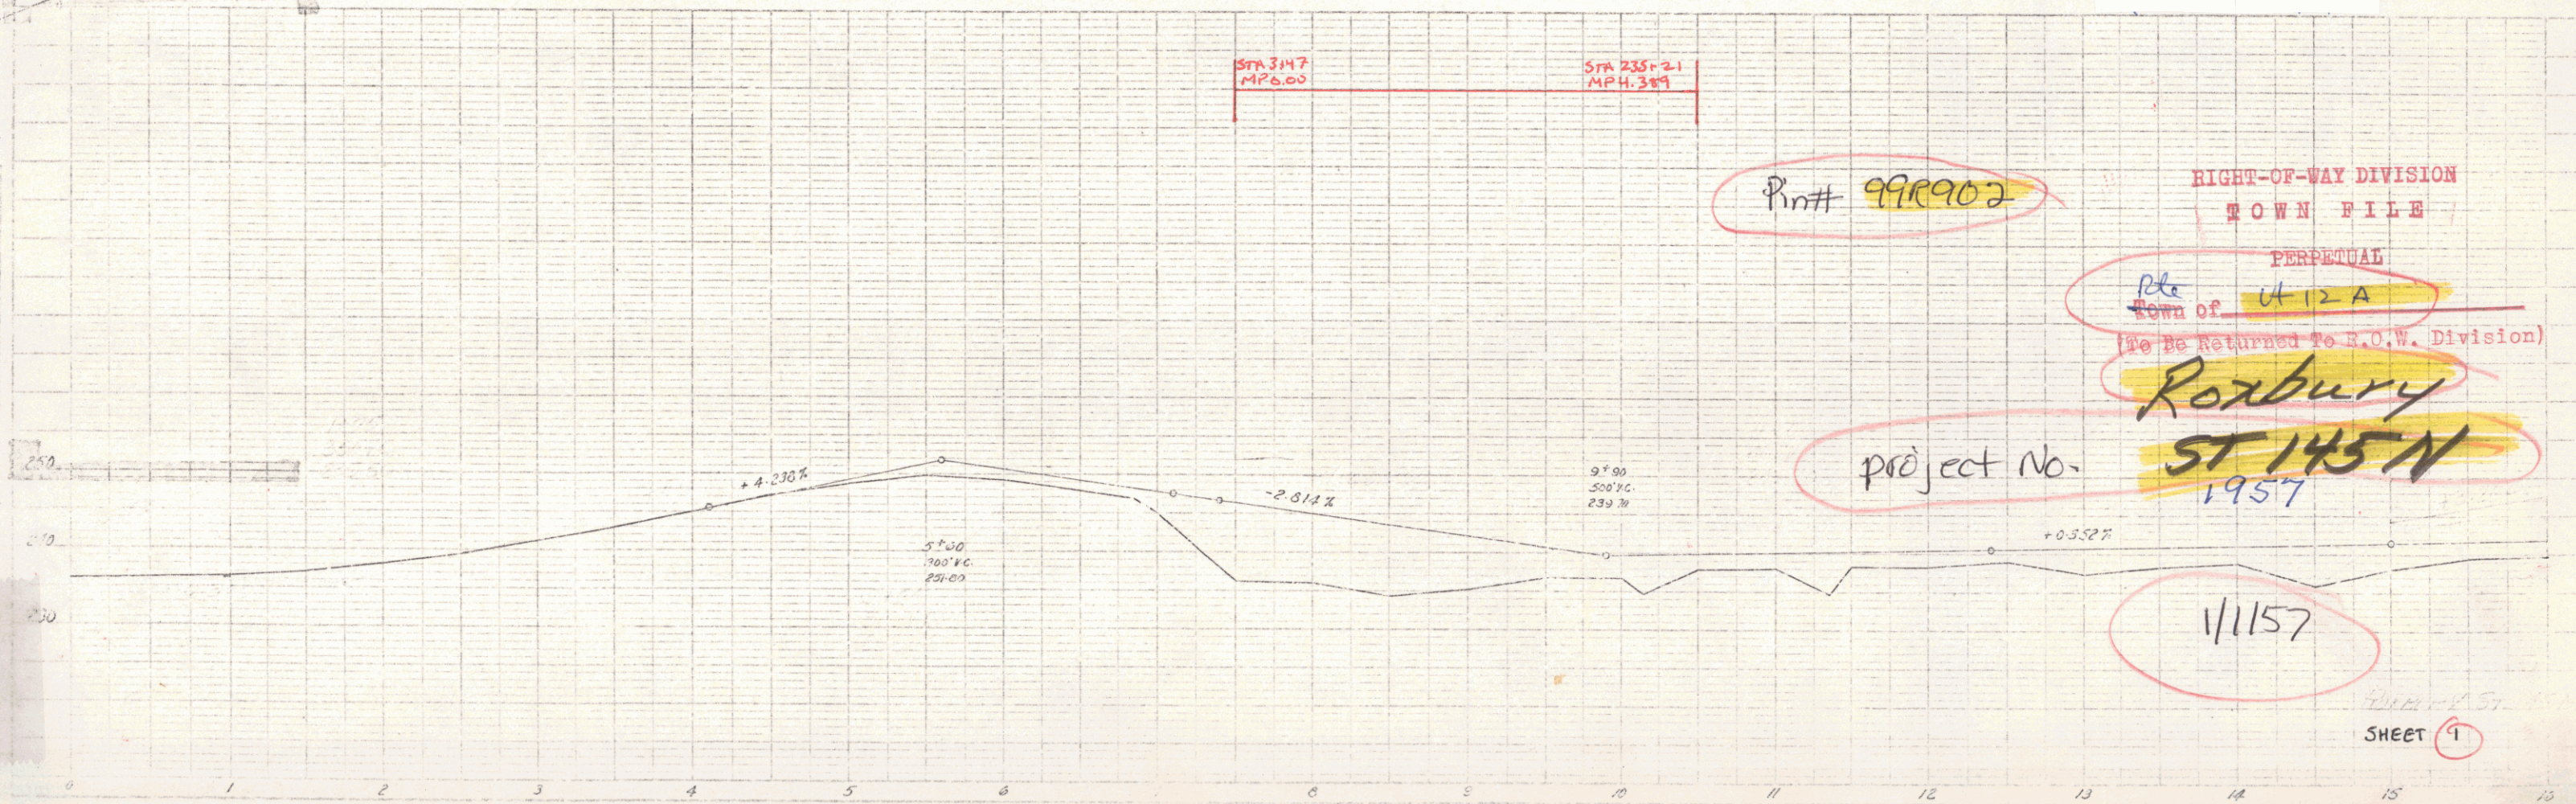






POOR ORIGINAL COPY

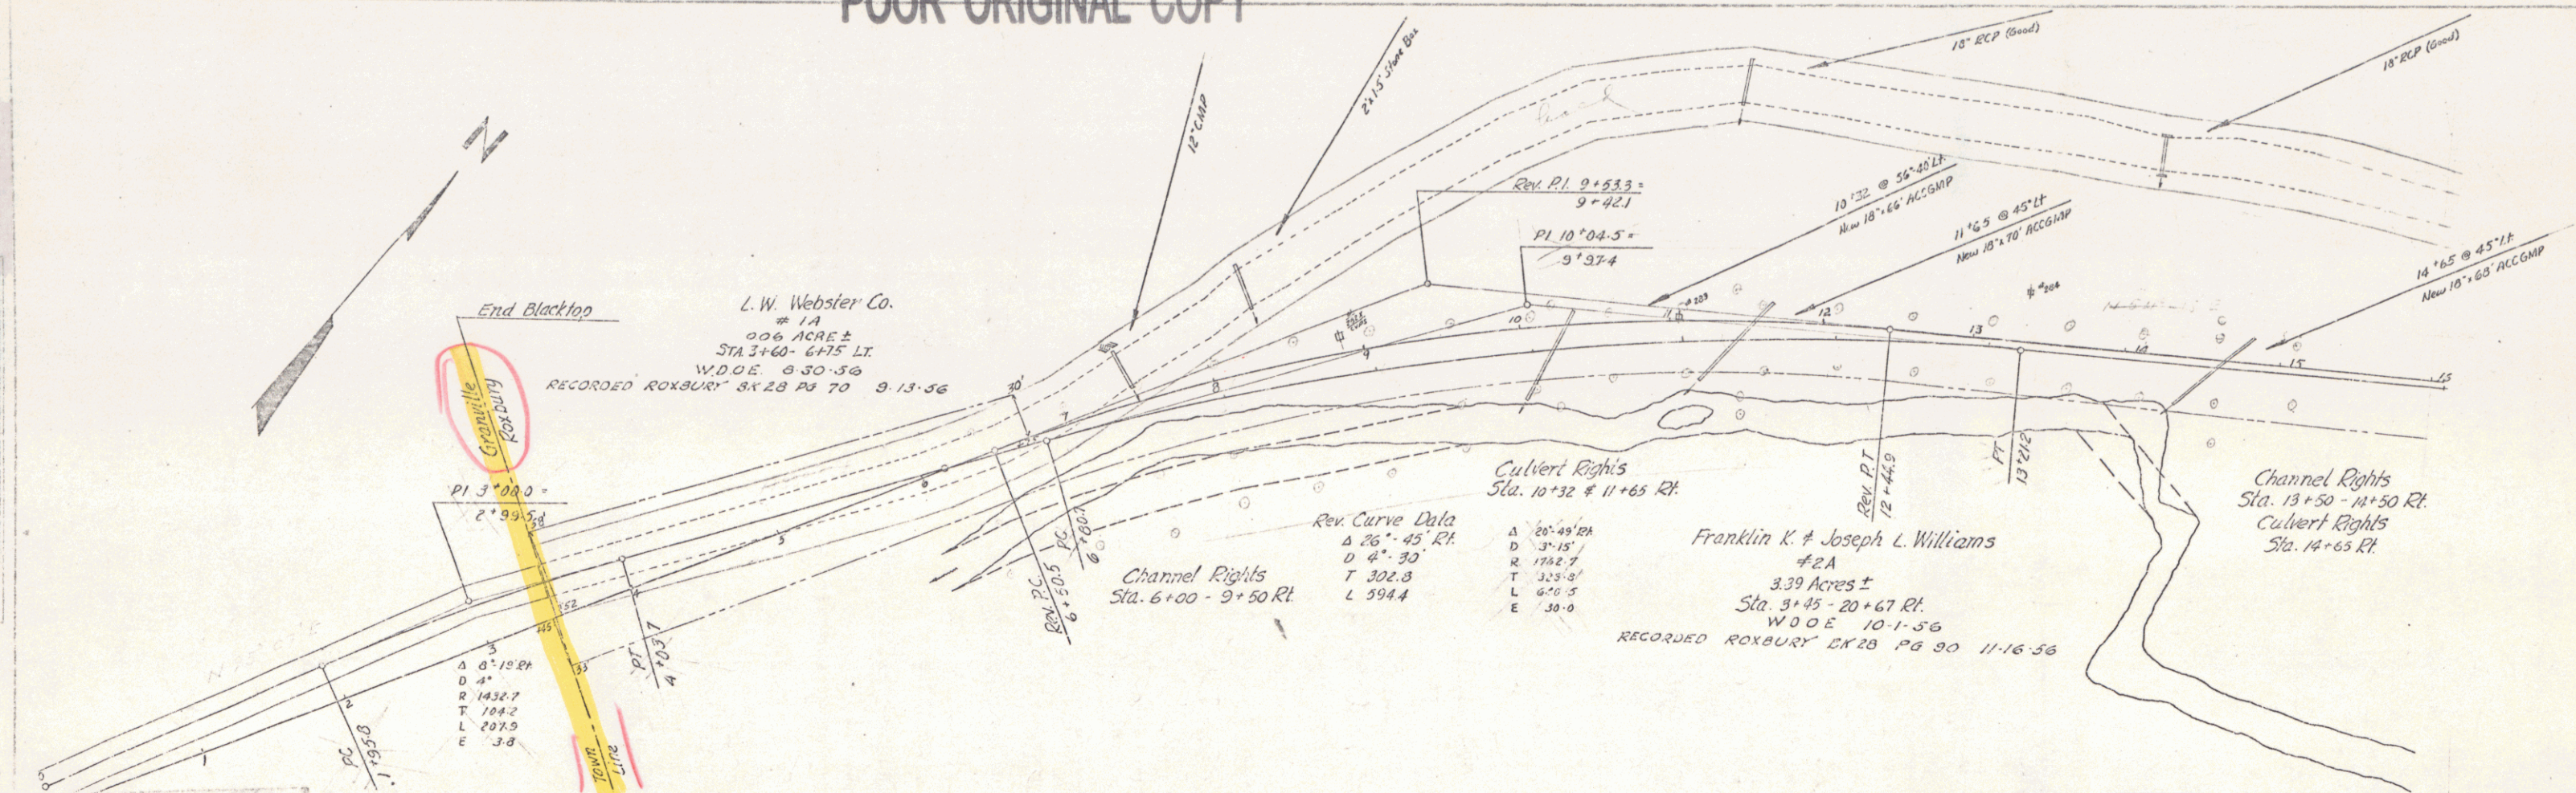

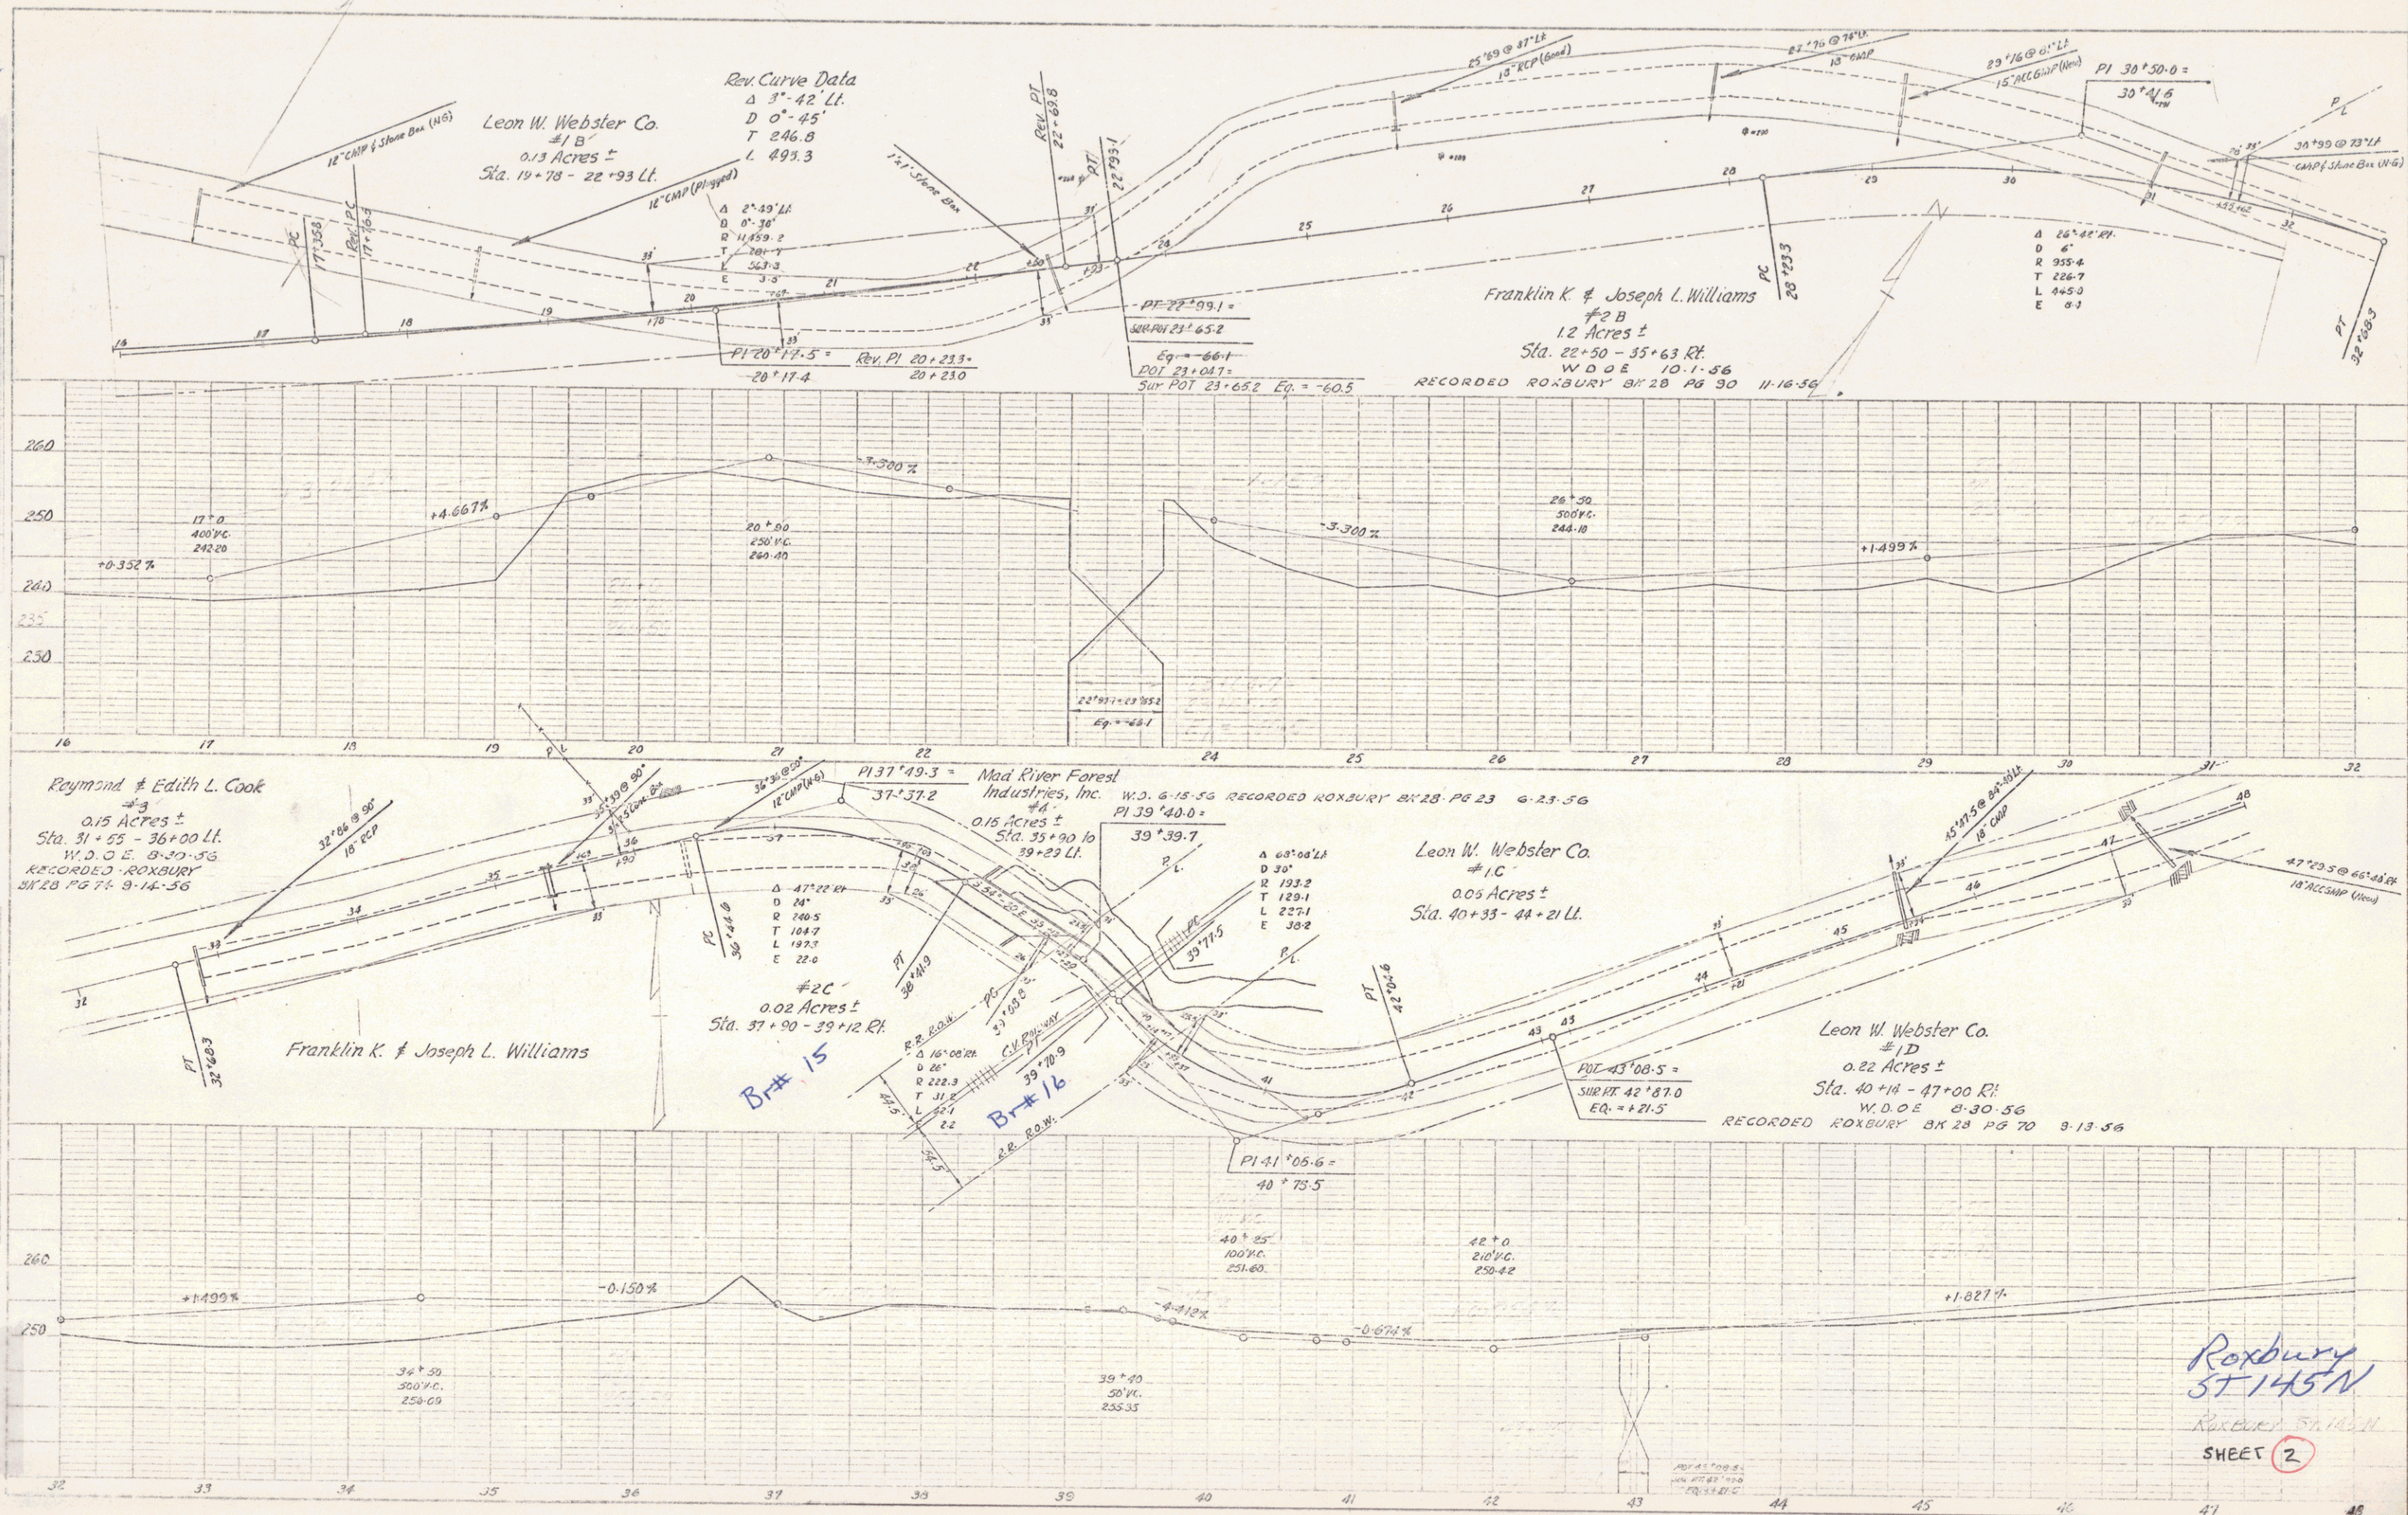


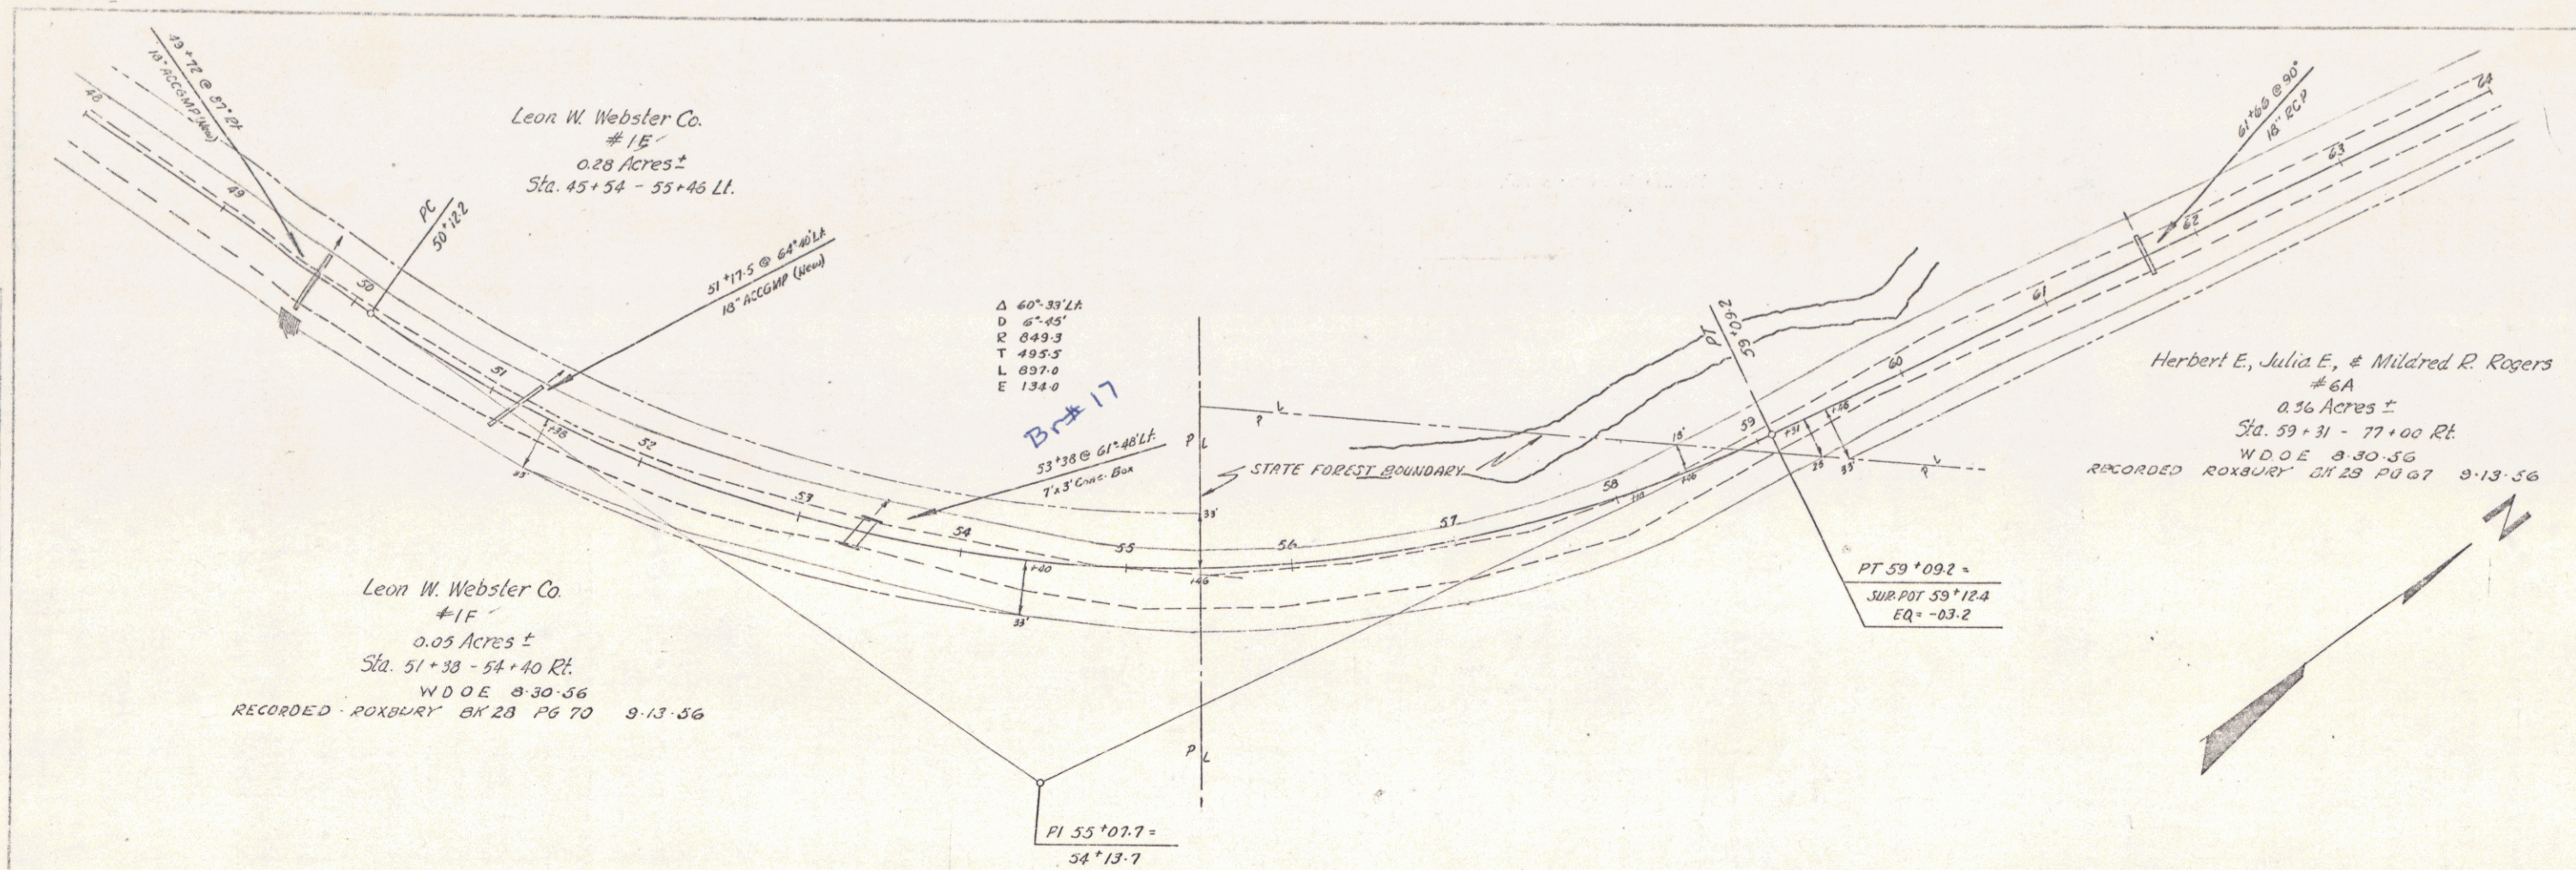


Roxbury
5T145N
SHEET 3

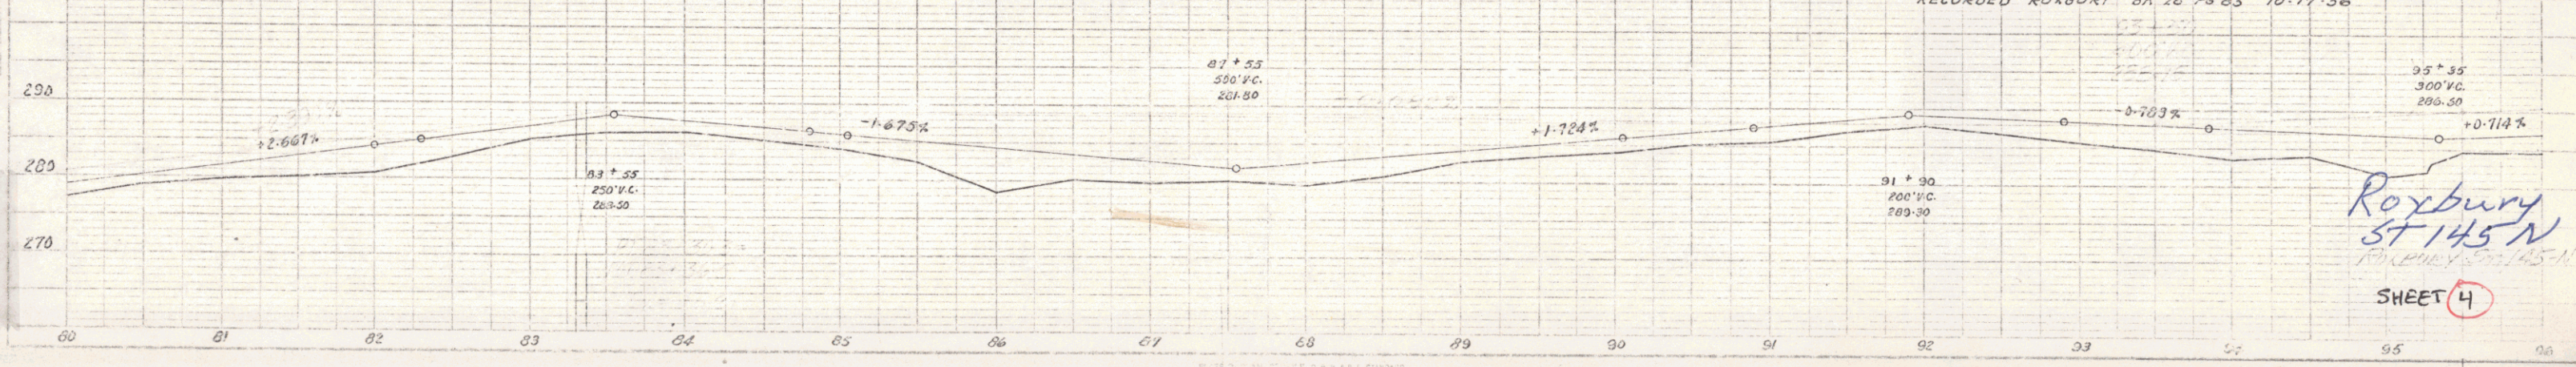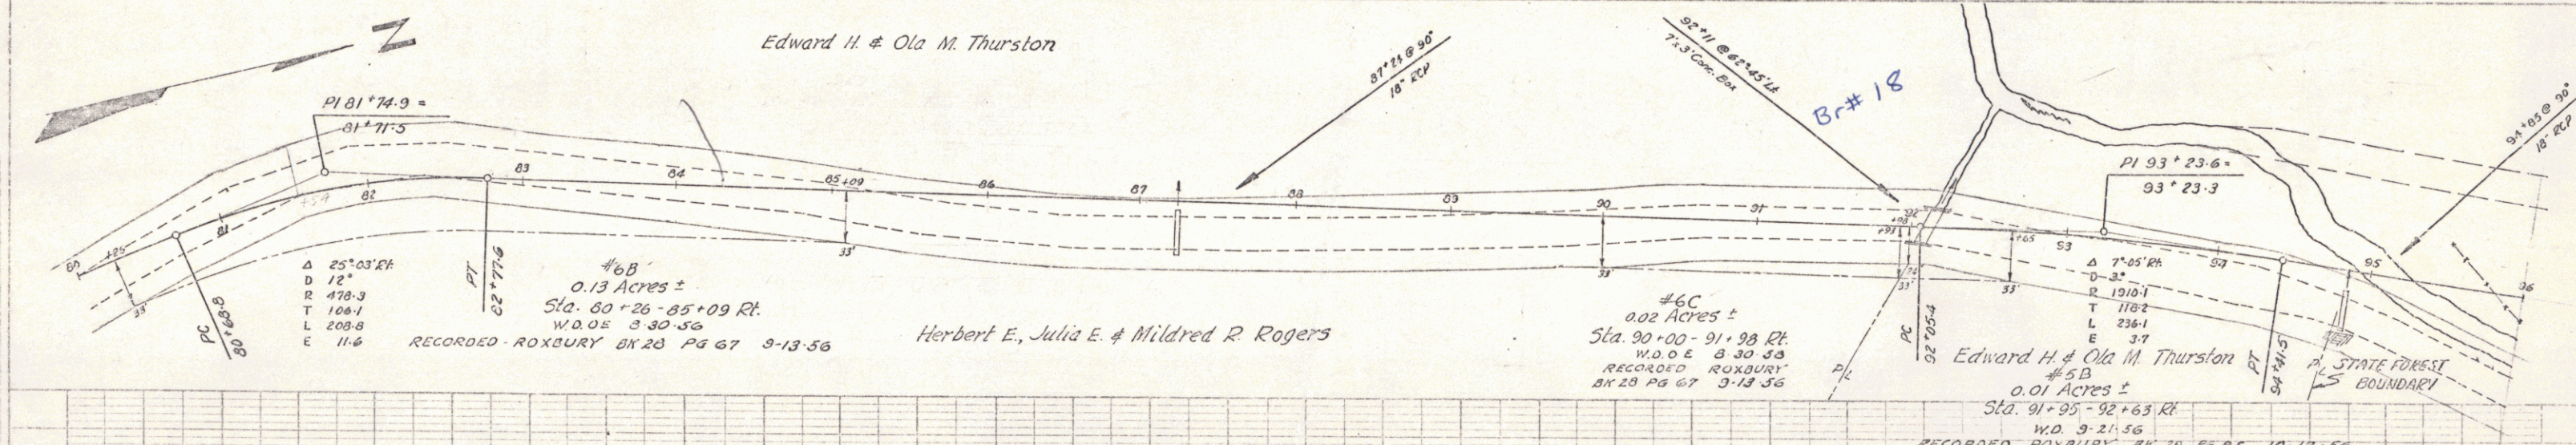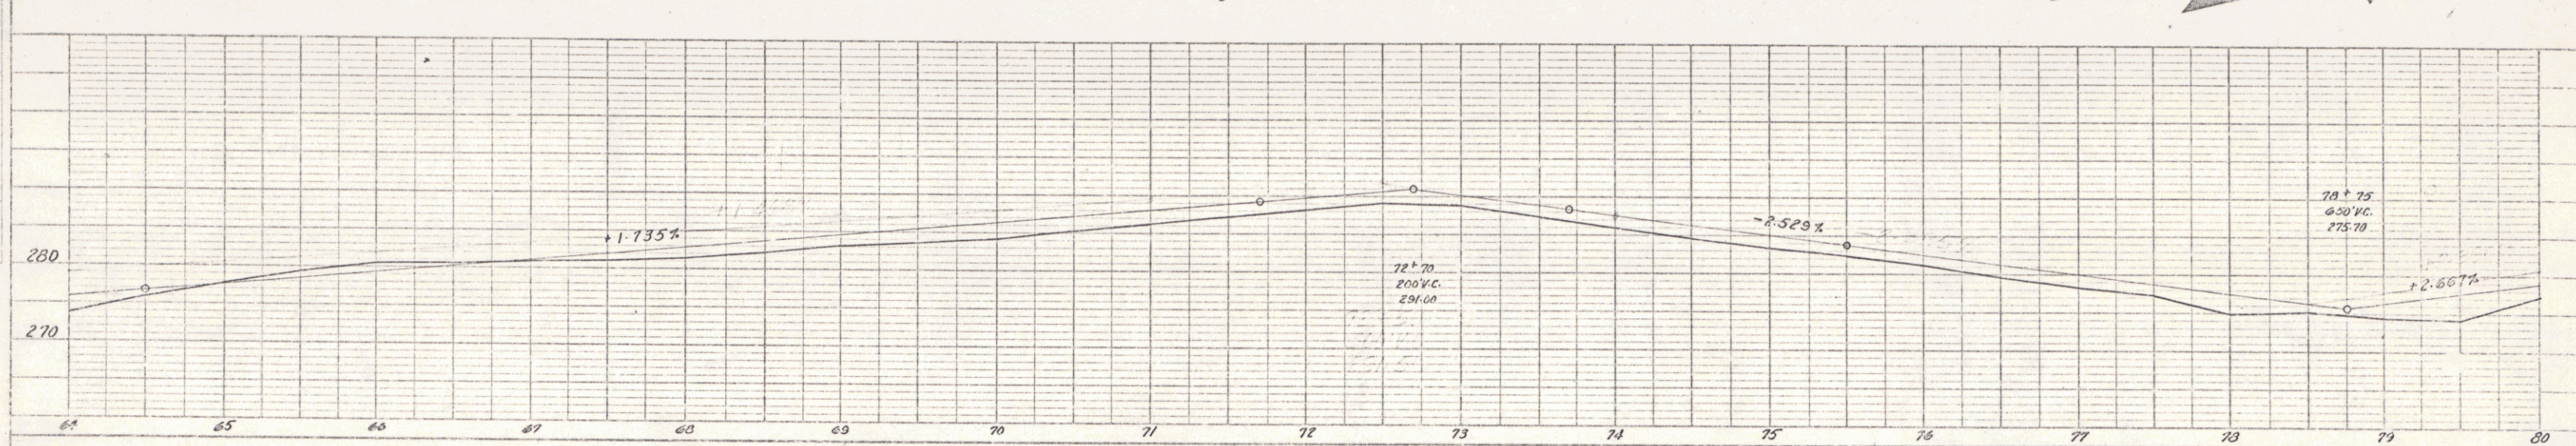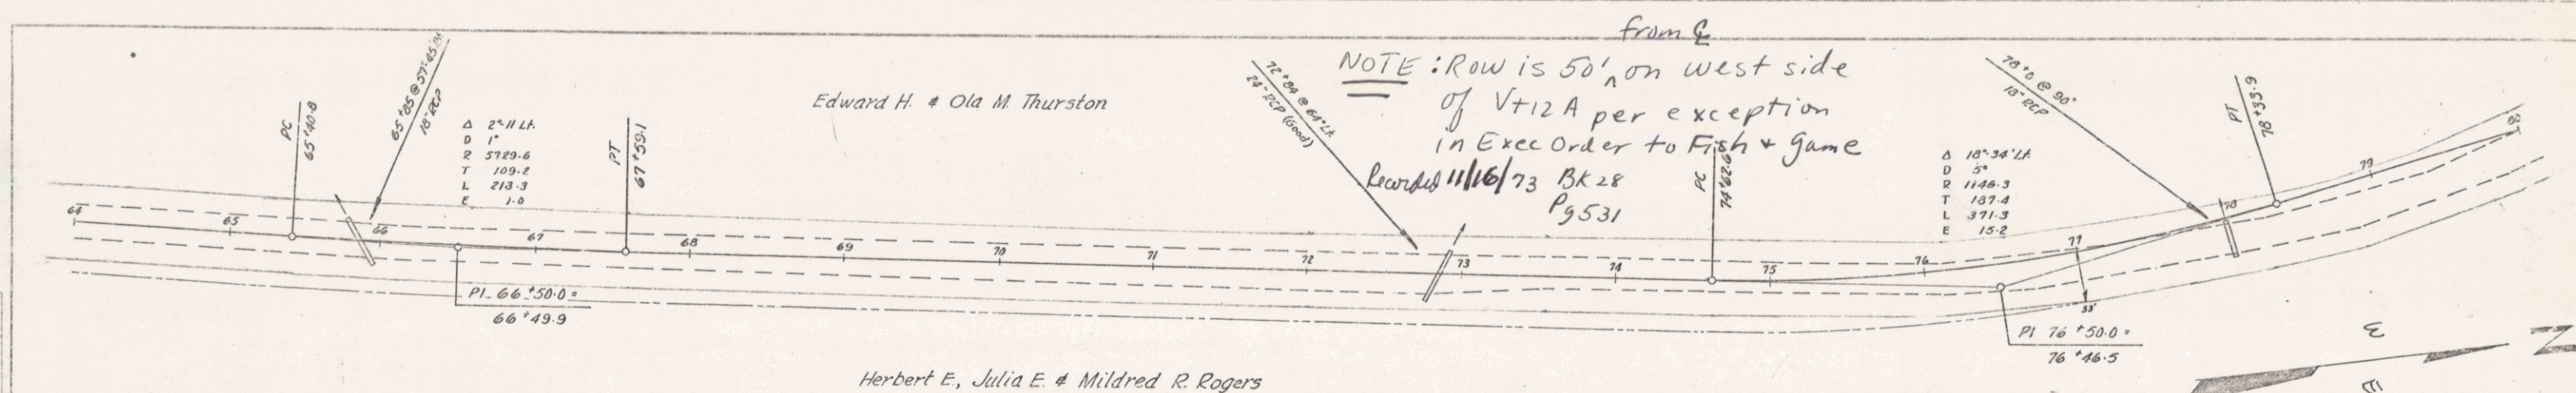

Roxbury
ST 145 N
SHEET 4

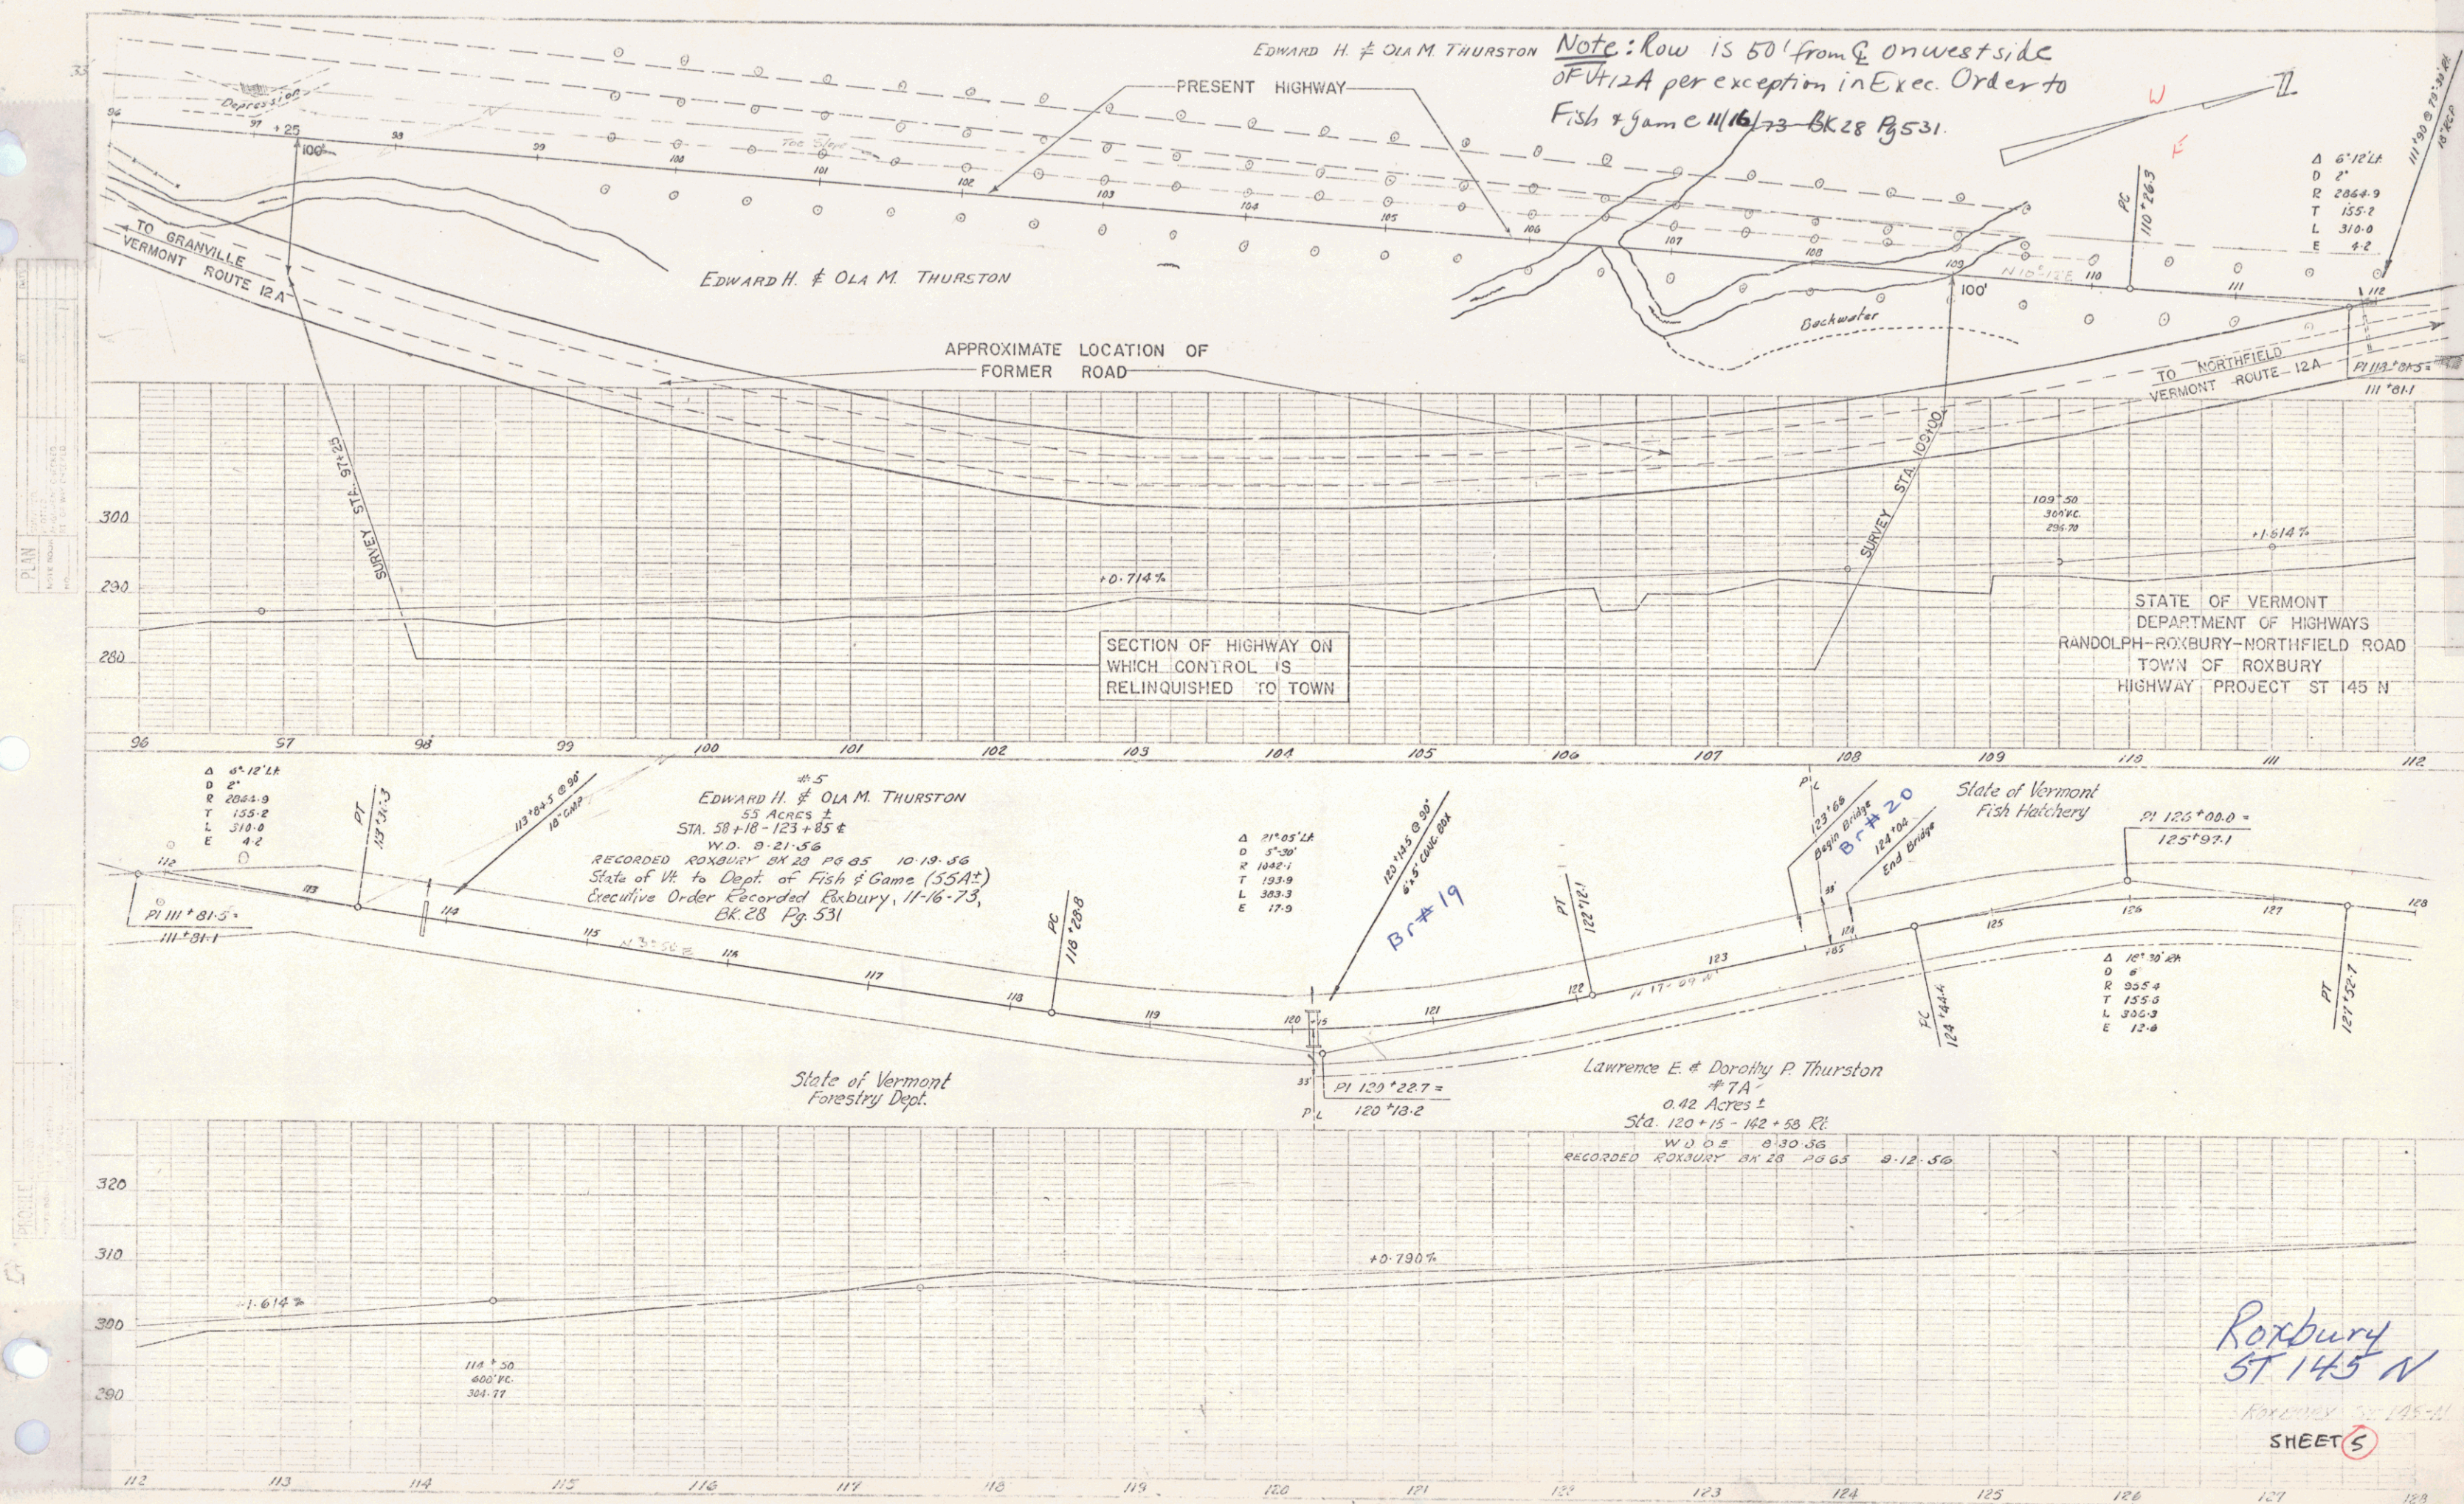

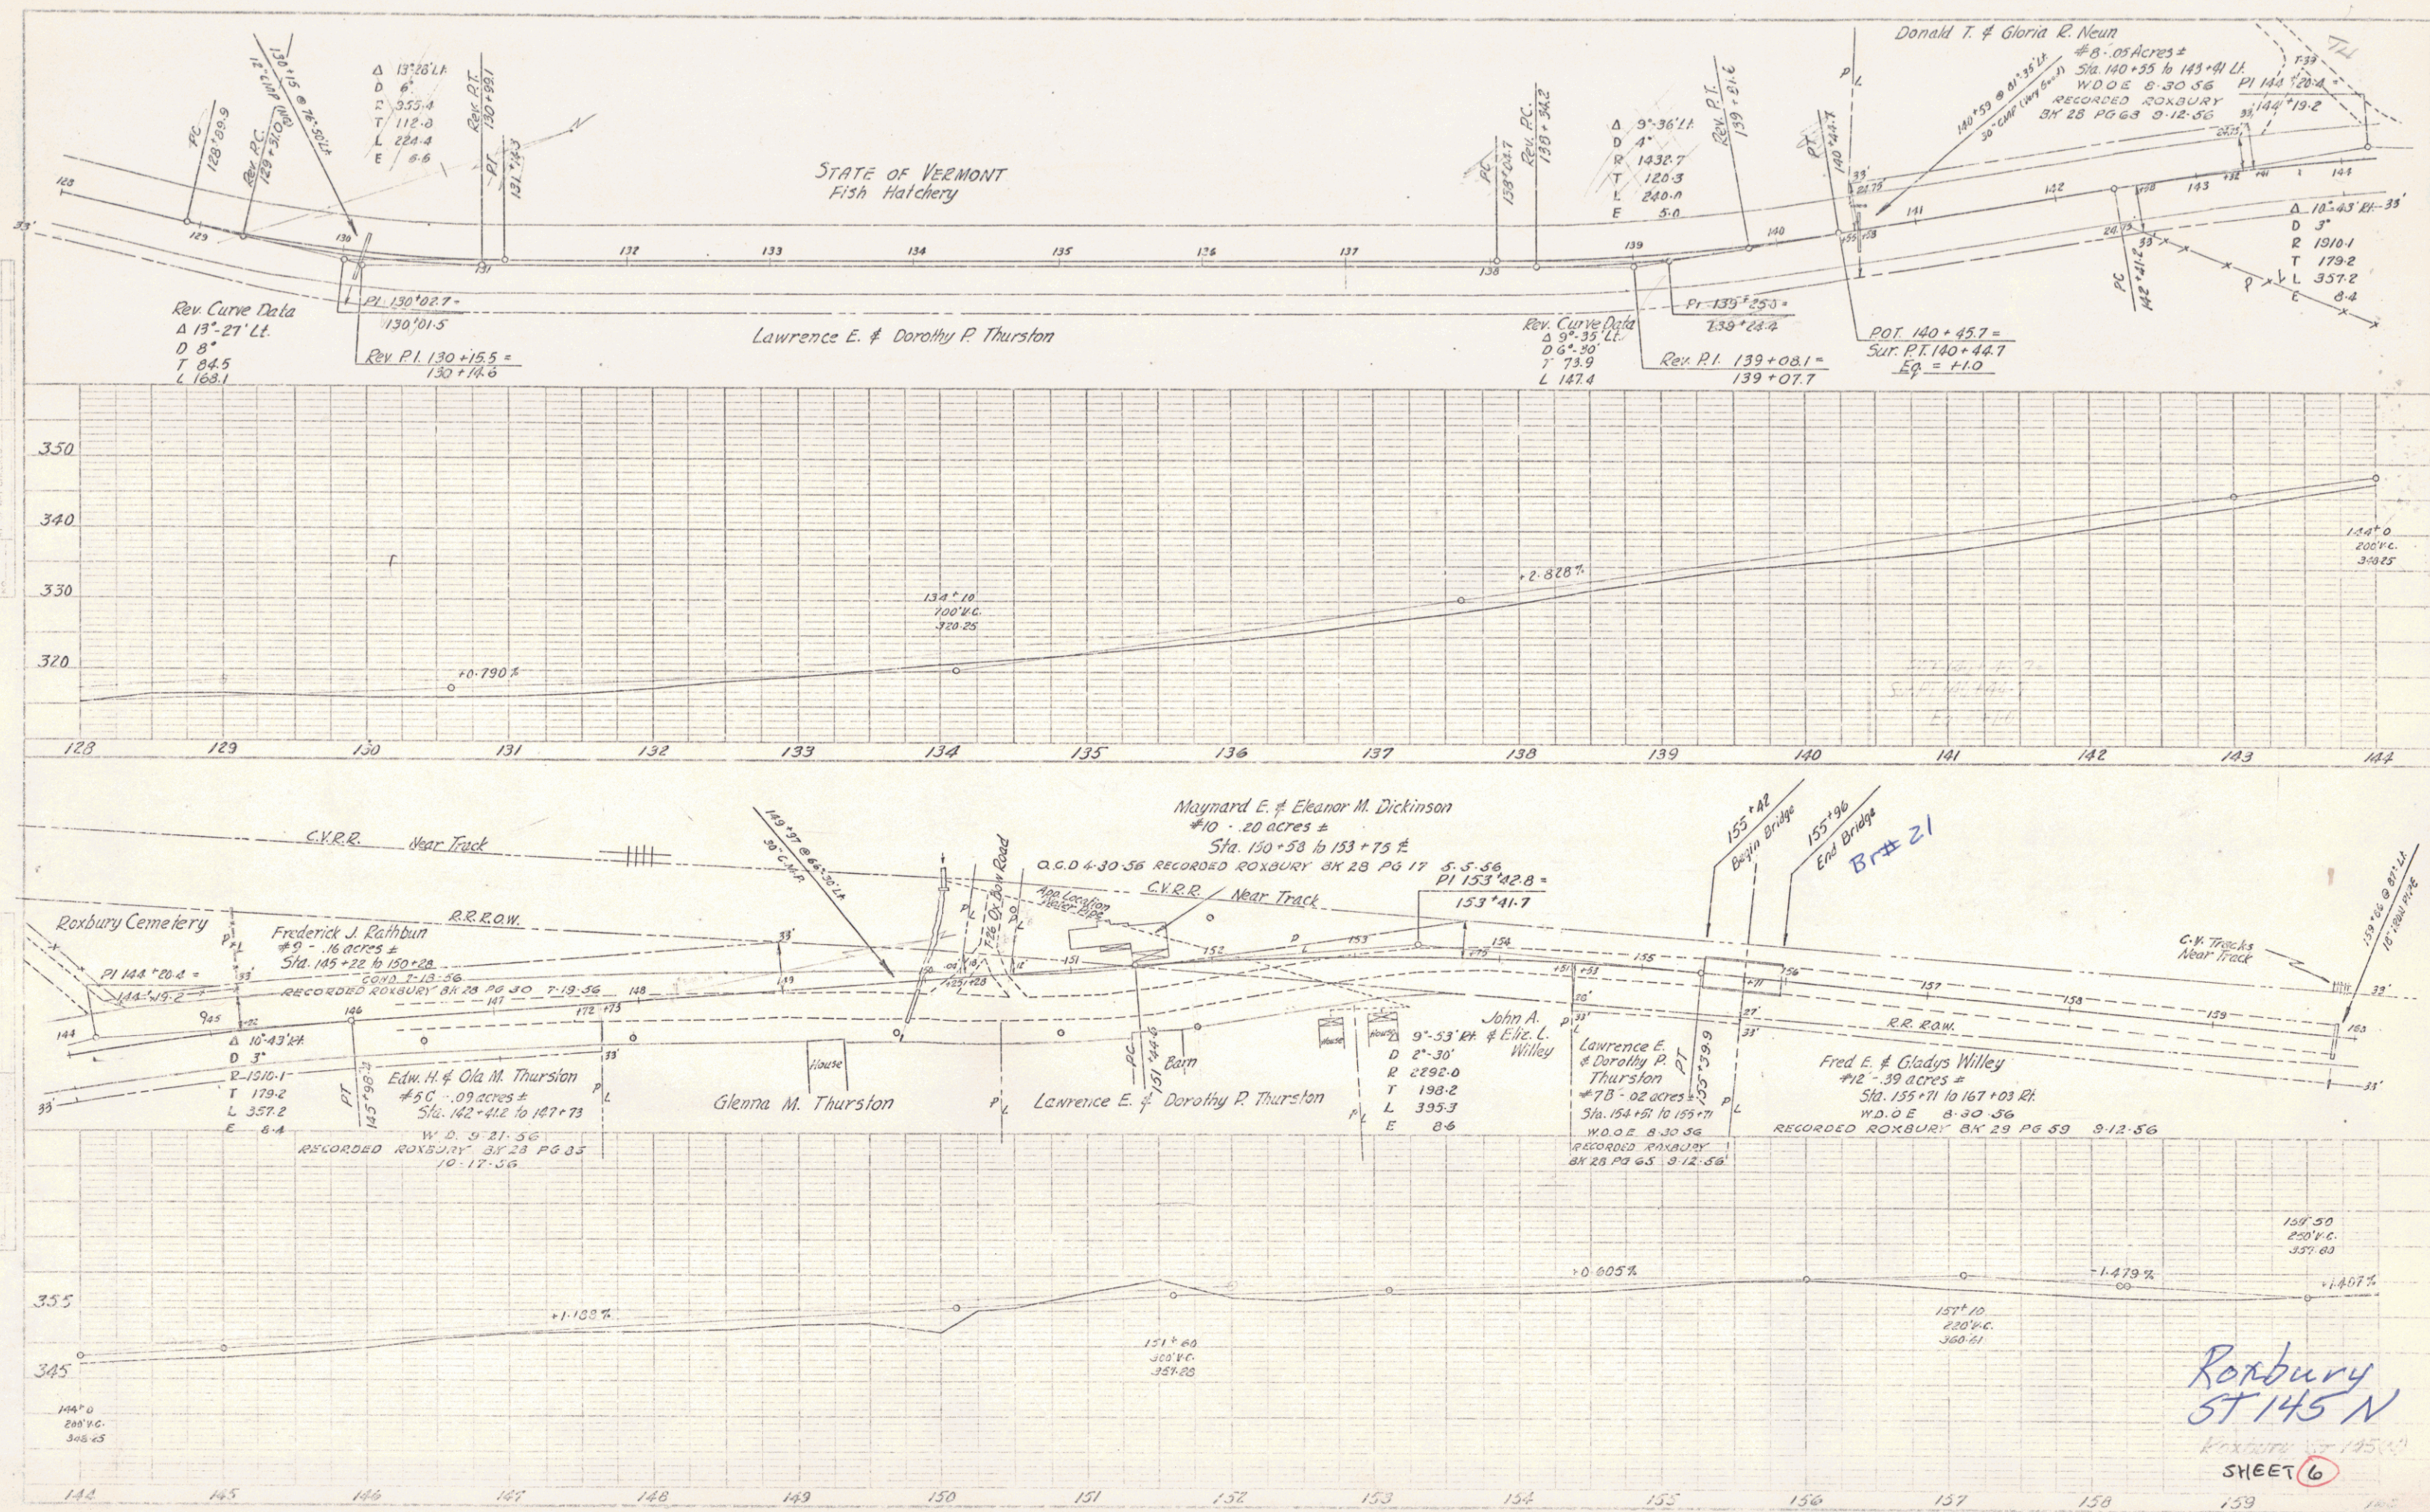

PLAN	DATE	BY
1901	1901	1901
1902	1902	1902
1903	1903	1903
2000	2000	2000

PROFILE	DATE	BY
1901	1901	1901
1902	1902	1902
1903	1903	1903
2000	2000	2000

