

INDEX OF SHEETS

1	TITLE SHEET	
2	TYPICAL SHEET	
3-5A	QUANTITY AND DRAINAGE SHEETS	
6	EARTHWORK SHEET	
7	ROW DETAIL SHEET	
8-9A	PLAN AND PROFILE SHEETS	
10	A-60 SOLID ROCK EXCAVATION	3/10/65
11	B-1 BANKING TABLES	3/10/65
12	B-5 TYPICAL SLOPE GRADING	3/10/65
13	B-6 MUCK EXCAVATION	3/10/65
14	B-10 EMBANKMENT ON A SLOPE	3/10/65
15	B-11 METHODS OF SLOPE STABILIZATION	3/10/65
16	C-1 CURBS	3/10/65
17	C-1A CURBS	3/10/65
18	D-2 HEADWALLS	7/19/67 R
19	D-3 GUTTERS AND JUTE MATTING	8/1/66 R
20	D-4 FLUSHING BASINS	3/10/65
21	D-8 DROP INLETS	3/10/65
22	D-10 DROP INLET TOPS	3/10/65
23	D-11 DROP INLET GRATES	3/10/65
24	E-31 Federal Aid Construction Identification Signs	8/21/67 R
25	E-32 Road Construction Approach Signs	1/6/65
26	E-34 On-Project Construction Signs	5/3/67 R
27	G-4 Plank Guard Rail	12/30/65 R
28	G-6 Three Cable Guard Rail with Light Steel Posts	8/31/67
29	G-7 Three Cable Guard Rail with Light Steel Posts	8/31/67
30	G-8 Bridge Railing (For Bridge Approaches)	3/18/67 R
31	G-9 Bridge Railing (For Bridge Approaches)	3/18/67 R
32	U-1 Boundary and Project Markers	3/10/65
33-32	Cross Sections	



* 9-5, 5, D Bridge Information Sheets
* 9-5, 5, D Earthwork and Final Check
FOR RIGHT OF WAY DETAILS, SEE RIGHT OF WAY PLANS FOR THIS PROJECT.

STATE OF VERMONT
DEPARTMENT OF HIGHWAYS
PROPOSED IMPROVEMENT
TOWN OF WEATHERSFIELD
COUNTY OF WINDSOR
VERMONT ROUTE 12
ASCUTNEY, VT. - CLAREMONT, N.H. RD.

BEGINNING AT A POINT 0.331 MILE NORTHWESTERLY
OF THE N.H.-VT. STATE LINE AND EXTENDING
SOUTHEASTERLY 0.316 MILE


LENGTH OF ROADWAY 1,667.0 FEET = 0.316 MILE
LENGTH OF PROJECT 1,667.0 FEET = 0.316 MILE

ADT 1966	3200
ADT 1986	6075
DHV 1986	935
D	55.5%
T	6%
V	50 MPH

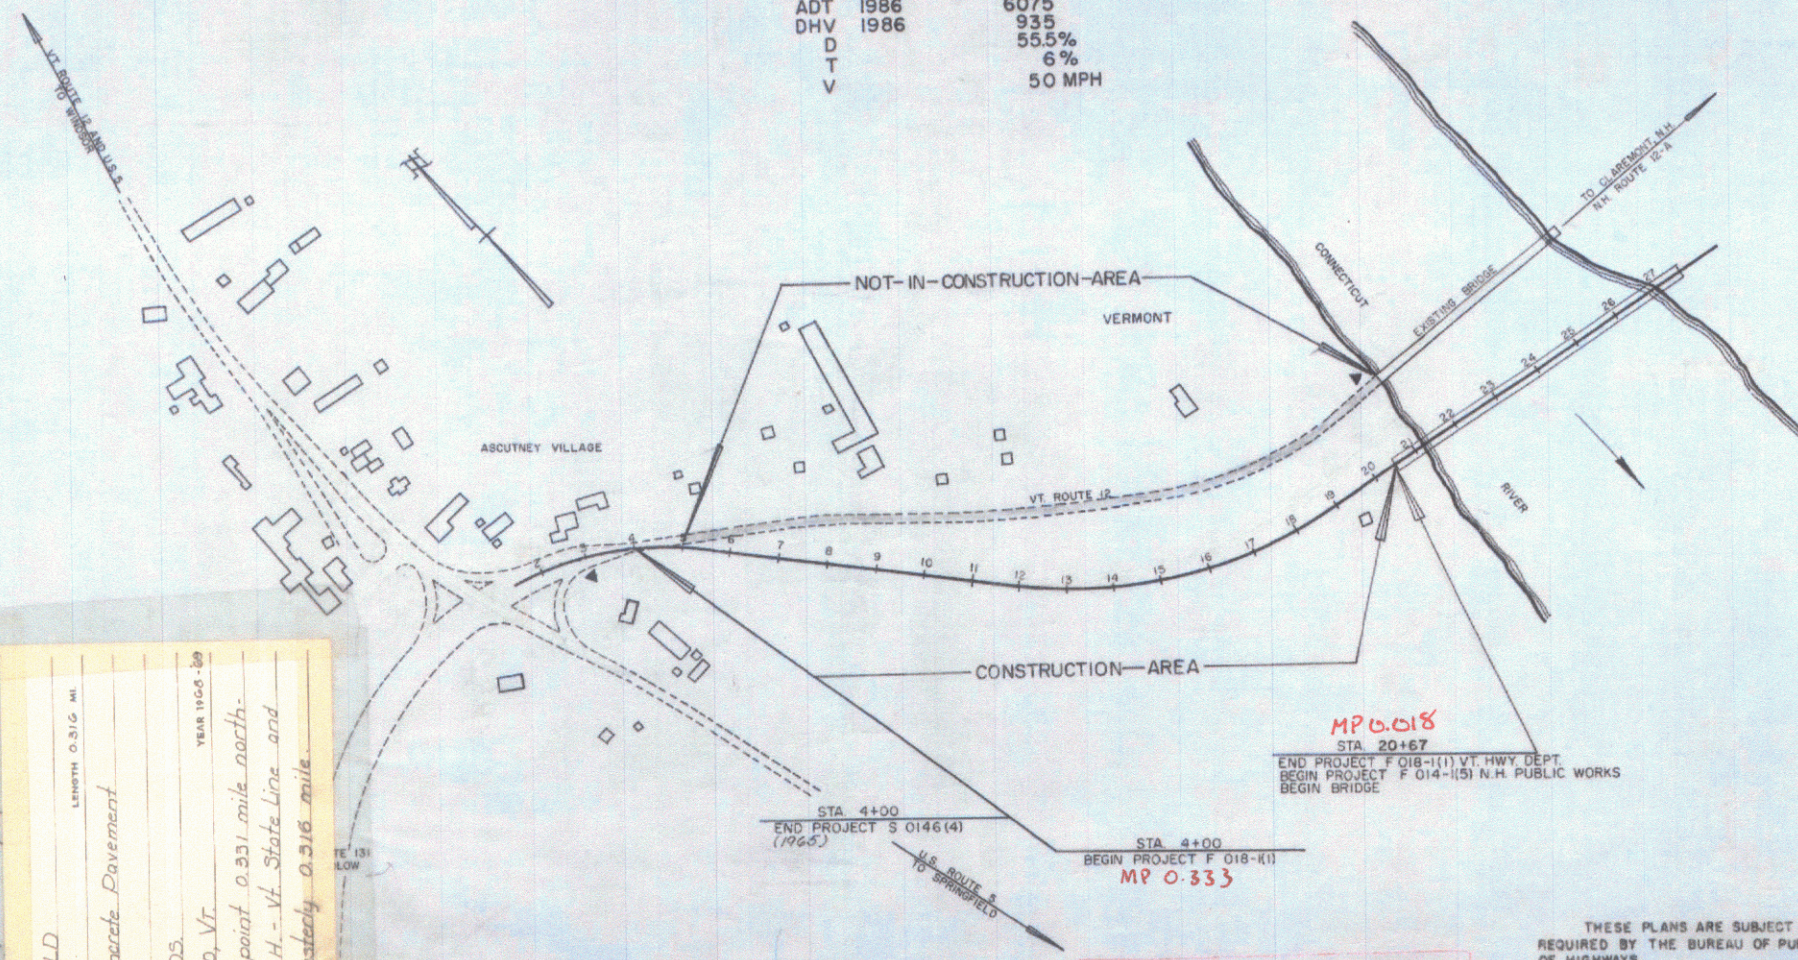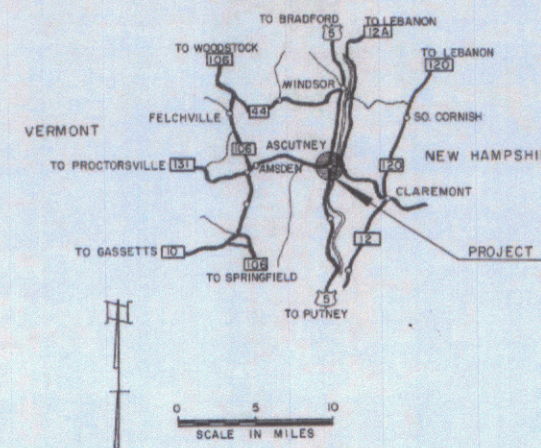

PROJECT NAME & NUMBER	TYPE PAVEMENT	AREA SQ.
WEATHERSFIELD F 018-1(1)	BITUMINOUS CONCRETE	
RECORD PLANS		
MATERIALS		
SUB-BASE OF GRAVEL - ROGERS' PIT, PERKINSVILLE, VT.		
SUB-BASE OF SAND - HANE		
GRAVEL SHOULDER - HAMMOND PIT, WINDSOR, VT.		
CRUSHED GRAVEL		
NEW HAMPSHIRE CRUSHED GRAVEL		
CONVENTIONAL SIGNS

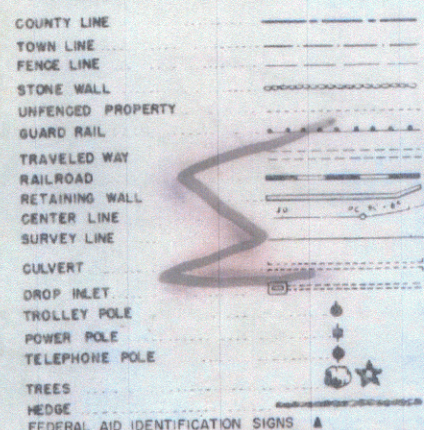

RIGHT-OF-WAY	
SLOPE RIGHTS	
GROUND ELEVATION	
GRADE ELEVATION	
CURVE DATA	
DEFLECTION OF ANGLE	
DEGREE OF CURVE	
RADIUS OF CURVE	
TANGENT DISTANCE	
LENGTH OF CURVE	
EXTERNAL DISTANCE	
POINT OF INTERSECTION	
POINT OF CURVE	
POINT OF TANGENT	
POINT ON SUB-TANGENT	

PROJECT WEATHERSFIELD
F 018-1(1)
TYPE Bituminous Concrete Pavement
CONTRACTOR ROGERS BRAS
BRATTLEBORO, VT
LOCATION Beginning at a point 0.331 mile north-
westerly of the N.H.-Vt. State Line and
extending southeasterly 0.316 mile

APPROVED DATE 2/24/65 ASST. CHIEF ENGINEER	APPROVED DATE 2/23/65 DISTRICT ENGINEER	APPROVED DATE 2/18/65 BRIDGE ENGINEER	APPROVED DATE 2/18/65 DISTRICT ENGINEER	APPROVED DATE 2/15/65 HIGHWAY ENGINEER	APPROVED DATE 2/24/65 CHIEF ENGINEER
--	---	---	---	--	--

DEPARTMENT OF TRANSPORTATION BUREAU OF PUBLIC ROADS	
APPROVED	DATE
DIVISION ENGINEER	DATE
PROJECT F NO. 018-1(1)	
SHEET 1 OF 42 SHEETS	

STATE OF VERMONT DEPARTMENT OF HIGHWAYS RIGHT-OF-WAY PLANS DETAIL SHEET OF

TABLE OF PROJECT PROPERTY ACQUISITION

PARCEL NO.	GRANTOR	SHEET NO.	BEGINNING STATION	ENDING STATION	TAKING	REM.	RIGHTS	TITLE TAKEN	DATE	TOWN OR CITY RECORDED	BK.	PG.	REMARKS
1	STATE OF VERMONT (Forwtd) MILDRED N. LAPHAM	4	1+56	2+26	4,279 s.f.	1,981 s.f.		Cond Order	1-6-64	Weathersfield	40	162 164	House
2	J. NEWELL GREEN	4	2+23 2+75 LT. 3+00 3+75 LT.	5+40 3+50 LT. 5+00 LT.	0.24A±	0.86A±	Slope (T) (100 s.f.) Drive (T) Slope (T) (1000 s.f.)						900' In take already occurred in fee by St. of VT.
3	ASCUTNEY REAL ESTATE CORP.	4	2+75 2+75 RT. 3+15 4+15 4+69	6+81 6+81 RT.	0.6A±	2.0A±	Slope (T) (0.16A±) Drive (T) Drive (T) Drive (T)						Sign
4	HAROLD D. GARDNER	4	5+06 5+50 LT. 5+30 LT. 7+10 LT.	7+09 7+50 LT.	0.12A±	1.7A±	Slope (T) (800 s.f.) Drive (T) Drive (T)						
5	HERBERT C. & ELEANOR S. STEELE	4	6+81 9+00 RT.	8+95	0.6A±	2.0A±	Drainage (P)						
6	ALTON E. & BARBARA B. FONTAINE	4,5	7+70 12+70 RT. 9+00 RT. 14+50 RT. 14+00 RT.	21+87 19+15 RT.	9.1A±	39.9A±	Water pipe crossing (P) Drainage (P) Drainage (P) Drive (T)						2 CRM LIGHT POSTS & TRAILER HOUSE
7	CELIA P. MARTIN	5	12+45	21+95	0.45A±	1.65A±							
8	BERNARD N. & GLADYS A. CAREY & KENNETH A. CAREY	4,5	10+50				Water pipe crossing (P)						

TABLE OF REVISIONS

REVISION NO.	SHEET NO.	DESCRIPTION OF REVISION	DATE	MADE BY	APPROVED BY
1.	4.	Parcel #1 Increased take 1,019 sq. ft. per H.P.R.	5-3-65	RMW	J. L.
2.	4	Parcel #1 Change in owner-ship.	5-18-65	MMB	J. L.
3.	6-9	REVISED LINE AND GRADE FROM 9+00-20+50	12-31-65	RVT	L
3	6	ADDED CURB FROM 1+25 TO 2+75 LT. WITH WIDENED WALKING AREA IN BACK OF SAME CURB	12-31-65	BEB	L
3	6	CORRECTED TOPO IN AREA OF INTERSECTION	12-31-65	BEB	L
3	6	ADDED ITEM OF PLANTING TREES, SHRUBS AND VINES @ 3+00-3+75± LT.	12-31-65	BEB	L
3	6	NOTED ON PLANS TO SAVE CRANBERRY BUSH @ 3+50 LT.	12-31-65	BEB	L
3	6	ADDED PAVEMENT TO APPROACH @ 9+78 LT.	12-31-65	BEB	L
3	8	CHANGED DRAINAGE LOCATION @ 16+50-17+50 RT-LT	12-31-65	BEB	L
4	8	Added Stone Fill and Channel Excav @ 16+50-18+75 RT.	12-31-65	BEB	L
5	8-36	Added Drive @ 13+85 RT.	4-28-66	RVT	L
6	6, 31, 32	Added Sidewalk @ 0+52-2+33 LT.	5-11-66	BEB	L
6	6, 32	Paved Drives @ 3+15 RT, 4+11 & 4+15 RT & 4+23 RT	5-11-66	BEB	L


LEGEND

MADE BY R. Wilson DATE 4-8-65
CHECKED BY A. Blinn DATE 4-9-65


--- TAKING WITHOUT ACCESS
--- P --- TAKING WITHOUT ACCESS ALONG PROPERTY LINES
--- TAKING WITH ACCESS
(P) PERMANENT EASEMENT
(T) TEMPORARY EASEMENT

--- SR --- SLOPE RIGHTS
--- PROPERTY LINE
--- Δ --- TOP OF CUT
--- O --- TIE OF SLOPE

APPROVED T. C. Bernabey DATE 4-27-65
APPROVED G. M. Lane DATE 4-28-65
APPROVED H. P. Radigan DATE 4-28-65
R.O.W. DIRECTOR
WEATHERSFIELD F 018-1(1)
SHEET 5 OF 42 SHEETS

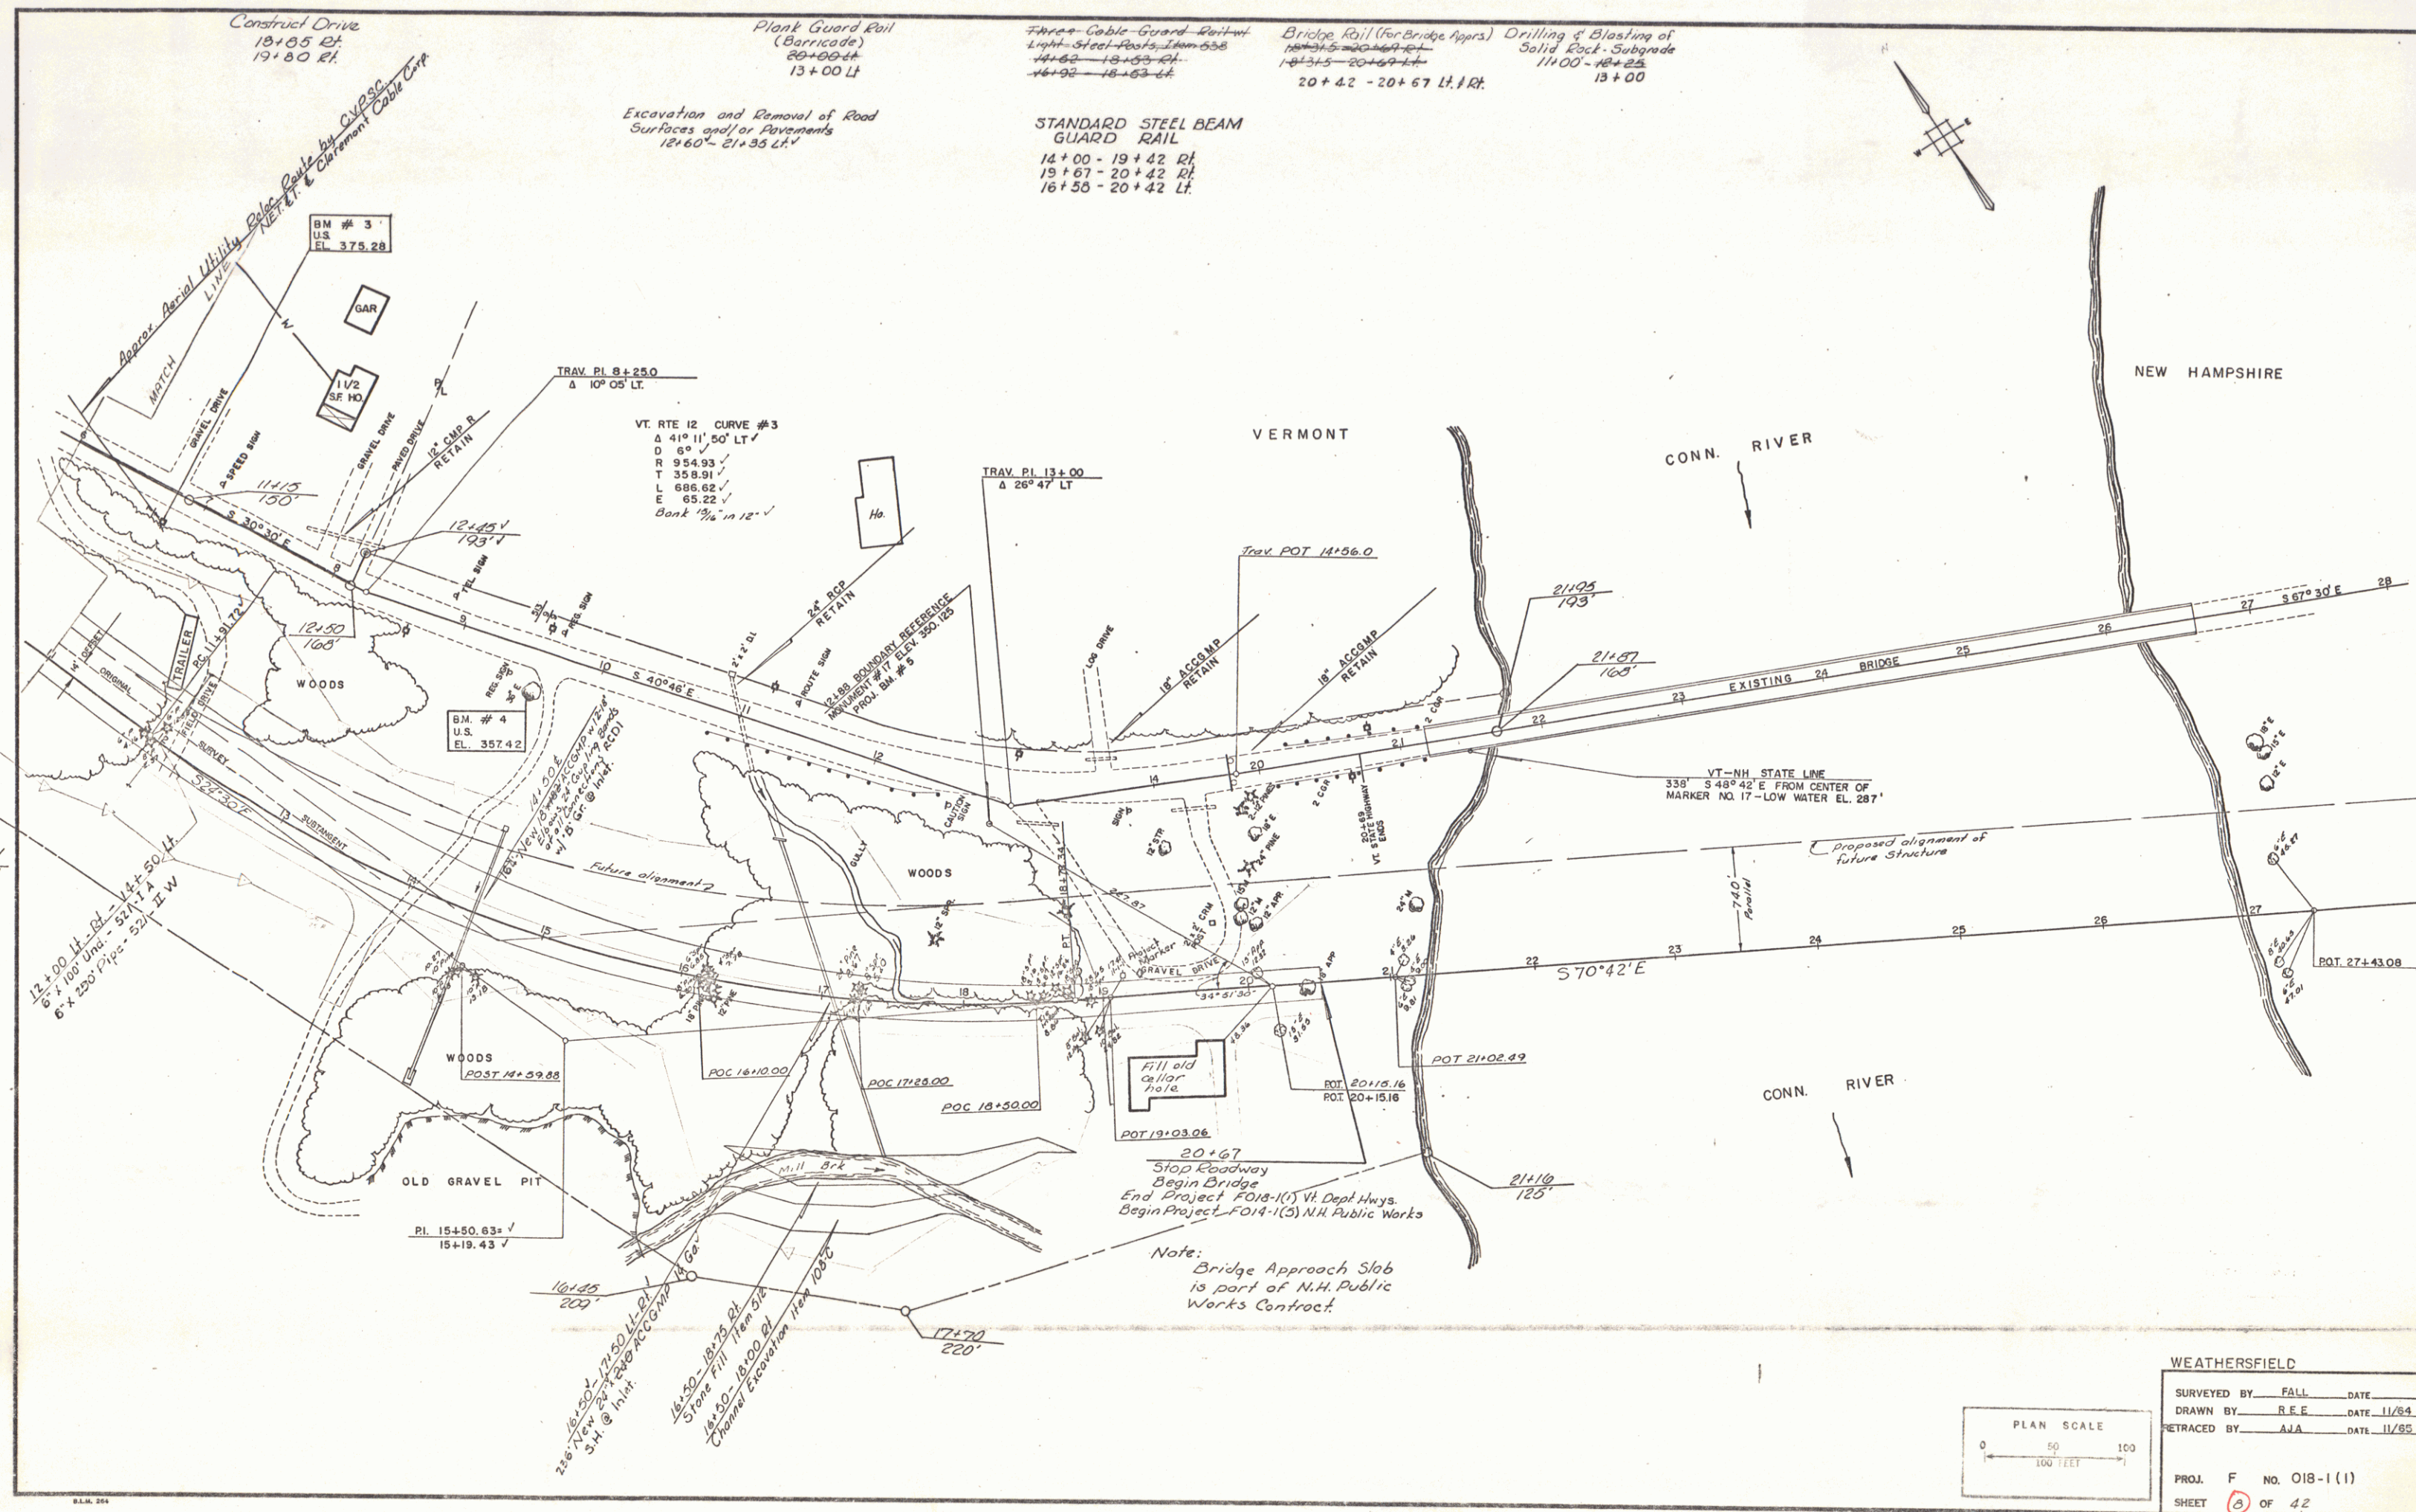


VERMONT DEPARTMENT OF HIGHWAYS
RIGHT-OF-WAY PLANS
PROJECT: WEATHERSFIELD
No. FO18-1(1)
SHEET 2 OF 8

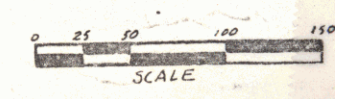


SHEET 4 of 8

5

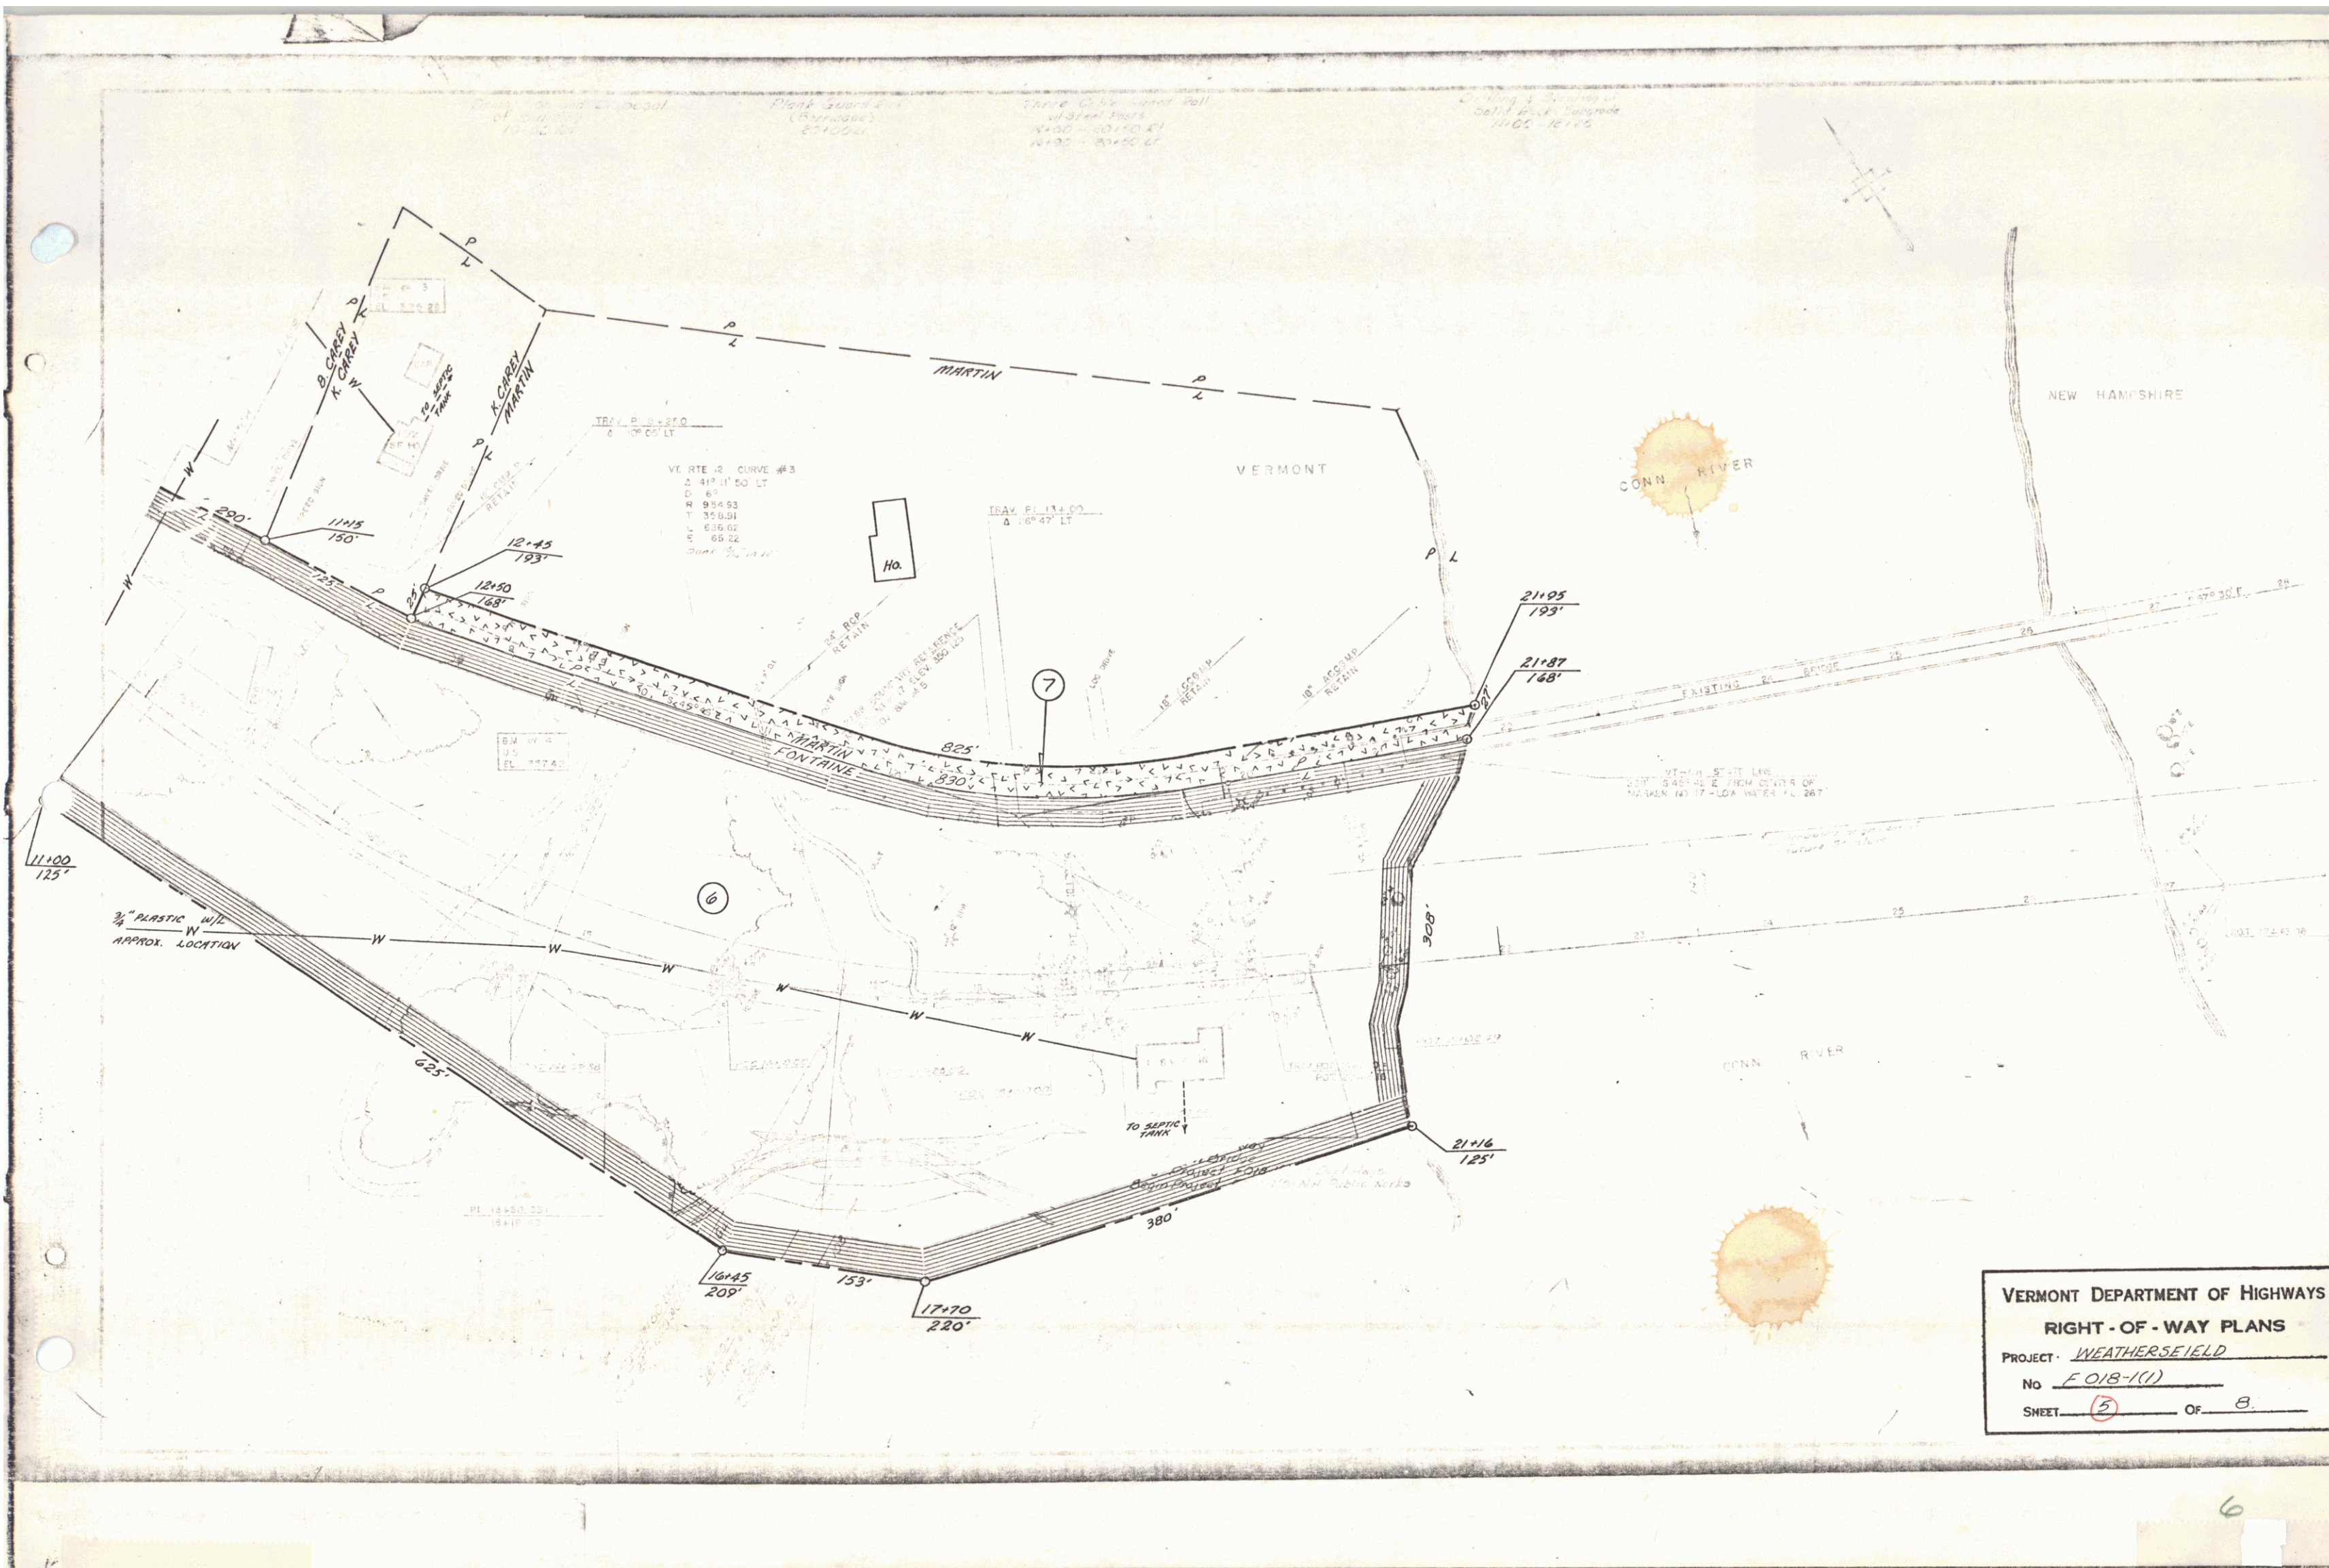

VERMONT DEPARTMENT OF HIGHWAYS
RIGHT-OF-WAY PLANS
PROJECT: WEATHERSFIELD
NO: FOIB-1(1)
SHEET 5 OF 8

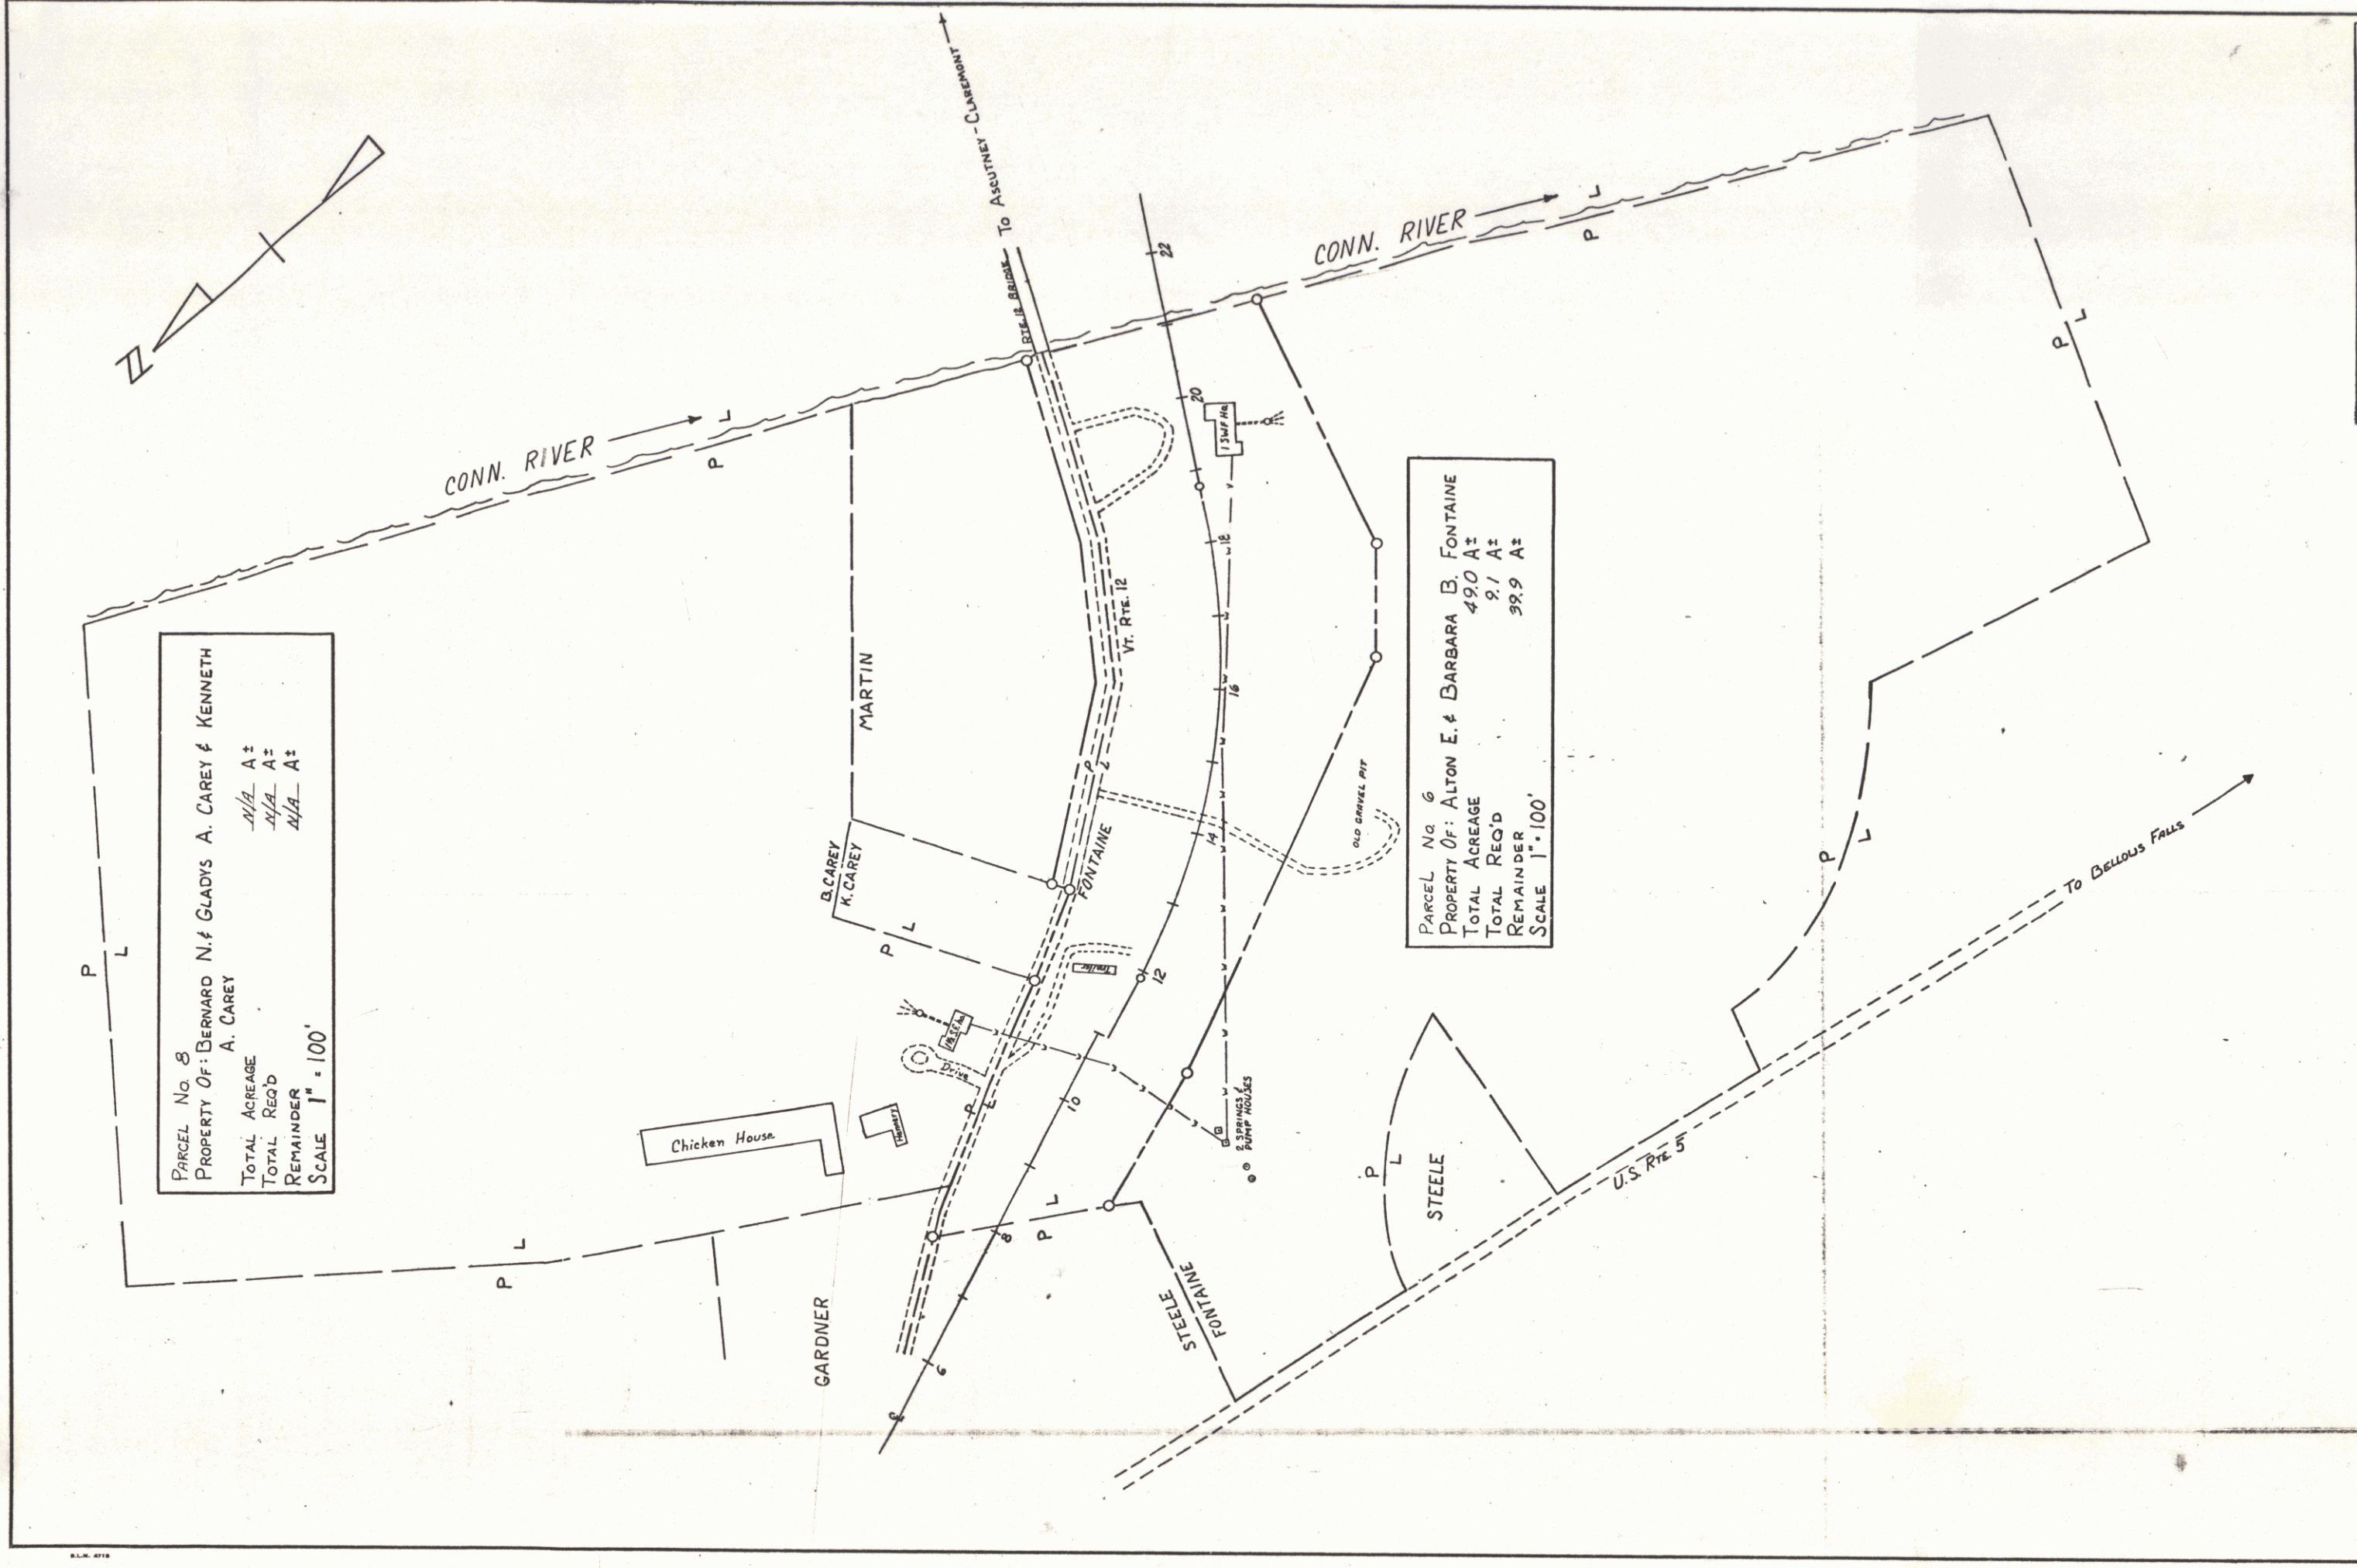

VERMONT DEPARTMENT OF HIGHWAYS

RIGHT-OF-WAY PLANS

PROJECT: WEATHERSFIELD

NO. F 018-1(1)

SHEET 6 OF 8

SHEET 6 OF 8

7