

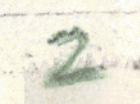


21

NOTE 3607-1 - ENCL. FILE

paulding	10-53
A Parker	11-53
Z. W. Esper	11-53

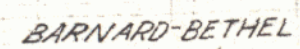

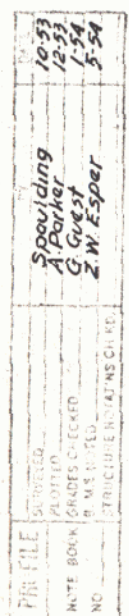

C. & R. TREE
ITEM 110

Construct Drives
Sta. 368+00 to 368+10
Sta. 368+10 to 368+20
Sta. 368+20 to 368+30

Three Cable Guard Rail
Sta. 364+00 to 364+10
Sta. 364+10 to 364+20
Sta. 364+20 to 364+30

B.M. #34-A
S.I.R. 24' Maple
Elev. 1454.71

B.M. #34-B
S.I.R. 24' Maple
Elev. 1463.29

B.M. #34-C
Spot on Ledge
Elev. 1503.65

B.M. #35-A
S.I.R. 14' Maple
Elev. 1521.85

369+75 to 375+03 Lt
Limits of Clearing & Grubbing
Item 104


#36
JOSEPH H. & KATHERINE M. WARD
STA. 371+30-394+87
6.9 ACRES
STA. 379+50, 384+00, 391+50
CULVERT RIGHTS
W.D.O.E. 11/8/54
RECORDED: BARNARD-BK 32-PG 97-5720/66

CARL & ALICE ZUCKMAYER

ARNOLD V. & LUCY G. POWELL

Δ = 81°16' Rt
D = 8°0'
R = 716.8
T = 615.1
L = 1015.8
E = 22.7
Bank 1/2 per ft
Hor. SD = 370'



#35
CARL & ALICE ZUCKMAYER
STA. 364+00-371+39
1.92 ACRES
COND. 9/17/54
RECORDED: BARNARD-BK 31-PG 479, 495-9/17/54

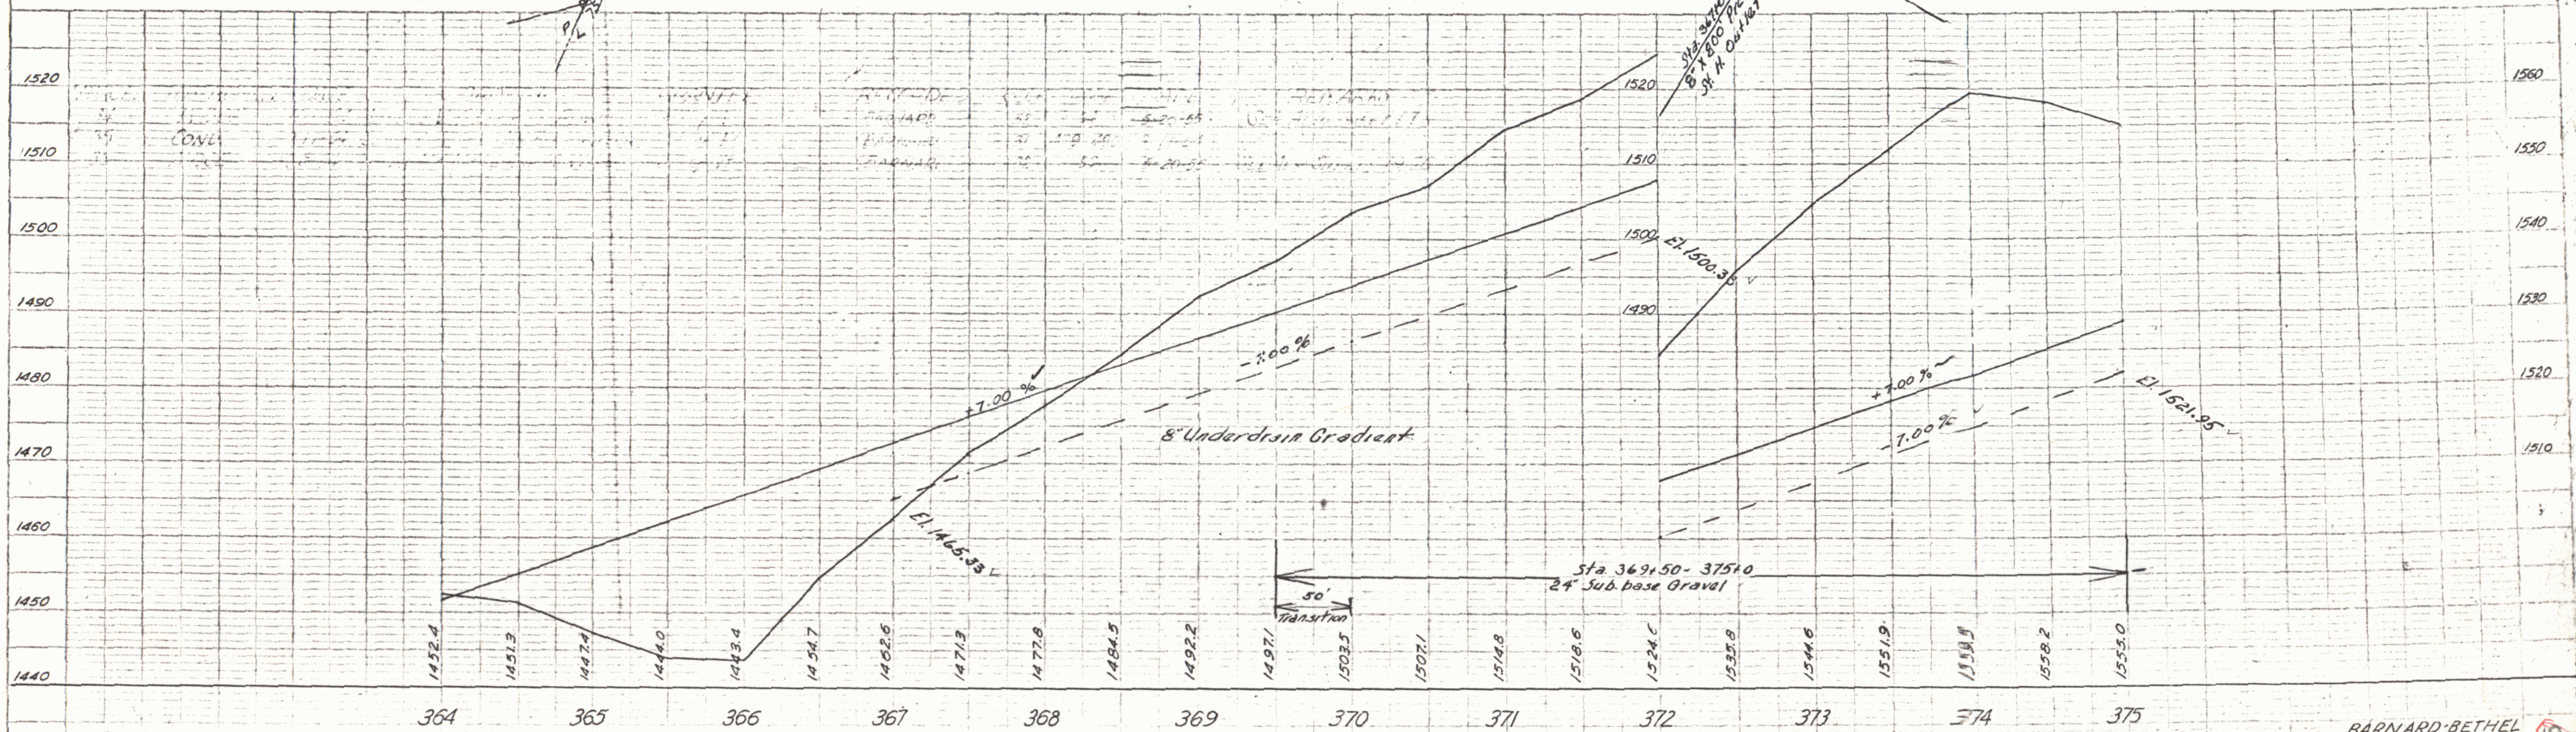

B.M. #34-A S.I.R. 24' Maple 9' Lt of Sta. 366+52 Elev. 1454.71
B.M. #35-A S.I.R. 14' Maple 14' Lt of Sta. 371+50 Elev. 1521.85
B.M. #34-B S.I.R. 24' Maple 40' Lt Sta. 367+10 Elev. 1463.29
B.M. #34-C Spot on Ledge 52' Lt Sta. 371+10 Elev. 1503.65


BARNARD-BETHEL

THE CLARKSON ENGINEERING CO., INC.
CONSULTING ENGINEERS
BOSTON MASSACHUSETTS

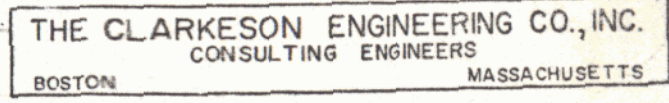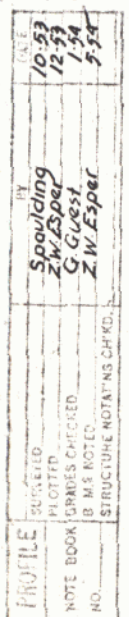

DATE	12/17/54
BY	W. E. Spurr
REVISION	12/17/54
NO.	1
PLAN	1
NOTE BOOK	12/17/54
RT. OF WAY CHECKED	
NO.	



DATE	12/17/54
BY	W. E. Spurr
REVISION	12/17/54
NO.	1
PROFILE	1
NOTE BOOK	12/17/54
STRUCTURE NOTING CHECKED	
NO.	

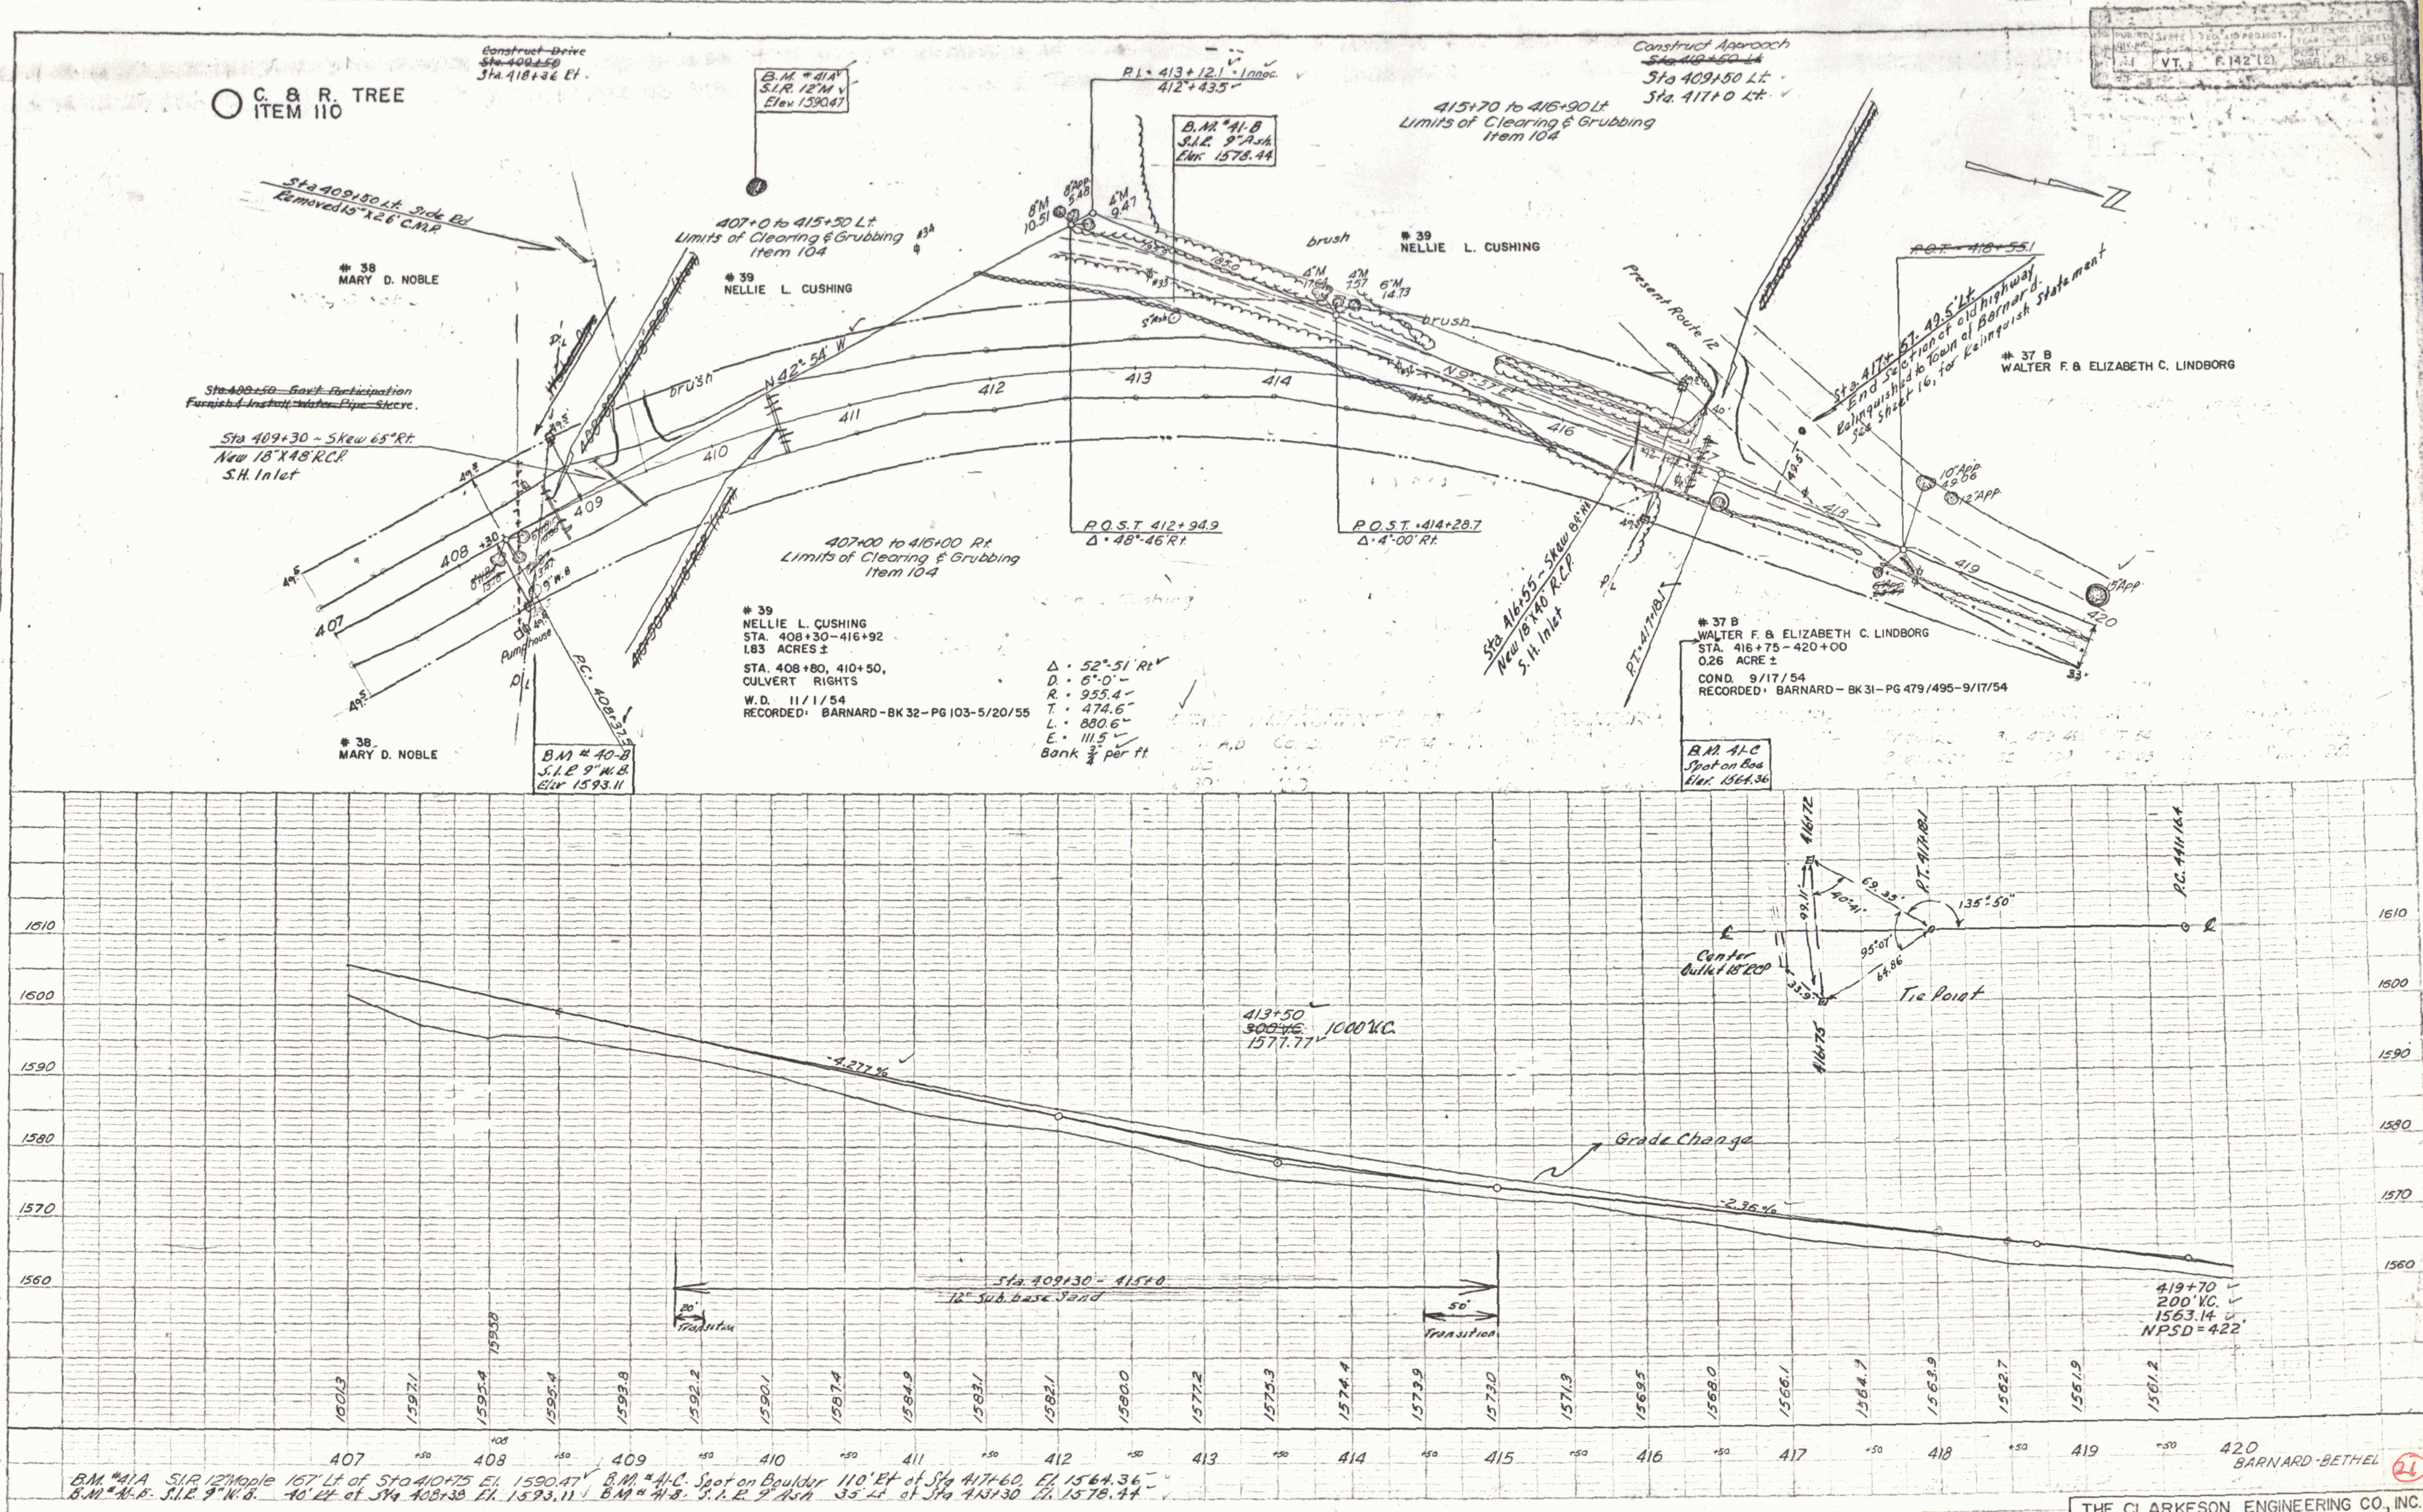

9-49
 12-33
 5-34
 S. W. Espar
 PLAN
 NO.

9-49
 12-33
 5-34
 S. W. Espar
 PROFILE
 NO.



C. & R. TREE
 ITEM 110

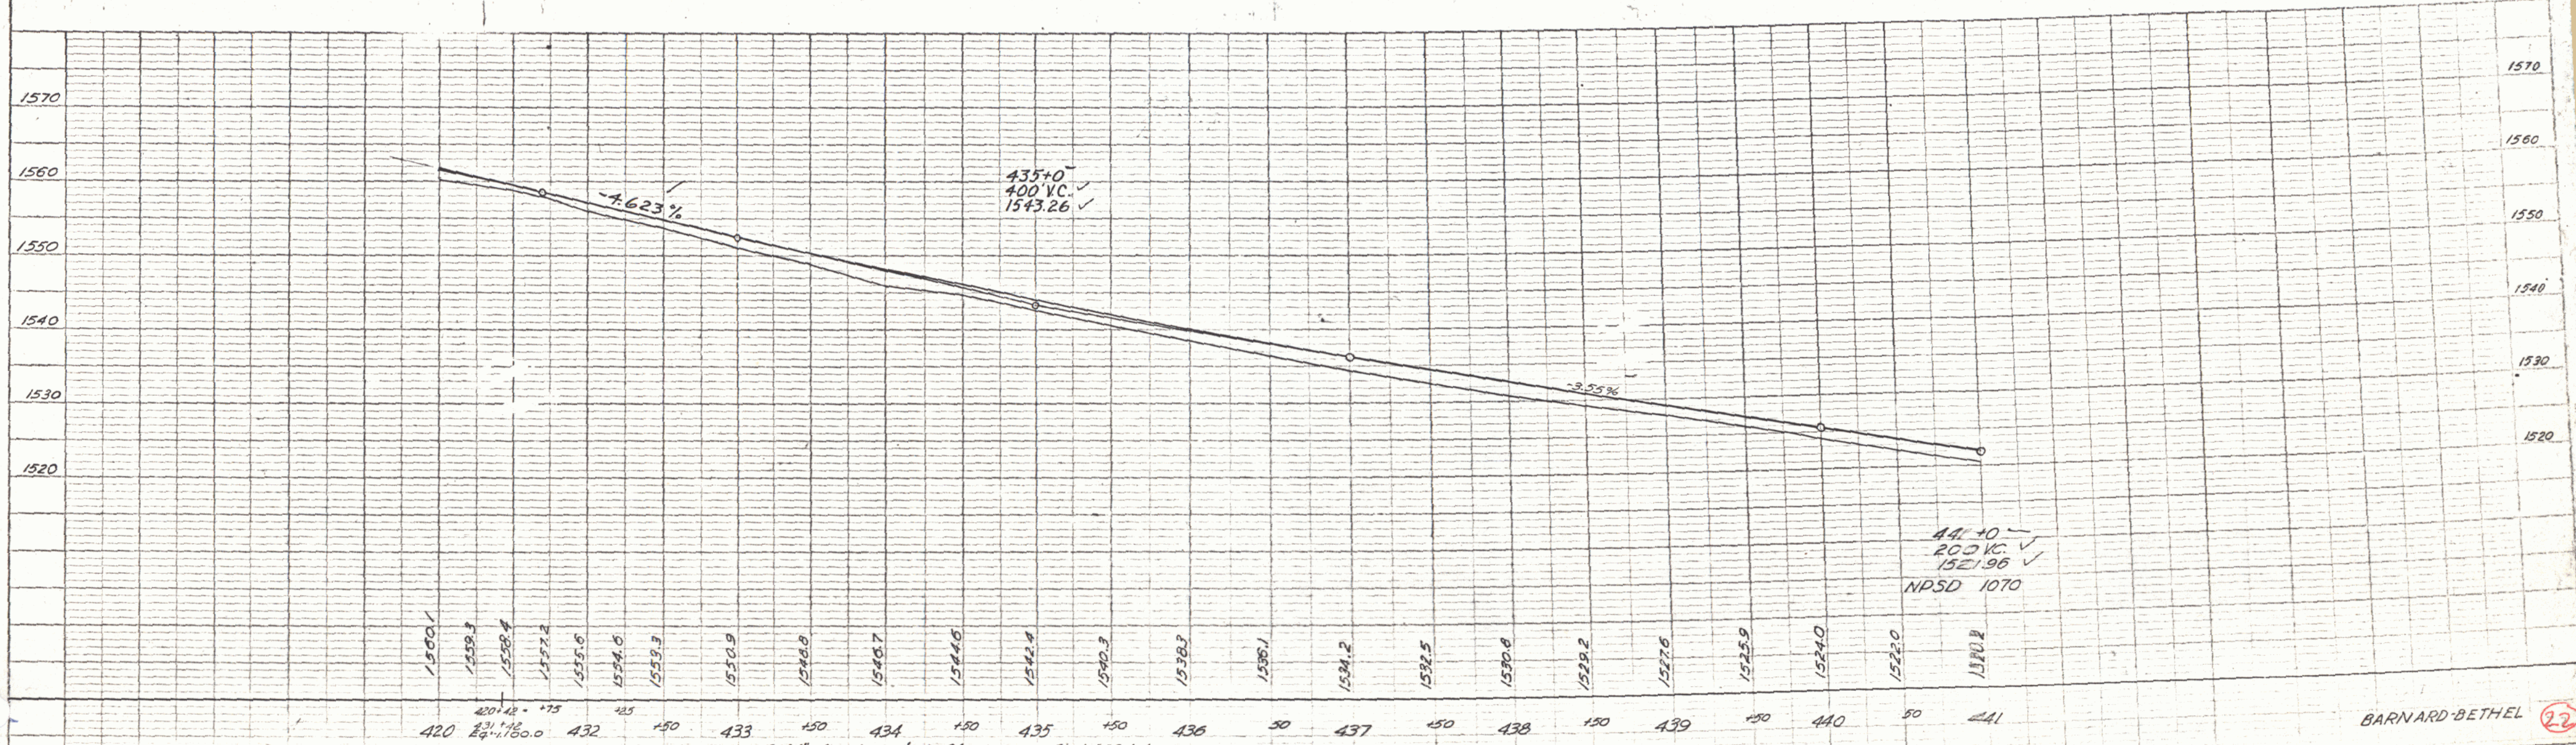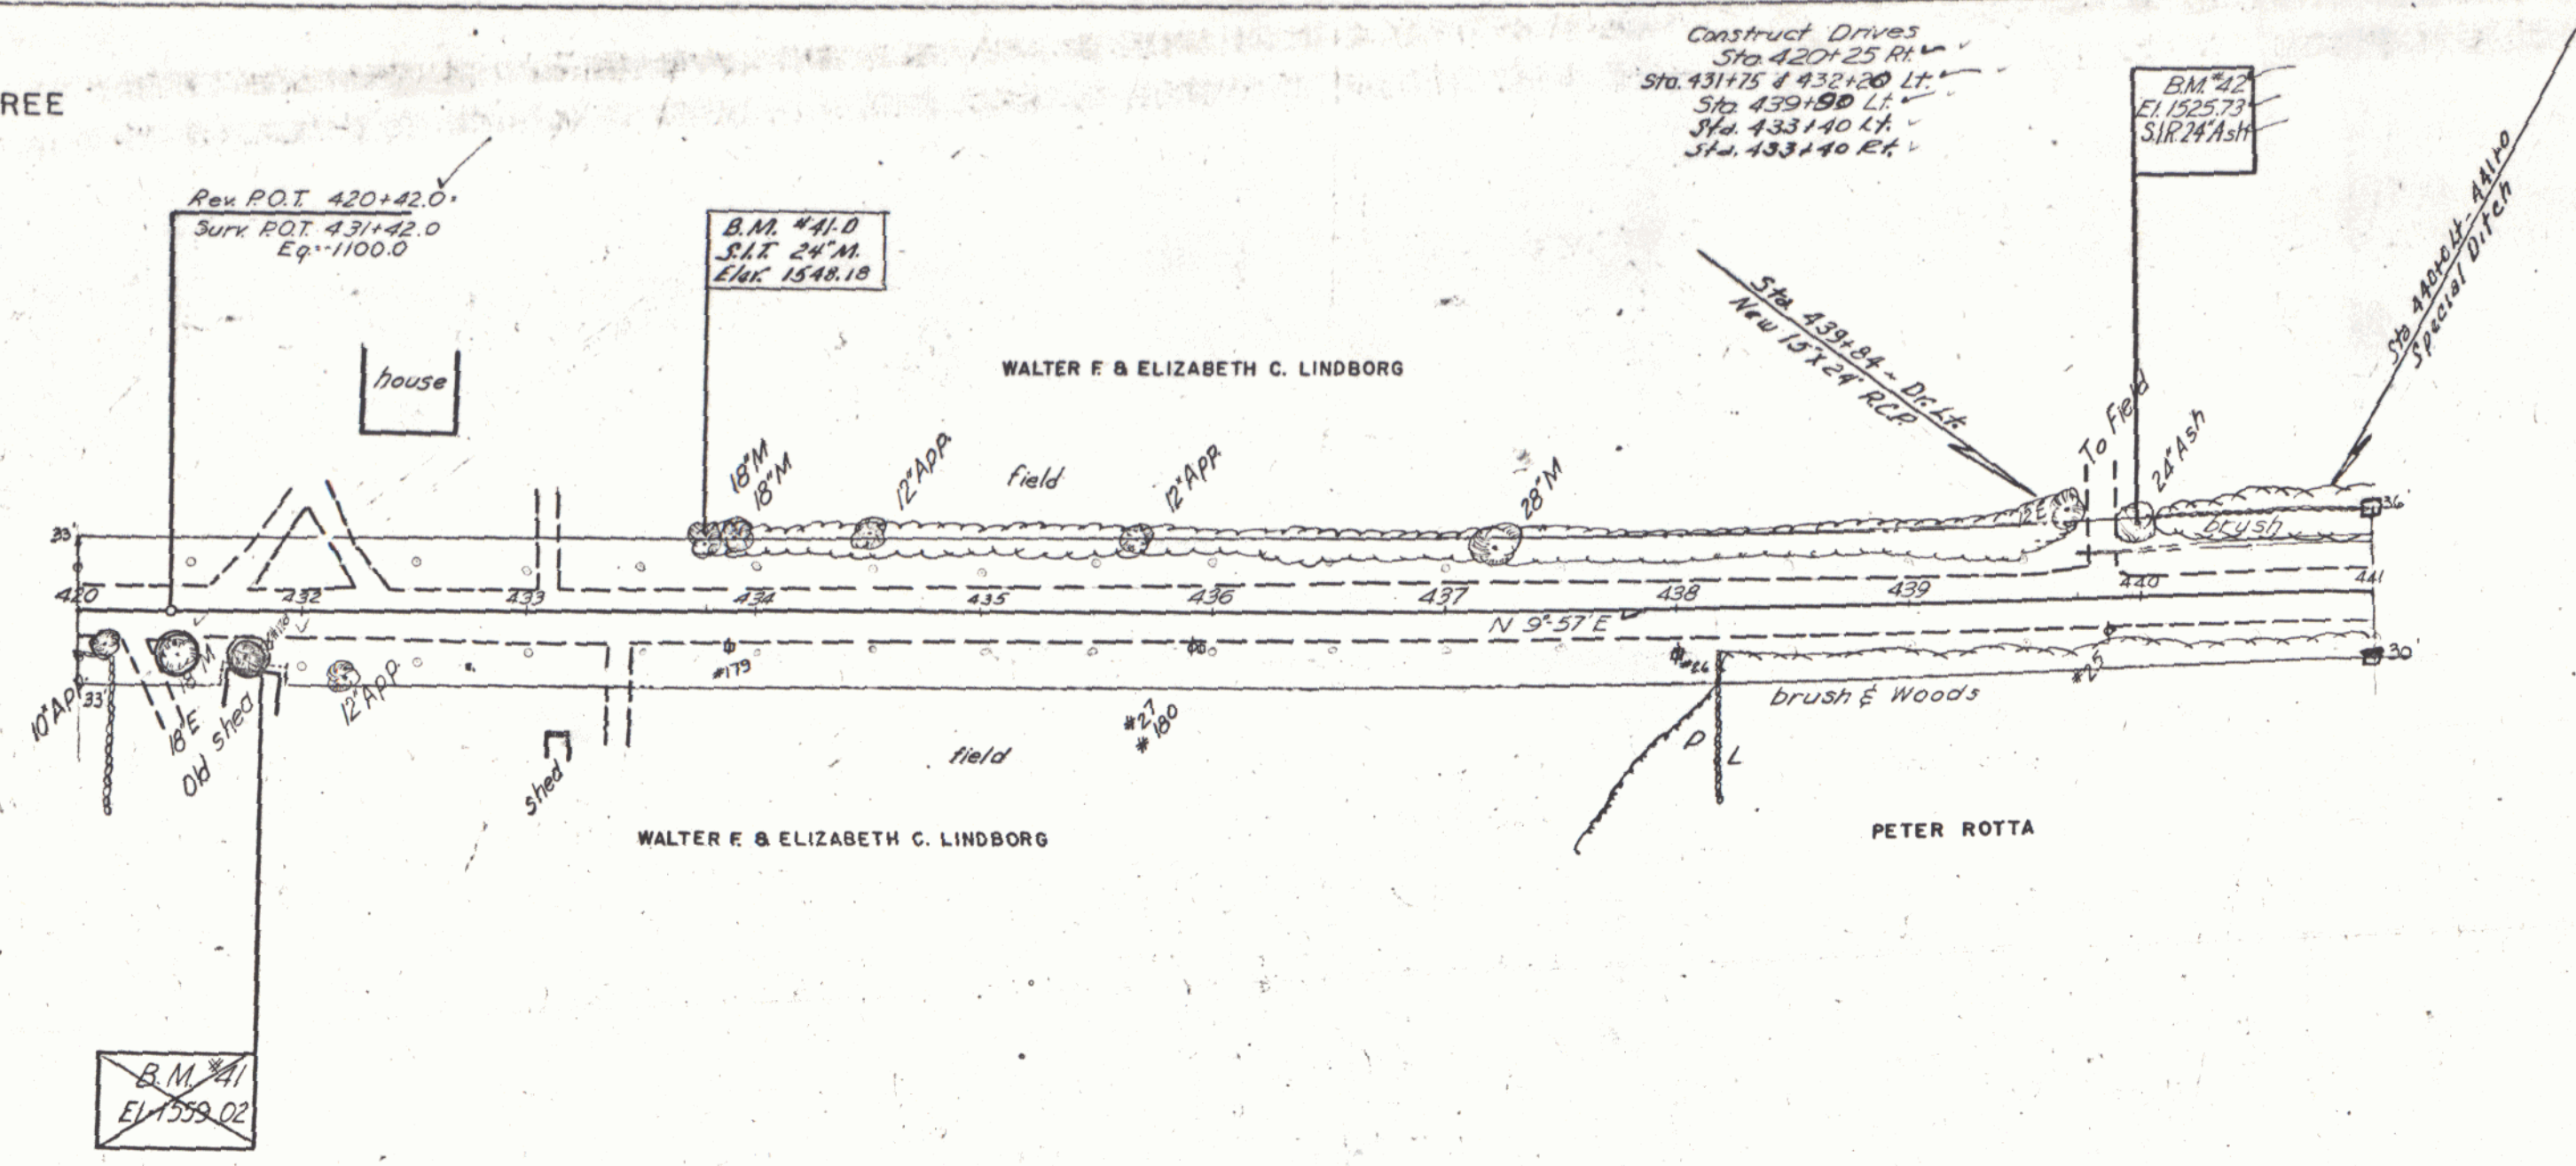

B.M. #41 S.I.R. 18' M, 26' L, Sta. 420+00, EL. 1559.02
 B.M. #42 S.I.R. 24' Ash, 34' L, Sta. 440+00, EL. 1525.73
 B.M. #41-D, S.I.T. 24' Maple 35' L, Sta. 433+80, EL. 1548.18


C. & R. TREE
ITEM 110

WALTER F. & ELIZABETH C. LINDBORG

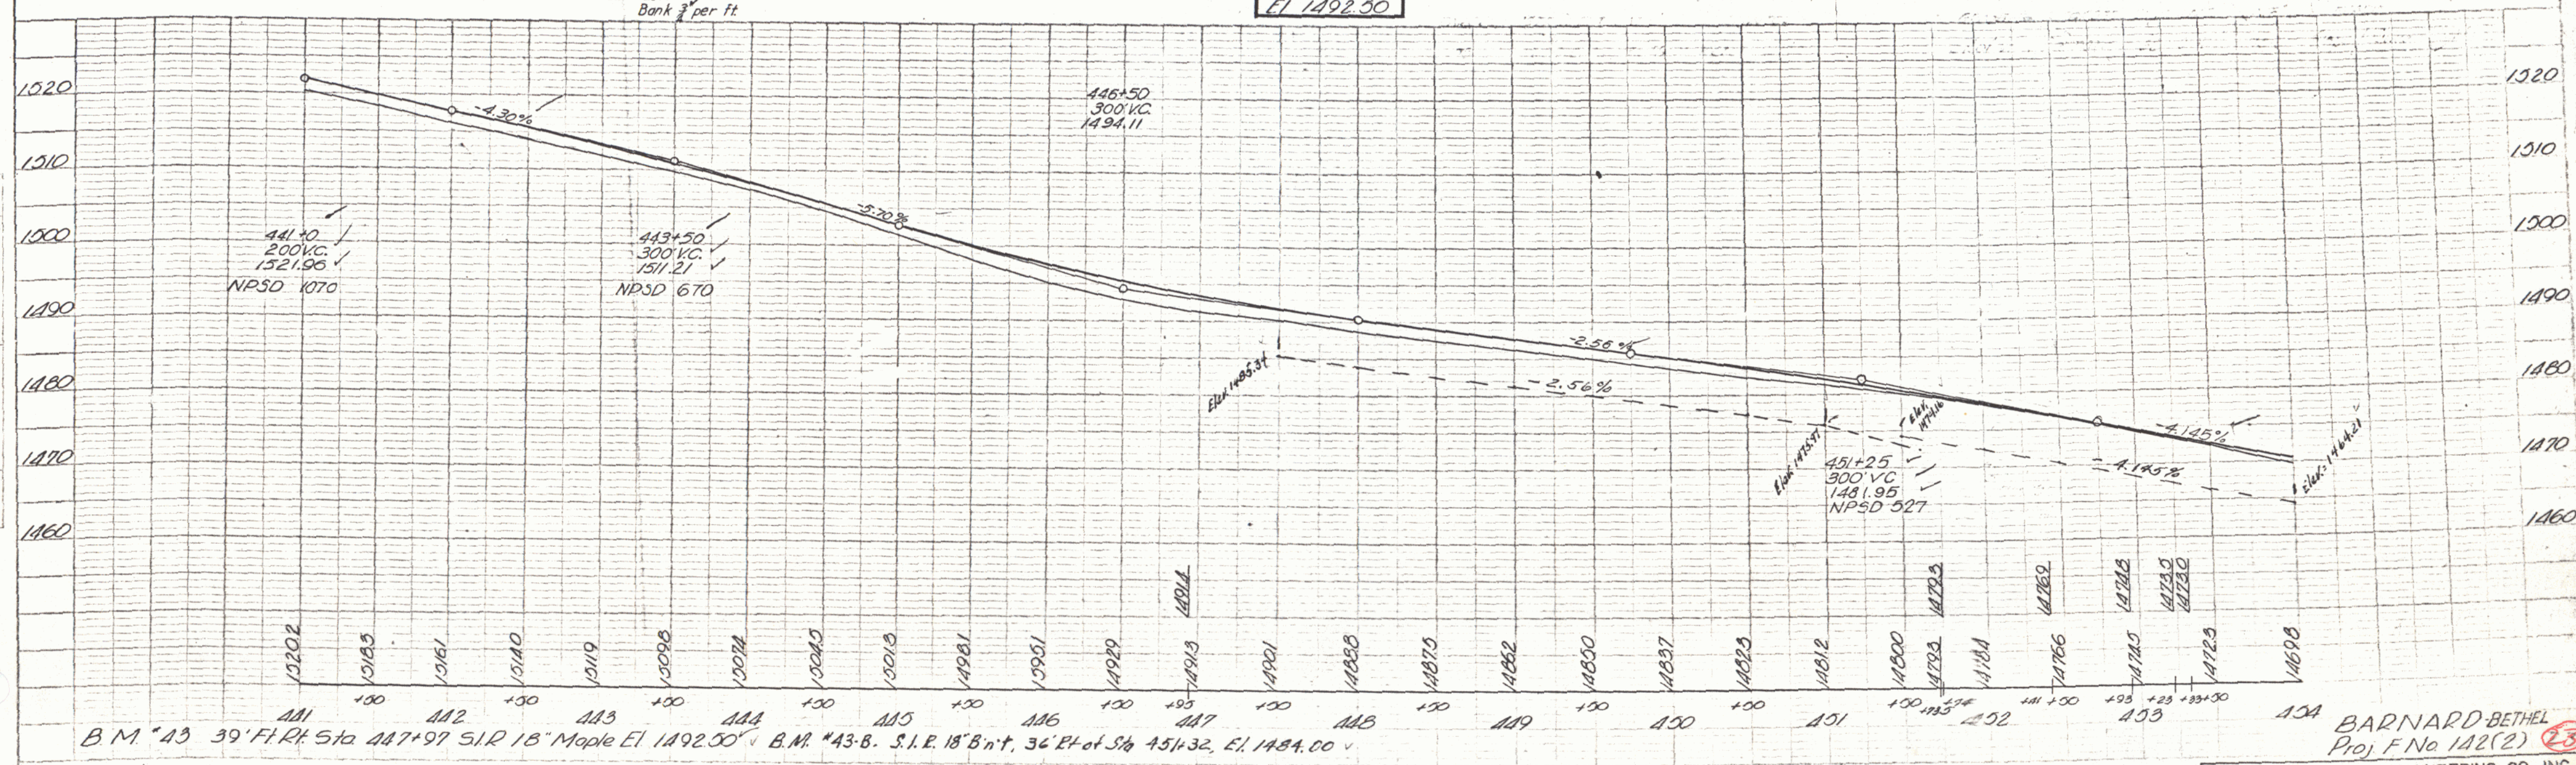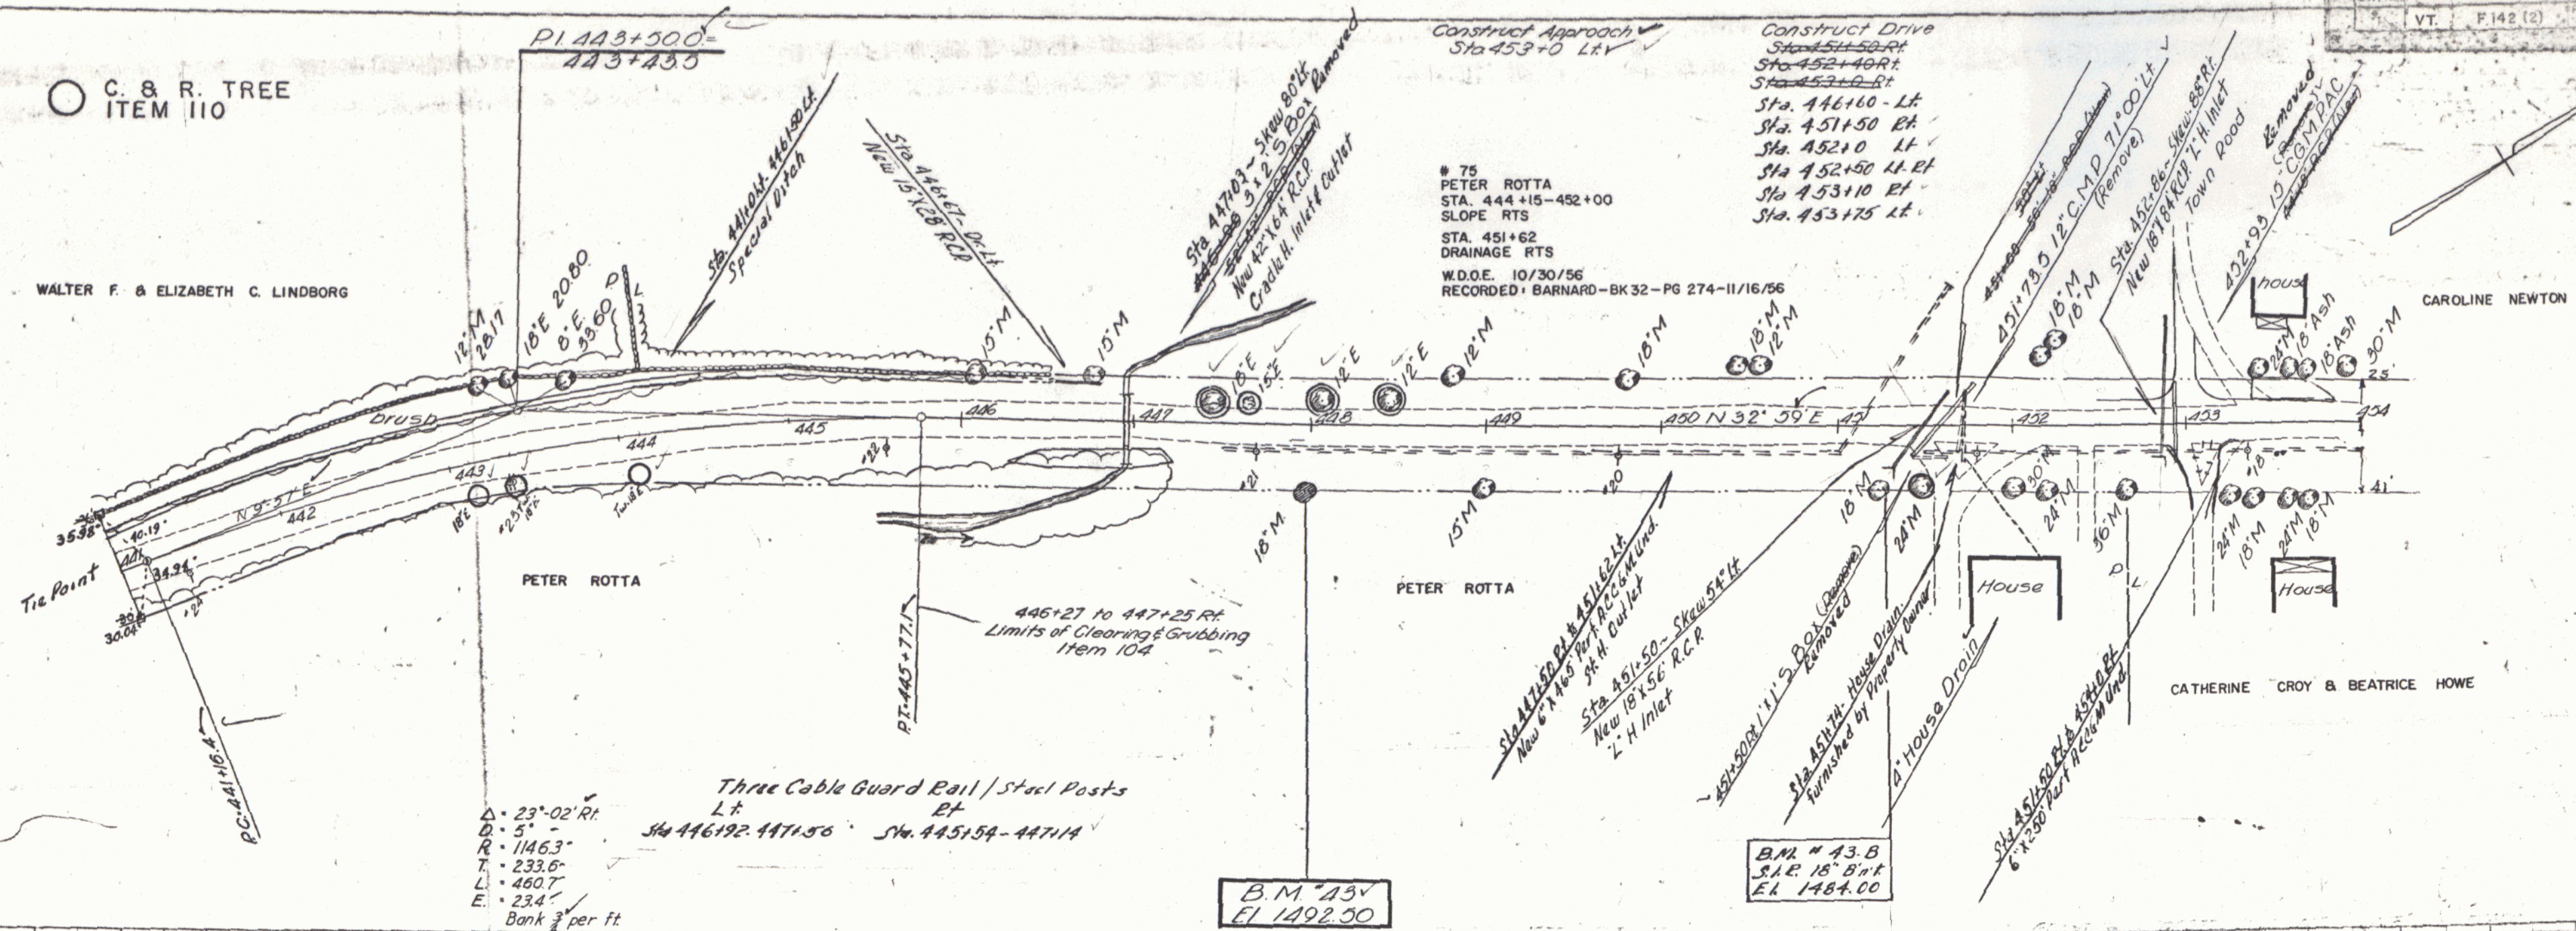

PLAN	SURVEYED	BY	DATE
NOTE BOOK	PLOTTED	<i>Spyking</i>	<i>9-29</i>
NO.	ALIGNMENT CHECKED	<i>Palmer</i>	<i>3-52</i>
	RT. OF WAY CHECKED	<i>Z.W. Esper</i>	<i>11-53</i>
		<i>Palmer</i>	<i>3-52</i>

9-00	Spaulding	SURVIVED
3-53	Palmer	PLOTTED
1-54	Guest	GRADES CHECKED
3-05	Palmer	R. M.'S NOTED
		STRUCTURE NOTATIONS CHECKED

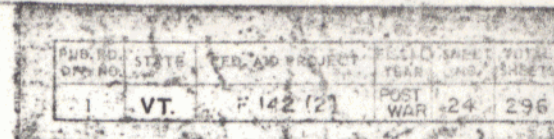

BARNARD-BETHEL
Proj. F No. 142(2) 24

THE CLARKESON ENGINEERING CO., INC.
CONSULTING ENGINEERS

BOSTON MASSACHUSETTS

○ C. & R. TREE
ITEM 110

CHARLES & MARIE W. VISCHER

LOUISE GIBBS ABBOTT

HAZEL S. BOGEN

LEILA B. ABBOTT

EDWARD H. & LULU DOUGLASS



TOWN OF BARNARD CEMETERY

40
OSCAR A. & ALICE L. CHARLAND
STA. 466+10
CULVERT RIGHT
COND. 9/17/54
RECORDED: BARNARD-BK 31-PG 479/495-9/17/54
Deeded to Edward G. Everett 2, Hockanook, N.J.
Deed Dated Sept. 30, 1955

Plank Guard Rail

Δ • 9'-17" Lt
D • 1'-45"
R • 3274.2
T • 265.8
L • 530.5
E • 10.7
Bank 1/2 per ft

Construct Drives
LT
Sta 465+74
Sta 466+140
Sta 466+184
Sta 469+25
Sta 472+50
RT
Sta 466+50
Sta 471+85

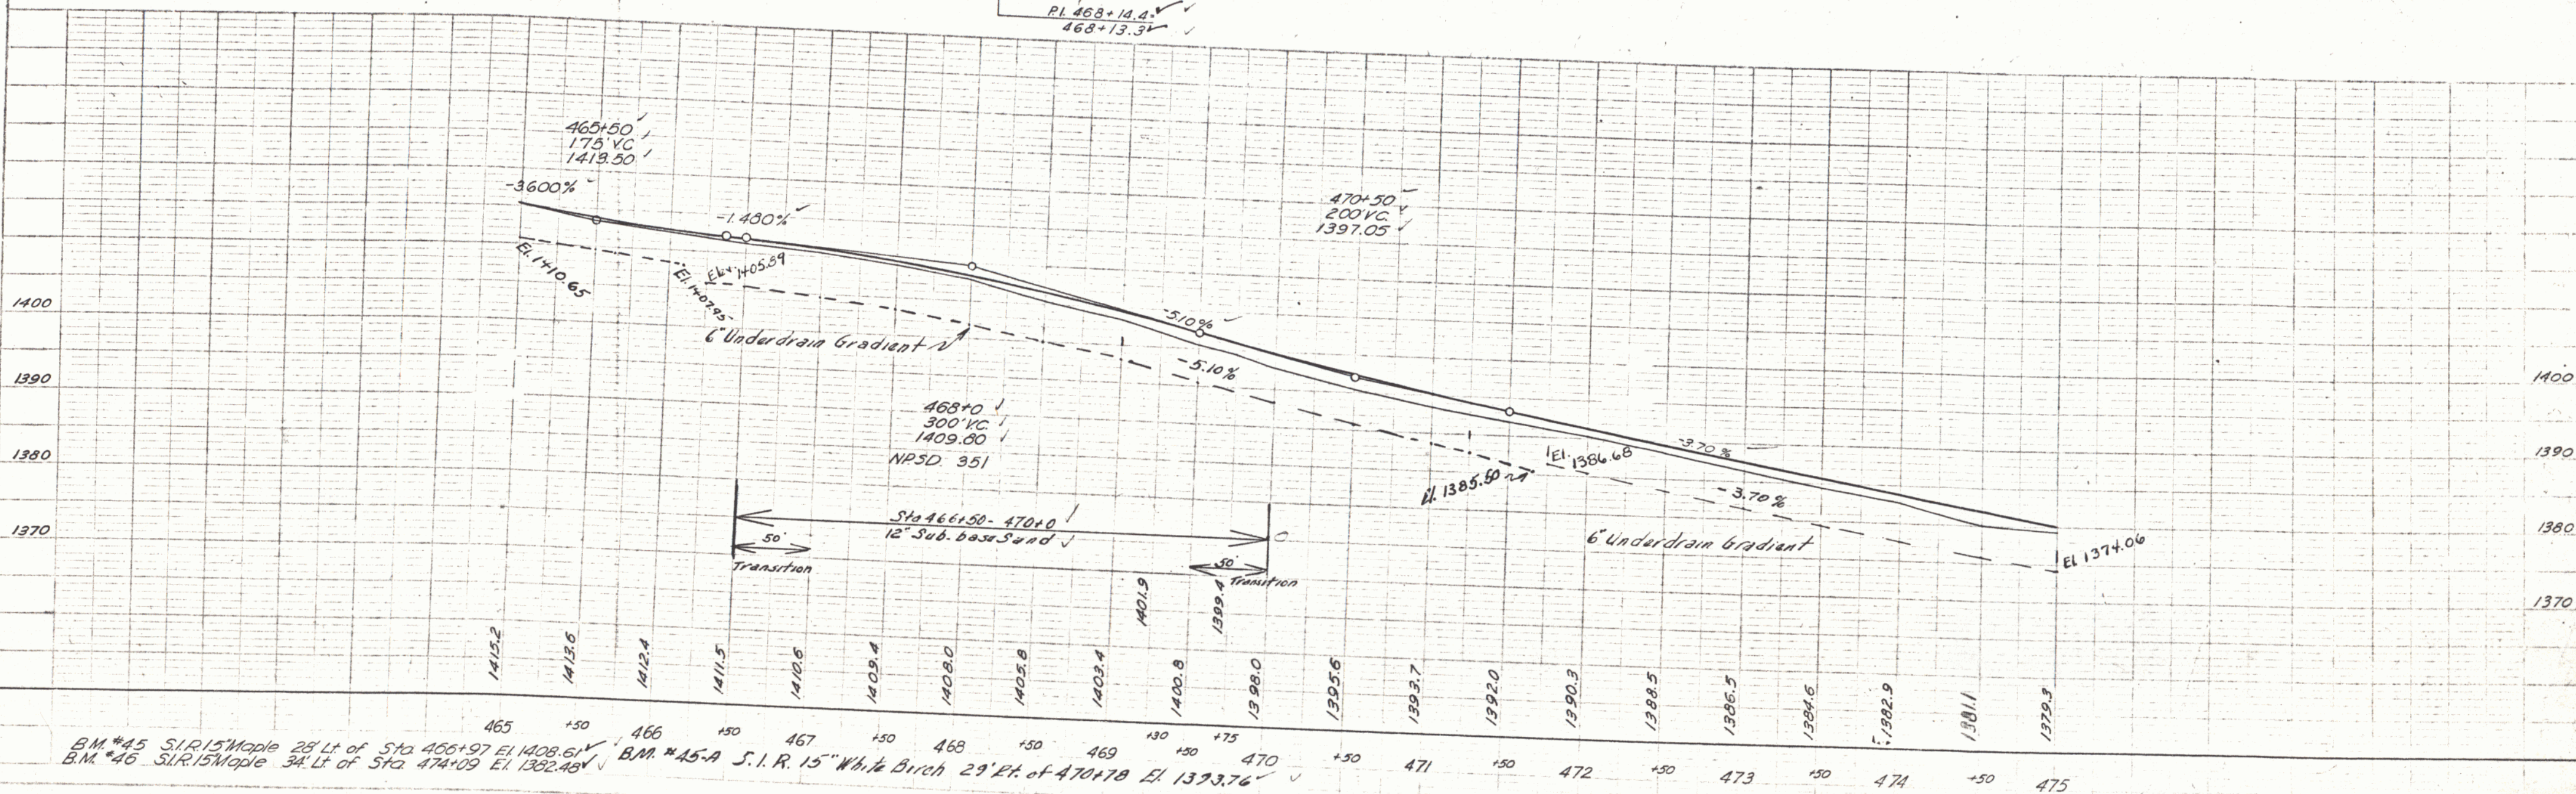
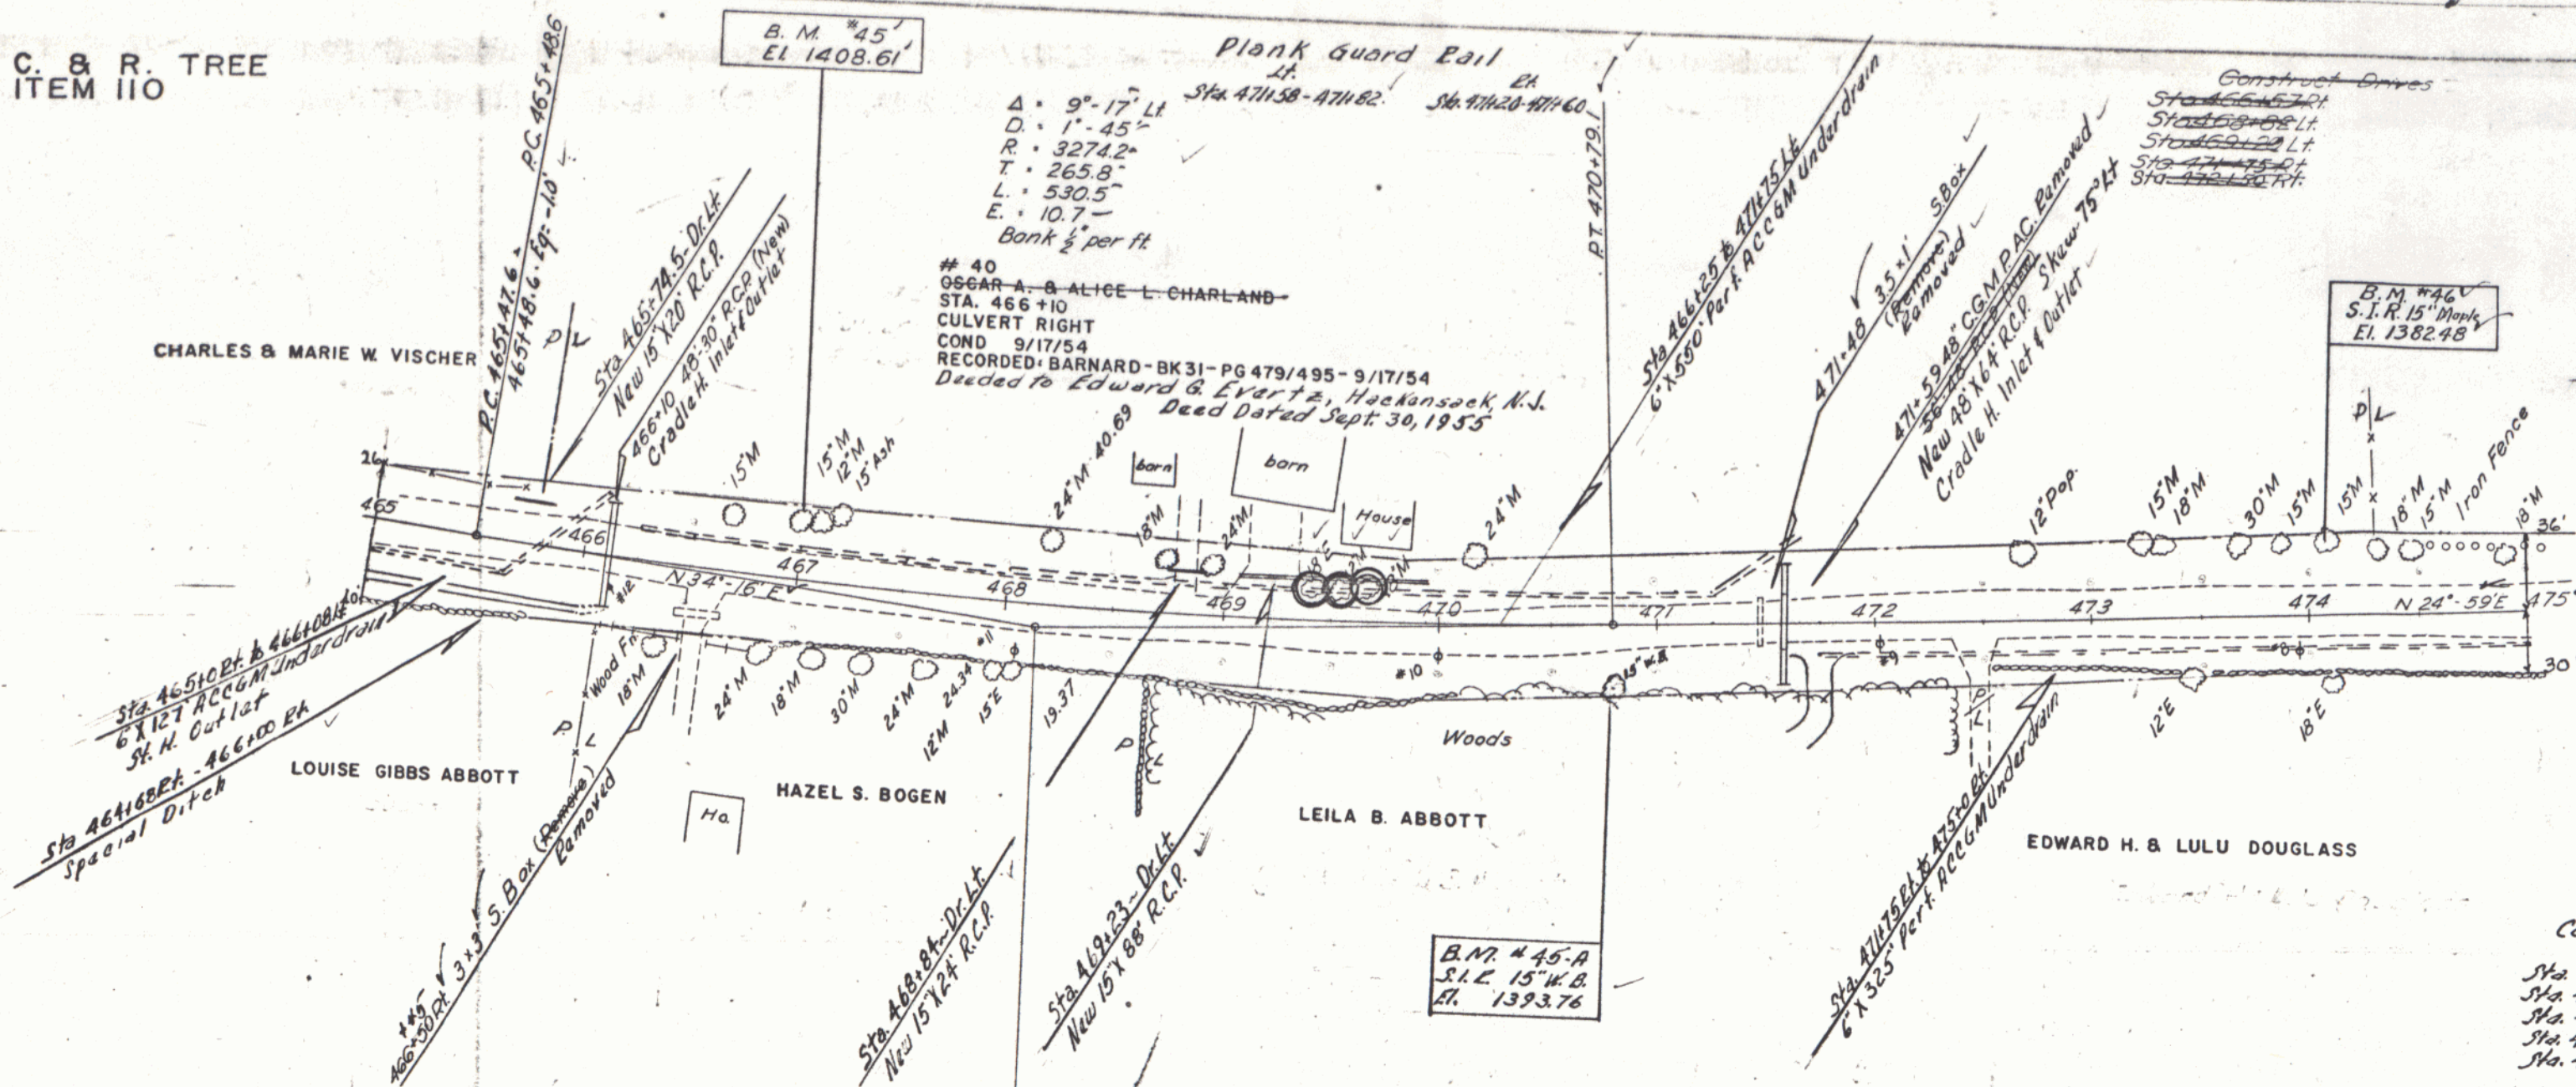


B.M. #45 S.I.R. 15" Maple 28' Lt. of Sta 466+97 El. 1408.61
B.M. #46 S.I.R. 15" Maple 34' Lt. of Sta 474+09 El. 1382.48
B.M. #45-A S.I.R. 15" White Birch 29' Lt. of 470+78 El. 1393.76

BARNARD-BETHEL

THE CLARKESON ENGINEERING CO., INC.
CONSULTING ENGINEERS
BOSTON MASSACHUSETTS

10-53	Spaulding	10-53
11-53	W.E. Spier	11-53
11-53	Z.W. Spier	11-53

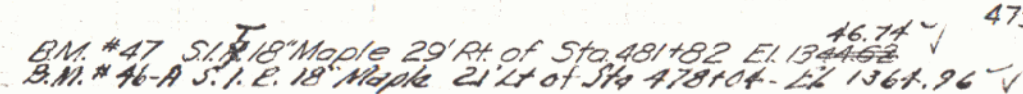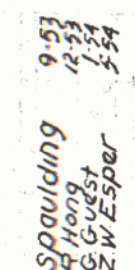

C. & R. TREE
ITEM 110

Three Cable Guard Rail
Sta 486+82-488+90

Construct Approaches
Sta 486+50-487+50 Rt
Sta 489+50 Lt

Construct Drives

Sta 483+25 Rt
Sta 483+96 Rt
Sta 488+50 Rt
Sta 490+75 Rt
Sta 491+17 Rt
Sta 492+90 Rt
Sta 483+35 Lt
Sta 484+80 Lt
Sta 489+20 Lt
Sta 489+50 Lt

Rev. Curve Data
Δ 77° 40' Lt
D 35'
R 143.7
T 131.8
L 221.9

Revised Curve Data
Δ 76° 10' Lt
D 35'
R 163.7
T 120.3
L 217.6
E 44.3
Bank 3/4 per ft
Hor. S.D. 13.5'

Construct Drives
Sta 483+40 Rt
Sta 483+50 Rt
Sta 483+60 Rt
Sta 483+70 Rt
Sta 483+80 Rt
Sta 483+90 Rt
Sta 484+00 Rt
Sta 484+10 Rt
Sta 484+20 Rt
Sta 484+30 Rt
Sta 484+40 Rt
Sta 484+50 Rt
Sta 484+60 Rt
Sta 484+70 Rt
Sta 484+80 Rt
Sta 484+90 Rt
Sta 485+00 Rt
Sta 485+10 Rt
Sta 485+20 Rt
Sta 485+30 Rt
Sta 485+40 Rt
Sta 485+50 Rt
Sta 485+60 Rt
Sta 485+70 Rt
Sta 485+80 Rt
Sta 485+90 Rt
Sta 486+00 Rt
Sta 486+10 Rt
Sta 486+20 Rt
Sta 486+30 Rt
Sta 486+40 Rt
Sta 486+50 Rt
Sta 486+60 Rt
Sta 486+70 Rt
Sta 486+80 Rt
Sta 486+90 Rt
Sta 487+00 Rt
Sta 487+10 Rt
Sta 487+20 Rt
Sta 487+30 Rt
Sta 487+40 Rt
Sta 487+50 Rt
Sta 487+60 Rt
Sta 487+70 Rt
Sta 487+80 Rt
Sta 487+90 Rt
Sta 488+00 Rt
Sta 488+10 Rt
Sta 488+20 Rt
Sta 488+30 Rt
Sta 488+40 Rt
Sta 488+50 Rt
Sta 488+60 Rt
Sta 488+70 Rt
Sta 488+80 Rt
Sta 488+90 Rt
Sta 489+00 Rt
Sta 489+10 Rt
Sta 489+20 Rt
Sta 489+30 Rt
Sta 489+40 Rt
Sta 489+50 Rt
Sta 489+60 Rt
Sta 489+70 Rt
Sta 489+80 Rt
Sta 489+90 Rt
Sta 490+00 Rt
Sta 490+10 Rt
Sta 490+20 Rt
Sta 490+30 Rt
Sta 490+40 Rt
Sta 490+50 Rt
Sta 490+60 Rt
Sta 490+70 Rt
Sta 490+80 Rt
Sta 490+90 Rt
Sta 491+00 Rt
Sta 491+10 Rt
Sta 491+20 Rt
Sta 491+30 Rt
Sta 491+40 Rt
Sta 491+50 Rt
Sta 491+60 Rt
Sta 497+50 Rt
Sta 497+60 Rt
Sta 497+70 Rt
Sta 497+80 Rt
Sta 497+90 Rt
Sta 498+00 Rt
Sta 498+10 Rt
Sta 498+20 Rt
Sta 498+30 Rt
Sta 498+40 Rt
Sta 498+50 Rt
Sta 498+60 Rt
Sta 498+70 Rt
Sta 498+80 Rt
Sta 498+90 Rt
Sta 499+00 Rt
Sta 499+10 Rt
Sta 499+20 Rt
Sta 499+30 Rt
Sta 499+40 Rt
Sta 499+50 Rt
Sta 499+60 Rt
Sta 499+70 Rt
Sta 499+80 Rt
Sta 499+90 Rt
Sta 500+00 Rt

Rev. P.I. 491+63.3
491+40.7

B.M. #49
STR 36" M
Elev 1293.58

GLADYS WILSON BUNDY

EDWARD F. & EDITH H. WARD


UNIVERSALIST SOCIETY

BESSIE E. HOWE & LENA E. WESTINGHOUSE

JOHN KEDRIC THAYER

Revised Curve Data
Δ 41° 35' Rt
D 9'
R 632.3
T 241.4
L 461.1
E 44.1
Bank 3/4 per ft
Hor. S.D. 315'

Rev. Curve Data
Δ 43° 00' Rt
D 9' 30"
R 603.1
T 237.6
L 452.6
E 45.1

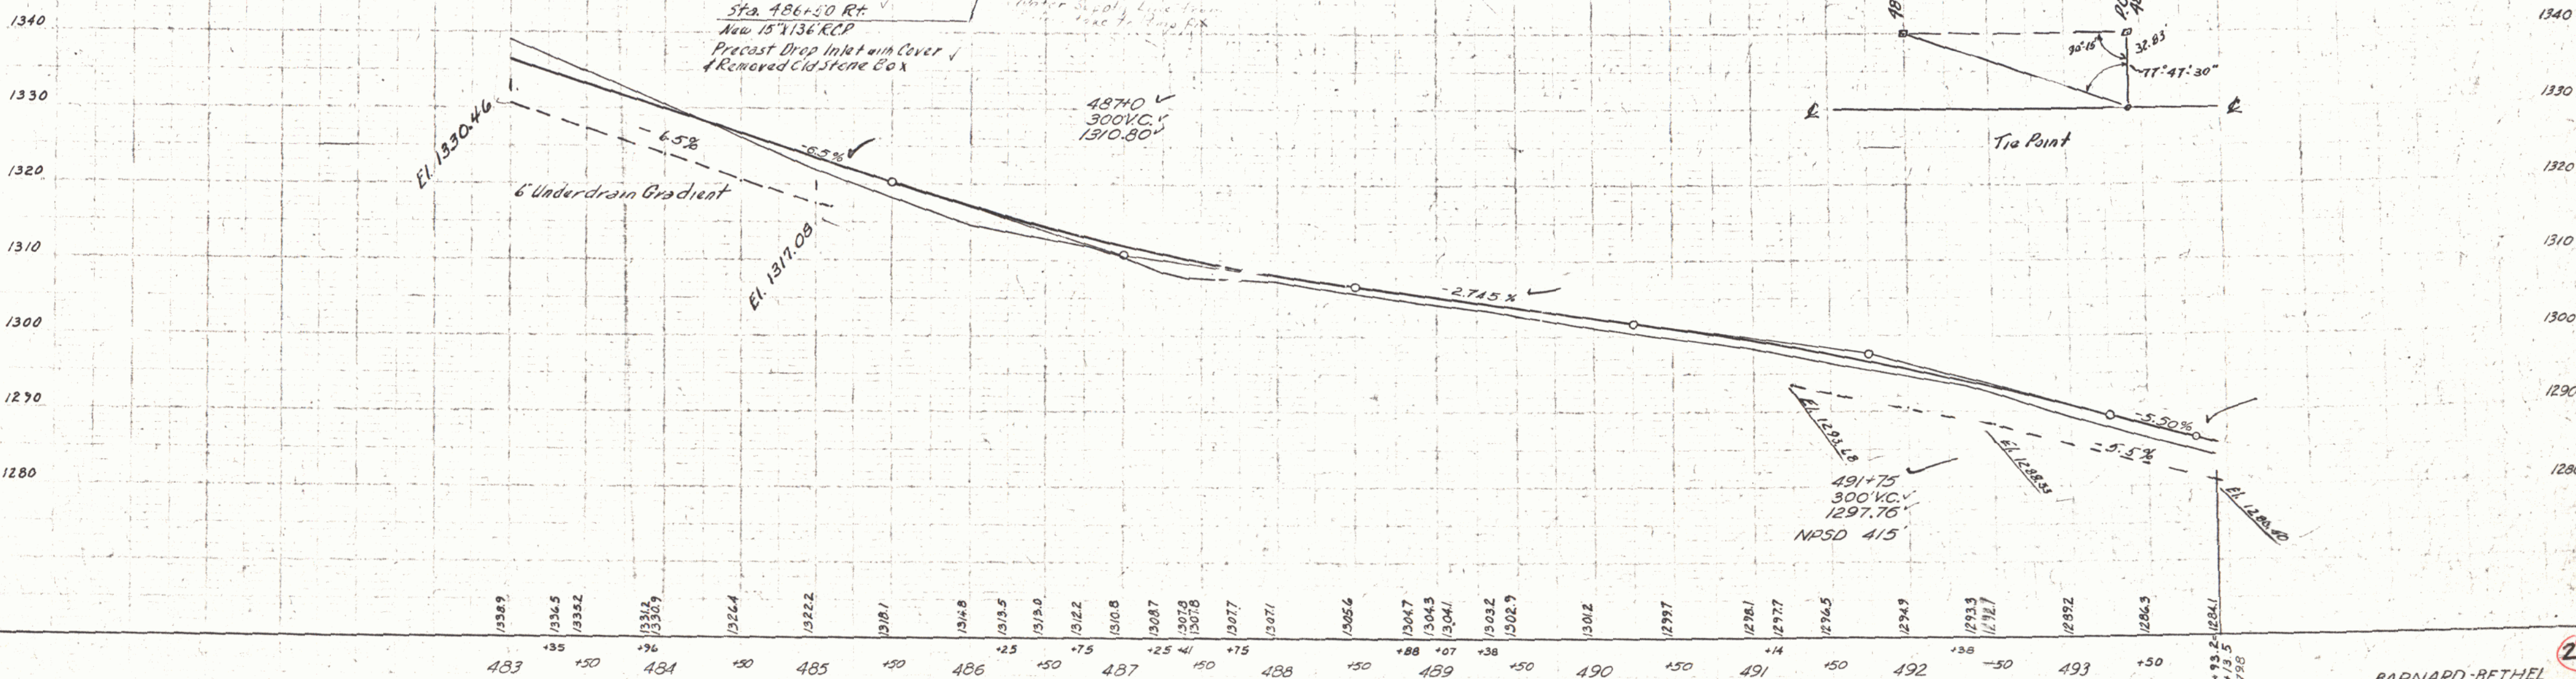

B.M. #48 Spot on Conc Steps 40' Rt of Sta 485+21 El. 1315.65
B.M. #49 S.I.P. 36" Maple 32' Lt of Sta 492+58 El. 1293.58
B.M. #48-B S.I.T. 18" Maple 28' Lt Sta 489+70 El. 1306.79



BARNARD-BETHEL

THE CLARKSON ENGINEERING CO., INC.
CONSULTING ENGINEERS
BOSTON MASSACHUSETTS



27

DATE	
BY	
PROJECT	
NOTE BOOK	
NO.	

DATE	
BY	
PROJECT	
NOTE BOOK	
NO.	

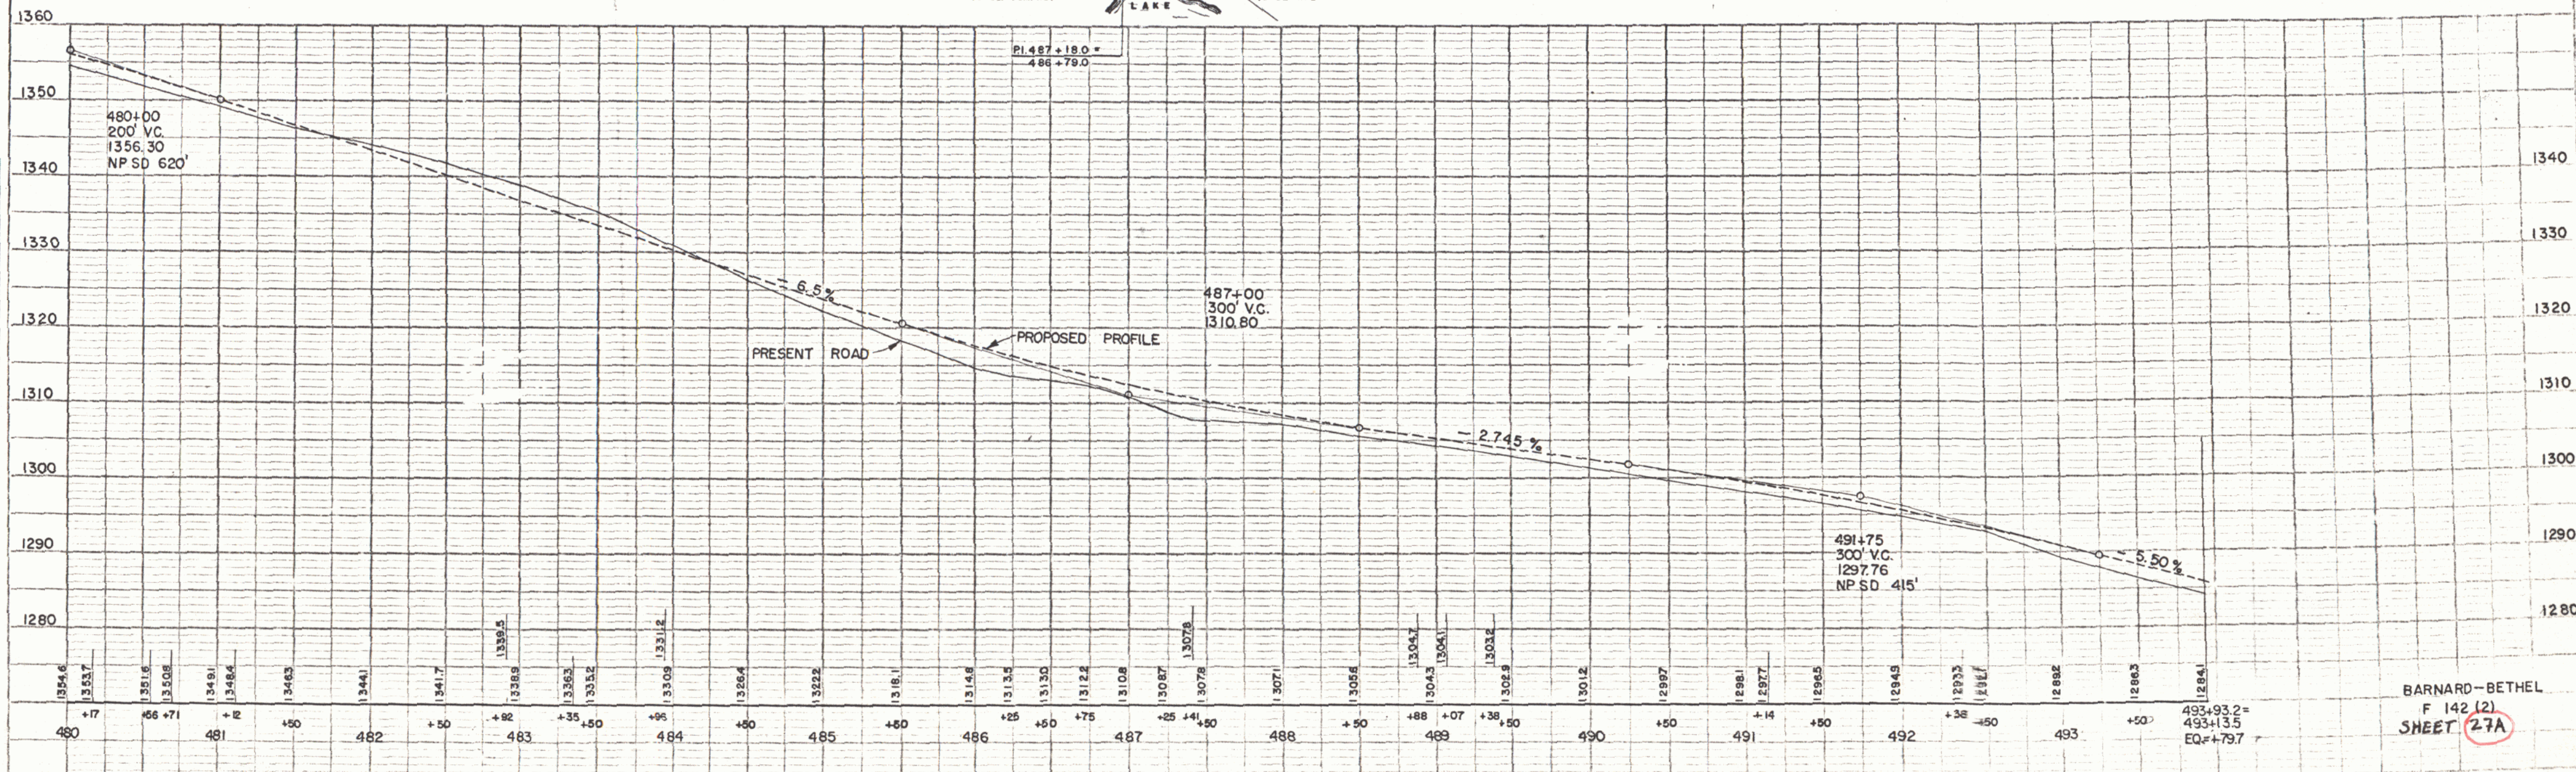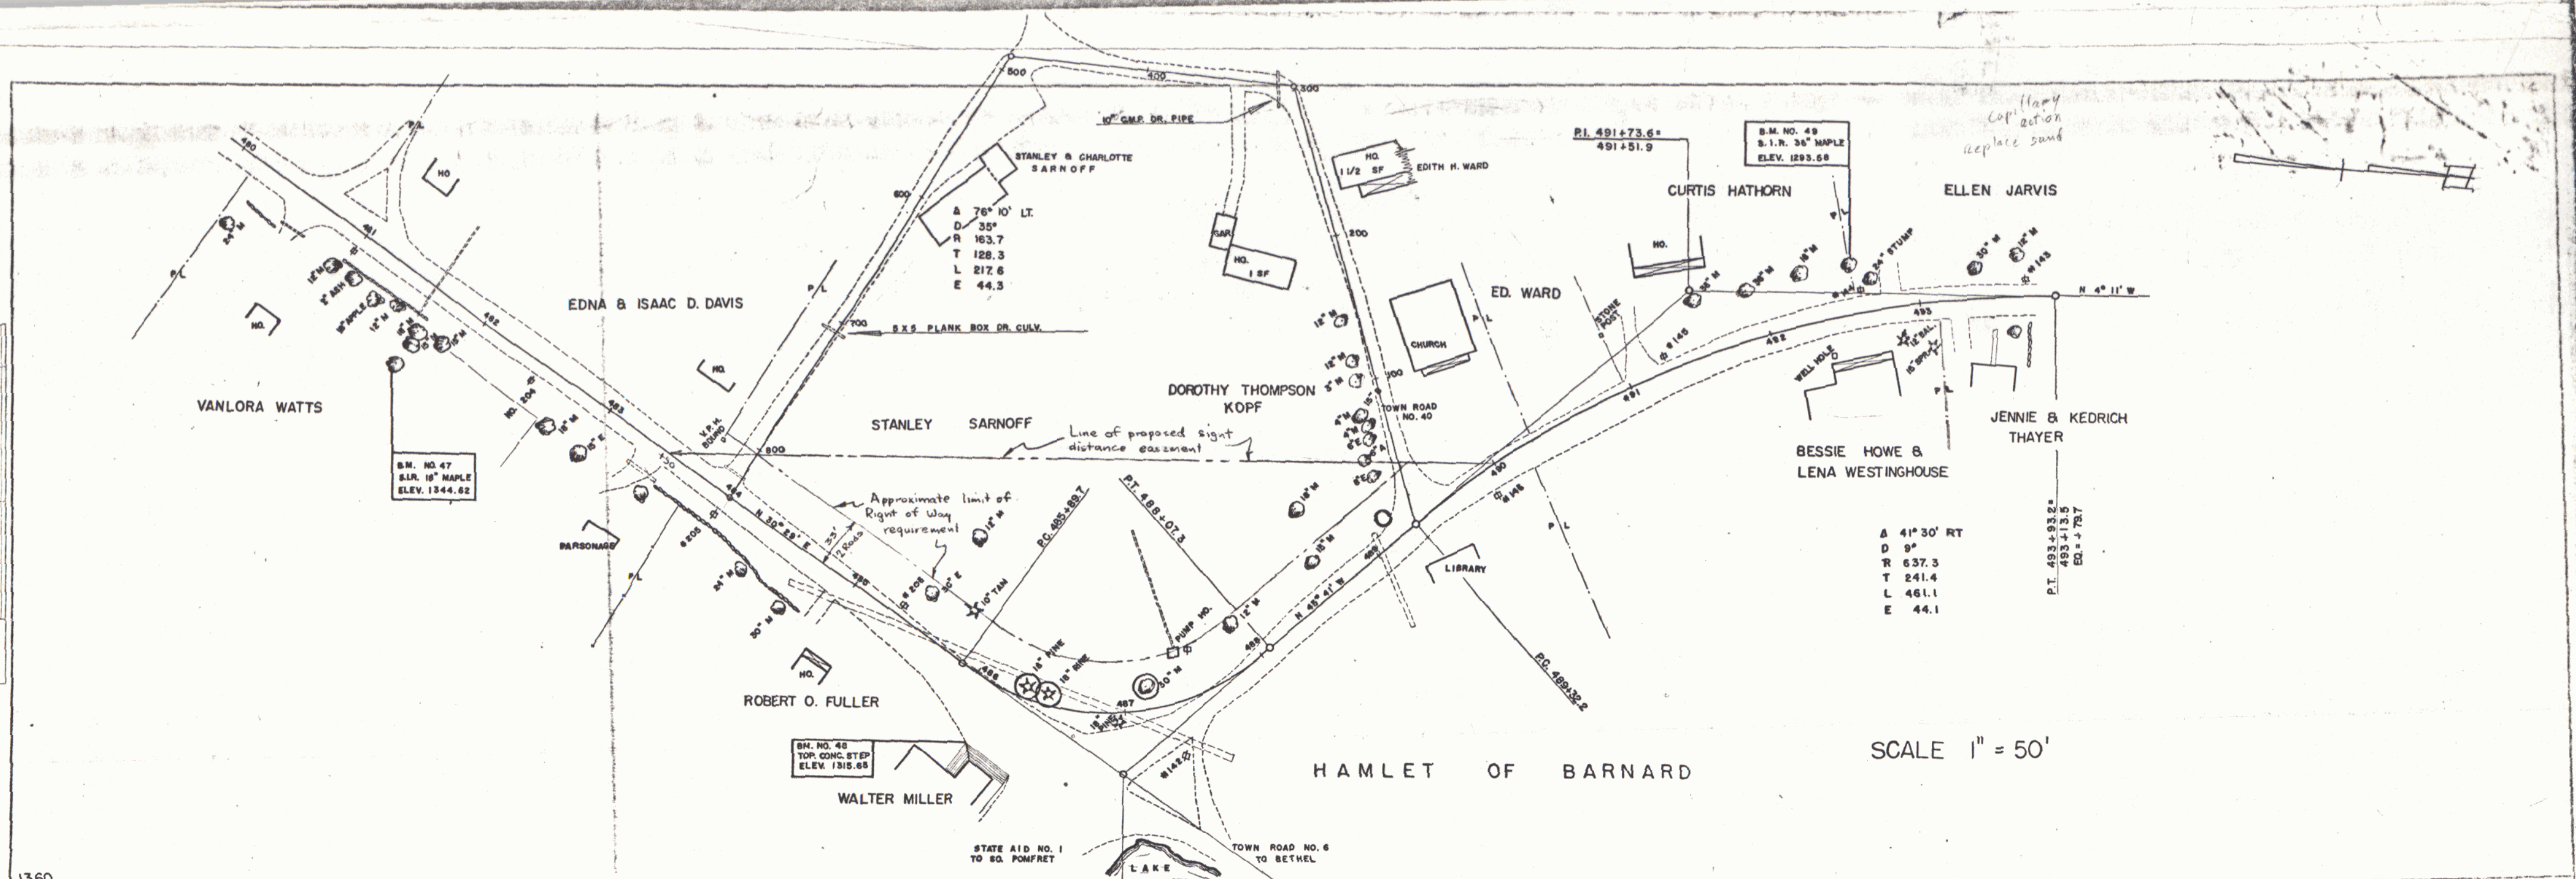


BARNARD-BETHEL
F 142 (2)
SHEET 27A

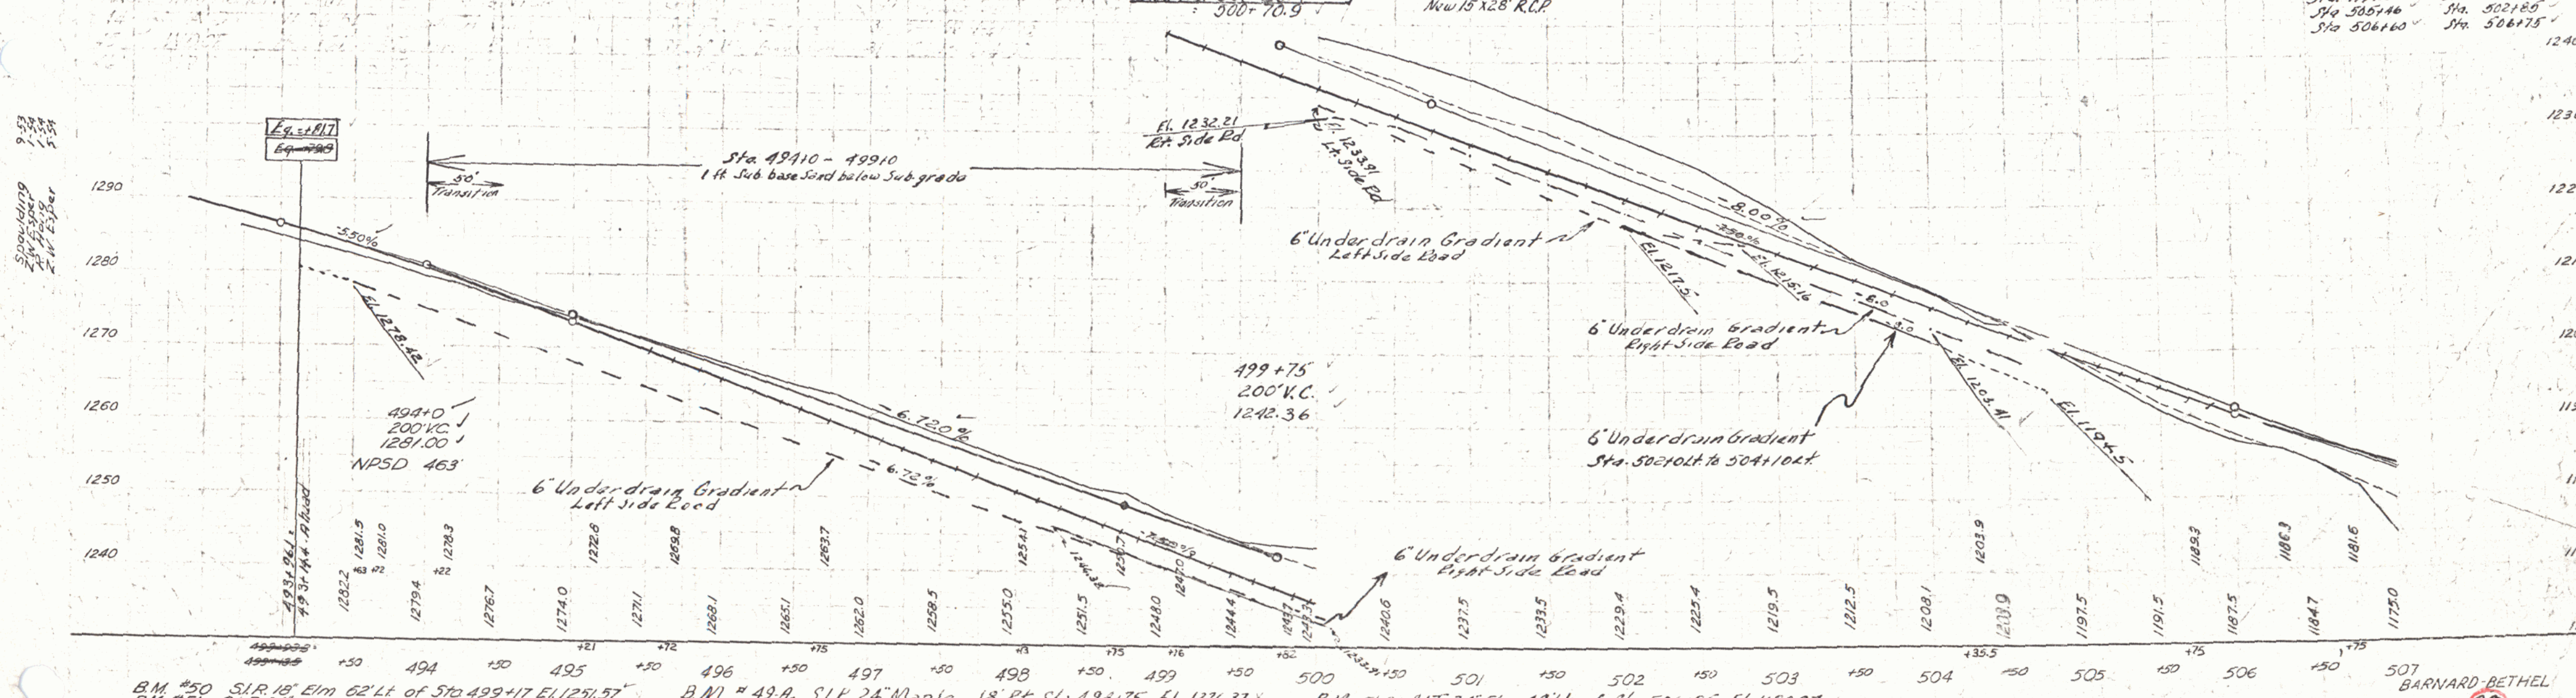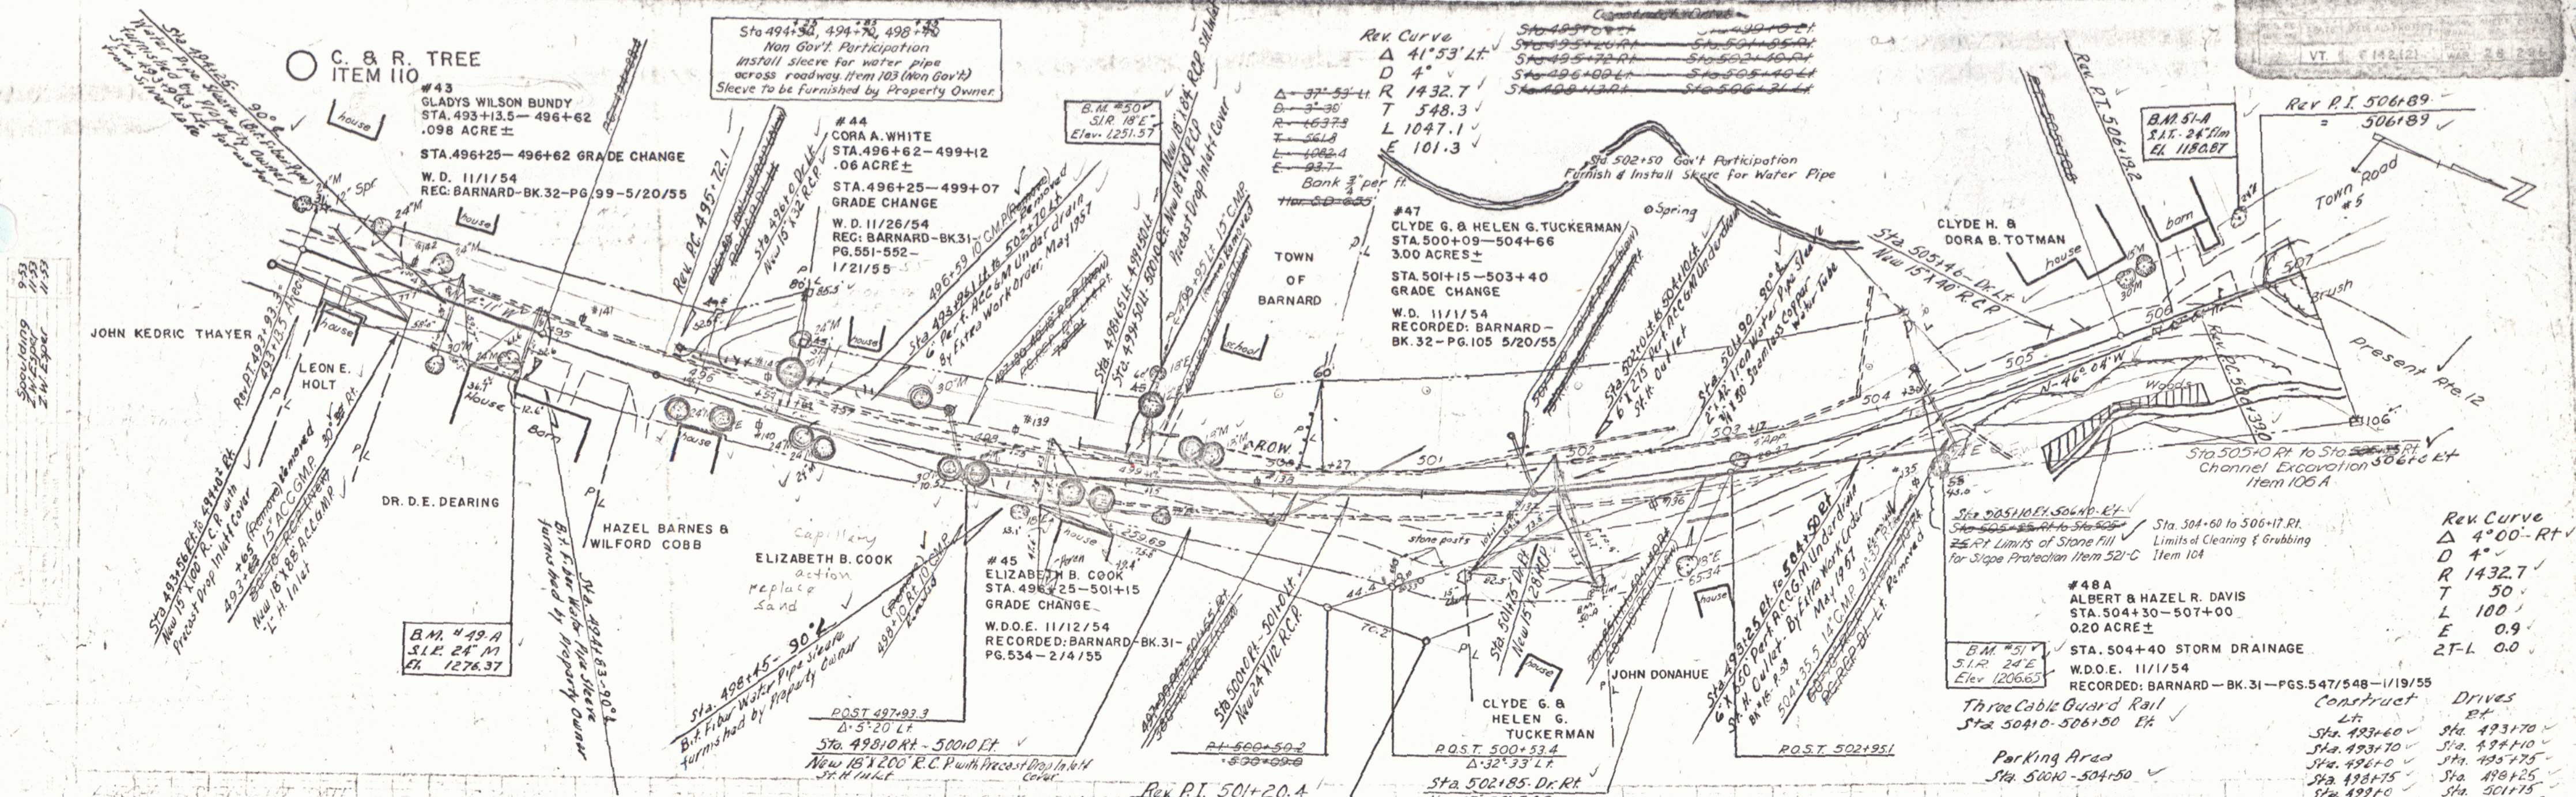

THE CLARKESON ENGINEERING CO., INC.
CONSULTING ENGINEERS
BOSTON MASSACHUSETTS

28

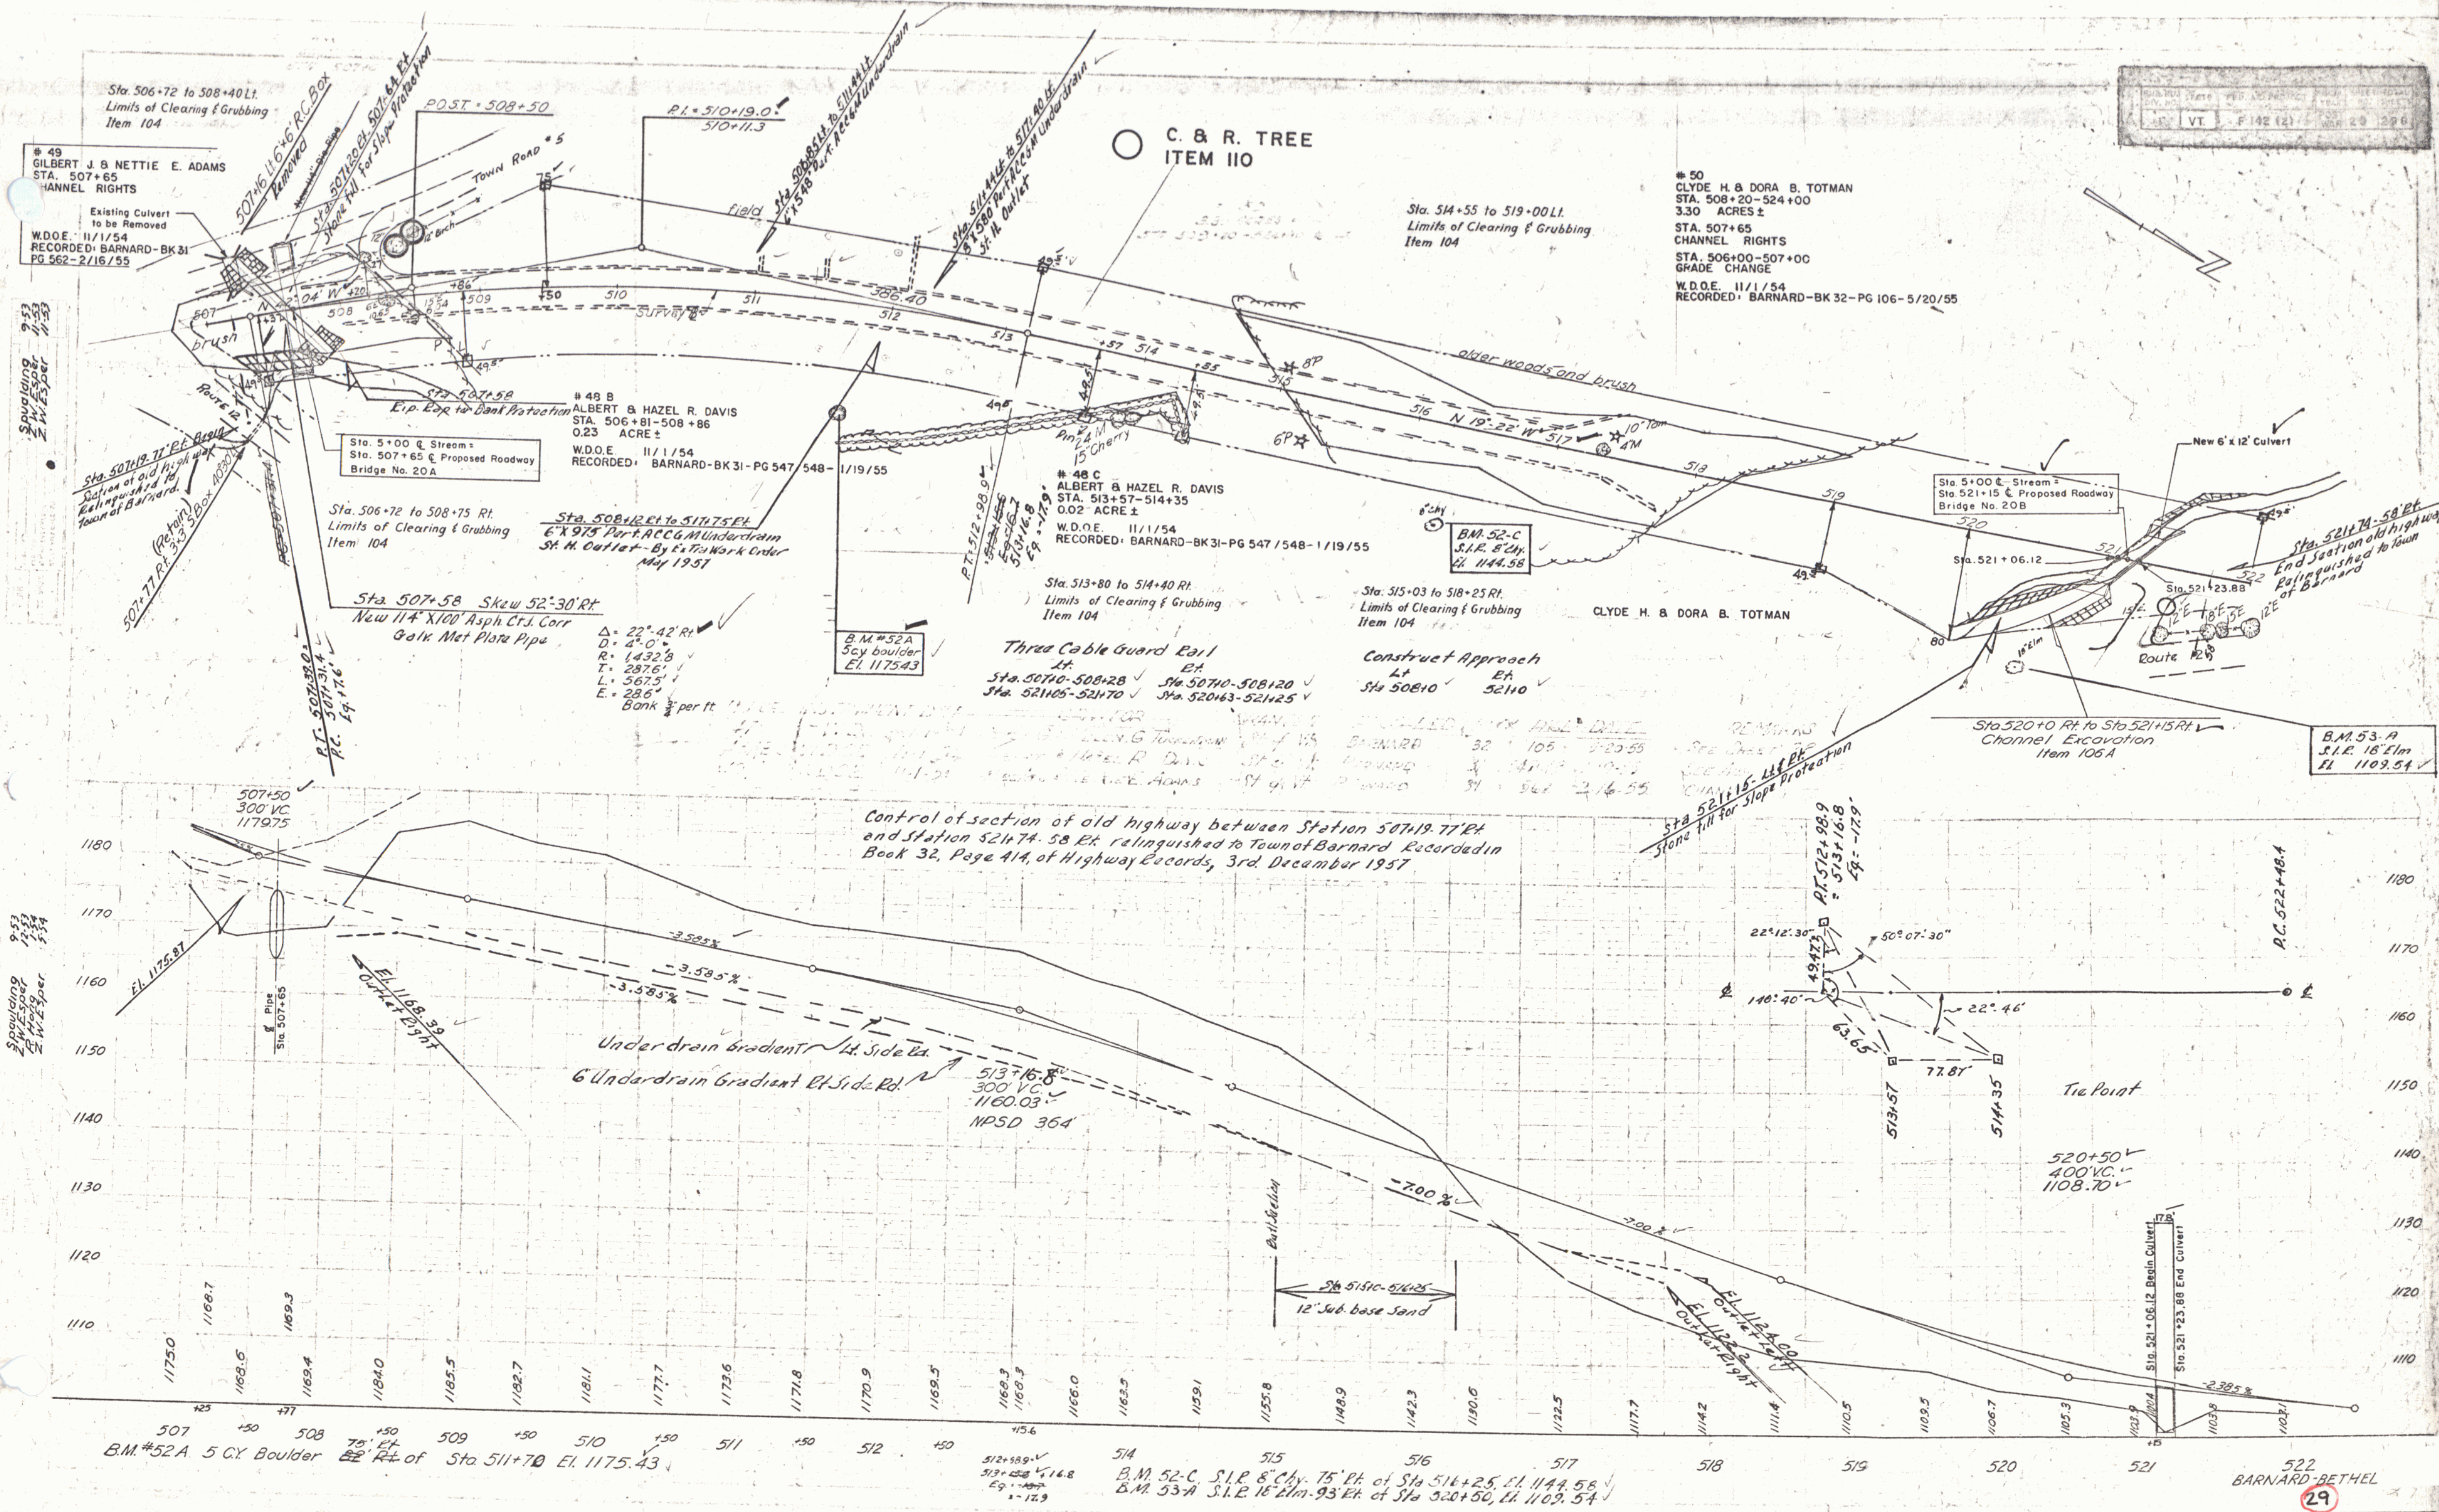

VT F 142 (2) JAN 29 1966

PLAN	SURVEYED	BY	DATE
NOTE BOOK	PLOTTED	Spaulding	9-53
NO.	ALIGNMENT CHECKED	Z.W.E.S.P.R.	11-53
	RT. OF WAY CHECKED	Z.W.E.S.P.R.	11-53

51 A
WALLACE & MARIE DE GIACOMO
STA. 529 +50 - 533+00
0.26 ACRE ±
STA. 530 +25 - 532+25
CHANNEL RTS.
W.D.O.E. 11/15/54
RECORDED: BARNARD-BK 32- PG 113- 5/20/55

FILE NO.	PROJECT	LOCAL	STATUS
DIV. NO.			
VT.	F 342 (2)	WAR	30 29E

B.M. 53-B
S.L.T. 18" M
E.L. 109912

FRED E. & HULDAH B. ALLEN

Sta. 524+00 to 525+30 Rt.
Limits of Clearing & Grubbing
Item 104


$$\begin{array}{r} P.1. 524 + 63.5 \\ \hline 524 + 63.3 \\ \\ P.1. 524 + 45.2 \\ \hline 524 + 44.9 \end{array}$$

B.M. #54 ✓
S.I.R 10° E
Elev. = 1086.35

WALLACE & MARIE DE GIACOMO

Sta. 530+75 to 532+25 Lt.
Limits of Clearing & Grubbing
Item 104

Spaulding	9-53
Z.W. Esper	12-53
Z. Hong	1-54
Z.W. Esper	5-54

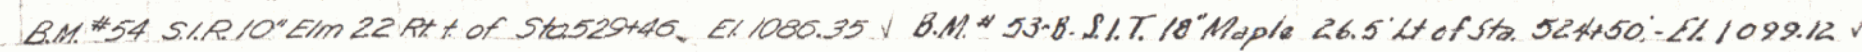

BARNARD-BETHEL

THE CLARKESON ENGINEERING CO., INC.
CONSULTING ENGINEERS
BOSTON MASSACHUSETTS

17

51 B
WALLACE & MARIE DE GIACOMO
STA. 536+50-544+00
1.24 ACRES ±
STA. 546+00
CULVERT RIGHTS
W.D.O.E. 11/15/54
RECORDED: BARNARD-BK32-PG 11

Sta. 537+26 Lt ✓
 Slope fill for Slope Protection
 of Channel Enc. Earth ✓

Sta. 5+00 @ Stream =
Sta. 537+18 @ Proposed Roadway
Bridge No. 21

Sta. 537 + 11.15 ✓

B.M. 54-B
S.I.R. 36° E
El. 1060.4

~~Rev. Curve Data
Δ: 18° 40' Rt.
D: 5' 15"
R: 1091.73
T: 179.43
L: 355.68
E: 14.65~~

~~Surv. Curve Data
Δ. 18° 40' Rt.
D. 7° 0'
R. 819.0
T. 134.6
L. 266.7
E. 11.0
Backsight 2°~~

Bar Curve Data

Δ	19° 02' Rt. ✓
D	6° ✓
E	955.4 ✓
T	160.2 ✓
L	317.2 ✓
E	13.3 ✓

Sta. 538+50 ~ 90' ✓
New 18" x 48" A.C.C.M.P.
5.4 Inlet

2.T. 539197.4
 Pot. 539196.8
 Eq. = +0.6

WALLACE & MARIE DE GIACOMO

~~Construct Drives~~
~~Sta 522+40 Rk.~~
~~Sta 533+80 Lt.~~

Construct Drivas
Lt. Rt.
Sta. 533+60 ✓ Sta. 533+40 ✓
Sta. 537+60 ✓ Sta. 542+60 ✓

WALLACE & MARIE DE GIACOMO

Sta. 538+55 to 542+35 Lt.
Sta. 541+82 to 544+05 Lt.
Limits of Clearing & Grub-
bing. Item 104
Rev. P.I. = 544+42.5 ✓

Surv. Pl. = ~~544~~ - ~~50.0~~ .
~~544~~ - ~~49.7~~
 $\Delta 6^{\circ} 09' \text{ Rt.}$
 $D 2^{\circ}$
 B.M. 55
 S.L. 30.5

B.M. # 55-1-A
S.I.P. 18 Y.B.
E1. 1035.11

Three Cable Guard Rail / Steel Posts
 Lt. Et
 Sta. 535+78-537+54 ✓ Sta. 536+56-539+28 ✓
 Sta. 544-11-542+23 ✓

Parking Area. ✓
Lt.
Sta 54610-54710

Rev. Curve Data ✓
 Δ . 5°-51' ✓ Rt.
 D . 2°-02' ✓
 R . 2,864.9 ✓
 T . 146.4 ✓
 L . 292.5 ✓
 E . 3.7 ✓
 Bank $\frac{1}{2}$ Per ft



Rev. P. T. = 54.3

545+50 ✓
300' V.C. ✓
1035.57 ✓

547
BARNARD-BETHEL

○ C. & R. TREE
ITEM 110

WALLACE & MARIE DE GIACOMO

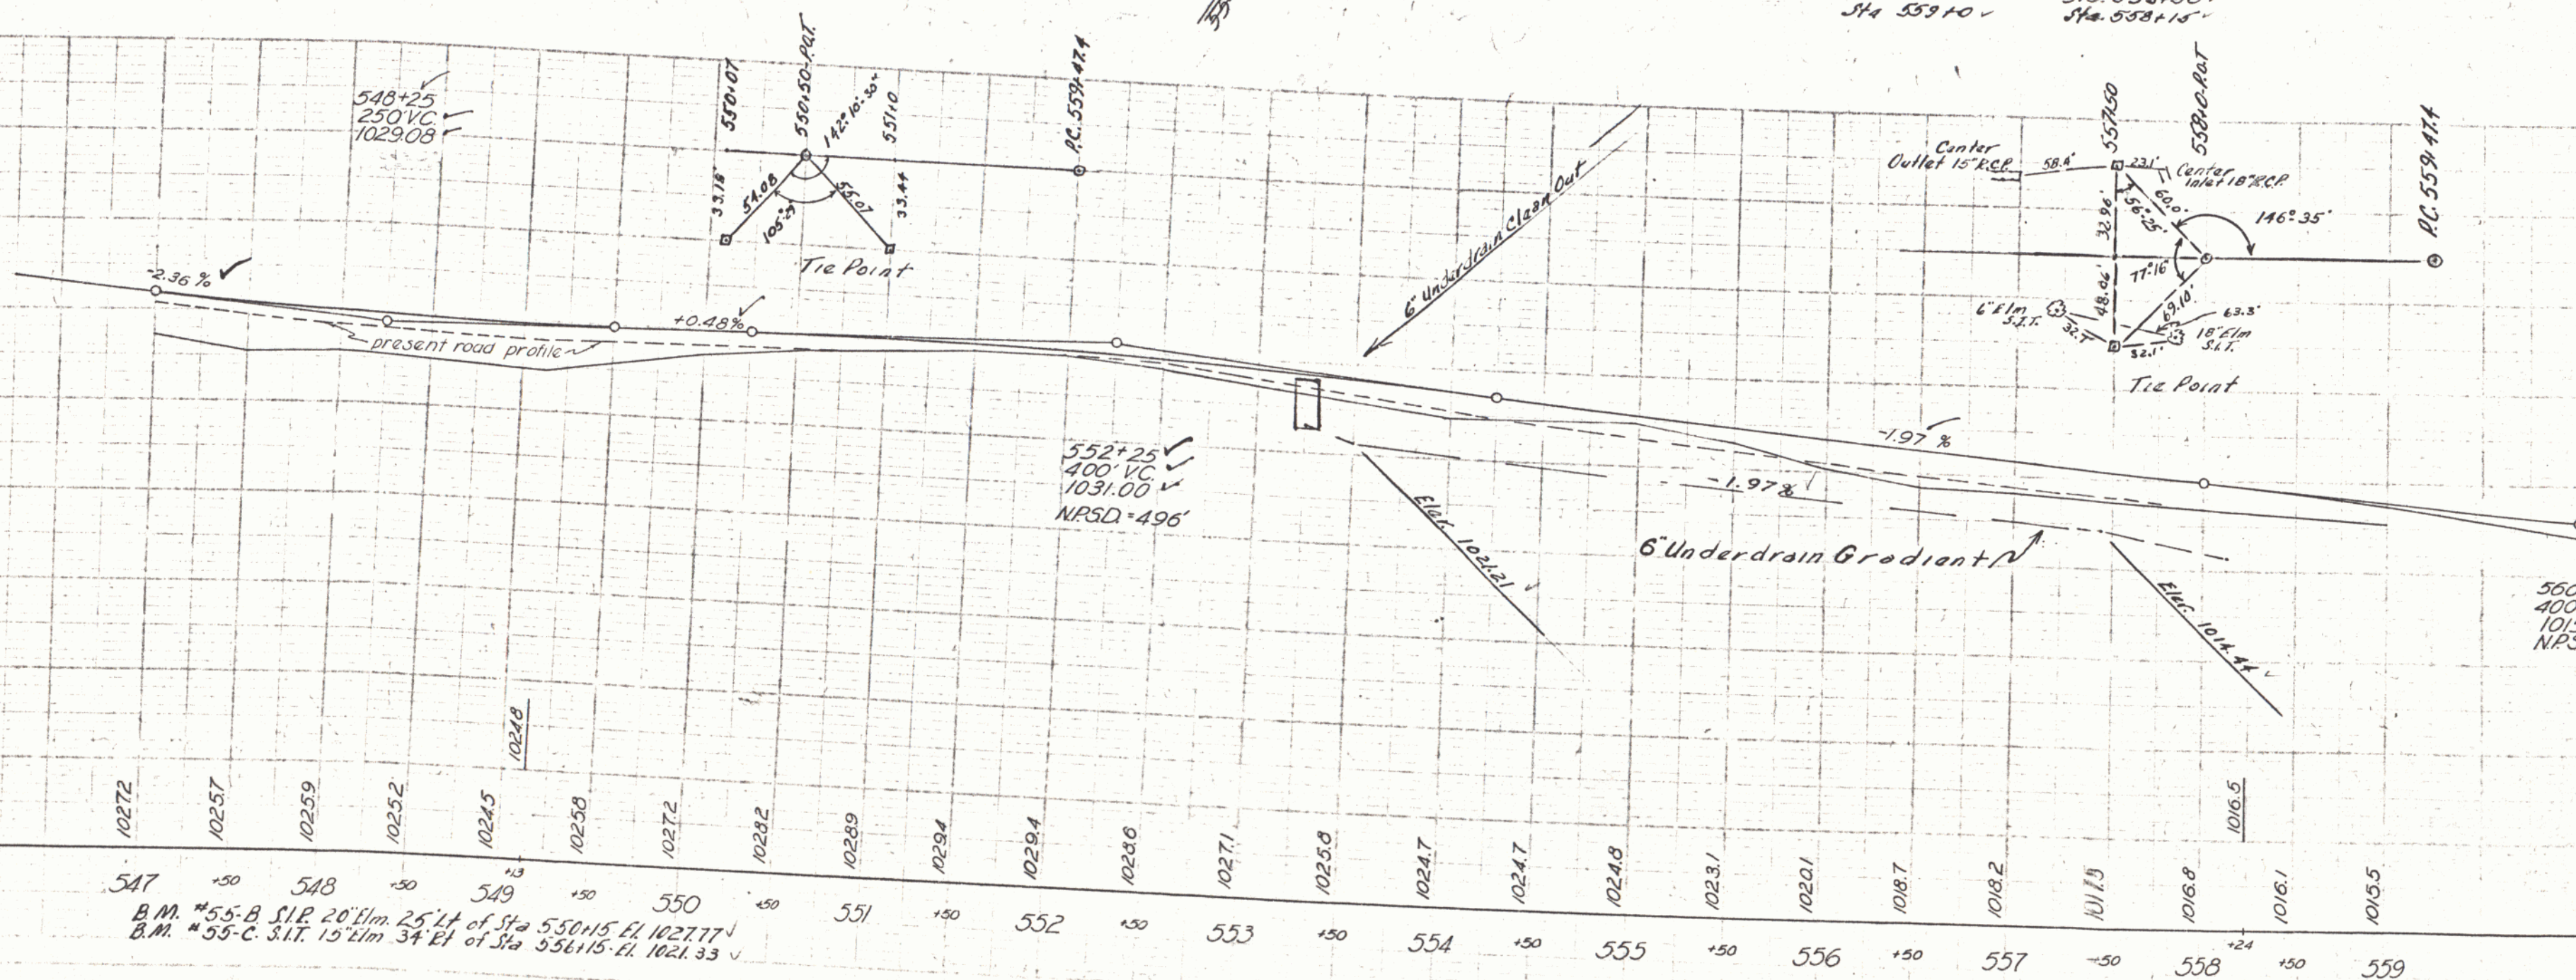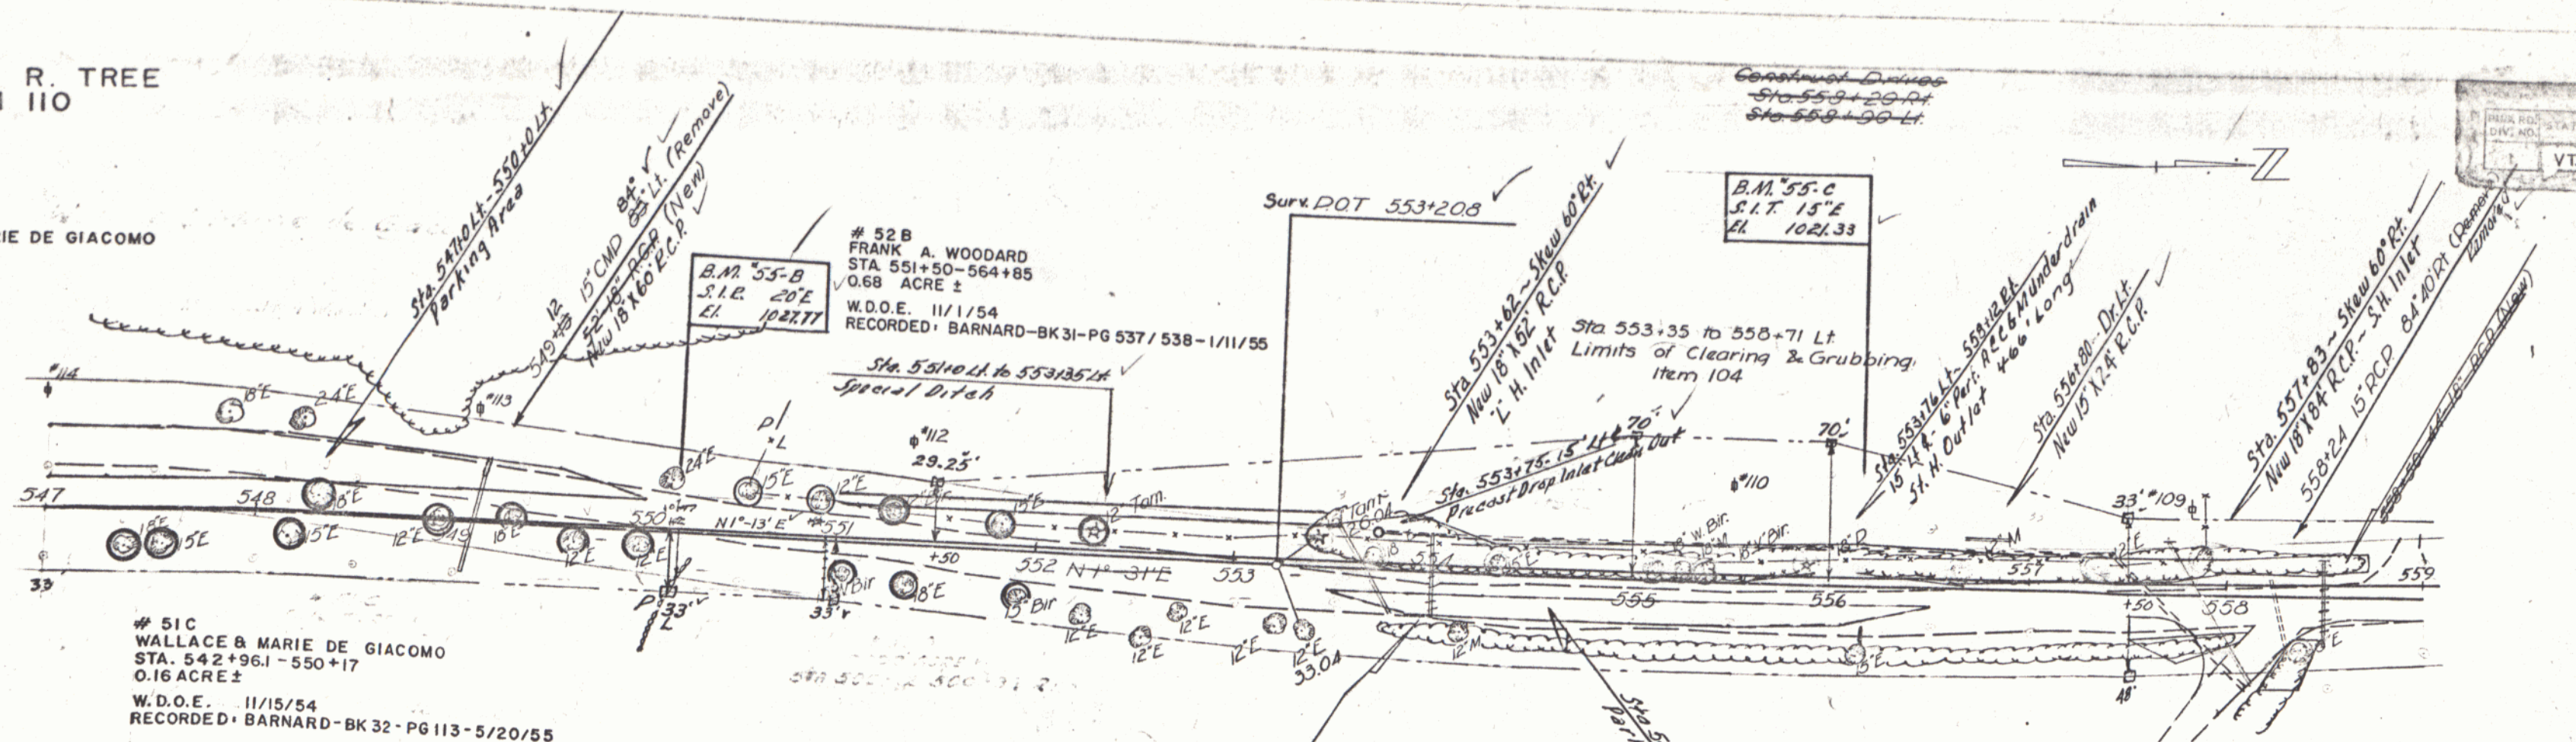

B.M. #55-B S.I.P. 20' Elm 25' Lt of Sta 550+15 El. 1027.77
B.M. #55-C S.I.P. 15' Elm 34' El of Sta 556+15 El. 1021.33

○ C. & R. TREE
ITEM 110



Construct Drives
Sta 559+50 Rt
Sta 560+00 Lt
Sta 561+00 Lt
Sta 562+00 Rt
Sta 563+00 Rt

Construct Drives
Sta 564+00 Rt
Sta 565+00 Rt
Sta 566+00 Rt
Sta 567+00 Rt
Sta 568+00 Rt

VT F 142 (2) 33 255

9-53
Sponsoring
Z.W. Espar
11-53

9-53
Sponsoring
Z.W. Espar
11-53

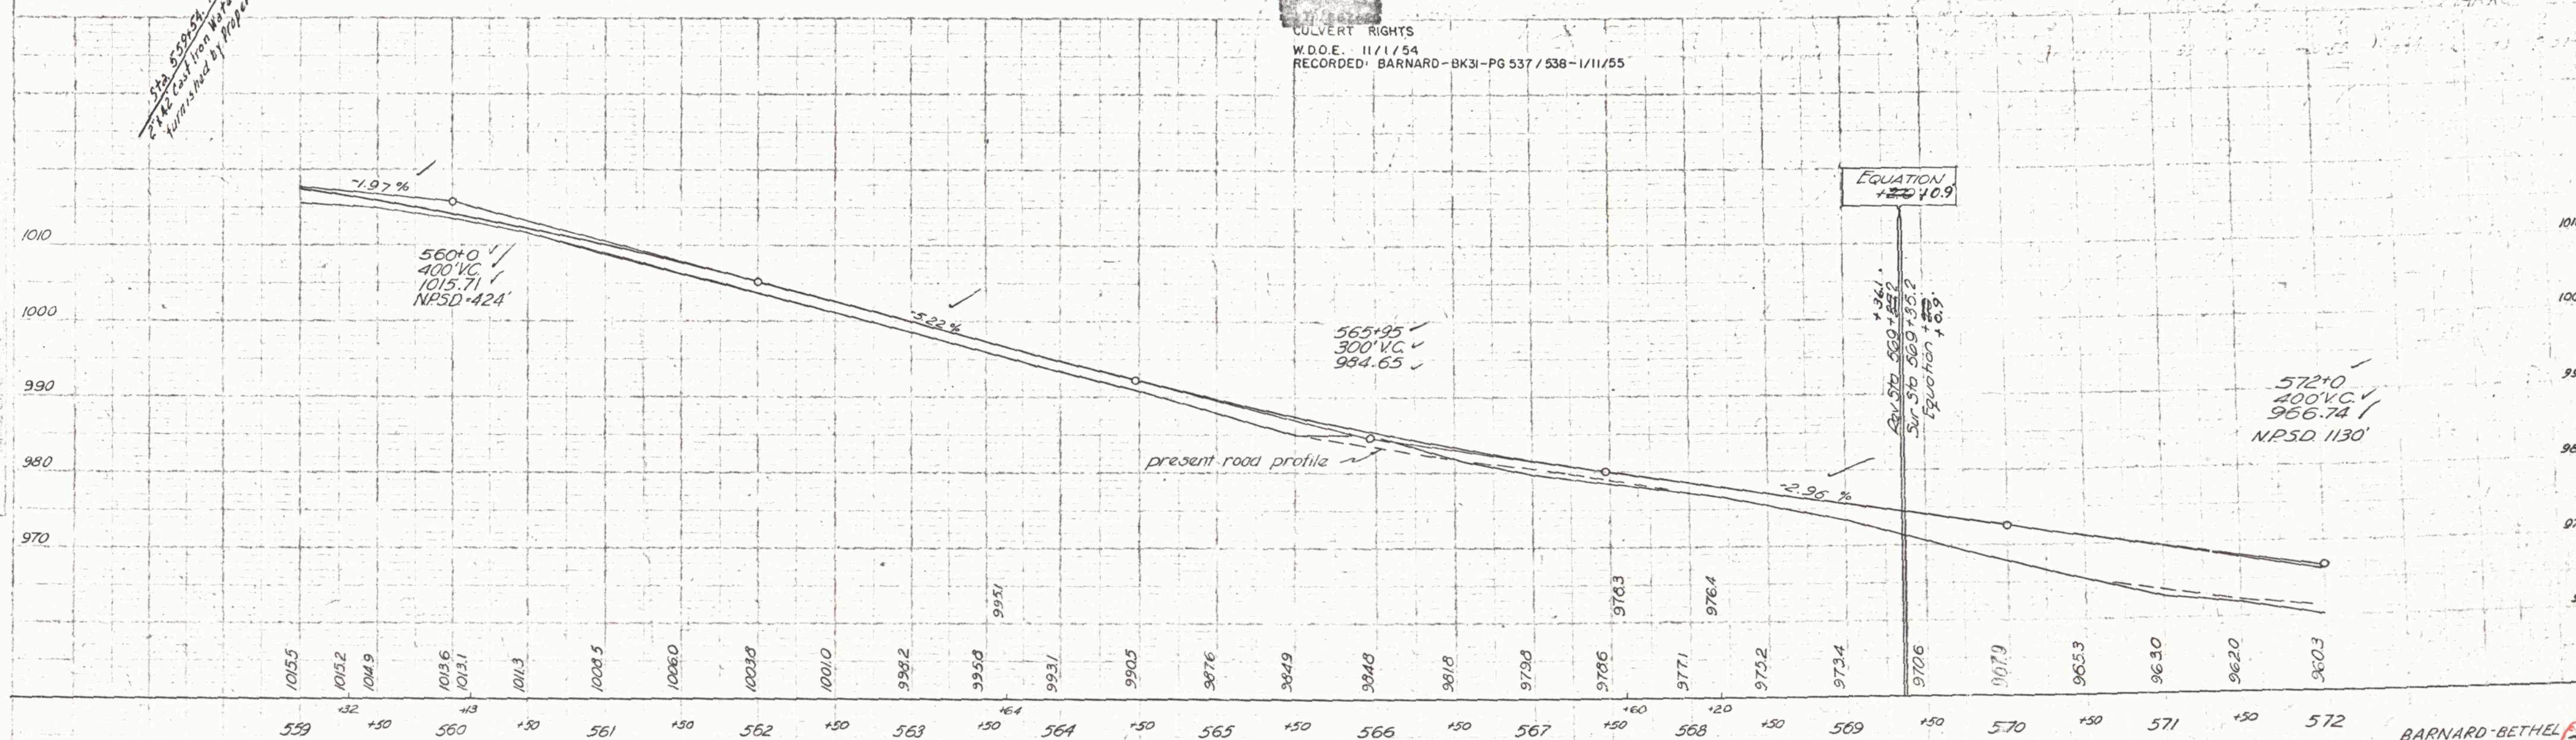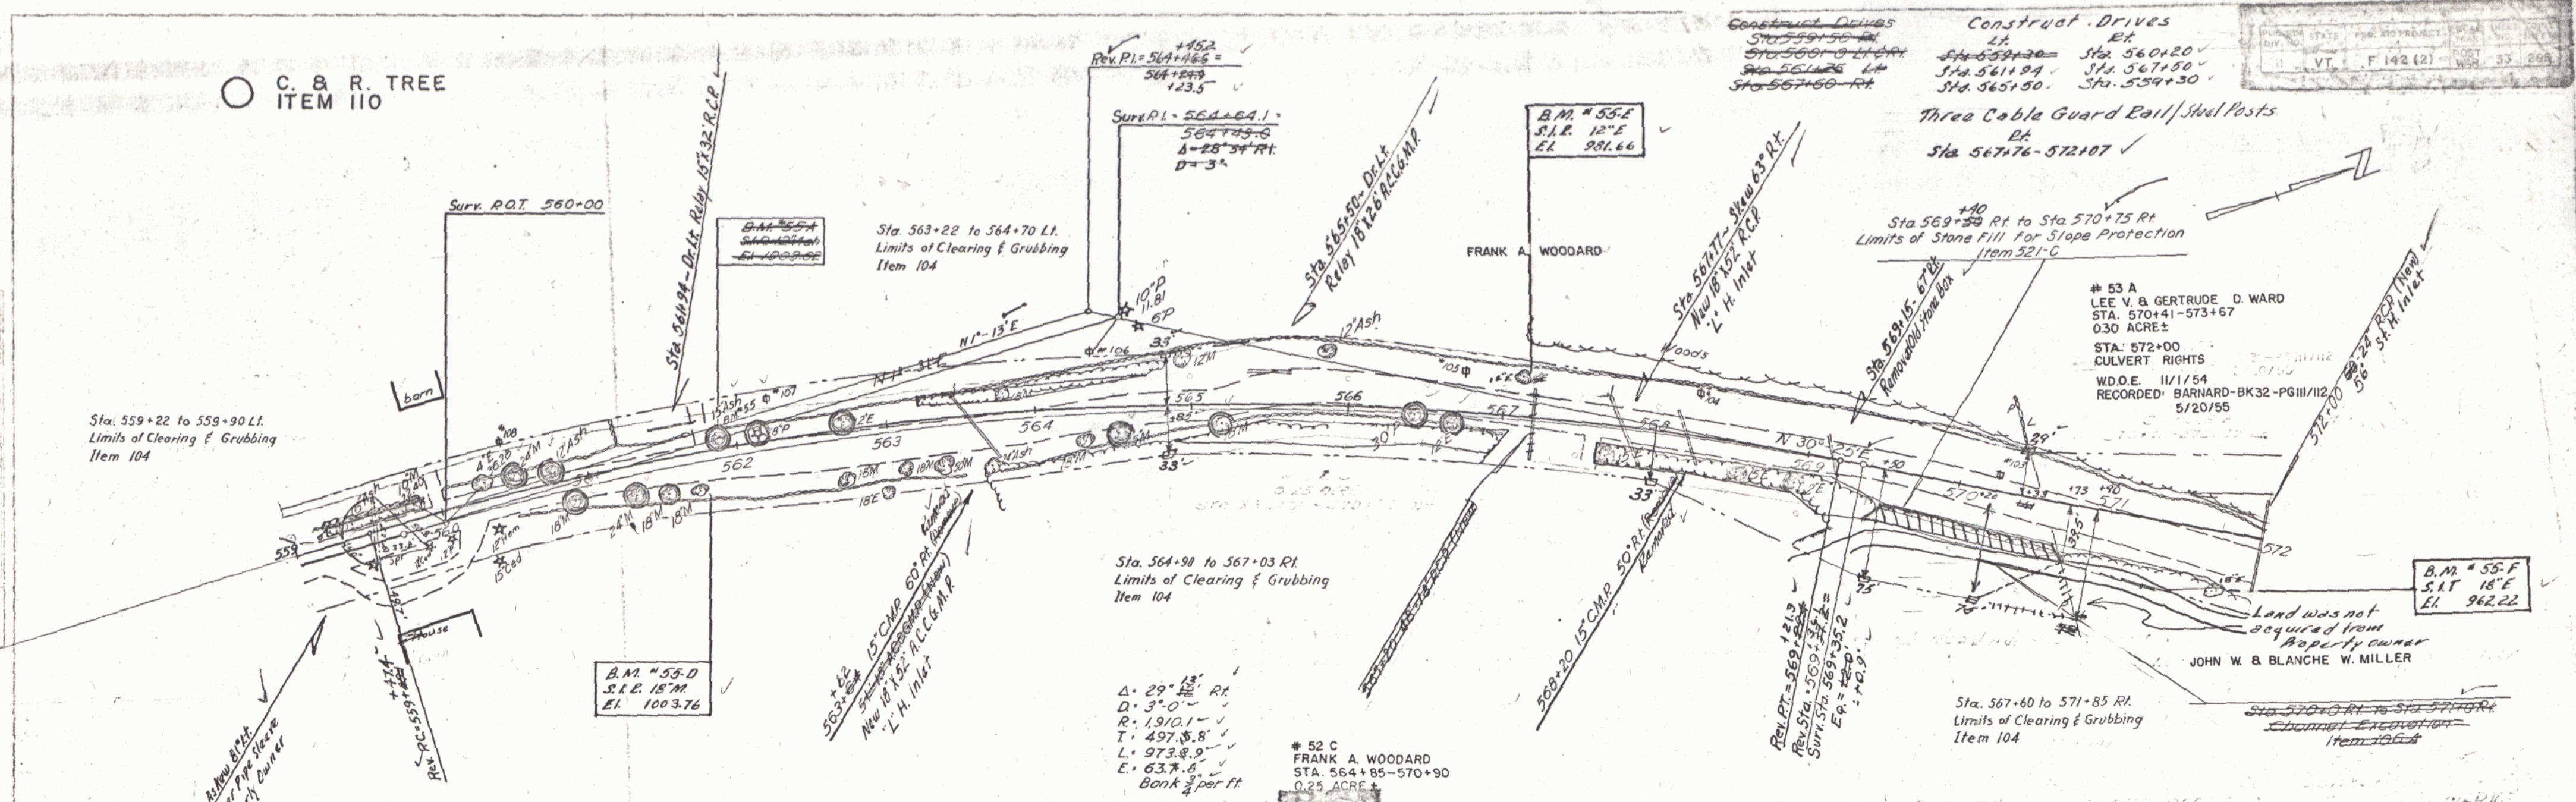

B.M. #55-D S.I.P. 18' Maple 27' E of Sta. 564+75 El. 1003.76
B.M. #55-F S.I.P. 12' Elm 38' E of Sta. 567+15 El. 981.66
B.M. #55-G S.I.P. 18' Elm 40' E of Sta. 571+75 El. 962.22

○ C. & R. TREE
ITEM 110

Three Cable Guard Rail / Steel Posts
Et
Sta 576194 Et to Sta 579150 Et. ✓

~~Construct Drives~~
~~Sto. 574 + 80 ft.~~
~~Sto. 579 + 50 ft.~~
~~Sto. 580 + 08 ft.~~

Construct	Drives
Lt	Rt.
Sta 578+79 ✓	Sta. 573+50 ✓
Sta 579+44 ✓	Sta. 575+75 ✓

VT. F 142 (2) POST 2 30

B.M. #57
S.I.R. 125
Elev. 922.5

B.M. 57-A
S.I.R. 12" M.
El. 924.59

53 C
LEE V. & GERTRUDE D. WARD
STA. 581+00-585+00
0.29 ACRE ±
STA. 583+40
CULVERT RIGHTS
W.D.O.E. 11/1/54
RECORDED: BARNARD-2122


Sta. 581+10 to 586+90 / Lt.
Limits of Clearing & Grubbing
Item 104

Sta. 584+88 to 587+00 Rt.
Limits of Clearing & Grubbing
Item 104

53 B
LEE V. & GERTRUDE D. WARD
STA. 576+50- 581+00
0.26 ACRE ±
W.D.O.E. 11/1/54
RECORDED: BARNARD-BK32-PG III 112-5/20/55

Sta. 580+35 Rt. Owner to remove barn
not later than
April 15, 1955

LEE V. & GERTRUDE D. WARD

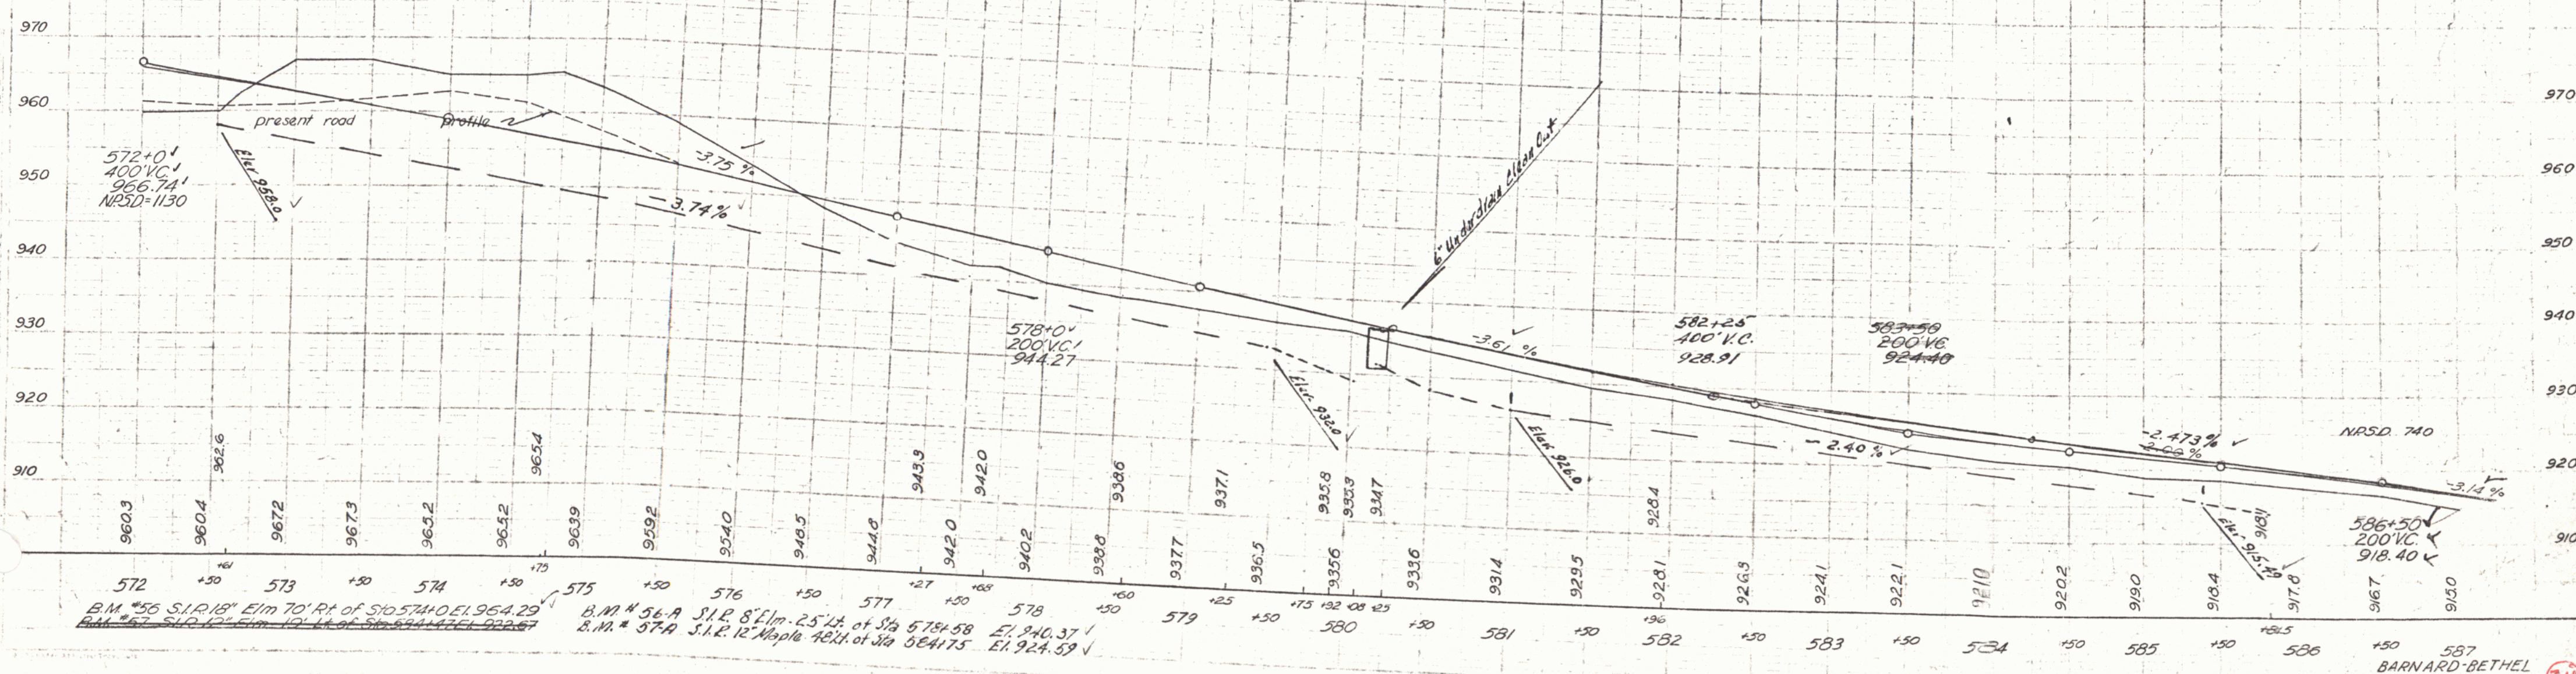

THE CLARKESON ENGINEERING CO., INC.
CONSULTING ENGINEERS
BOSTON MASSACHUSETTS

Spaulding
Z.W. Espar
Z.W. Espar

Spaulding
Z.W. Espar
Z.W. Espar

C. & R. TREE
ITEM 110

LEE V. & GERTRUDE D. WARD

#53 D
LEE V. & GERTRUDE D.
WARD
STA. 587+00 - 588+60
0.10 ACRE ±
W.D.O.E. 11/1/54
RECORDED: BARNARD -
BK 32 - PG 111/112 - 5/20/55

Sta. 587+00 to 589+00 Rt.
Limits of Clearing & Grubbing
Item 104

B.M. 57-B
S.I.R. 15" Ash
EL. 913.65

Δ: 7°18' Rt.
D: 2°0'
R: 2864.9'
T: 182.8'
L: 365.0'
E: 5.81'
Bank 2' per ft.

#55 E
RALEIGH & MARJORIE D. CAMPBELL
STA. 590+25
CULVERT RIGHTS
W.D.O.E. 7/1/55
RECORDED: BARNARD - BK 32 - PG 108 - 7/13/55

#55 B
RALEIGH & MARJORIE D. CAMPBELL
STA. 593+00 - 596+50
0.09 ACRE ±
W.D.O.E. 11/1/54
RECORDED: BARNARD - BK 31 - PG 553/554 - 1/24/55

#55 C
RALEIGH & MARJORIE D.
CAMPBELL
STA. 599+00 - 602+50
0.10 ACRE ±
W.D.O.E. 11/1/54
RECORDED: BARNARD - BK 31 - PG 553/554 - 1/24/55
Sta. 600+78 to 601+50 Lt.
Limits of Clearing & Grubbing
Item 104

#55 D
RALEIGH & MARJORIE D. CAMPBELL
STA. 601+83
CULVERT RIGHTS
W.D.O.E. 5-13-55
RECORDED: BARNARD - BK 32 - PG 107 - 5/20/55

Construct Drive
Sta. 591+00 Rt.
Sta. 597+10 Lt.
Sta. 597+50 Rt.
Sta. 597+90 Lt.
Sta. 598+10 Lt.

Construct Parking Area
599+0 to 604+0 Rt.


B.M. 38-A
S.I.R. 20" Elm
EL. 907.66

Sta. 599+00 to 602+50
Parking Area

Sta. 597+35 Non Gov't Participation
Install sleeve for water pipe across
roadway. Item 103. (Non Gov't)
Sleeve to be furnished by Property Owner.

Three Cable Guard Rail
Sta. 587+50 - 588+94

Δ: 1°51' Rt.
D: 0°30'
R: 11459.2'
T: 185.0'
L: 370.0'
E: 1.5'
No Bank

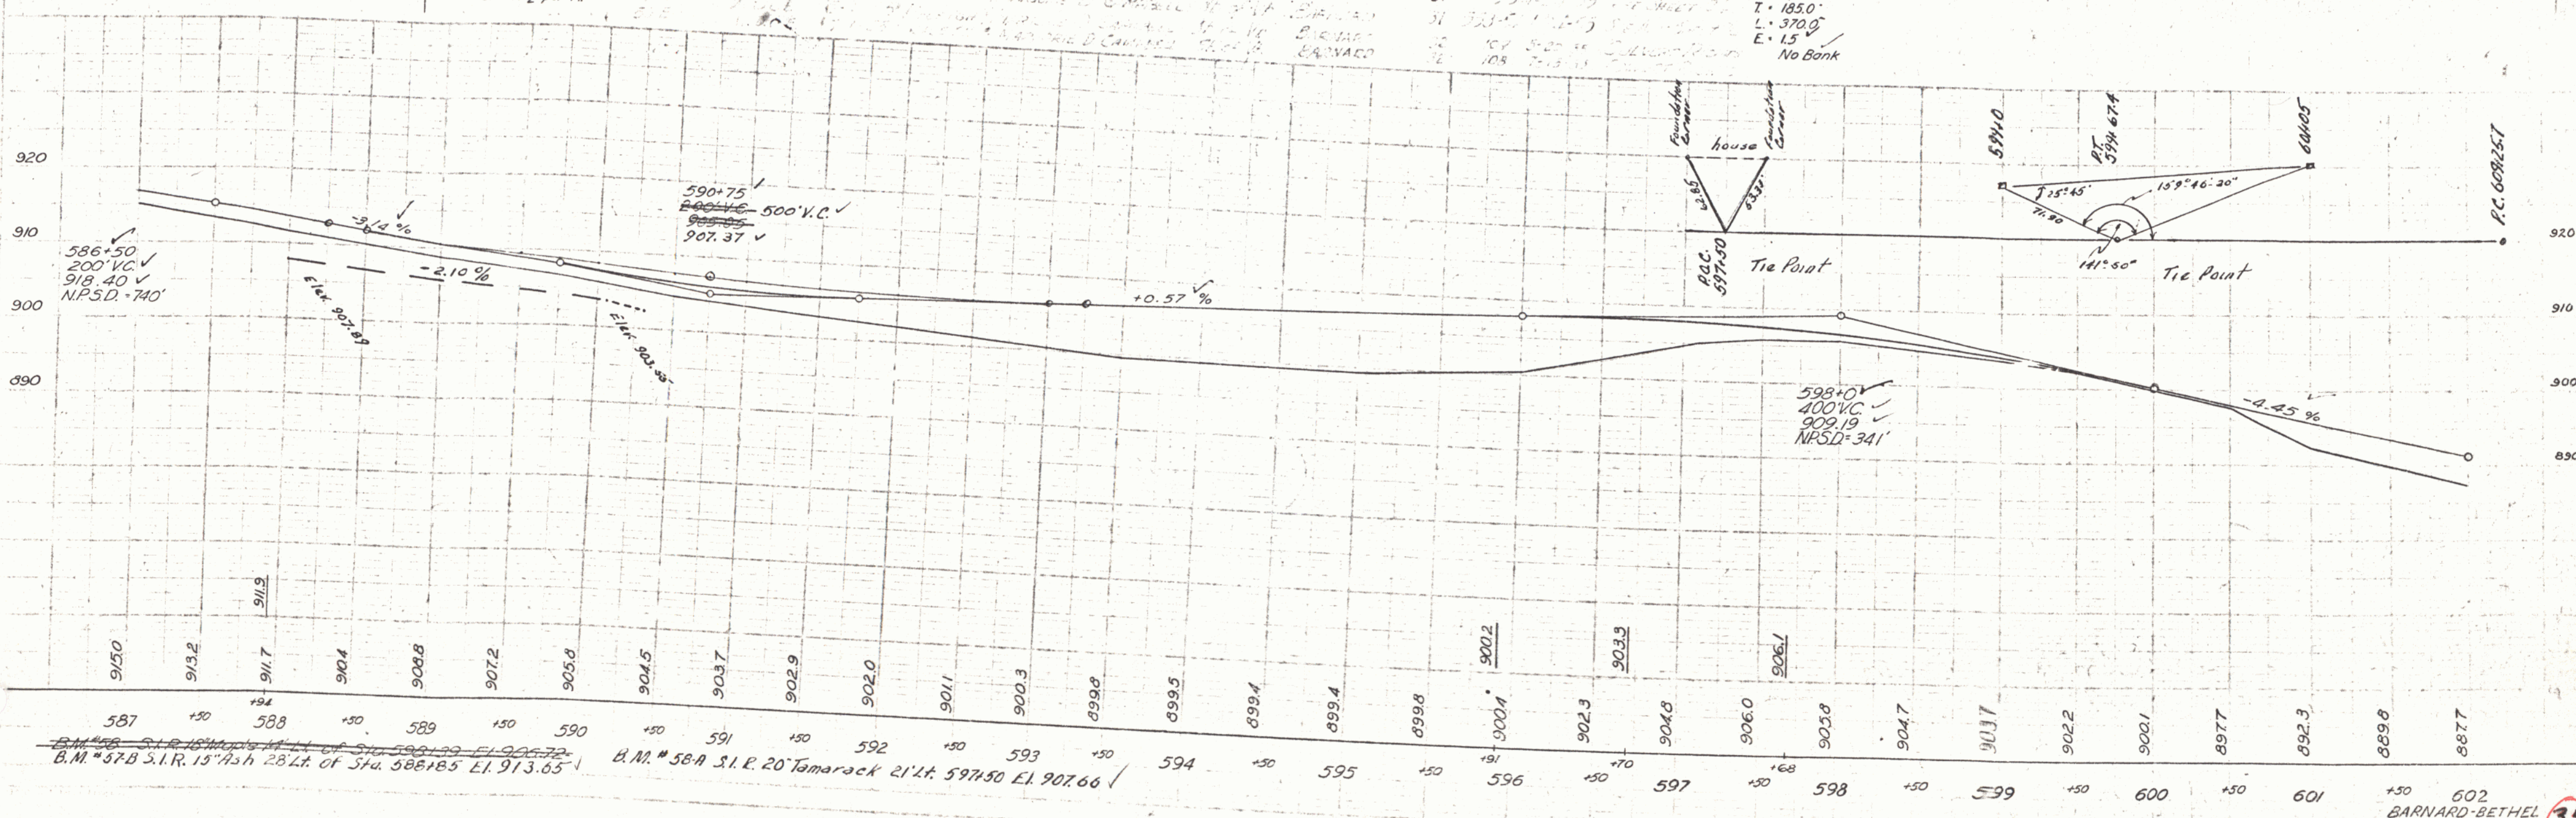

C. & R. TREE
ITEM 110

LEE V. & GERTRUDE D. WARD

#55E
RALEIGH & MARJORIE D. CAMPBELL
STA. 590+25
CULVERT RIGHTS
W.D.O.E. 7/1/55
RECORDED: BARNARD - BK32 - PG108 - 7/13/55

#55B
RALEIGH & MARJORIE D. CAMPBELL
STA. 593+00 - 596+50
0.09 ACRE ±
W.D.O.E. 11/1/54
RECORDED: BARNARD - BK31 - PG553/554 - 1/24/55

Construct Drive
Sta. 591+00 RM
Sta. 597+10 L+V
Sta. 597+50 R+V
Sta. 597+100 L+V
Sta. 597+90 L+V
Sta. 598+10 L+V

#55C
RALEIGH & MARJORIE D. CAMPBELL
STA. 599+00 - 602+50
0.10 ACRE ±
W.D.O.E. 11/1/54
RECORDED: BARNARD - BK31 - PG553/554 - 1/24/55
Sta. 600+76 to 601+50 L+V
Limits of Clearing & Grubbing
Item 104

#55D
RALEIGH & MARJORIE D. CAMPBELL
STA. 601+83
CULVERT RIGHTS
W.D.O.E. 5-13-55
RECORDED: BARNARD - BK32 - PG107 - 5/20/55

#53D
LEE V. & GERTRUDE D. WARD
STA. 587+00 - 588+60
0.10 ACRE ±
W.D.O.E. 11/1/54
RECORDED: BARNARD - BK32 - PG111/112 - 5/20/55

#55A
RALEIGH & MARJORIE D. CAMPBELL
STA. 588+40 - 590+00
0.06 ACRE ±
W.D.O.E. 11/1/54
RECORDED: BARNARD - BK31 - PG553/554 - 1/24/55

Sta. 587+00 to 589+00 R/L
Limits of Clearing & Grubbing
Item 104

Δ: 7' 10" R/L
D: 2' 0"
R: 2.864.9
T: 182.8'
L: 363.0'
E: 58'

B.M. 57-B
S.I.R. 15' ASH
L: 913.65


Three Cable Guard Rail
Steel Posts
Sta. 587+50 - 588+24

Sta. 597+29 - 600+00
Water Pipe by Property Owner

Sta. 597+35 Non Govt Participation
Install sleeve for water pipe across
roadway. Item 103. (Non Govt)
Sleeve to be furnished by Property Owner



Δ: 1' 51" R/L
D: 0' 30"
R: 1,459.2
T: 185.0'
L: 370.0'
E: 1.5'

No Bank

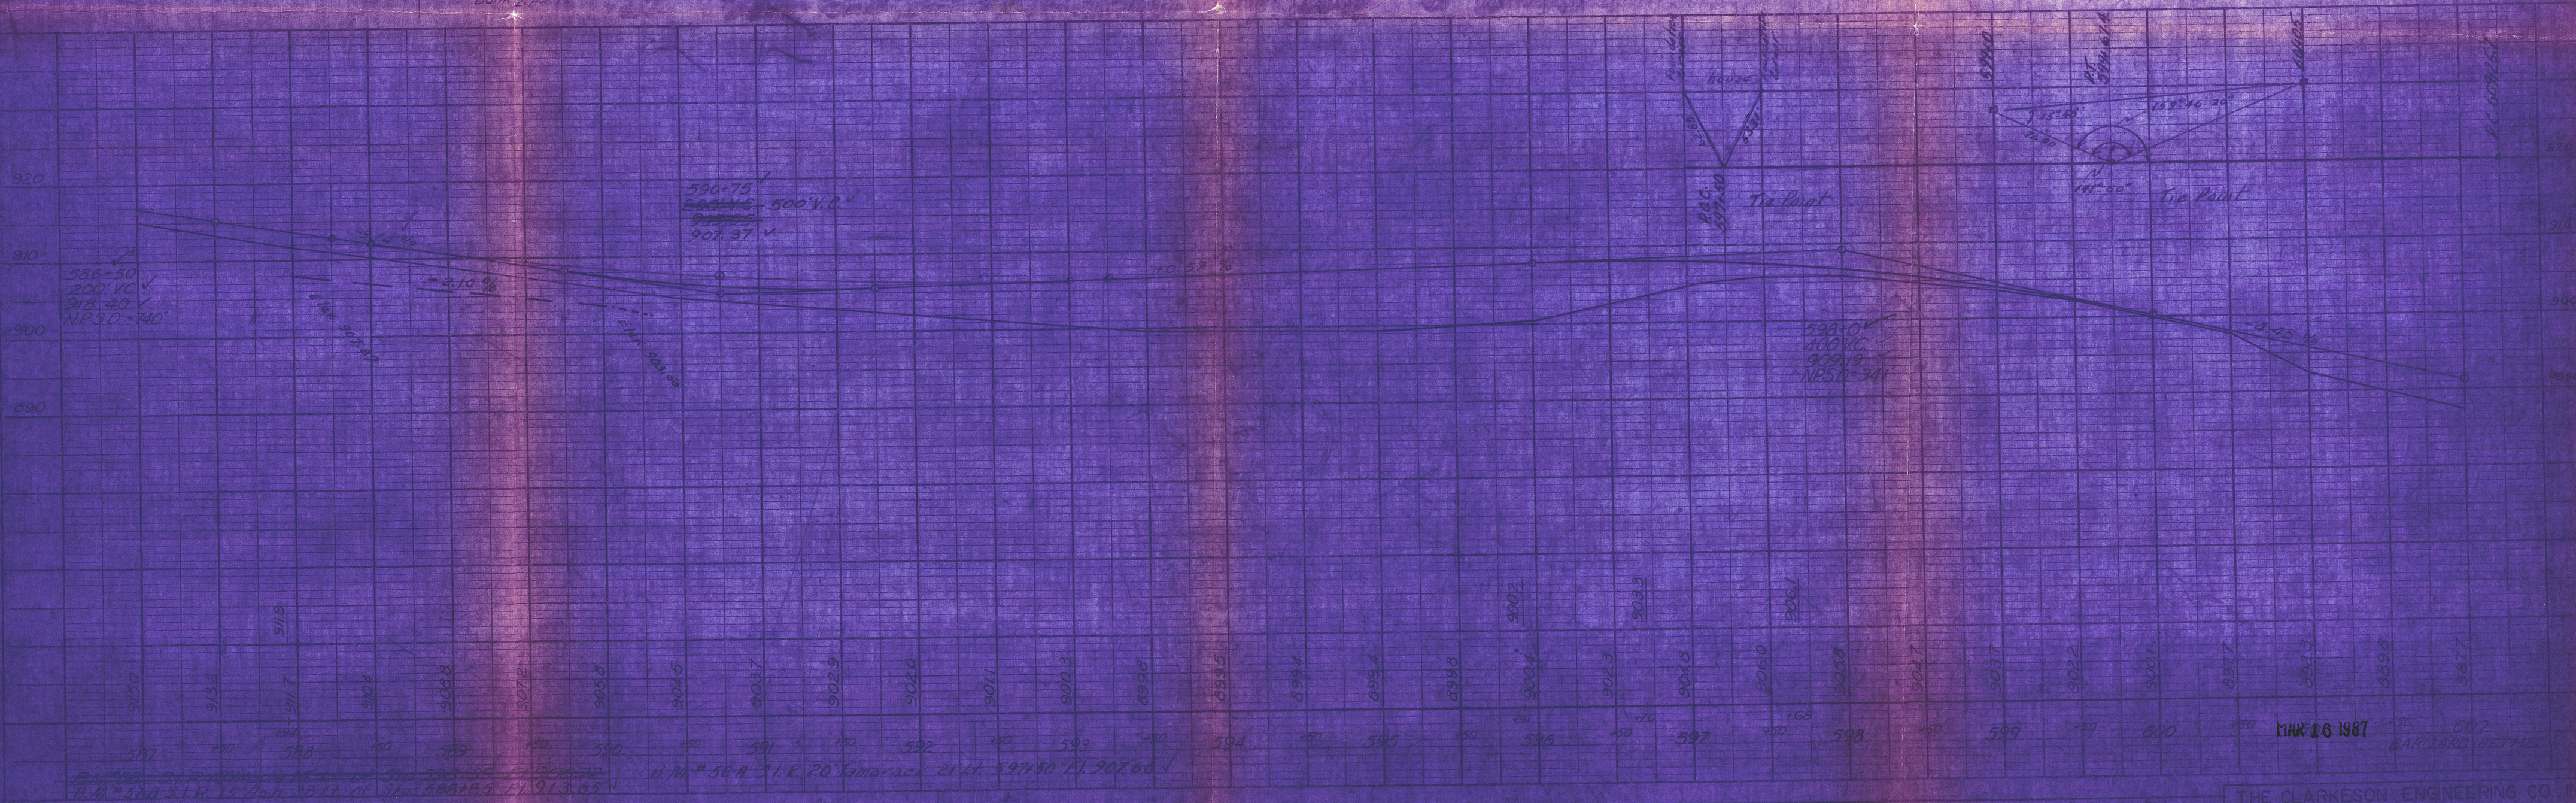

MAY 16 1987

THE CLARKSON ENGINEERING CO., INC.
CONSULTING ENGINEERS
BOSTON MASSACHUSETTS

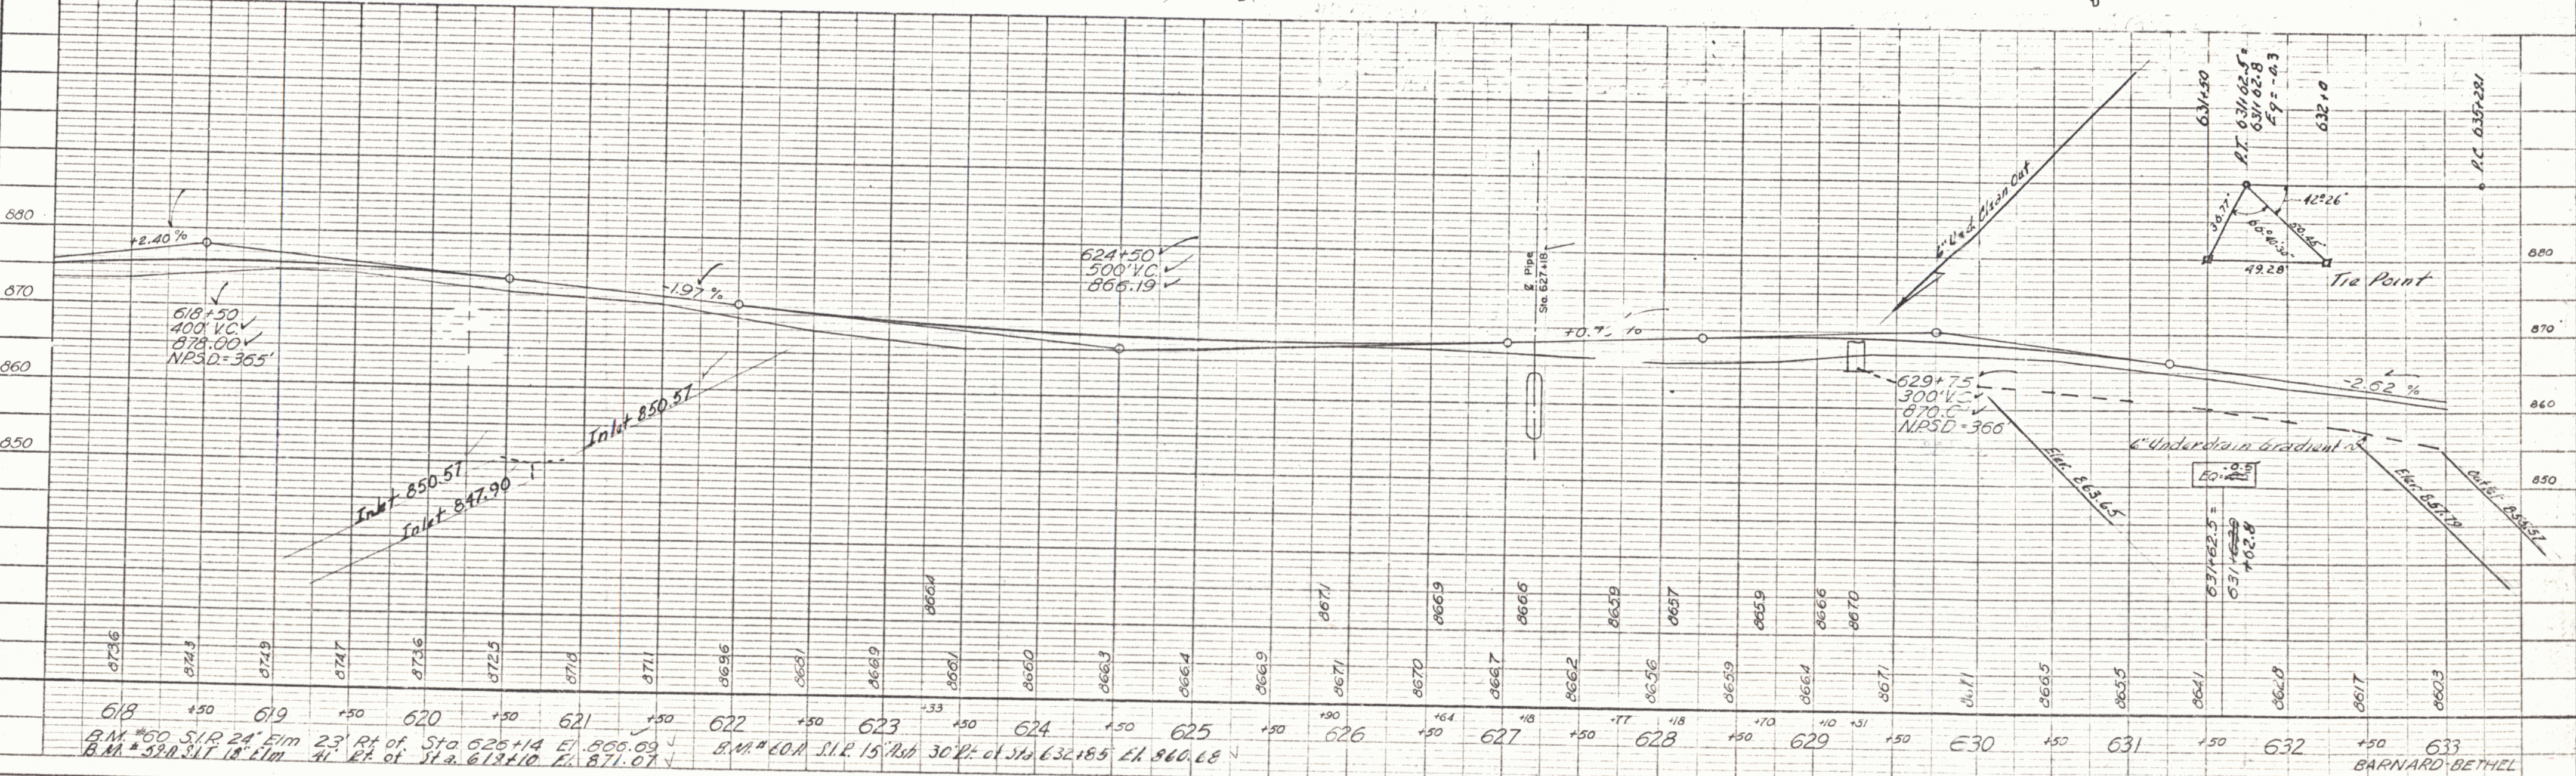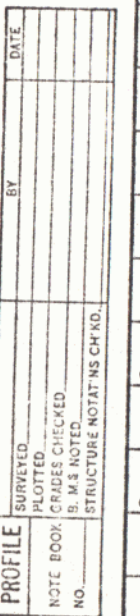

PLAN	9/53
DESIGNED BY	SPaulding
CHECKED BY	W. E. Spaulding
DATE	11/53
NO.	

PROFILE	9/53
DESIGNED BY	SPaulding
CHECKED BY	W. E. Spaulding
DATE	11/53
NO.	

○ C. & R. TREE
ITEM 110

57 E
LINWOOD B. & LENA B. ROBERTS
STA. 635+25-636+25
SLOPE RIGHTS
W.D.O.E. 5/13/55
RECORDED: BARNARD-BK 32-PG 109-5/20/55

57 C
LINWOOD B. & LENA B. ROBERTS
STA. 635+29.1-645+00
0.21 ACRE ±
W.D.O.E. 11/1/54
RECORDED: BARNARD-BK 31-PG 559/560-1/28/55

58 B
ANDREW W. & DORIS E. DAVIS
STA. 645+00-647+55
0.04 ACRE ±
COND. 9/17/54
RECORDED: BARNARD-BK 31-PG 479/495-9/17/54

58 A
ANDREW W. & DORIS E. DAVIS
STA. 640+50-645+00
0.23 ACRE ±
COND. 9/17/54
RECORDED: BARNARD-BK 31-PG 479/495-9/17/54

58 C
ANDREW W. & DORIS E. DAVIS
STA. 645+00-645+00
SLOPE RIGHTS
STA. 645+00
DRAINAGE RIGHTS
W.D.O.E. 12/16/55
RECORDED: BARNARD-BK 32
PG 134-2/3/56


Sta. 633+05 to 636+40 R.I.
Limits of Clearing & Grubbing
Item 104

57 B
LINWOOD B. & LENA B. ROBERTS
STA. 632+00-638+94
0.48 ACRE ±
W.D.O.E. 11/1/54
RECORDED: BARNARD-BK 31-PG 559/560-1/28/55


Sta. 636+50 to 639+50
Limits of Sub-Base of Sand
Item 202

B.M. #60-B
S.I.R. 24" M.
E.L. 849.24

Δ 25° 36' Rt.
D 2° 15'
R 2546.6'
L 578.5'
L 1137.7'
E 64.9'
Bank 1/2 per ft.

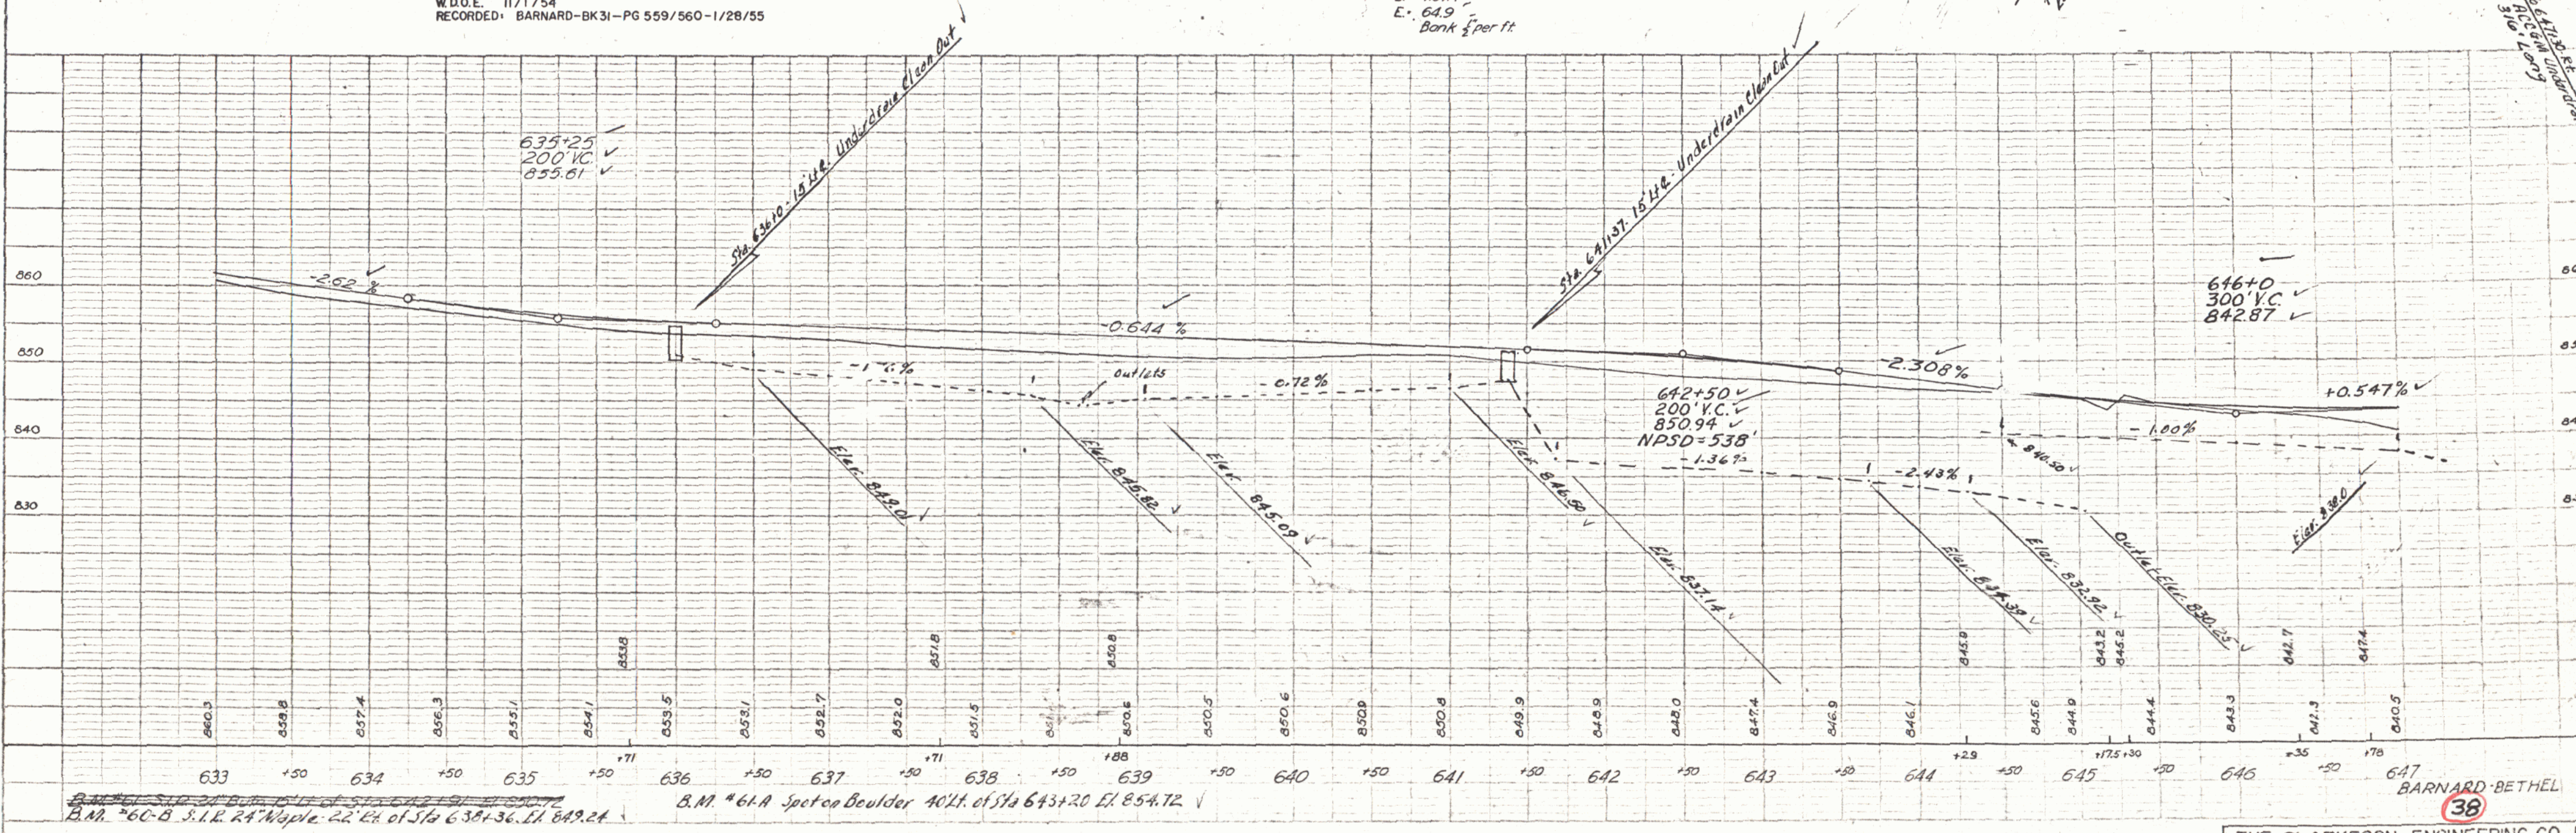

PROFILE	3. REEDED	BY	DATE
NOTE BOOK	PLOTTED	<i>Spaulding</i>	<i>9-53</i>
NO.	GRADES CHECKED	<i>G. Guest</i>	<i>1-54</i>
	B. M. NOTED	<i>R. Hong Long</i>	<i>1-54</i>
	STRUCTURE NOTATIONS CHNG.	<i>Z. W. Espar</i>	<i>5-54</i>

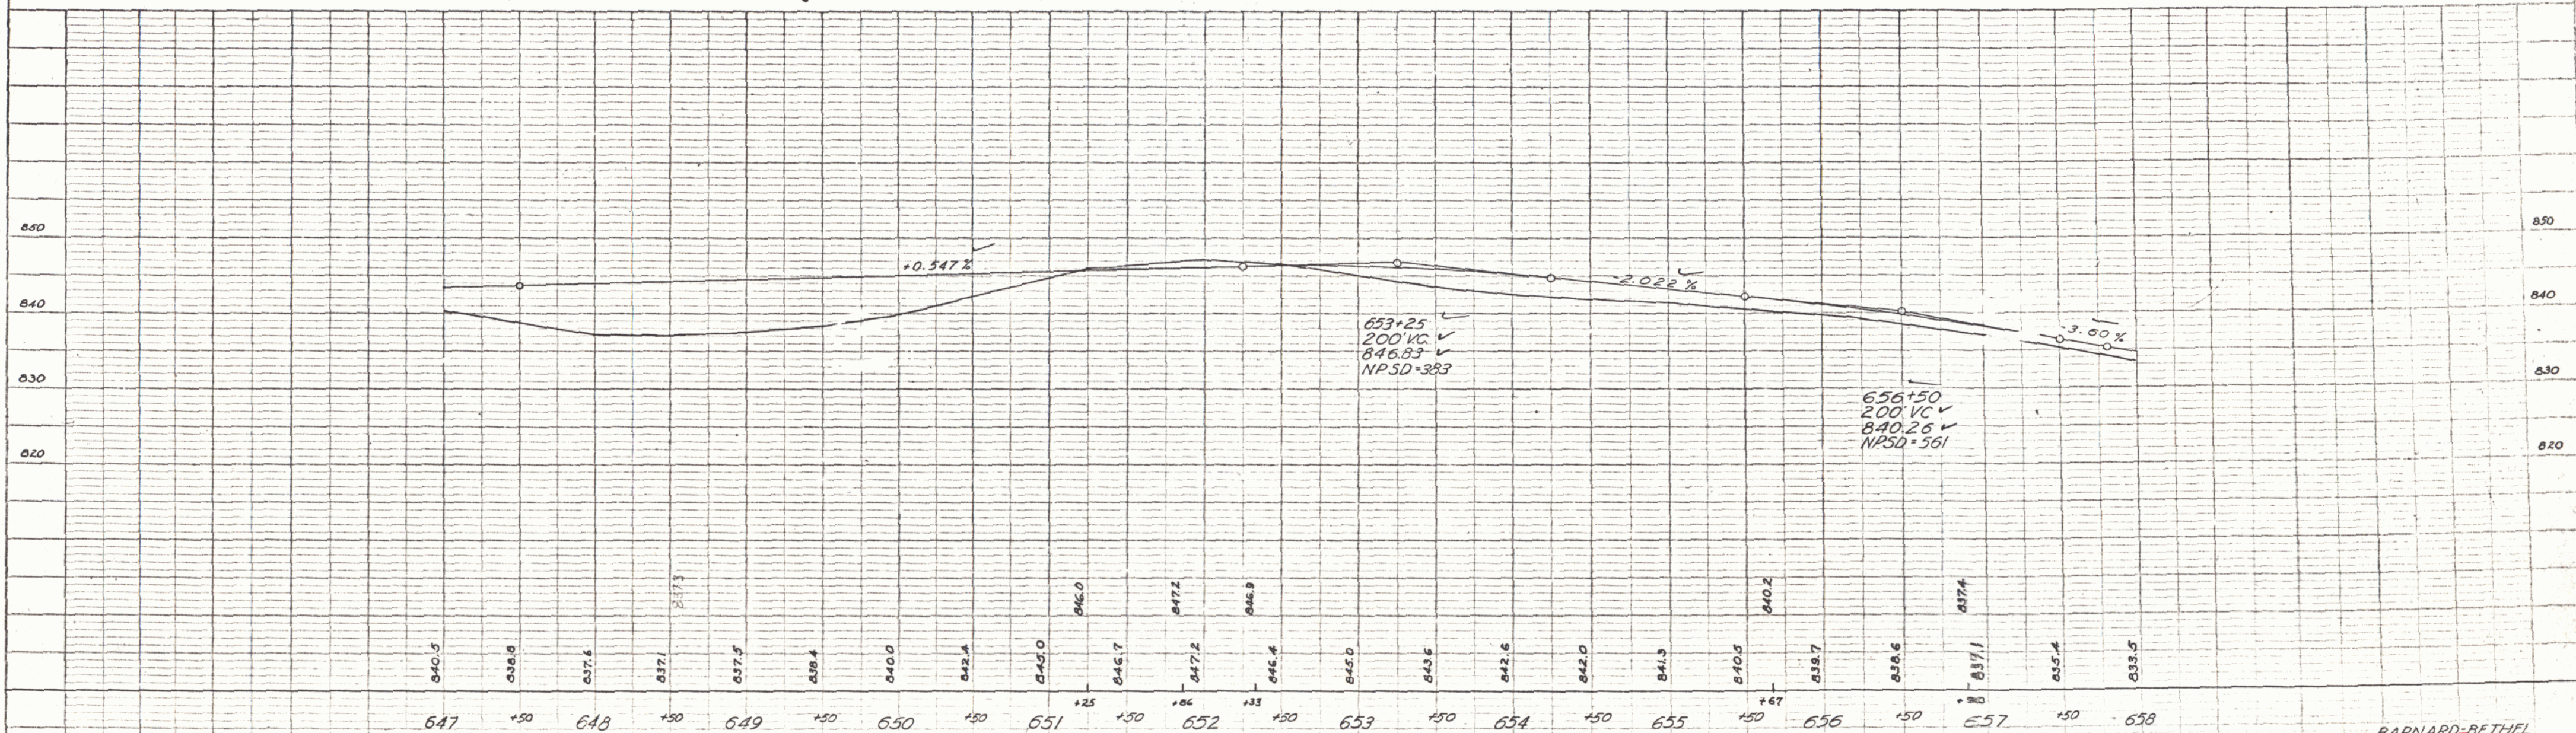

B.M. #61-B. Spot on Boulder 82' Lt. of Sta 648+34 El. 845.32 ✓
B.M. #61-C. S.I.R. 30' Maple 25' Lt. of Sta 651+50 El. 849.63

PLAN
 SURVEYED BY: J. W. ESPEL
 PLOTTED BY: J. W. ESPEL
 NOTE BOOK ALIGNED CHECKED BY: J. W. ESPEL
 NO. 11-53

PROFILE
 SURVEYED BY: J. W. ESPEL
 PLOTTED BY: J. W. ESPEL
 NOTE BOOK ALIGNED CHECKED BY: J. W. ESPEL
 NO. 11-53

C. & R. TREE
 ITEM 110

B.M. #62
 S.I.R. 15' Pine
 E.I. 833.65



Construct Drives
 Lt
 Sta 661+80 ✓
 Sta 663+80 ✓
 Sta 669+50 ✓
 Sta 666+90 ✓

B.M. #62-A
 S.I.R. 18' E
 E.I. 827.30

Construct Drives
 Sta 661+0 R.H.
 Sta 670+25 R.H.
 Sta 670+70 L.H.
 Sta 671+0 R.H.



Rev Curve Data
 Δ: 0°-56' Lt.
 D: 0°-30' Lt.
 R: 11459.2'
 T: 93.3'
 L: 186.6'
 E: 0.41'
 No Bank

PUB. RD. STATE PROJECT FISCAL SHEET TOTAL
 DATE: 11-53 POST: 40.296
 VT F. 142 (2) MAR-40

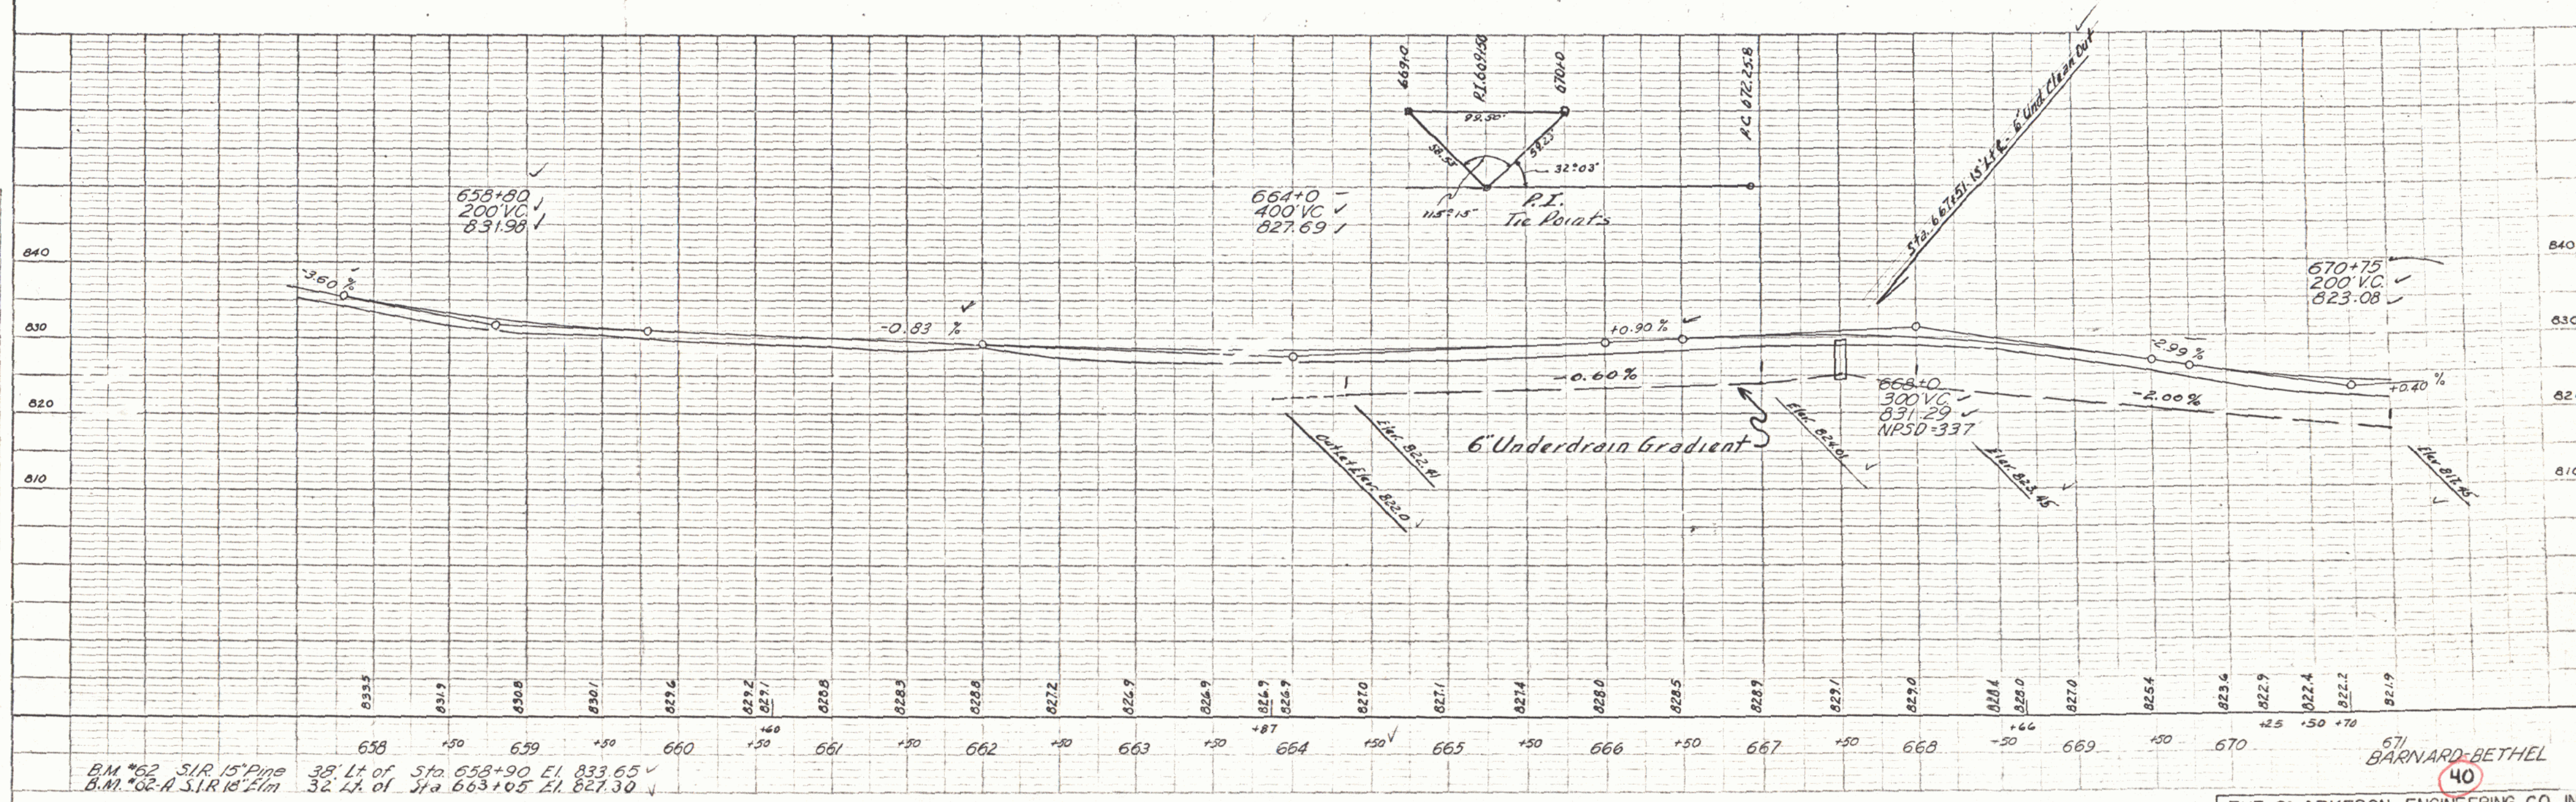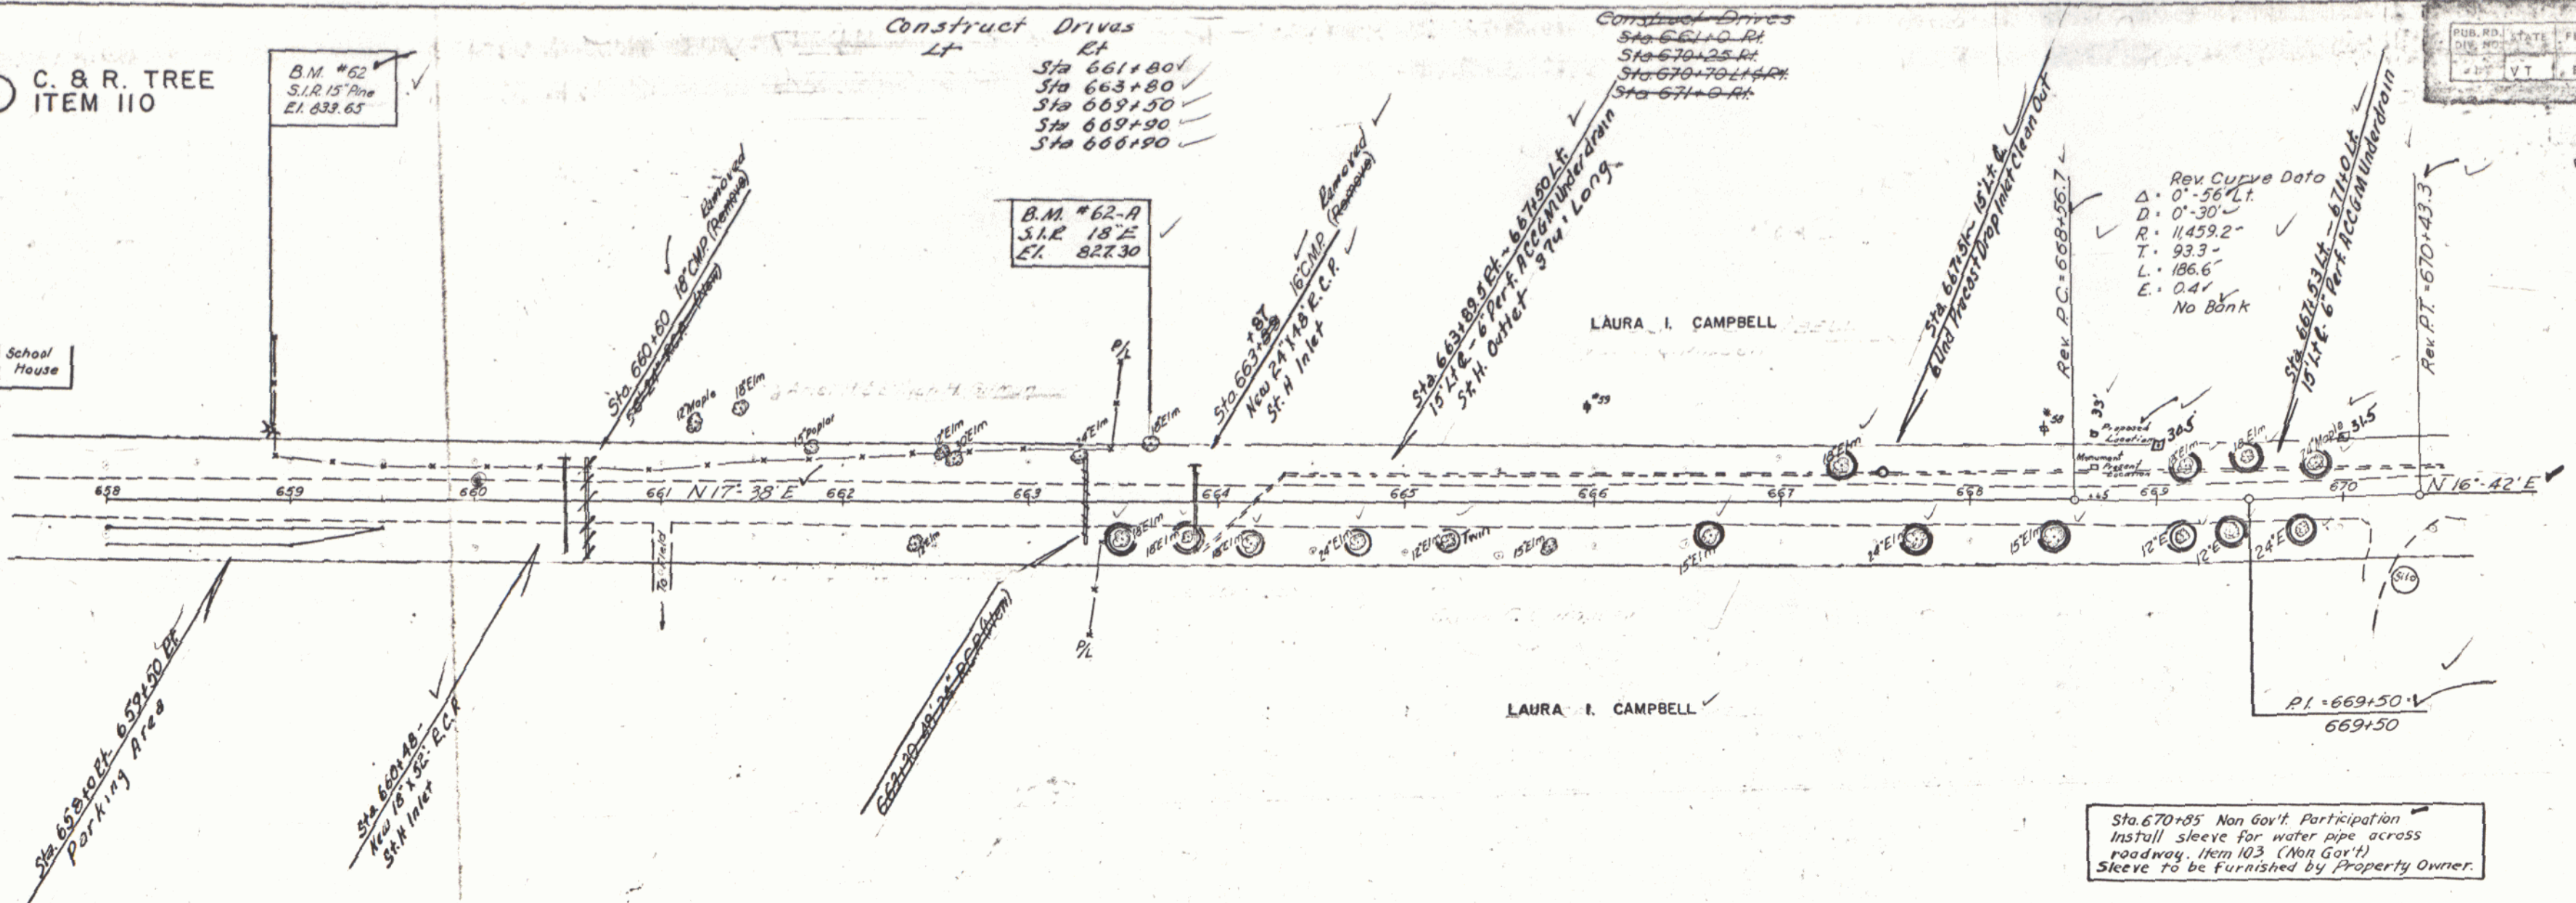


B.M. #62 S.I.R. 15' Pine 38' Lt. of Sta 658+90 E.I. 833.65 ✓
 B.M. #62-A S.I.R. 18' E 32' Lt. of Sta 663+05 E.I. 827.30 ✓

THE CLARKSON ENGINEERING CO., INC.
 CONSULTING ENGINEERS
 BOSTON MASSACHUSETTS

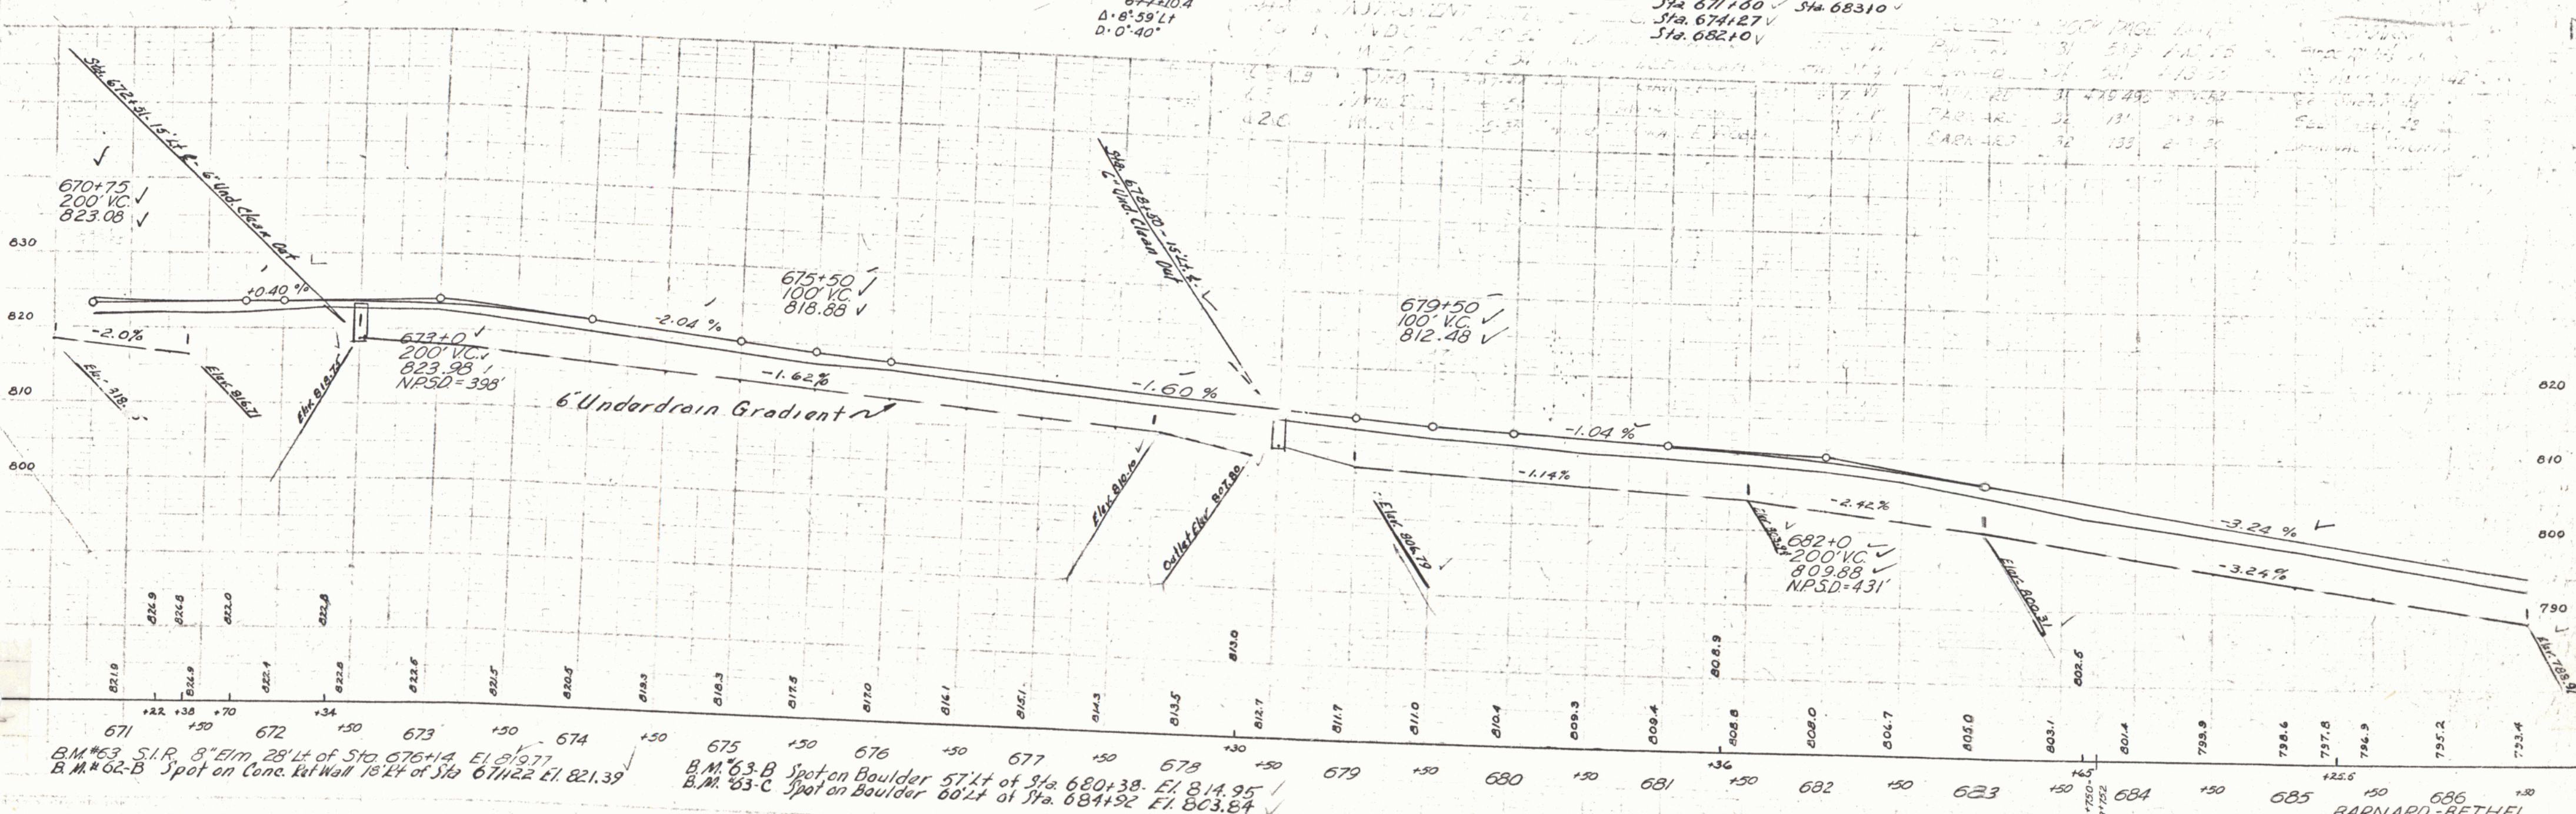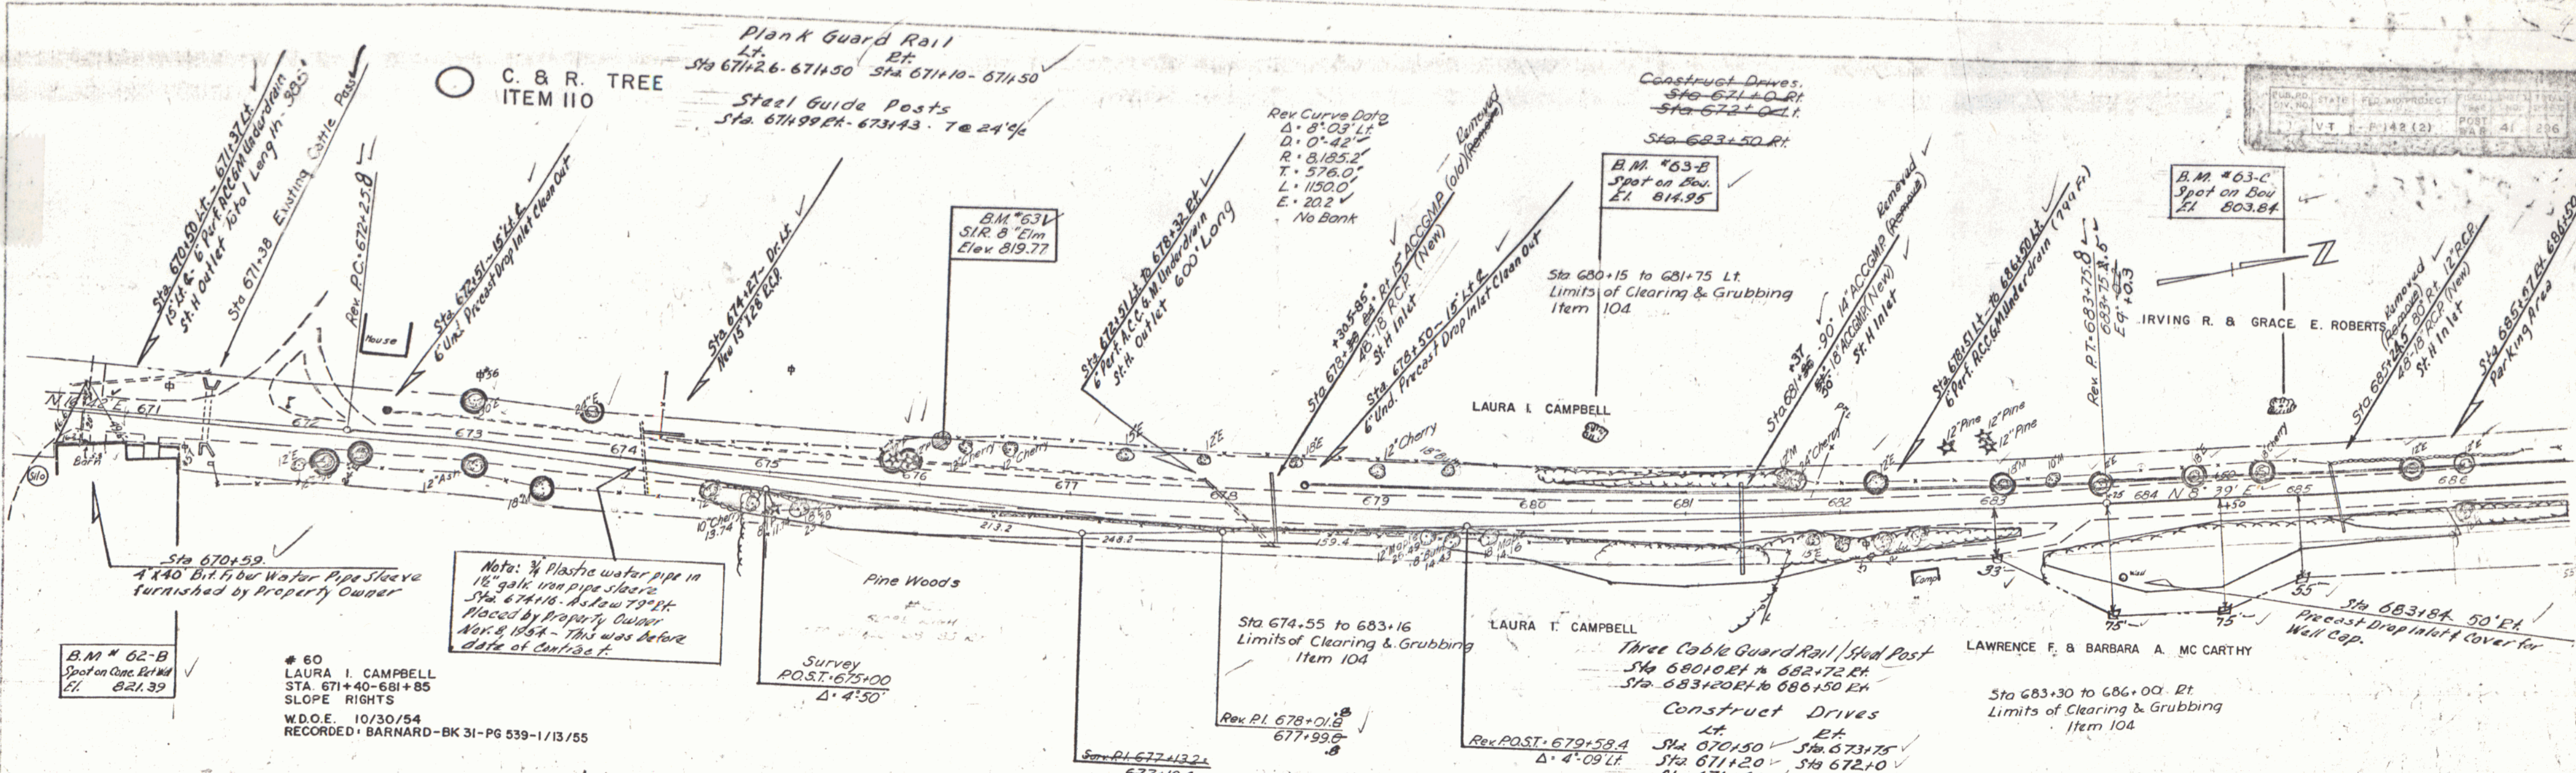


B.M. #63 S.I.R. 8" Elm. 28' Lt of Sta 676+14. El. 819.77
 B.M. #62-B Spot on Conc. Ret Wall 18' Lt of Sta 671+22 El. 821.39
 B.M. #63-B Spot on Boulder 57' Lt of Sta 680+38. El. 814.95
 B.M. #63-C Spot on Boulder 60' Lt of Sta 684+92 El. 803.84

55-11
 55-12
 55-13
 55-100

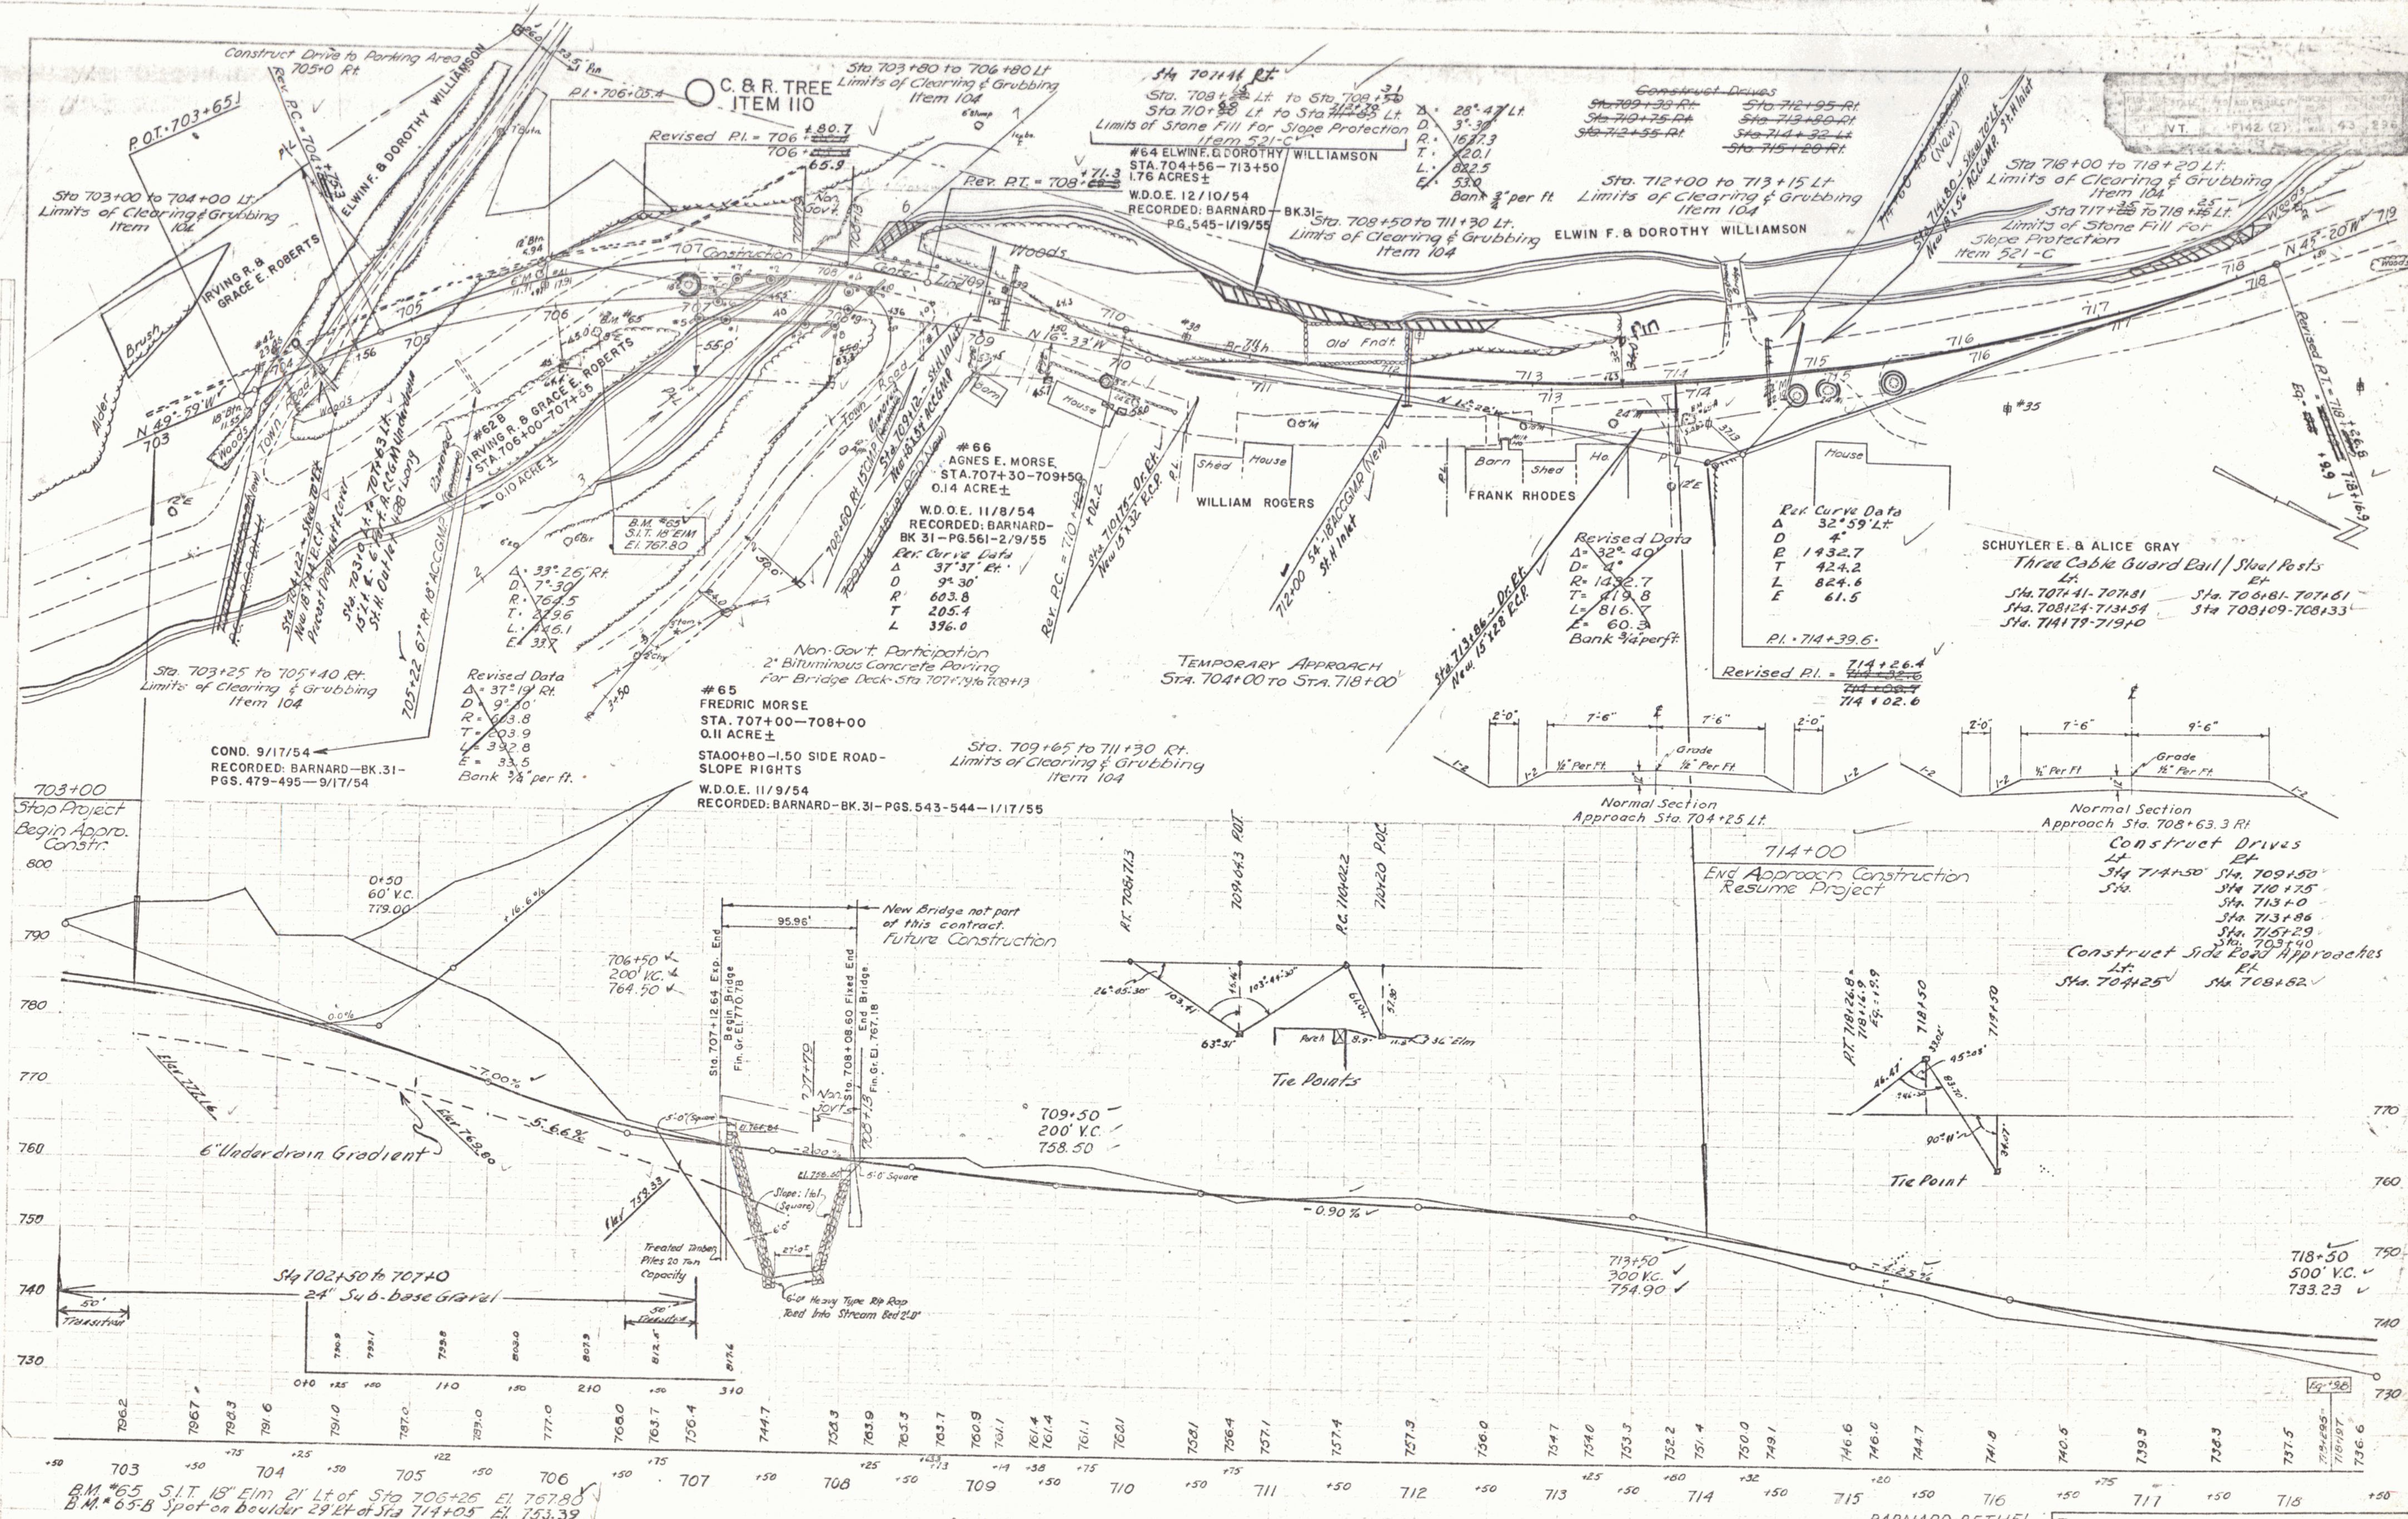

WOOD
BUCKLEY
10/17/52
10/11/52

WOOD
PRATT
10/17/52
10/11/52

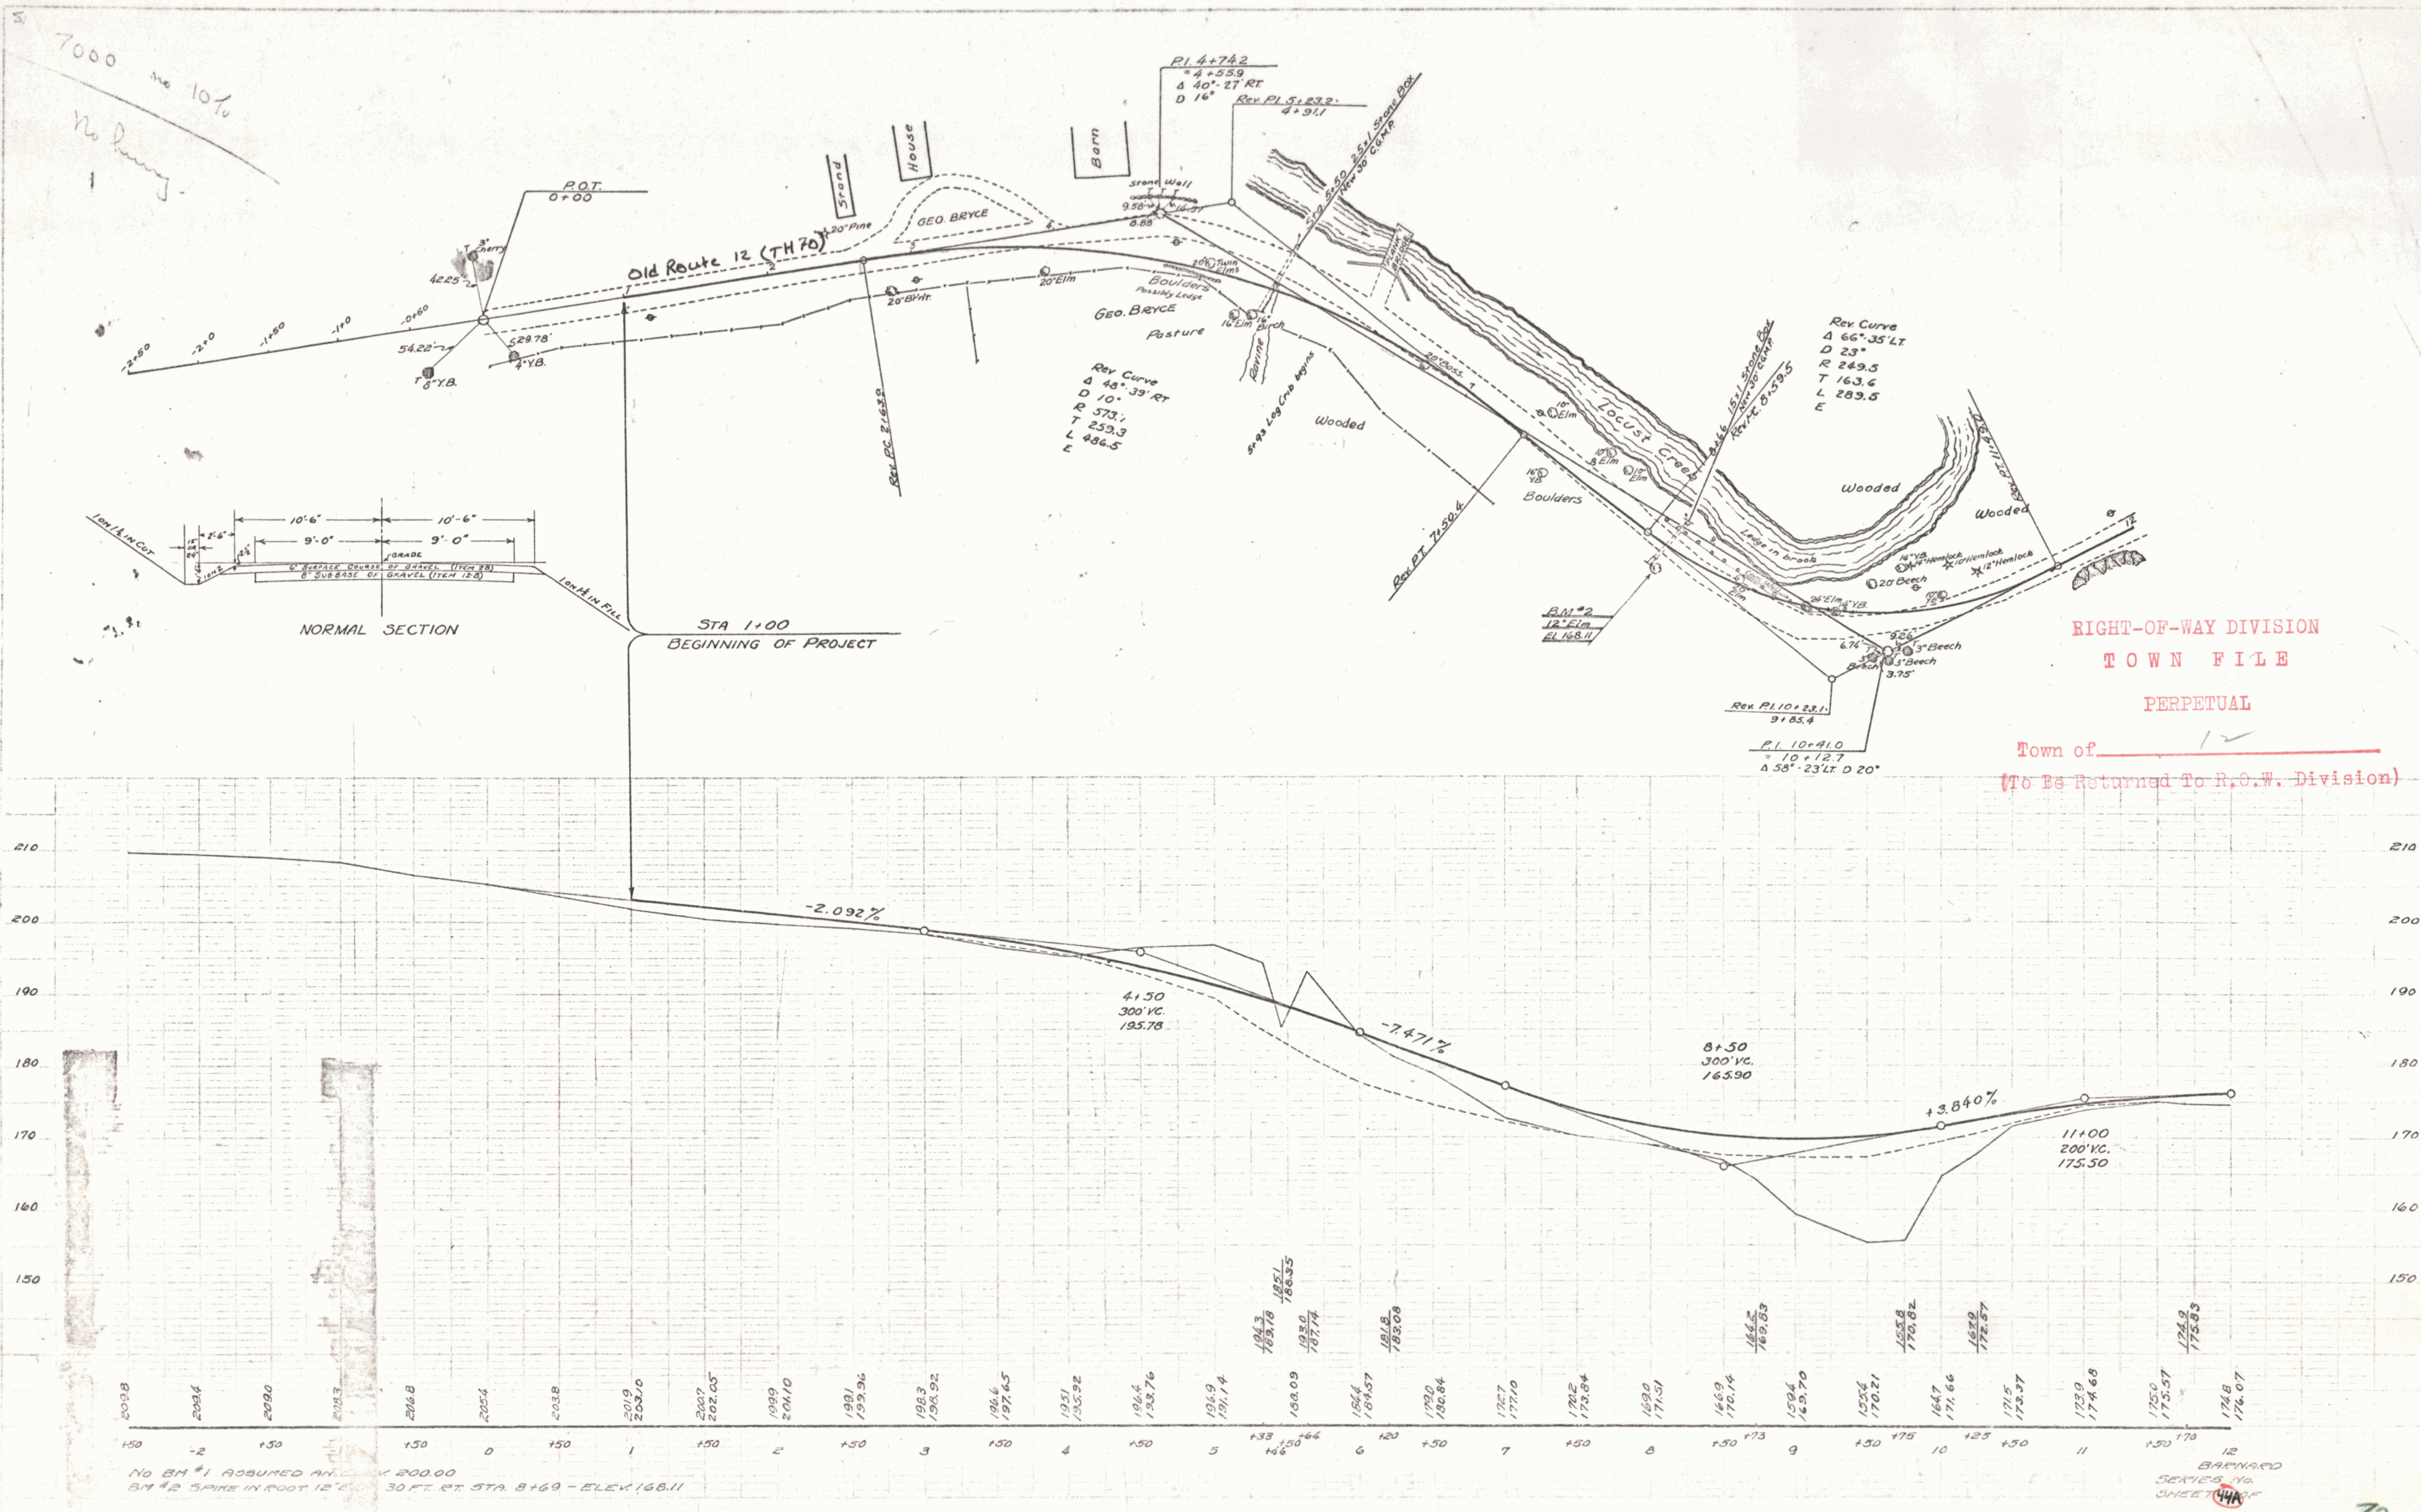

RIGHT-OF-WAY DIVISION
TOWN FILE
PERPETUAL
Town of _____
(To Be Returned To R.O.W. Division)


NO BM #1 ASSUMED AT STA. 200.00
BM #2 SPIRE IN ROOT 12' 30 FT. RT. STA. 8+69 - ELEV 168.11

BARNARD
SERIES NO.
SHEET 144


DIST. # 4 PLAN

WOOD BUCKLEY
11/12

WOOD BUCKLEY
11/12

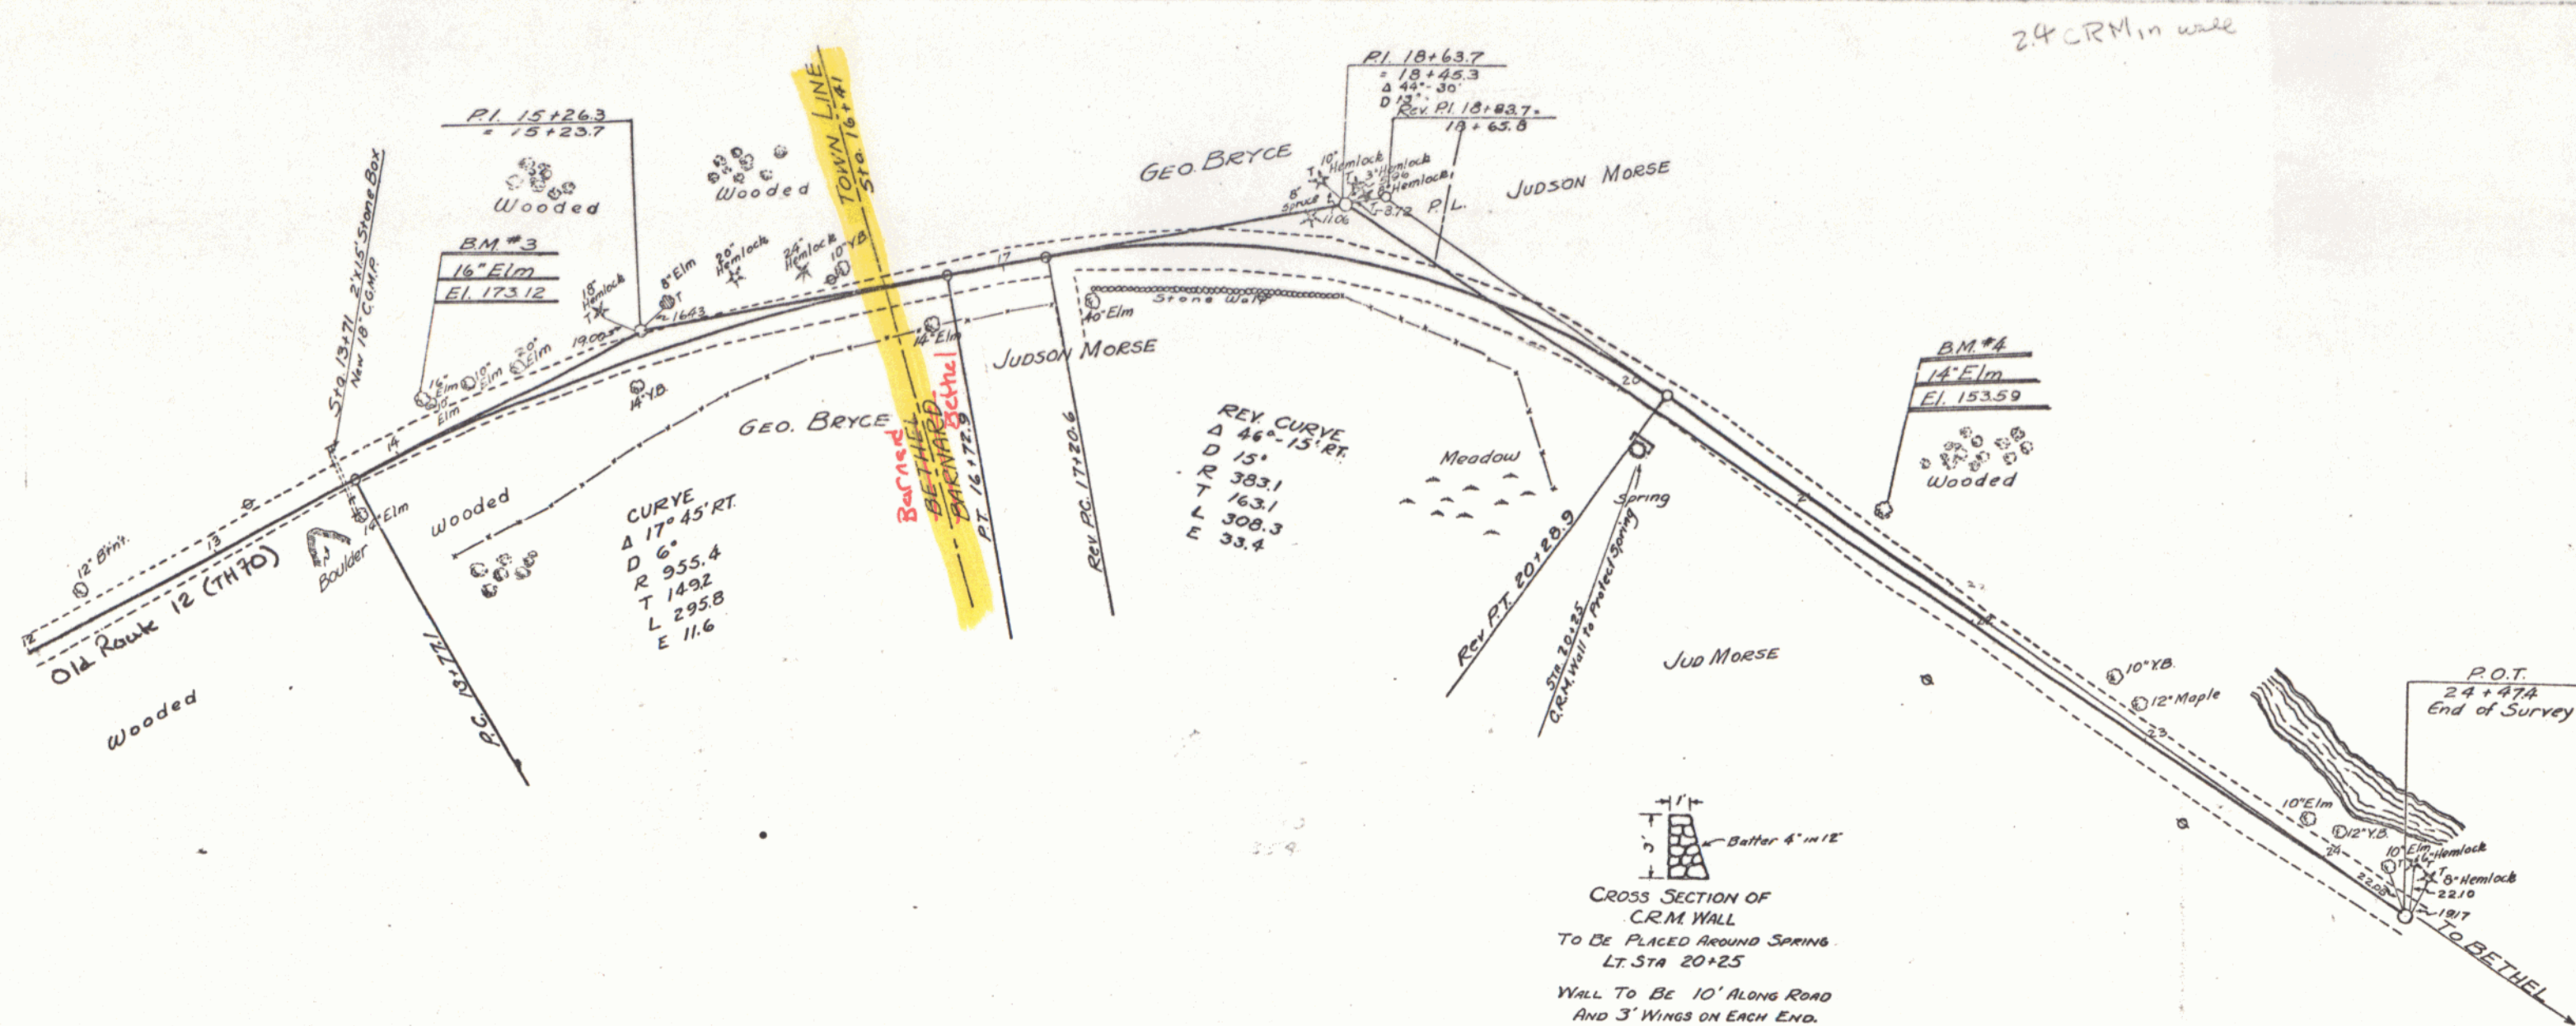

CROSS SECTION OF
CRM WALL
TO BE PLACED AROUND SPRING
LT. STA 20+25
WALL TO BE 10' ALONG ROAD
AND 3' WINGS ON EACH END.

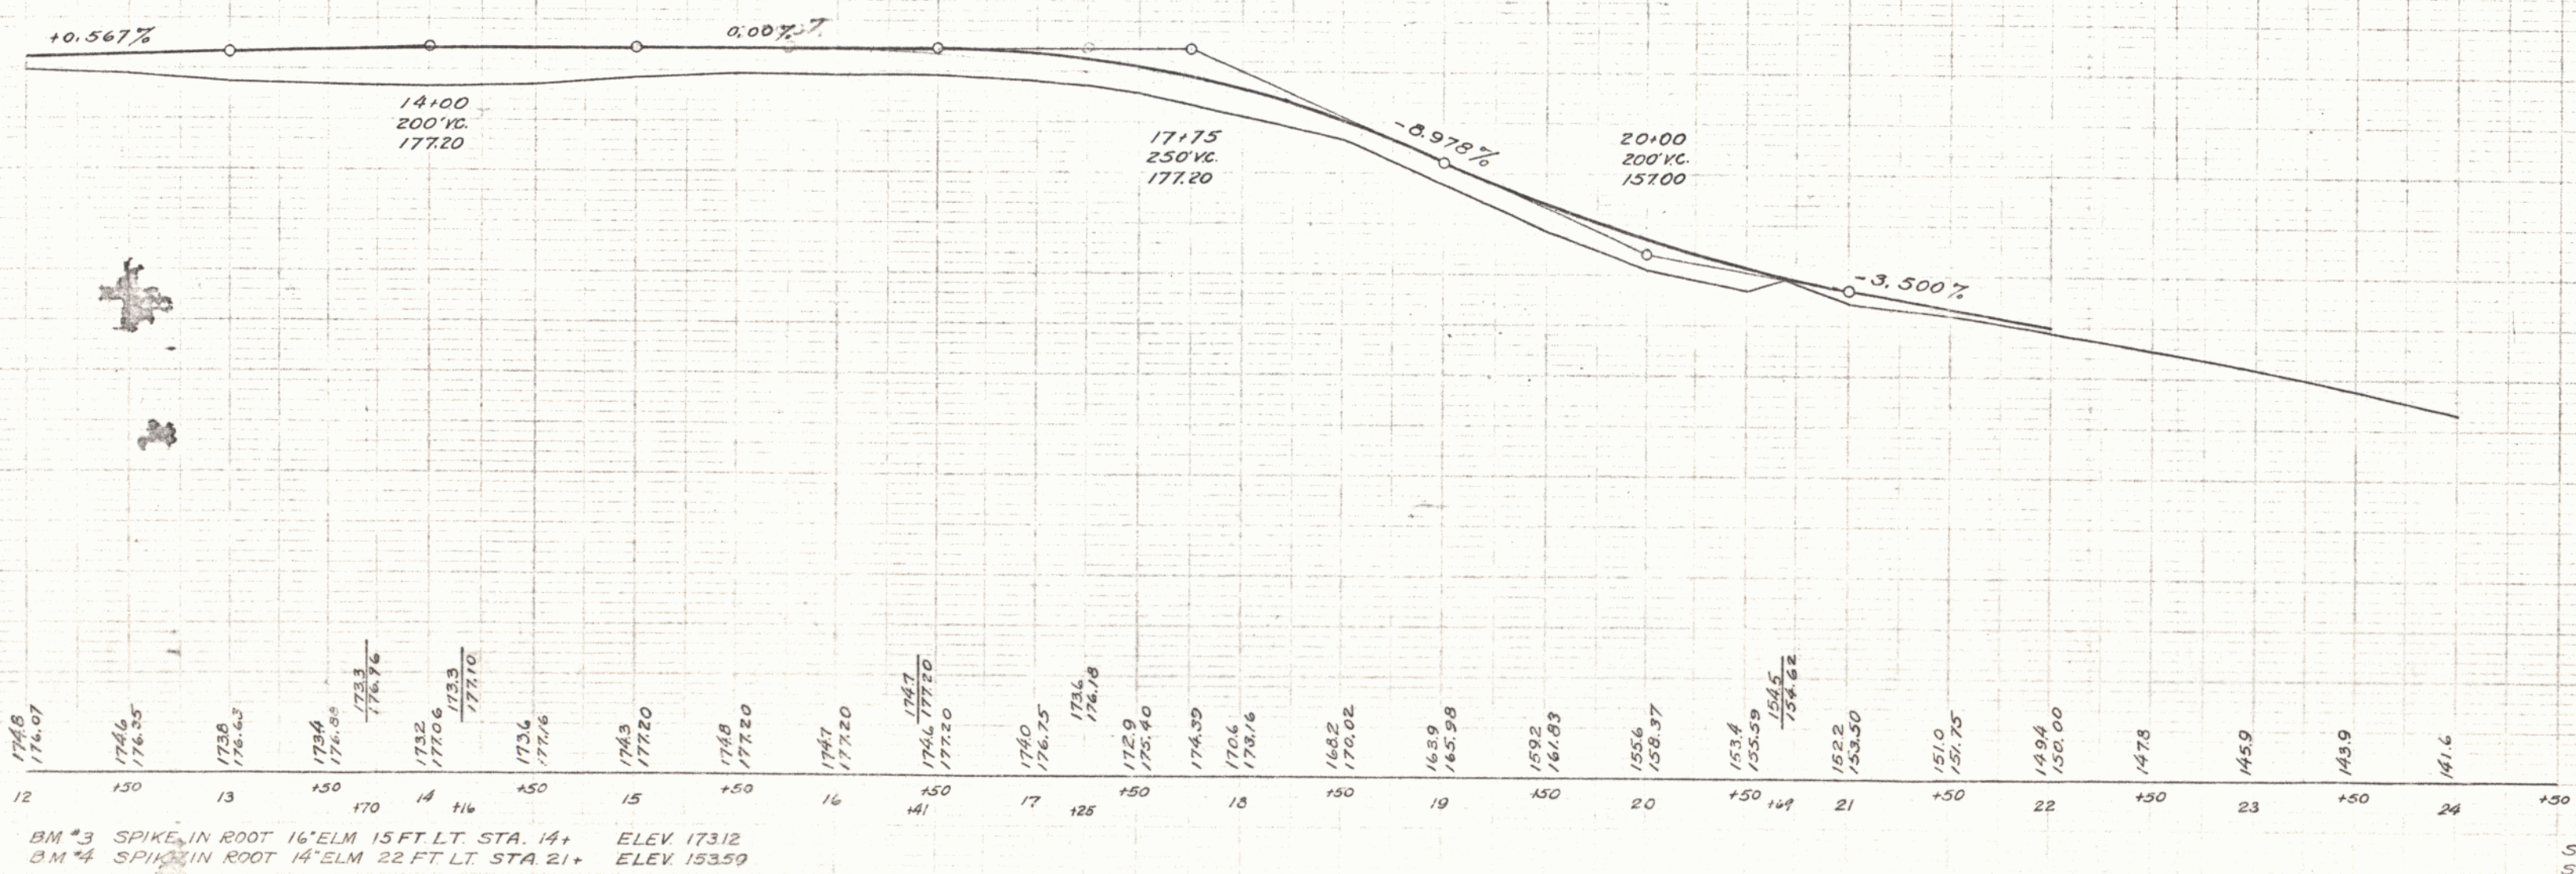

BM #3 SPIKE IN ROOT 16' ELM 15 FT LT. STA. 14+ ELEV 17312
BM #4 SPIKE IN ROOT 14' ELM 22 FT LT. STA. 21+ ELEV 15359



SERIES No. 448
SHEET 448
BARNARD

Three Cable Guard Rail / Steel Posts
 Sta 736+81-741+77 ✓ Sta 736+81-740+17 ✓


Construct Drive
 Sta 744+50 LK ✓


#68
 FRANCIS & EMMA CAMPBELL
 STA. 737+98
 WATER RIGHTS
 W.D.O.E. 11/1/54
 RECORDED: BARNARD-BK 31-PG 540-1/13/55

STATE: VT REG. NO. 102 (2) FISCAL YEAR: 1955 POST: 45-29

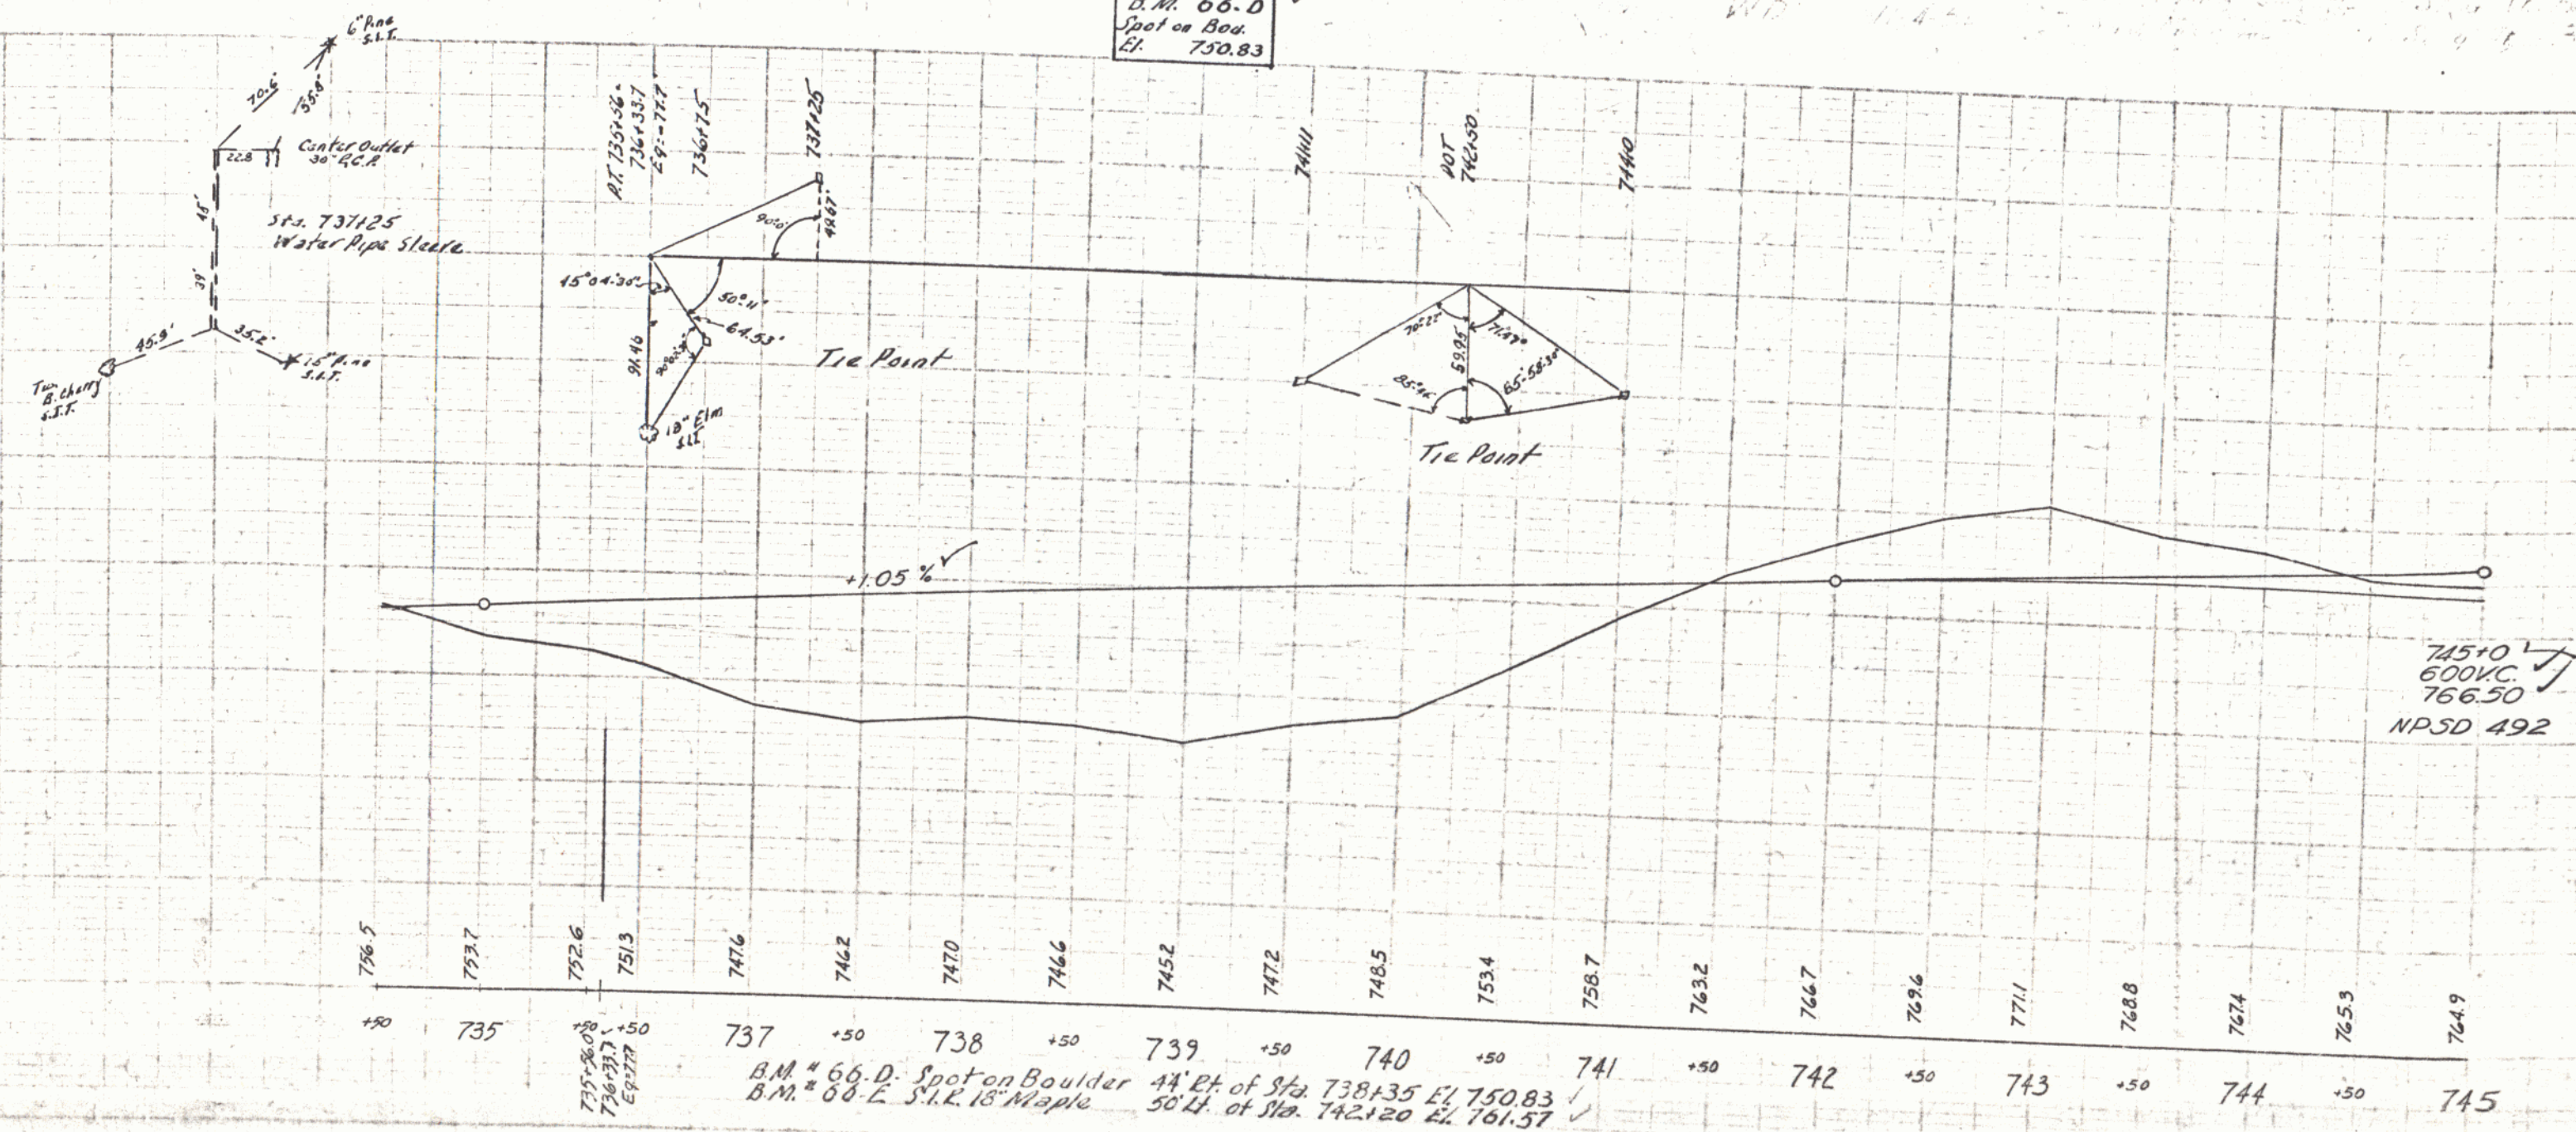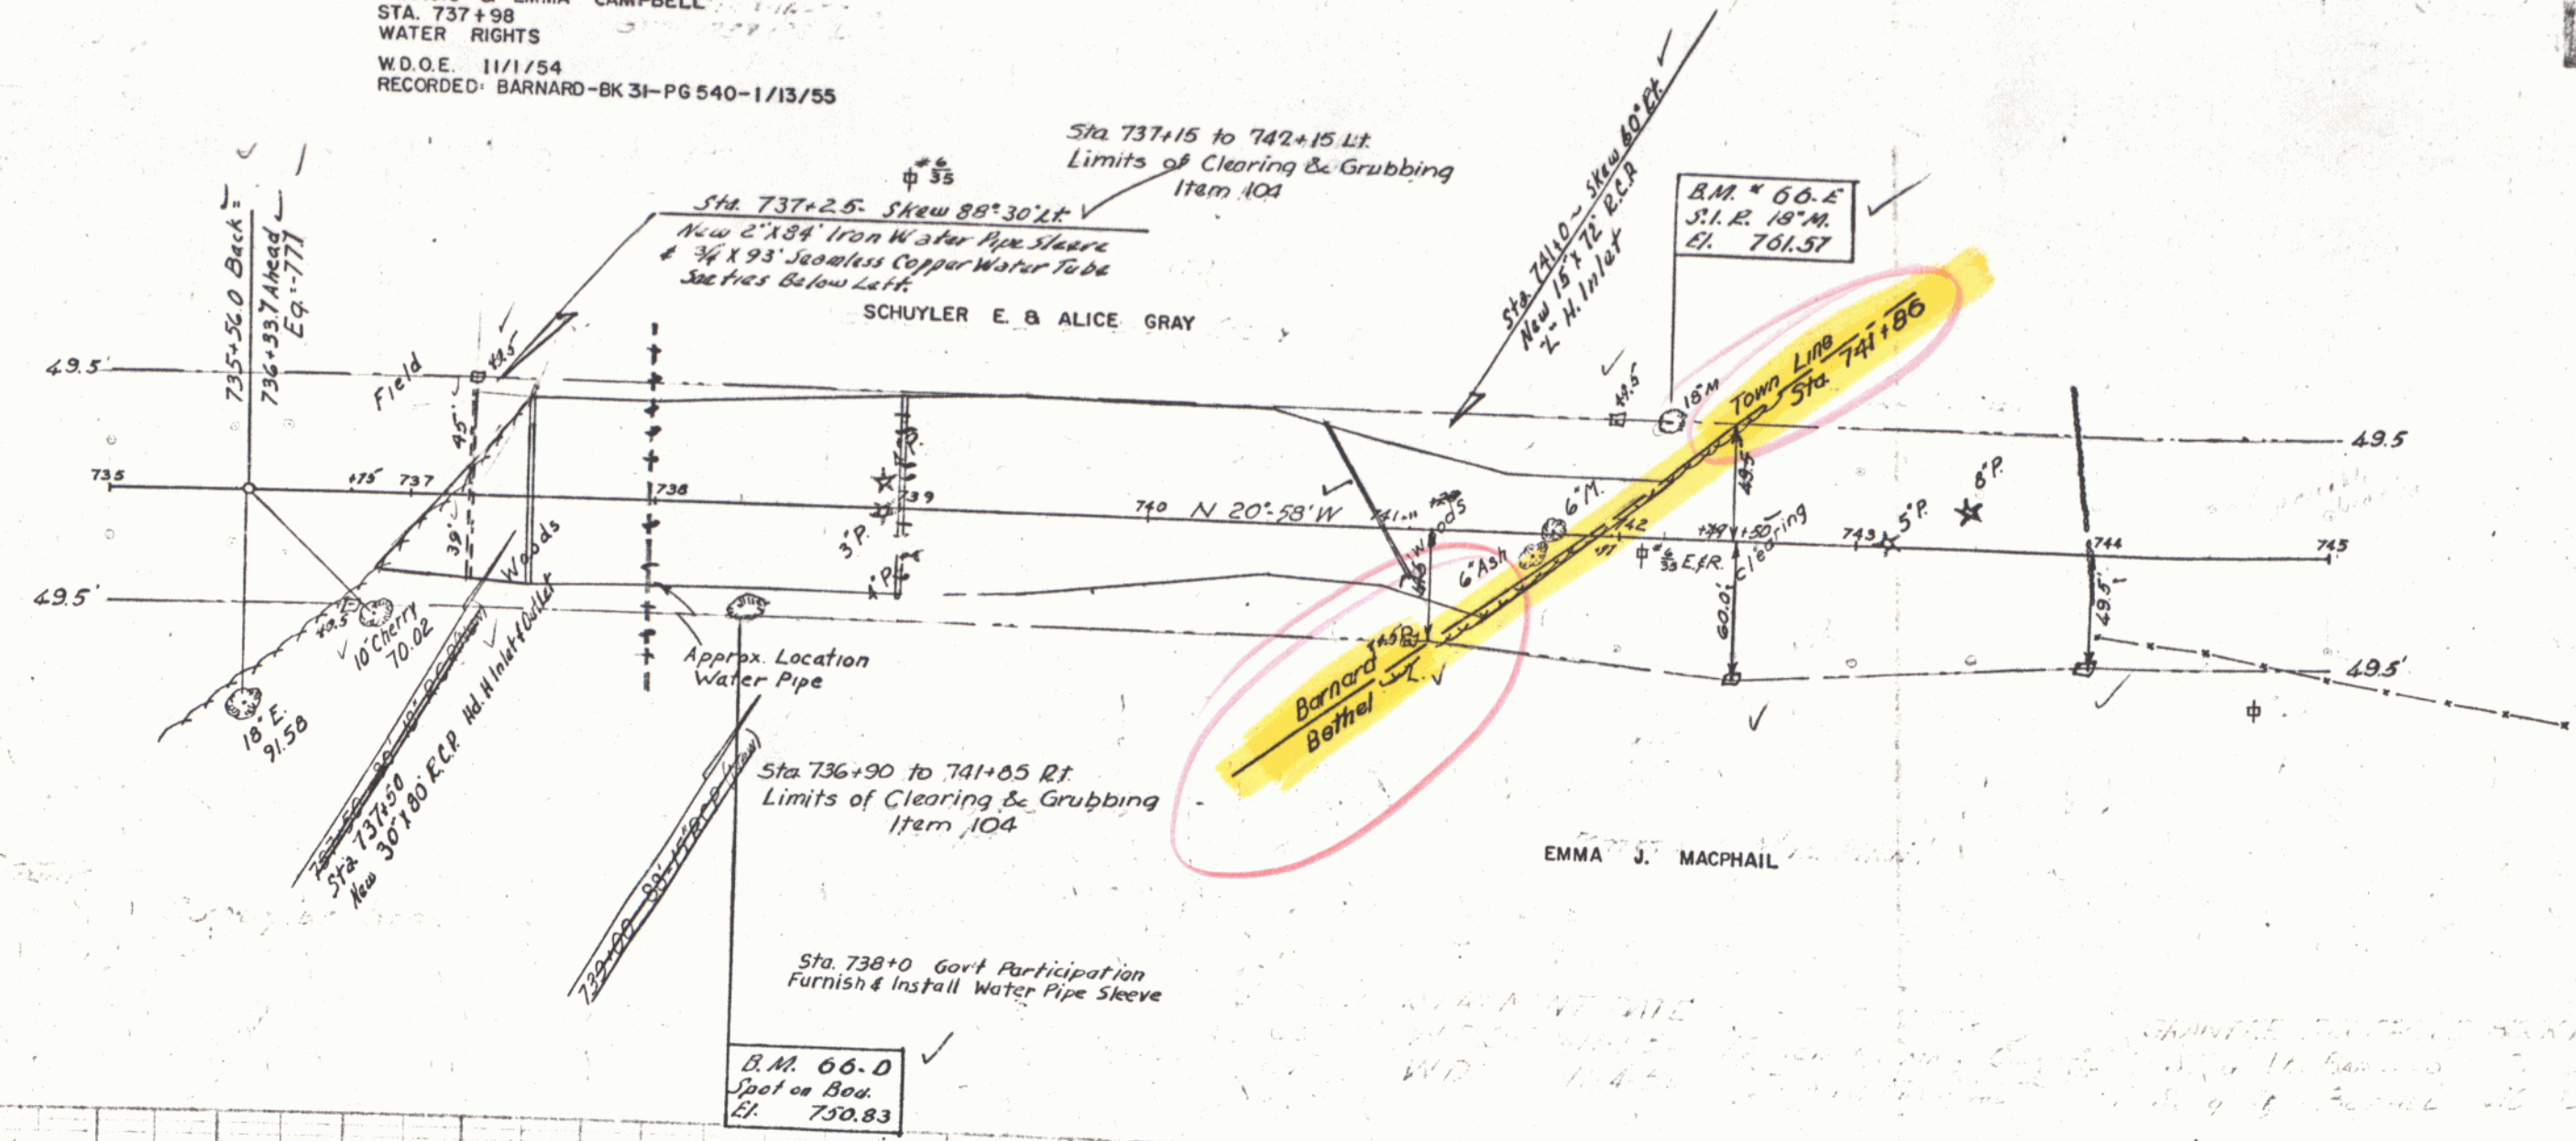

Spaulding	9-53
R. Hong	1-54
G. Guest	1-54
Z.W. Esper	5-54

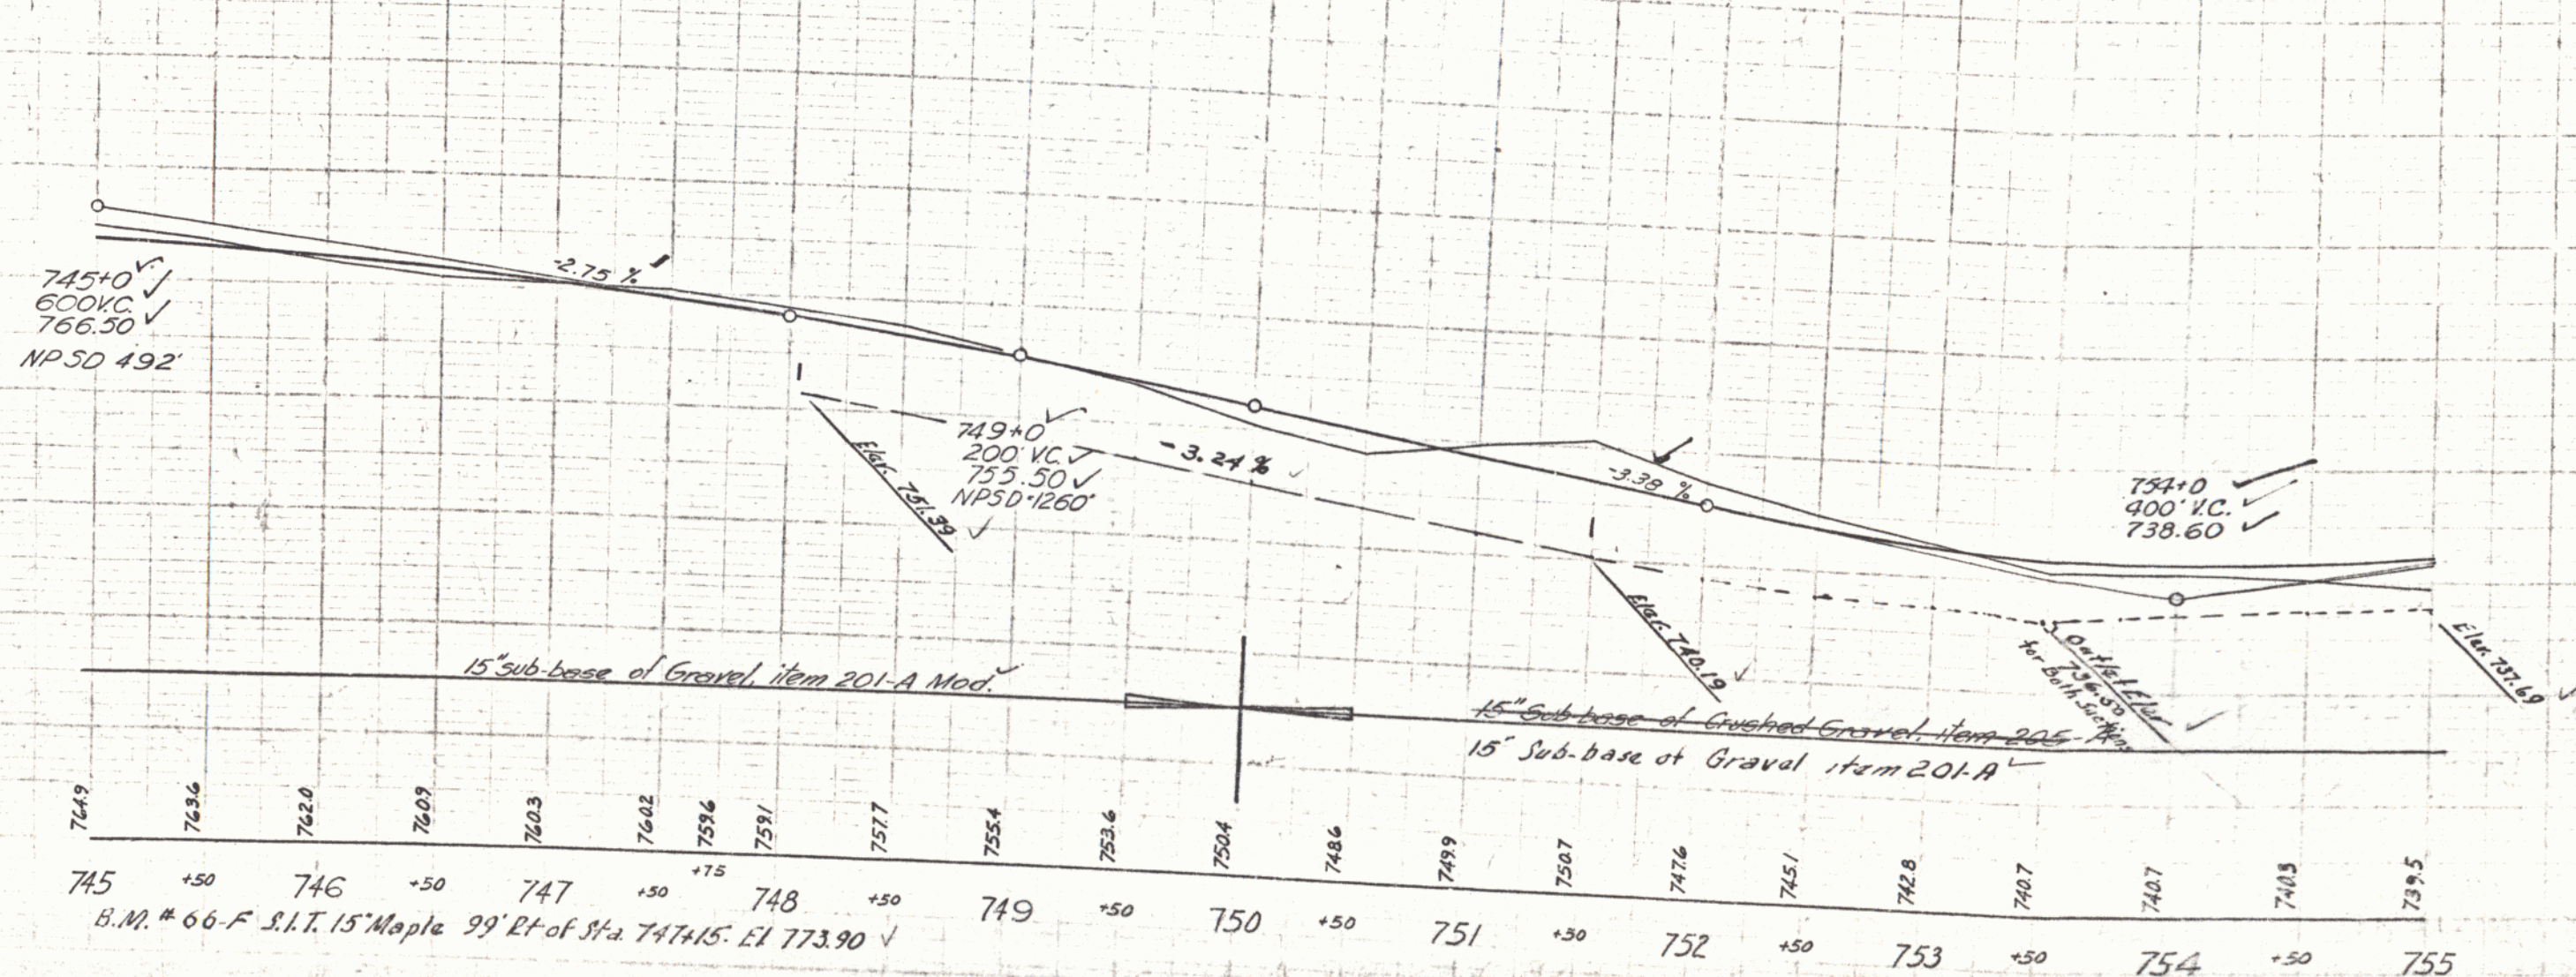


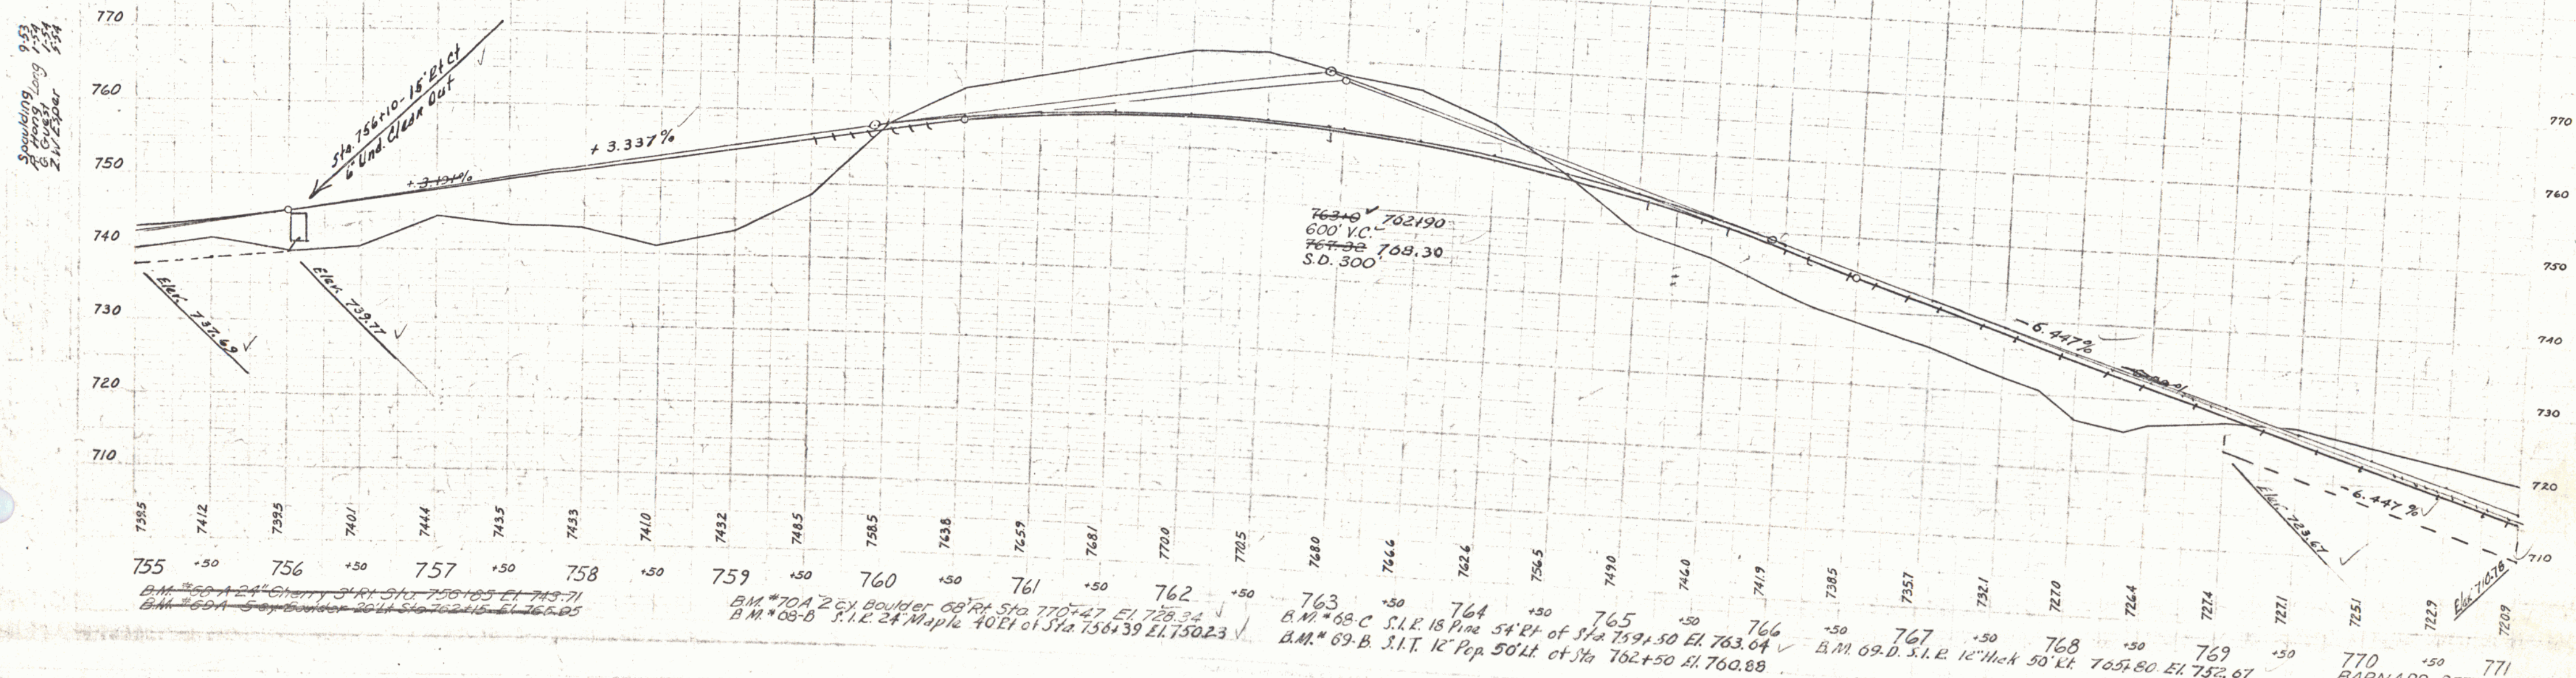


Spaulding	9-53
A. Parker	11-53
Z. W. Esper	11-53

Spaulding	9-53
A. Hong	1-54
G. Gust	1-54
W. F. Deet	5-54

70
RANDOLPH LUMBER CO., INCORPORATED
STA. 763+25-788+99
5.85 ACRES ±
STA. 765+50, 768+00, 781+50, 788+80
CULVERT RIGHTS
W.D. 11/4/54
RECORDED- BETHEL-BK 40-PG 540-5/20/54

PUB. NO. DIV. NO.	STATE	FED. AID PROJECT	FISCAL YEAR	SHEET NO.
1	VT.	F 142 (2)	POST WAR	48

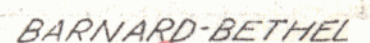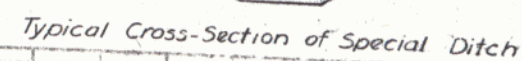

Three Cable Guard Rail / Steel Posts
 Lt. Sta. 781+49 - 788+15 Rt. Sta. 782+11 - 788+62

Rev PI 785+79.1
 785+06.9
 Start PI 785+38.9
 785+77.5
 $\Delta = 40^{\circ} 58'$
 $D = 3^{\circ}$

Sta 789+0 Lt. Construct Approach
 Construct Drive Sta 781+25 Lt.

VT. F-42 131 POST 43 296

781+43 to 781+82 Lt.
 Limits of Clearing & Grubbing
 Item 104

Sta 781+43 - Skew 47° Rt.
 New 30' x 108' ACC. LAMP
 No. H. Inter. Outlet

RANDOLPH LUMBER CO. INCORPORATED

RANDOLPH LUMBER CO. INCORPORATED

Rev Curve Data
 $\Delta = 44^{\circ} 40' Rt.$
 $D = 3^{\circ} 20'$
 $R = 1719.1$
 $T = 706.2$
 $L = 1340.2$
 $E = 139.4$
 Bank $\frac{3}{4}$ per ft

71 A
 ROY J. & LAURA M. STILLWELL
 STA. 788+99-794+50
 0.55 ACRE $\pm$
 W.D. 10/30/54
 RECORDED: BETHEL-BK 40-PG 541-5/20/55

B.M. # 70 F
 Spot on Boulder
 El. 609.21

779+15 to 779+65 Rt.
 Limits of Clearing & Grubbing
 Item 104

781+15 to 781+80 Rt.
 Limits of Clearing & Grubbing
 Item 104

783+25 to 783+70 Rt.
 Limits of Clearing & Grubbing
 Item 104

B.M. 70-D
 S.I.T. 1/4 Sec. 6 E.
 El. 653.08

Control of section of old highway between Station 746+08 $\pm$ 356' Lt. and Station 794+51 49.5' Lt. relinquished to Town of Bethel
 Recorded Book A1, Page 290-A, of Land Records,
 Date, 3rd December, 1957.

785+75
 600' VC.
 620.99

786+0
 600' VC.
 617.82

Tie Point

792+50
 300' VC.
 602.00

EQ = +290

779 B.M. 70-D. S.I.T. 1/4 Sec. 6 E. 33' E. of Sta. 780+38. El. 653.08
 B.M. # 70 F. Spot on Boulder 90' E. of Sta. 789+35 El. 609.21

BARNARD BETHEL

THE CLARKSON ENGINEERING CO., INC.
 CONSULTING ENGINEERS
 BOSTON MASSACHUSETTS

Three Cable Guard Rail / Steel Posts
 Lt. Rt.
 Sta. 795+18-796+14 Sta. 795+90-796+38
 Sta. 796+92-797+08 Sta. 797+16-797+48
 Sta. 801+50-802+50

Plank Guard Rail
Sta. 797+08 ✓

~~Construct Drives~~
~~Sta. 794+20 Lt~~
~~Sta. 794+70 R#~~

Construct	Drives
Lt.	Rt.
Sta 794+15 ✓	Sta 794+75 ✓
Sta 797+12 ✓	Sta 795+80 ✓
	Sta. 797+65 ✓

71 A Non-
ROY J. & LAURA M. STILLWELL Sta 79614-
STA. 788 + 99 - 794 + 50 Lt.
0.55 ACRE ±
W.D. 10/30/54
RECORDED: BETHEL-BK40-PG.541-5/20/55
NOTE: SEE SHEET 49

Non-Govt Participation
2" Bituminous Concrete Paving
for Bridge Deck - 576 T96 + 24 to T97 + 08
Three Cable Guard Rail / Steel Posts.
Non-Govt Participation

Sta 797+35 to 798+45 Lt.
Limits of Clearing & Grubbing
Item 104

72 A
FLORENCE E. & CLARENCE A. SHARPE
STA. 797+25—798+50
SLOPE RIGHTS

CE A. SHARPE


73 A
GLENN M. & ANNA L. BULLARD
STA. 800+66-809+50
1.45 ACRES±
W.D.O.E. 11/1/54
RECORDED: BETHEL-BK.40-PG.543-5/20/55

#718
ROY J. & LAURA M. STILLWELL
STA. 800+15 - 800+79
0.34 ACRE ±
W.D. 10/30/54
RECORDED: BETHEL - BK. 40 - PG. 541 - 5/20/55

Sta 7941⁺¹⁰ Non Gov't Participation ✓
Install sleeve for water pipe across
roadway. Item 103. (Non Gov't)
Sleeve to be furnish by Property Owner.


$$\text{STA } 794.49 = \text{STA } 6+91$$

B.M. #71 ✓
Conc. Post
Elev.: 605.26

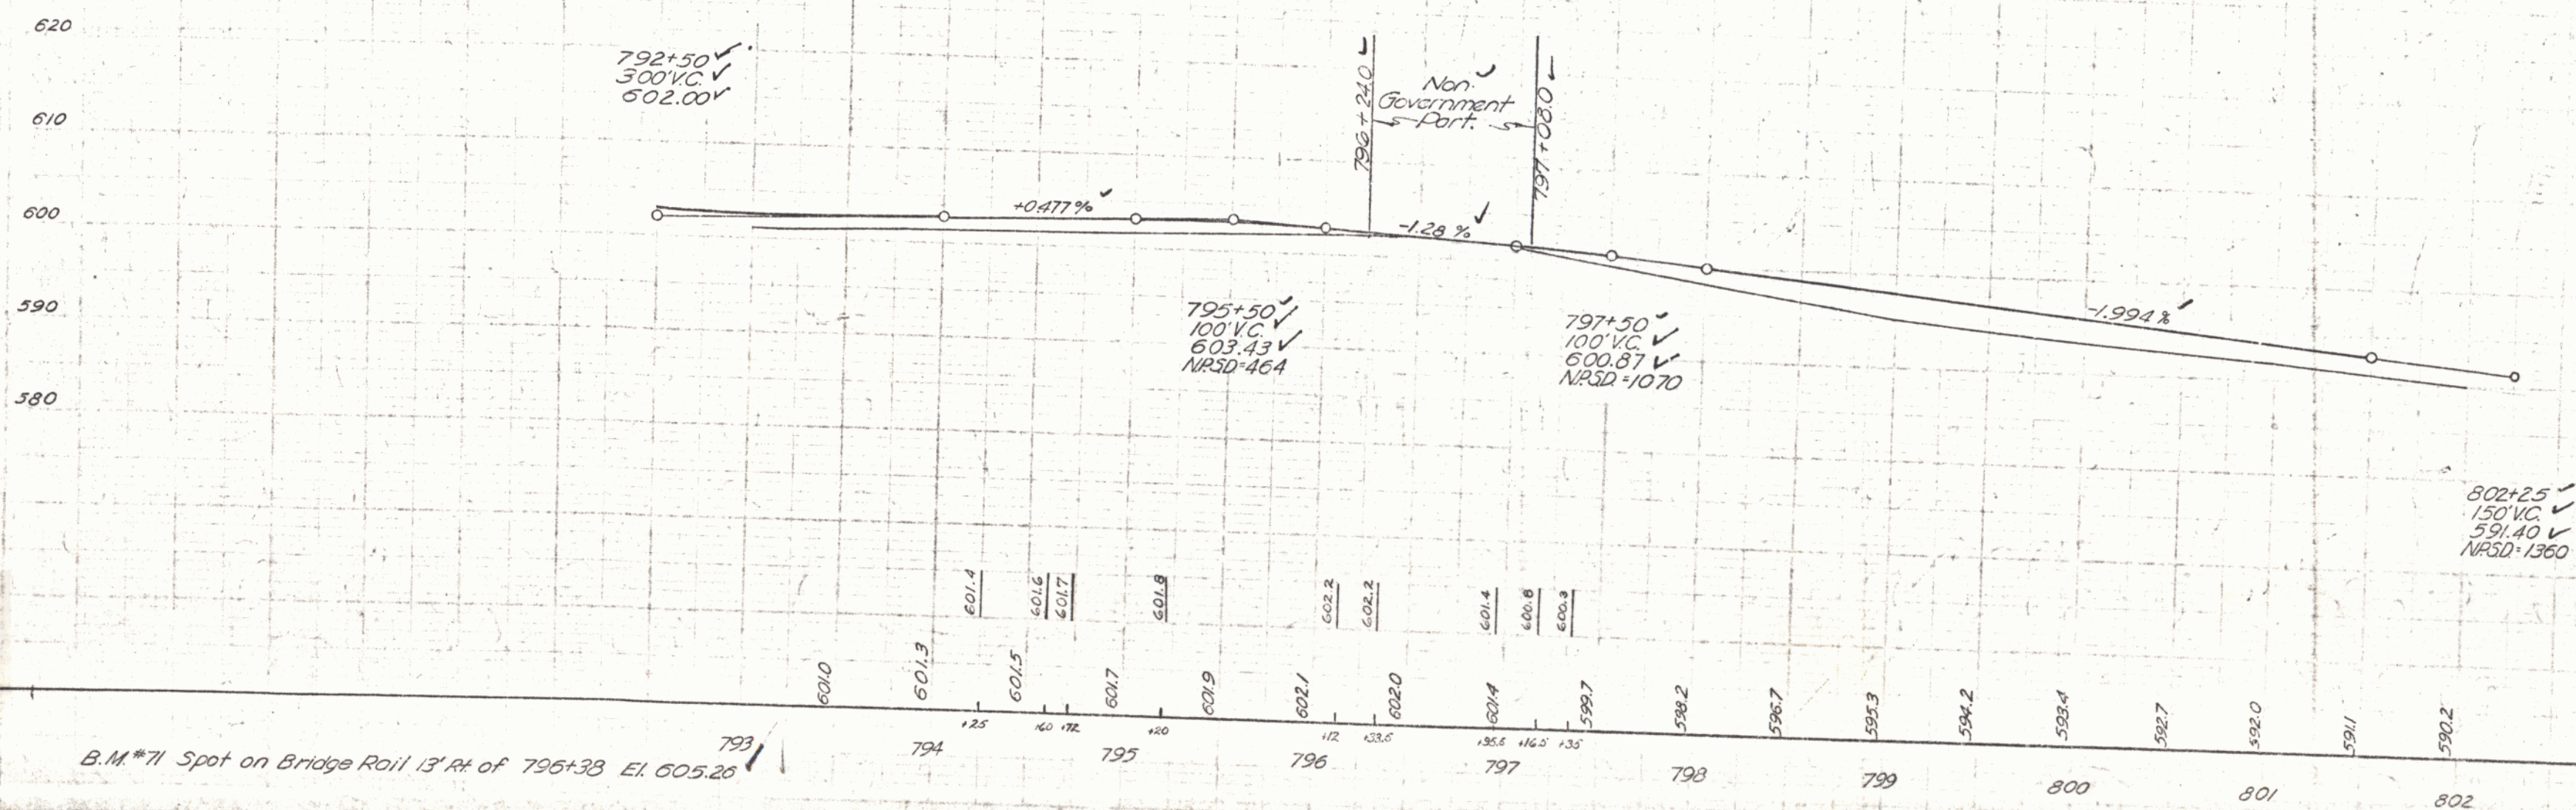


BARNARD-BETHEL

DETAIL
PWA DOC NO VT
1092-F-24-BR-11
SHEET 2 OF 13

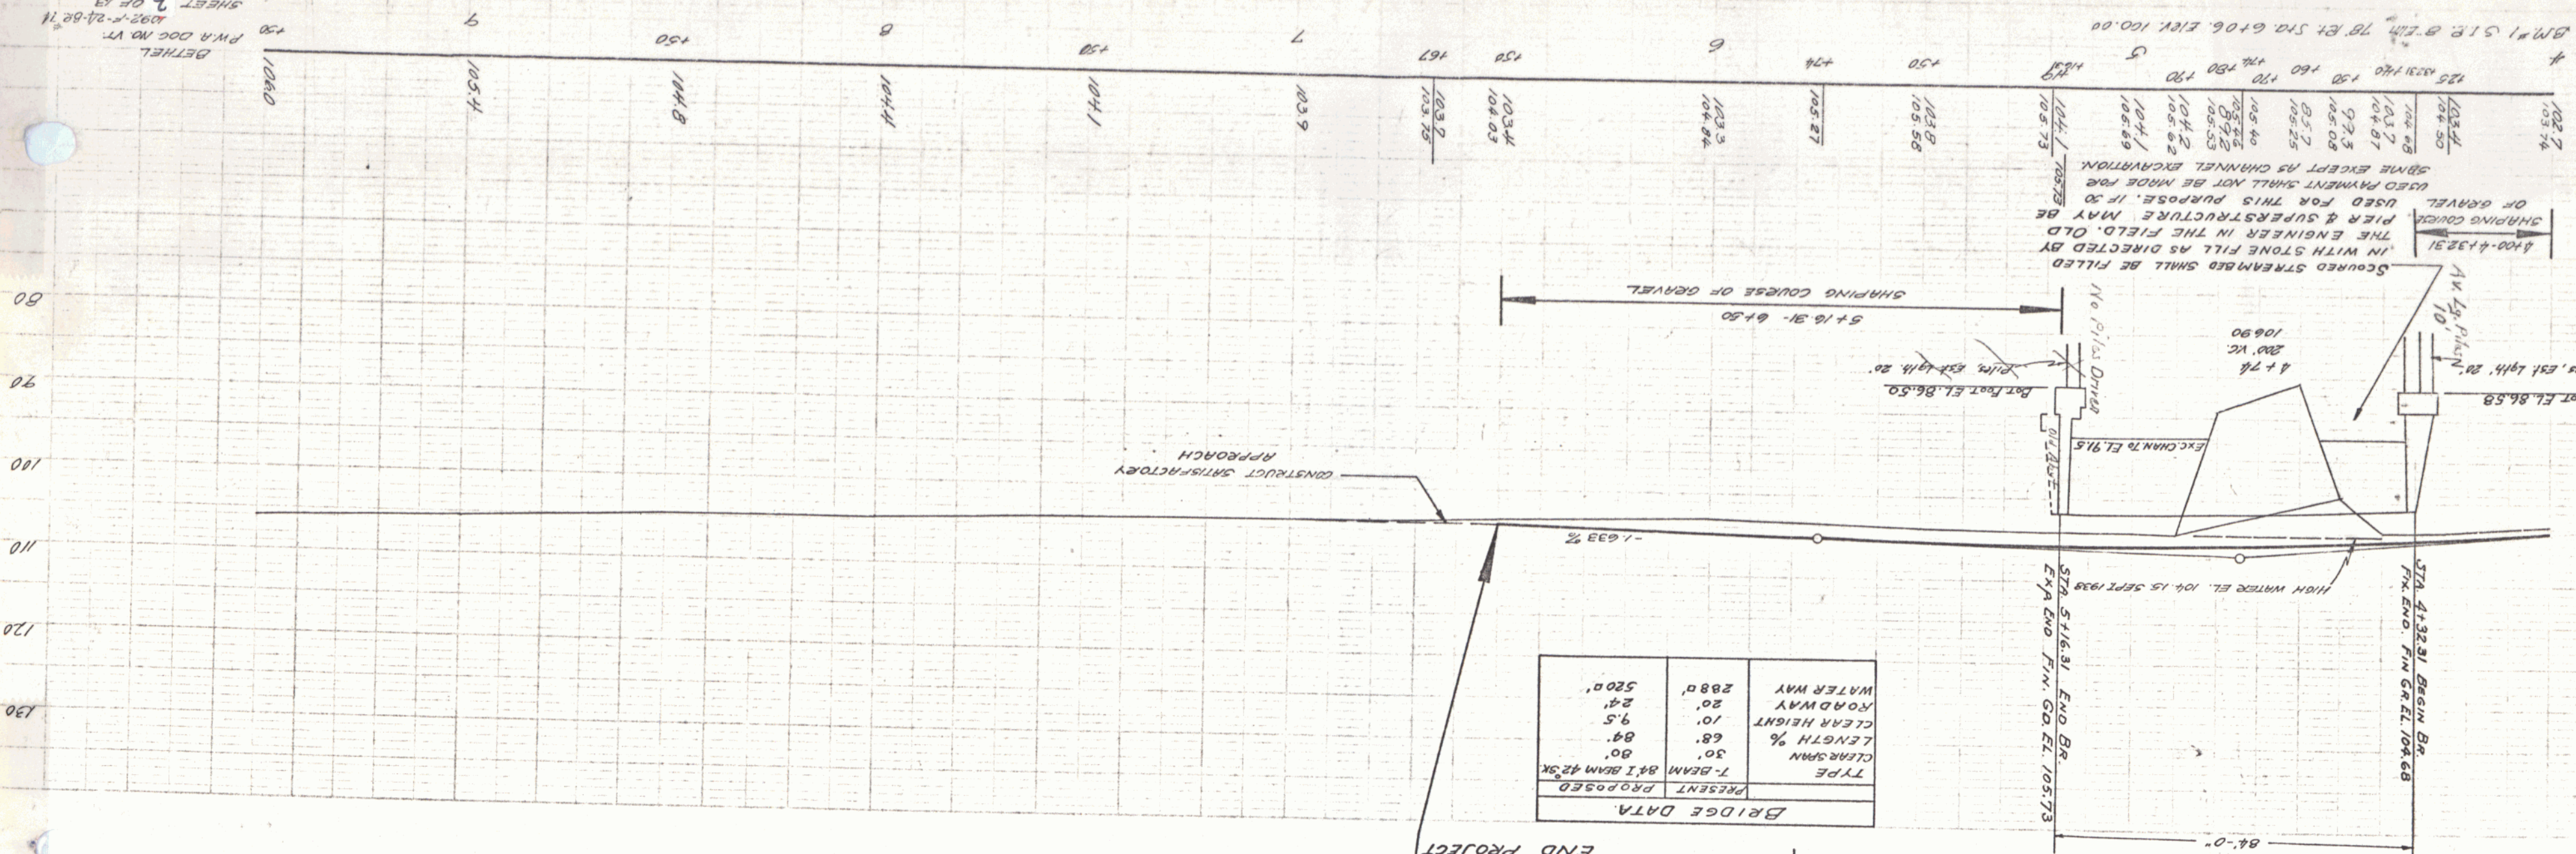


BRIDGE DATA	
TYPE	PROPOSED
PRESENT	PROPOSED
TYPE	PROPOSED
LENGTH	80'
CLEAR HEIGHT	9.5'
ROADWAY	20'
WATERWAY	28.80'
500'	

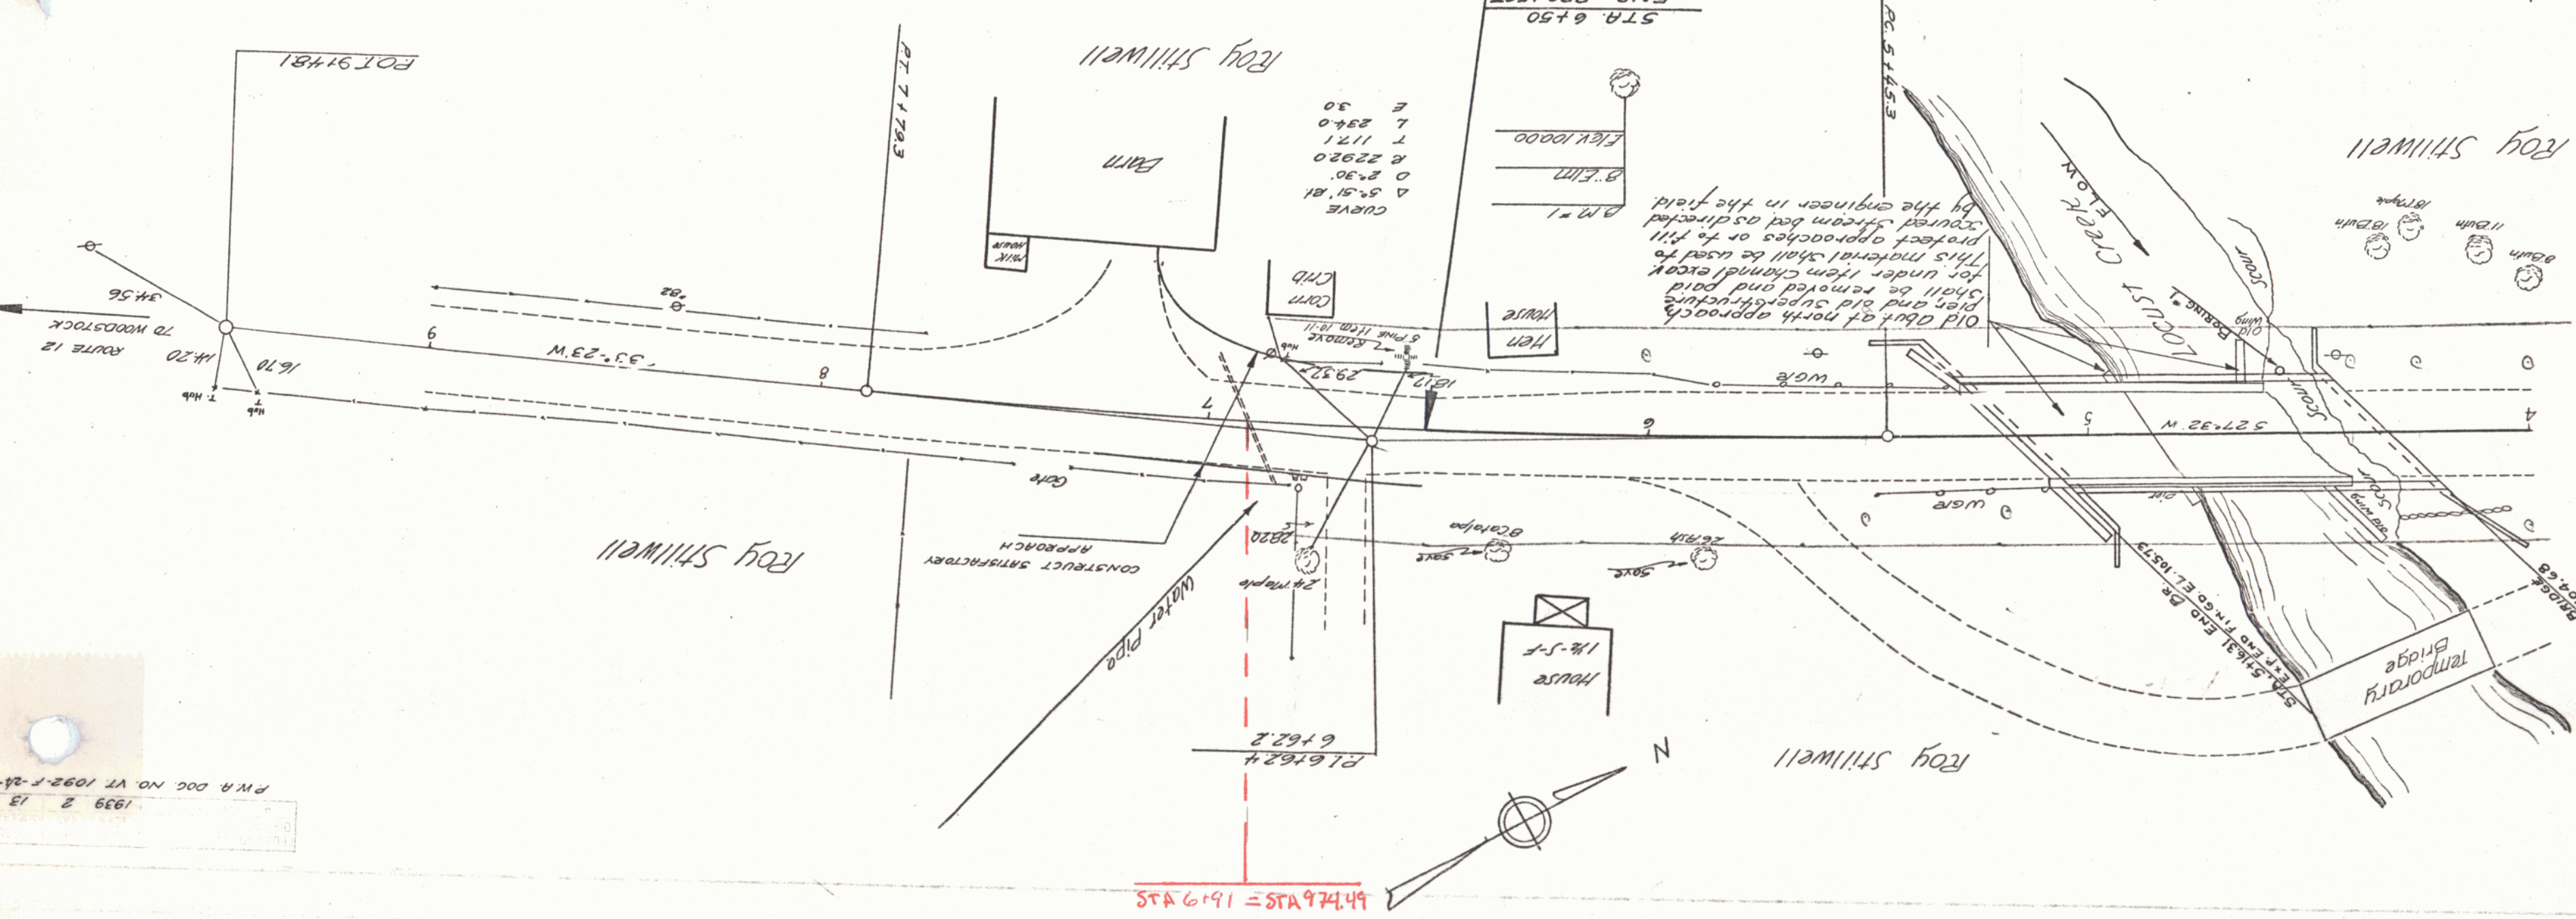

Br# 30
M.P. 1.02
RIGHT-OF-WAY DIVISION
TOWN FILE
PERPETUAL
Town of VT
(To Be Returned To R.O.W. Division)
Plans superseded by
later project

11-38
10-38
10-38

11-38
10-38
10-38

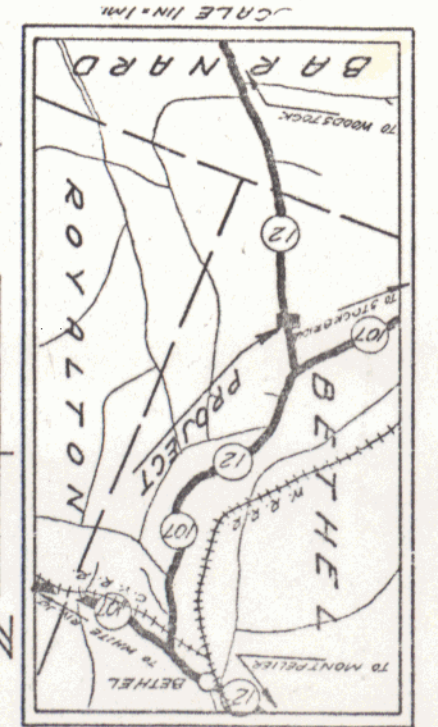


PWA Doc No VT 1092-J-24-BR-44
SHEET 50B

INDEX OF SHEETS
SHEET NO. 1-12
PLAN & PROFILE
NO. 2
DETAILS ABUTMENT NO. 1
SERIES 51 B 24 (84 FROM MODIFIED P&E 42-5KEN)
NO. 2
3.0 5C CHIL
3.0 11 BARRICADES, SIGNS, & LIGHTS
3.0 20 DETAILS G.P. & GEN. NOTES
9 STANDARD STRUCTURE SHEET 330 CABLE GUARD RAIL
10-13 CROSS SECTIONS


SUMMARY OF QUANTITIES	
NO.	ITEM
10-11	Common Excavation Incl. Borrow
15	Channel Excavation
16	Structure Excavation
18	Maintenance of Traffic
19-6	Sub-base of Gravel
22	Surface Course of Gravel
41a	Concrete Class 7
41c	Concrete Class C
42	Reinforcing Steel
43-5	Steel Superstructure (100,342')
50	Temporary Bridge (Maintenance & Removal)
51	Timber Piling
52	Heavy Stone Fill (Modified)
53	Cable Guard Rail
50a	anchors for cable guard rail
50b	Each
2300	L.F.
75	C.Y.
2380	L.F.
1	"
1	"
1.5	"
16332	Lbs
322	"
64	"
150	"
260	C.Y.
1.5	"
775	"
100	C.Y.
100	QUANT. UNIT

CURVE
D 1
E 0.9
L 2234
T 101.7
R 57296
Δ 2°02'21"

TYPICAL SECTION

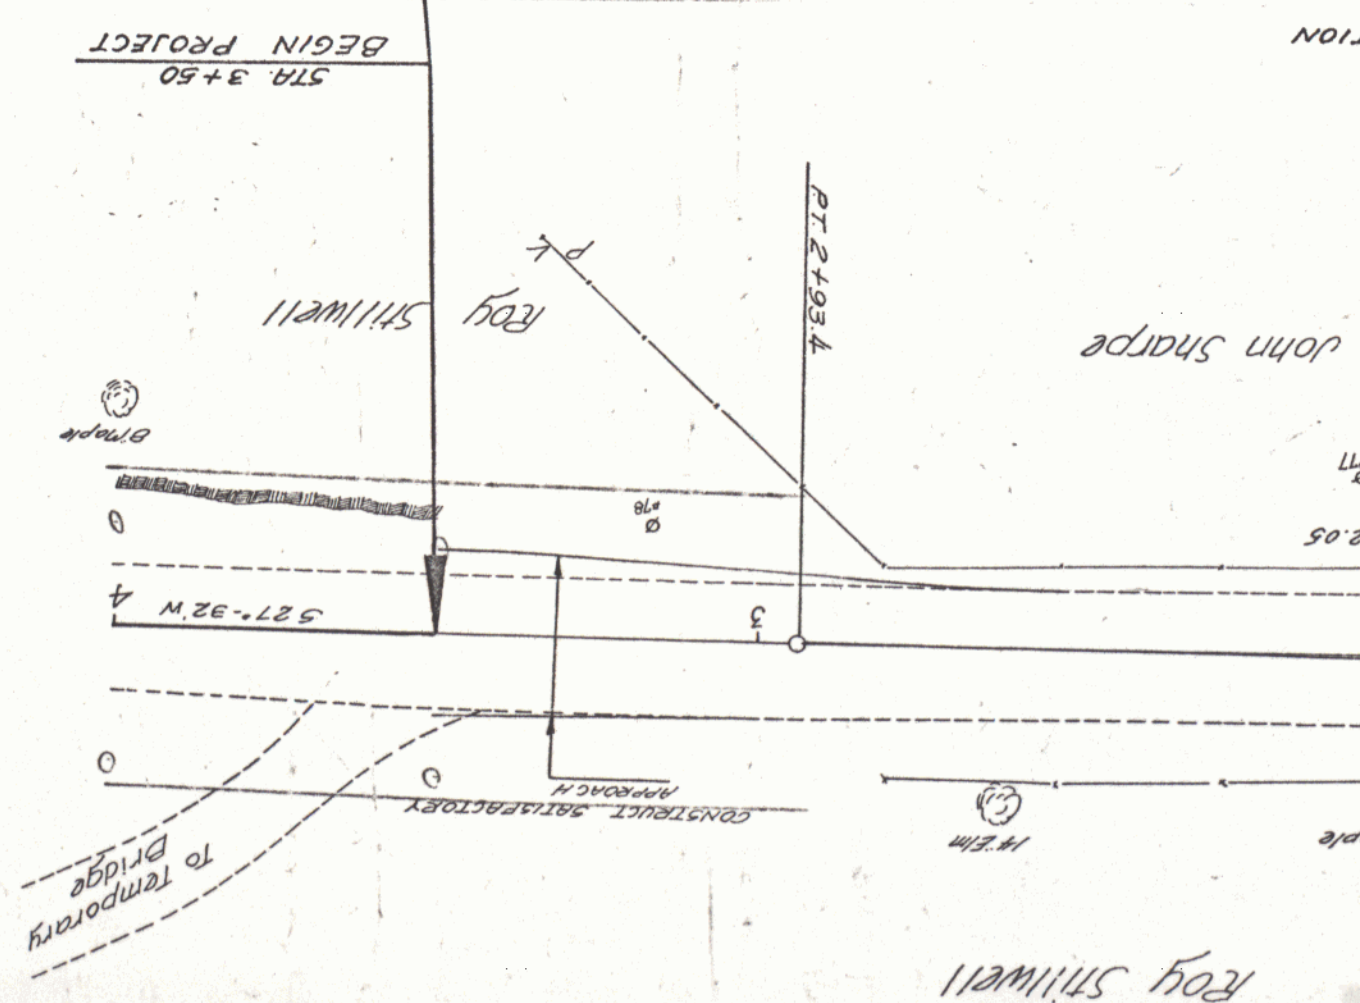

CABLE GUARD RAIL	
ITEM	QUANT. UNIT
1	100
2	100
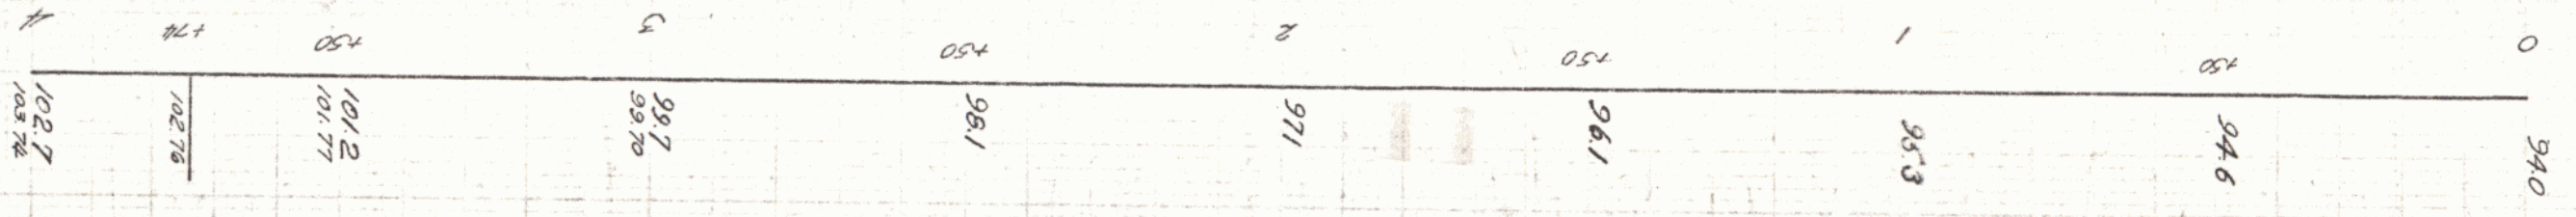

3+50-4+00
SHARPING COURSE OF
GRAVEL

CONST. SATISFACTORY
APPROACH
+4.138 %
2' HIGH WATER ELEV. 104.15 (SEPT. 1938)

BEGIN PROJECT
STA. 3+50

APPROVED
DISTRICT HIGHWAY COMMISSIONER
CORRECT
BRIDGE ENGINEER
APPROVED
COMMISSIONER OF HIGHWAY

1939 1 13
PWA Doc. No VT 1092-J-24-BR-44

DIST. # 4 PLANS

C. & R. TREE
ITEM 110

Three Cable Guard Rail / Steel Posts

Sta 801+50 - 809+34

Construct Drives

Sta 810+28

Sta 811+50

Construct Approach
Sta 810+0 Lt

Construct Drives
Sta 811+25 Rt
Sta 811+25 Lt
Sta 812+25 Rt

72 B
FLORENCE E. & CLARENCE A. SHARPE
STA. 804+00-810+27
1.03 ACRES
W.D. 11/1/54
RECORDED BETHEL-BK 40-PG 542-5/20/55

Sta 805+60 to 809+62 Lt
Limits of Clearing & Grubbing
Item 104. 1125' old shed

Surv P.I. 806+27.9
806+26.7

OWNER TO MOVE SHED & SUGAR HOUSE

old sugar house

Sta 805+81 to 808+80 Lt
New 6" x 20" Port to 10" Gal Metal

Construct Drive

corn house

$\Delta = 83^{\circ}-56'$
 $D = 19^{\circ}-00'$
 $R = 302.9$
 $T = 272.5$
 $L = 443.8$
 $E = 104.5$

B.M. # 71.8
S.I.R. 12" Pine
El. 587.00

Sta 802+10 Rt to Sta 809+50 Rt
Channel Excavation
Item 106A

Sta 801+75 Rt to Sta 809+50 Rt
Limits of Stone Fill for Slope Protection
Item 521-C

Sta 803+46 to 805+90 Rt
Limits of Clearing & Grubbing
Item 104

$\Delta = 12^{\circ}-22'$ Rt
 $D = 4^{\circ}$
 $R = 1432.7$
 $T = 155.2$
 $L = 309.2$
 $E = 8.4$
Bank 3/4" per ft

808+04 14" VCP Removed

73 B
GLENN M. & ANNA L. BULLARD
STA. 808+40-809+50
0.17 ACRES
W.D. 5/17/57
RECORDED BETHEL-BK 41-PG 223-5/22/57

FRANK M. & MARY M. ARNOLD
B.M. # 72
S.I.R. 30" M
El. 591.51


P.I. 5+00.0
3+98.8
P.I. 810+65.2
810+64.5

STA 812+00
END PROJECT F142(2)

$\Delta = 7^{\circ}-43'$
 $D = 1^{\circ}-30'$
 $R = 3819.8$
 $T = 257.6$
 $L = 514.5$
 $E = 8.7$
No Bank

Sta 809+50 Rt
Stone Fill for Slope Protection

802+25
150' V.C.
591.40

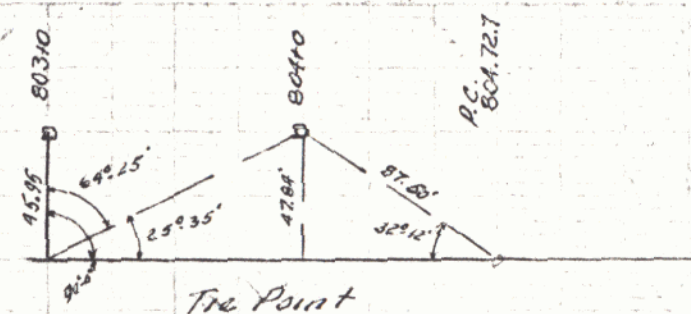

808+0
200' V.C.
594.64
N.P.S.D. = 356

811+25
250' V.C.
593.45
N.P.S.D. = 350

B.M. # 72 S.I.R. 30" Maple 43' Rt of 809+97 El. 591.51
B.M. # 71.8 S.I.R. 12" Pine 35' Lt of 804+04 El. 587.00