

INDEX OF SHEETS

- SHEET NO.
1. Title Sheet
 2. Typical Sheet
 3. Quantity Sheet
 4. Item Detail and Drainage Sheet
 - 5-8. Earthworks
 5. A-61 Rock Cuts
 6. B-1 Backfill Tables
 7. C-5 Typical Slope Grading
 8. D-6 Mock Excavation
 - 9-10. Embankment on a Slope
 9. E-11 Slope Stabilization
 10. F-1 Timber Curb
 11. D-2 Headwalls and Underdrain
 12. D-4 Underdrain Flushing Basin
 13. D-16 Drop Inlet
 14. E-1 Barricades, Signs and Lights
 15. E-31 Federal Aid Construction Identification Sign
 16. G-2a Two Cable Guard Rail
 17. G-4 Marker Posts and Guide Posts
 18. J-1 Project Markers and Boundary Markers
 19. S-8. Plate Pipe #2
 20. S-8. Plate Pipe #2
 21. Night of Way Detail Sheet
 - 22-23. Blank
 - 24-25. Plan and Profile Sheets
 - 26-27. Cross Sections
 - 28-29. Channel Sections and Pipe Details
 - 30-31. Approach Sections
 - 32-33. Binning Transitions

NOTE: For R.O.W. Details, see R.O.W. Plans for this project.

RECORD PLANS: ADDITIONAL SHEETS:

- 1-2 DRAINAGE
- 3-4 BIRM B. ROW
- 5-6 GRANULAR BORROW
- 7-8 LEDGE
- 9-10 STRIPPING OF GRAVEL PITS
- 11-12 APPROACHES REVISED
- 13-14 SHEETS FROM R.O.W.
- 15-16 SHEETS REV. X SECTIONS 85-A-20-A

STATE OF VERMONT DEPARTMENT OF HIGHWAYS

Proposed Improvement

FEDERAL AID SECONDARY PROJECT

TOWN OF ELMORE COUNTY OF LAMOILLE MONTPELIER-MORRISVILLE STATE HIGHWAY


BEGINNING AT A POINT APPROXIMATELY 1.9 MILES
NORTHERLY OF THE WORCESTER-ELMORE TOWN LINE
AND EXTENDING NORTHERLY 2.777 MILES

LENGTH OF PROJECT 1466L6 ft. = 2.777mi.

PROJECT NAME & NUMBER	TYPE OF PAV.
ELMORE S 0241(4)	BIT. CONC. 35.839 SY
RECORD PLANS	MATERIALS
SUB BASE OF GRAVEL CAMPBELL PIT	MORRISVILLE VT.
PAVING PIT	ELMORE VT.
SUB BASE OF SAND	BARROWS PIT
CUTBACK ASPHALT	SHELL OIL CO.
BIT CONC. L.M. PIPE	BURLINGTON VT.
METAL CULVERT PIPE	NORTHEAST CULVERT CO.
REINFORCED CONC. PIPE	TWO CABLE G. RAIL
WOOD GUIDE POSTS	WOOD MARKER POSTS
BOUNDARY MARKERS	PROJECT MARKERS
TREATED TIMBER CURB	PRECAST RCDS
S.T. GRISWOLD & CO. INC.	WILLISTON VT.
CONTRACTOR: GEORGE & VREDENBURGH	NEWPORT VT.
RESIDENT ENGINEER: RICHARD F. TOWNS	
INSPECTOR: ALLEN NEWTON	
RECORD PLANS: RICHARD F. TOWNS	
CONTRACT: JULY 30, 1965	STARTED: AUG. 2, 1965
COMPLETED: OCT. 8, 1965	ACCEPTED: OCT. 11, 1965


1964	ADT	155
1965	ADT	280
1965	DHV	65
	D = 70%	
	T = 4%	
	V = 50 MPH	

Pin # 99R 983

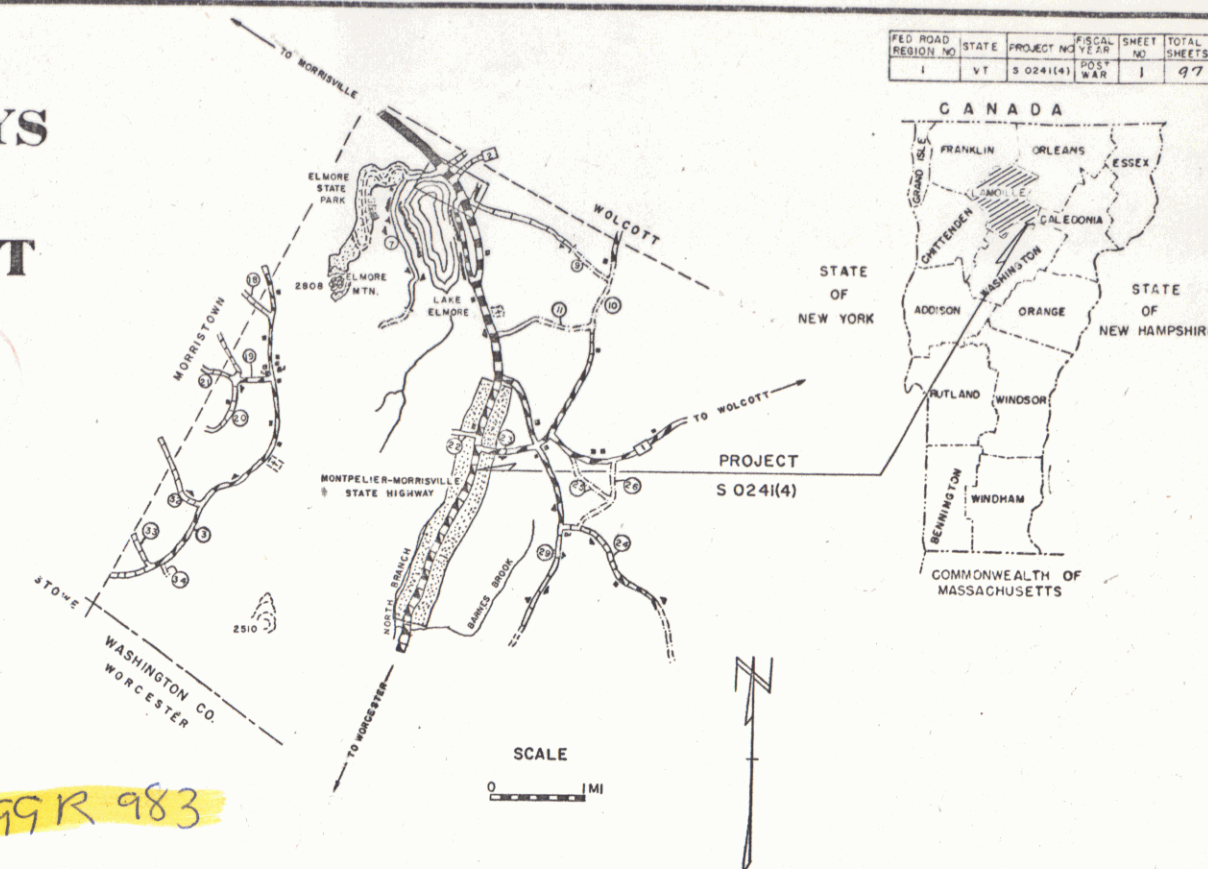


END PROJECT S 0241(3) BEGIN PROJECT S 0241(4)

M.P.I. 5.8

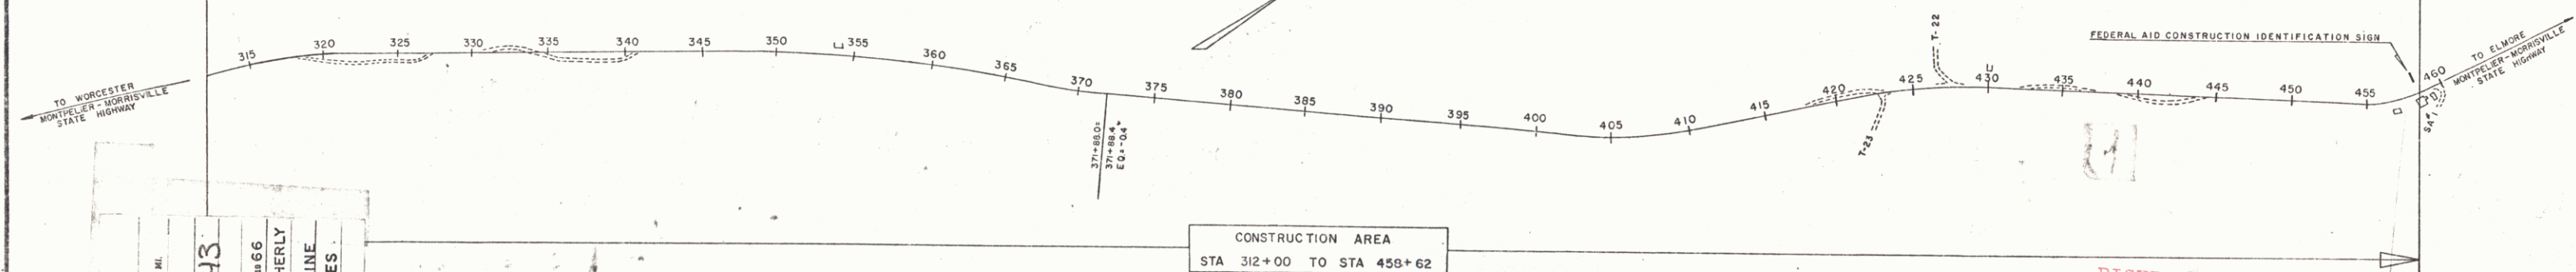

BENCH MARK
CO
COUNTY LI
TOWN LINE
FENCE LIN
STONE WA
UNFENCED
GUARD RA
TRAVELED
RAILROAD
RETAINING
CENTER L
SURVEY L
CULVERT
DROP INL
TROLLEY
POWER P
TELEPHO
TREES
HEDGE

RIGHT-OF-WAY
SLOPE RIGHTS
GROUND ELEVATION
GRADE ELEVATION
CURVE DATA
DEFLECTION OF ANGLE
DEGREE OF CURVE
RADIUS OF CURVE
TANGENT DISTANCE
LENGTH OF CURVE
EXTERNAL DISTANCE
POINT OF INTERSECTION
POINT OF CURVE
POINT OF TANGENT
POINT ON TANGENT
POINT ON SUB-TANGENT

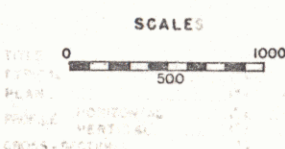

APPROVED	APPROVED	APPROVED	APPROVED	APPROVED	APPROVED	APPROVED	APPROVED	APPROVED	APPROVED
DATE 2/26/64	DATE 2/26/64	DATE 2/26/64	DATE 9/13/64	DATE 9/13/64	DATE 9/13/64	DATE 2/26/64	DATE 2/26/64	DATE 2/26/64	DATE 2/26/64

THESE PLANS ARE SUBJECT TO SUCH REVISIONS AS MAY BE
REQUIRED BY THE BUREAU OF PUBLIC ROADS OR THE COMMISSIONER
OF HIGHWAYS.
CONSTRUCTION IS TO BE CARRIED ON IN ACCORDANCE WITH THESE
PLANS AND THE STANDARD SPECIFICATIONS FOR HIGHWAY AND BRIDGE
CONSTRUCTION, DATED APRIL 1964, AS APPROVED BY THE BUREAU OF
PUBLIC ROADS ON OCTOBER 12, 1964, INCLUDING ALL SUBSEQUENT
APPROVED REVISIONS AND SUCH REVISED SPECIFICATIONS AND SPECIAL
PROVISIONS AS ARE INCORPORATED IN THESE PLANS.


DEPARTMENT OF COMMERCE BUREAU OF PUBLIC ROADS
APPROVED
DIVISION ENGINEER
DATE
PROJECT S NO. 0241(4)
SHEET 1 OF 97 SHEETS



PLAN	DATE	BY	CHKD
NO.	1/25/54	W. Smith	W. Smith
NO.	1/25/54	W. Smith	W. Smith


PROFILE	DATE	BY	CHKD
NO.	1/25/54	W. Smith	W. Smith
NO.	1/25/54	W. Smith	W. Smith

CONSTRUCT DRIVE
TWO CABLE GUARD RAIL
REMOVING AND RESETTIN
TWO CABLE GUARD RAIL WITH
WOOD POSTS
MUCK EXCAVATION

NOTE
ALL DRIVES WILL HAVE A
MINIMUM 12' WIDTH AND
15 FEET RADIUS

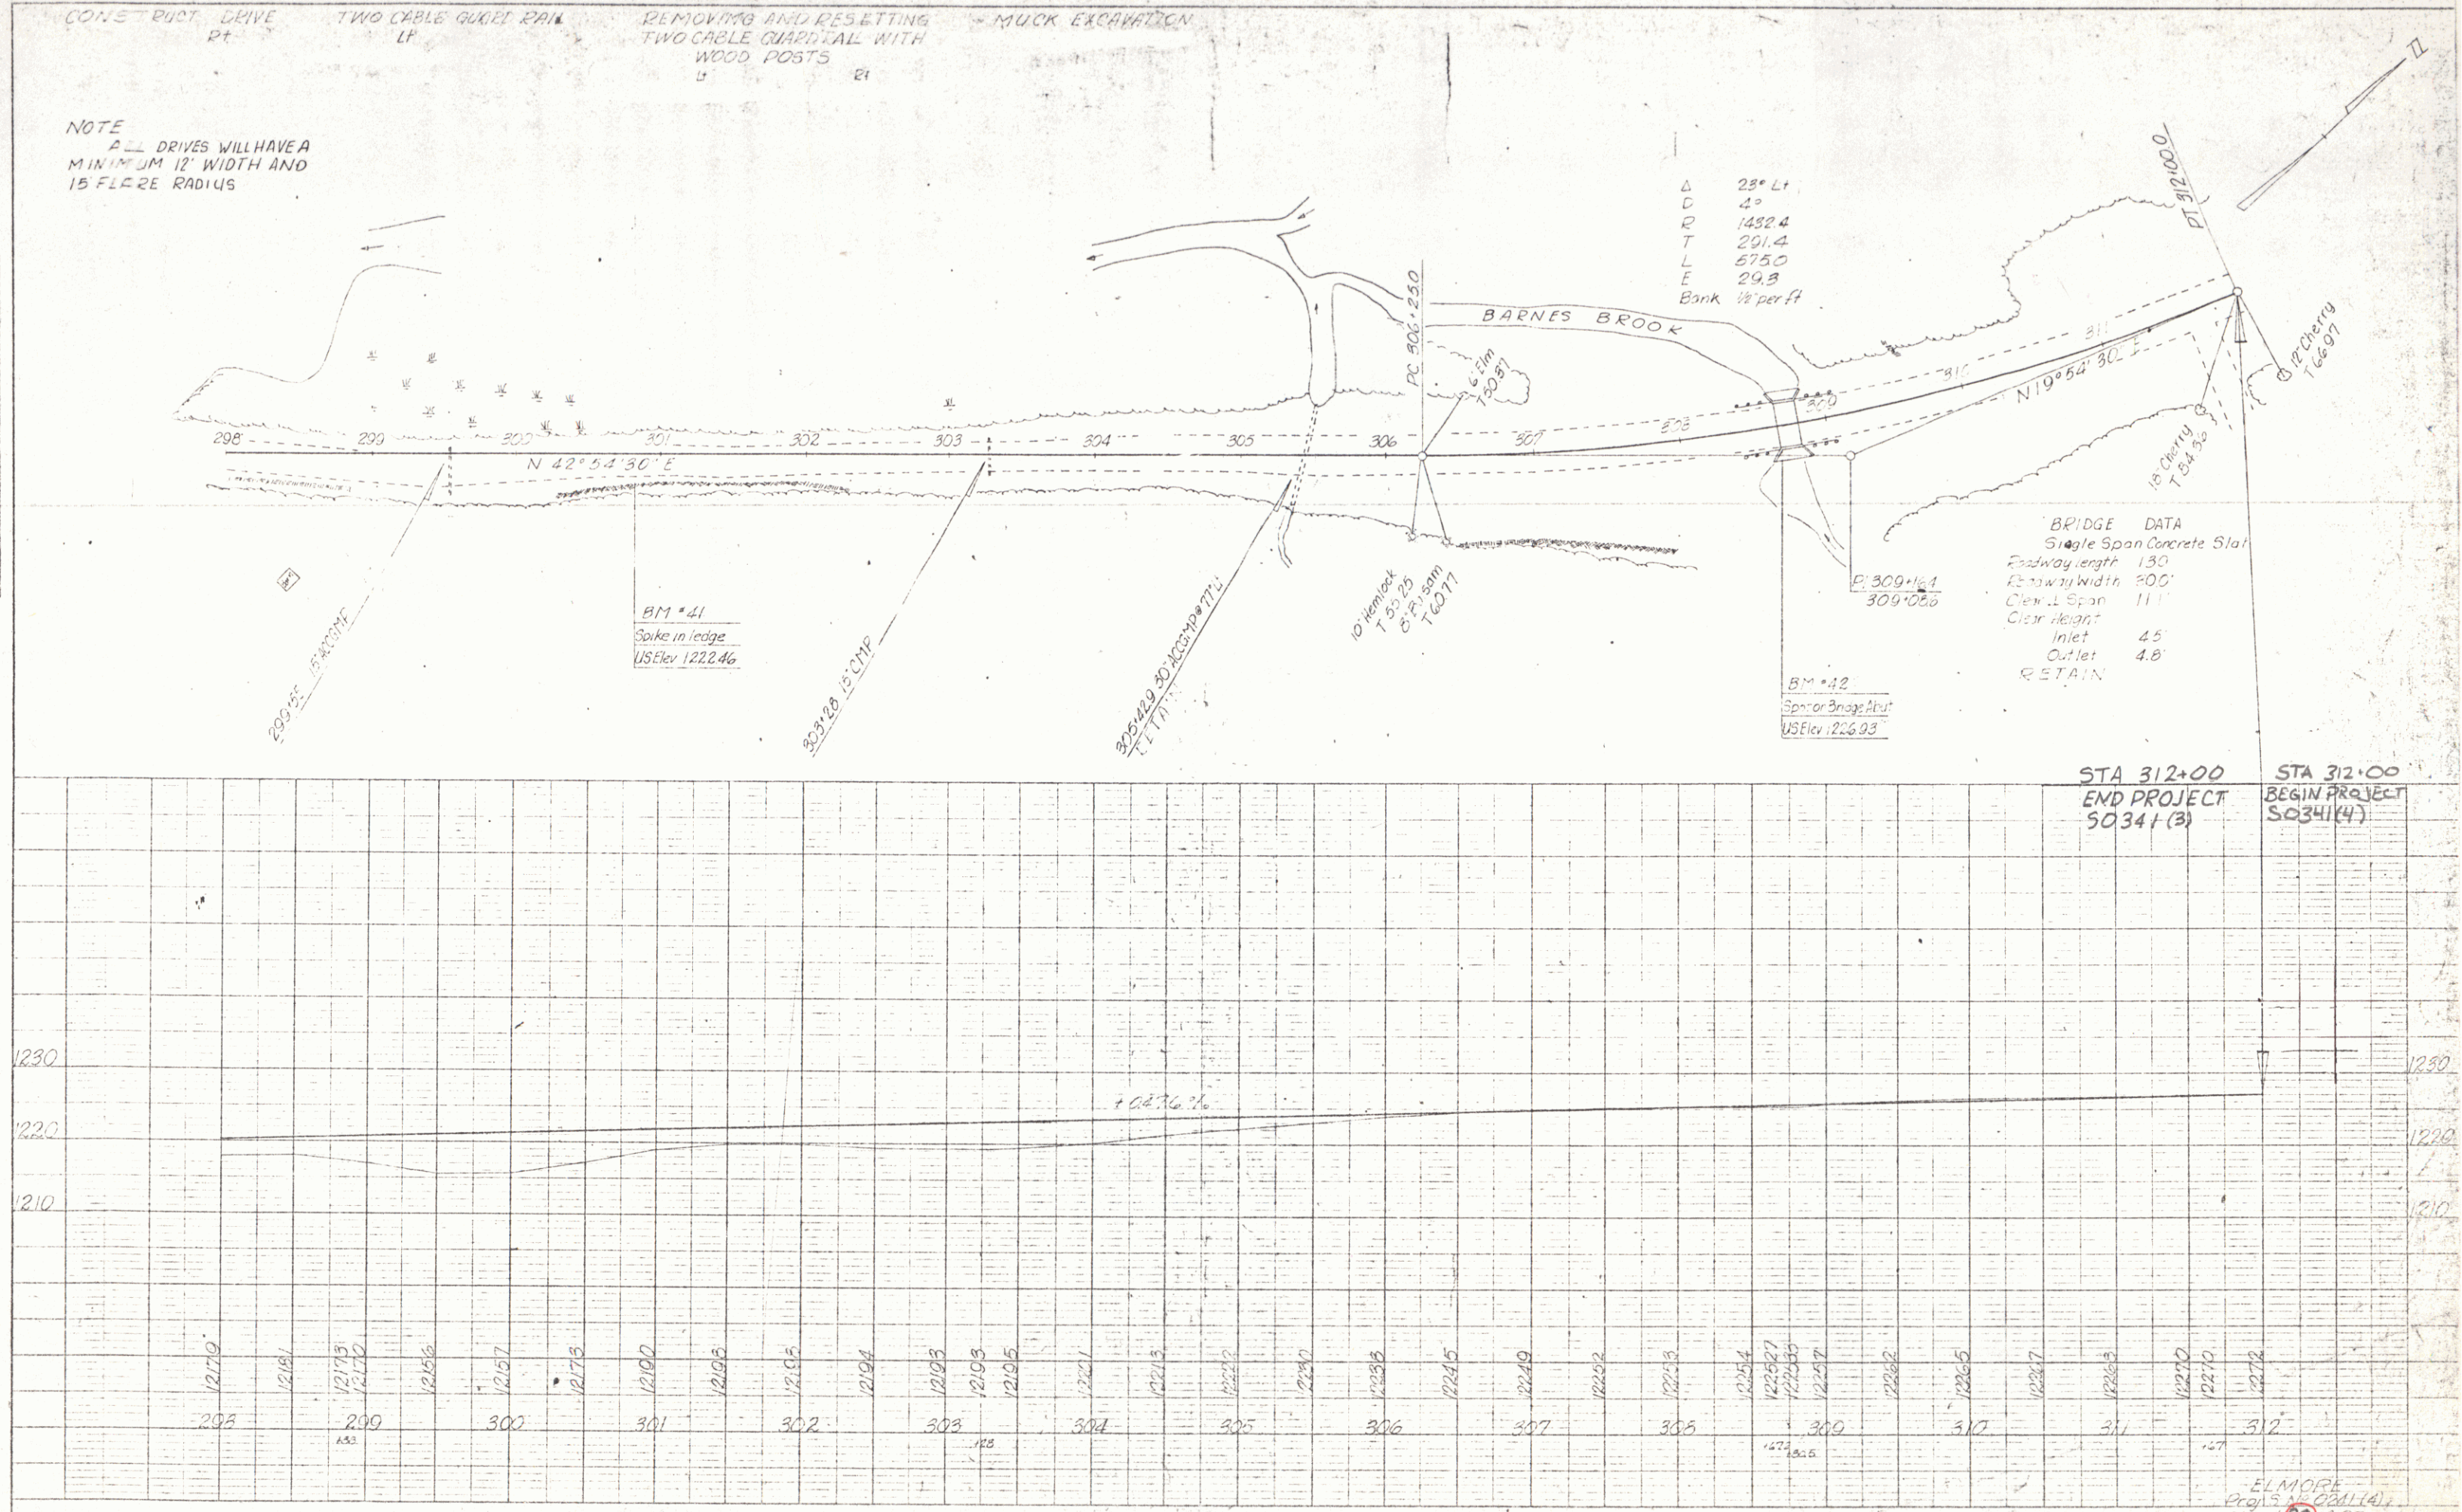

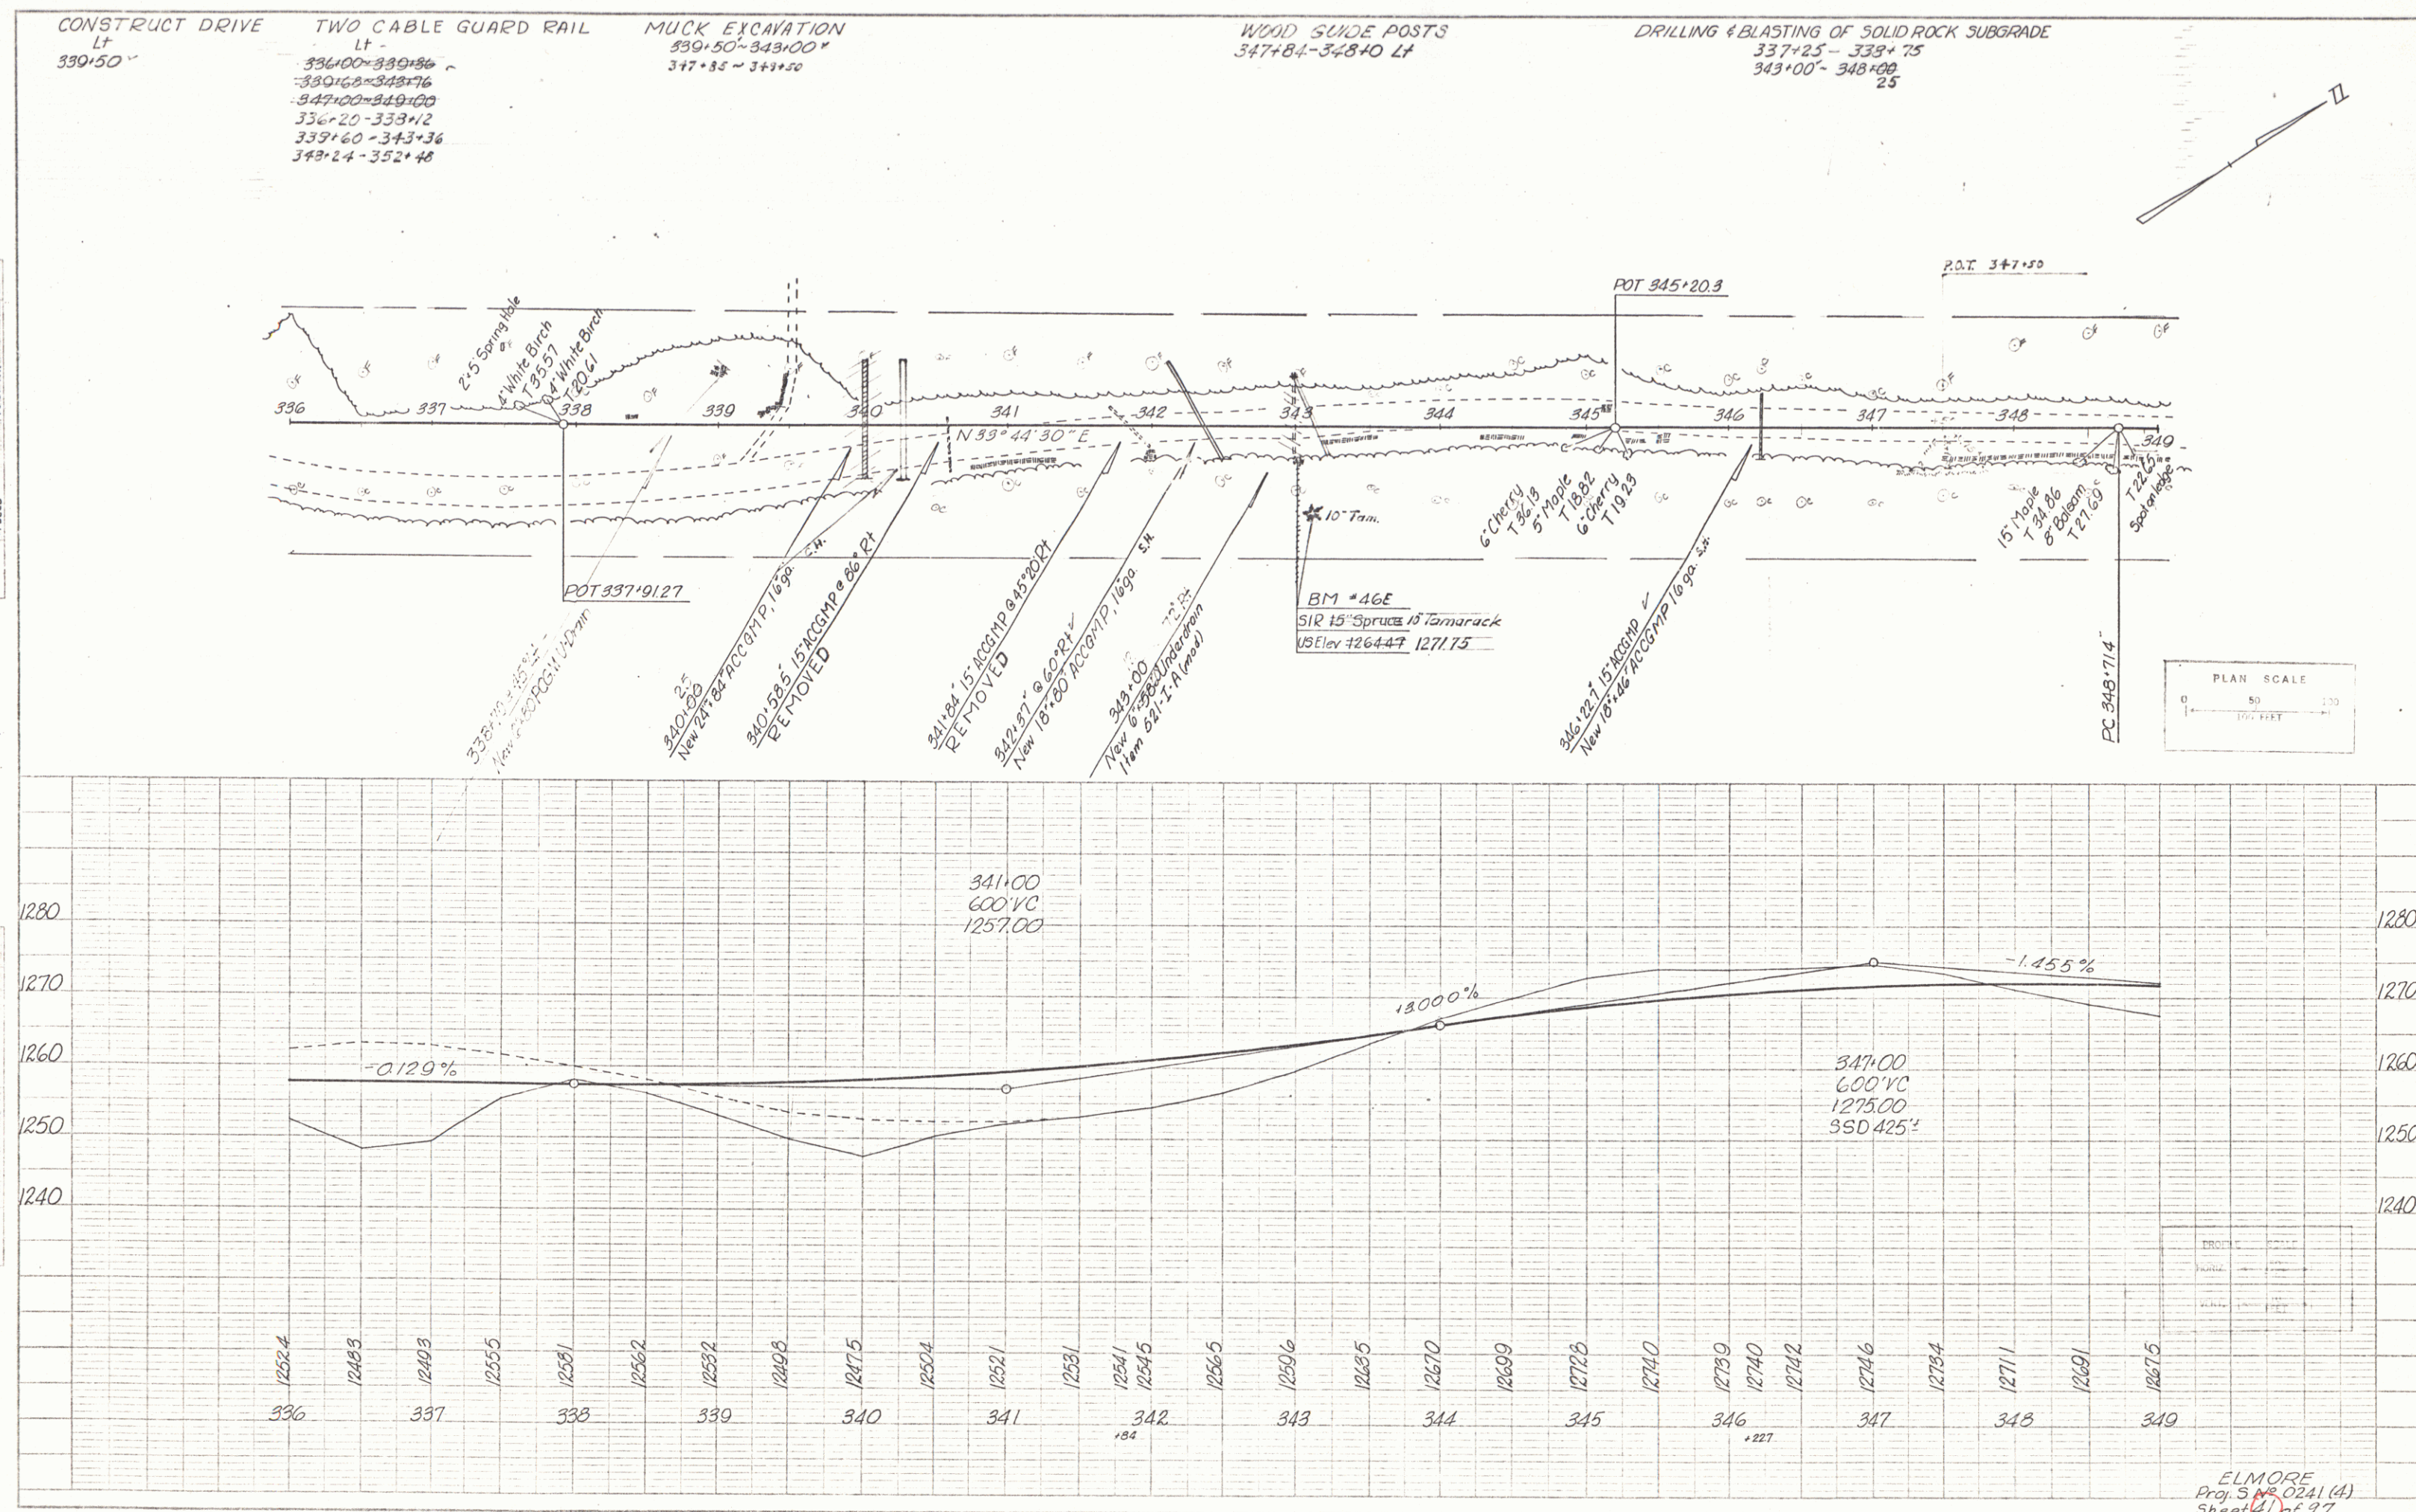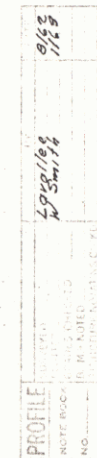

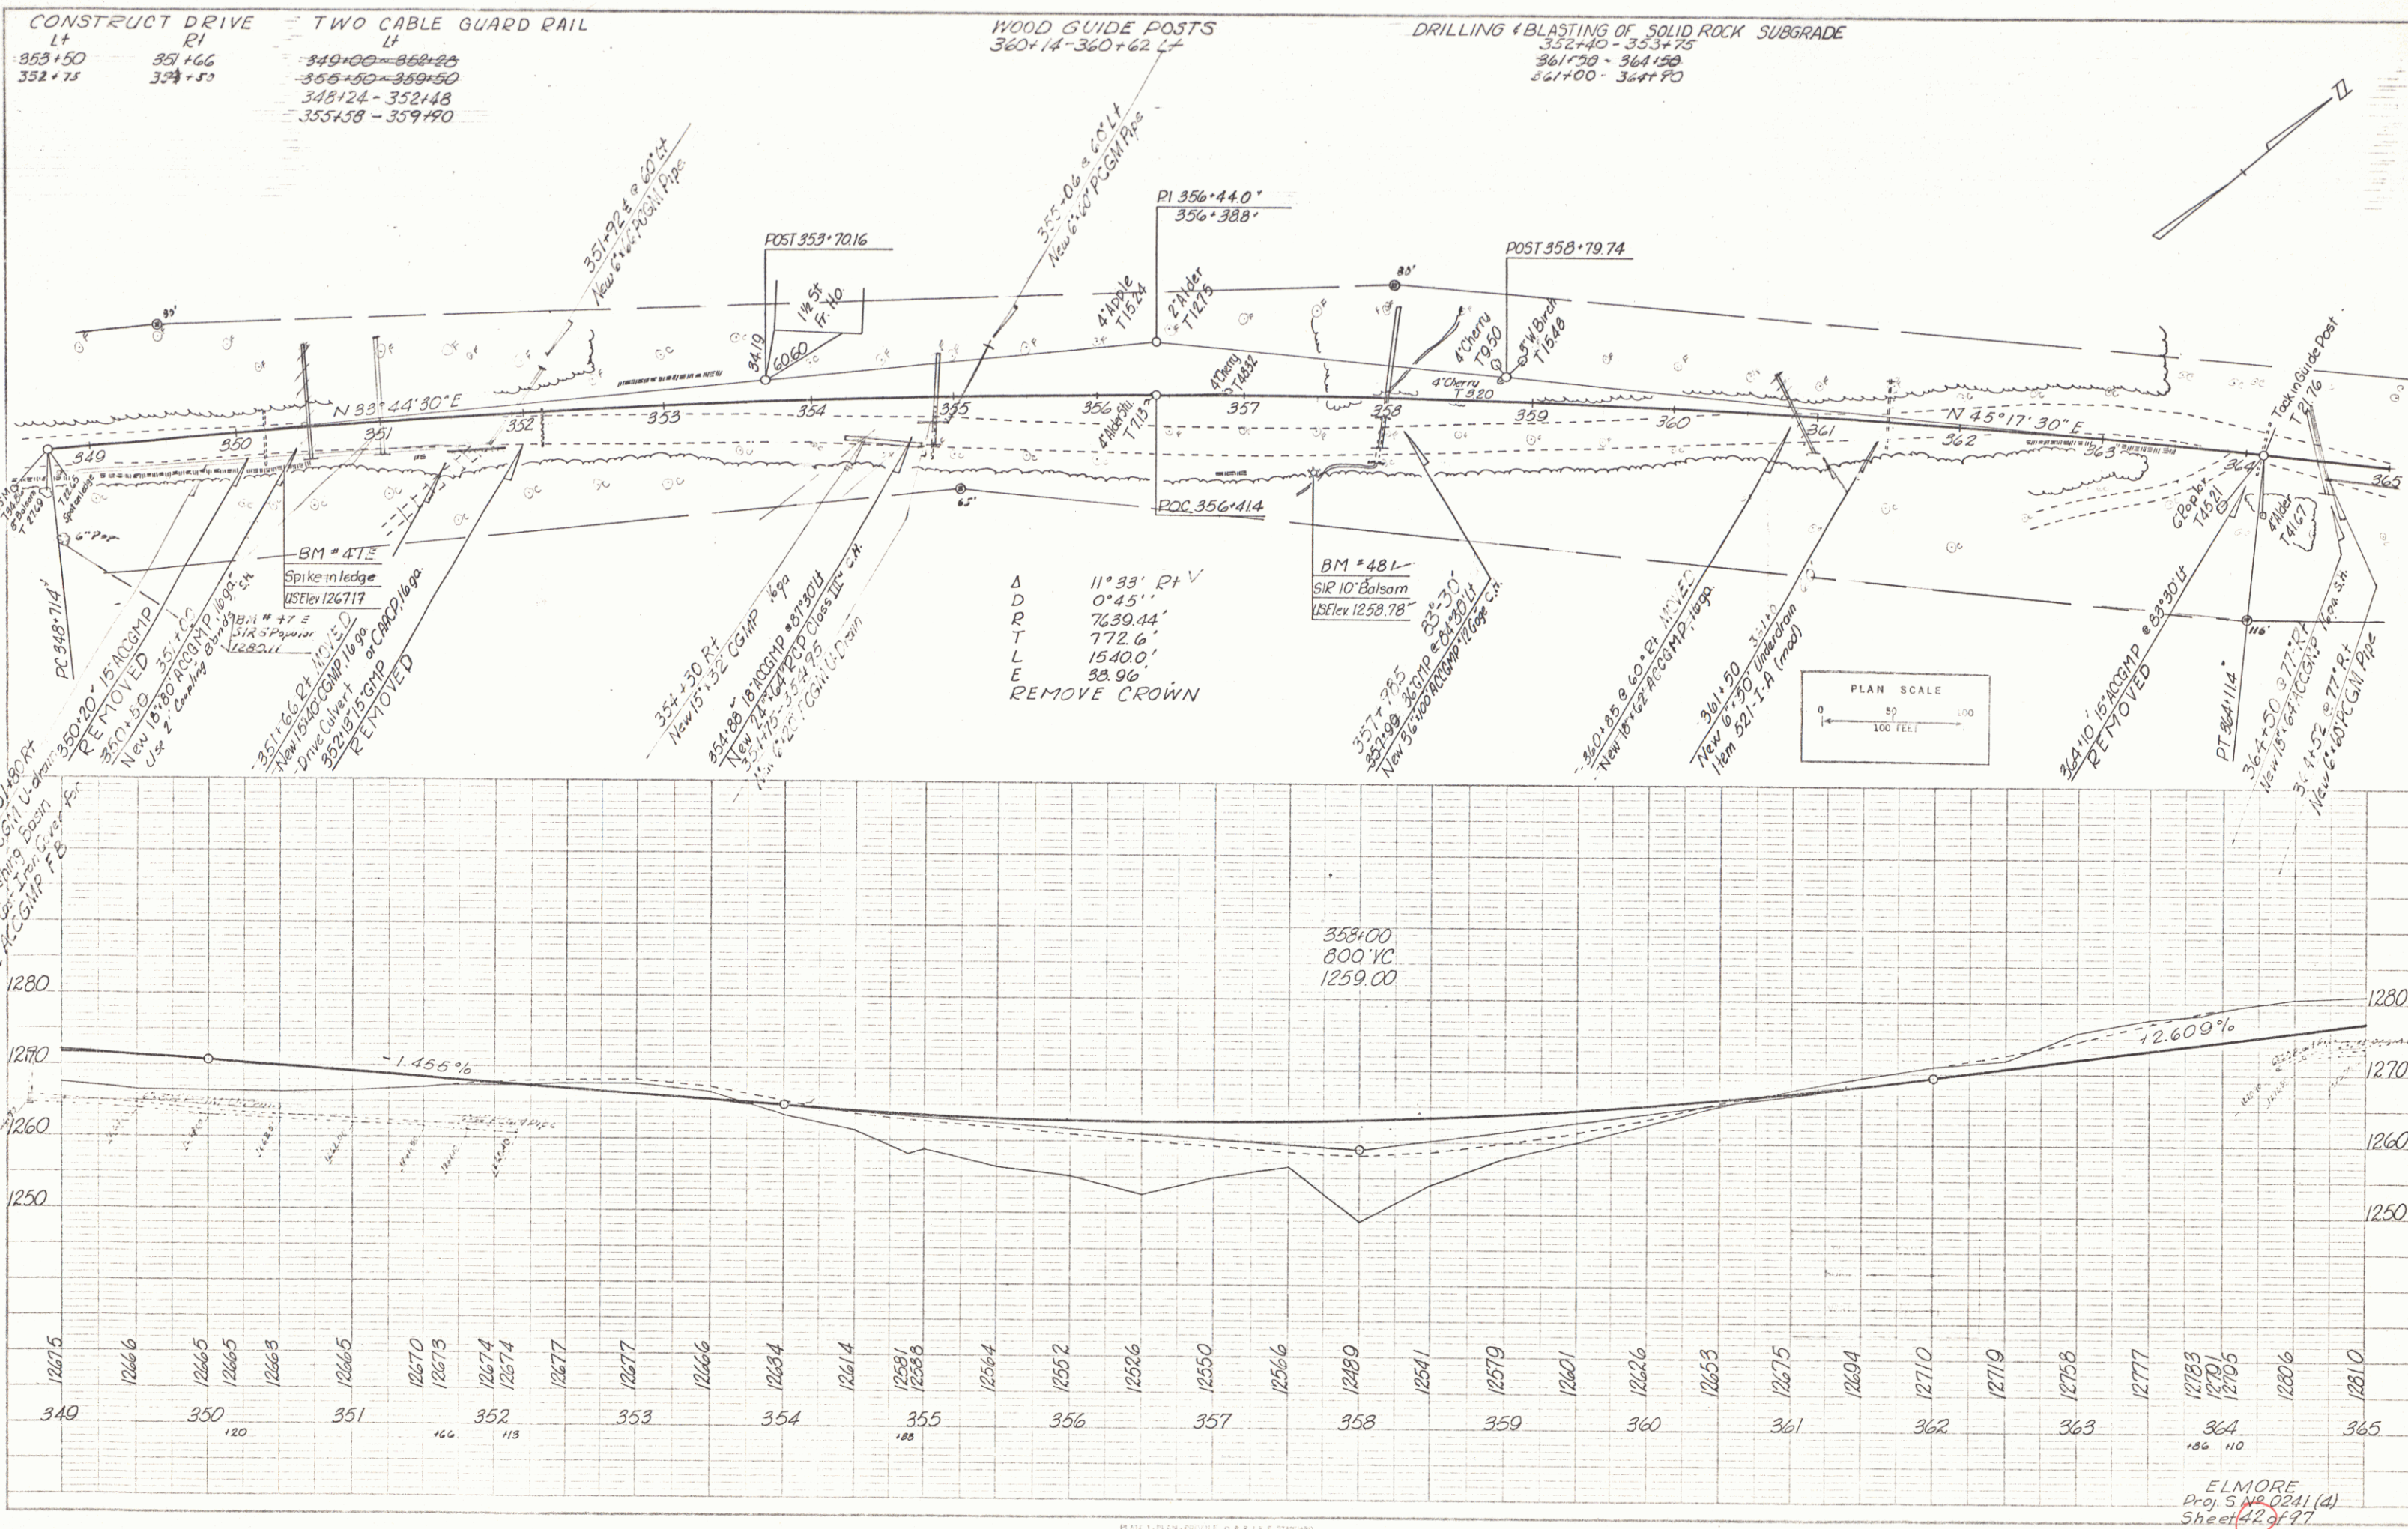


PLAN
1/4" = 100'
1/4" = 100'
1/4" = 100'

PROFILE
1/4" = 100'
1/4" = 100'

ELMORE
Proj. 5 No. 1241 (d)
Sheet 42 of 77


PLAN
 DATE: 01/25/14
 DRAWN BY: [Signature]
 CHECKED BY: [Signature]
 NO. 114

PROFILE
 DATE: 01/25/14
 DRAWN BY: [Signature]
 CHECKED BY: [Signature]
 NO. 114

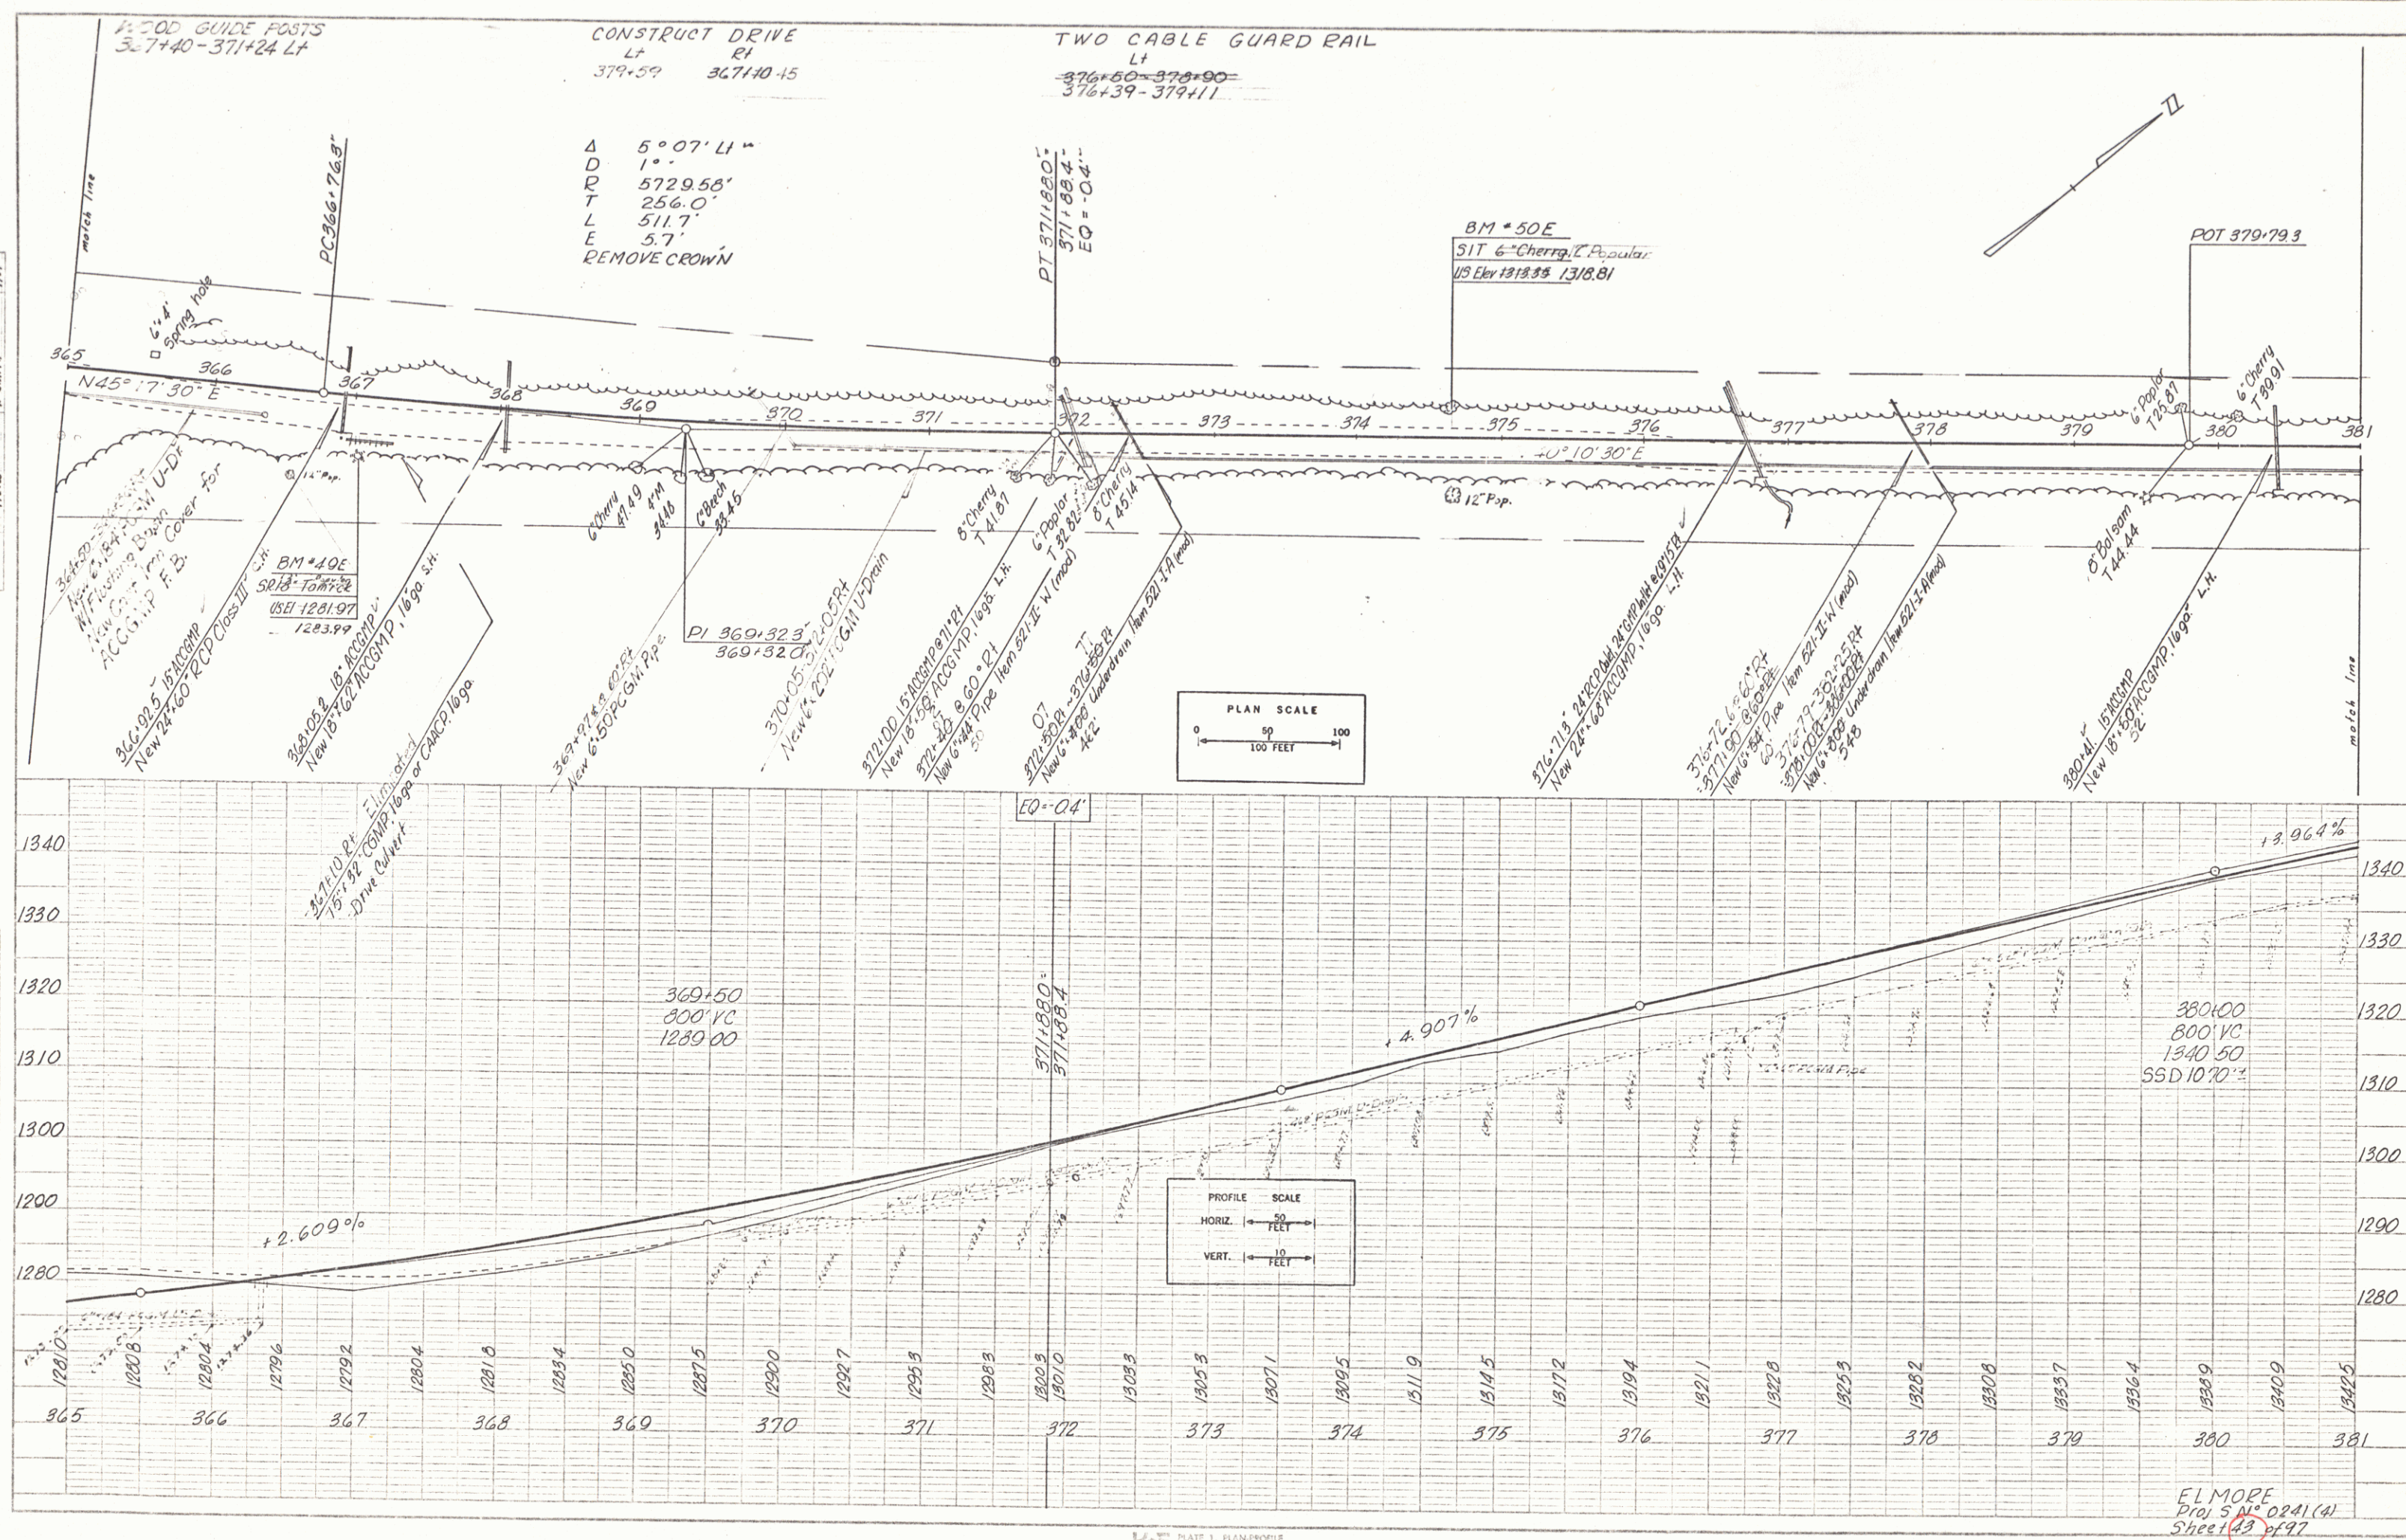

PLAN
 DATE: 9-28-58
 DRAWN BY: C.E.H.
 CHECKED BY: R.

PROFILE
 DATE: 9-28-58
 DRAWN BY: C.E.H.
 CHECKED BY: R.

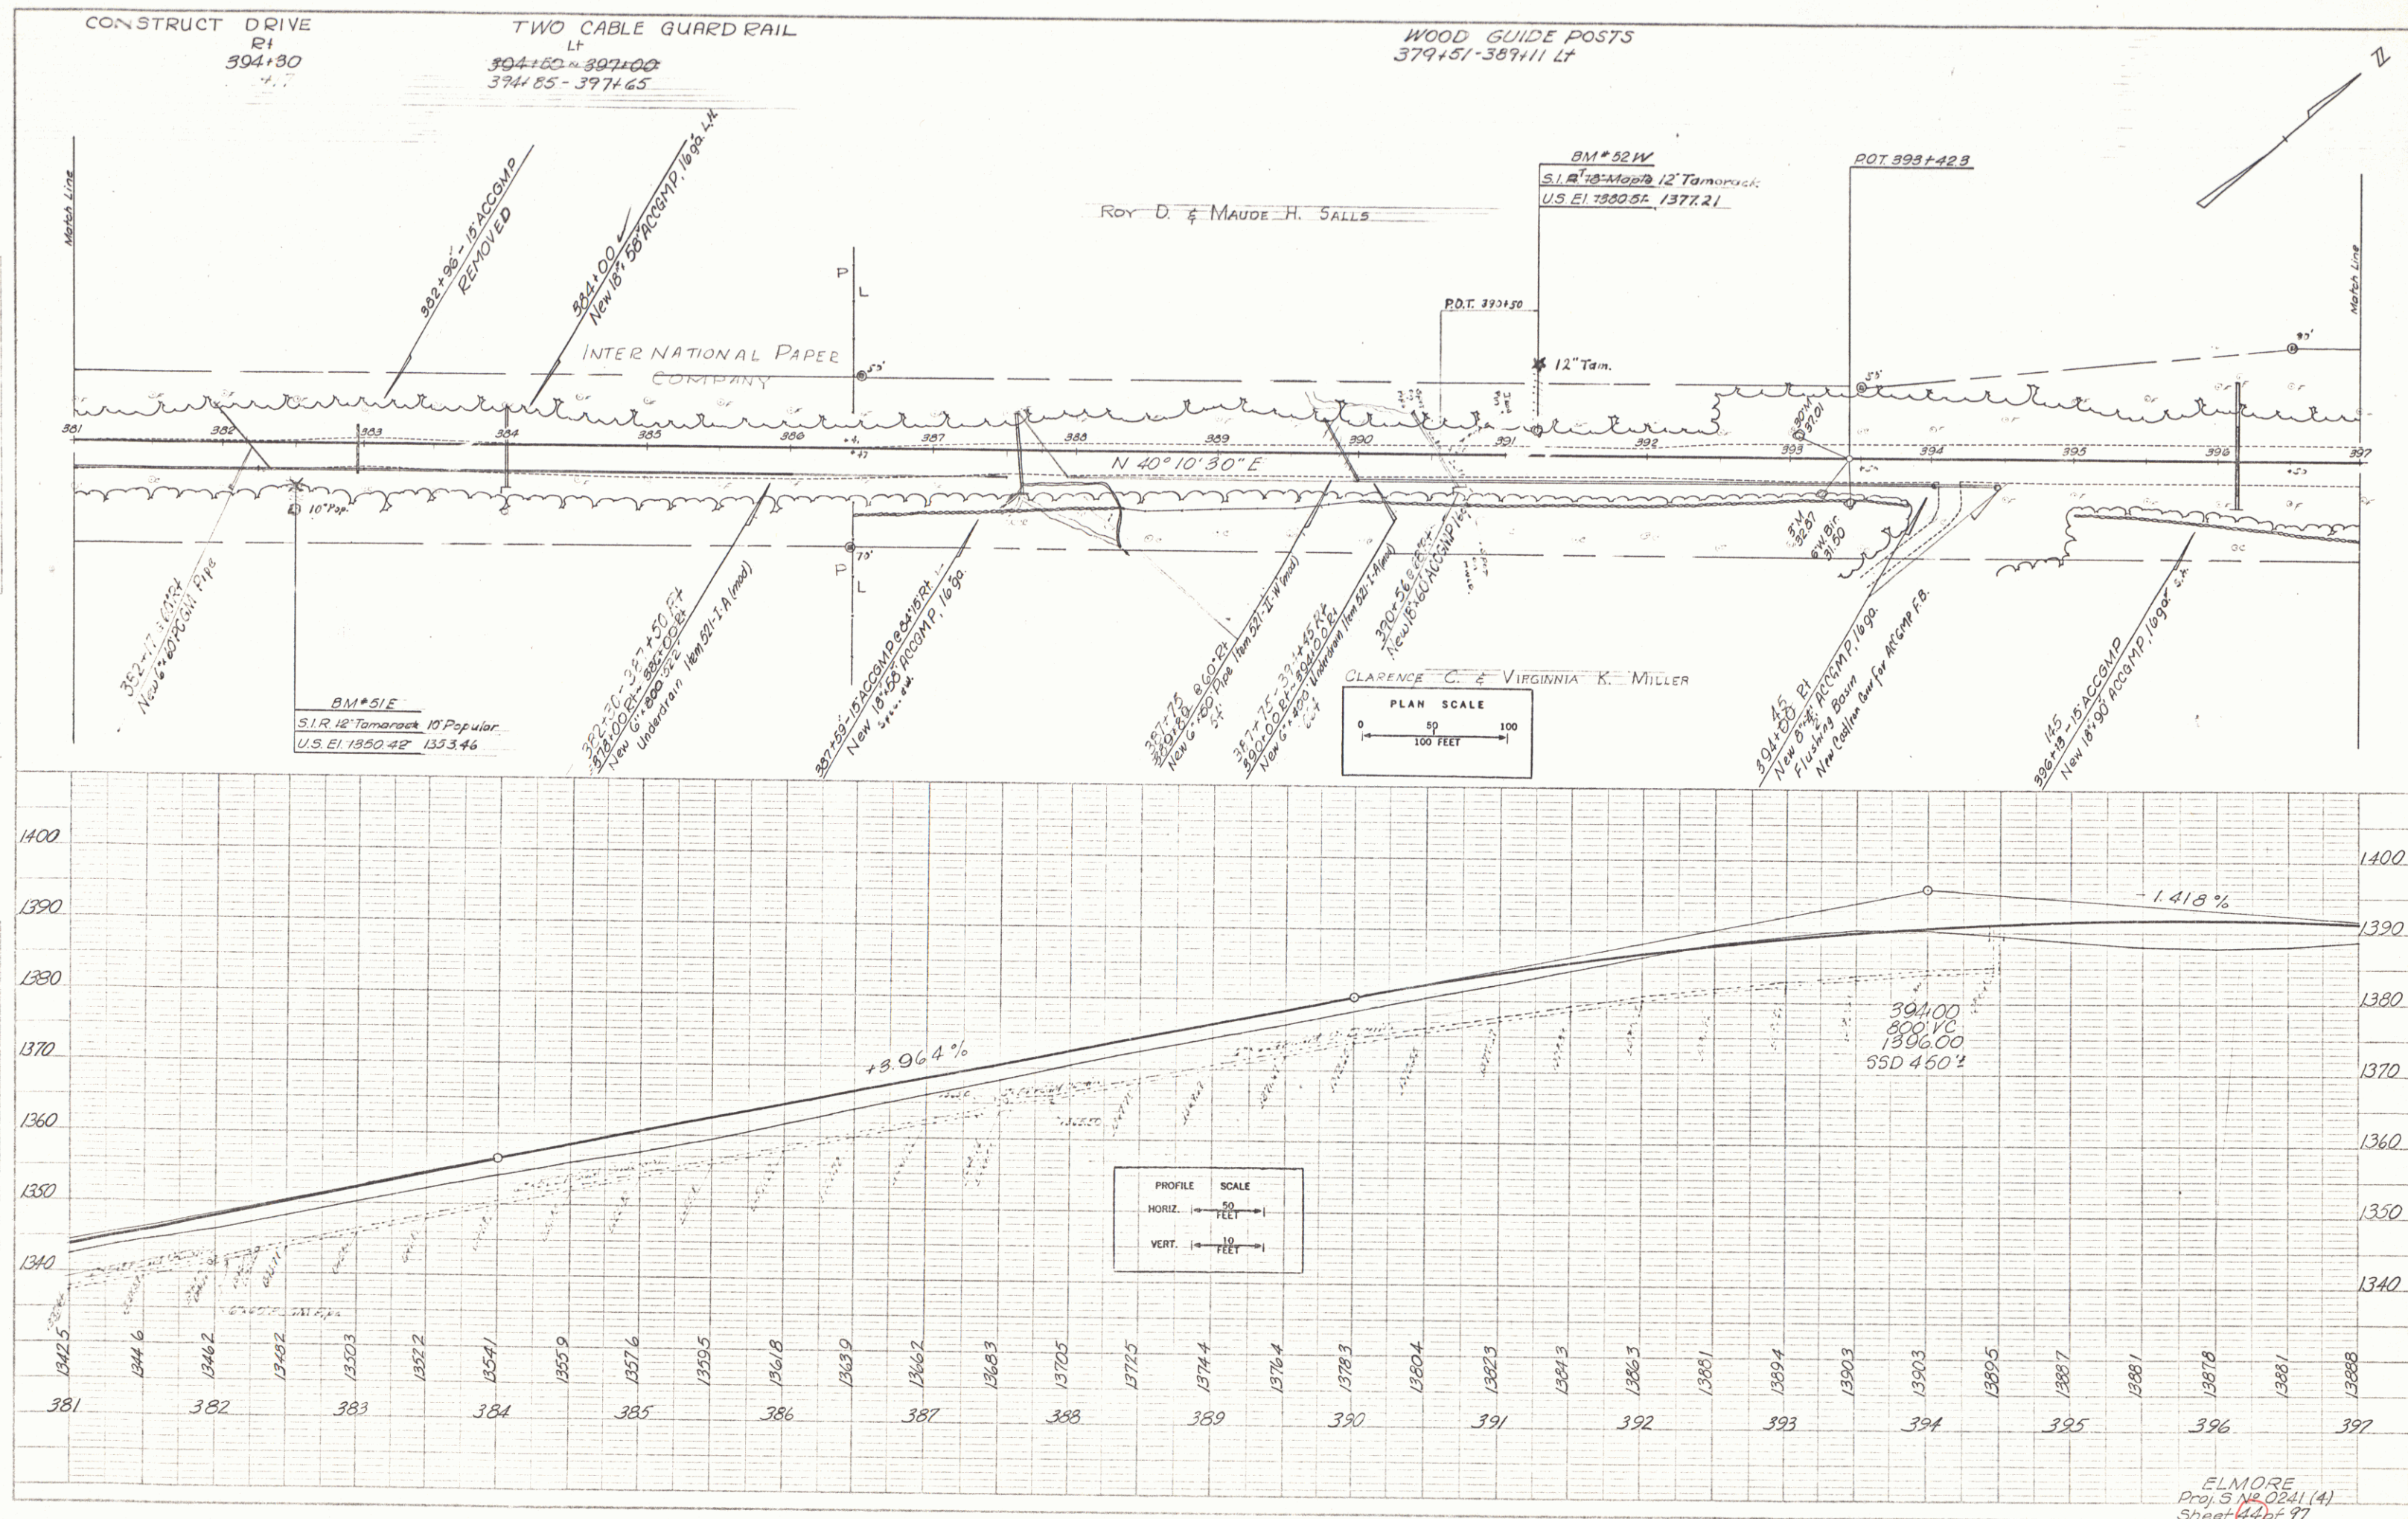

ELMORE
 Proj. 5 No. 0341 (4)
 Sheet 4 of 97

PLAN	9/65	2/65
NOTE BOOK	1/5 Smith	2/5 Smith
NO.	Traced	

PROFILE	9/65	2/65
NOTE BOOK	1/5 Smith	2/5 Smith
NO.	Traced	

