



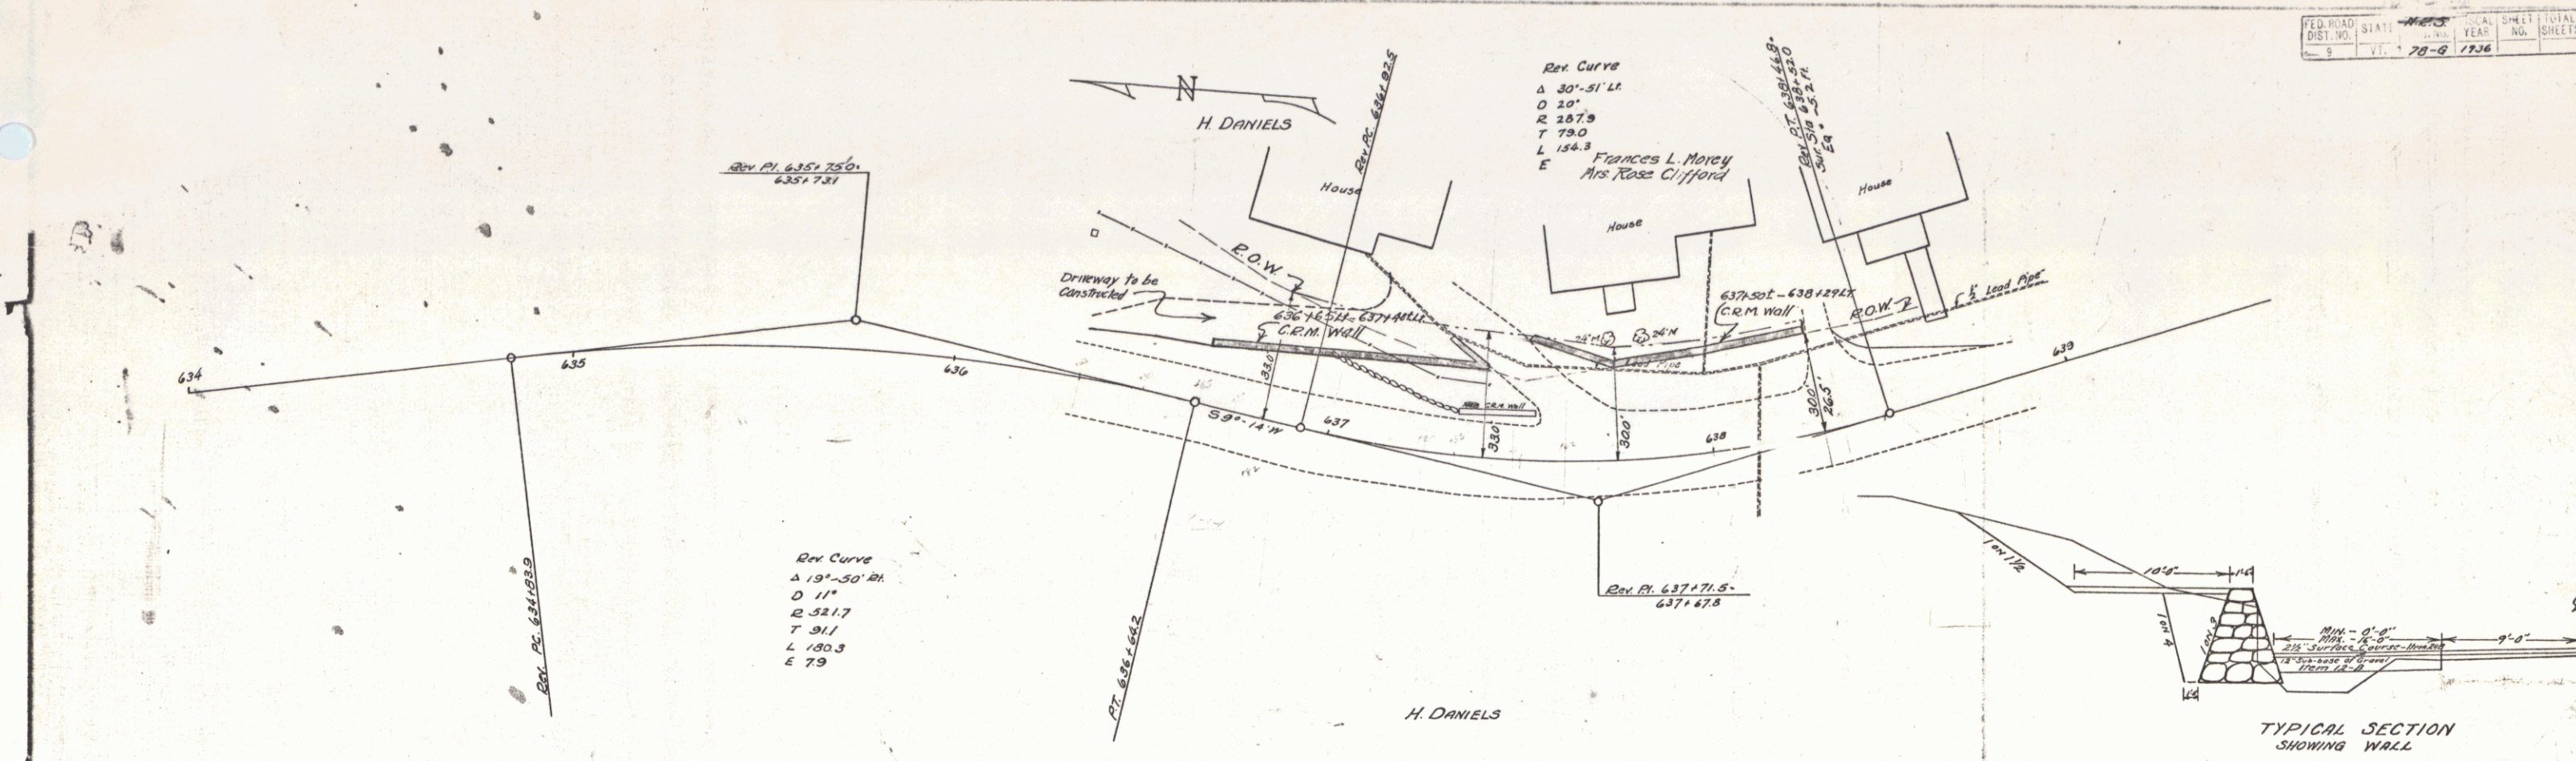

TYPICAL SECTION SHOWING WALL

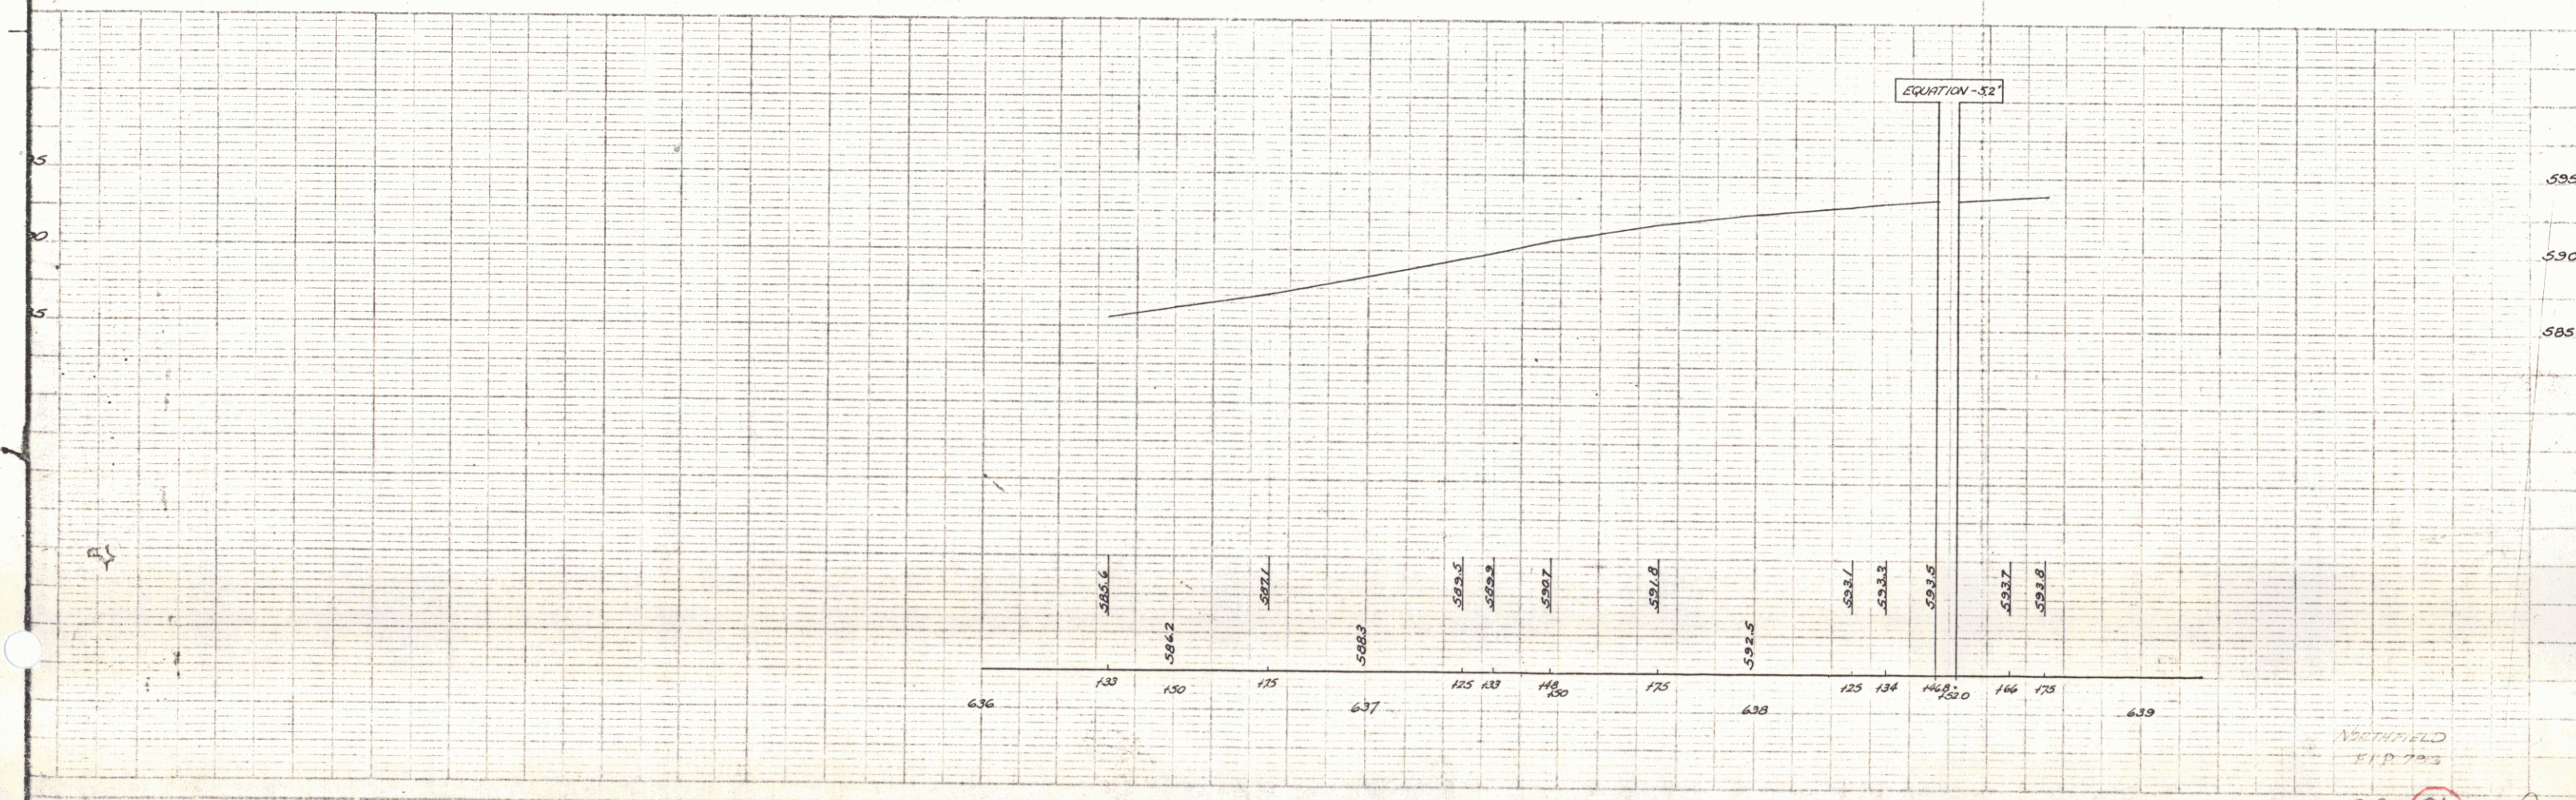

NOTED
E.P. 703

SHEET 8A