


PLAN	NO.	SUBMITTED DATE	BY	DATE
NOTE BOOK		ALIGNMENT CHECKED		
NO.		RT OF WAY CHECKED		

PROFILE	NO.	SUBMITTED DATE	BY	DATE
NOTE BOOK		GRADES CHECKED		
NO.		STRUCTURE NOTATIONS CHKO		

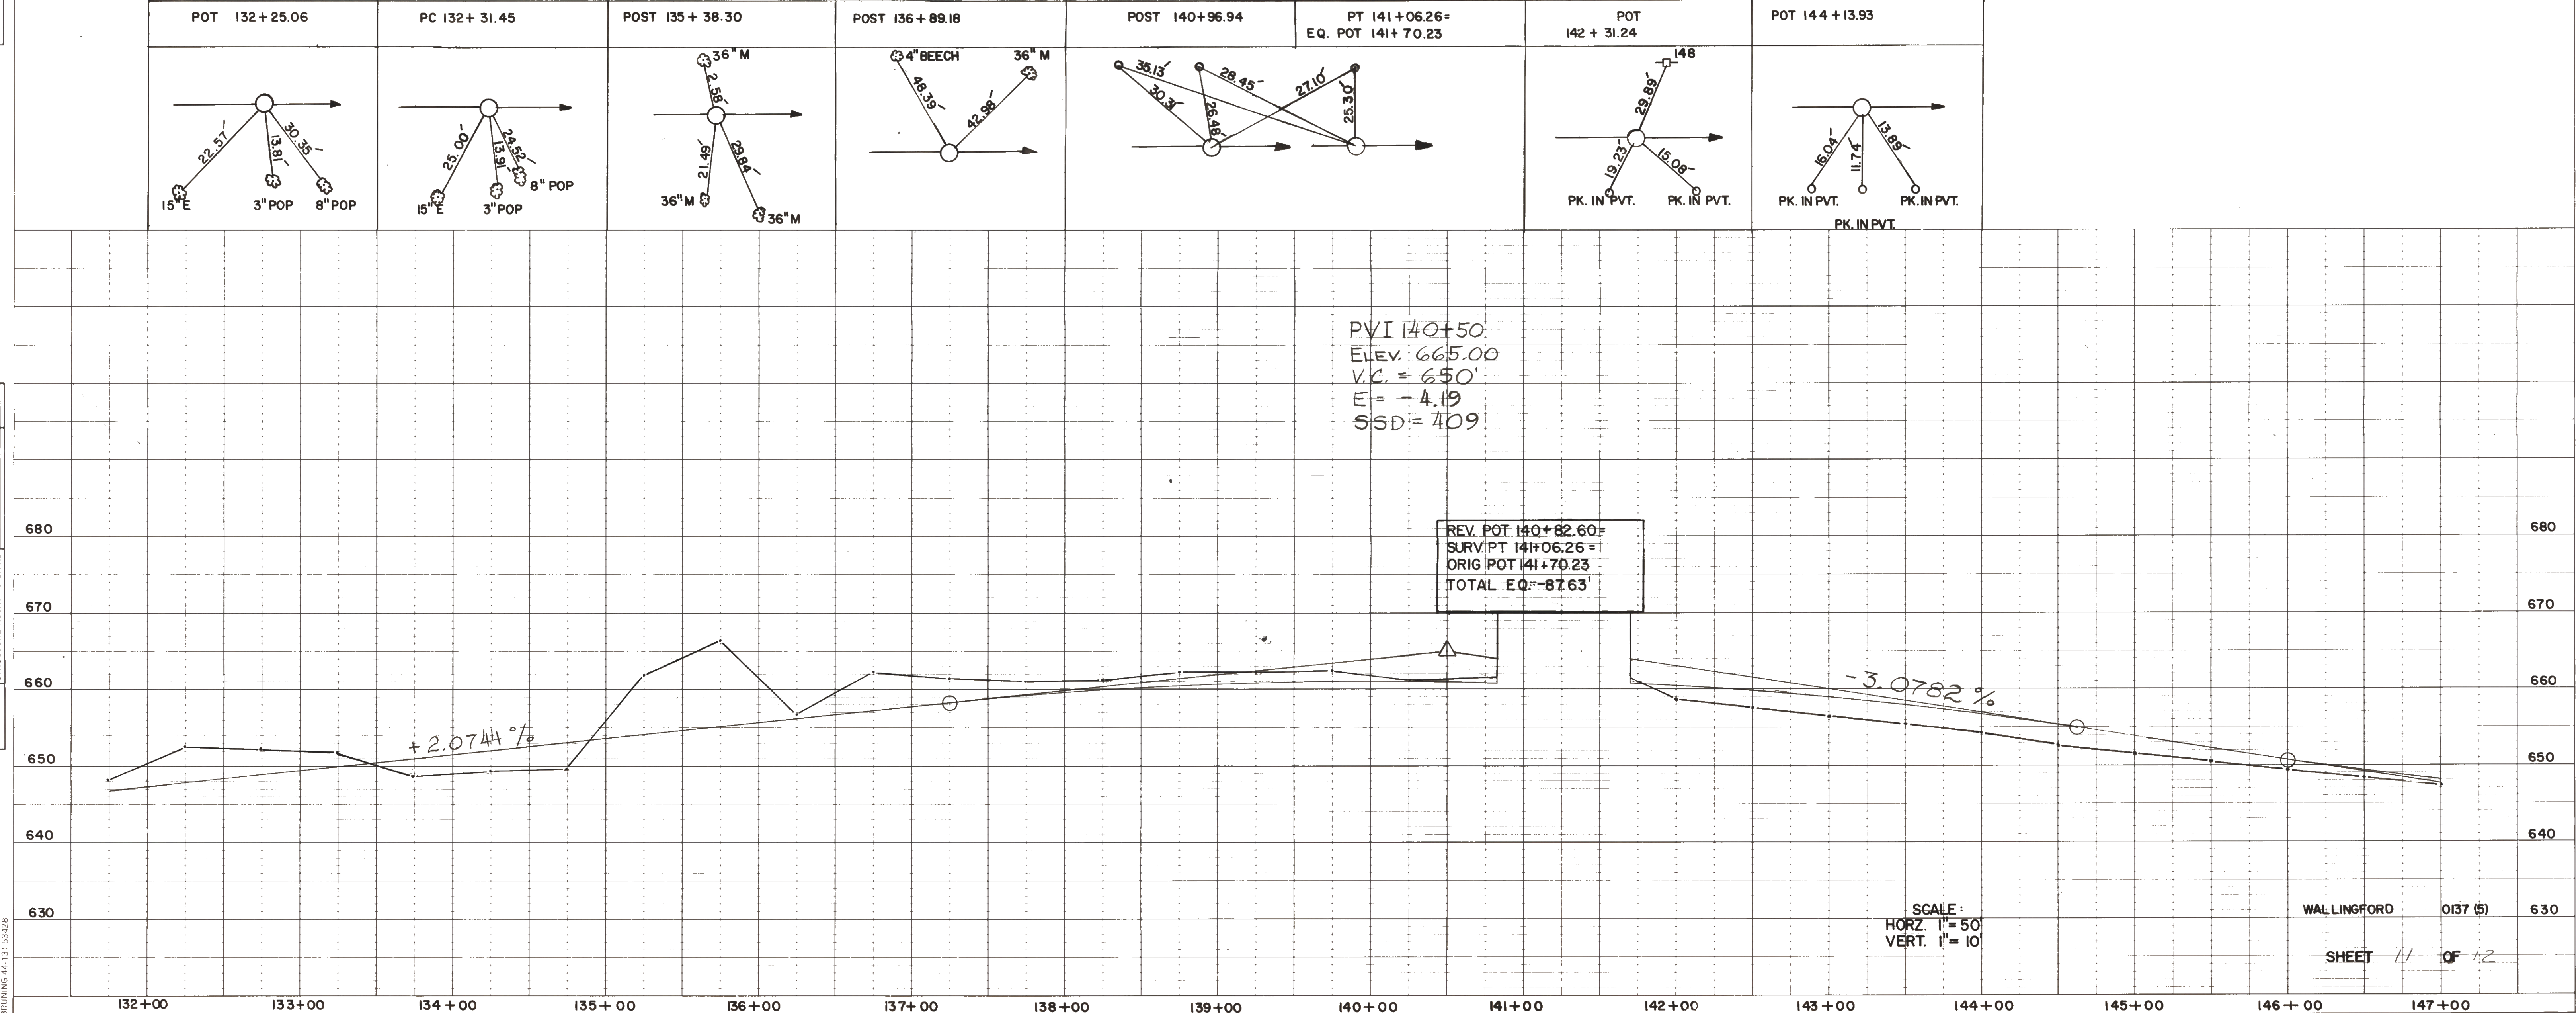

BRUNING 44 131 53428