




ML CURVE DATA

△ 9° 00' RT.
D 1°
T 450.93'
L 900.00'
R 5729.58'
E 17.72'
BANK 0.021 FT./FT.

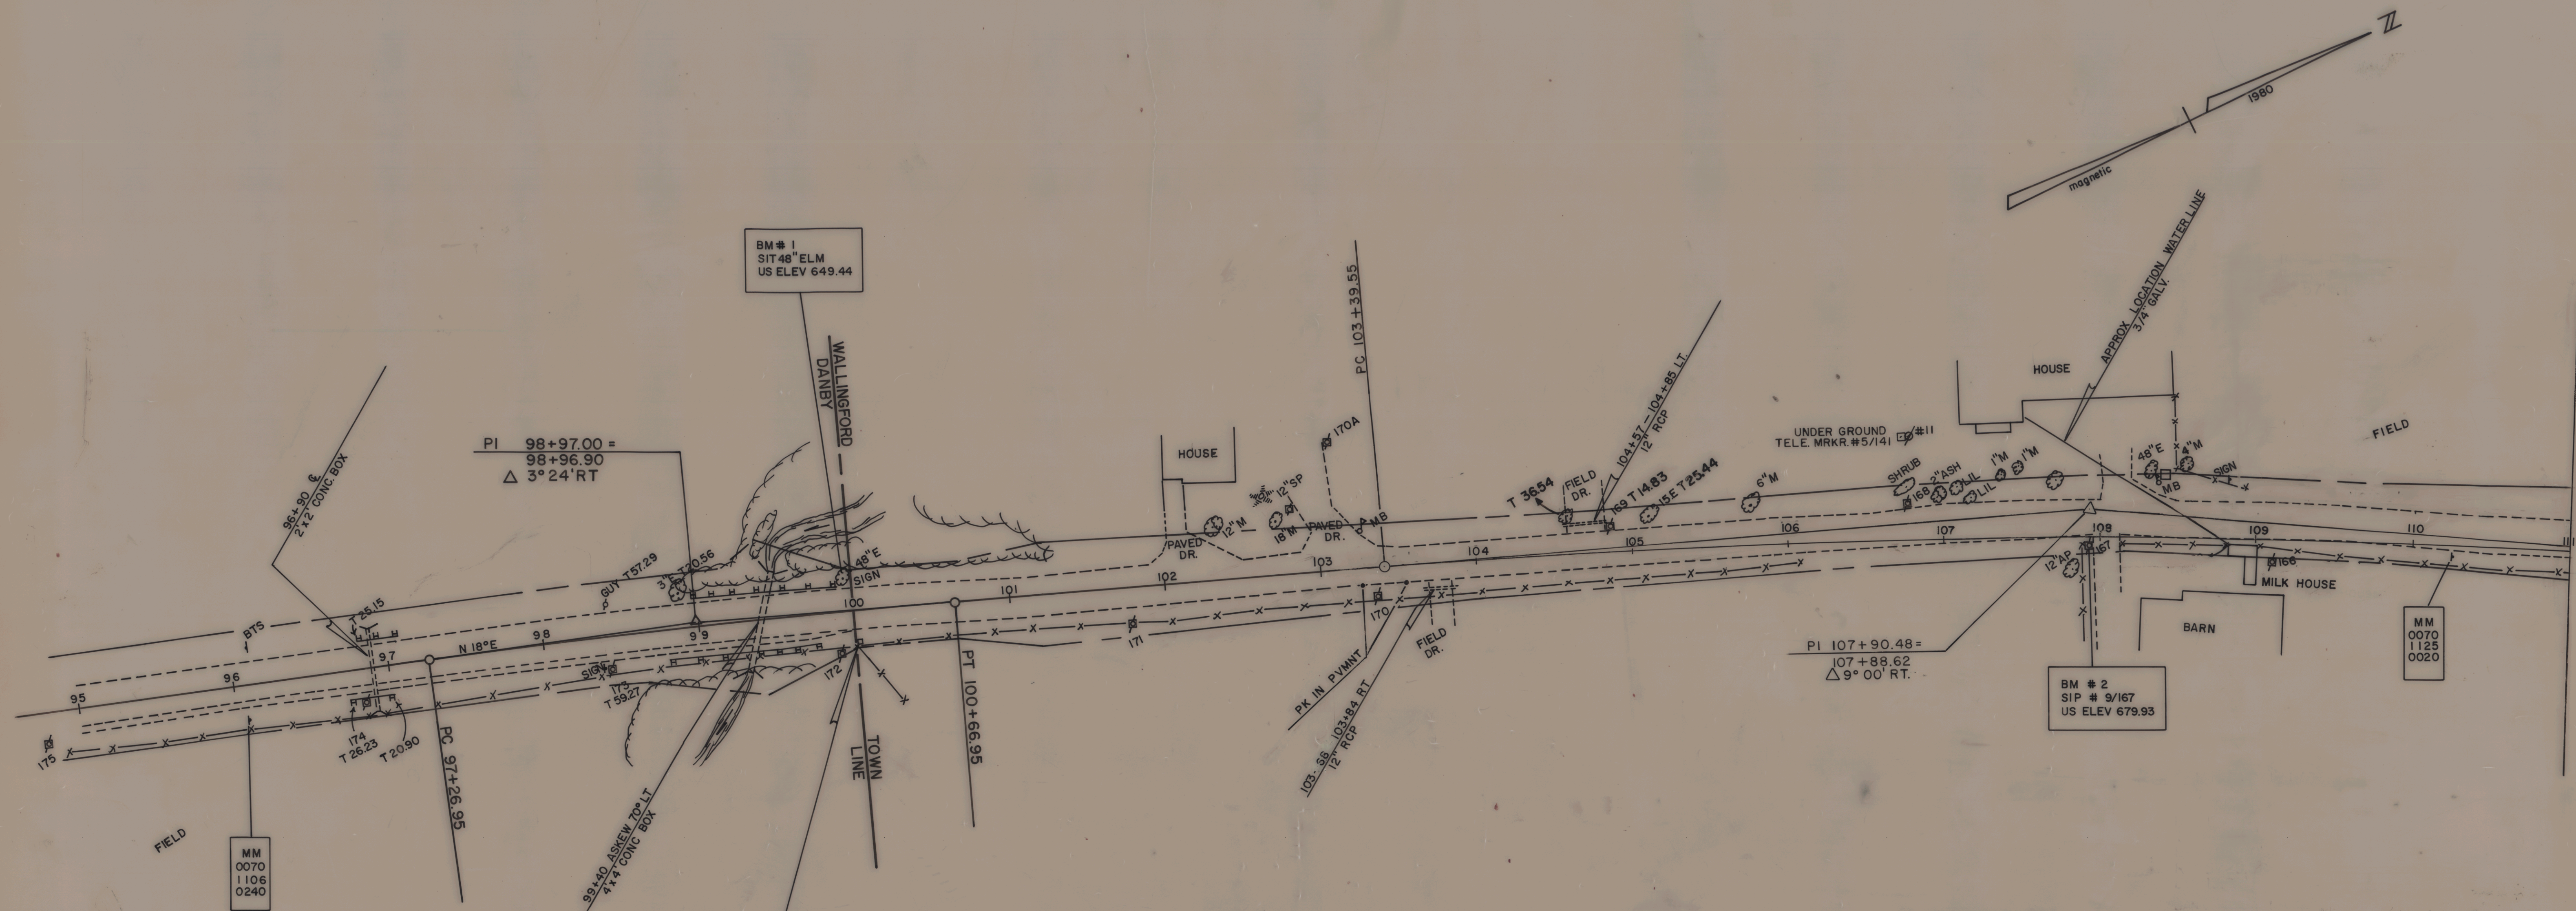