


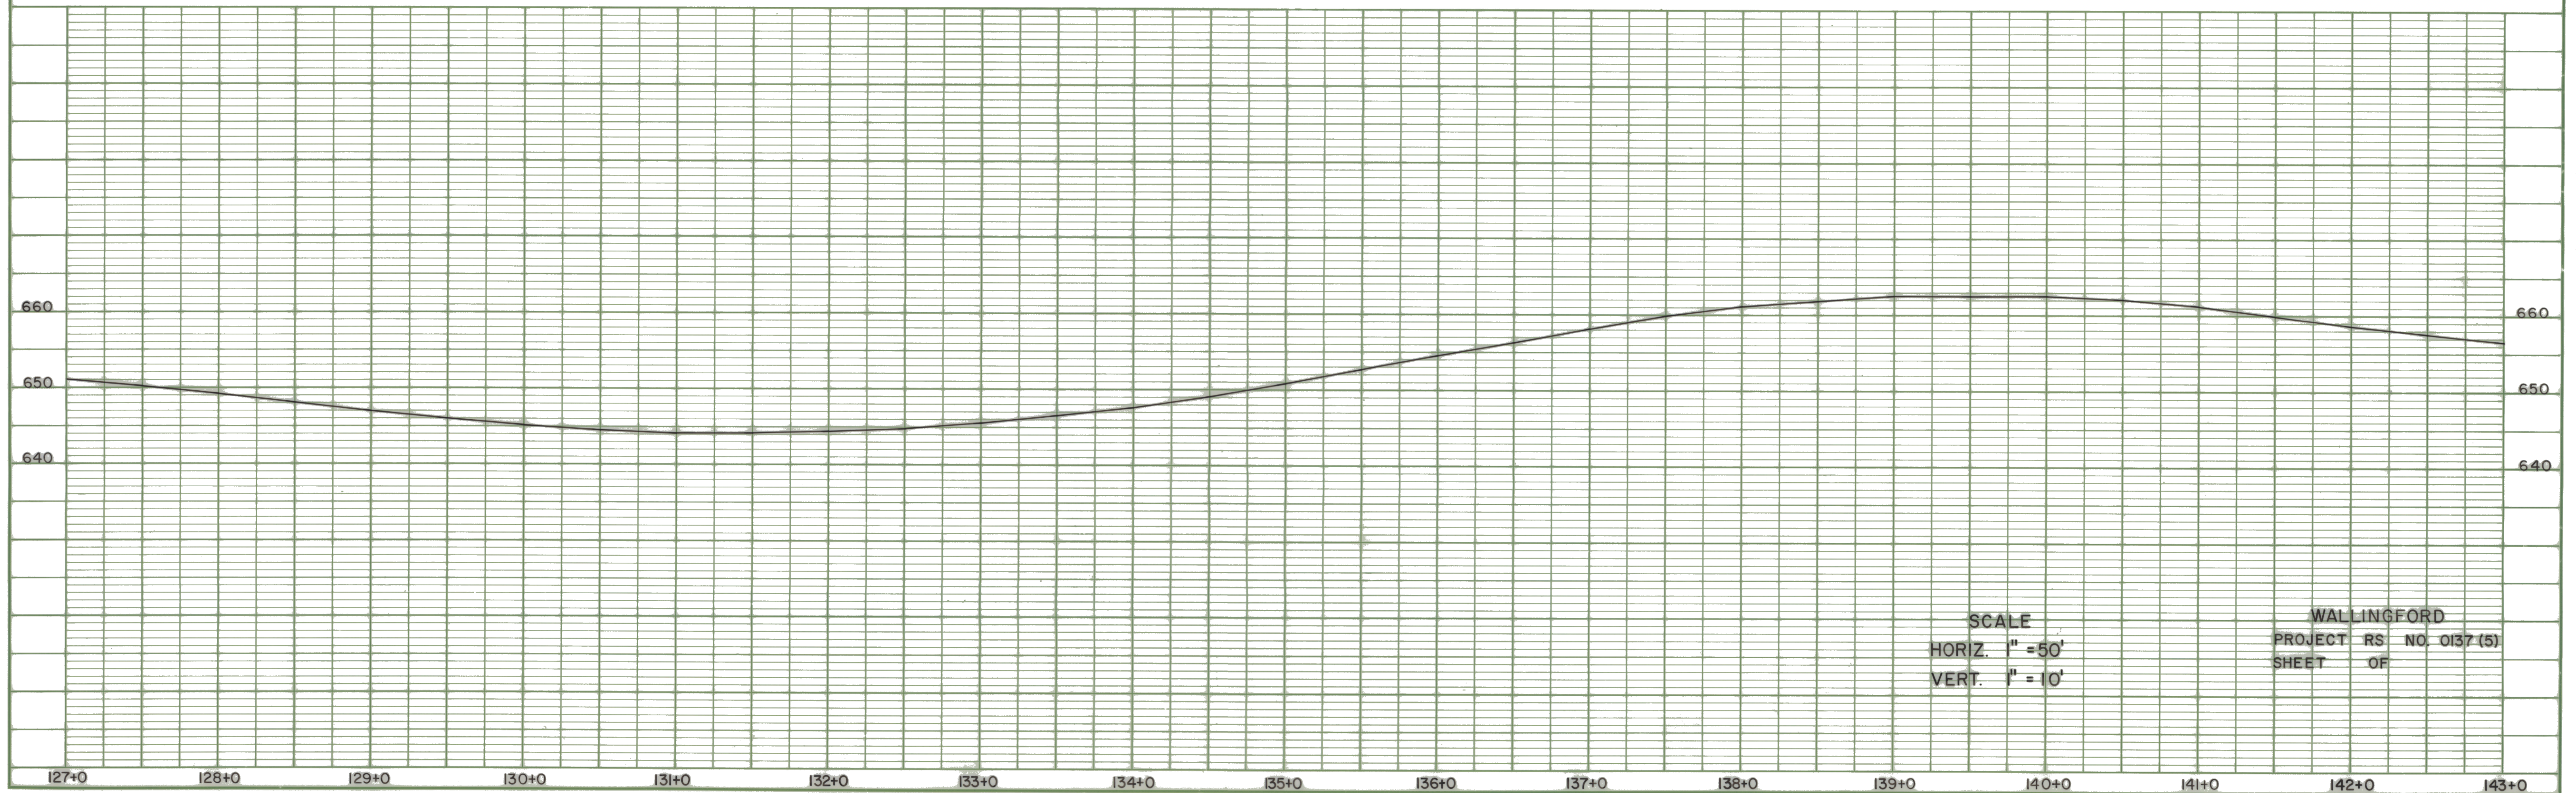

SCALE
HORIZ. 1" = 50'
VERT. 1" = 10'

WALLINGFORD
PROJECT RS NO. 0137 (5)
SHEET OF