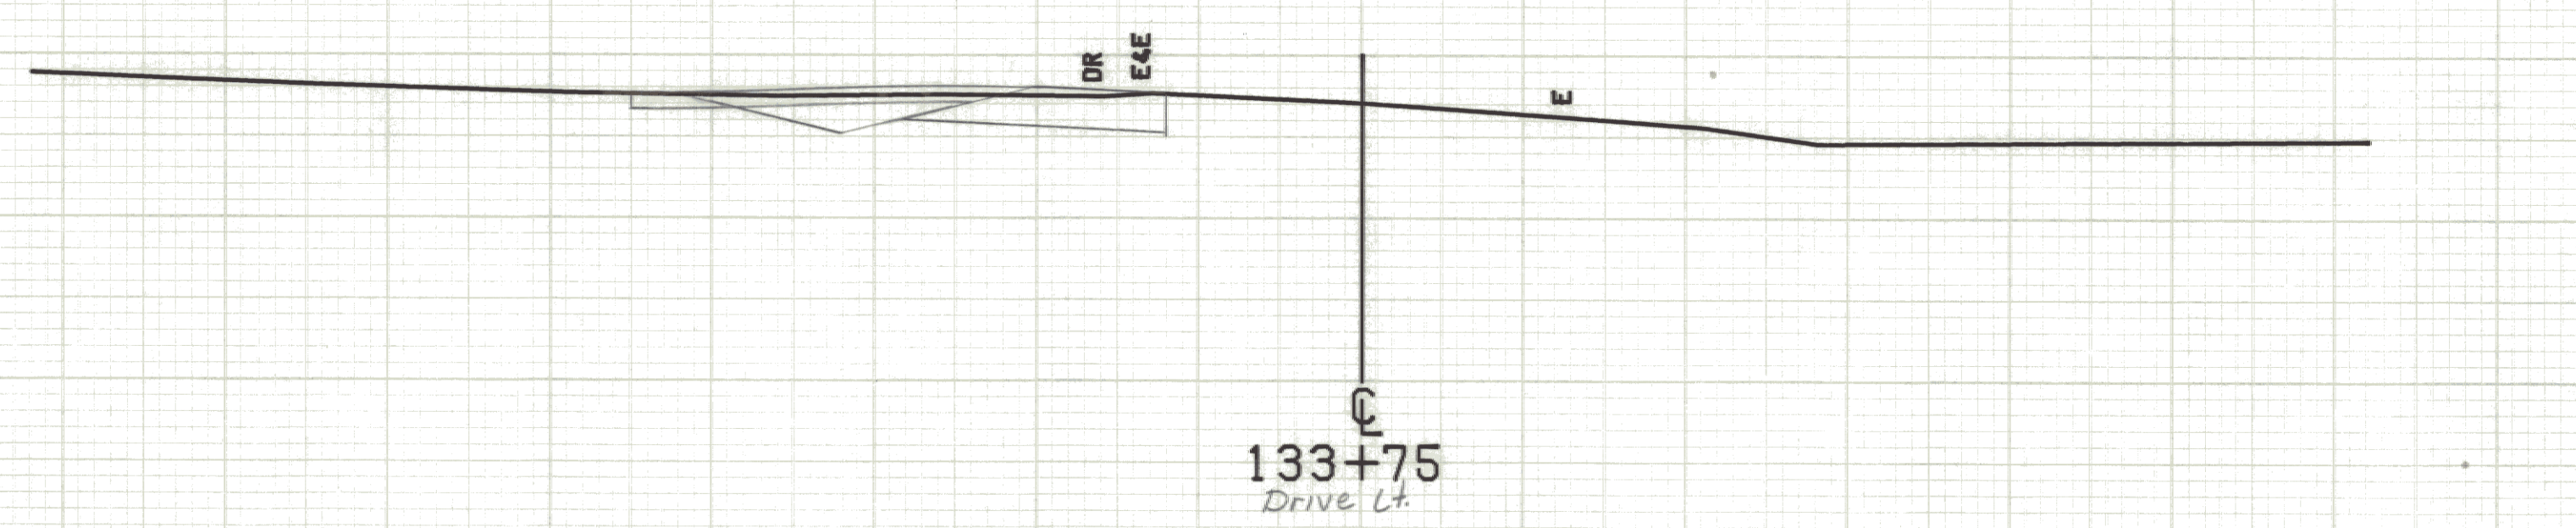
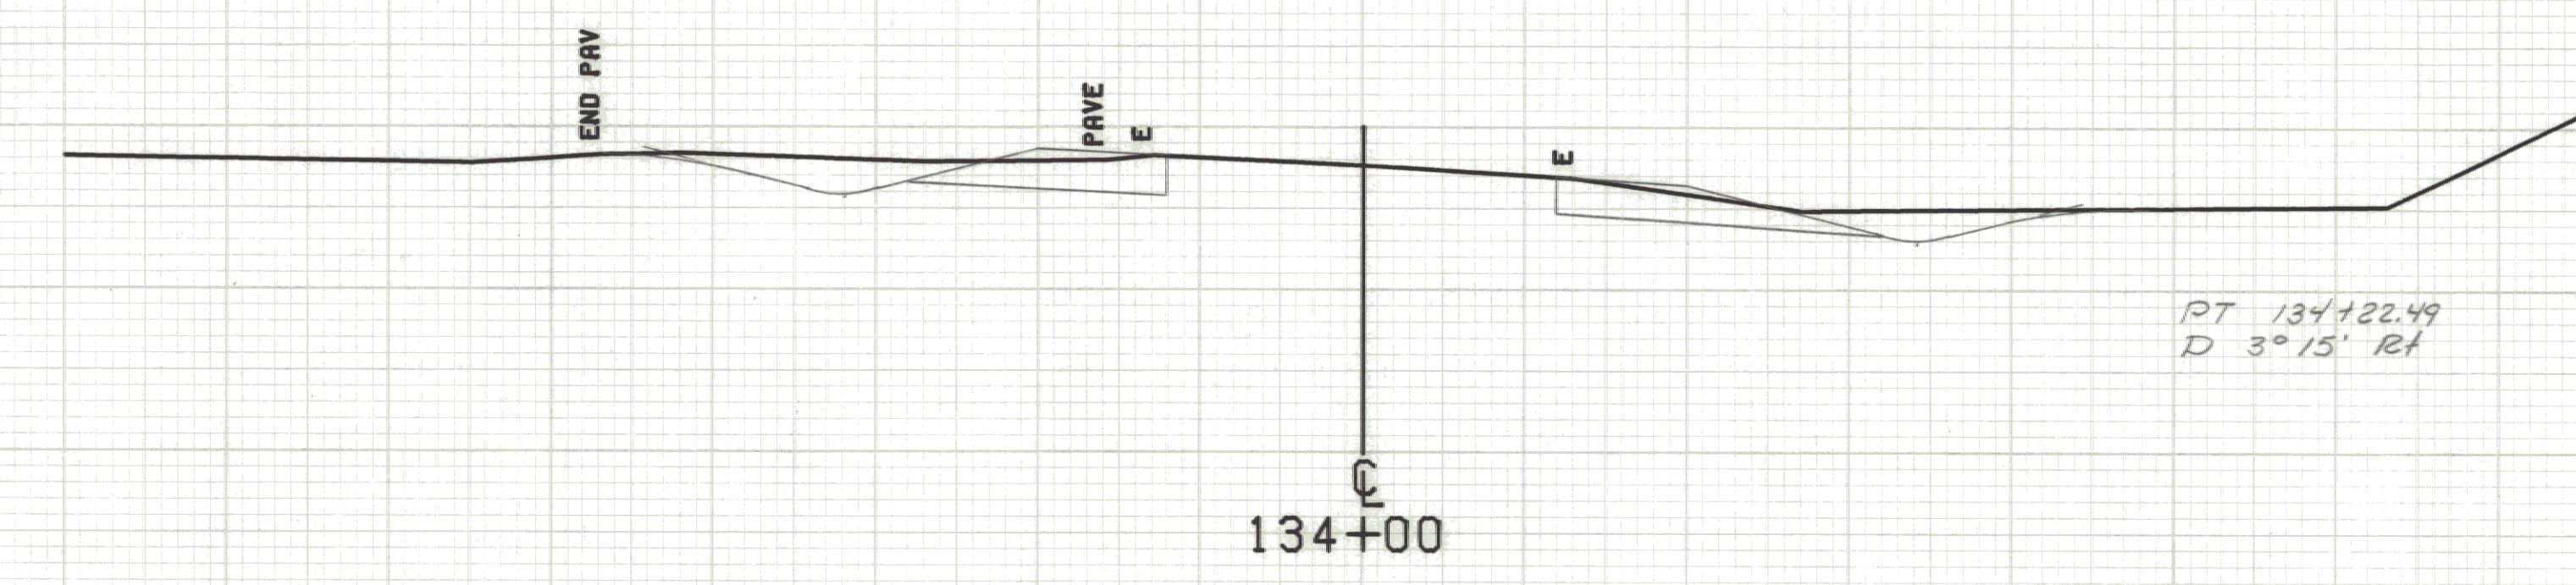
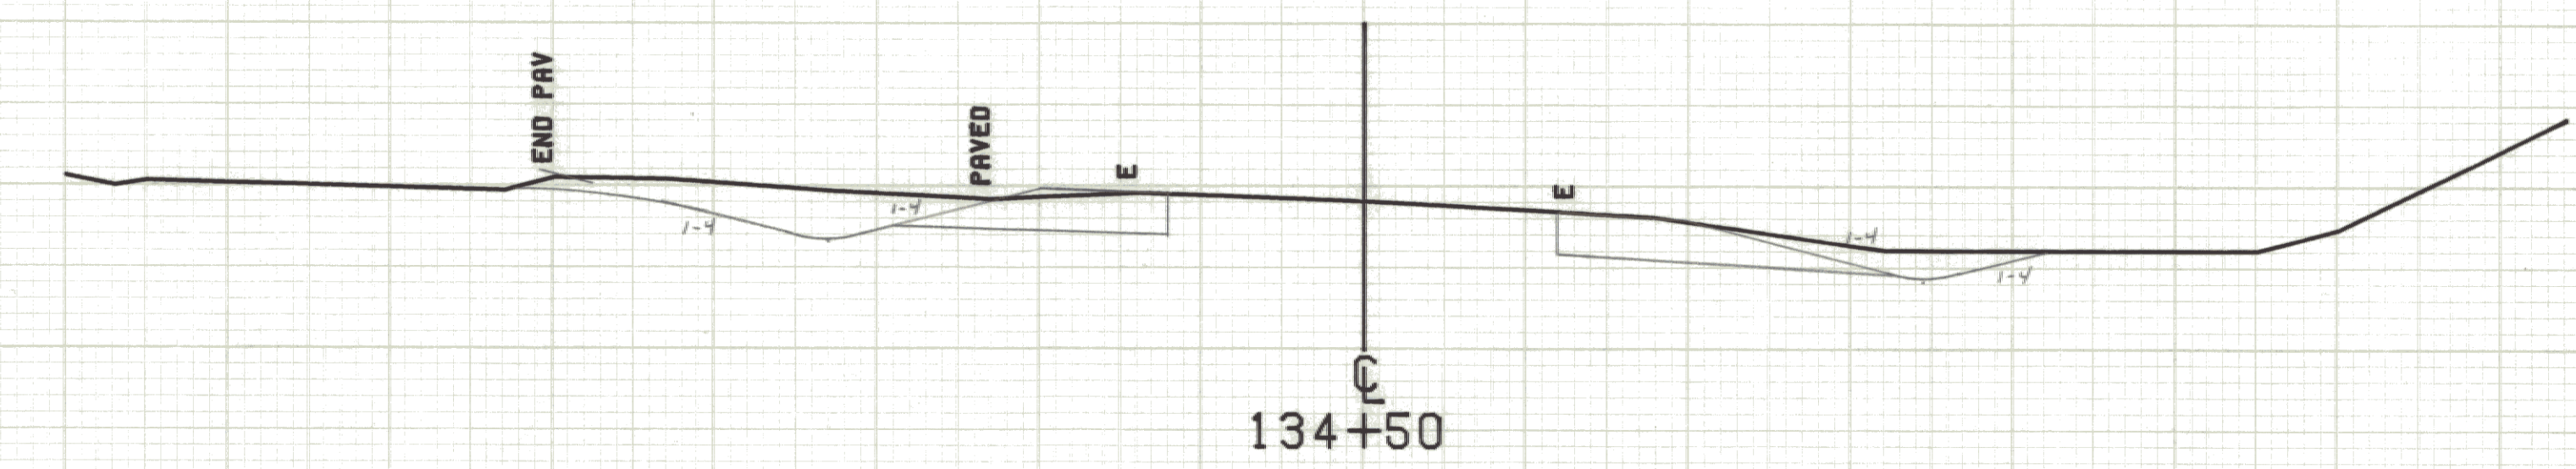


640

640

SCALE 10 FEET

FROM STA. 133+00	TO STA. 134+50
PROJECT NAME	WALLINGFORD
NO.	RS0137(5)
SURVEYED BY	DAVIS
SHEET OF	SHEETS
	PLOTTED 10/06/80
	02/80