


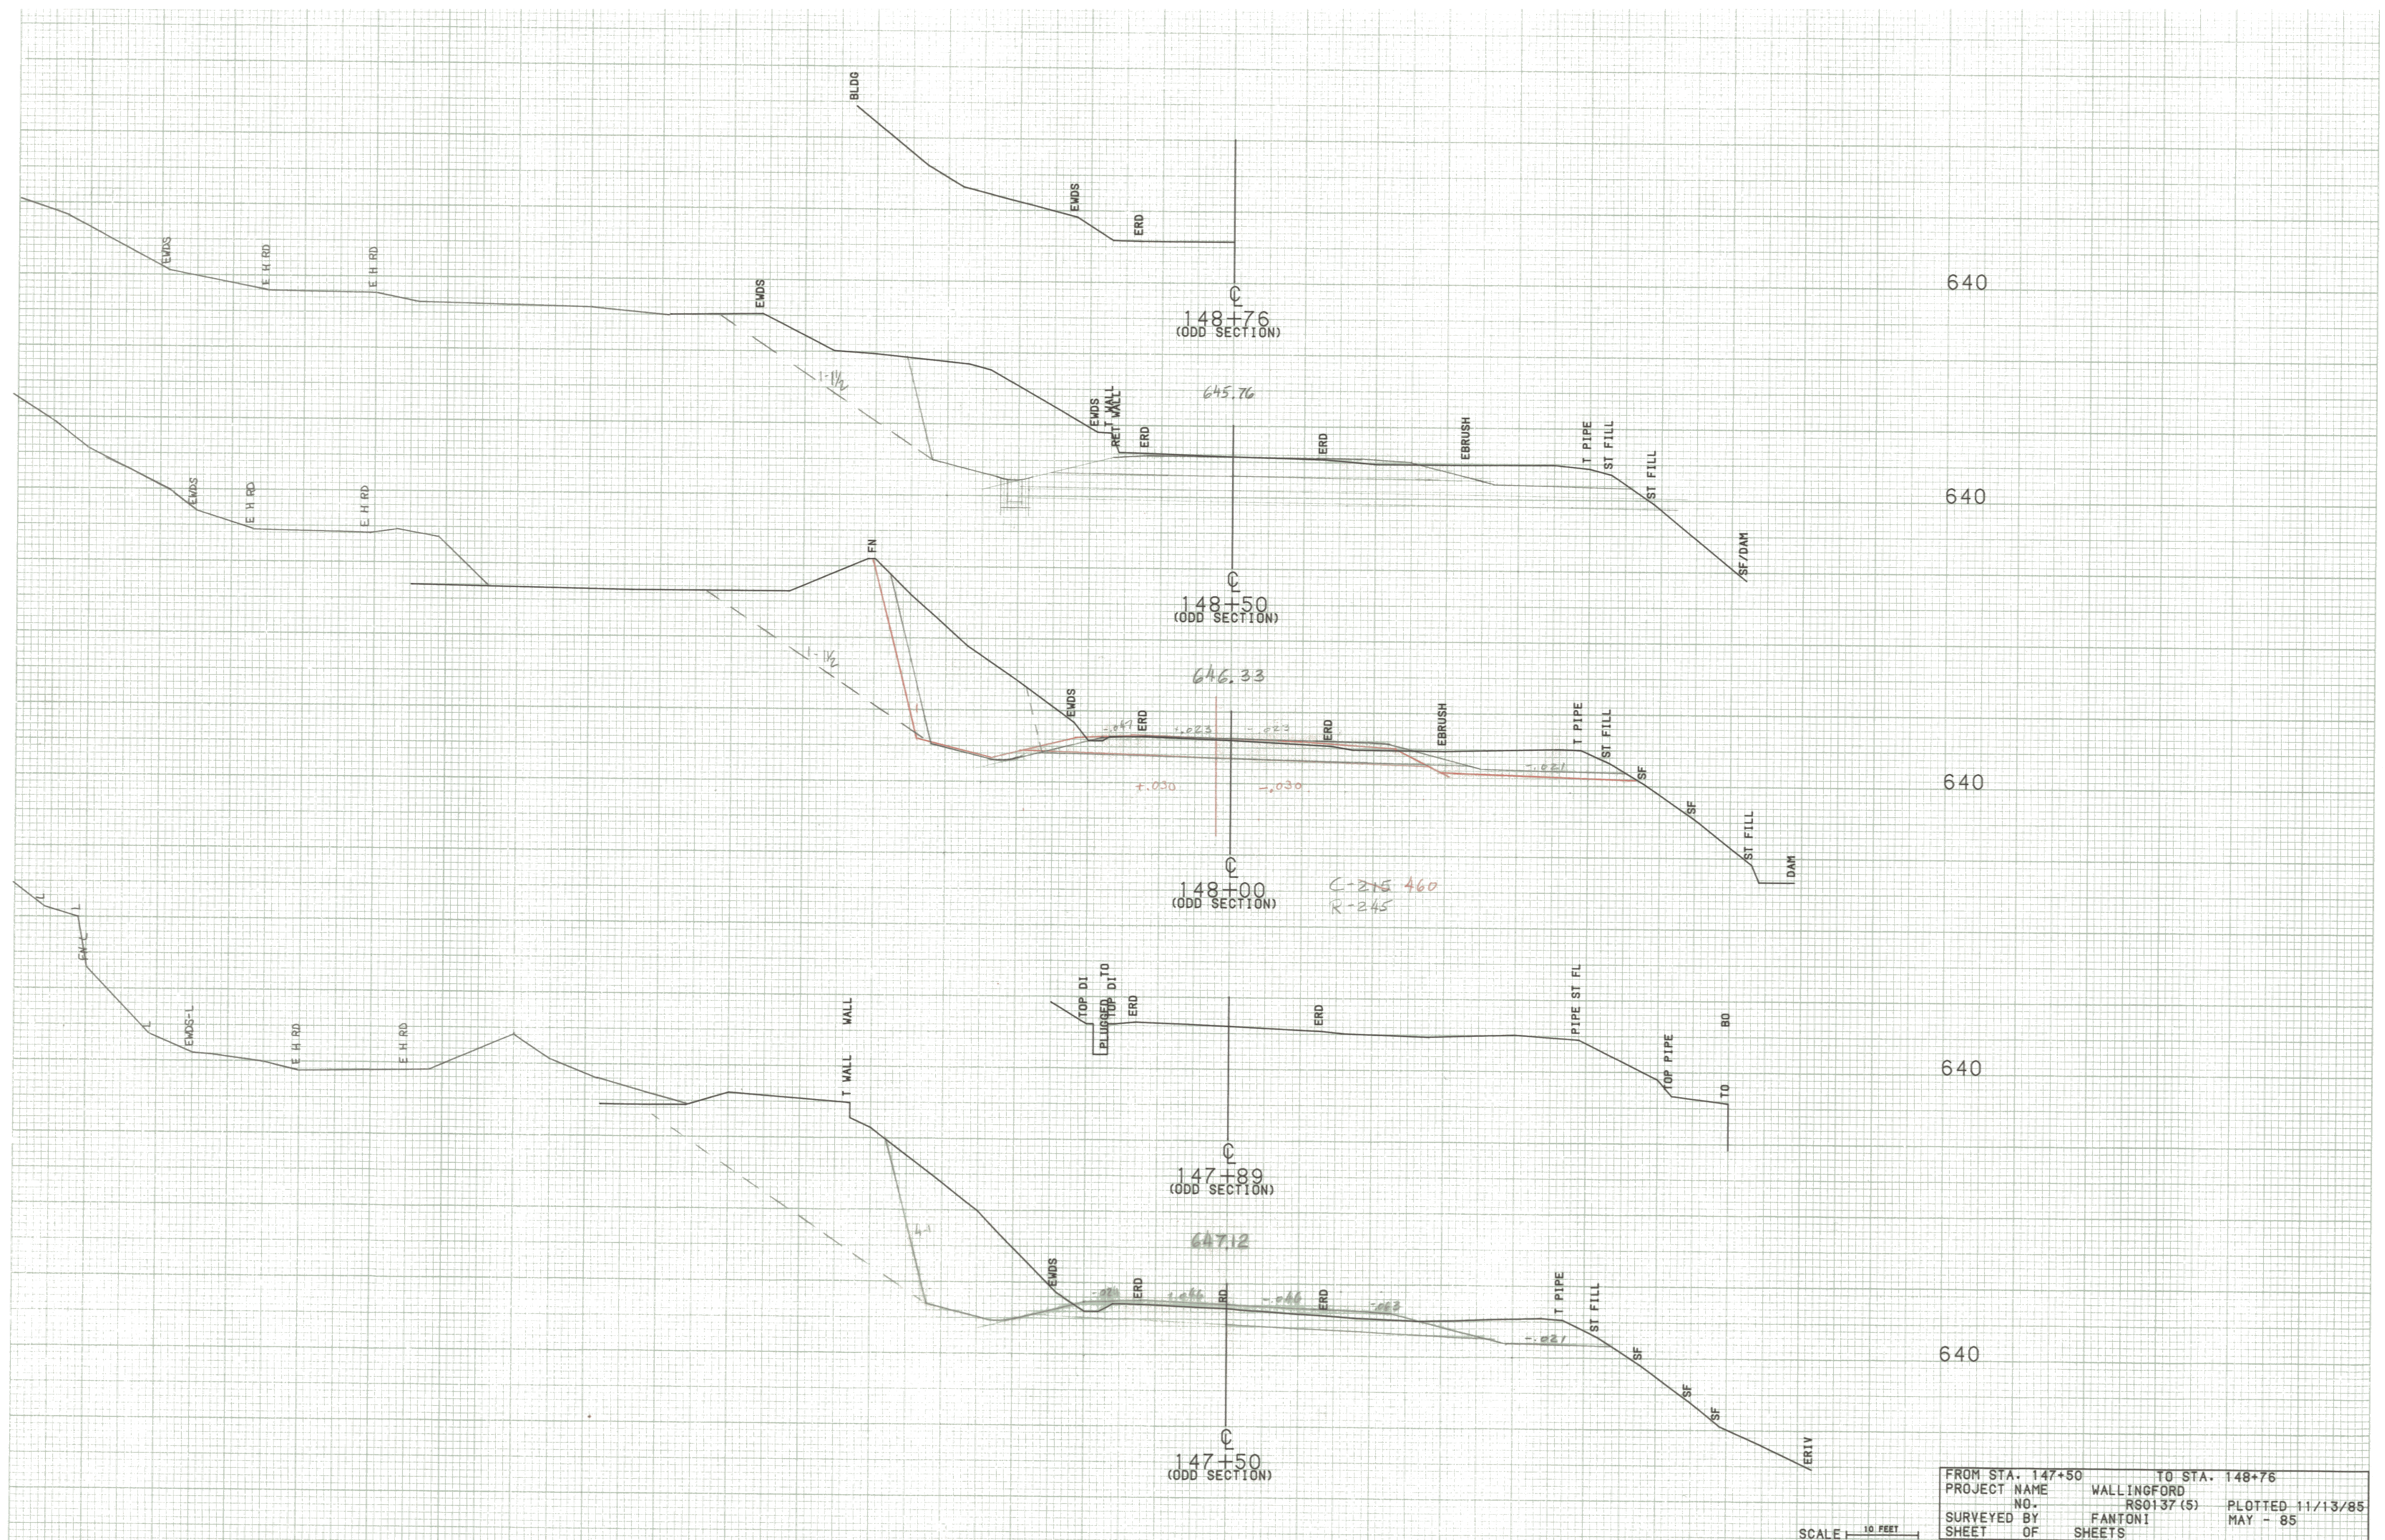

FROM STA. 147+50	TO STA. 148+76
PROJECT NAME	WALLINGFORD
NO.	RS0137 (5)
SURVEYED BY	FANTONI
SHEET OF	SHEETS
	PLOTTED 11/13/85
	MAY - 85