


DATE	BY
SURVEYED	NOTED
PLATTED	AREA
NOTE BOOK	NO.

DATE	BY
10/86	
VT. SURVEY CONSULTANTS	
BRYANT ASSOC.	
SURVEYED	NOTED
PLATTED	AREA
NOTE BOOK	NO.

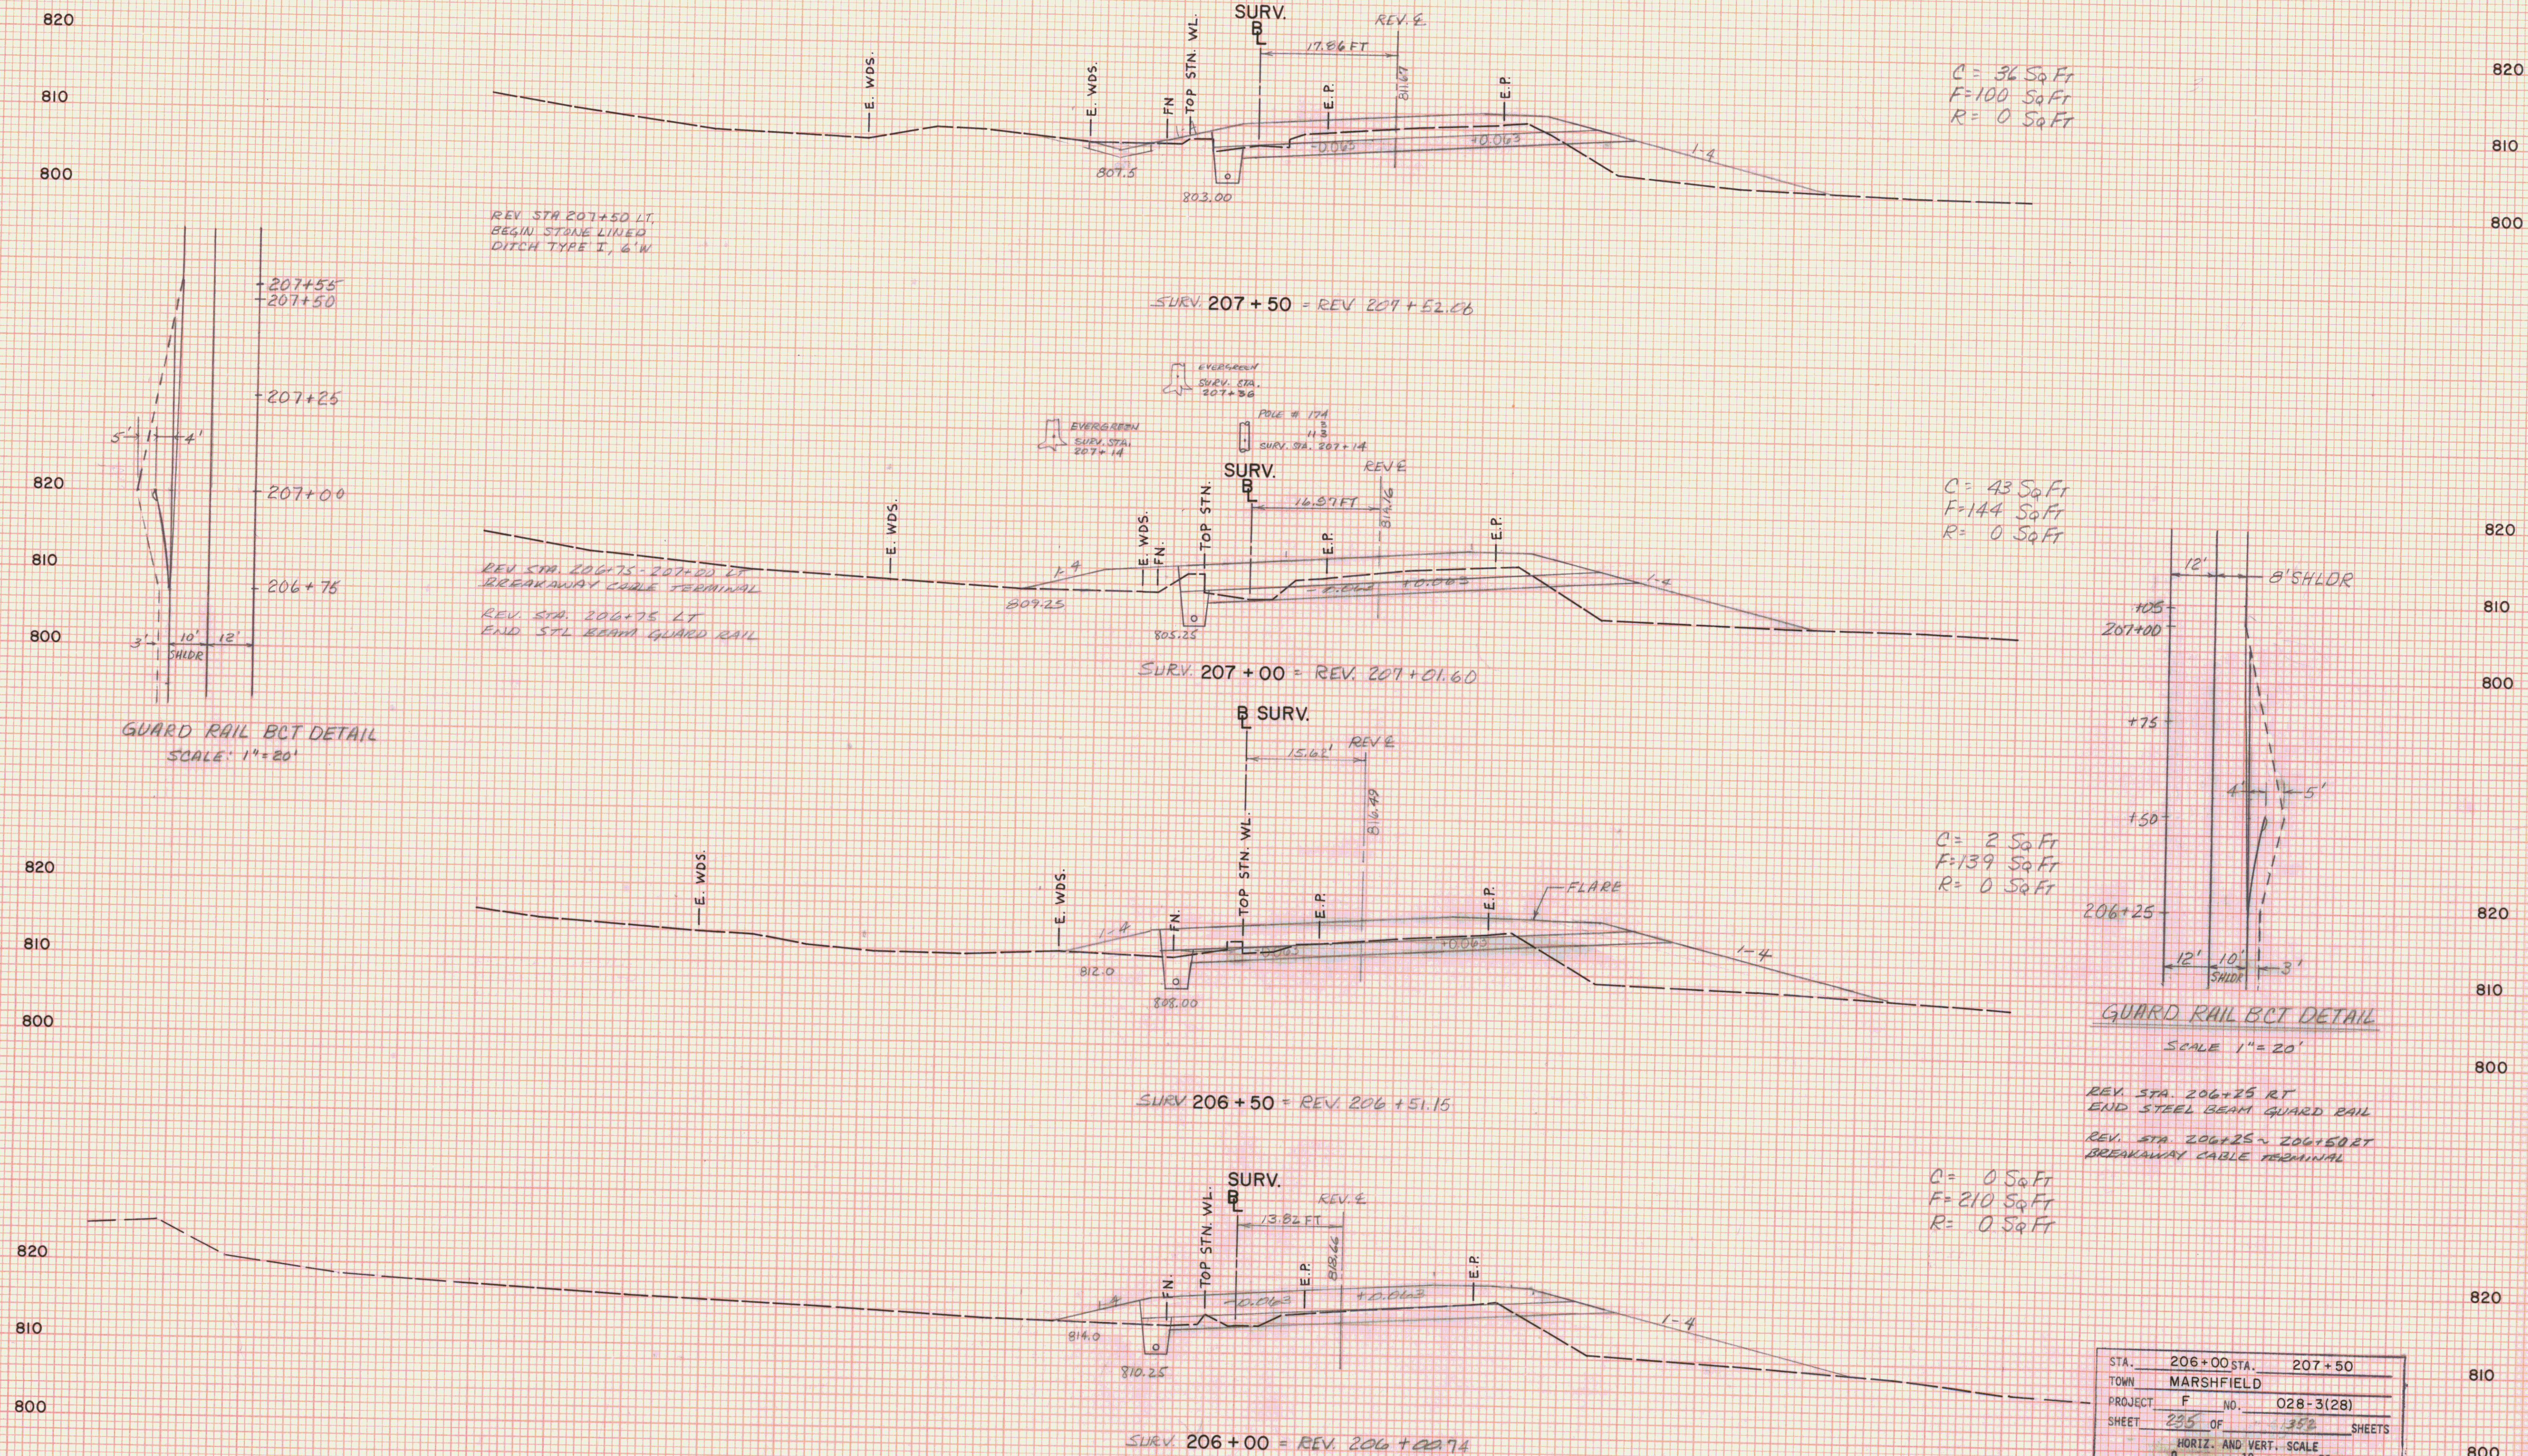

GUARD RAIL BCT DETAIL
SCALE: 1"=20'

GUARD RAIL BCT DETAIL
SCALE 1"=20'

REV STA. 206+25 RT.
END STEEL BEAM GUARD RAIL

REV. STA. 206+25 ~ 206+50 RT
BREAKAWAY CABLE TERMINAL