


FINAL SURVEY	BY	DATE
SURVEYED		
PLOTTED		
TEMPLATE		
AREAS		
AREAS CHECKED		
NO.		

ORIGINAL SURVEY	SURVEYED	BY	DATE
		V.T. SURVEY CONSULT.	10/86
		BRYANT ASSOC.	11/86
	PLOTTED		
	TEMPLATE		
	AREAS		
	AREAS CHECKED		
	NO		

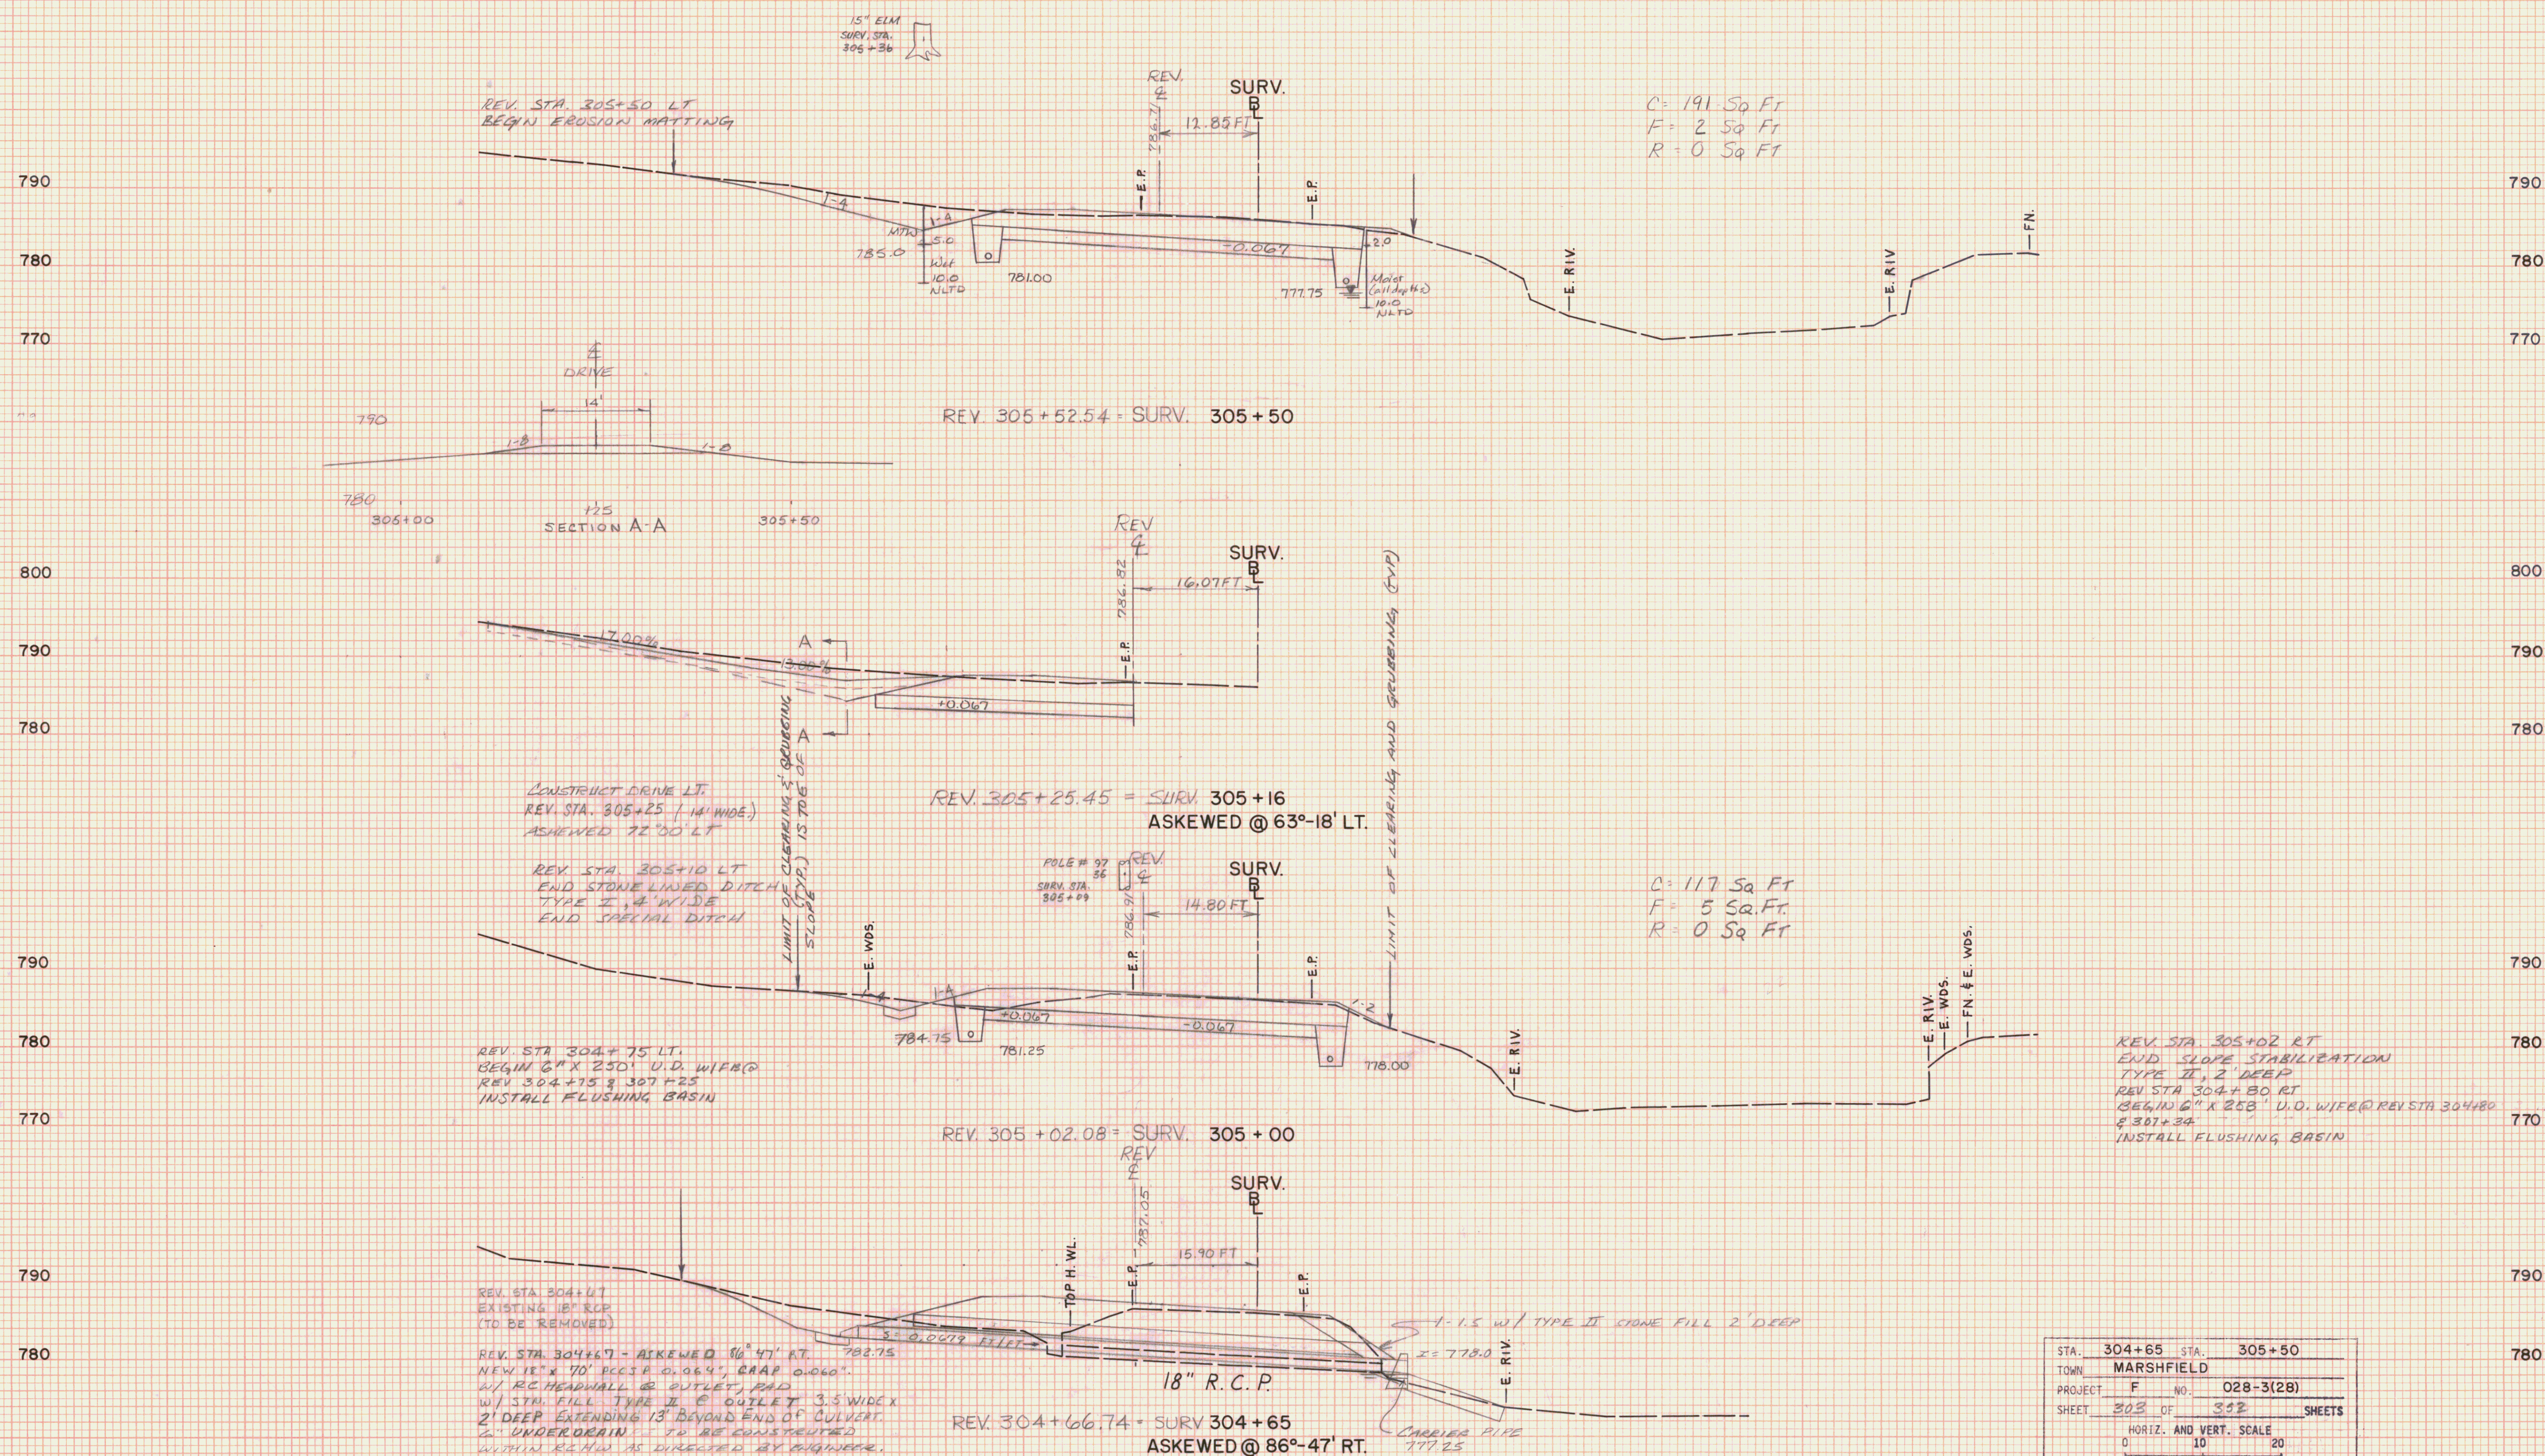

STA. 304+65 STA. 305+50
TOWN MARSHFIELD
PROJECT F NO. 028-3(28)
SHEET 303 OF 302 SHEET
HORIZ. AND VERT. SCALE
0 10 20
SURVEYED BY: VT. SURVEY CONSULTANTS DATE 10/86