
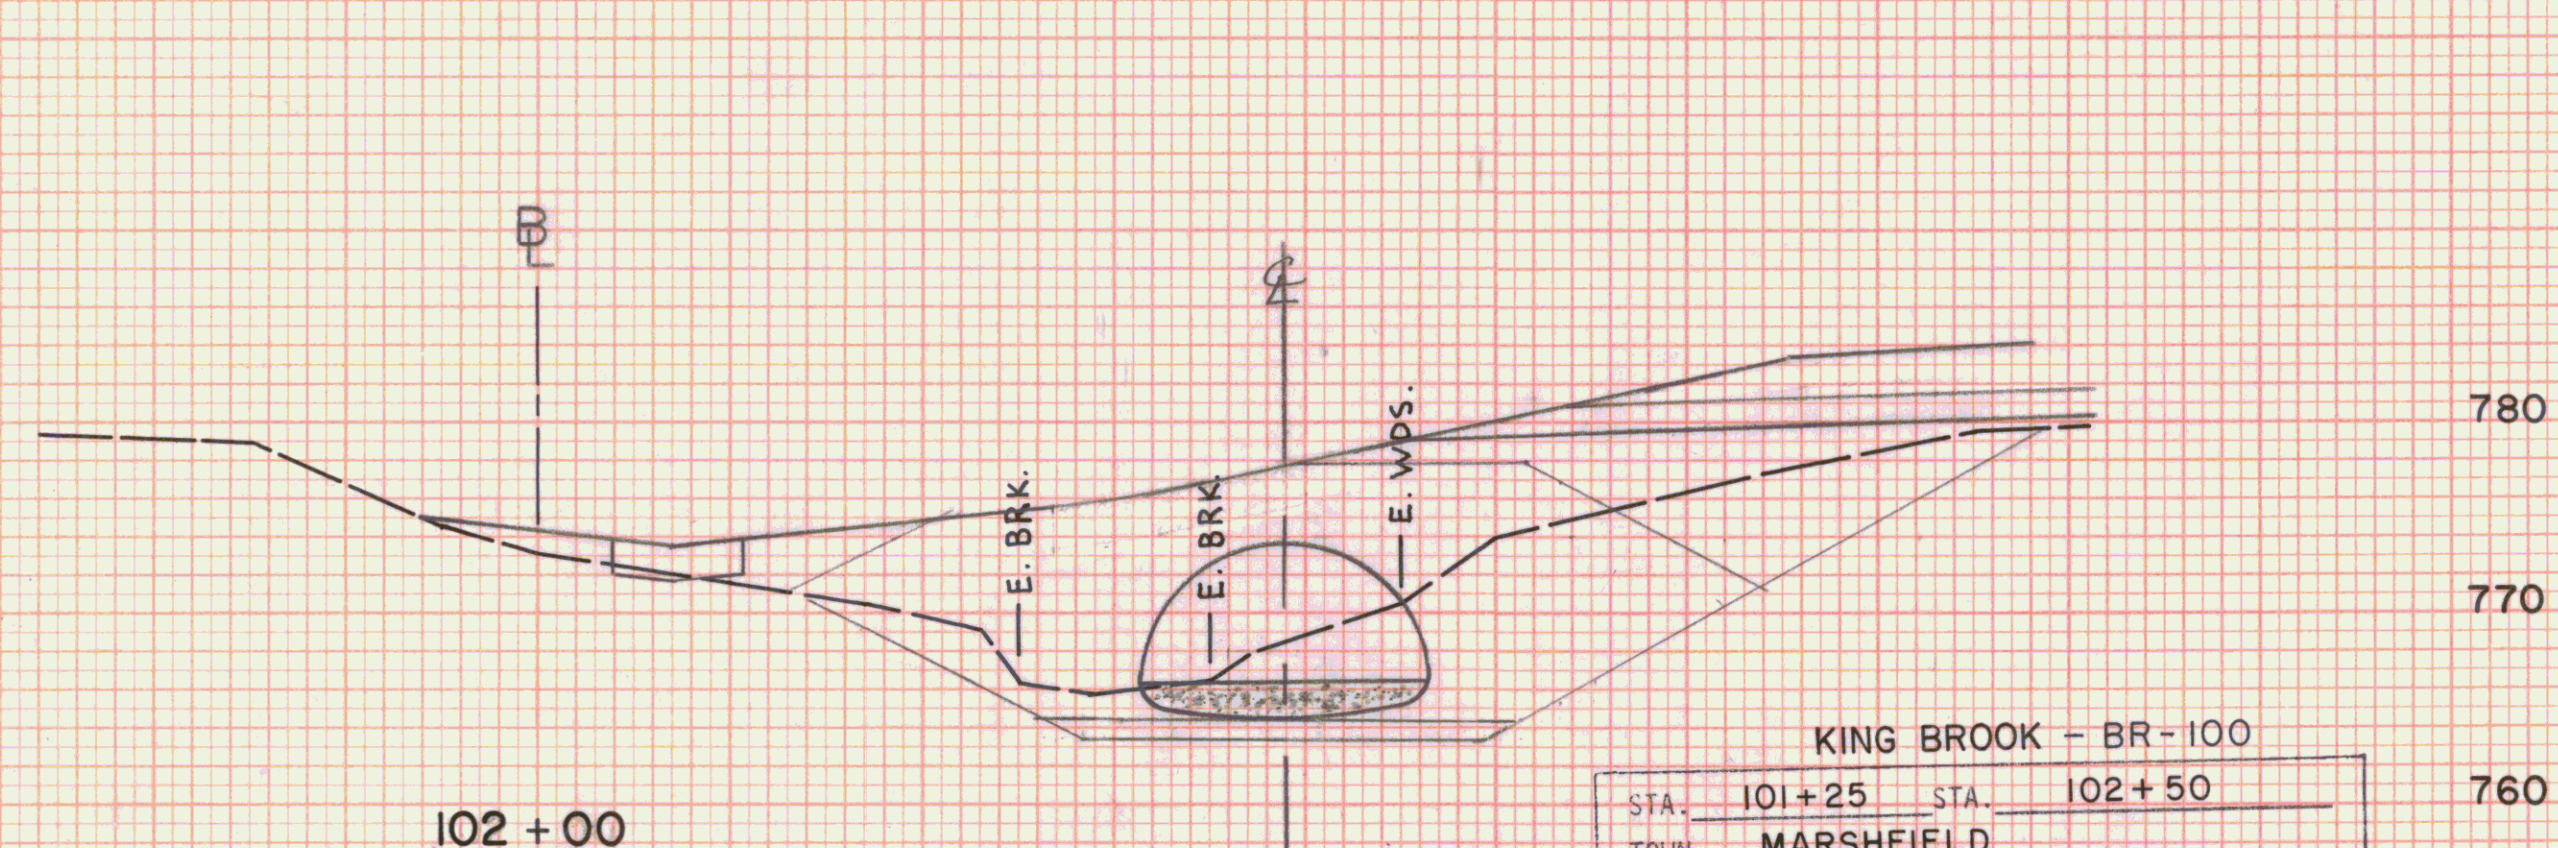
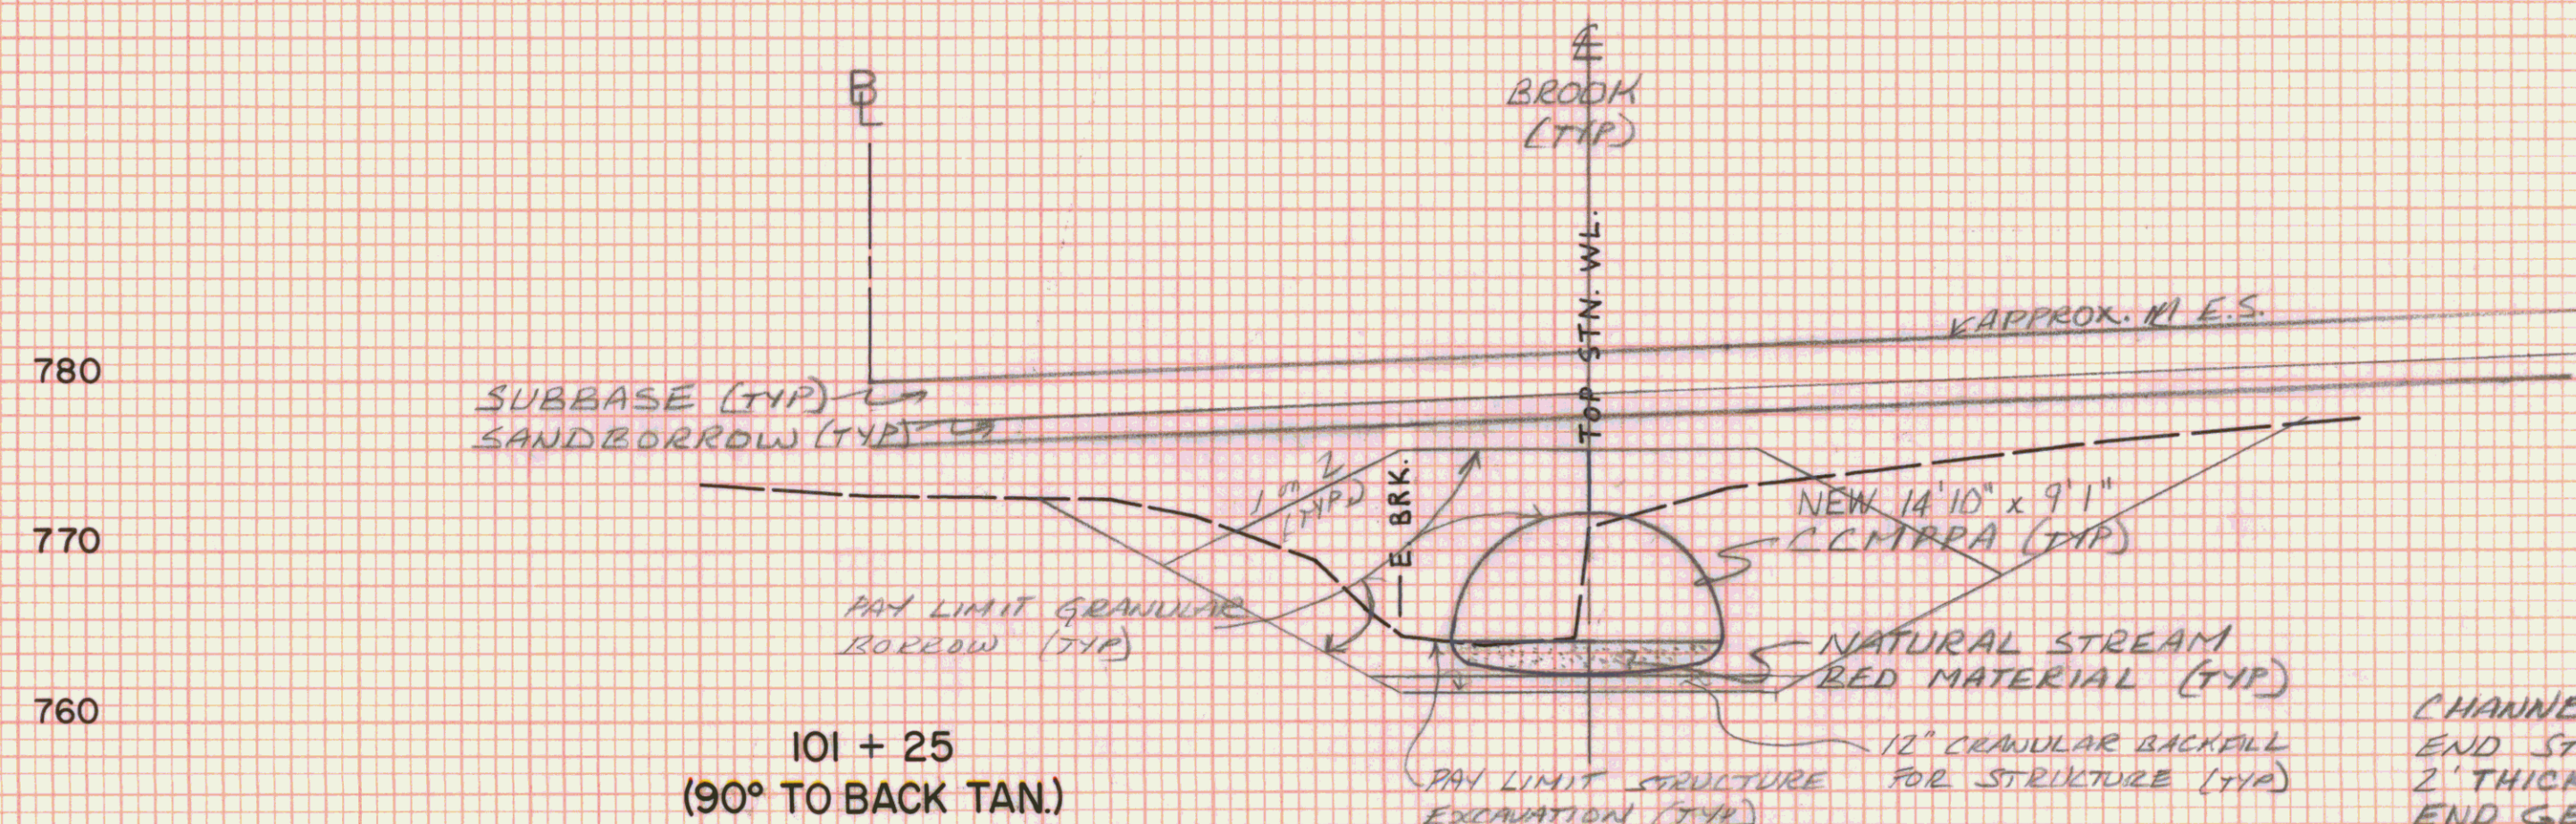
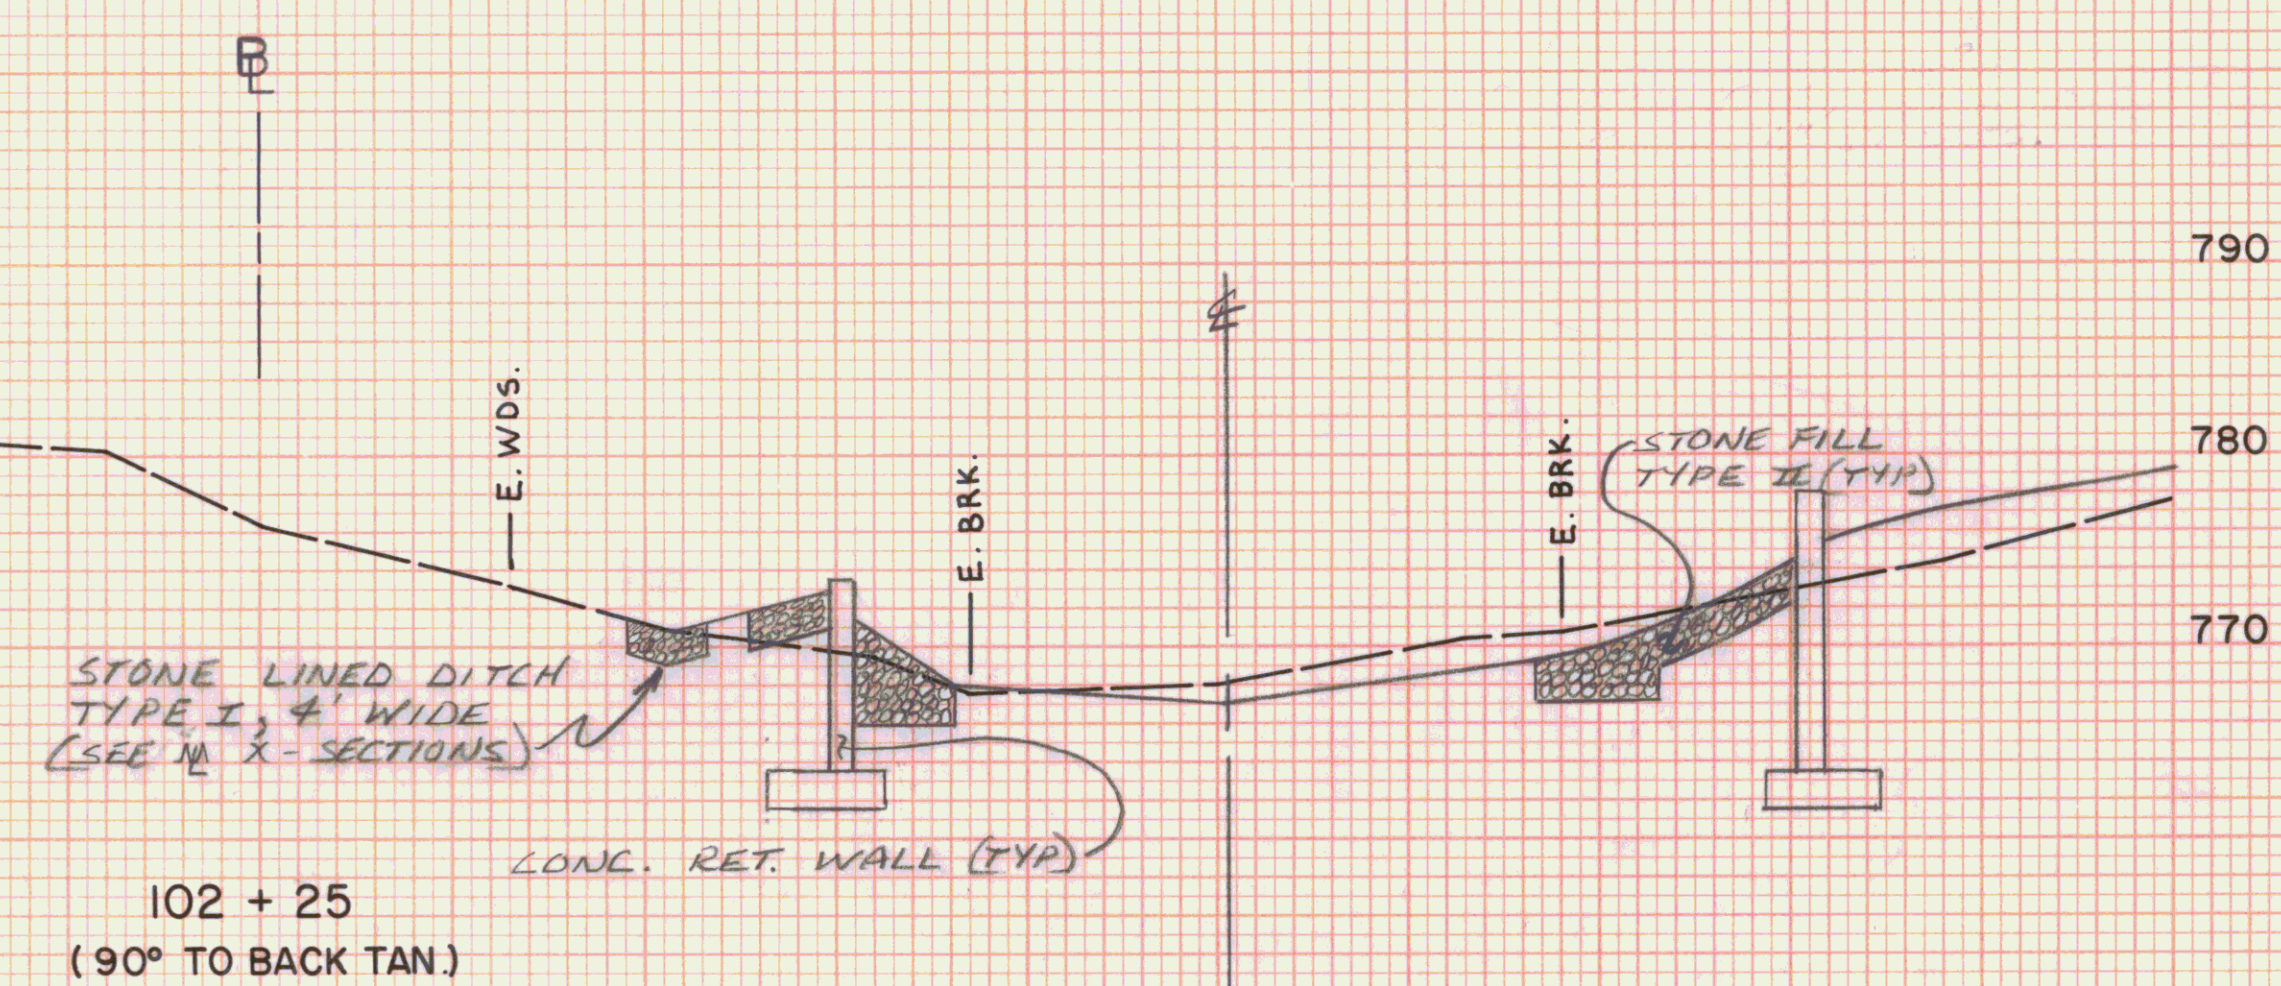
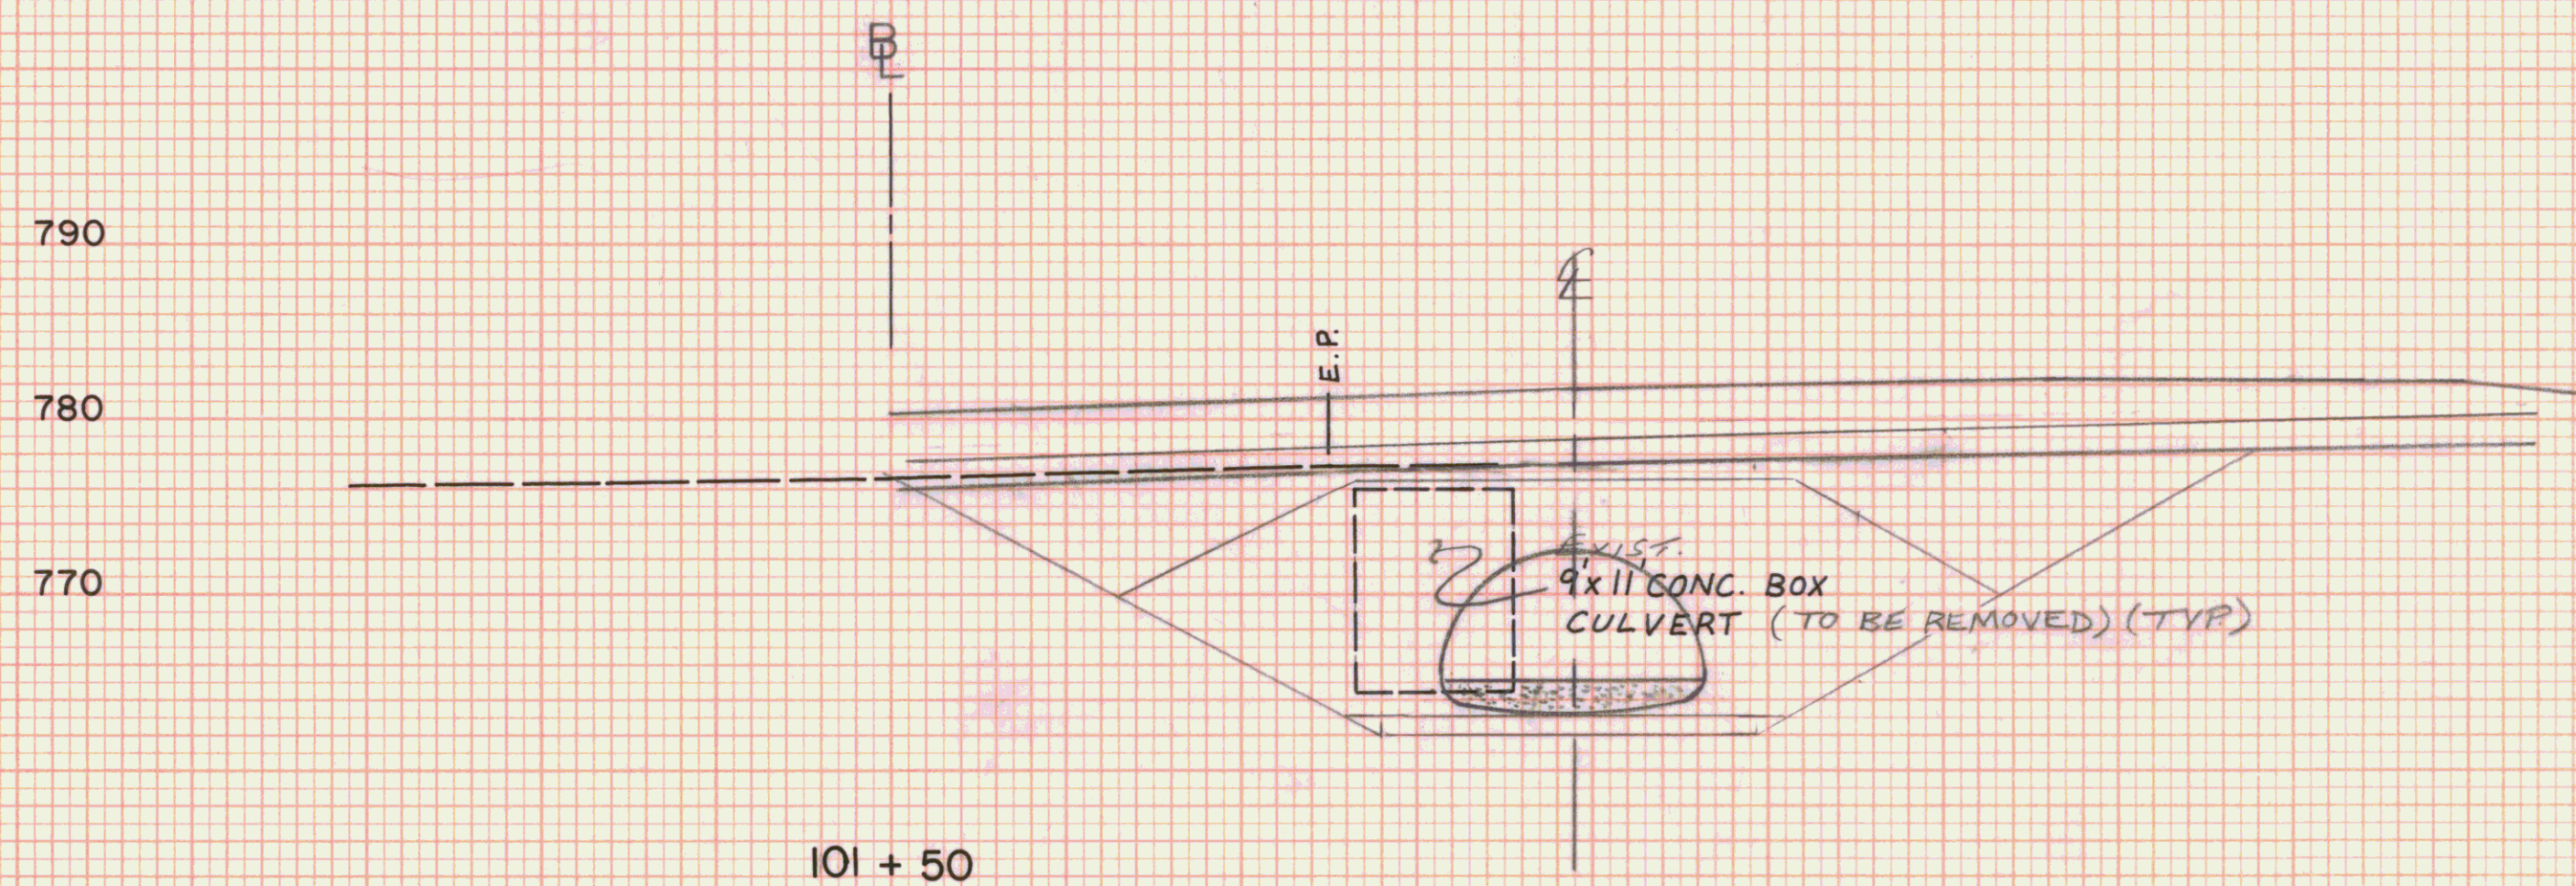
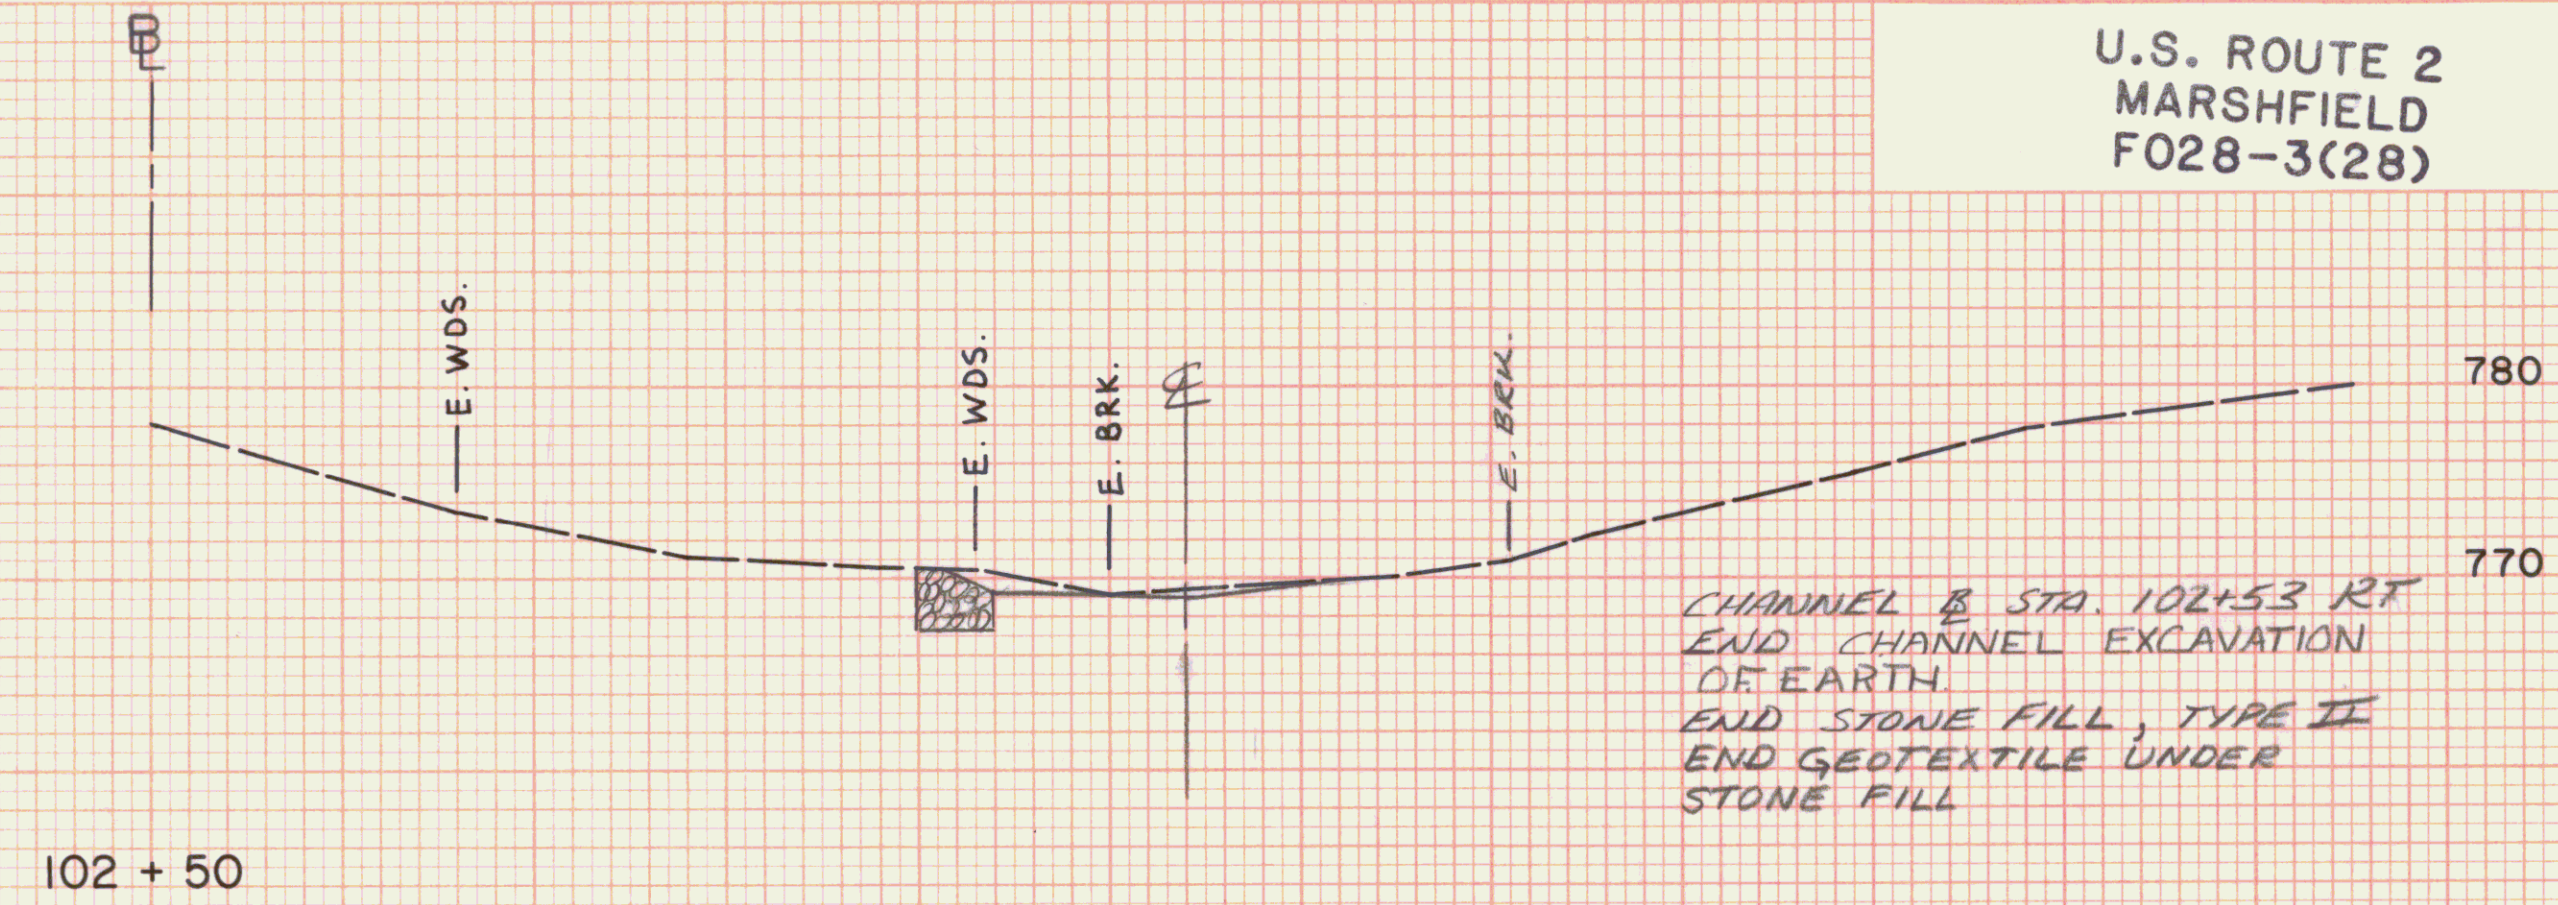


FINAL SURVEY	DATE	
	BY	
	SURVEYED	
	NOTED	
NO.		

ORIGINAL SURVEY	DATE	12/86
	BY	VT. SURVEY CONSULTANTS
	NOTED	BRYANT ASSOC.
	NO.	

KING BROOK
CHANNEL SECTIONS
STA. 113+85.00
(NEW 14'-10"x9'-1" CGMPPA.
REV. STA. 114+00
ASKEWED 70°00'00")

U.S. ROUTE 2
MARSHFIELD
F028-3(28)

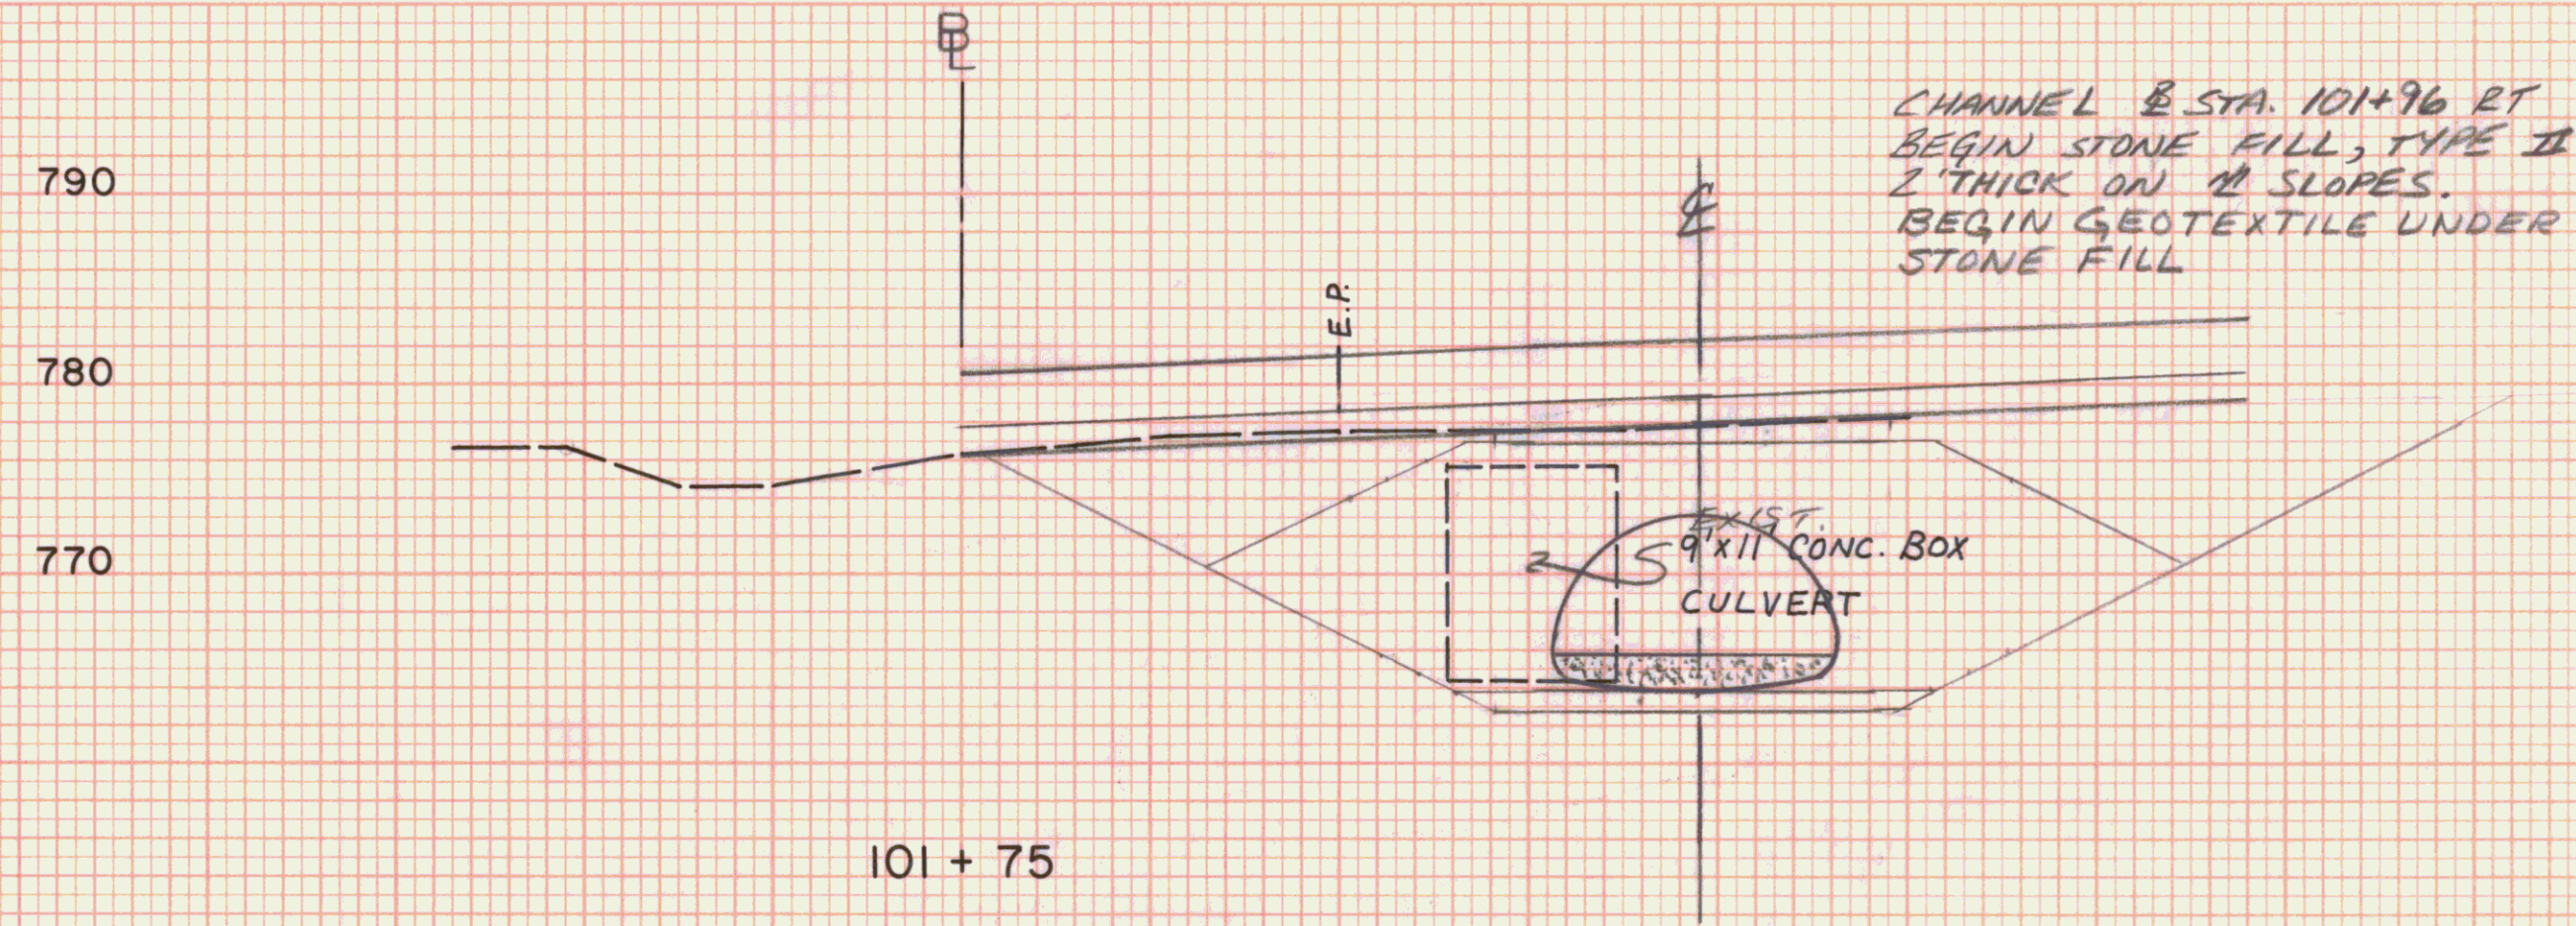

NOTE: ALL CONSTRUCTION NOTE STA. SHOULD BE
REFERENCED J. TO CHANNEL CL, THEN PLOTTED
J. TO CL OF BROOK FOR LIMITS.

KING BROOK - BR-100	
STA. 101+25	STA. 102+50
TOWN MARSHFIELD	
PROJECT FECC NO. F028-3(28)	
SHEET 335	OF 352 SHEETS
HORIZ. AND VERT. SCALE 0 10 20	
VT. SURVEY SURVEYED BY: CONSULTANTS DATE 12/86	