

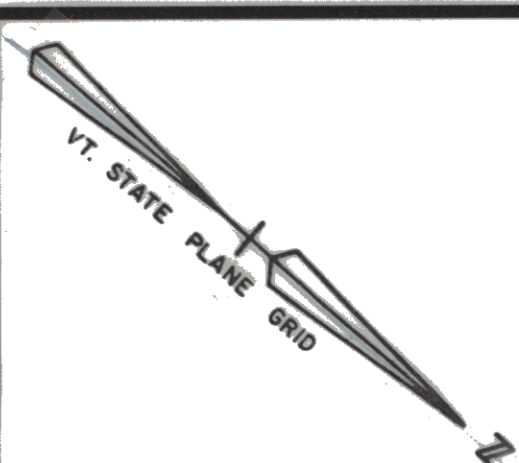


FOOTING REINFORCING PLAN
SCALE: 1/8" = 1'-0"

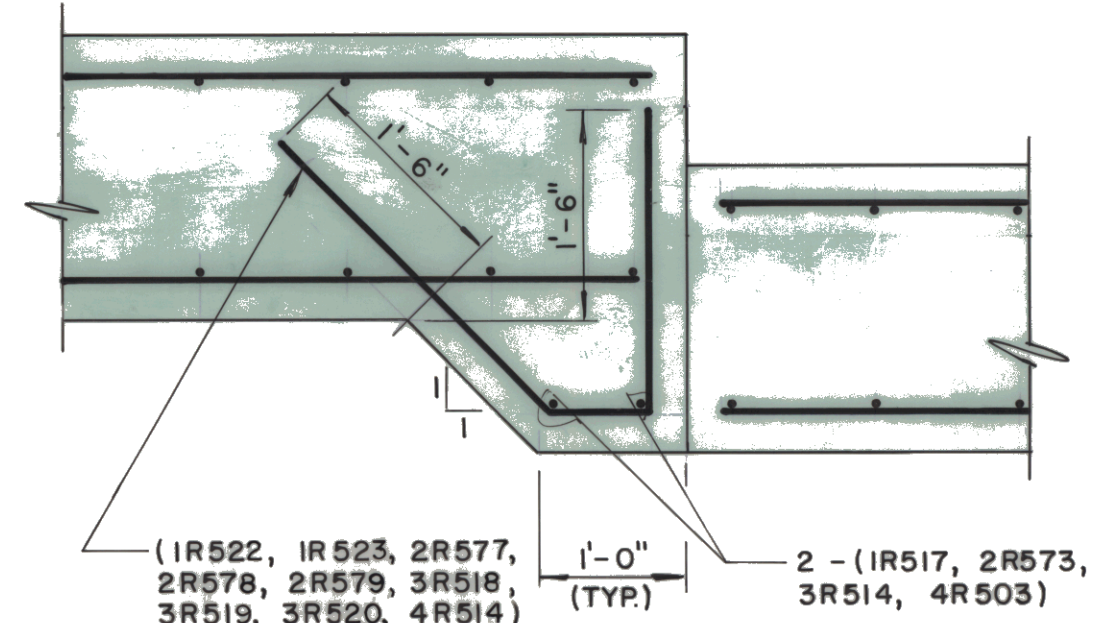

FOOTING STEP DETAIL
NOT TO SCALE

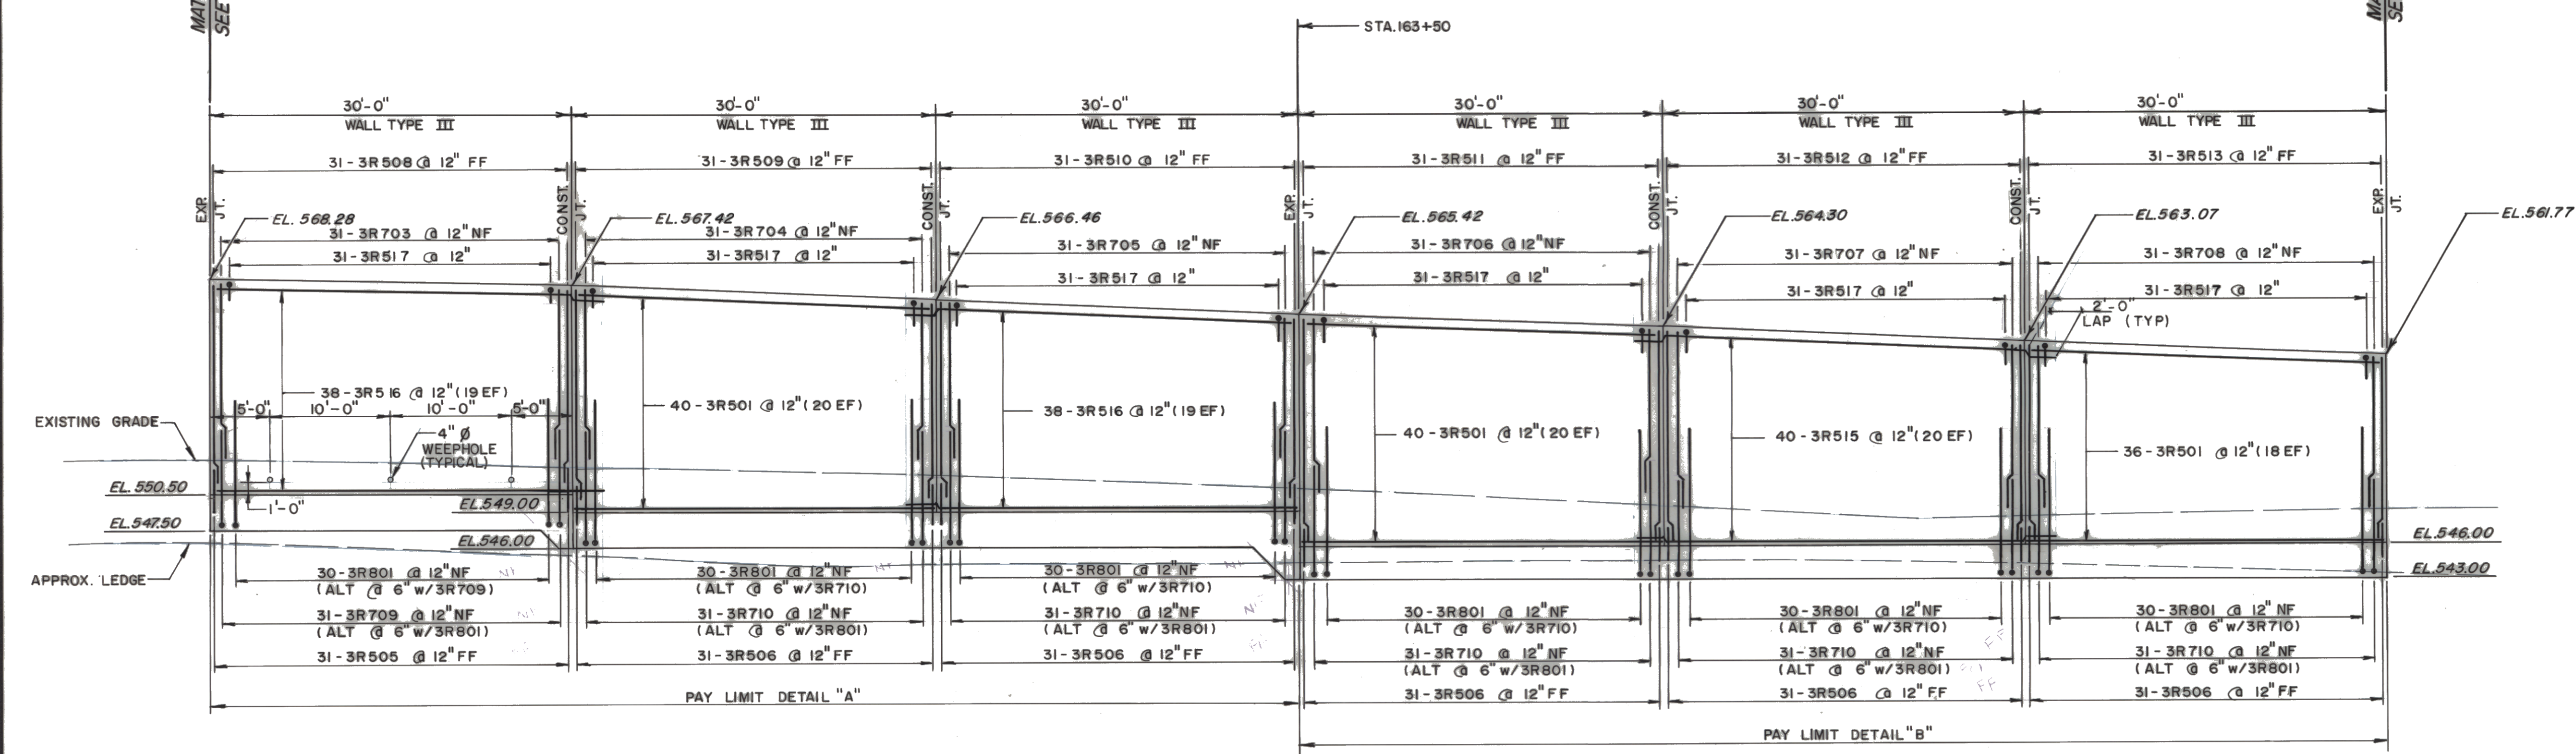

ELEVATION (VIEW FACING SOUTH)
SCALE: 1/8" = 1'-0"

- NOTES**
1. FOR WALL TYPE SECTIONS, SEE SHT. 158
 2. FOR PAY LIMIT DETAILS, SEE SHT. 157 & 159
 3. FOR EXPANSION AND CONTRACTION JOINT DETAILS, SEE SHT. 154
 4. FOR BORING LOCATIONS & BORING LOGS, SEE SHTS. 168 & 169
 5. HORIZONTAL DIMENSIONS ON PLAN VIEW ARE GIVEN RADIAL TO C. RT. 346.
 6. HORIZONTAL DIMENSIONS ON ELEVATION VIEW ARE GIVEN ALONG TOP OF WALL AND ARE CONCENTRIC WITH C. RT. 346
 7. N.F. = NEAR FACE
F.F. = FAR FACE
E.F. = EACH FACE

PAE ENGINEERING CORPORATION
Engineers - Planners - Landscape Architects
8 Blackstone Valley Place, Lincoln, RI 02665
401/334/4100

STATE OF VERMONT AGENCY OF TRANSPORTATION			
Town Of POWNA		Bridge No.	
Highway No. ROUTE 346		Log Sta.	
CONCRETE RETAINING WALL			
STA. 162+60 TO STA. 164+40			
Designed By J.S.J.		Drawn By K.M.B.	
Checked By	Date	Bridge Design Supervisor	Date
PROJECT POWNA		PROJECT NO. RS0107 (7)	
I.G.C. Info.		Bridge Sheet No.	
Sheet 155 of 319			