



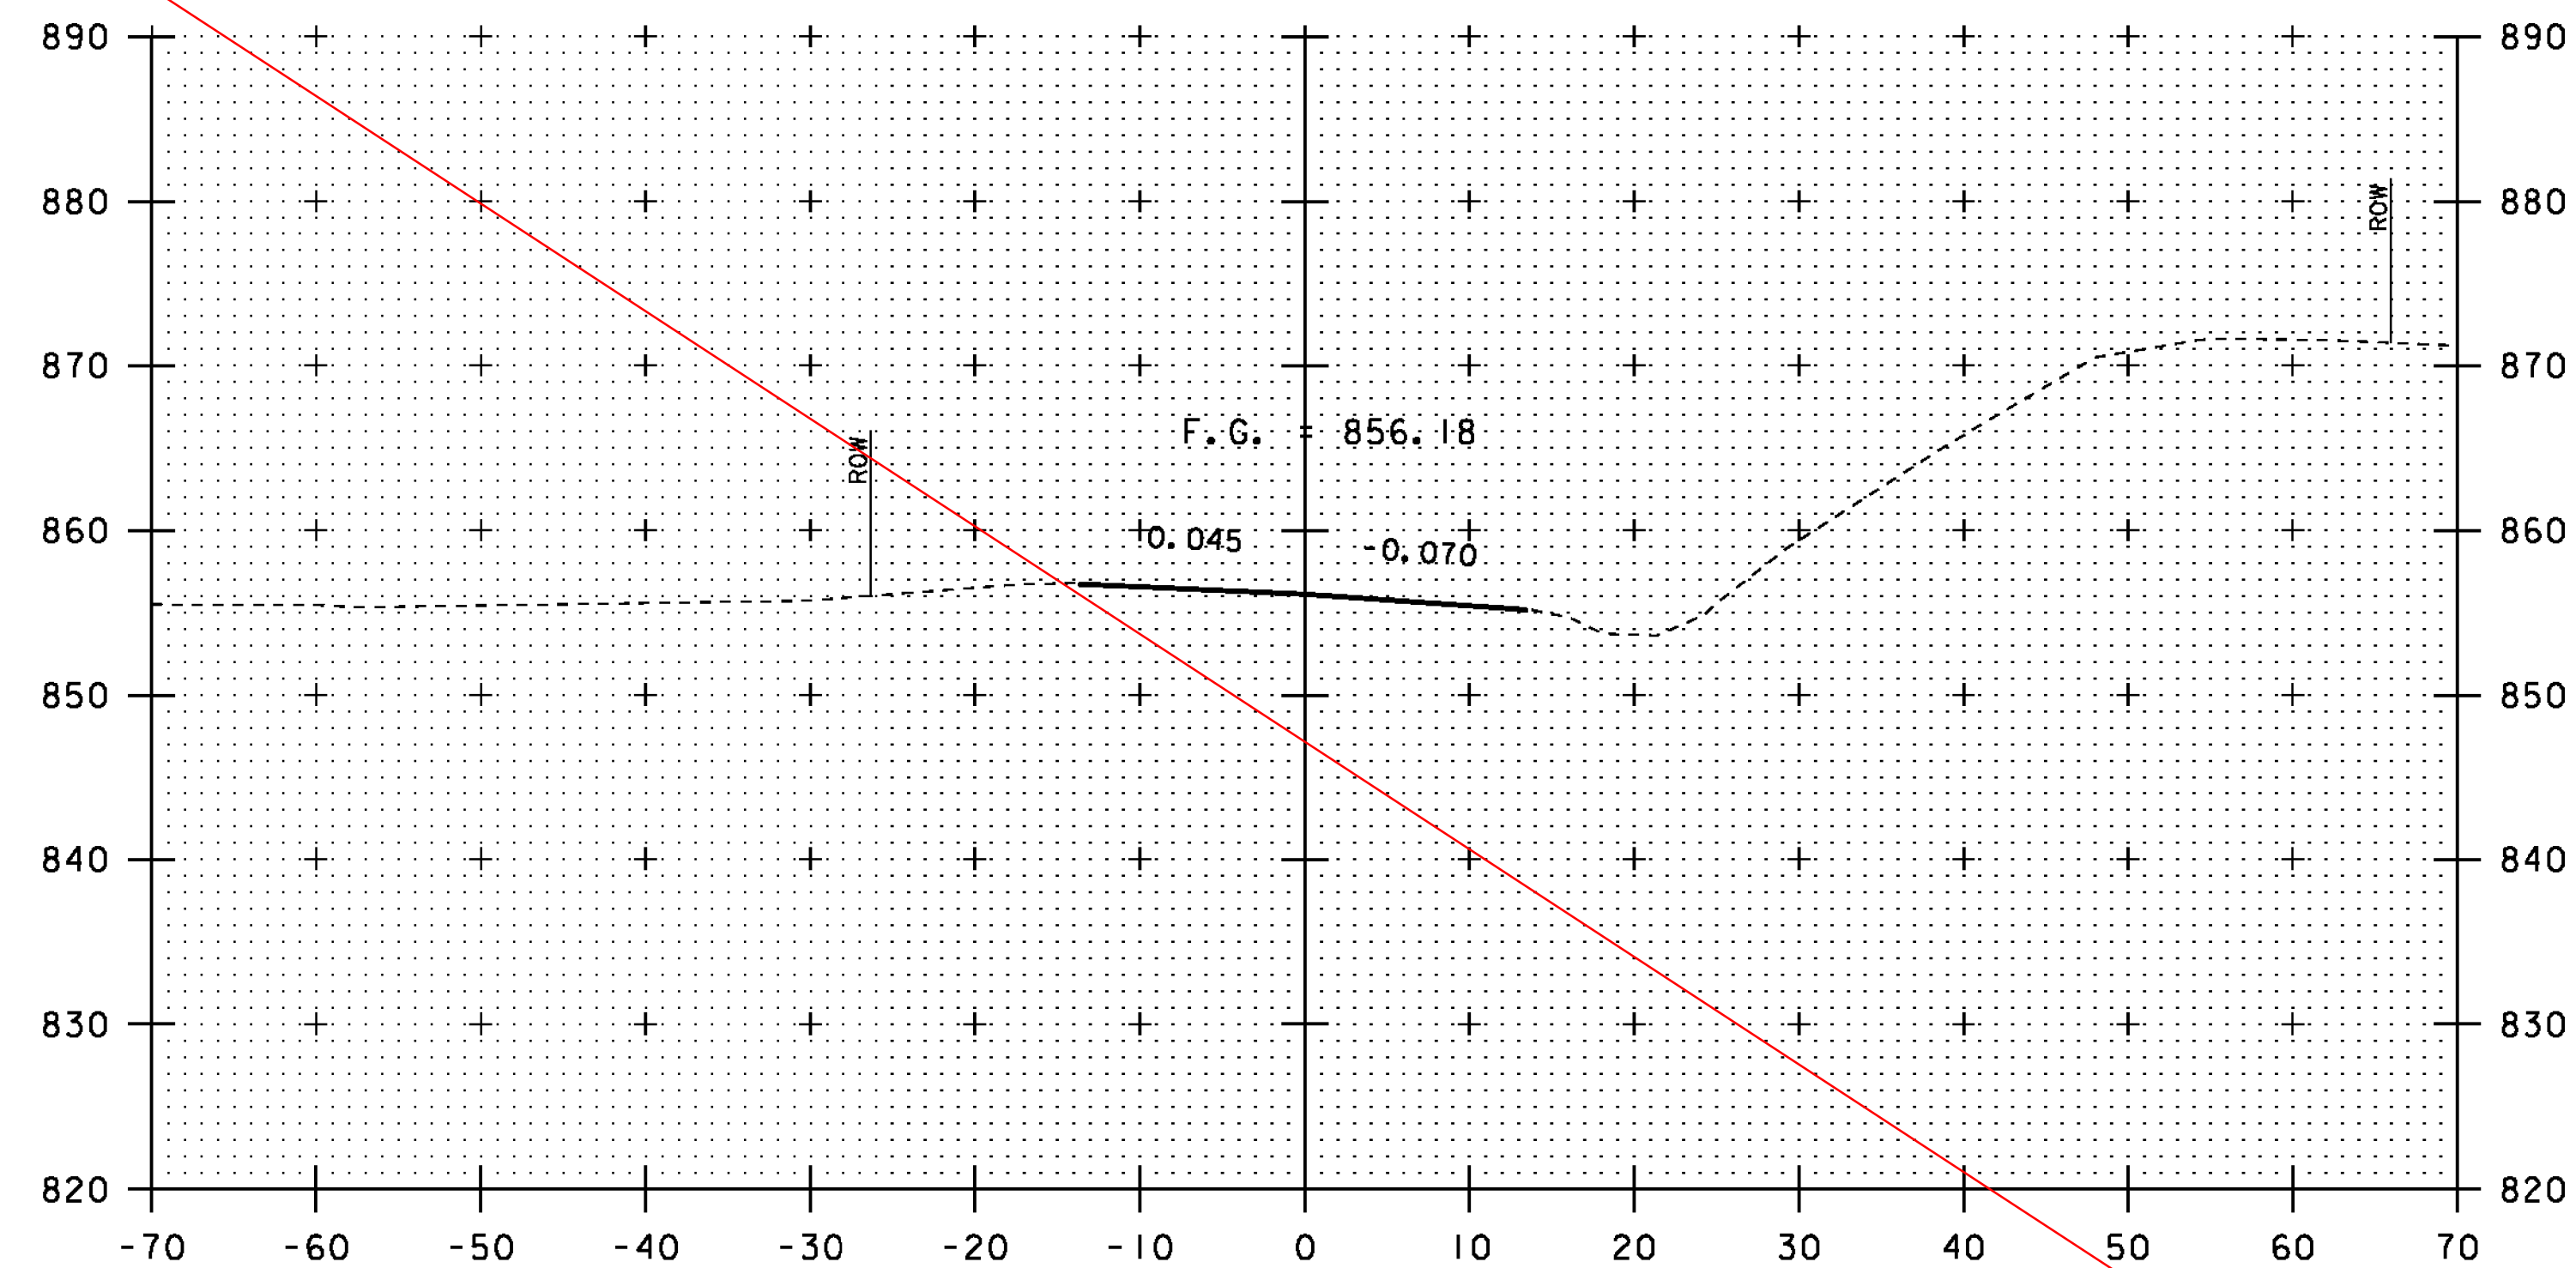


258+00


BEGIN APPROACH
MATCH EXISTING
STA 258+00.00

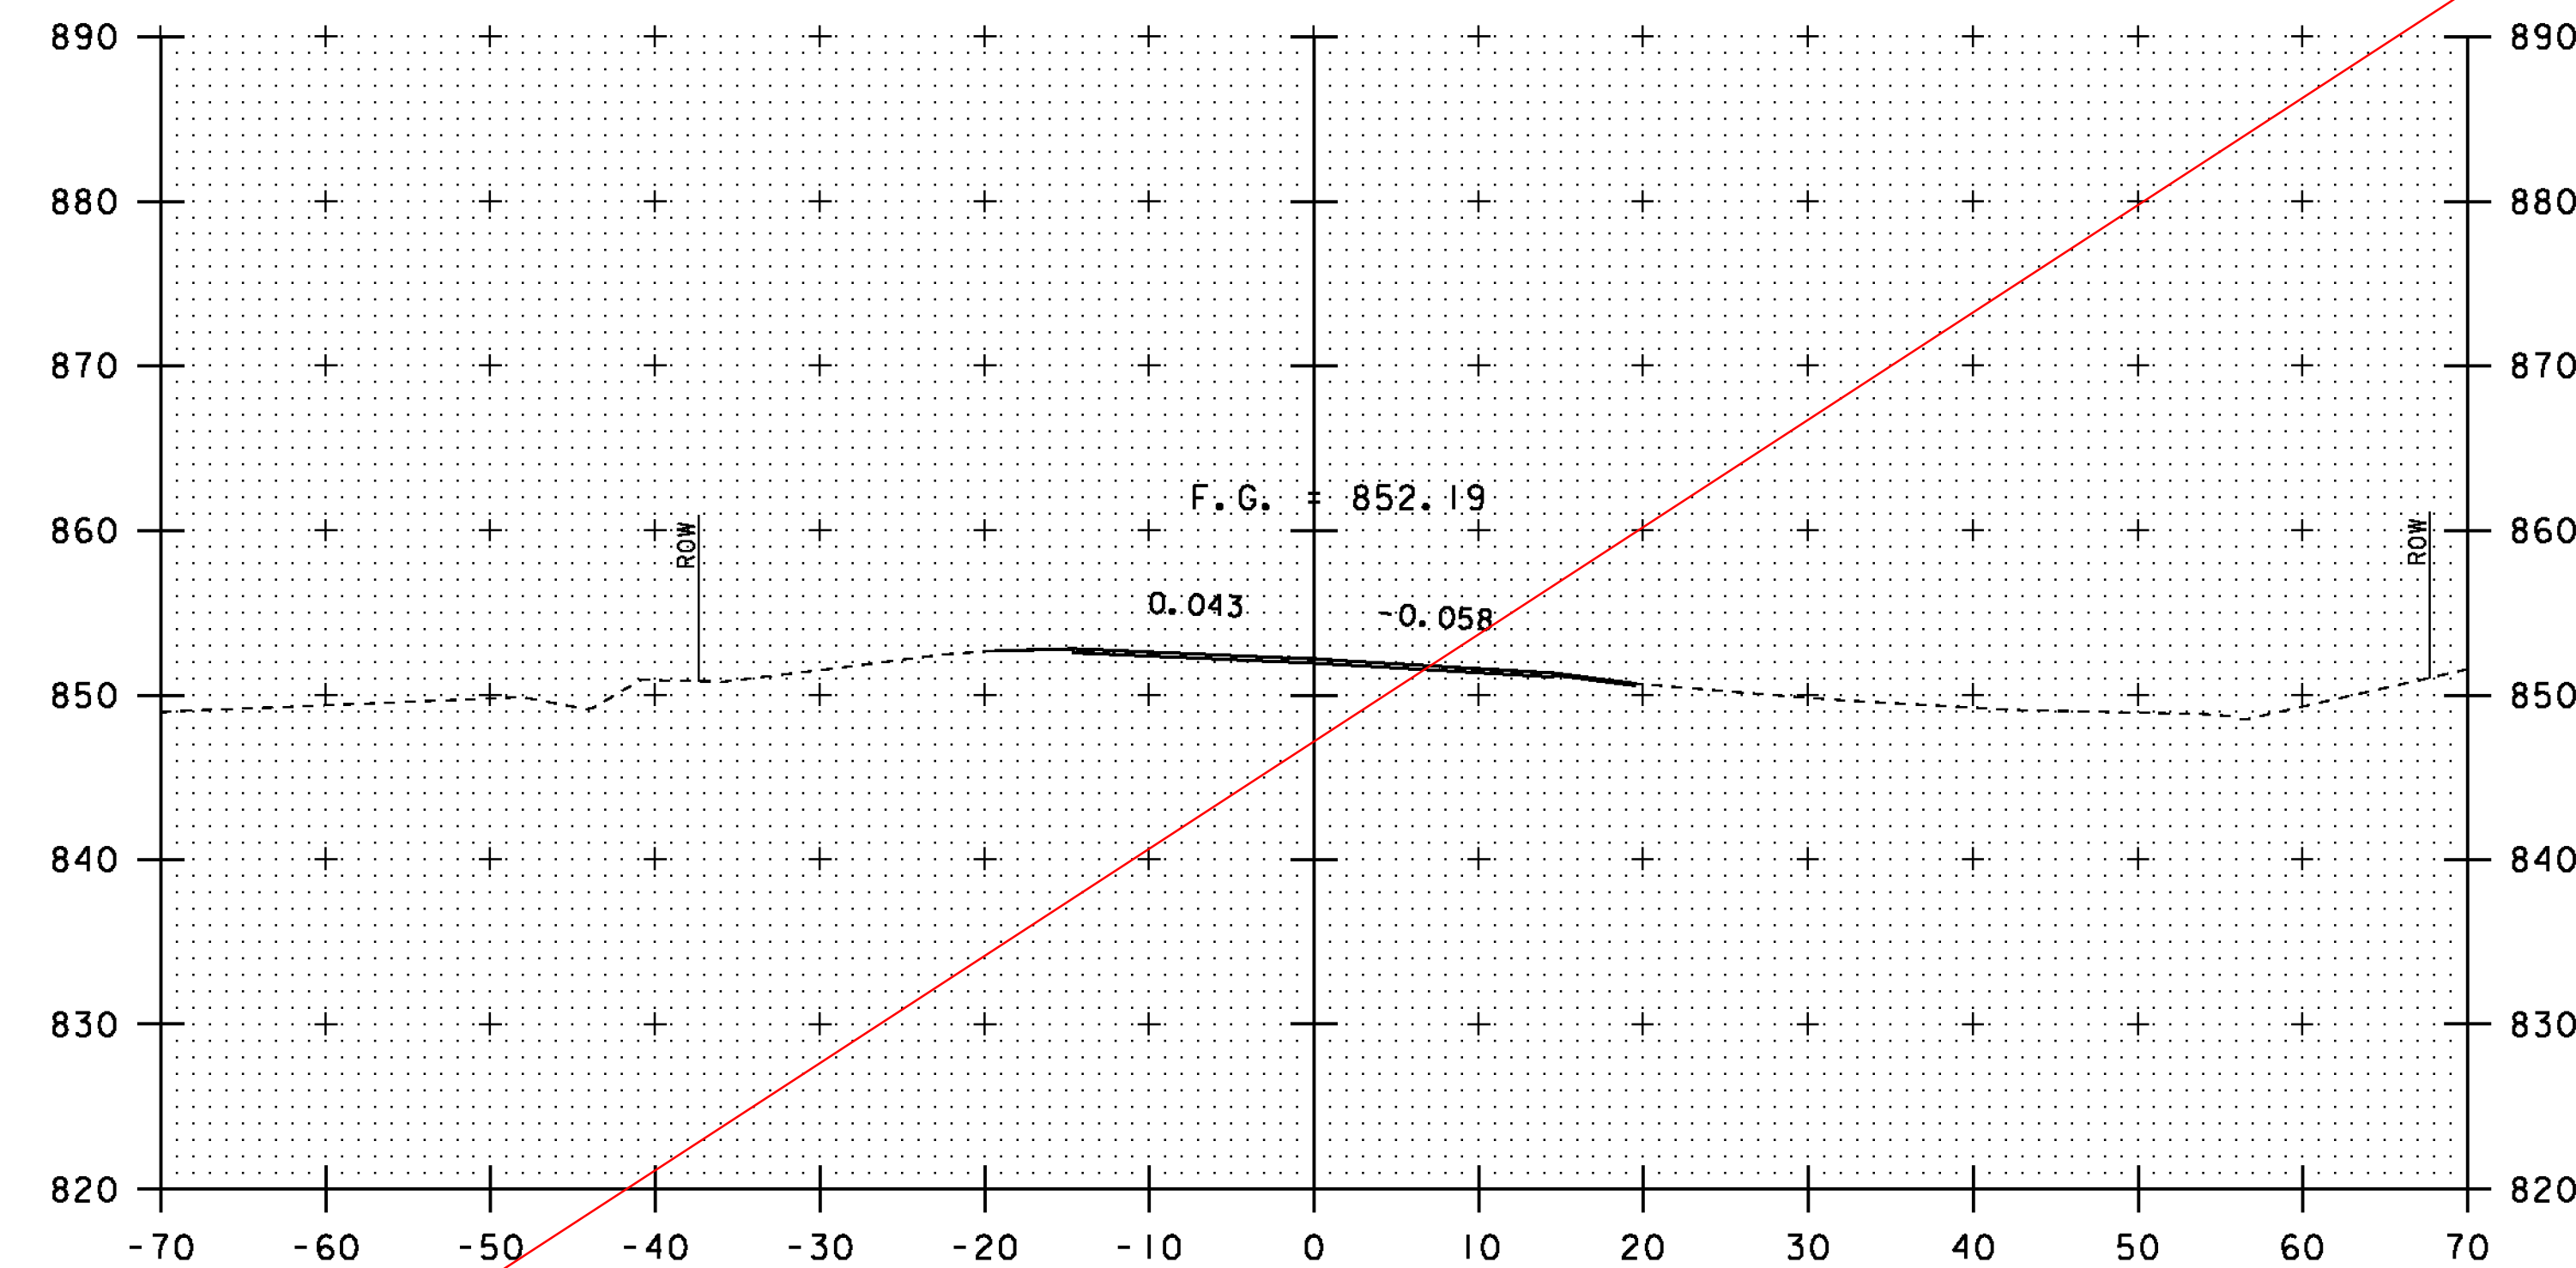

258+50

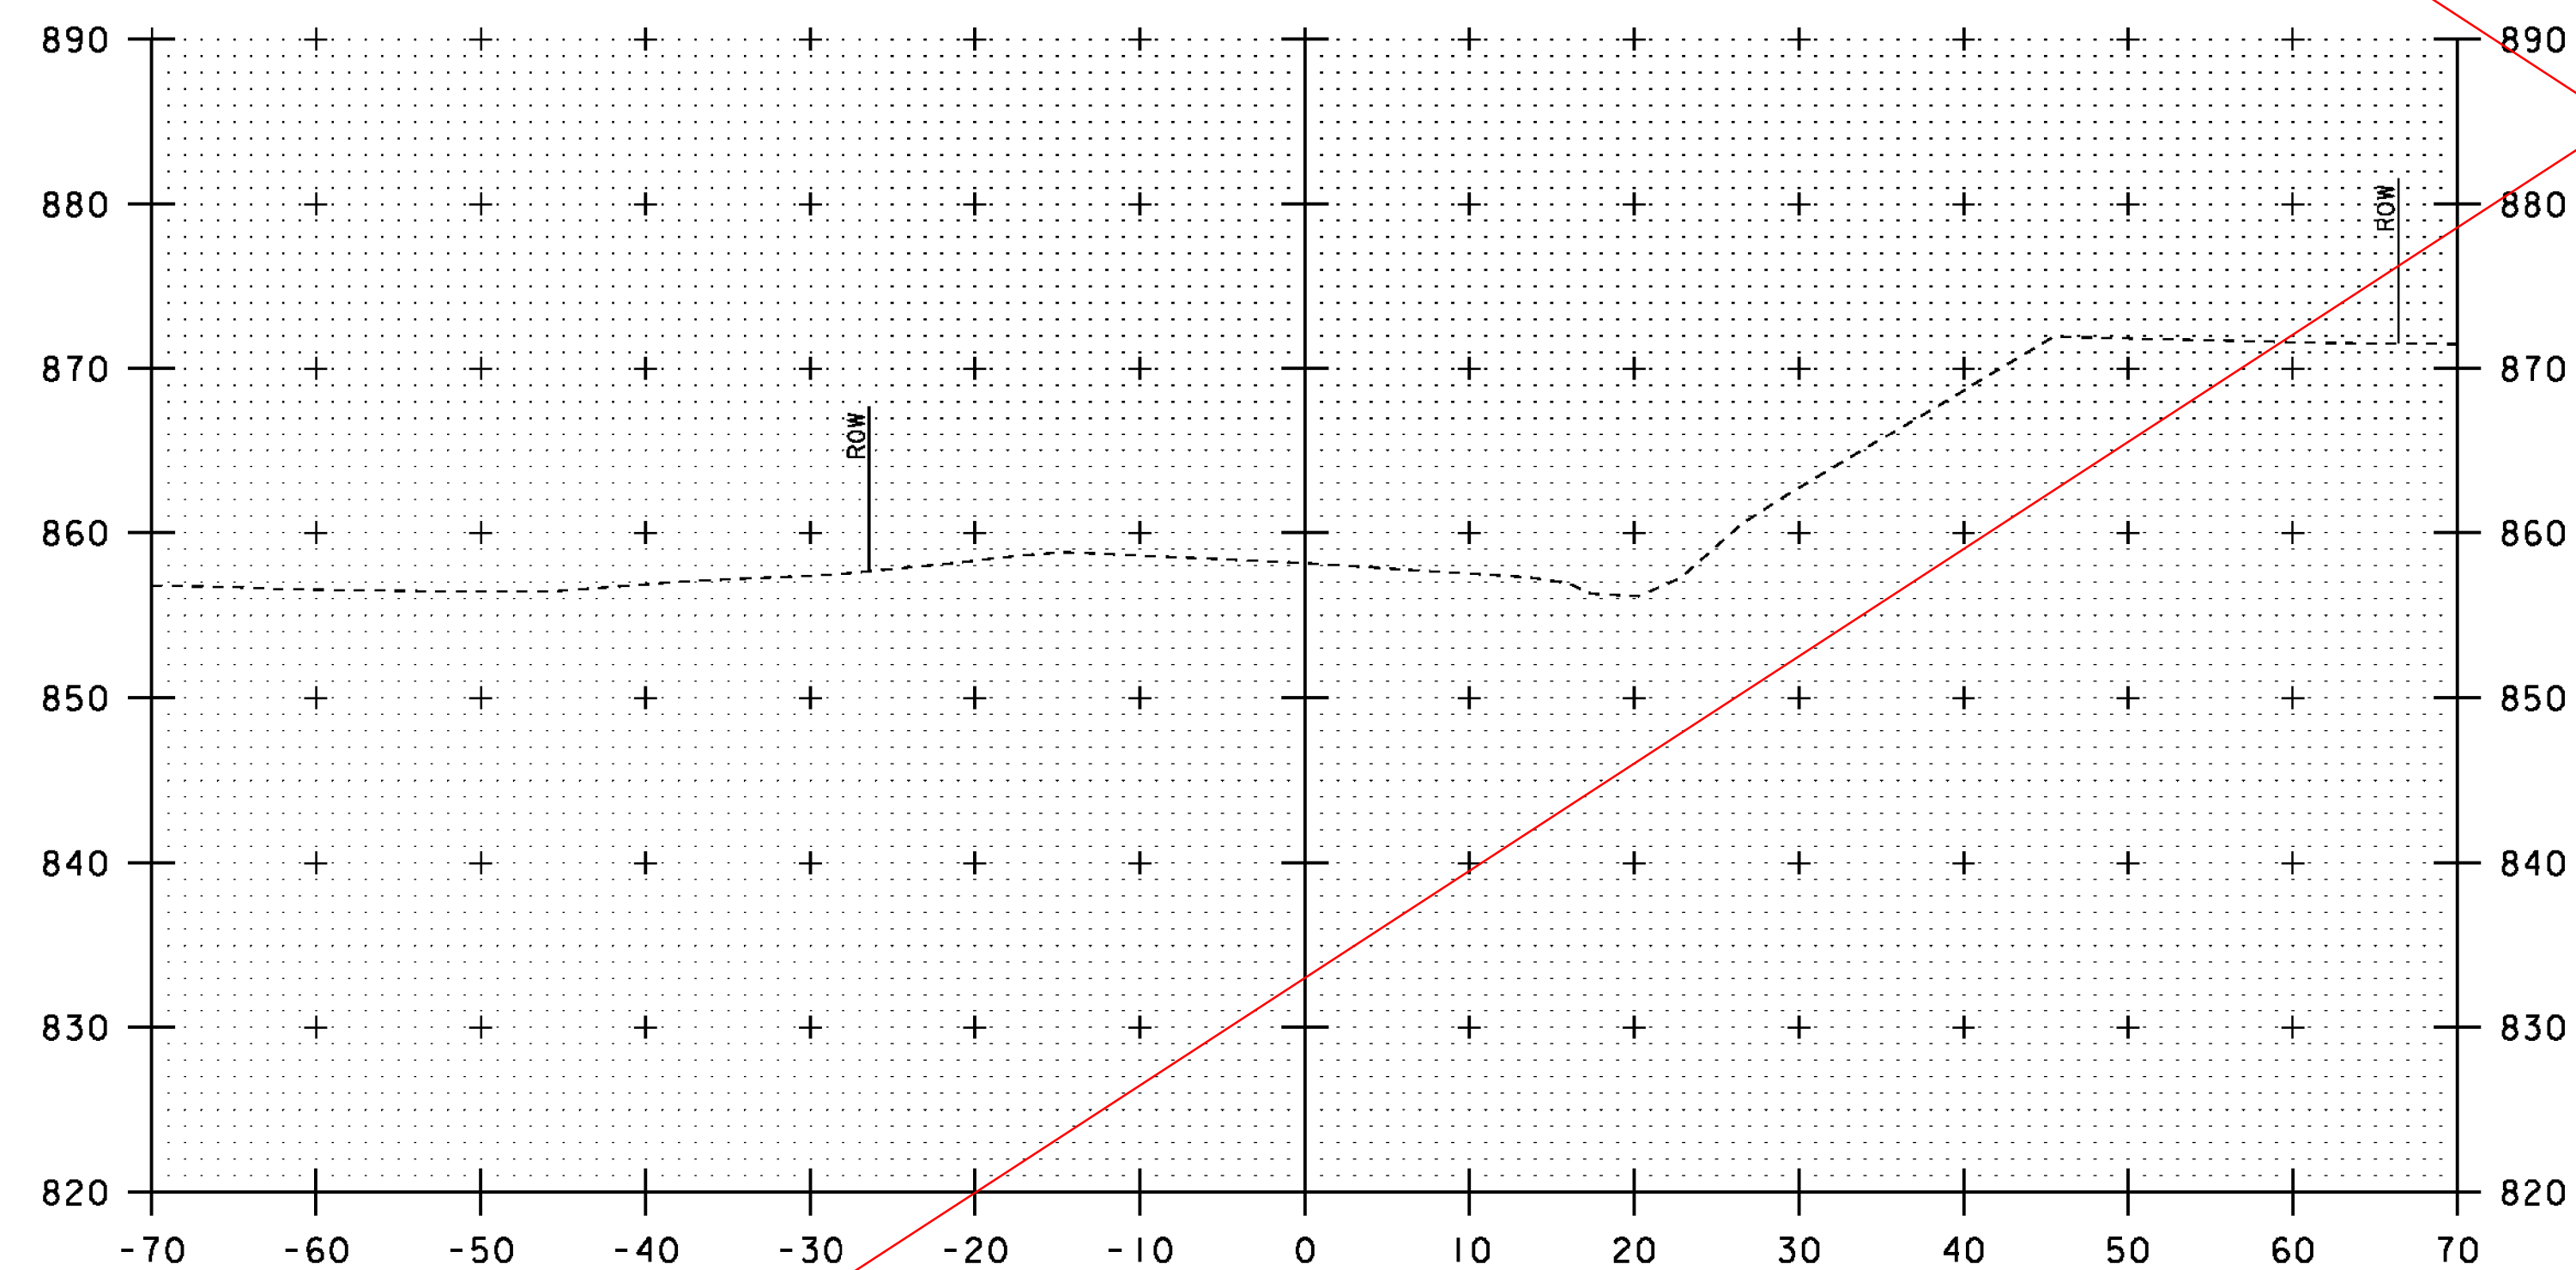

257+75

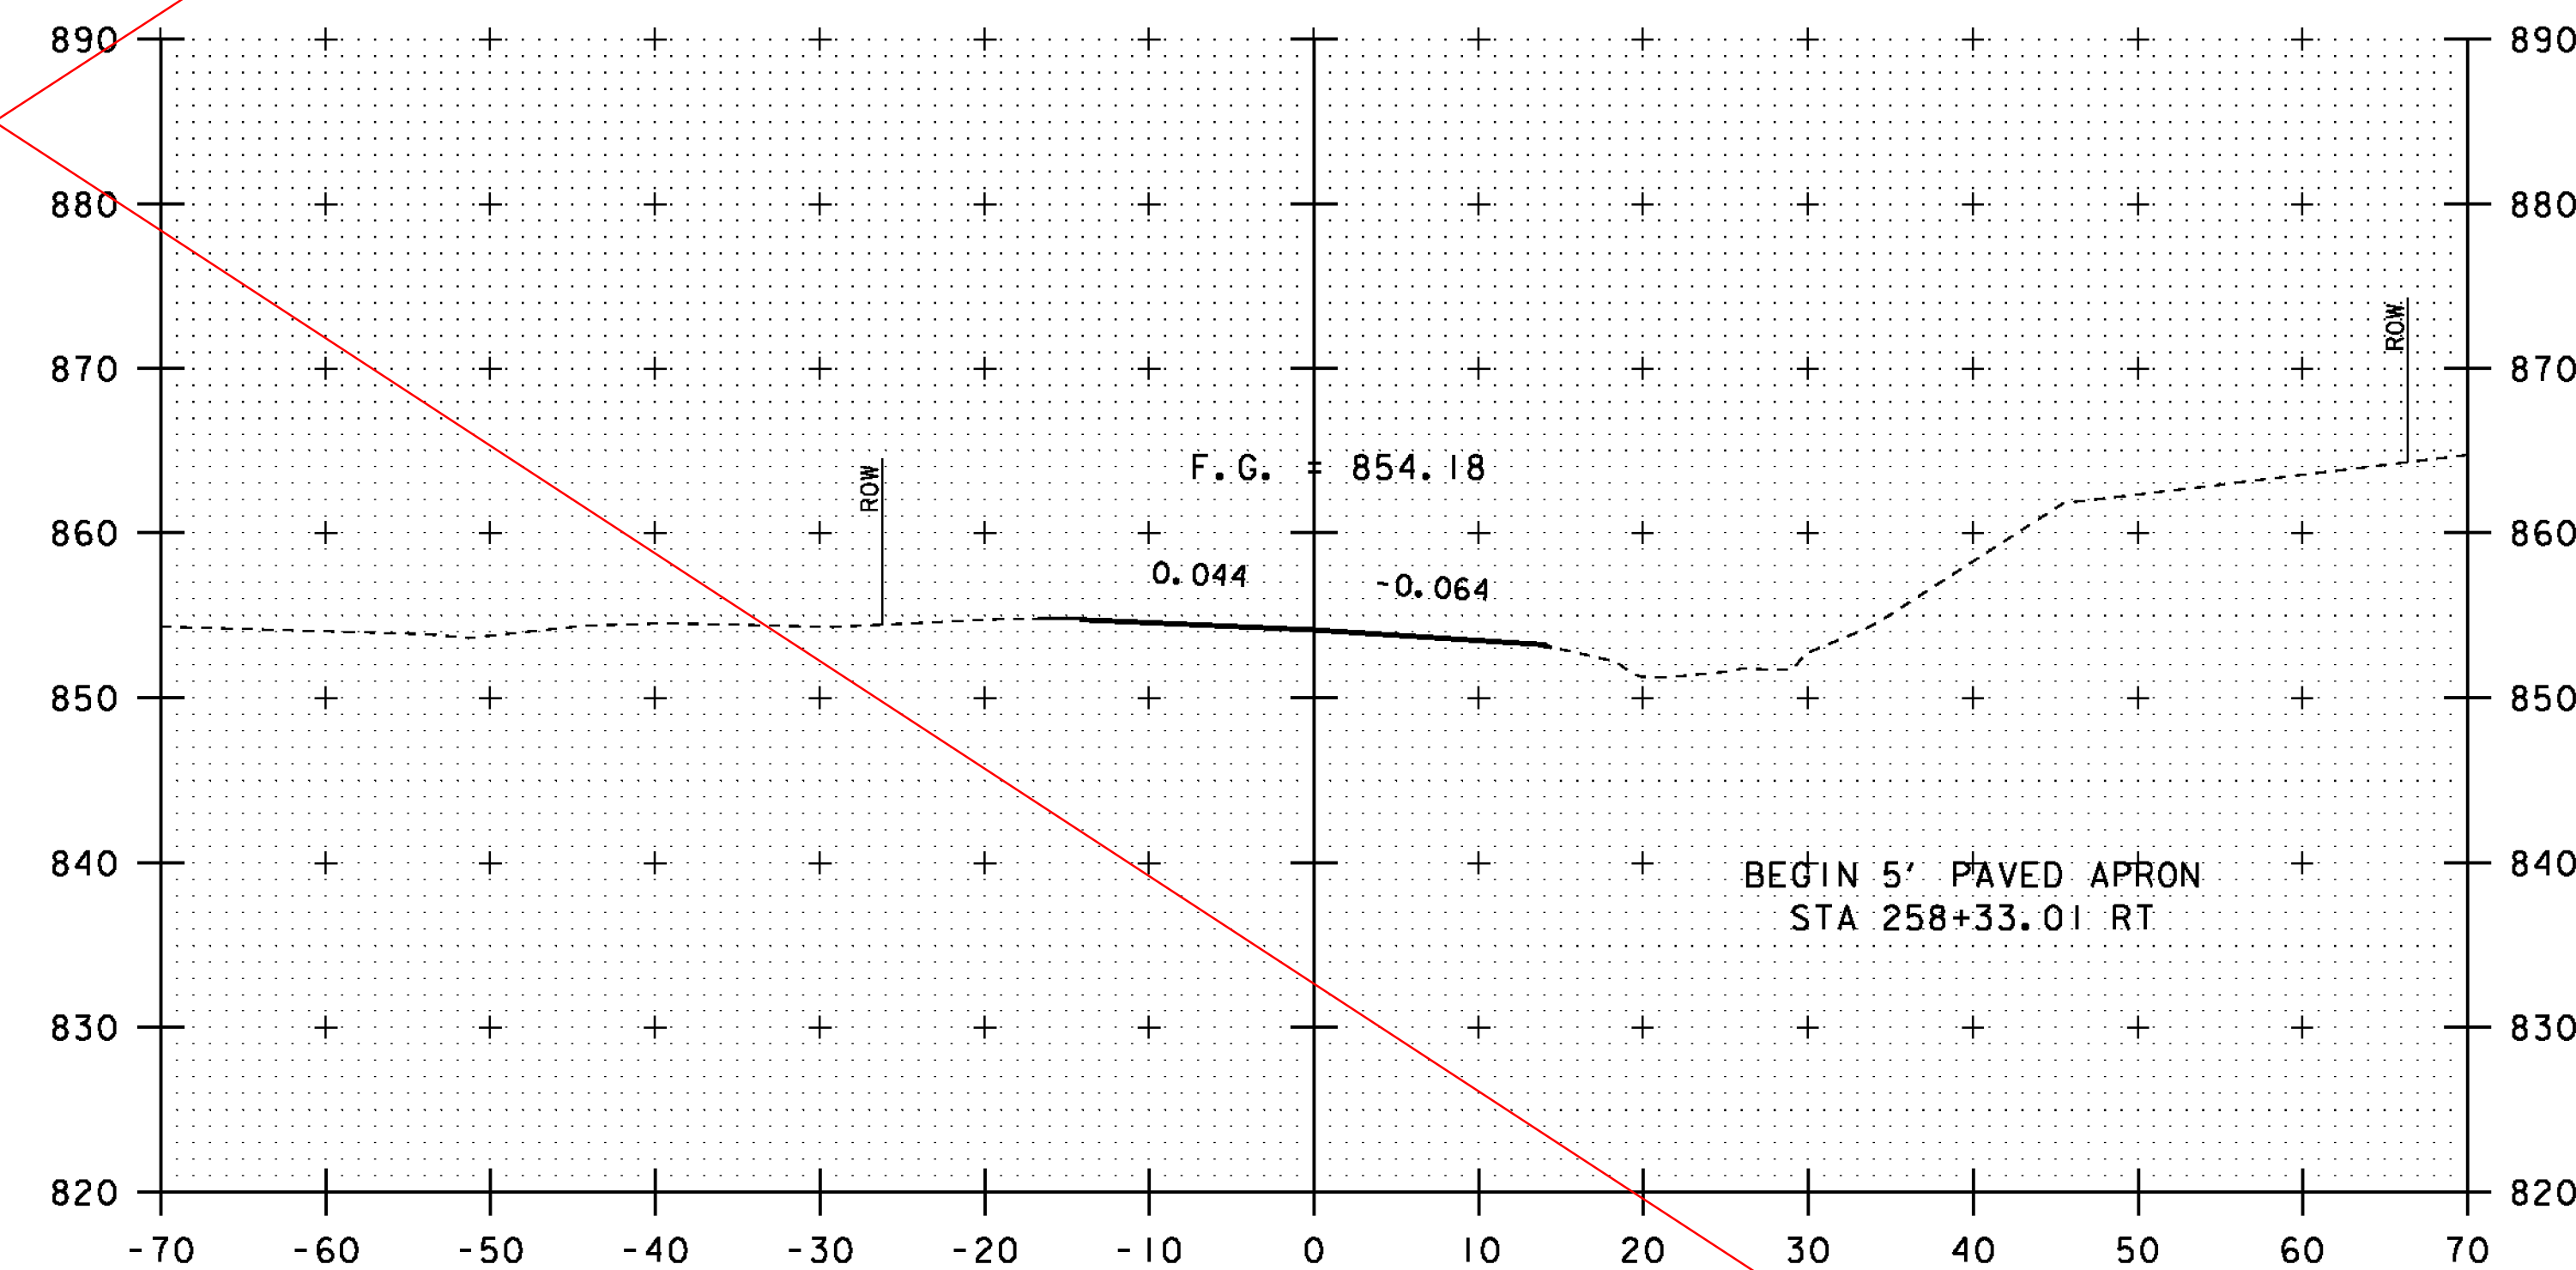

258+25

BEGIN 5' PAVED APRON
STA 258+33.01 RT

NOTE: SEE REVISED SHEET
DATED 26-OCT-2011
FOR POST IRENE REVISIONS

10 0 10
SCALE: 1" = 10'-0"

STA. 257+75 TO STA. 258+50

PROJECT NAME: PITTSFIELD-STOCKBRIDGE
PROJECT NUMBER: STP 022-1(22)S

FILE NAME: s00b122xsl.dgn
PROJECT LEADER: C. P. WILLIAMS
DESIGNED BY: G. ROY
VT 100 CROSS SECTIONS (1)

PLOT DATE: 02-SEP-2011
DRAWN BY: G. ROY
CHECKED BY: R. YOUNG
SHEET 34 OF 41