



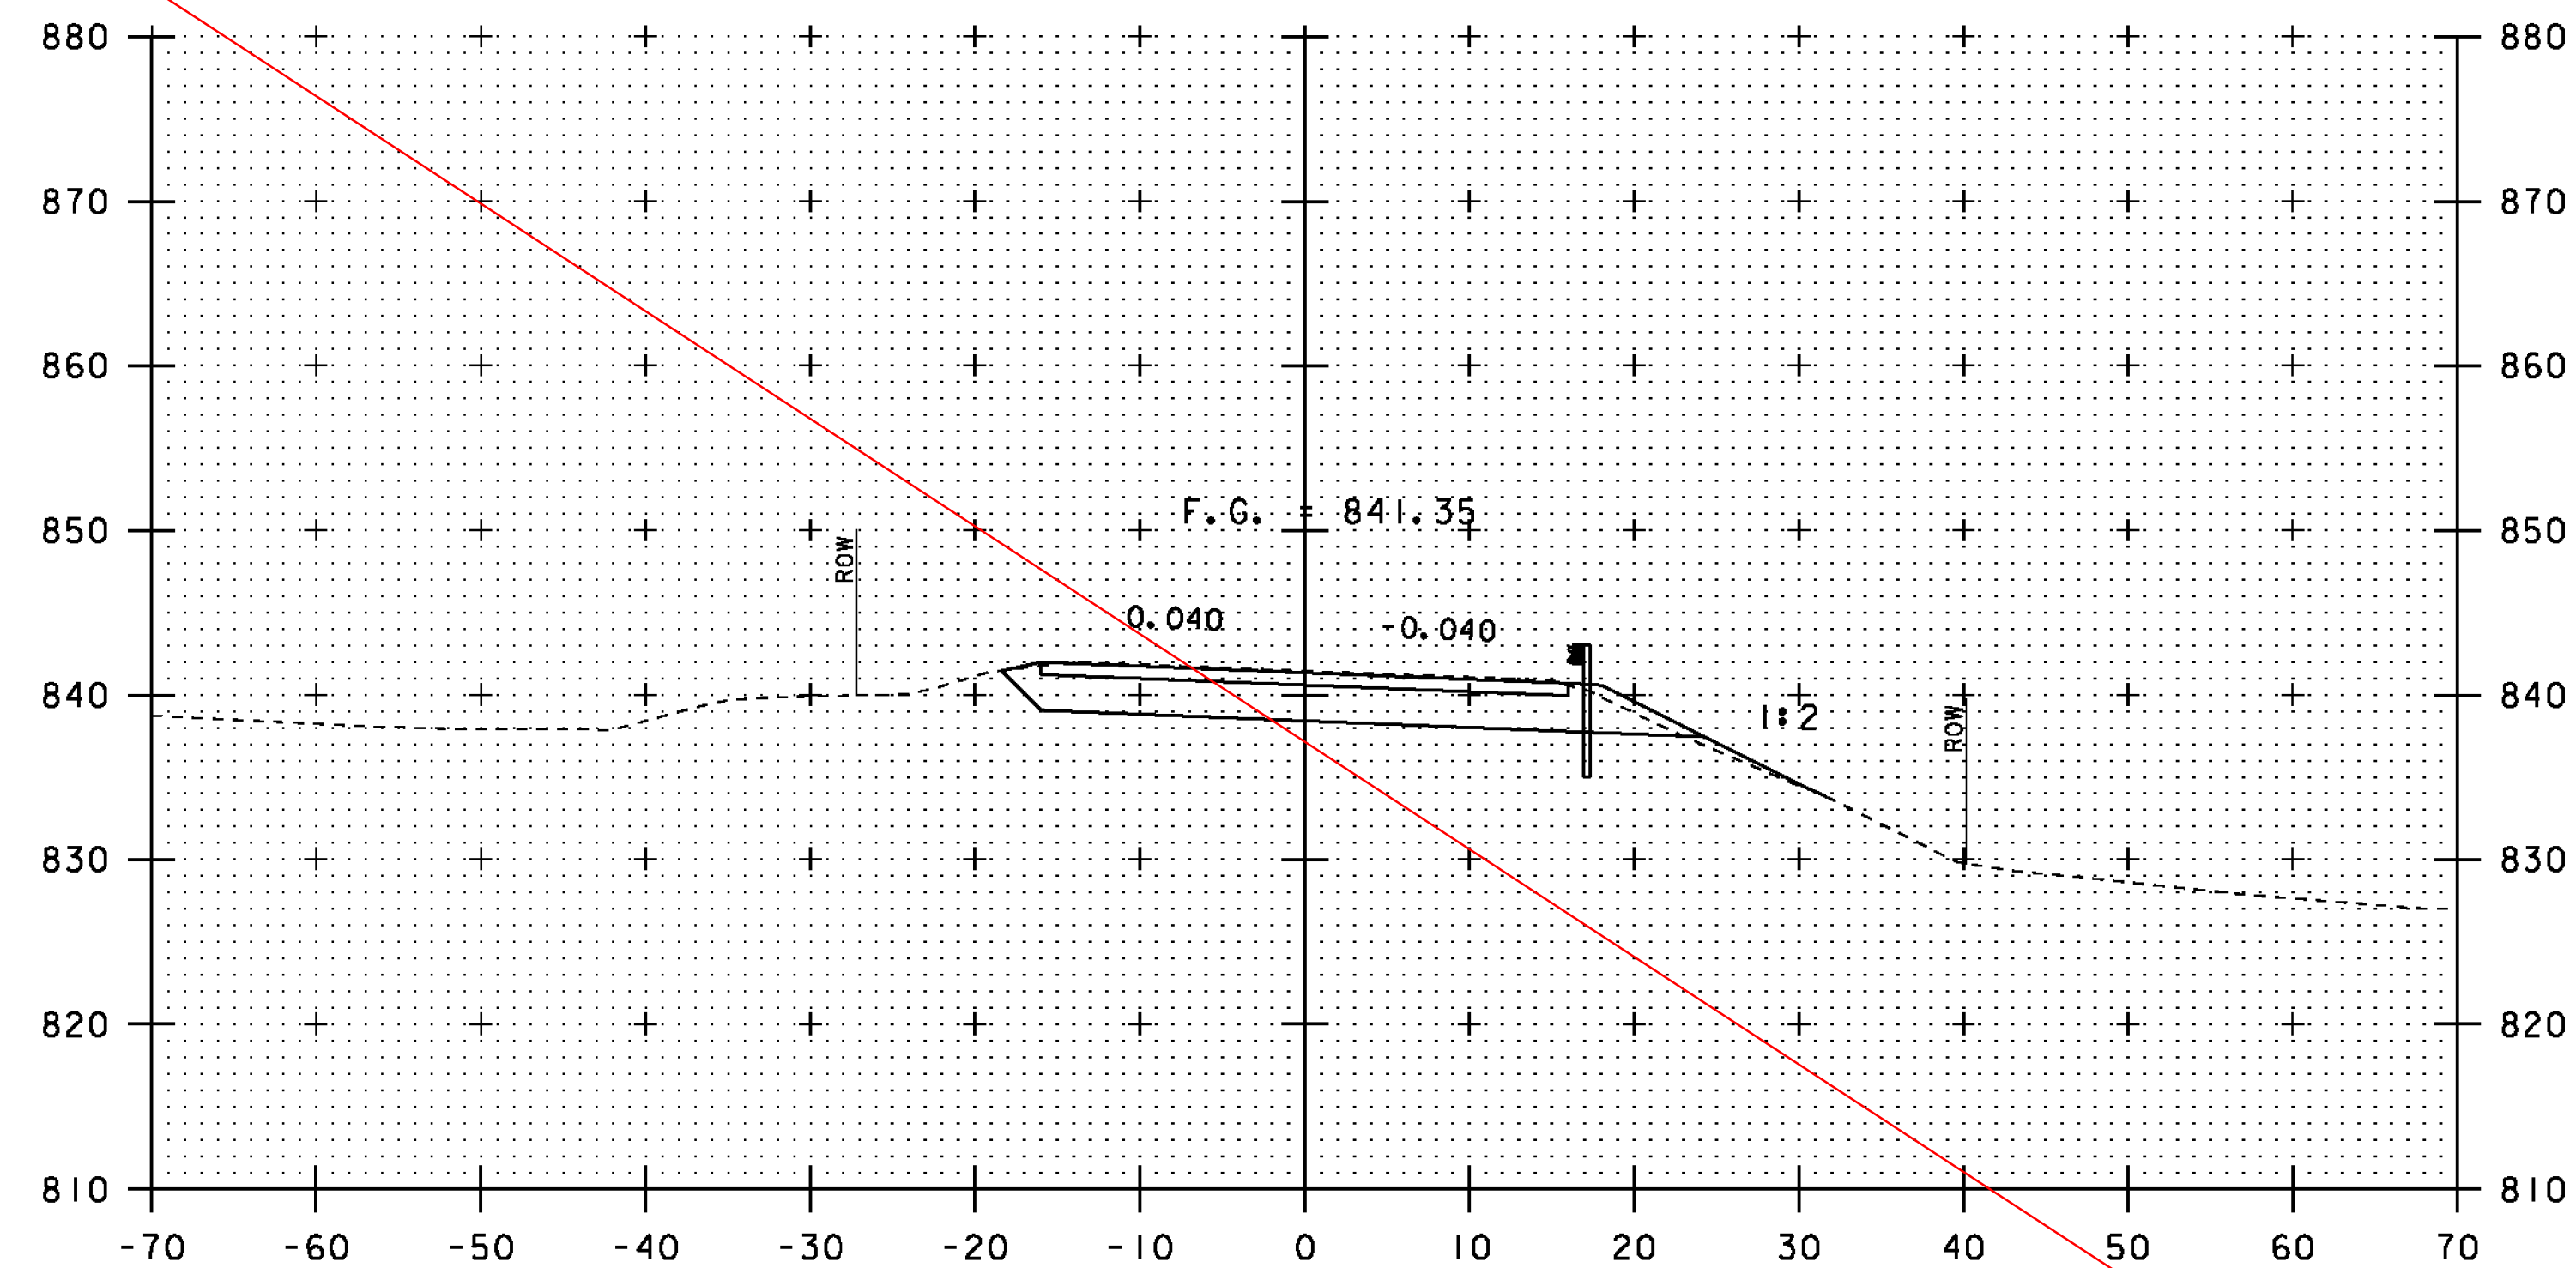


261+00


END PROJECT
BEGIN APPROACH
STA 261+00.00

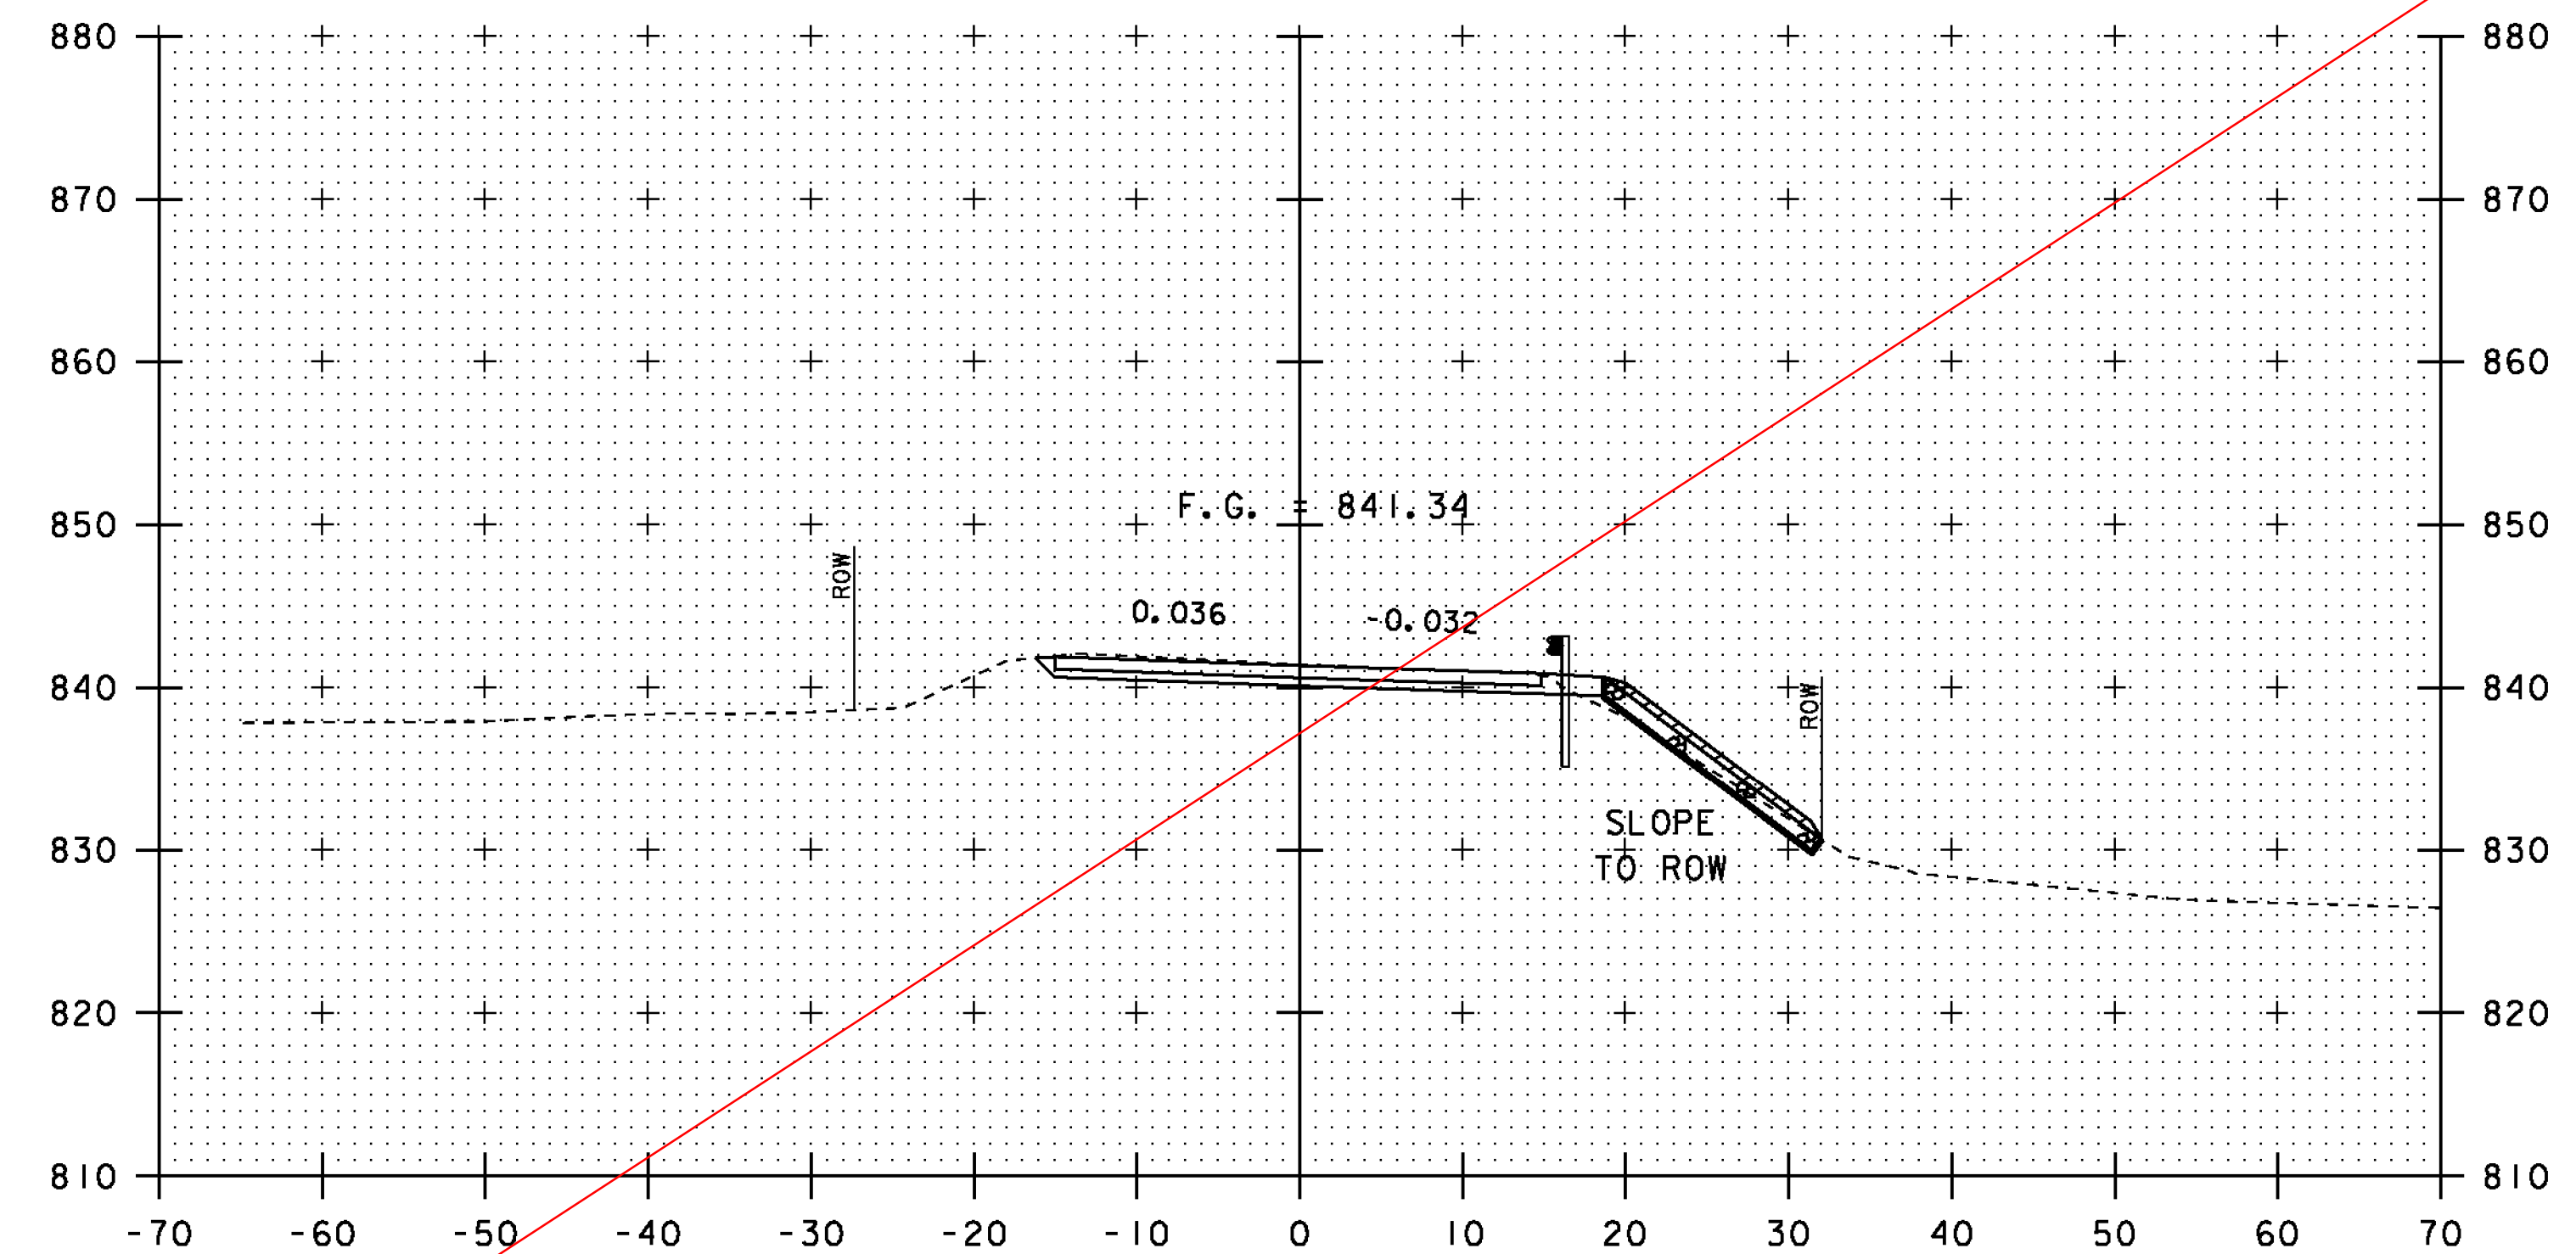

261+50

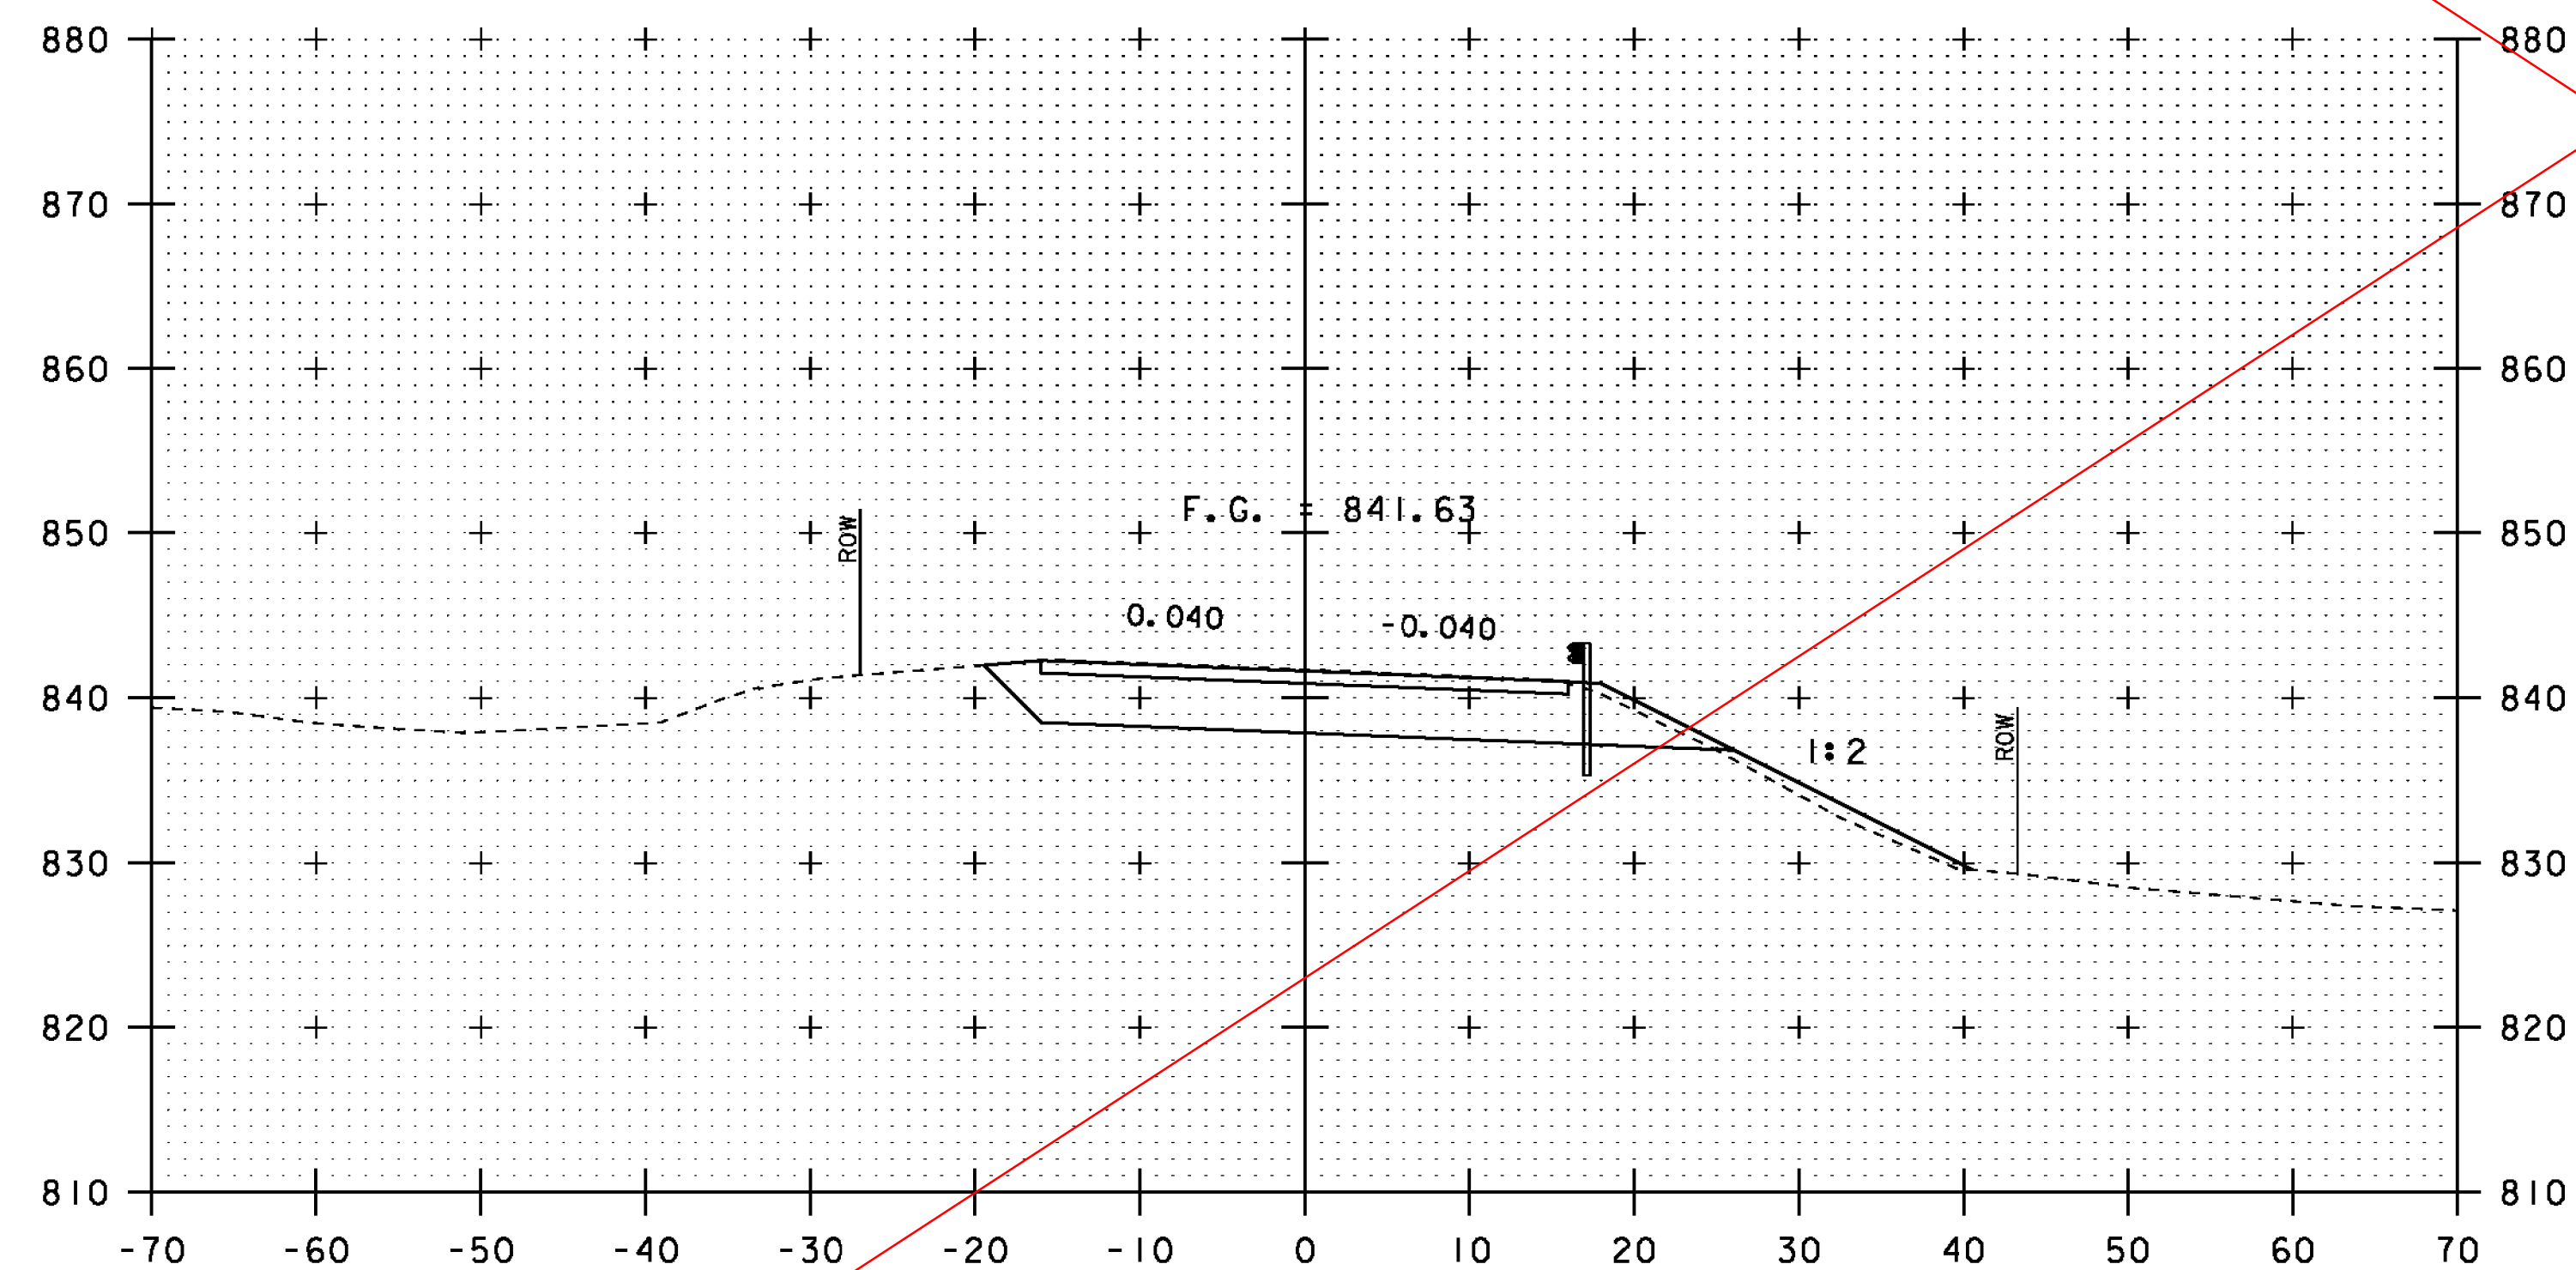

260+75

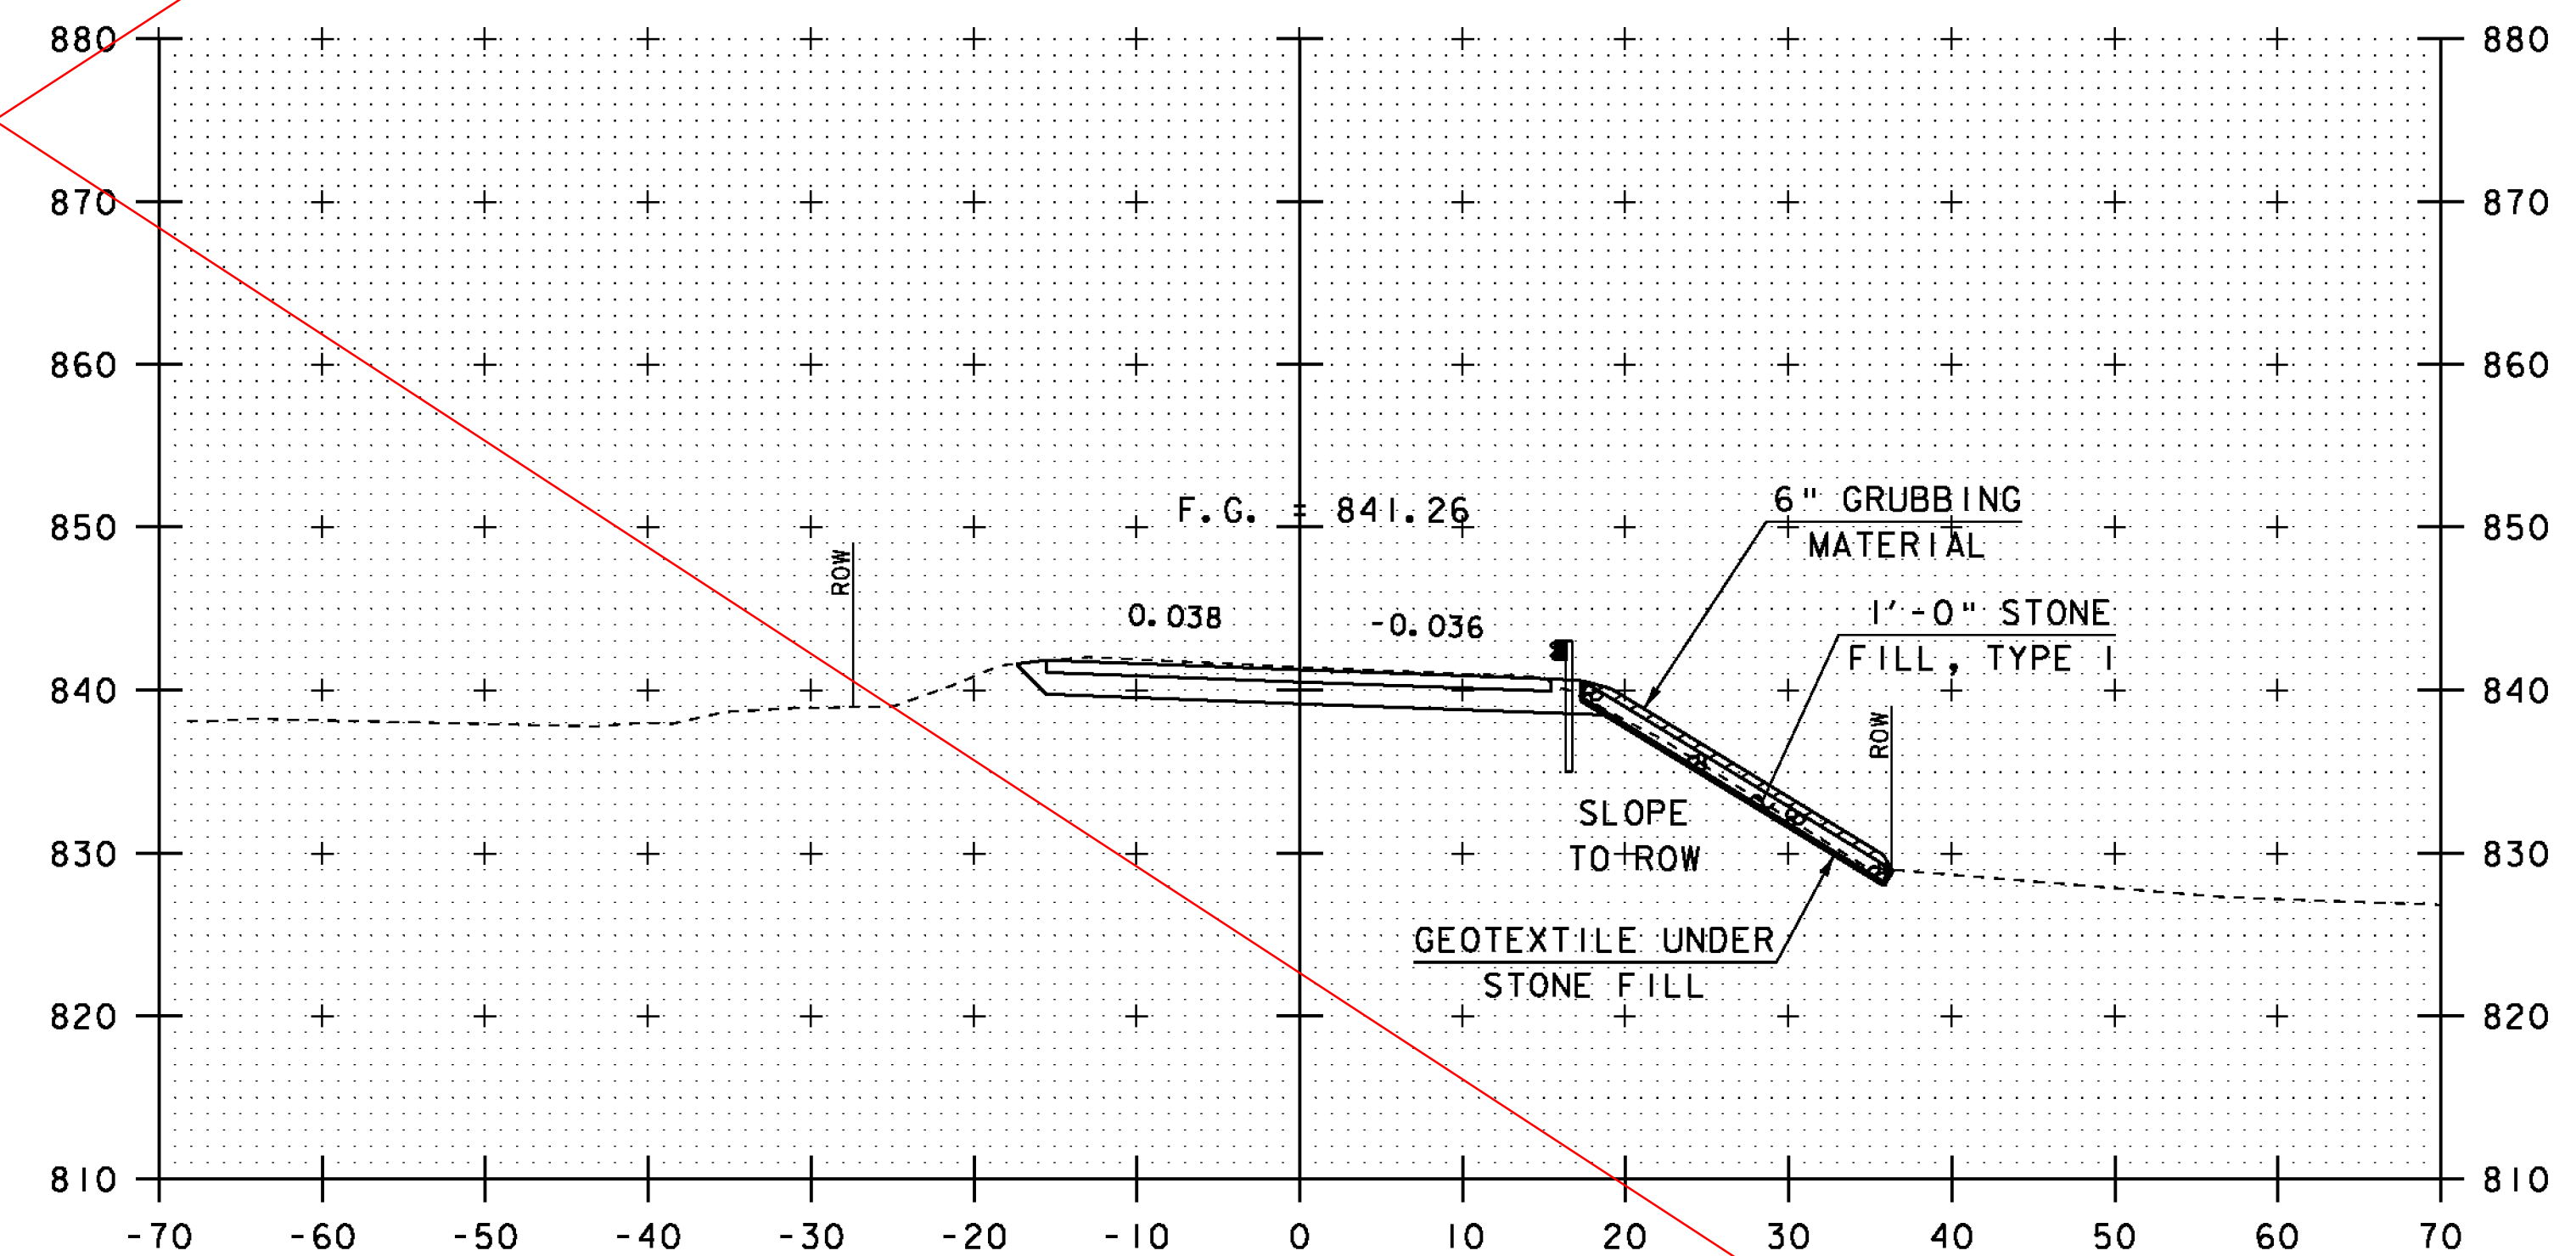

261+25

STA 261+25.0 RT
BEGIN GEOTEXTILE UNDER STONE FILL
STONE FILL, TYPE I
GRUBBING MATERIAL

NOTE: SEE REVISED SHEET
DATED 26-OCT-2011
FOR POST IRENE REVISIONS

10 0 10
SCALE: 1" = 10'-0"

STA. 260+75 TO STA. 261+50

PROJECT NAME: PITTSFIELD-STOCKBRIDGE	
PROJECT NUMBER: STP 022-1(22)S	
FILE NAME: s00b122xsl.dgn	PLOT DATE: 02-SEP-2011
PROJECT LEADER: C. P. WILLIAMS	DRAWN BY: G. ROY
DESIGNED BY: G. ROY	CHECKED BY: R. YOUNG
VT 100 CROSS SECTIONS (4)	SHEET 37 OF 41