

THIS IS STATIONING FOR TYPE I STONE FILL  
@ DITCH ALONG NO. MAIN STREET - SHEET #8  
CONSTRUCT DITCH WITH STONE FILL, TYPE II

CONCRETE FACE EXISTING METAL BIN RETAINING WALL

14+00.0 LT. - 16+75.0 LT.

### CONSTRUCT REINFORCED CONCRETE RETAINING WALL

16+75.0 LT. - 16+94.3 LT.

CONCRETE FACE EXISTING CONCRETE RETAINING WALL

16+94.3 LT. - 17+27.1 LT.

CONSTRUCT REINFORCED CONCRETE STEPS -SEE DETAIL-  
SHEET #21

17+27.1 LT. - 17+32.5 LT.

CONSTRUCT 10' PAVED APRON

20+25 RT.

COLD PLANING - BIT. CONC. PAVEMENT

14+00.0 LT. - 17+77.5 LT.

20+23.0 - 24+00.0

### REMOVAL OF EXISTING RAILING

20+54.6 LT. - 20+79.4 LT.

METAL HAND RAILING -SEE DETAIL-SHEET #51

20+54.6 LT. - 20+79.4 LT.

## REMOVING AND RESETTING CURB

14+00.0 LT. - 17+31.1 LT.

17+54.7 RT. - 17+63.8 RT.  
17+77.5 LT. - 17+88.5 LT.

17+77.5 LI. - 17+92.5 LI.  
17+77.5 RT. - 17+92.5 RT.

20+55.7 LT. - 23+53.7 LT.

PORTLAND CEMENT CONCRETE SIDEWALK, 5 INCH

14+00.0 LT. - 17+32.4 LT.

17+54.7 RT. - 17+63.8 RT.

17+77.5 LT. - 17+92.5 LT.

17+77.5 RI. - 17+92.5 RI.  
20+54.2 LT. - 23+53.7 LT.

## REMOVING AND RESET GUARD RAIL

20+87.5 LT. - 23+53.7 LT.

STA. 20+30.00 RT.  
BEGIN NON-PARTICIPATION PROJECT

BEGIN NON-PARTICIPATION PROJECT

STA. 20+13.56  
BEGIN PARTICIPATION PROJECT

BEGIN PARTICIPATION PROJECT

STA. 17+77.50 LT.  
END PARTICIPATION PROJECT

END PARTICIPATION PROJECT

LAYOUT SHEET (2)

|               |             |
|---------------|-------------|
| PROJECT NAME: | SPRINGFIELD |
|---------------|-------------|

PROJECT NUMBER: STP 016-2 (10)S

FILE NAME: 00b124\Structures\sbl24102.i

PROJECT MANAGER: R. WHITCROFT


DESIGNED BY: G. ROY

PLOT DATE: 17-AUG-2004

DRAWN BY: G. ROY

CHECKED BY: R. WHITCOMB

SHEET 12 OF 72

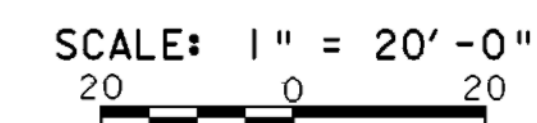

LAYOUT SHEET (2)