
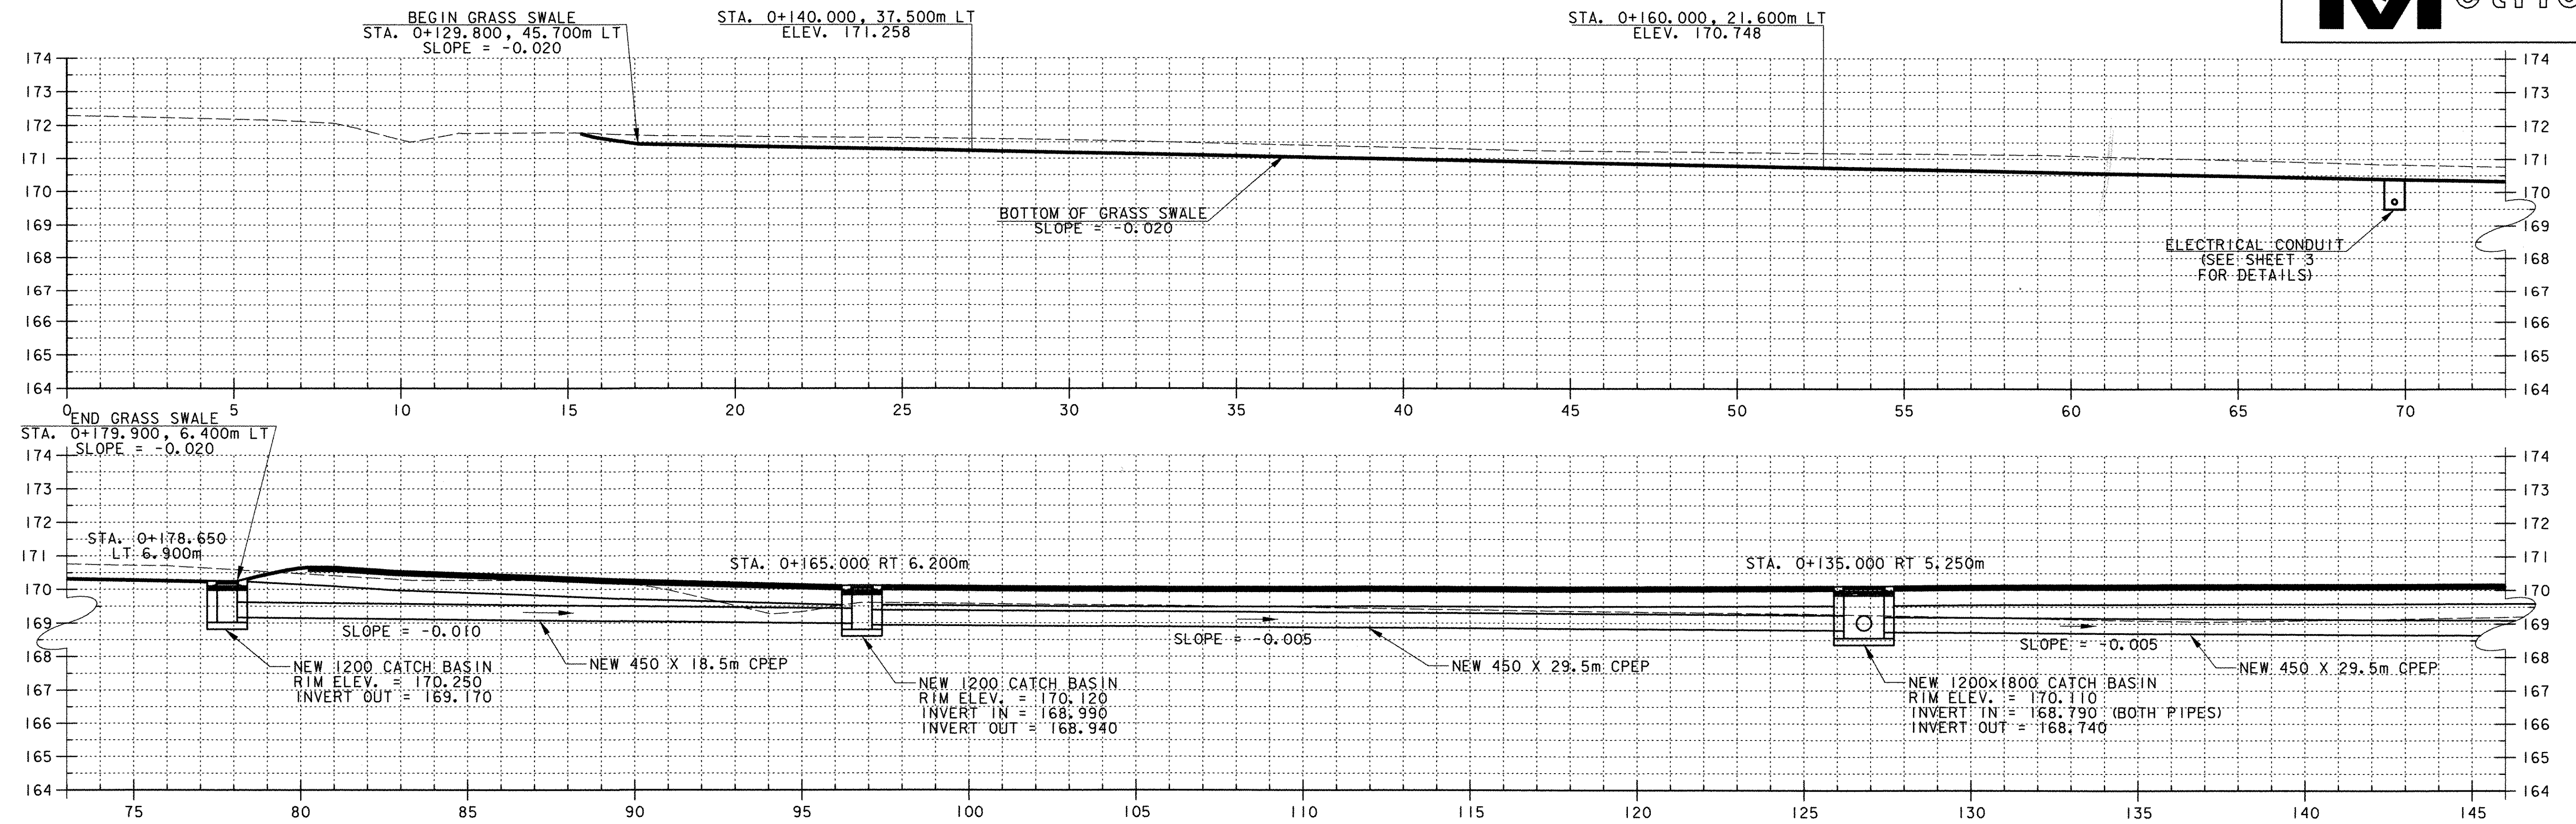
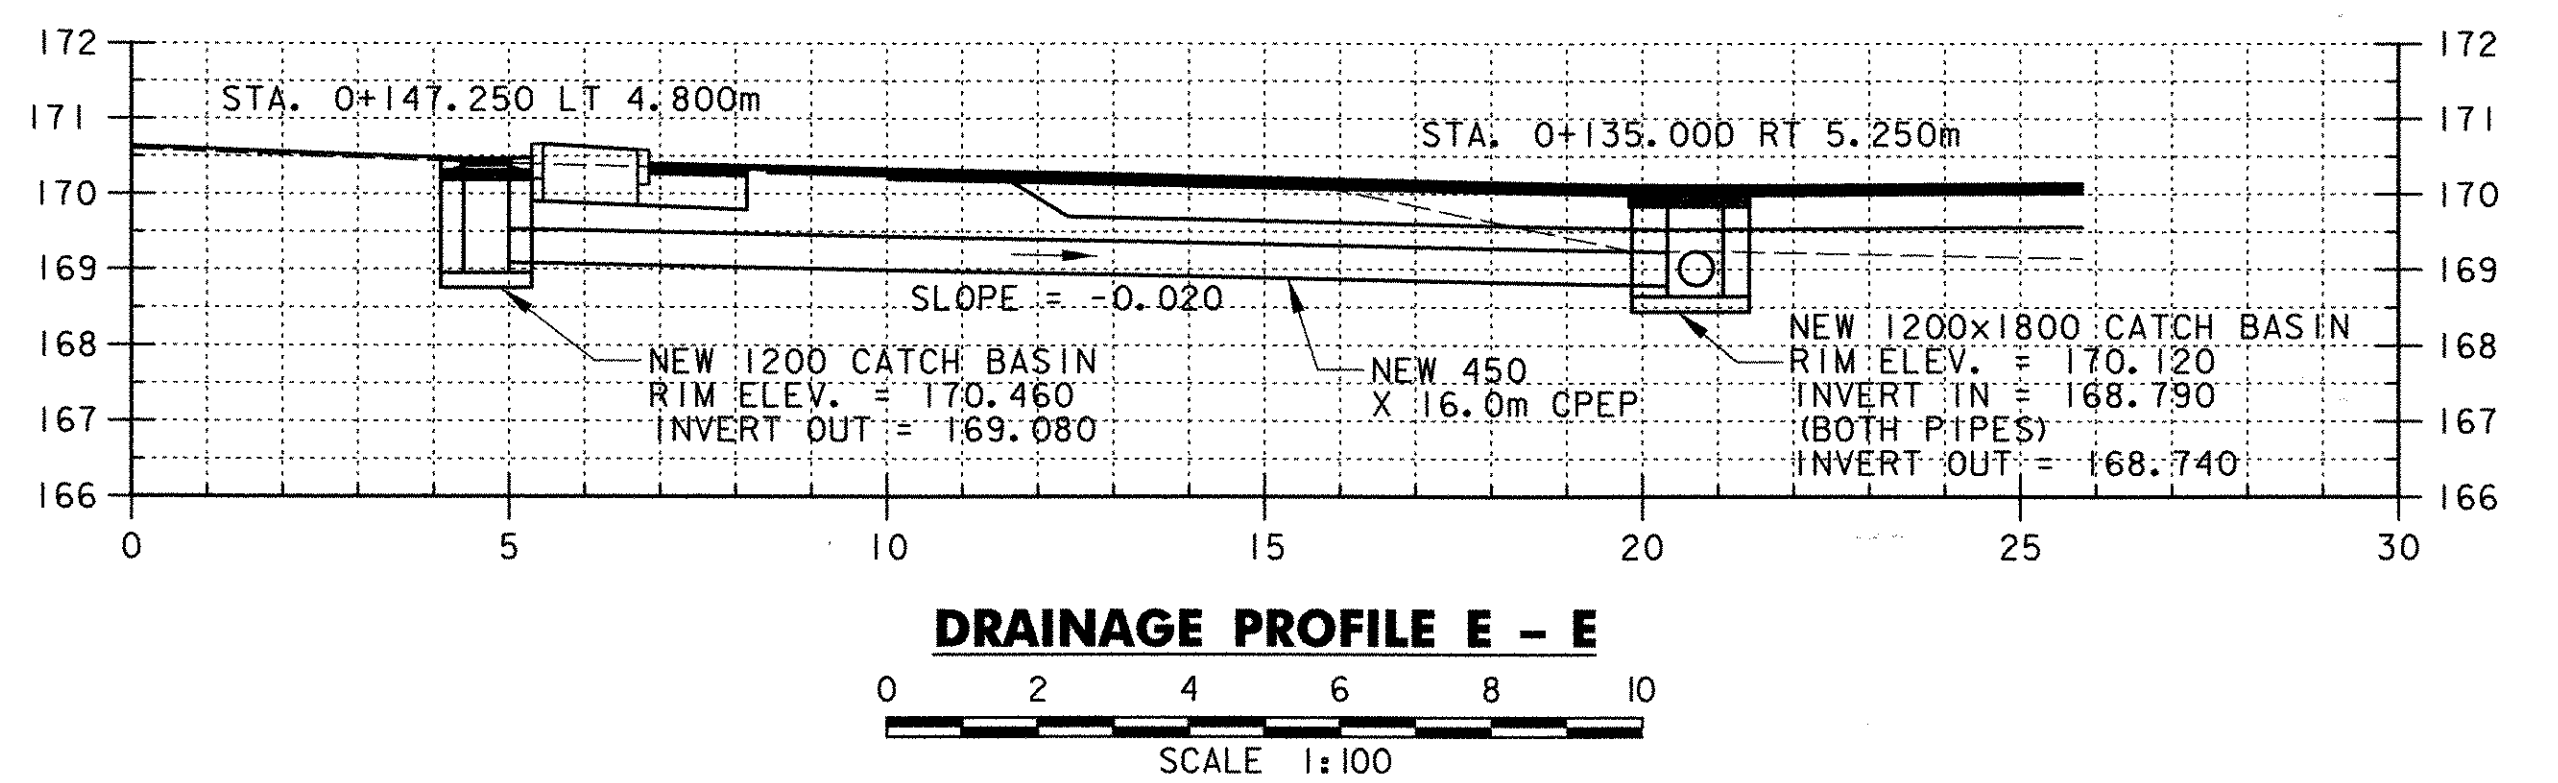


DRAINAGE PROFILE D - D

0 2 4 6 8 10

SCALE 1:100

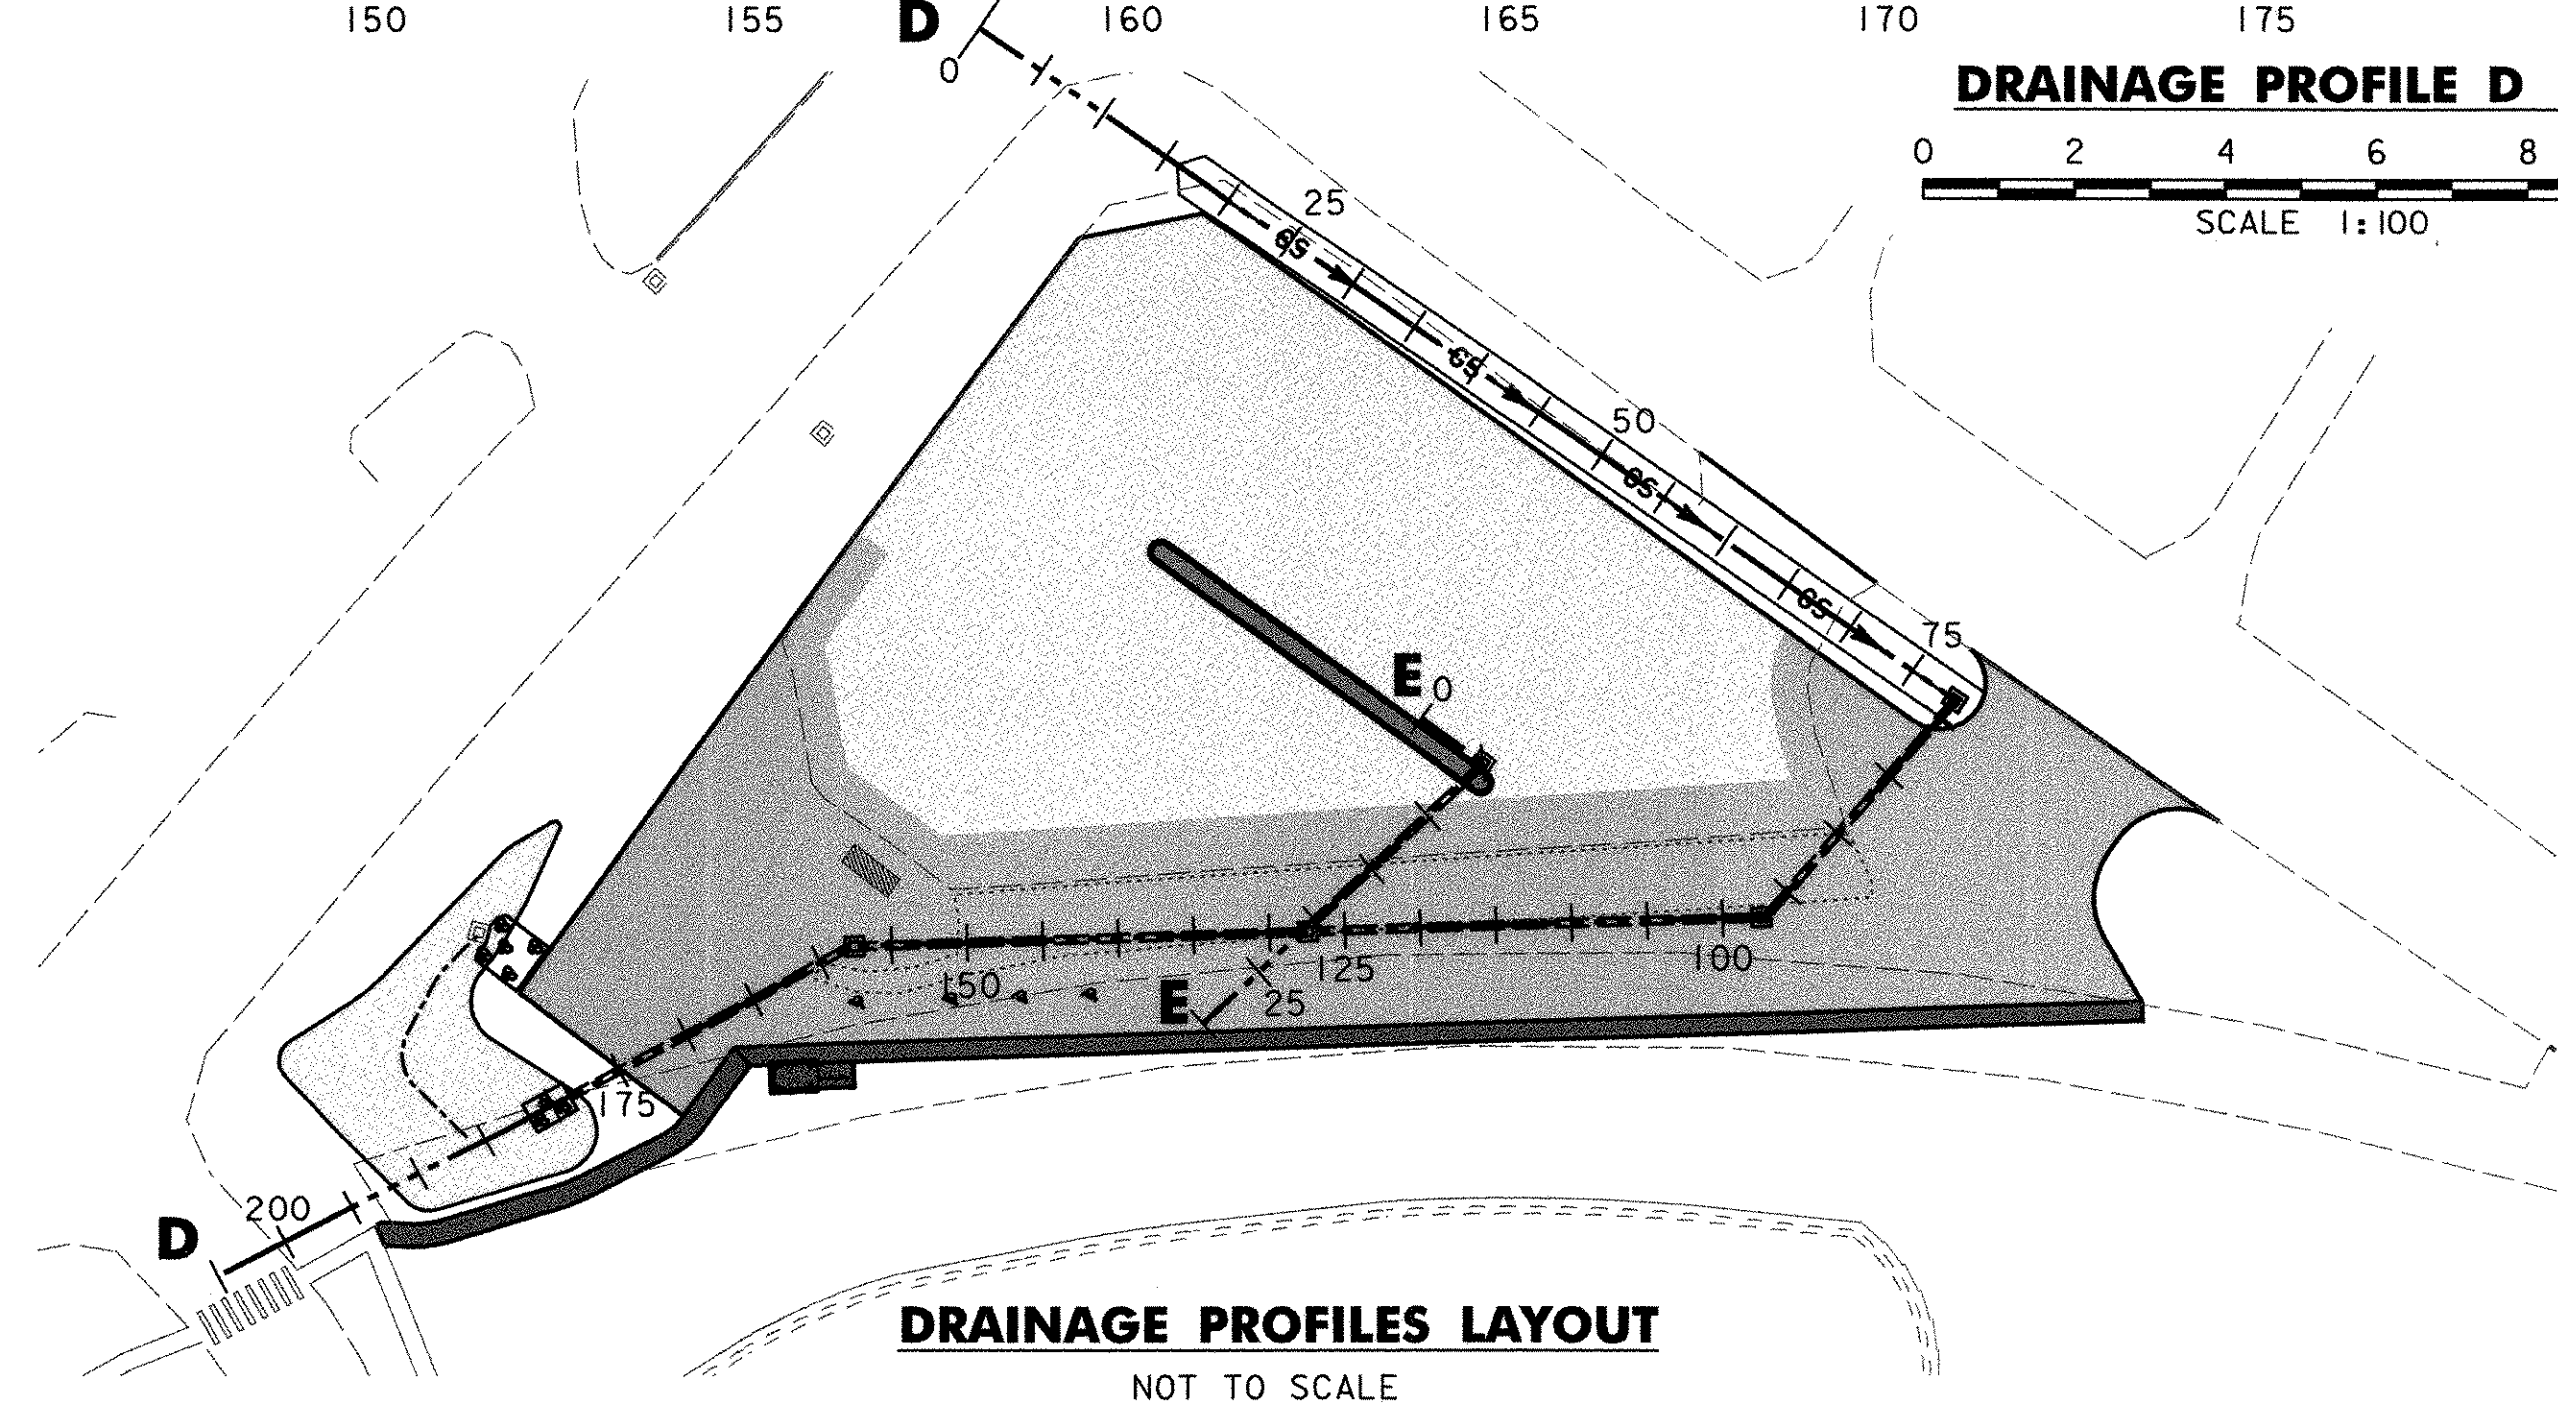

DRAINAGE PROFILE E - E

0 2 4 6 8 10

SCALE 1:100

DATUM

VERTICAL NAVD 88

HORIZONTAL NAD 83

PROJECT NAME: ST. ALBANS PARK & RIDE

PROJECT NUMBER: CMG PARK (23)S

FILE NAME:

PROJECT LEADER: JWT

DESIGNED BY: PGJ

DRAINAGE PROFILES

PLOT DATE: 10/14/2005

DRAWN BY: PGJ

CHECKED BY: EPD

SHEET 29 OF 29