




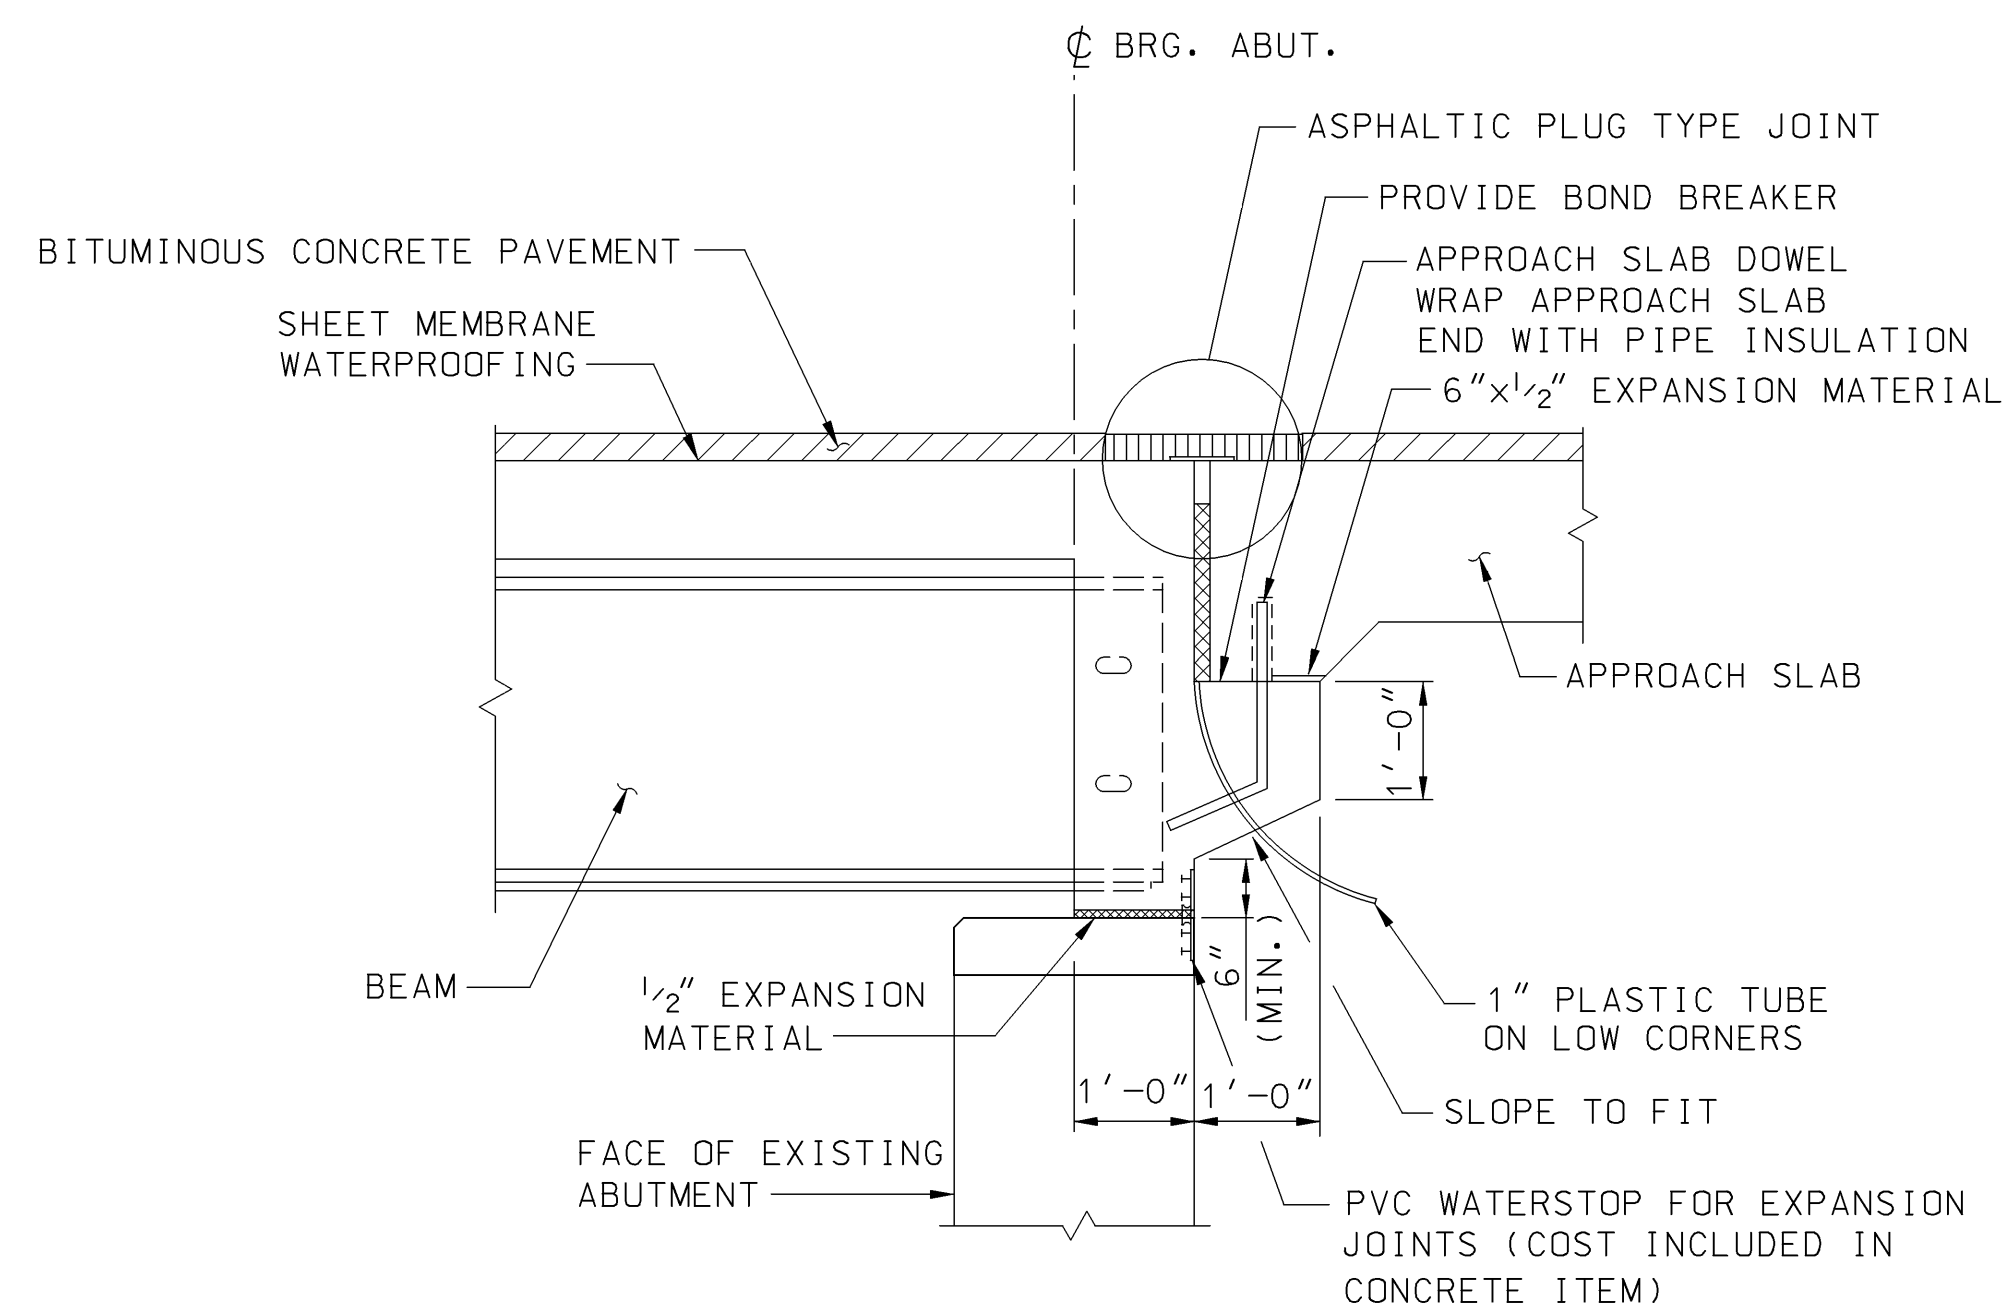


CURTAIN WALL DETAIL AT ABUTMENTS
(PERPENDICULAR TO CENTERLINE BEARING)
NOT TO SCALE

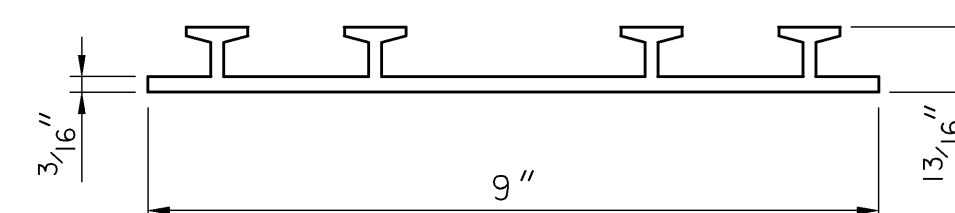


P.V.C. WATERSTOP
NOT TO SCALE

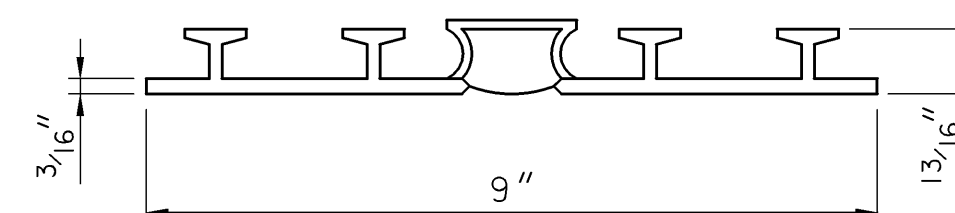

P.V.C. WATERSTOP FOR EXPANSION JOINTS
NOT TO SCALE

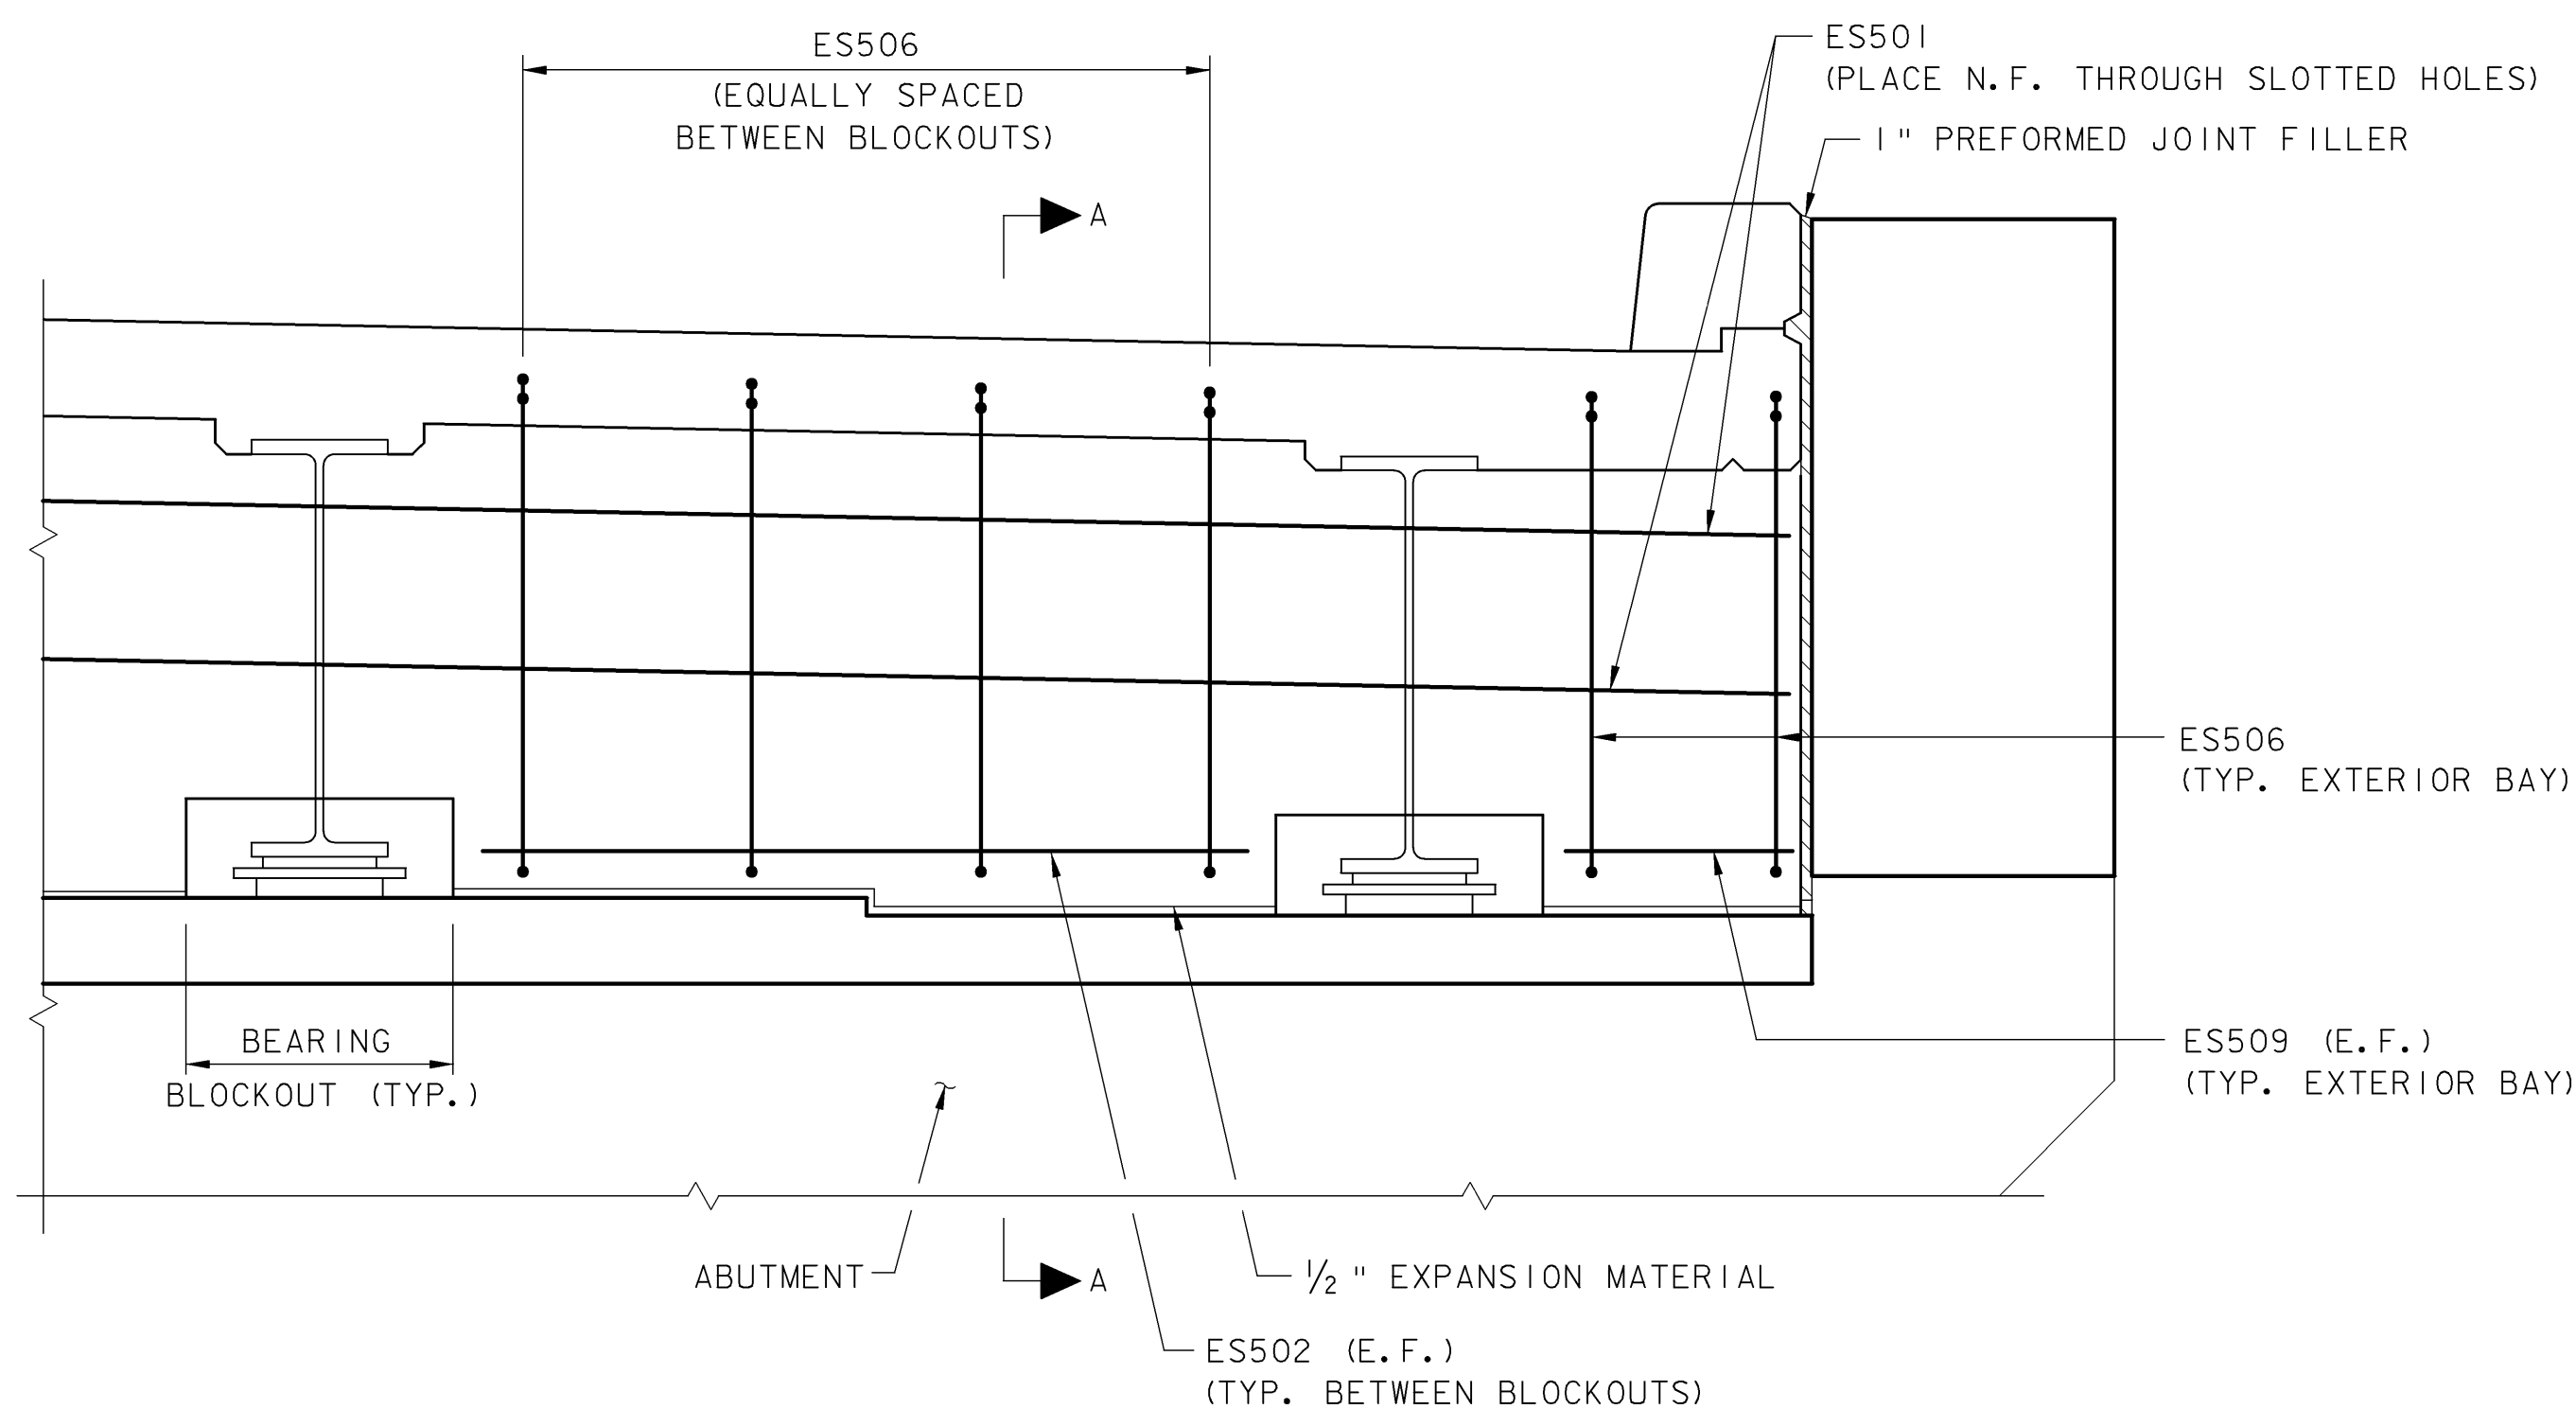

ELEVATION
(PERPENDICULAR TO CENTERLINE BEAMS)
NOT TO SCALE

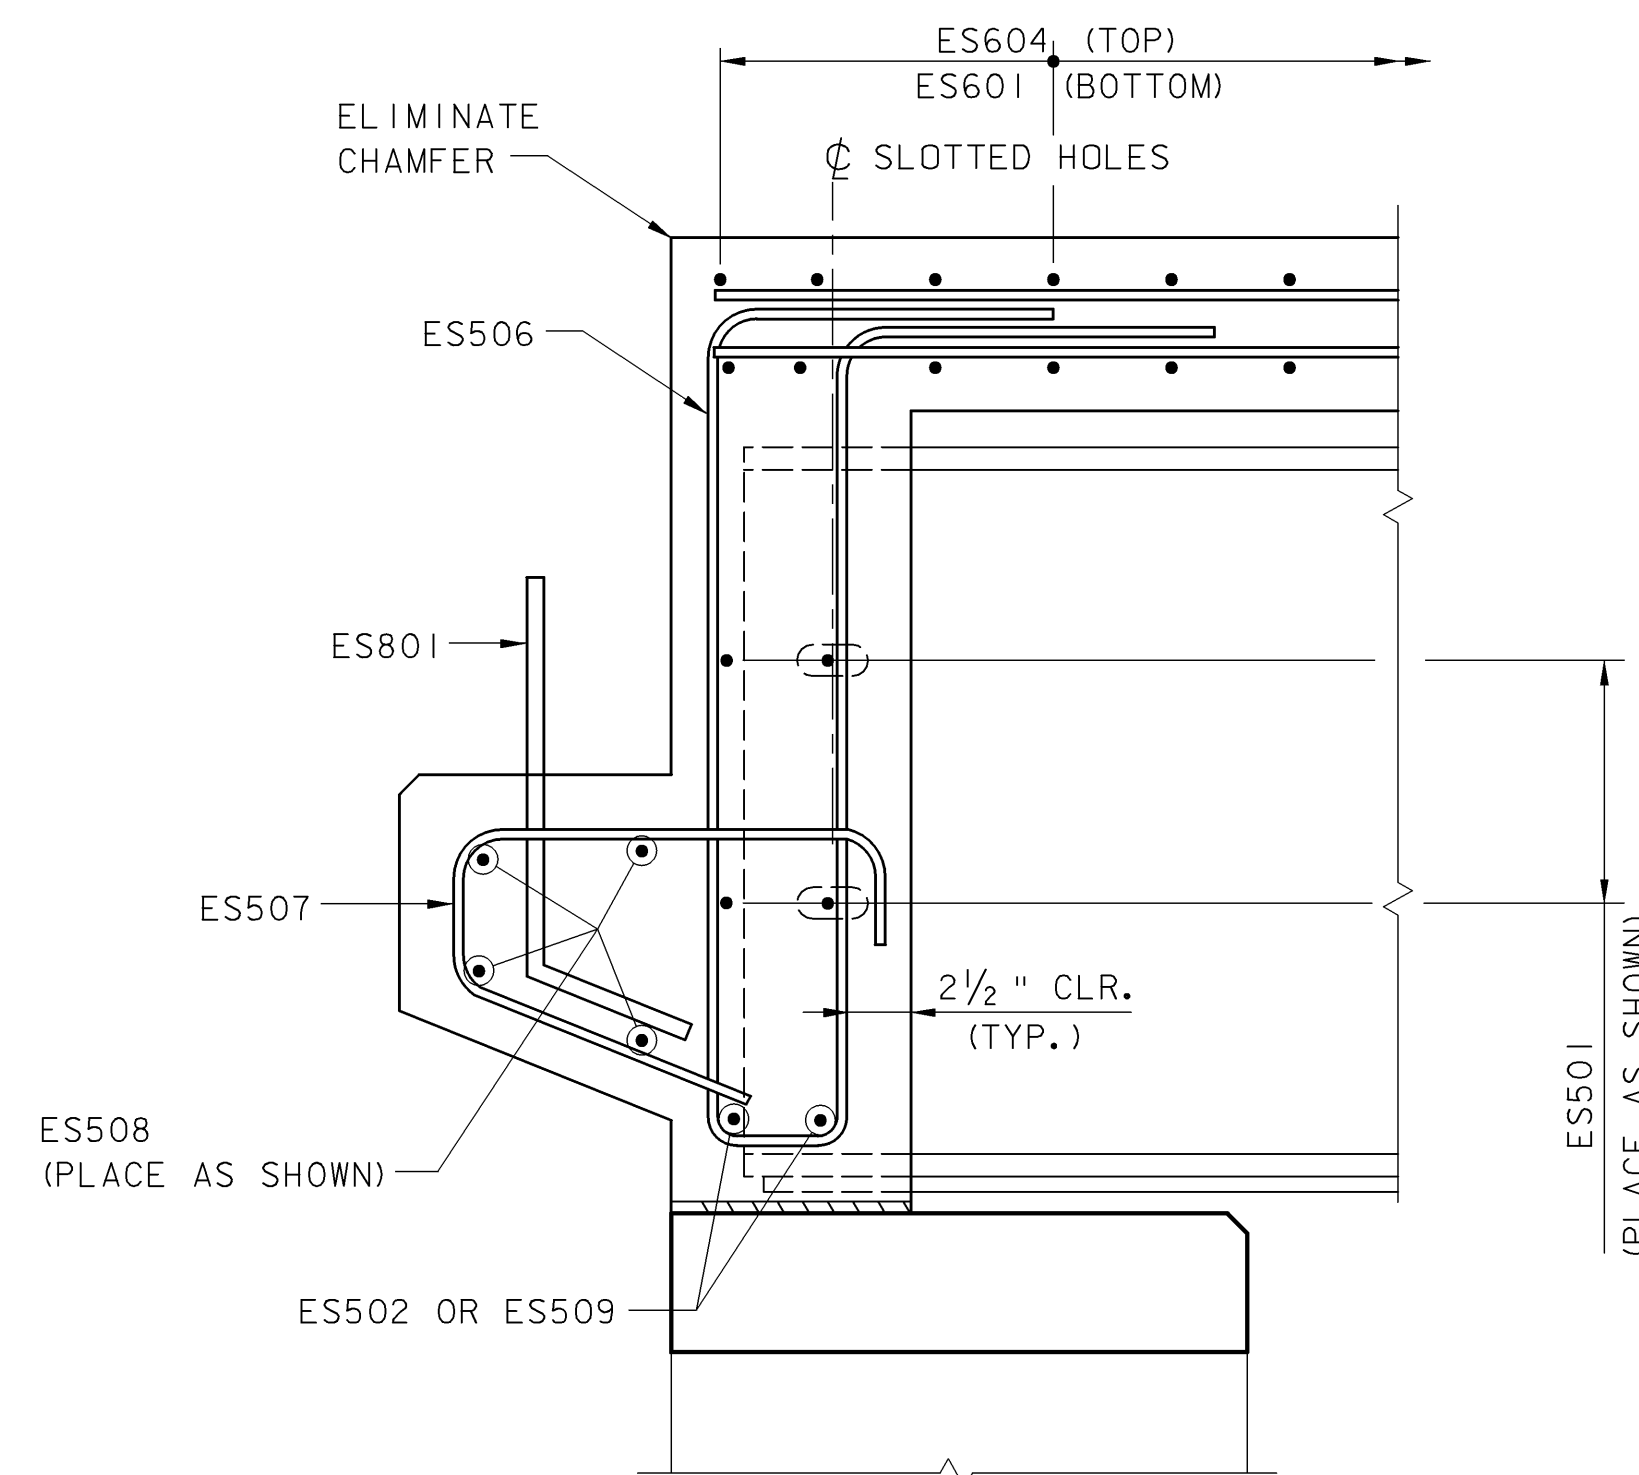

SECTION A-A
(PERPENDICULAR TO CENTERLINE BEARING)
NOT TO SCALE

THIS SHEET SUPERSEDES CONTRACT PLAN SHEET 29 DATED 6/05. REVISIONS ON THIS SHEET REFLECT CHANGES IN DESIGN AND DETAILS AS PER CHANGE ORDER NO. 2, SUBSTITUTING NEW STEEL BEAMS FOR RECYCLED BEAMS.

TOWN OF GRAFTON CAMBRIDGEPORT BRIDGE

Town Of	GRAFTON	Bridge No.	16G
Highway No.	TH 1	Log. Sta.	
		Surv. Sta.	
TH 1 (CAMBRIDGEPORT BRIDGE) OVER THE SAXTONS RIVER			
CURTAIN WALL			
Designed By	L. S. GARDNER	Drawn By	B. J. MASSE
Checked By	Date	Bridge Design Supervisor	
J. T. KLEIN	12/05	M. A. COLGAN	Date 12/05
PROJECT	GRAFTON	PROJECT NO.	TH2-0104
I.G.C. Info.			
File No. 51335DT1	Sheet 29R of 42		

VHB Vanasse Hangen Brustlin, Inc.

VHB NO. 51335

plot date: 2/3/2006