

INDEX OF SHEETS

- 1 TITLE SHEET
- 2 PROJECT TYPICAL SHEET
- 3 PAVING DETAILS AND PAVEMENT JOINT DETAIL SHEET
- 4-6 QUANTITY SHEETS
- 7-8 ITEM DETAIL SUMMARY SHEETS
- 9 DITCH CLEANING DETAIL SHEET
- 10-34 LAYOUT SHEETS
- 35-58 TRAFFIC SIGN SUMMARY SHEETS
- 59 TRAFFIC SIGN DETAIL SHEET
- 60-61 VEHICLE LOOP DETECTOR DETAIL SHEETS
- 62-63 BRIDGE DETAIL SHEETS
- 64-65 BRIDGE APPROACH SECTION DETAIL SHEETS
- 66 GUARDRAIL AND MISC. DETAIL SHEET
- 67 CONSTRUCTION APPROACH SIGNING SHEET

VAOT STANDARDS

C-1M	TREATED TIMBER CURB/CONCRETE CURB, TYPE B	01-03-00
D-3M	TREATED GUTTERS	06-13-97
D-6M	REINFORCED CONC. DROP INLET W/GRATE	06-13-97
D-10M	TOP FOR DROP INLET W/GRANITE SLOPE EDGING	06-13-97
D-15M	CAST IRON GRATE W/ FRAME, TYPE D AND E	06-13-97
E-100M	CONSTRUCTION APPROACH SIGNS	03-01-04
E-101M	CONSTRUCTION SIGN DETAILS	05-30-03
E-102M	CONSTRUCTION SIGN DETAILS	06-30-03
E-102AM	CONSTRUCTION SIGN DETAILS	06-13-97
E-103M	MAINLINE TRAFFIC CONTROL DIVIDED HIGHWAY ONE LANE CLOSED	03-01-04
E-106M	TRAFFIC CONTROL MISCELLANEOUS DETAILS	03-01-04
E-107M	DELINEATION, BARRICADES AND DETOURS FOR CONSTRUCTION AREAS	06-30-03
E-107AM	BREAKAWAY BARRICADE DETAILS	06-13-97
E-108M	CONSTRUCTION ZONE LONGITUDINAL DROP OFFS	06-13-97
E-110M	MAJOR MAINTENANCE OPERATION LANE CLOSURE	06-13-97
E-111M	MAINTENANCE OPERATION APPROACH SIGNS	02-17-98
E-121M	STANDARD SIGN PLACEMENT CONVENTIONAL ROAD	06-13-97
E-123M	GUIDE SIGN PLACEMENT	06-13-97
E-124M	TOWN LINE SIGNS	06-13-97
E-128AM	VILLAGE SIGNS	06-13-97
E-134M	BRIDGE NUMBER PLAQUE	06-13-97
E-136AM	U.S. ROUTE MARKER SIGN DETAILS	06-13-97
E-136BM	STATE ROUTE MARKER SIGN DETAILS	06-13-97
E-136CM	STATE NUMBERED TOWN HWY. SIGN DETAILS	06-13-97
E-138M	REFERENCE PLAQUE DETAILS STATE & TOWN HWY.	05-30-03
E-140M	REGULATORY SIGN DETAILS	06-13-97
E-141M	REGULATORY SIGN DETAILS	06-13-97
E-142M	REGULATORY SIGN DETAILS	06-13-97
E-143M	REGULATORY SIGN DETAILS	06-13-97
E-144M	REGULATORY SIGN DETAILS	03-29-99
E-145AM	REGULATORY SIGN DETAILS	06-13-97
E-145BM	REGULATORY SIGN DETAILS	06-13-97
E-146M	REGULATORY SIGN DETAILS	06-13-97
E-150M	WARNING SIGN DETAILS	06-13-97
E-151M	WARNING SIGN DETAILS	06-13-97
E-152M	WARNING SIGN DETAILS	06-13-97
E-153M	WARNING SIGN DETAILS	06-13-97
E-154M	WARNING SIGN DETAILS	06-13-97
E-155M	WARNING SIGN DETAILS	06-13-97
E-160M	FLANGED CHANNEL STEEL SIGN POST	06-13-97
E-163M	TUBULAR STEEL SIGN POST	06-13-97
E-164M	SQUARE STEEL SIGN POST	06-13-97
E-172M	VEHICLE DETECTOR LOOP DETAILS	06-13-97
E-173M	PULLBOXES AND JUNCTION BOXES	06-13-97
E-191M	PAVEMENT MARKING DETAILS	02-01-99
E-192M	PAVEMENT MARKING DETAILS	12-28-98
E-193M	PAVEMENT MARKING DETAILS	06-13-97
G-1M	STEEL BEAM GUARDRAIL WITH STEEL POSTS	01-03-00
G-10M	ANCHOR FOR STEEL BEAM GUARDRAIL	01-03-00
G-4M	YIELDING MARKER POSTS	06-13-97
G-19M	GENERIC GRADING PLAN FOR GUARDRAIL TERMINALS	11-15-02
J-3M	MAILBOX SUPPORT DETAILS	06-13-97
SB-R6-82M	BRIDGE RAILING HEAVY DUTY STEEL BEAM	07-10-97
T-1M	TEMPORARY EROSION CONTROL DETAILS	06-13-97
T-2M	TEMPORARY EROSION CONTROL DETAILS	06-13-97

STATE OF VERMONT AGENCY OF TRANSPORTATION




PROPOSED IMPROVEMENT TOWNS OF SALISBURY AND MIDDLEBURY COUNTY OF ADDISON U.S. ROUTE 7

BEGINNING IN THE TOWN OF SALISBURY AT MILE MARKER 1.123 = STA. 1+807.293 AND EXTENDING
NORTHERLY ALONG U.S. ROUTE 7 FOR A DISTANCE OF 12 359.762 m (7.680 MILES)
TO A POINT IN MIDDLEBURY AT MILE MARKER 4.276 = STA. 6+881.555.

LENGTH OF ROADWAY 12 359.762 m (7.680 MILES)
LENGTH OF PROJECT 12 359.762 m (7.680 MILES)

WORK TO BE PERFORMED UNDER THIS PROJECT INCLUDES RESURFACING WITH
A SHIM / LEVELING COURSE AND WEARING COURSE, COLD PLANING, NEW PAVEMENT
MARKINGS, DRAINAGE IMPROVEMENTS, GUARDRAIL IMPROVEMENTS AND INCIDENTAL ITEMS.

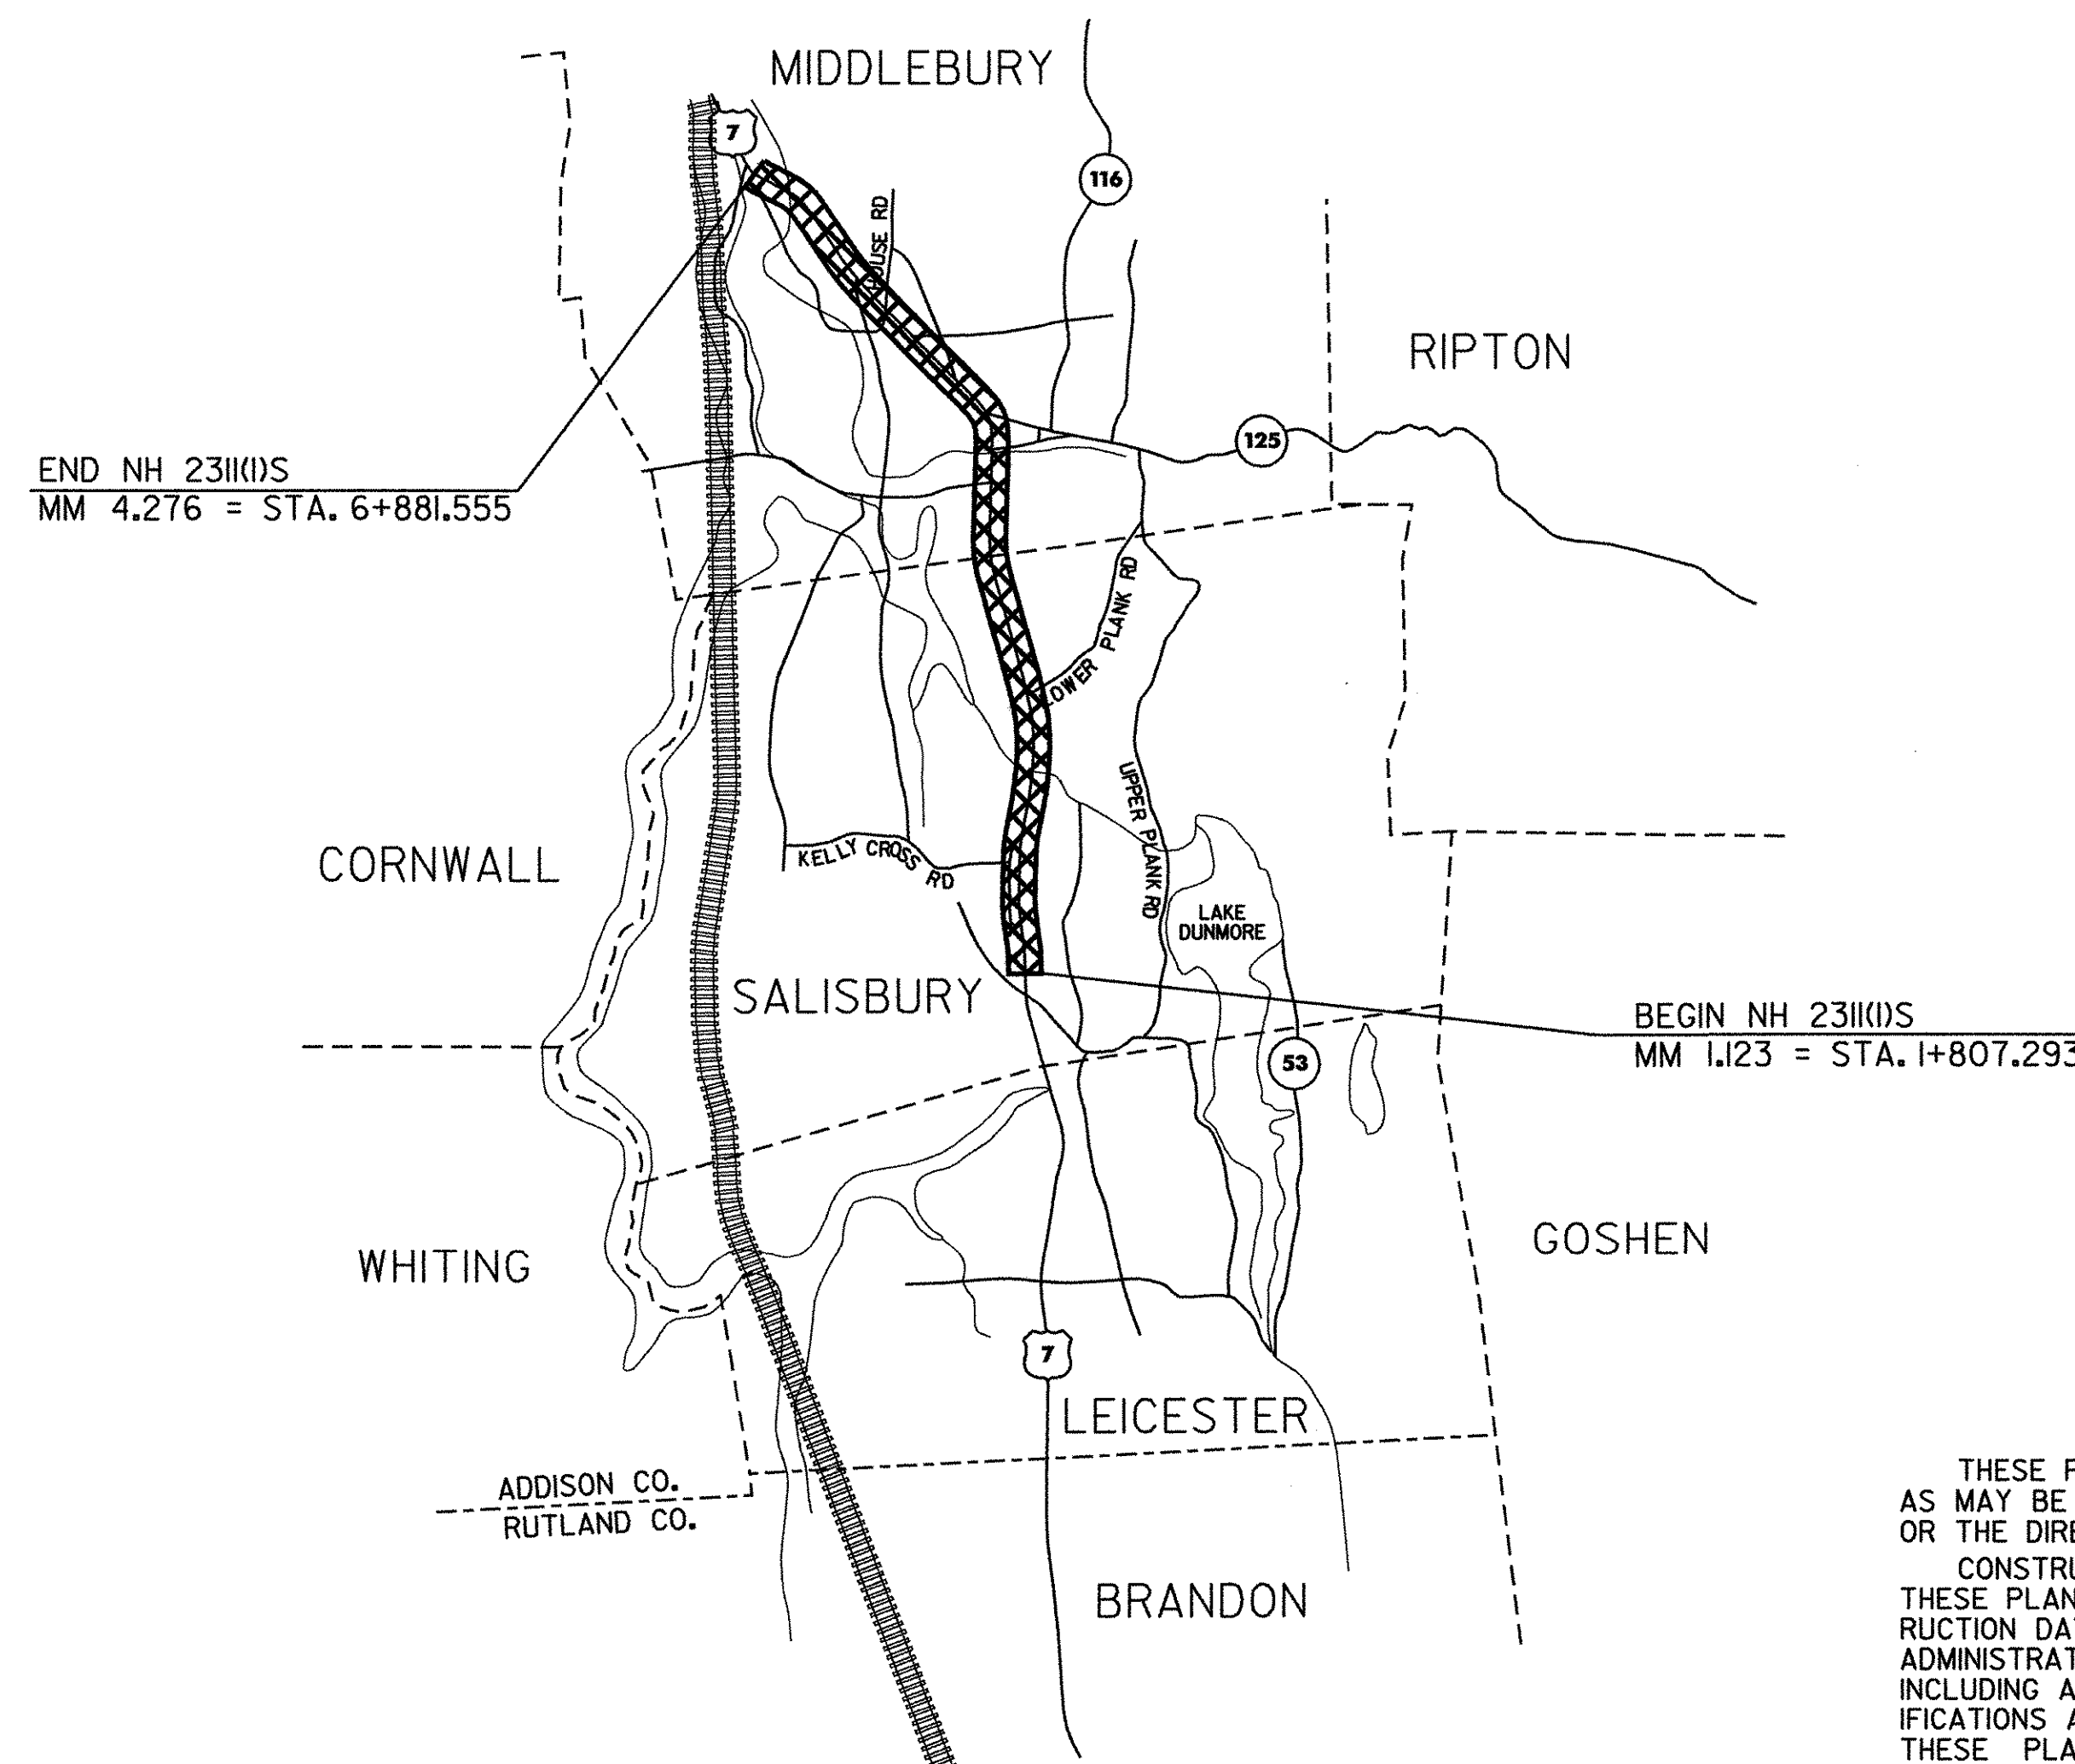


RECORD PLANS

CONTRACTOR: PIKE INDUSTRIES, INC. - BERLIN VT
RESIDENT ENGINEER: T. COURSE
CONSTRUCTION BEGAN: MAY 2, 2005
CONSTRUCTION COMPLETE: OCTOBER 26, 2005
RECORD PLANS BY: T. COURSE & E. FOSTER

I HEREBY CERTIFY THAT ALL THE CONSTRUCTION REQUIRED BY
THIS SET OF DRAWINGS HAS BEEN ACCOMPLISHED AS INDICATED HEREIN.

BY *Anthony J. Course* RESIDENT ENGINEER
DATE *6/28/06*

NOTE: Any further information concerning final quantities, amounts or other details
relative to this project may be found at Central Files in the electronic archives.

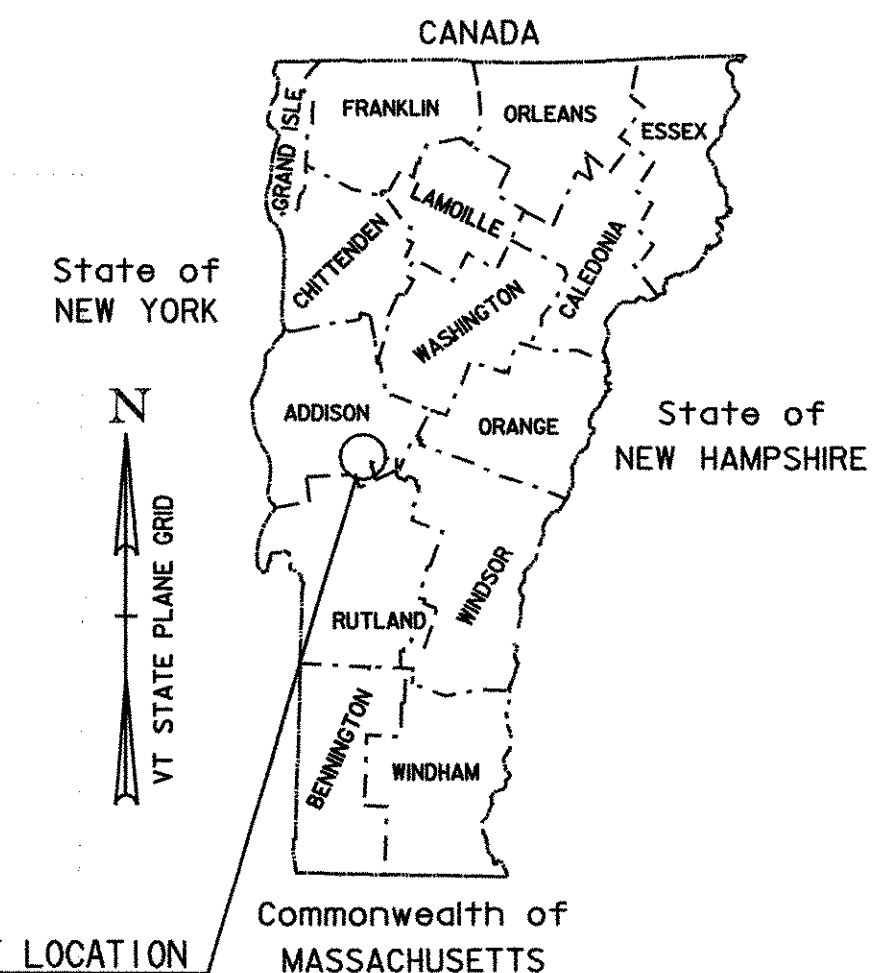


PROJECT LOCATION
NH 231(1)S
Commonwealth of MASSACHUSETTS

TRAFFIC DATA

	ADT		DHV		ESAL'S (2003-2013)
	2003	2013	2003	2013	
START OF PROJECT TO VT 125 (MIDDLEBURY)	8,500	9,900	900	1,000	4,749,000
VT 125 TO HALLADAY HILL RD.	10,600	11,400	1,100	1,200	3,306,000
HALLADAY HILL RD. TO END OF PROJECT	13,400	14,400	1,400	1,500	3,392,000

SALISBURY - MIDDLEBURY, US ROUTE 7, MM 1.123 TO MM 4.276	
BITUMINOUS CONCRETE PAVEMENT SUPERPAVE MIXTURE DESIGN CRITERIA	
DESIGN LANE/DESIGN LIFE ESAL	6,175,500
DESIGN NUMBER OF GYRATIONS	75
PERFORMANCE GRADED ASPHALT BINDER	PG 64-28

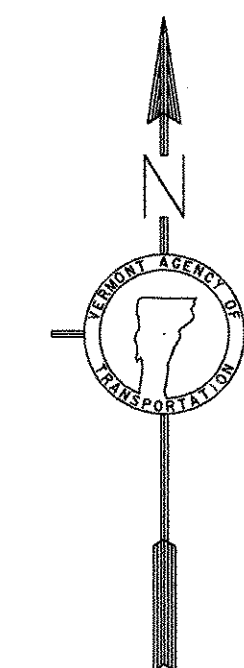

UNLESS OTHERWISE NOTED, ALL DRAWINGS AND
DETAILS OF THE PROJECT PLANS ARE NOT TO
SCALE

RIGHT OF WAY LIMITS, IF APPLICABLE, ARE
PROVIDED SOLELY FOR THE CONVENIENCE OF
THE STATE AND ITS CONTRACTOR DURING
THE COURSE OF THIS PAVING PROJECT. ANY
REFERENCES TO OFFSETS ON THESE PLANS ARE
APPROXIMATE AND SHOULD NOT BE RELIED UPON
FOR ANY OTHER PURPOSES




THESE PLANS ARE SUBJECT TO SUCH ENGINEERING CHANGES
AS MAY BE REQUIRED BY THE FEDERAL HIGHWAY ADMINISTRATION
OR THE DIRECTOR OF PROGRAM DEVELOPMENT.
CONSTRUCTION IS TO BE CARRIED ON IN ACCORDANCE WITH
THESE PLANS AND THE STANDARD SPECIFICATIONS FOR CONST-
RUCTION DATED 2001, AS APPROVED BY THE FEDERAL HIGHWAY
ADMINISTRATION ON JANUARY 4, 2001 FOR USE ON THIS PROJECT,
INCLUDING ALL SUBSEQUENT REVISIONS AND SUCH REVISED SPEC-
IFICATIONS AND SPECIAL PROVISIONS AS ARE INCORPORATED IN
THESE PLANS.

APPROVED <i>[Signature]</i> DATE <i>1/3/05</i> DIRECTOR OF PROJECT DEVELOPMENT	
DEPARTMENT OF TRANSPORTATION FEDERAL HIGHWAY ADMINISTRATION	
APPROVED _____ DATE _____ DIVISION ADMINISTRATOR	
PROJECT SALISBURY - MIDDLEBURY NH 231(1)S	
SHEET 1 OF 67 SHEETS	

NOTES

- THE PAVEMENT WEARING COURSE SHALL BE TYPE IIIS.
THE LEVELING COURSE SHALL BE TYPE IVS UNLESS OTHERWISE DIRECTED BY THE RESIDENT ENGINEER. LEVELING HAS BEEN INCLUDED TO RESHAPE THE ROADWAY PRIOR TO PAVING THE TOP COURSE ALONG THE OVERLAY AND COLD PLANE TYPICAL SECTIONS. AN ESTIMATED THICKNESS OF 15mm OF ITEM 490.30 HAS BEEN INCLUDED TO COVER THIS PROVISION.


ALL ASPHALT CEMENT USED IN THE BITUMINOUS CONCRETE PAVEMENT SHALL BE PG 64-28.
- EMULSIFIED ASPHALT SHALL BE APPLIED ON EXISTING PAVEMENT SURFACES, BETWEEN ALL COURSES OF PAVEMENT AND ON COLD PLANED SURFACES AT THE RATE OF 0.12 L/SM OR AS DIRECTED BY THE RESIDENT ENGINEER.
- BITUMINOUS CONCRETE PAVEMENT TOLERANCE = +/- 5 mm (TOTAL THICKNESS EXCLUDING LEVELING).
- EXISTING SHOULDER MATERIAL DEEMED UNSUITABLE BY THE RESIDENT ENGINEER WILL BE EXCAVATED TO A DEPTH OF 75 mm +/- OR AS DIRECTED BY THE ENGINEER. EXCAVATED MATERIAL WILL BE SPREAD ON THE ADJACENT SLOPES OR REMOVED FROM THE PROJECT, AS DIRECTED BY THE ENGINEER. THIS WORK WILL BE PAID FOR USING THE APPROPRIATE RENTAL ITEMS SUCH AS ALL PURPOSE EXCAVATOR RENTAL, GRADER RENTAL, LOADER RENTAL, TRUCK RENTAL, AND POWER BROOM RENTAL. THE METHOD OF REMOVAL AND THE USE OF RENTAL ITEMS SHALL BE APPROVED BY THE ENGINEER PRIOR TO ANY WORK BEING DONE. MATERIAL REMOVED SHALL BE REPLACED WITH SUBBASE OF CRUSHED GRAVEL (FINE GRADED) OR AGGREGATE SHOULDERS.
- ONE METER OF BACKING IS REQUIRED BEHIND THE FACE OF GUARD RAIL WITH 1.8m POSTS. IF THIS CANNOT BE OBTAINED THEN 2.4m POSTS SHALL BE USED.
- COLD PLANING TO BE COMPLETED ACCORDING TO THE TYPICAL OR AS NOTED OTHERWISE ON THE PLANS. A FULL DEPTH BUTT JOINT SHALL BE CONSTRUCTED AT THE PROJECT BEGINNING/END AND AT ALL SIDE ROAD APPROACHES AS DENOTED ON THE PROJECT PLANS OR AS OTHERWISE DIRECTED BY THE RESIDENT ENGINEER.
- PIPE INLET AND OUTLET AREAS, AND DITCH CLEANING THROUGH THE PROJECT, SHALL BE PERFORMED AT LOCATIONS AS DIRECTED ON THE DITCH CLEANING DETAIL SHEET AND AS DIRECTED BY THE RESIDENT ENGINEER. PAYMENT WILL BE UNDER THE APPLICABLE EQUIPMENT RENTAL ITEM(S).
- ALL DRIVES SHALL RECEIVE A PAVED APRON AS DIRECTED BY THE RESIDENT ENGINEER. ANY AND ALL REQUIRED EXCAVATION IN DRIVE AREAS SHALL BE AS DIRECTED AND WILL BE PAID FOR UNDER THE APPLICABLE RENTAL ITEM(S). IF REQUIRED, A NEW DRIVEWAY SUBBASE SHALL BE CONSTRUCTED AND WILL BE PAID FOR UNDER ITEM 301.28, SUBBASE OF CRUSHED GRAVEL (FINE GRADED). A NEW BITUMINOUS SURFACE SHALL BE CONSTRUCTED AS DIRECTED AND WILL BE PAID FOR UNDER ITEM 490.30. ESTIMATED QUANTITIES OF THE ABOVE ITEMS HAVE BEEN INCLUDED TO PAY FOR THIS WORK.
- ESTIMATED QUANTITIES OF ITEM 608.25, EXCAVATOR RENTAL AND 608.37, TRUCK RENTAL HAVE BEEN INCLUDED FOR THE PROVISION OF CONSTRUCTING GUARD RAIL END SECTIONS WITH EXCAVATED DITCHING MATERIAL. THE GUARD RAIL END SECTIONS SHALL BE CAPPED WITH AN ESTIMATED 75mm DEPTH OF AGGREGATE SHOULDER MATERIAL UNLESS OTHERWISE DIRECTED BY THE RESIDENT ENGINEER. THE QUANTITIES INCLUDED REFLECT 5 TONS OF AGGREGATE SHOULDER MATERIAL FOR EACH GUARD RAIL TERMINAL.
- ITEM 616.47, BITUMINOUS CONCRETE GUTTERS AND TRAFFIC ISLANDS WILL BE PAID ONLY WHERE SPECIFIED IN THE PLANS. ALL OTHER BITUMINOUS CONCRETE PAVEMENT WORK, WHICH COULD INVOLVE SOME HAND-WORK (SUCH AS DRIVE AND SIDEROAD APPROACHES AND AROUND DRAINAGE/UTILITY STRUCTURES), SHALL BE PAID FOR AT THE CONTRACT UNIT PRICE FOR ITEM 490.30, SUPERPAVE BITUMINOUS CONCRETE PAVEMENT.
- ALL EDGES OF PAVEMENT SHALL BE BACKED UP FULL HEIGHT WITH AGGREGATE SHOULDER MATERIAL, OR AS DIRECTED BY THE RESIDENT ENGINEER AND WILL BE PAID FOR UNDER ITEM 402.12, AGGREGATE SHOULDERS.
- GRASS GROWING ADJACENT TO PAVEMENT, OR THROUGH CRACKS IN THE PAVEMENT, WHICH MAY HAMPER THE PLACEMENT OF NEW BITUMINOUS CONCRETE, SHALL BE REMOVED BY THE CONTRACTOR, AS DIRECTED BY THE ENGINEER. PAYMENT FOR THIS WORK WILL NOT BE MADE DIRECTLY, BUT WILL BE CONSIDERED INCIDENTAL TO ITEM 490.30, SUPERPAVE BITUMINOUS CONCRETE PAVEMENT.
- COMPACTION, GRADING, AND CLEAN UP OF ITEM 301.28, SUBBASE OF CRUSHED GRAVEL, ITEM 402.12, AGGREGATE SHOULDER MATERIAL, AND ITEM 651.35, TOPSOIL, IS TO BE INCLUDED IN THE CONTRACT PRICE OF EACH ITEM.

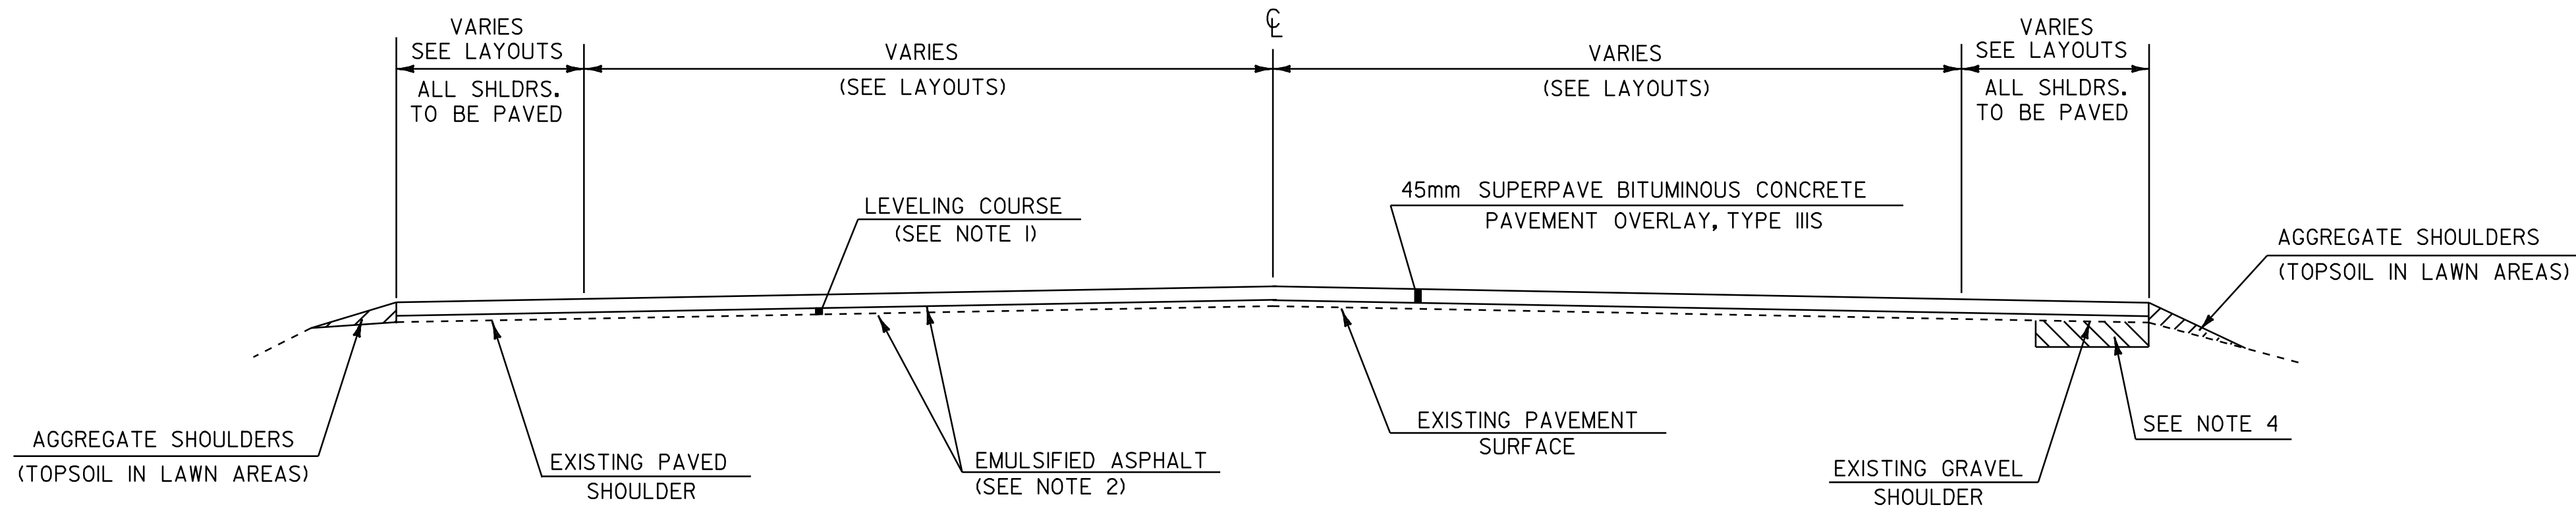

OVERLAY TYPICAL SECTION

SALISBURY
STA 1+807.293 TO 7+285.500

MIDDLEBURY
STA 0+000.000 TO 1+863.620
STA 2+276.736 TO 5+793.638

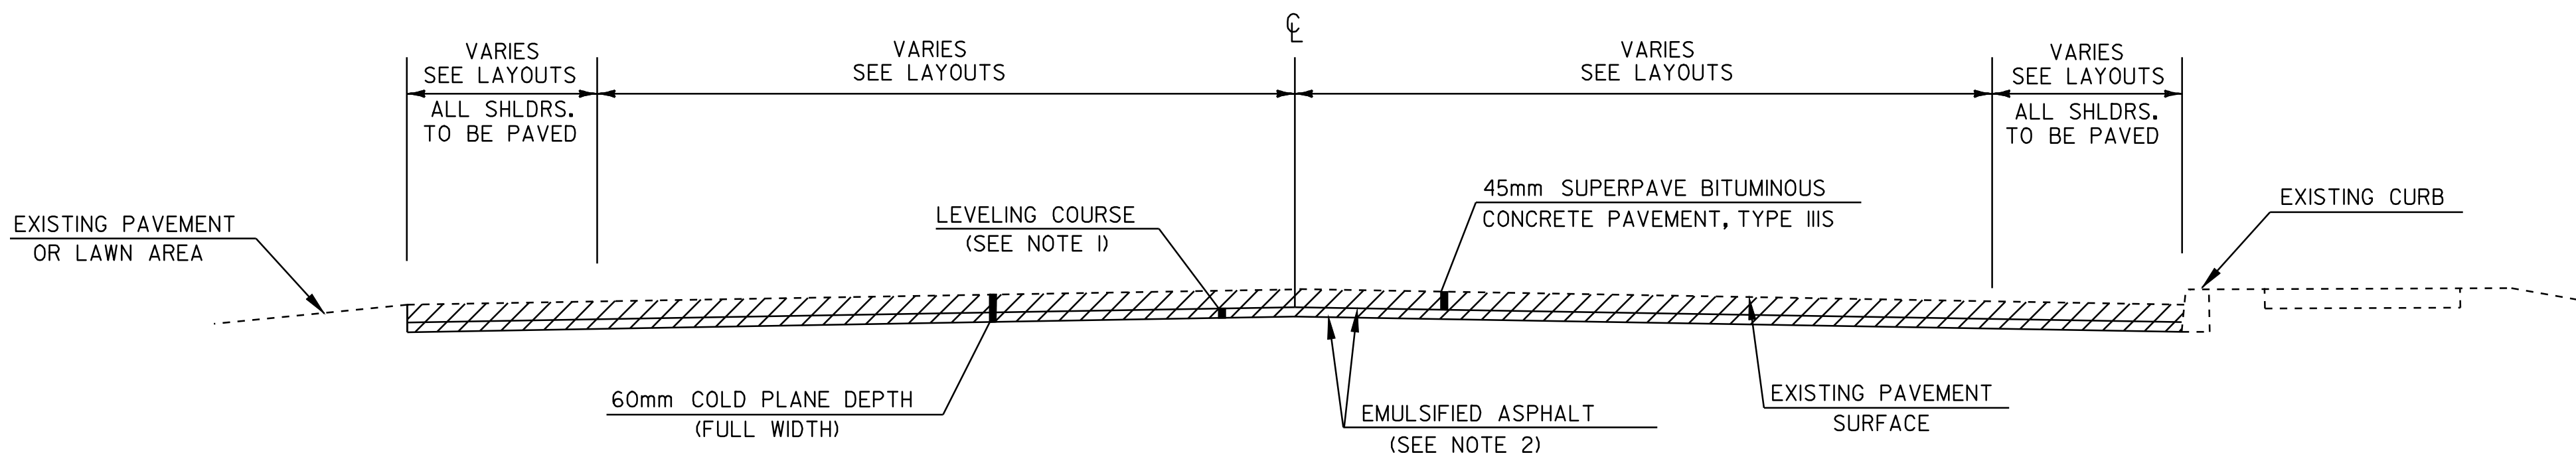

COLD PLANED TYPICAL SECTION

MIDDLEBURY
STA 1+863.620 TO 2+276.736
STA 5+793.638 TO 6+881.555

PROJECT PAVING LIMITS

TOWN & ROUTE	BEGIN STATION	END STATION	LANE TYPICAL	WEARING DEPTH	LEVELING Tons	NOTES
SALISBURY - US ROUTE 7	1+807.293	1+840.000	VARIES-3.6-3.6-VARIES	45 mm	15	LEVEL & PAVE W/45mm TYPE IIIS
	1+840.000	7+285.500	3.0-3.6-3.6-3.0	45 mm	2588	LEVEL & PAVE W/45mm TYPE IIIS
MIDDLEBURY - US ROUTE 7	0+000.000	0+970.000	3.0-3.6-3.6-3.0	45 mm	461	LEVEL & PAVE W/45mm TYPE IIIS
	0+970.000	1+010.000	VARIES-3.6-3.6-VARIES	45 mm	16	LEVEL & PAVE W/45mm TYPE IIIS
	1+010.000	1+090.000	0.9-3.6-3.6-0.9	- -	43	BR. # 125 - COLD PLANE 25mm, OVERLAY W/25mm TYPE IVS
	1+090.000	1+130.000	VARIES-3.6-3.6-VARIES	45 mm	16	LEVEL & PAVE W/45mm TYPE IIIS
	1+130.000	1+800.000	3.0-3.6-3.6-3.0	45 mm	318	LEVEL & PAVE W/45mm TYPE IIIS
	1+800.000	1+863.620	VARIES-3.6-3.6-VARIES	45 mm	32	LEVEL & PAVE W/45mm TYPE IIIS
	1+863.620	2+276.736	VARIES-SEE LAYOUT SHEETS	45 mm	255	COLD PLANE 60mm - LEVEL & PAVE W/45mm TYPE IIIS
	2+276.736	2+340.000	VARIES-3.6-3.6-VARIES	45 mm	32	LEVEL & PAVE W/45mm TYPE IIIS
	2+340.000	3+300.000	3.3-3.6-3.6-3.3	45 mm	477	LEVEL & PAVE W/45mm TYPE IIIS
	3+300.000	3+320.000	VARIES-3.6-3.6-VARIES	45 mm	10	LEVEL & PAVE W/45mm TYPE IIIS
	3+320.000	5+300.000	3.6-3.6-3.6-3.6	45 mm	1027	LEVEL & PAVE W/45mm TYPE IIIS
	5+300.000	5+320.000	VARIES-3.6-3.6-VARIES	45 mm	10	LEVEL & PAVE W/45mm TYPE IIIS
	5+320.000	5+793.638	3.3-3.6-3.6-3.3	45 mm	235	LEVEL & PAVE W/45mm TYPE IIIS
	5+793.638	6+881.555	VARIES-SEE LAYOUT SHEETS	45 mm	571	COLD PLANE 60mm - LEVEL & PAVE W/45mm TYPE IIIS



PROJECT
TYPICAL
SHEET #1

DESIGNED BY WHEELER DATE 12-02

DRAWN BY WHEELER DATE 12-02





DESIGN FILE NO. pave/01b018/pb018.dgn

PRF FILE pb018+tyl.l DATE 10-JUL-2006 PLOTTED 13


PROJ. NAME **SALISBURY - MIDDLEBURY**

PROJ. NO. **NH 2311(1)S**

SHEET **2** OF **67** SHEETS

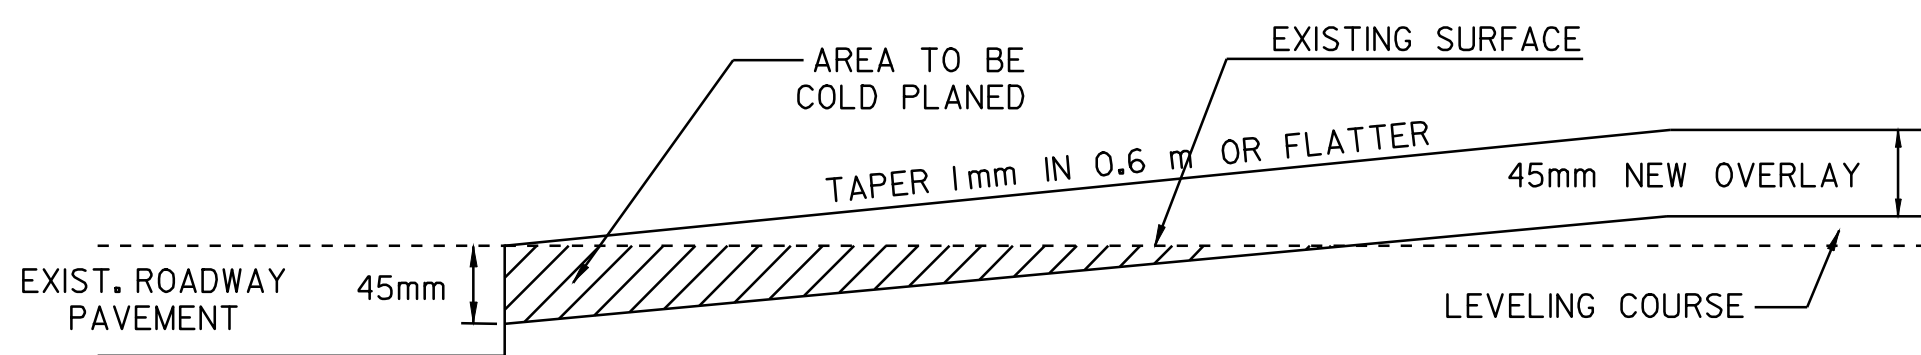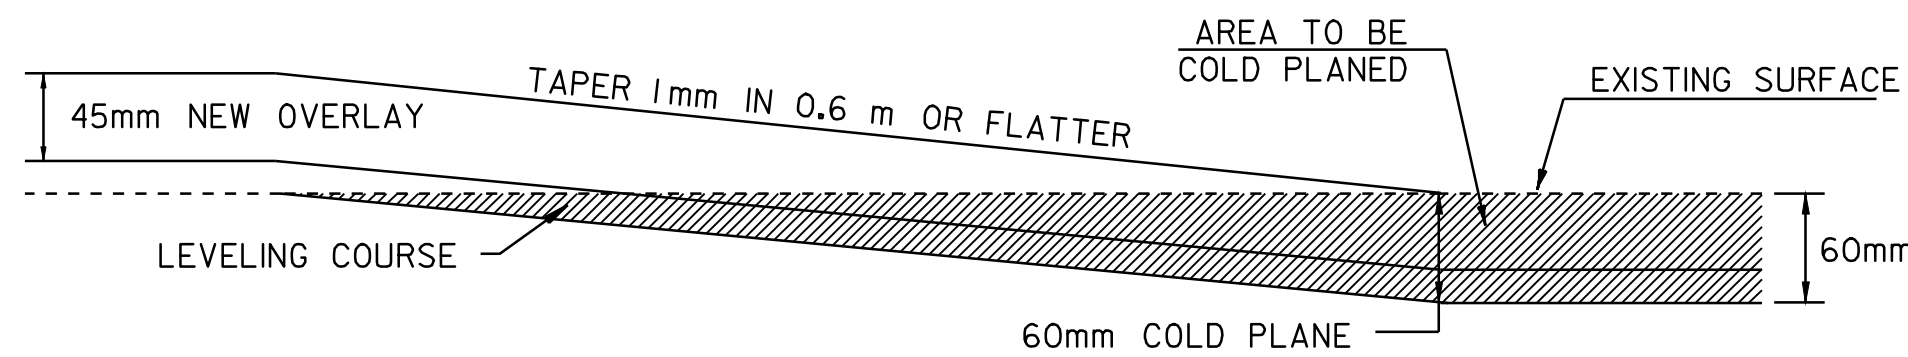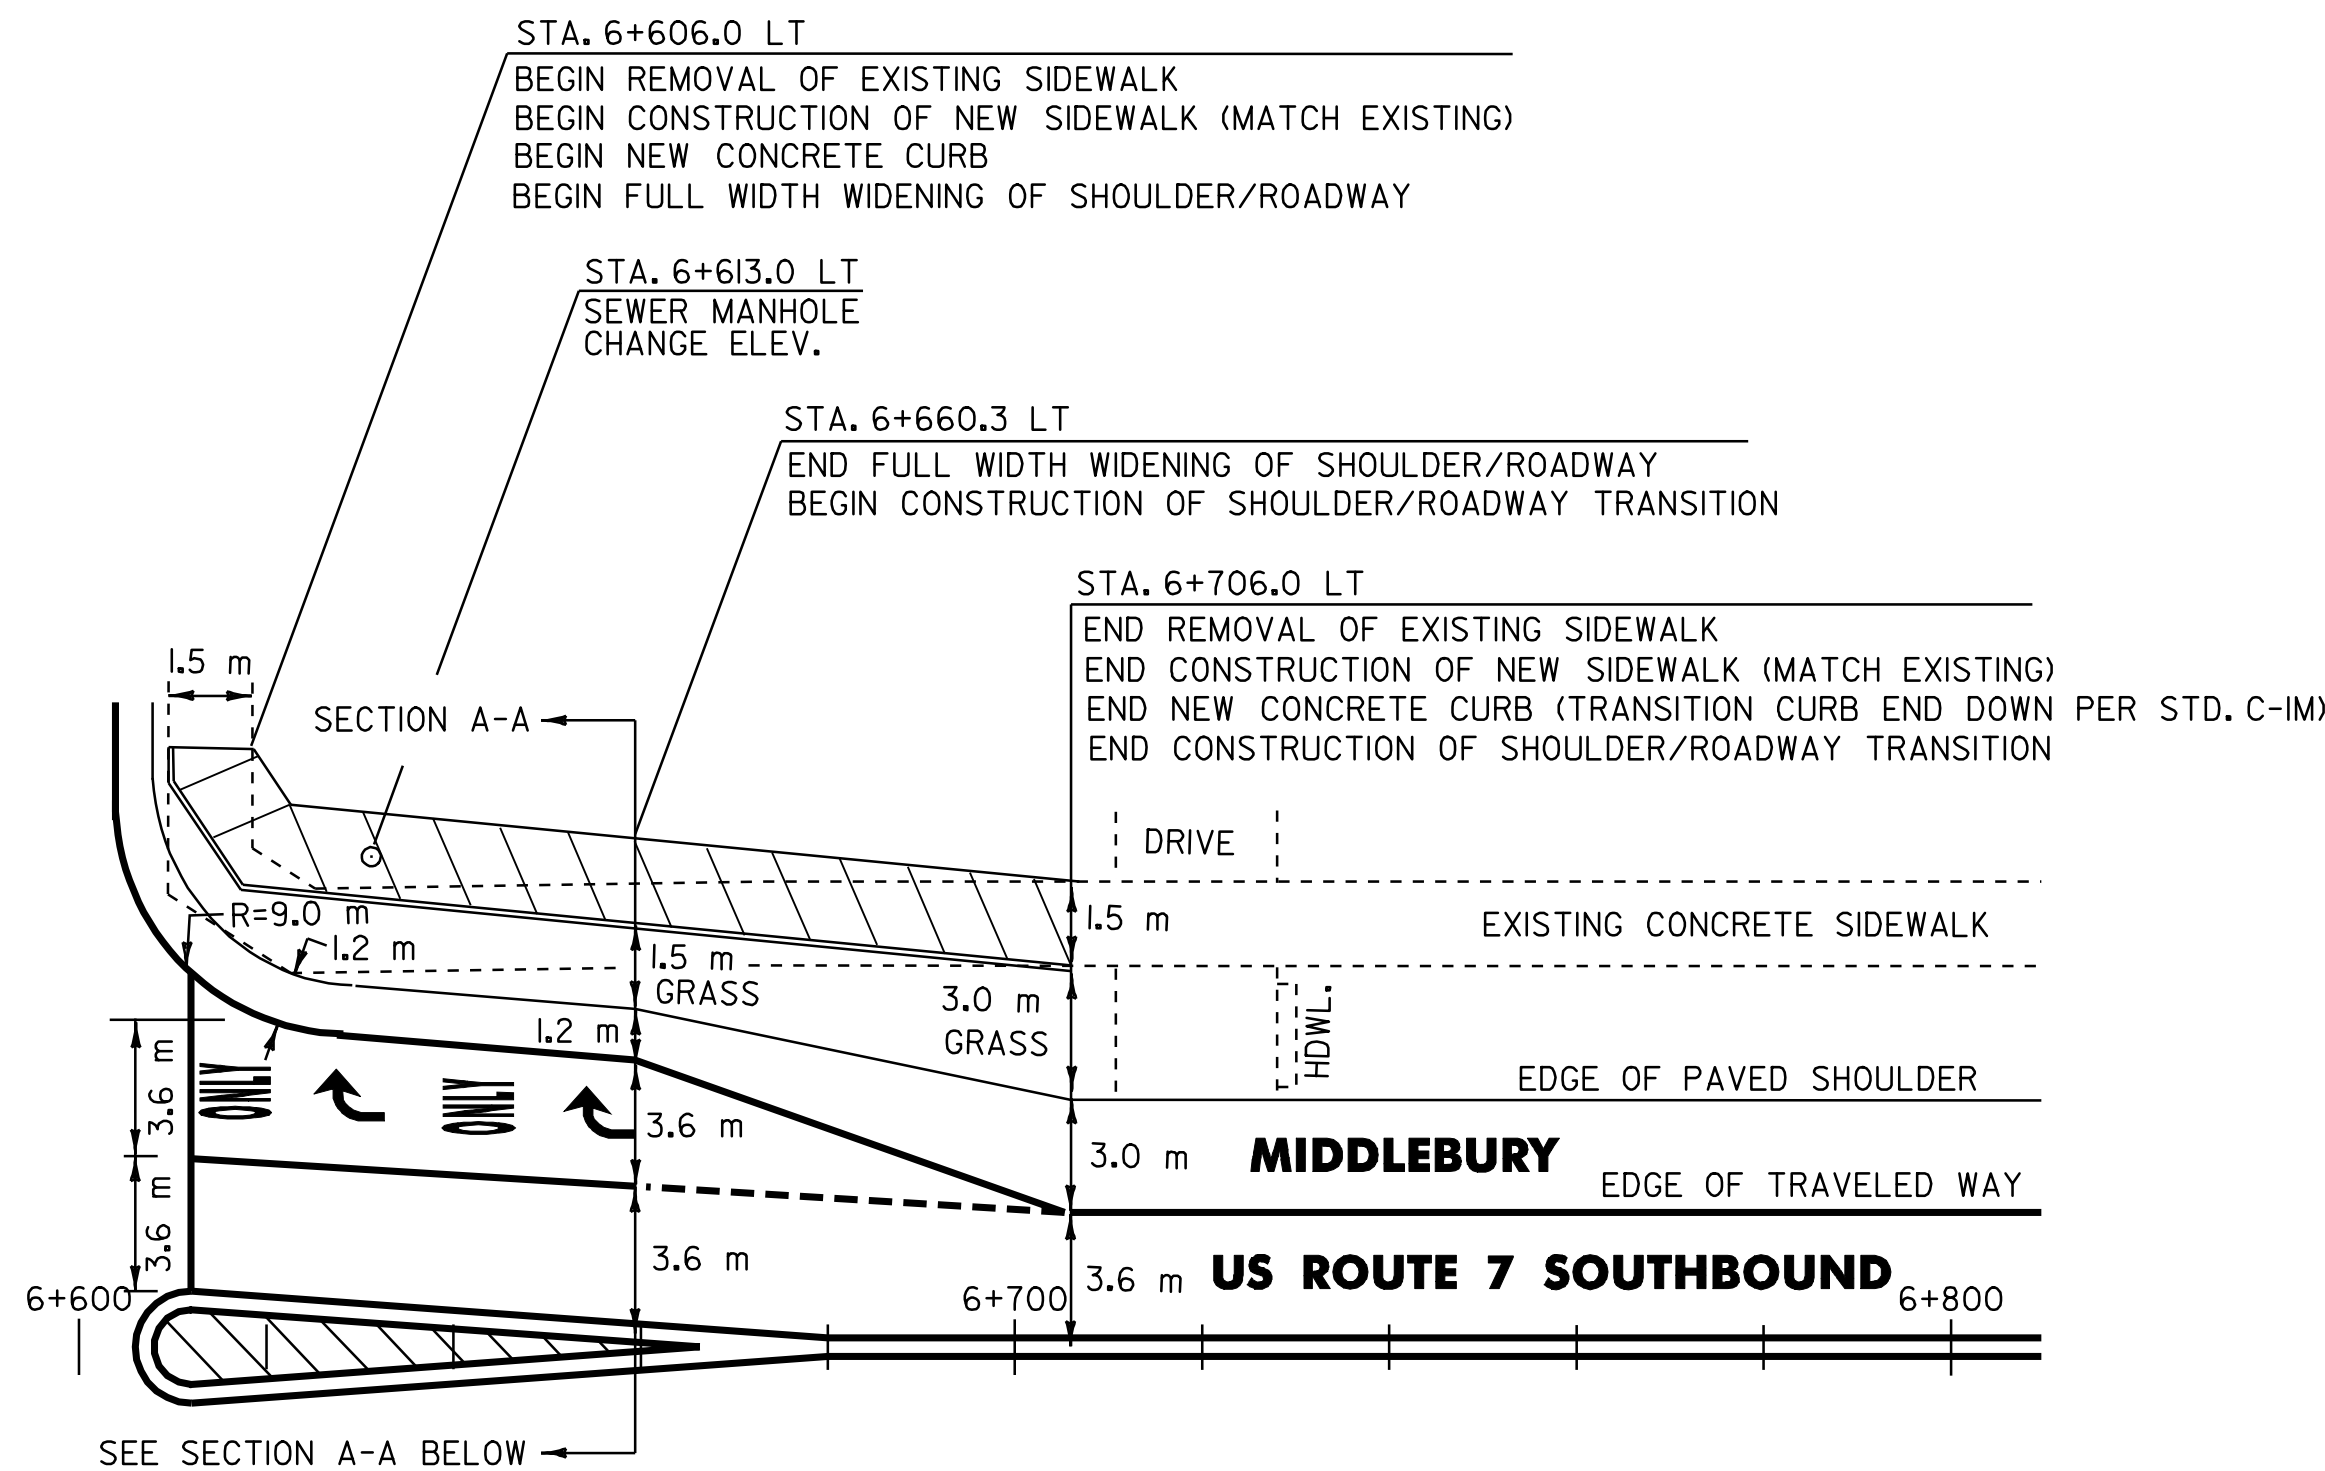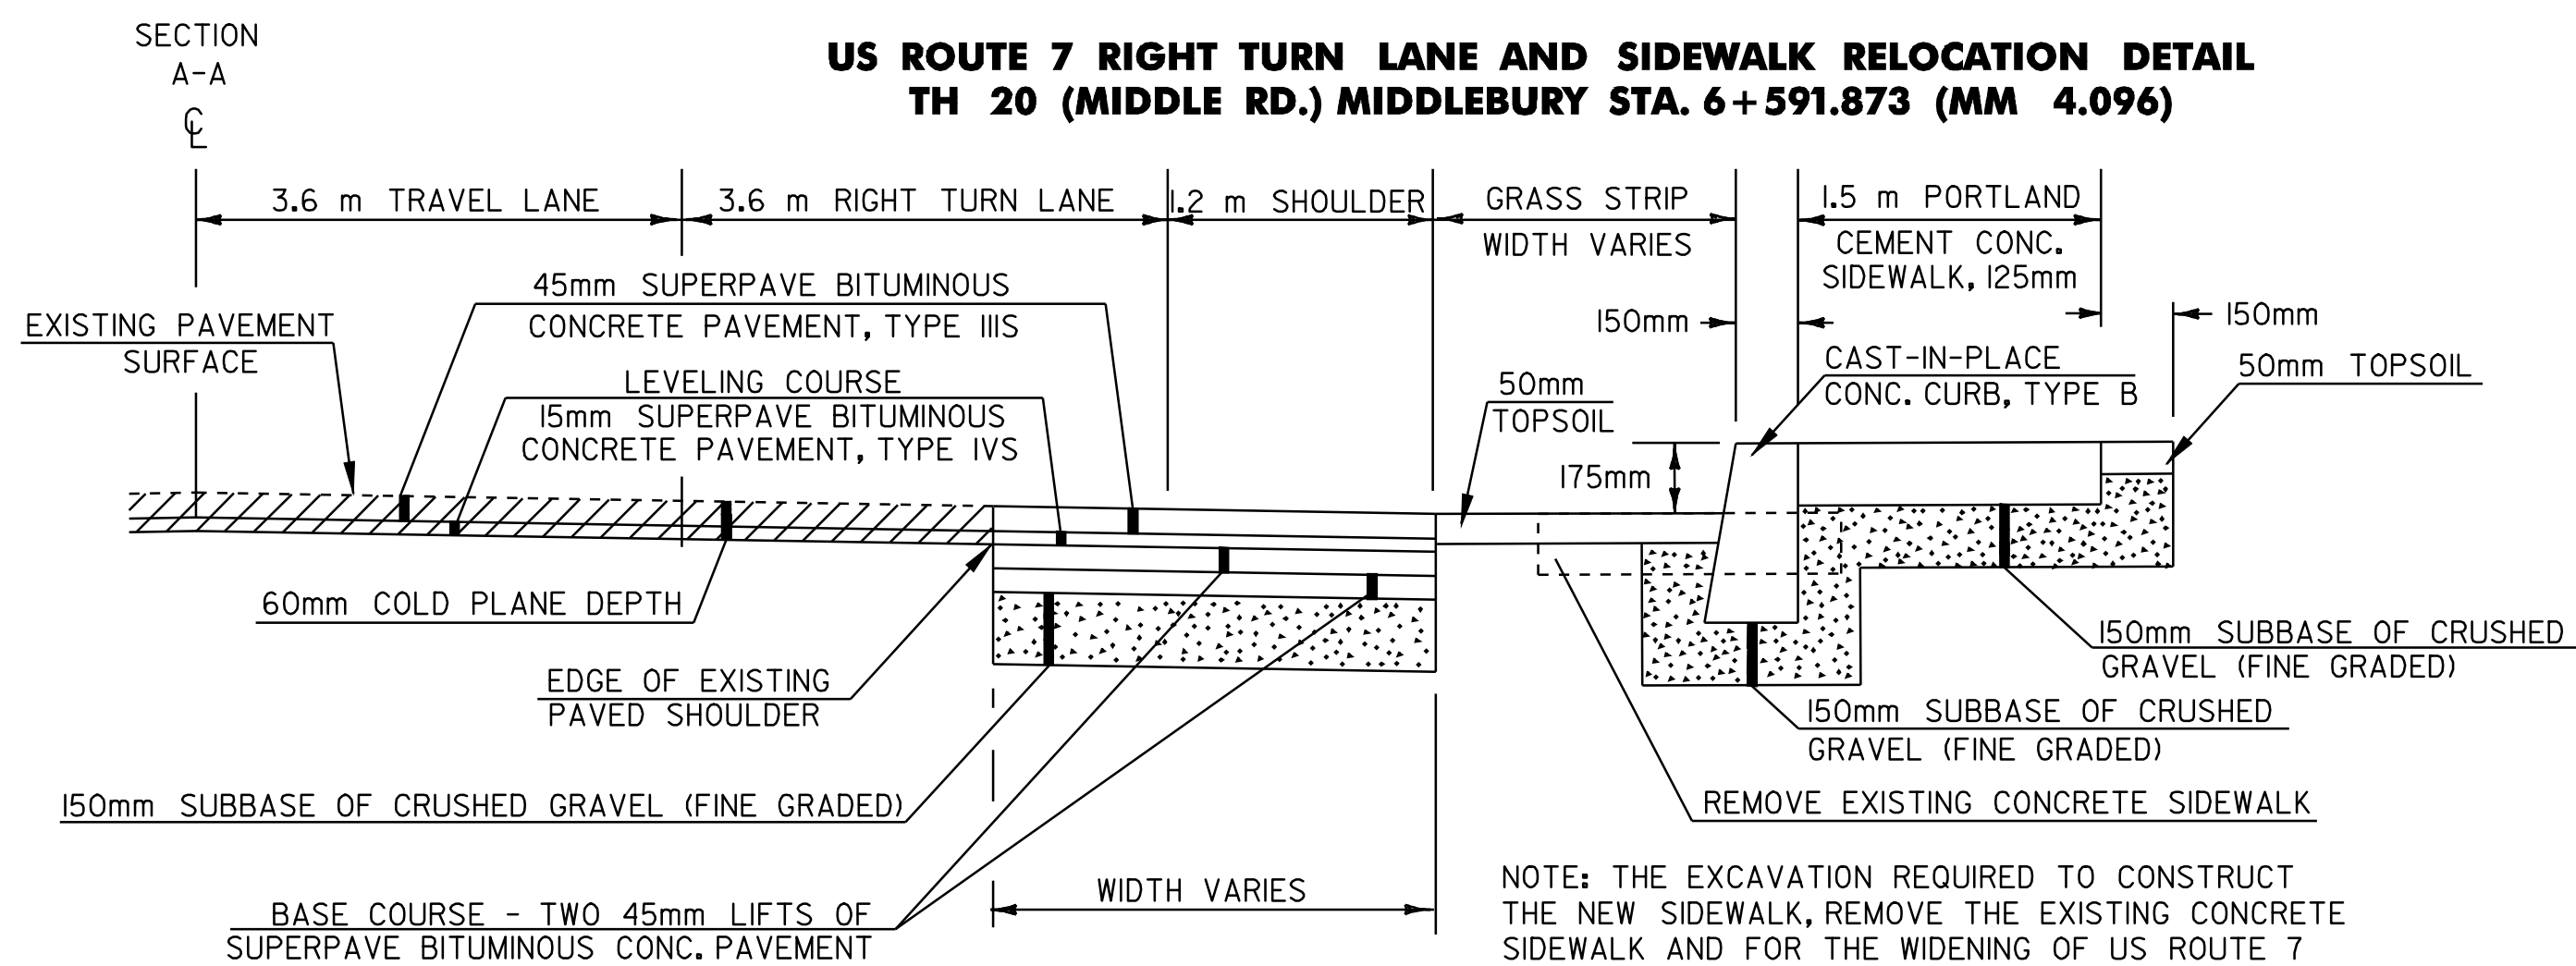**-APPROACH AREA DETAIL-****SALISBURY****STA 1+807.293 TO 1+843.293 (BEGIN PROJECT)****-TRANSITION AREA DETAIL-****MIDDLEBURY****STA 1+827.620 TO 1+863.620 (END OVERLAY/BEGIN COLD PLANING)****STA 2+276.736 TO 2+312.736 (END COLD PLANING/BEGIN OVERLAY)****STA 5+757.638 TO 5+793.638 (END OVERLAY/BEGIN COLD PLANING)****US ROUTE 7 RIGHT TURN LANE AND SIDEWALK RELOCATION DETAIL
TH 20 (MIDDLE RD.) MIDDLEBURY STA. 6+591.873 (MM 4.096)**



NOTE: THE EXCAVATION REQUIRED TO CONSTRUCT THE NEW SIDEWALK, REMOVE THE EXISTING CONCRETE SIDEWALK AND FOR THE WIDENING OF US ROUTE 7 SHALL BE PAID AS ITEM 203.15, COMMON EXCAVATION.

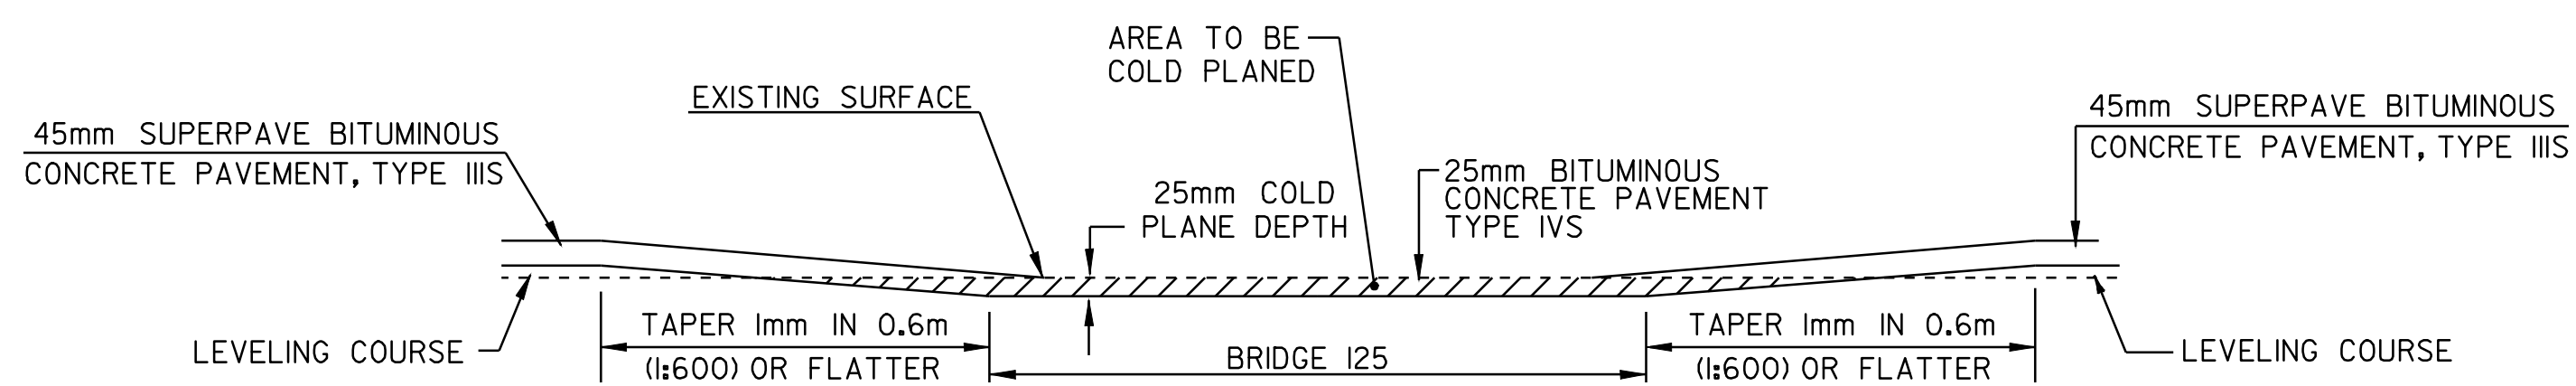**-COLD PLANING DETAIL @ BRIDGE-****BR 125 MIDDLEBURY STA. 1+050.902 (MM 0.653)****NOTE:**

PRECAUTIONS MUST BE TAKEN ON BRIDGE #125 TO AVOID DAMAGE TO THE EXISTING MEMBRANE. ANY COSTS ASSOCIATED WITH REPAIRING OR REPLACING THIS MEMBRANE, FROM DAMAGE DURING COLD PLANE OPERATIONS, SHALL BE THE RESPONSIBILITY OF THE CONTRACTOR.

THE CONTRACTOR SHALL TAKE PRECAUTIONS DURING CONSTRUCTION TO AVOID THE ACCUMULATION OF DEBRIS IN THE DRAINAGE STRUCTURES LOCATED AT THE CURB LINE AND IN THE EXPANSION JOINTS AT THE END OF THE BRIDGE. THE CONTRACTOR SHALL EXAMINE THESE BRIDGE FEATURES ON A REGULAR BASIS TO ENSURE THAT DEBRIS HAS NOT ACCUMULATED. ANY DEBRIS WHICH IS PRESENT SHALL BE REMOVED BY THE CONTRACTOR AT NO COST TO THE STATE.

REFER TO SHEETS 62 AND 63 FOR BRIDGE AND ASPHALTIC PLUG JOINT DETAILS.

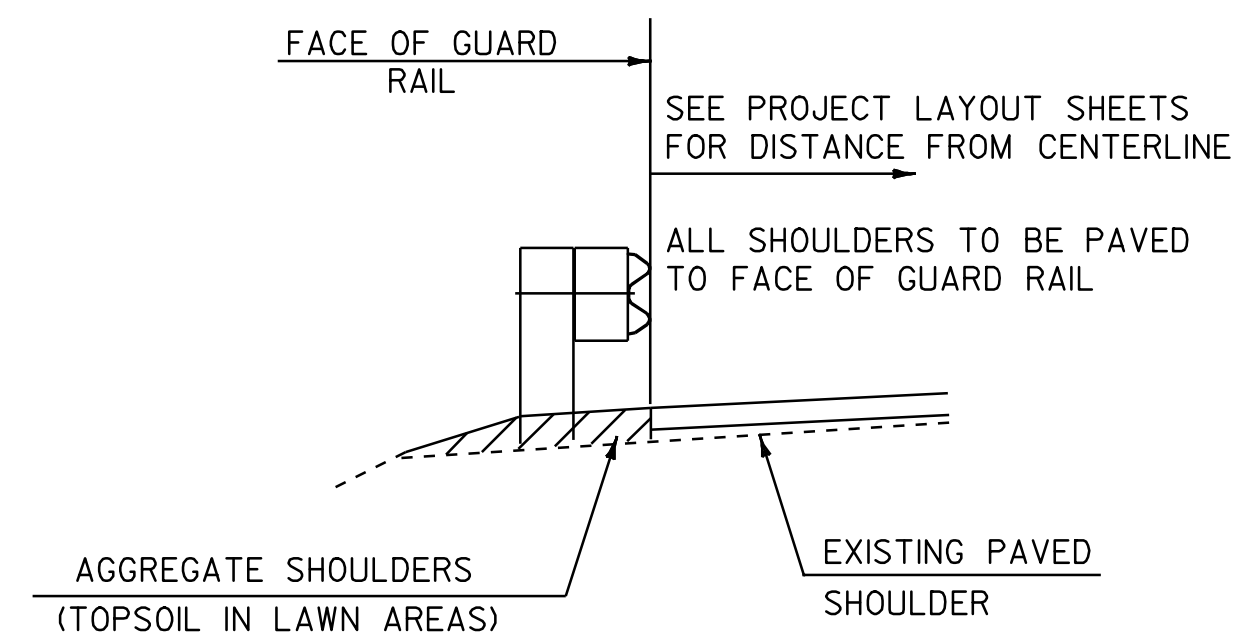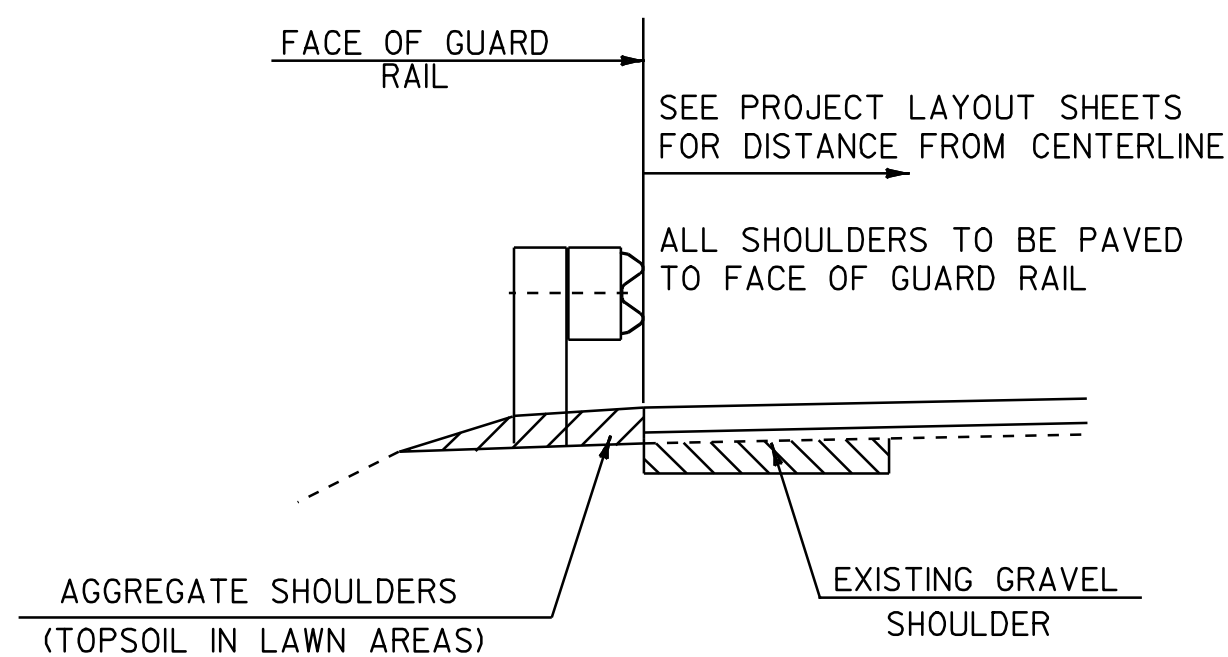**- TYPICAL SECTION AT GUARD RAIL -
(@ EXISTING PAVED SHOULDER)****- TYPICAL SECTION AT GUARD RAIL -
(@ EXISTING GRAVEL SHOULDER)****CONSERVATION SEED MIX
RURAL AREA - SEED MIXTURE**

% WT.	kg/HECTARE	NAME	PUR%	GERM%
38.0	25	CREeping RED FESCUE	98	85
38.0	25	TALL FESCUE	95	90
4.5	3	RED TOP	95	90
15.0	10	BIRDSFOOT TREFOIL	98	85
4.5	3	ANNUAL RYEGRASS	95	85
100.0	66			

SEED MIXTURE:
SHALL NOT HAVE A WEED CONTENT EXCEEDING 0.40% BY WEIGHT AND SHALL BE FREE OF ALL NOXIOUS SEED.

SEED:
TO BE APPLIED PER SEEDING FORMULAS OR AS DIRECTED BY THE ENGINEER.

FERTILIZER:
FORMULA 10-20-10, TO BE USED WITH SEED, APPLIED AT THE RATE OF 560 kg/HECTARE. (HYDRO SEEDERS MAY USE 19-19-19 FORMULA)

AGRICULTURAL LIMESTONE:
TO BE PLACED ON EARTH SLOPES AT THE RATE OF 4.5 TONS/HECTARE, OR AS DIRECTED BY THE ENGINEER.

HAY MULCH:
TO BE PLACED ON EARTH SLOPES AT THE RATE OF 4.5 TONS/HECTARE, OR AS DIRECTED BY THE ENGINEER.

TOPSOIL:
TO BE USED AS INDICATED ON THE PLANS, OR AS DIRECTED BY THE ENGINEER.

MARKER POSTS:
TO BE PLACED AS INDICATED OR AS DIRECTED BY THE ENGINEER.

**PROJECT
TYPICAL
SHEET #2**DESIGNED BY WHEELER DATE 12-02DRAWN BY WHEELER DATE 12-02DESIGN FILE NO. pave/01b018/pb018.dgnPRF FILE pb018+y2.1 DATE 10-JUL-2006PROJ. NAME **SALISBURY - MIDDLEBURY**PROJ. NO. **NH 2311(1)S**SHEET **3** OF **67** SHEETS

[illegible]

TOTALS		
QUANTITY SHEET 1	PROJECT NAME	SALISBURY - MIDDLEBURY
	PROJECT NUMBER	NH 2311(1)S
	DATE PLOTTED	10-JUL-2006 13:33
	SHEET	4 OF 67 SHEETS

LOCATION			ITEM DETAIL SUMMARY SHEET 1												
STATION	STATION	POS.	GUARDRAIL											REMARKS	
			616.35	621.20	621.20	621.21	621.505	621.505	621.60	621.70	621.71	621.80	676.10		
			TREATED TIMBER CURB	STEEL BEAM GUARDRAIL	STEEL BEAM G.R. W/2.4 m POSTS (MOD.)	HEAVY DUTY STEEL BEAM GUARDRAIL	MANUFACTURED TERMINAL SECTION	MANUFACTURED TERMINAL SECT (FLARED)	ANCHOR FOR RAIL	GUARDRAIL APPROACH SECT, TYPE I	GUARDRAIL APPROACH SECT, TYPE II	REMOVAL & DISPOSAL OF GUARDRAIL	DEL INEATORS WITH STEEL POSTS		
			m	m	m	m	EA	EA	EA	EA	EA	m	EA		
SALISBURY:															
I+808.0	2+119.0	LT		311.6				2				311.6	2	INSTALL NEW MANUFACTURED TERMINAL SECTION (FLARED) AT STA. I+808.0 - I+819.4 & STA. 2+119.0 (ON T-23).	
2+144.0	2+178.2	LT		34.2				2				53.8	2	INSTALL NEW MANUFACTURED TERMINAL SECTION (FLARED) AT STA. 2+144.0 (ON T-23) & STA. 2+166.8 - 2+178.2.	
3+594.1	3+825.9	LT		209.0				2				230.0	2	INSTALL NEW MANUFACTURED TERMINAL SECTION (FLARED) AT STA. 3+594.1- 3+605.5 & STA. 3+814.5 - 3+825.9.	
3+643.4	3+809.2	RT		152.0				2				171.6	2	INSTALL NEW MANUFACTURED TERMINAL SECTION (FLARED) AT STA. 3+643.4 - 3+654.8 & STA. 3+797.8 - 3+809.2.	
4+172.8	4+226.0	RT		57.0			I	I				81.4	2	INSTALL NEW MANUF. TERMINAL SECTION (FLARED) AT STA. 4+172.8 - 4+184.2. INSTALL NEW MANUF. TERM. SECTION AT STA. 4+226.0 (ON T-3).	
4+183.0	4+384.4	LT		178.6				2				200.0	2	INSTALL NEW MANUFACTURED TERMINAL SECTION (FLARED) AT STA. 4+183.0 - 4+194.4 & STA. 4+373.0 - 4+384.4.	
4+743.0	5+081.2	LT		315.4				2				335.0	2	INSTALL NEW MANUFACTURED TERMINAL SECTION (FLARED) AT STA. 4+743.0 - 4+754.4 & STA. 5+069.8 - 5+081.2.	
5+302.0	5+351.4	LT		26.6				2				47.0	2	INSTALL NEW MANUFACTURED TERMINAL SECTION (FLARED) AT STA. 5+302.0 - 5+313.4 & STA. 5+340.0 - 5+351.4.	
5+323.0	5+349.4	RT		26.6			I	I				49.6	2	INSTALL NEW MANUF. TERM. SECTION AT STA. 5+323.0 (ON T-9). INSTALL NEW MANUF. TERMINAL SECTION (FLARED) AT STA. 5+338.0 - 5+349.4.	
6+545.0	6+605.8	RT		38.0				2				60.0	2	INSTALL NEW MANUFACTURED TERMINAL SECTION (FLARED) AT STA. 6+545.0 - 6+556.4 & STA. 6+594.4 - 6+605.8. SEE SHEET 66 OF 67 FOR STEEL BEAM GUARDRAIL AT SMALL CULVERTS DETAIL.	
6+558.0	6+603.6	LT		22.8				2				46.0	2	INSTALL NEW MANUFACTURED TERMINAL SECTION (FLARED) AT STA. 6+558.0 - 6+569.4 & STA. 6+592.2 - 6+603.6. SEE SHEET 66 OF 67 FOR STEEL BEAM GUARDRAIL AT SMALL CULVERTS DETAIL.	
7+186.0	7+273.4	LT		64.6				2				87.0	2	INSTALL NEW MANUFACTURED TERMINAL SECTION (FLARED) AT STA. 7+186.0 - 7+197.4 & STA. 7+262.0 - 7+273.4.	
7+277.2	0+003.1	LT						I					I	INSTALL NEW MANUFACTURED TERMINAL SECTION (FLARED) AT STA. 7+277.2 (SALISBURY) - 0+003.1 (MIDDLEBURY)	
MIDDLEBURY:															
0+000.0	0+041.8	RT		19.0				2				34.2	2	INSTALL NEW MANUFACTURED TERMINAL SECTION (FLARED) AT STA. 0+000.0 & STA. 0+011.4 & STA. 0+030.4- 0+041.8. SEE SHEET 66 OF 67 FOR STEEL BEAM GUARDRAIL AT SMALL CULVERTS DETAIL.	
0+003.1	0+044.9	LT		30.4				I				52.3	I	INSTALL NEW MANUFACTURED TERMINAL SECTION (FLARED) AT STA. 0+033.5 - 0+044.9. GUARDRAIL REMOVAL BEGINS AT 7+281 (SALISBURY)	
0+052.0	0+097.6	LT		22.8				2				47.6	2	INSTALL NEW MANUFACTURED TERMINAL SECTION (FLARED) AT STA. 0+052.0 - 0+063.4 & STA. 0+086.2 - 0+097.6.	
0+181.2	0+321.8	LT		117.8				2				138.6	2	INSTALL NEW MANUFACTURED TERMINAL SECTION (FLARED) AT STA. 0+181.2 - 0+192.6 & STA. 0+310.4 - 0+321.8.	
0+325.2	0+595.0	LT		247.2				2				271.6	2	INSTALL NEW MANUFACTURED TERMINAL SECTION (FLARED) AT STA. 0+325.2 - 0+336.6 & STA. 0+583.6 - 0+595.0.	
0+602.0	0+780.6	LT			155.8			2				175.0	2	INSTALL NEW MANUFACTURED TERMINAL SECTION (FLARED) AT STA. 0+602.0 - 0+613.4 & STA. 0+769.2 - 0+780.6.	
0+945.9	1+010.5	LT		49.4				I		I		61.5	I	INSTALL NEW MANUF. TERMINAL SECTION (FLARED) AT STA. 0+945.9 - 0+957.3. BEGIN APPROACH SECTION TYPE II AT STA. 1+006.7 AND CONNECT TO EXISTING BRIDGE RAIL AT STA. 1+010.5. SEE SHEETS 64 AND 65 OF 67 FOR BRIDGE APPROACH SECTION DETAILS. SEE SHEET 63 OF 67 FOR BRIDGE DETAILS.	
0+983.5	1+021.5	RT		11.4				I		I		36.5	I	INSTALL NEW MANUF. TERMINAL SECTION (FLARED) AT STA. 0+983.5 - 0+994.9. BEGIN APPROACH SECTION TYPE I AT STA. 1+006.3 AND CONNECT TO EXISTING BRIDGE RAIL AT STA. 1+021.5. SEE SHEETS 64 AND 65 OF 67 FOR BRIDGE APPROACH SECTION DETAILS. SEE SHEET 63 OF 67 FOR BRIDGE DETAILS.	
1+079.5	1+109.9	LT		3.8				I		I		30.5	I	CONNECT APPROACH SECTION TYPE I TO EXISTING BRIDGE RAIL AT STA. 1+079.5 AND END AT STA. 1+094.7. SEE SHEETS 64 & 65 OF 67 FOR APPROACH SECTION DETAILS. SEE SHEET 63 OF 67 FOR BRIDGE DETAILS. INSTALL NEW MANUF. TERMINAL SECTION (FLARED) AT STA. 1+098.5 - 1+109.9.	
1+089.5	1+127.7	RT		22.8				I		I		38.5	I	CONNECT APPR. SECTION TYPE II TO EXISTING BRIDGE RAIL AT STA. 1+089.5 AND END AT STA. 1+093.5. SEE SHEETS 64 & 65 OF 67 FOR BRIDGE APPR. SECTION DETAILS. SEE SHEET 63 OF 67 FOR BRIDGE DETAILS. INSTALL NEW MANUF. TERMINAL SECTION (FLARED) AT STA. 1+116.3 - 1+127.7.	
1+877.0	1+947.0	RT		72.2				2				95.0	2	INSTALL NEW MANUFACTURED TERMINAL SECTION (FLARED) AT STA. 1+877.0 - 1+888.4 & STA. 1+947.0 (ON VT 125).	
1+923.0	2+037.0	LT		91.2				2				113.0	2	INSTALL NEW MANUFACTURED TERMINAL SECTION (FLARED) AT STA. 1+923.0 - 1+934.4 & STA. 2+025.6 - 2+037.0.	
1+993.0	2+050.0	RT		102.6				2				128.0	2	INSTALL NEW MANUFACTURED TERMINAL SECTION (FLARED) AT STA. 1+993.0 (ON VT. 125) & 2+038.6 - 2+050.0.	
2+601.4	2+647.0	LT		22.8				2				46.0	2	INSTALL NEW MANUFACTURED TERMINAL SECTION (FLARED) AT STA. 2+601.4 - 2+612.8 & STA. 2+635.6 - 2+647.0.	
2+607.9	2+642.1	RT		11.4				2				34.0	2	INSTALL NEW MANUFACTURED TERMINAL SECTION (FLARED) AT STA. 2+607.9 - 2+619.3 & STA. 2+630.7 - 2+642.1.	
SHEET SUBTOTAL				2261.2	155.8		2	48		2	2	2975.3	50		
DATUM														ITEM DETAIL SUMMARY SHEET 1	DRAWN BY <u>C.A.K.</u> DATE <u>2/02</u> SQUAD LEADER <u>D.E.G.</u> DESIGN FILE NO. <u>page/01b018/pb018.dgn</u> IPARM FILE <u>pb018.dgn</u> DATE PLOTTED <u>10-JUL-2006 13:3</u> PROJ. NAME <u>SALISBURY - MIDDLEBURY</u> PROJ. NO. <u>NH_231111S</u> SHEET <u>7</u> OF <u>67</u> SHEETS <u> </u>
VERTICAL <u>N/A</u>															
HORIZONTAL <u>N/A</u>															

ITEM DETAIL SUMMARY SHEET 2	SURVEYED BY	<u>N/A</u>	DATE	<u>N/A</u>	
	DRAWN BY	<u>C.A.K.</u>	DATE	<u>2/02</u>	
	SQUAD LEADER	<u>D.E.G.</u>			
	DESIGN FILE NO.	<u>pave/01b018/pb018.dgn</u>			
	IPARM FILE	<u>pb018d2.i</u>	DATE PLOTTED	<u>0-JUL-2006 13:34</u>	
	PROJ. NAME	<u>SALISBURY--MIDDLEBURY</u>			
PROJ. NO.	<u>NH_231111S</u>				
SHEET	<u>8</u>	OF	<u>67</u>	SHEETS	<u> </u>

646.40 DURABLE 100 mm WHITE LINE
(ALL LINES WILL INCLUDE EDGE LINE BREAKS AND
RADIUS FOR TOWN HIGHWAYS)
SALISBURY:
STA. 1+807.293 - STA. 2+360.0 LT & RT

646.60 TEMPORARY 100 mm WHITE LINE
(ALL LINES WILL INCLUDE EDGE LINE BREAKS AND
RADIUS FOR TOWN HIGHWAYS)
SALISBURY:
STA. 1+807.293 - STA. 2+360.0 LT & RT

646.41 DURABLE 100 mm YELLOW LINE
(ALL LINES WILL INCLUDE C/L BREAKS FOR
TOWN HIGHWAYS) S=SOLID, D=DASHED
SALISBURY:
STA. 1+807.293 - STA. 2+148.5 LT S
STA. 2+148.5 - STA. 2+323.0 S
STA. 2+323.0 - STA. 2+360.0 D
STA. 2+132.381 DOUBLE SOLID LT, T-23

646.61 TEMPORARY 100 mm YELLOW LINE
(ALL LINES WILL INCLUDE C/L BREAKS FOR
TOWN HIGHWAYS) S=SOLID, D=DASHED
SALISBURY:
STA. 1+807.293 - STA. 2+148.5 LT S
STA. 2+148.5 - STA. 2+323.0 S
STA. 2+323.0 - STA. 2+360.0 D
STA. 2+132.381 DOUBLE SOLID LT, T-23

646.46 DURABLE 600 mm STOP BAR
SALISBURY:
STA. 2+132.381 LT, T-23


646.66 TEMPORARY 600 mm STOP BAR
SALISBURY:
STA. 2+132.381 LT, T-23

646.50 DURABLE LETTER OR SYMBOL
SALISBURY:
STA. 2+132.381 LT, T-23, "S,T,O,P" (4 EA)

646.70 TEMPORARY LETTER OR SYMBOL
SALISBURY:
STA. 2+132.381 LT, T-23, "S,T,O,P" (4 EA)

675.50 REMOVING SIGNS
AS SHOWN - 8

675.60 ERECTING SALVAGED SIGNS
AS SHOWN - 1

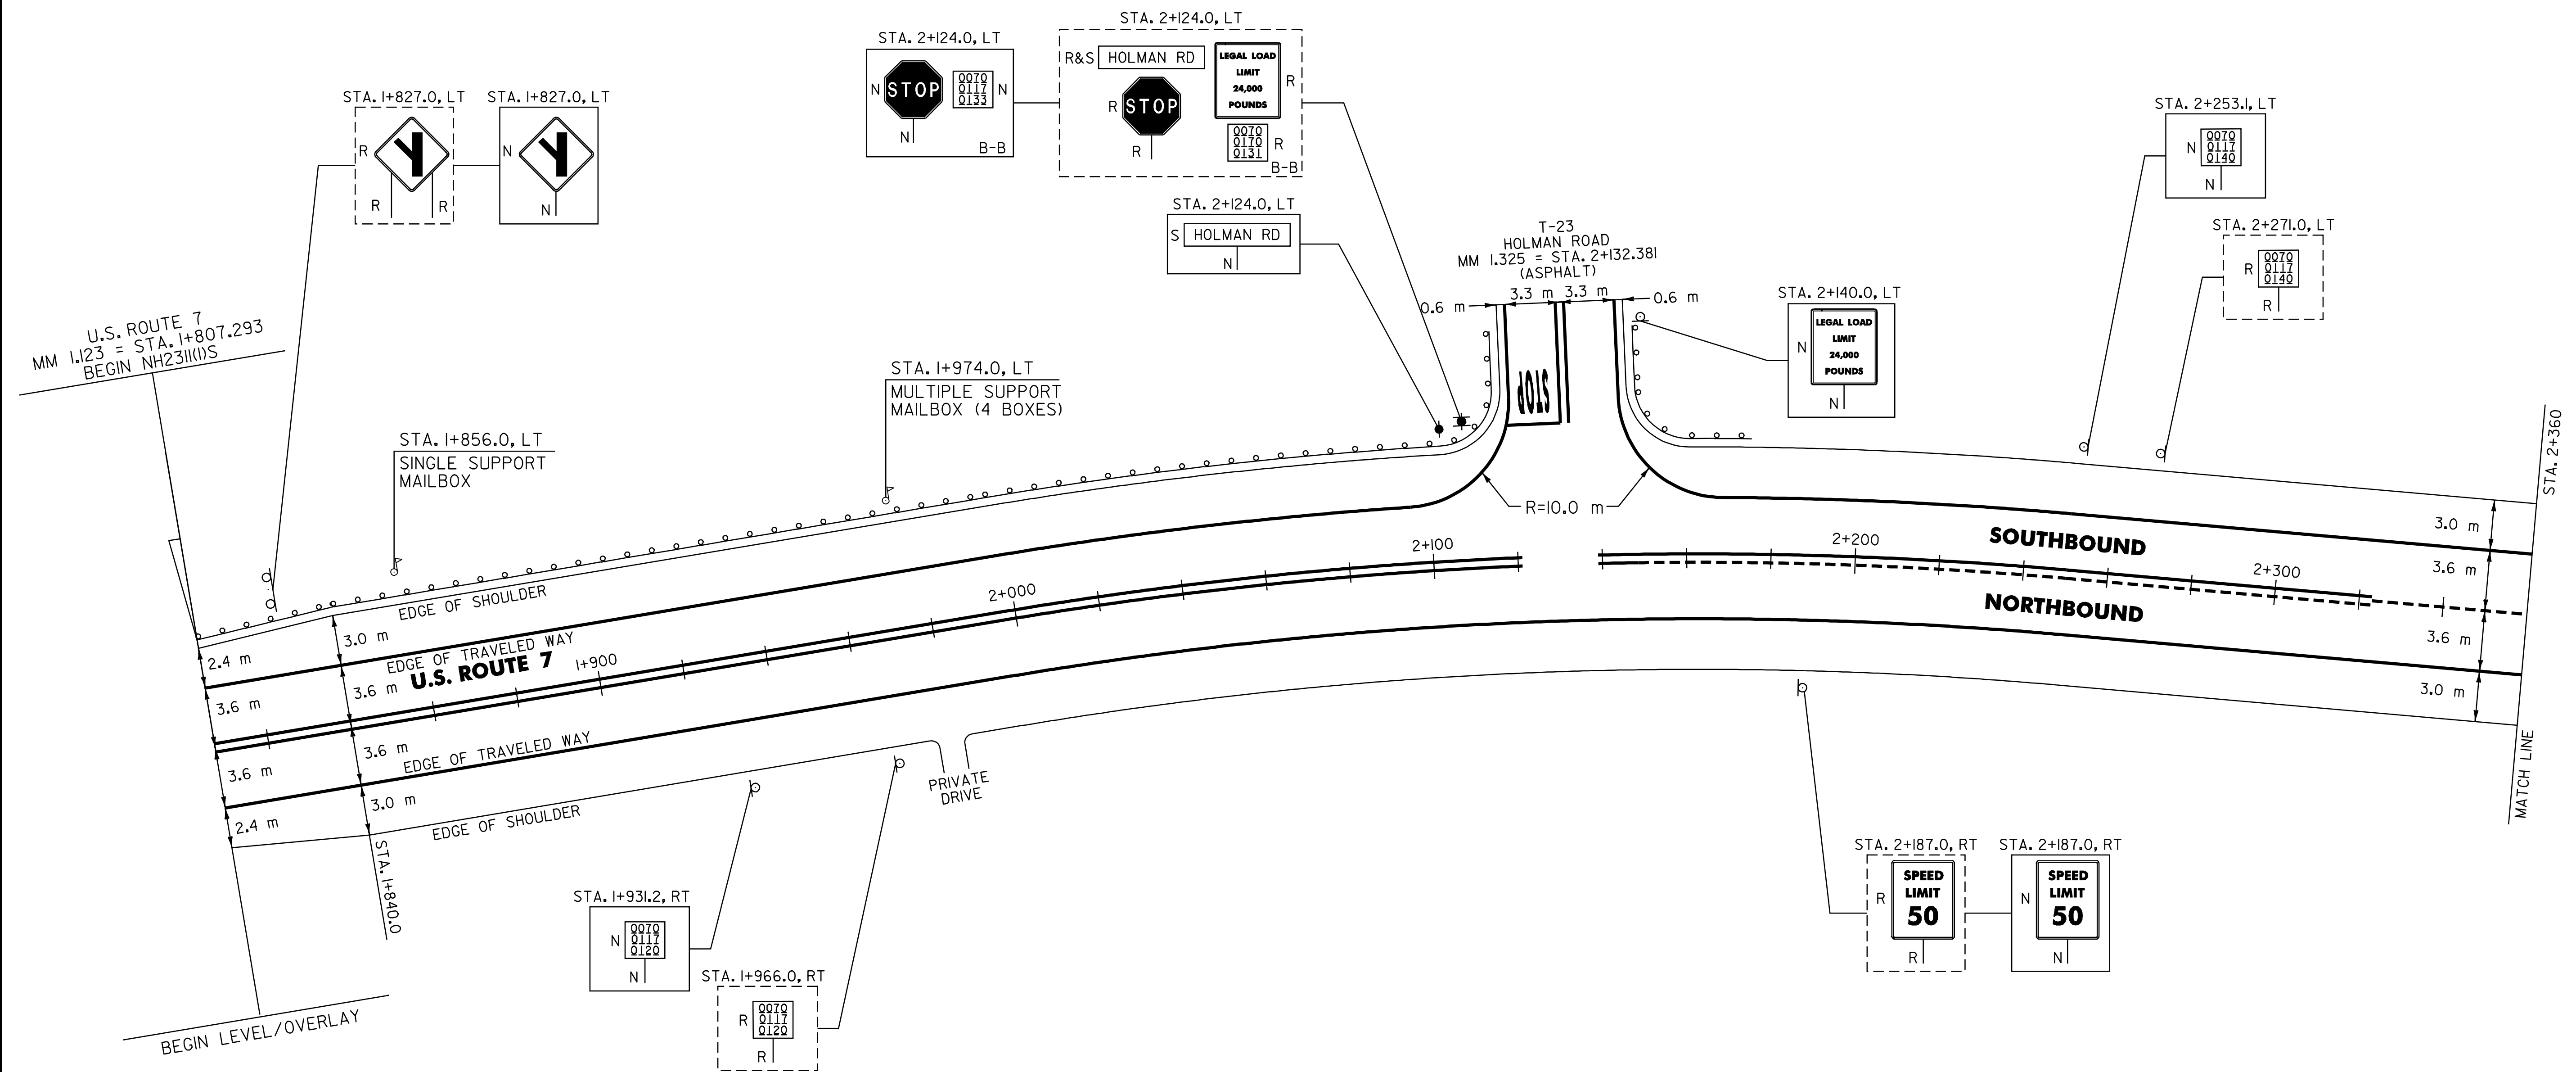

621.20 STEEL BEAM GUARDRAIL

SALISBURY:
STA. 1+819.4 - STA. 2+119.0 LT (311.6 m) (331.47 m)
STA. 2+144.0 - STA. 2+166.8 LT (347.2 m) (38.1 m)

621.505 MANUFACTURED TERMINAL SECTION (FLARED)

SALISBURY:
STA. 1+808.0 - STA. 1+819.4 LT
STA. 2+119.0 LT (ON T-23)
STA. 2+144.0 LT (ON T-23)
STA. 2+166.8 - STA. 2+178.2 LT

621.80 REMOVAL AND DISPOSAL OF GUARDRAIL

SALISBURY:
STA. 1+809.0 - STA. 2+119.0 LT (311.6 m)
STA. 2+144.0 - STA. 2+175.0 LT (53.8 m)

617.10 RELOCATE MAILBOX, SINGLE SUPPORT

SALISBURY:
STA. 1+856.0 LT

617.12 RELOCATE MAILBOX, MULTIPLE SUPPORT

SALISBURY:
STA. 1+974.0 LT

NOTE:

1. PAVING LIMIT ON ALL TOWN HIGHWAYS SHALL BE MEASURED 8 m BACK FROM U.S. ROUTE 7 EDGE OF SHOULDER UNLESS DENOTED OTHERWISE ON THE PLANS OR AS DIRECTED BY THE RESIDENT ENGINEER.

SIGN LEGEND
R= REMOVE
S= SALVAGE
N= NEW
RET= RETAIN
B-B= BACK TO BACK
EXISTING= -----
NEW= -----

PAVING
PROJECT
LAYOUT
1

SURVEYED BY N/A DATE N/A
DRAWN BY C.A.K. DATE 2/02
SQUAD LEADER D.E.G.
DESIGN FILE NO. pave/01b018/pb018.dgn
IPARM pb018p01.i DATE 10-JUL-2006 13:
FILE 10-JUL-2006 13:
PROJ. NAME SALISBURY - MIDDLEBURY
PROJ. NO. NH_231111S
SHEET 10 OF 67 SHEETS -----

DATUM
VERTICAL N/A
HORIZONTAL N/A

646.40 DURABLE 100 mm WHITE LINE
(ALL LINES WILL INCLUDE EDGE LINE BREAKS AND
RADIUS FOR TOWN HIGHWAYS)
SALISBURY:
STA. 2+360.0 - STA. 2+900.0 LT & RT

646.60 TEMPORARY 100 mm WHITE LINE
(ALL LINES WILL INCLUDE EDGE LINE BREAKS AND
RADIUS FOR TOWN HIGHWAYS)
SALISBURY:
STA. 2+360.0 - STA. 2+900.0 LT & RT


646.41 DURABLE 100 mm YELLOW LINE
(ALL LINES WILL INCLUDE C/L BREAKS FOR
TOWN HIGHWAYS) S=SOLID, D=DASHED

SALISBURY:		LT	C	RT
STA. 2+360.0	- STA. 2+671.5	-	D	-
STA. 2+671.5	- STA. 2+864.6	D	-	S
STA. 2+864.6	- STA. 2+900.0	S	-	S

646.61 TEMPORARY 100 mm YELLOW LINE
(ALL LINES WILL INCLUDE C/L BREAKS FOR
TOWN HIGHWAYS) S=SOLID, D=DASHED

SALISBURY:		LT	C	RT
STA. 2+360.0	- STA. 2+671.5	-	D	-
STA. 2+671.5	- STA. 2+864.6	D	-	S
STA. 2+864.6	- STA. 2+900.0	S	-	S

675.50 REMOVING SIGNS
AS SHOWN - I

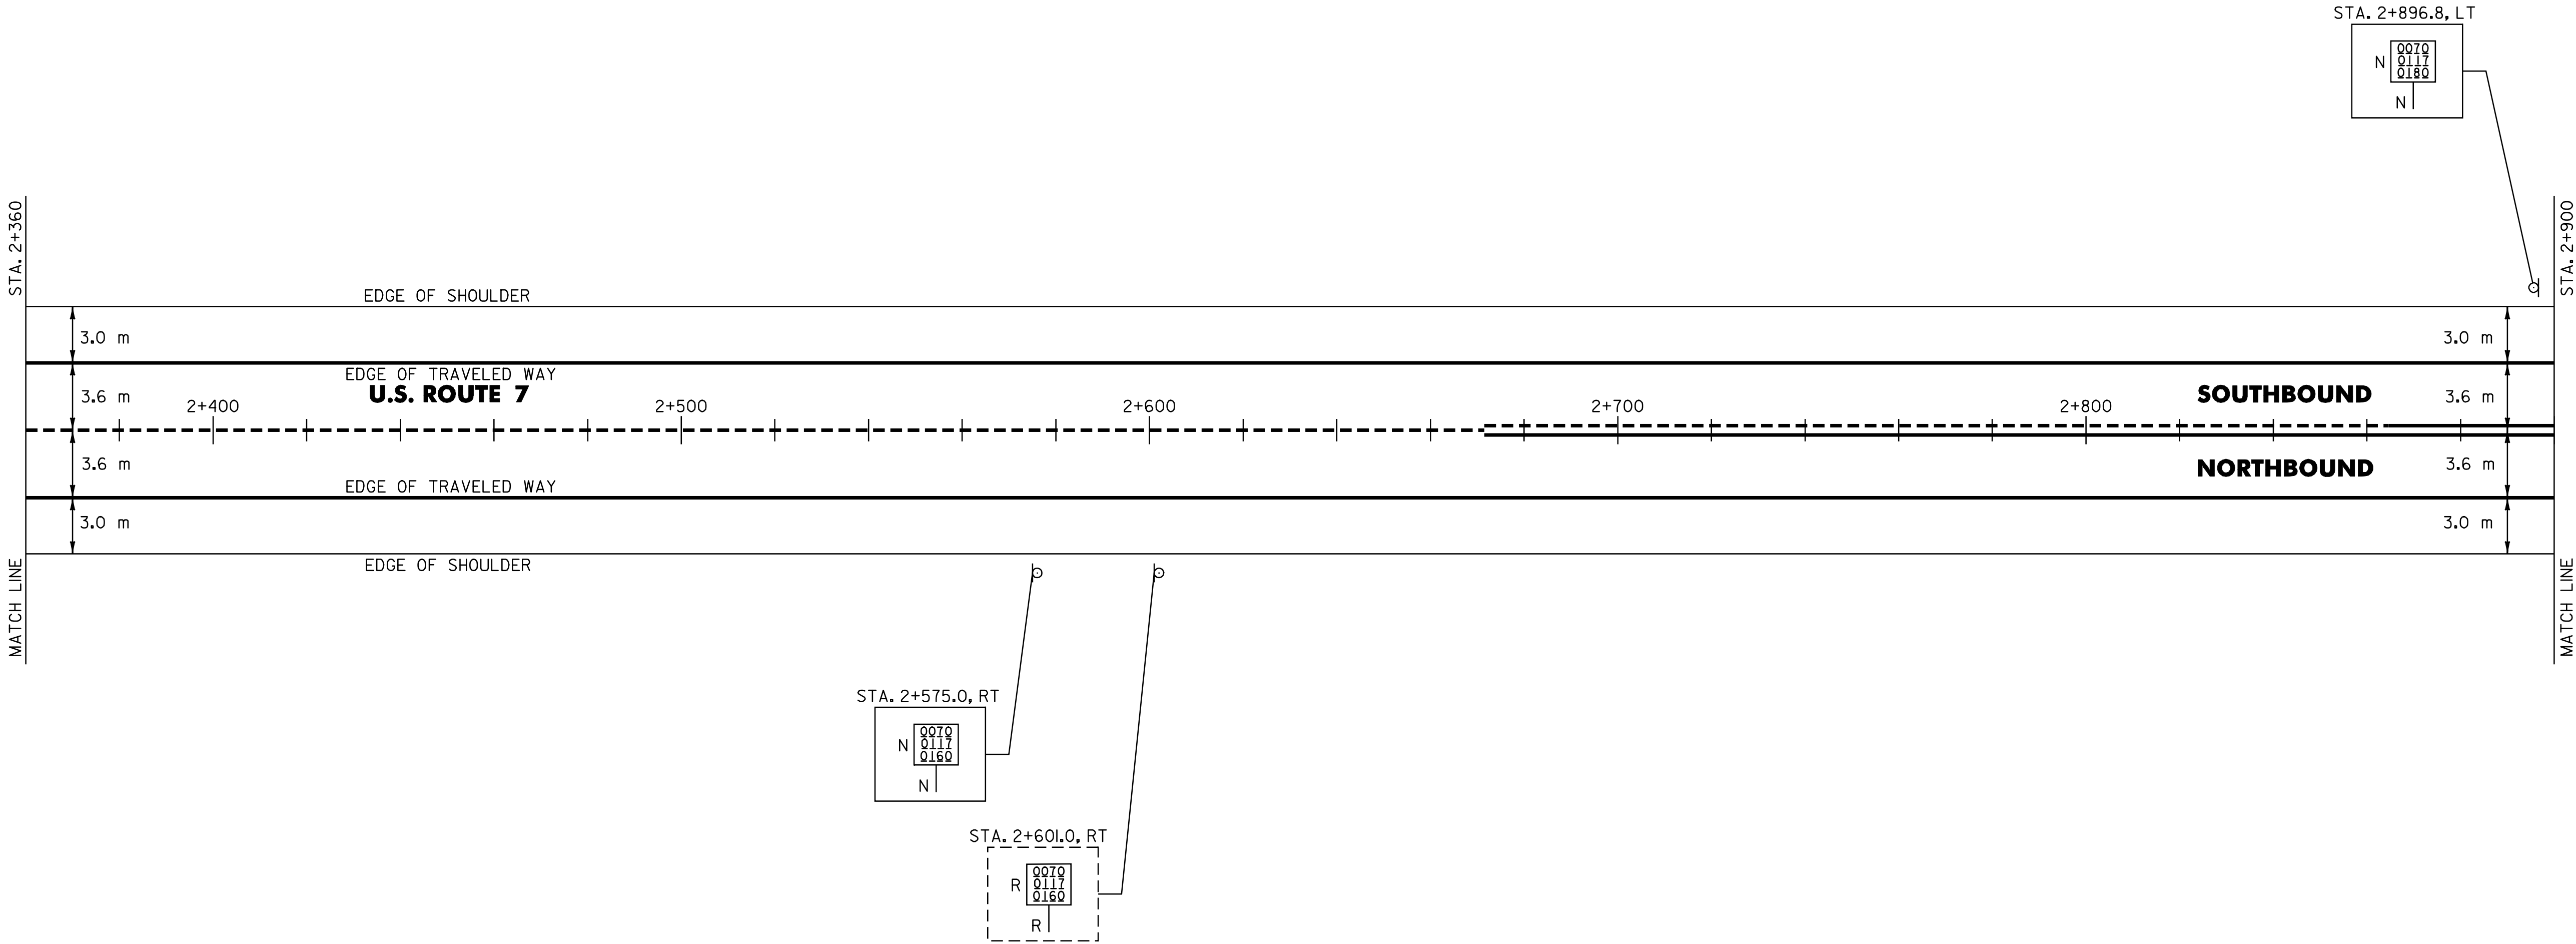

SIGN LEGEND
R= REMOVE
S= SALVAGE
N= NEW
RET= RETAIN
B-B= BACK TO BACK
EXISTING= -----
NEW= _____

PAVING
PROJECT
LAYOUT
2

SURVEYED BY N/A DATE N/A
DRAWN BY C.A.K. DATE 2/02
SQUAD LEADER D.E.G.
DESIGN FILE NO. pb018p02.1 FILE pb018p02.1
IPARM 10 DATE 10-JUL-2006
PROJ. NAME SALISBURY - MIDDLEBURY
PROJ. NO. NH_231111
SHEET 11 OF 67 SHEETS

DATUM
VERTICAL N/A
HORIZONTAL N/A

646.40 DURABLE 100 mm WHITE LINE
(ALL LINES WILL INCLUDE EDGE LINE BREAKS AND
RADIUS FOR TOWN HIGHWAYS)
SALISBURY:
STA. 2+900.0 - STA. 3+440.0 LT & RT

646.60 TEMPORARY 100 mm WHITE LINE
(ALL LINES WILL INCLUDE EDGE LINE BREAKS AND
RADIUS FOR TOWN HIGHWAYS)
SALISBURY:
STA. 2+900.0 - STA. 3+440.0 LT & RT

646.41 DURABLE 100 mm YELLOW LINE
(ALL LINES WILL INCLUDE C/L BREAKS FOR
TOWN HIGHWAYS) S=SOLID, D=DASHED
SALISBURY:
STA. 2+900.0 - STA. 2+912.9 LT S
STA. 2+912.9 - STA. 3+098.0 S - D
STA. 3+098.0 - STA. 3+186.5 - D S
STA. 3+186.5 - STA. 3+323.3 D - S
STA. 3+323.3 - STA. 3+440.0 S - S
STA. 3+337.780 DOUBLE SOLID LT, T-23

646.61 TEMPORARY 100 mm YELLOW LINE
(ALL LINES WILL INCLUDE C/L BREAKS FOR
TOWN HIGHWAYS) S=SOLID, D=DASHED
SALISBURY:
STA. 2+900.0 - STA. 2+912.9 LT S
STA. 2+912.9 - STA. 3+098.0 S - D
STA. 3+098.0 - STA. 3+186.5 - D S
STA. 3+186.5 - STA. 3+323.3 D - S
STA. 3+323.3 - STA. 3+440.0 S - S
STA. 3+337.780 DOUBLE SOLID LT, T-23

646.46 DURABLE 600 mm STOP BAR
SALISBURY:
STA. 3+337.780 LT, T-23


646.66 TEMPORARY 600 mm STOP BAR
SALISBURY:
STA. 3+337.780 LT, T-23

646.50 DURABLE LETTER OR SYMBOL
SALISBURY:
STA. 3+337.780 LT, T-23, "S,T,O,P" (4 EA)

646.70 TEMPORARY LETTER OR SYMBOL
SALISBURY:
STA. 3+337.780 LT, T-23, "S,T,O,P" (4 EA)

675.50 REMOVING SIGNS
AS SHOWN - 9

675.60 ERECTING SALVAGED SIGNS
AS SHOWN - 1

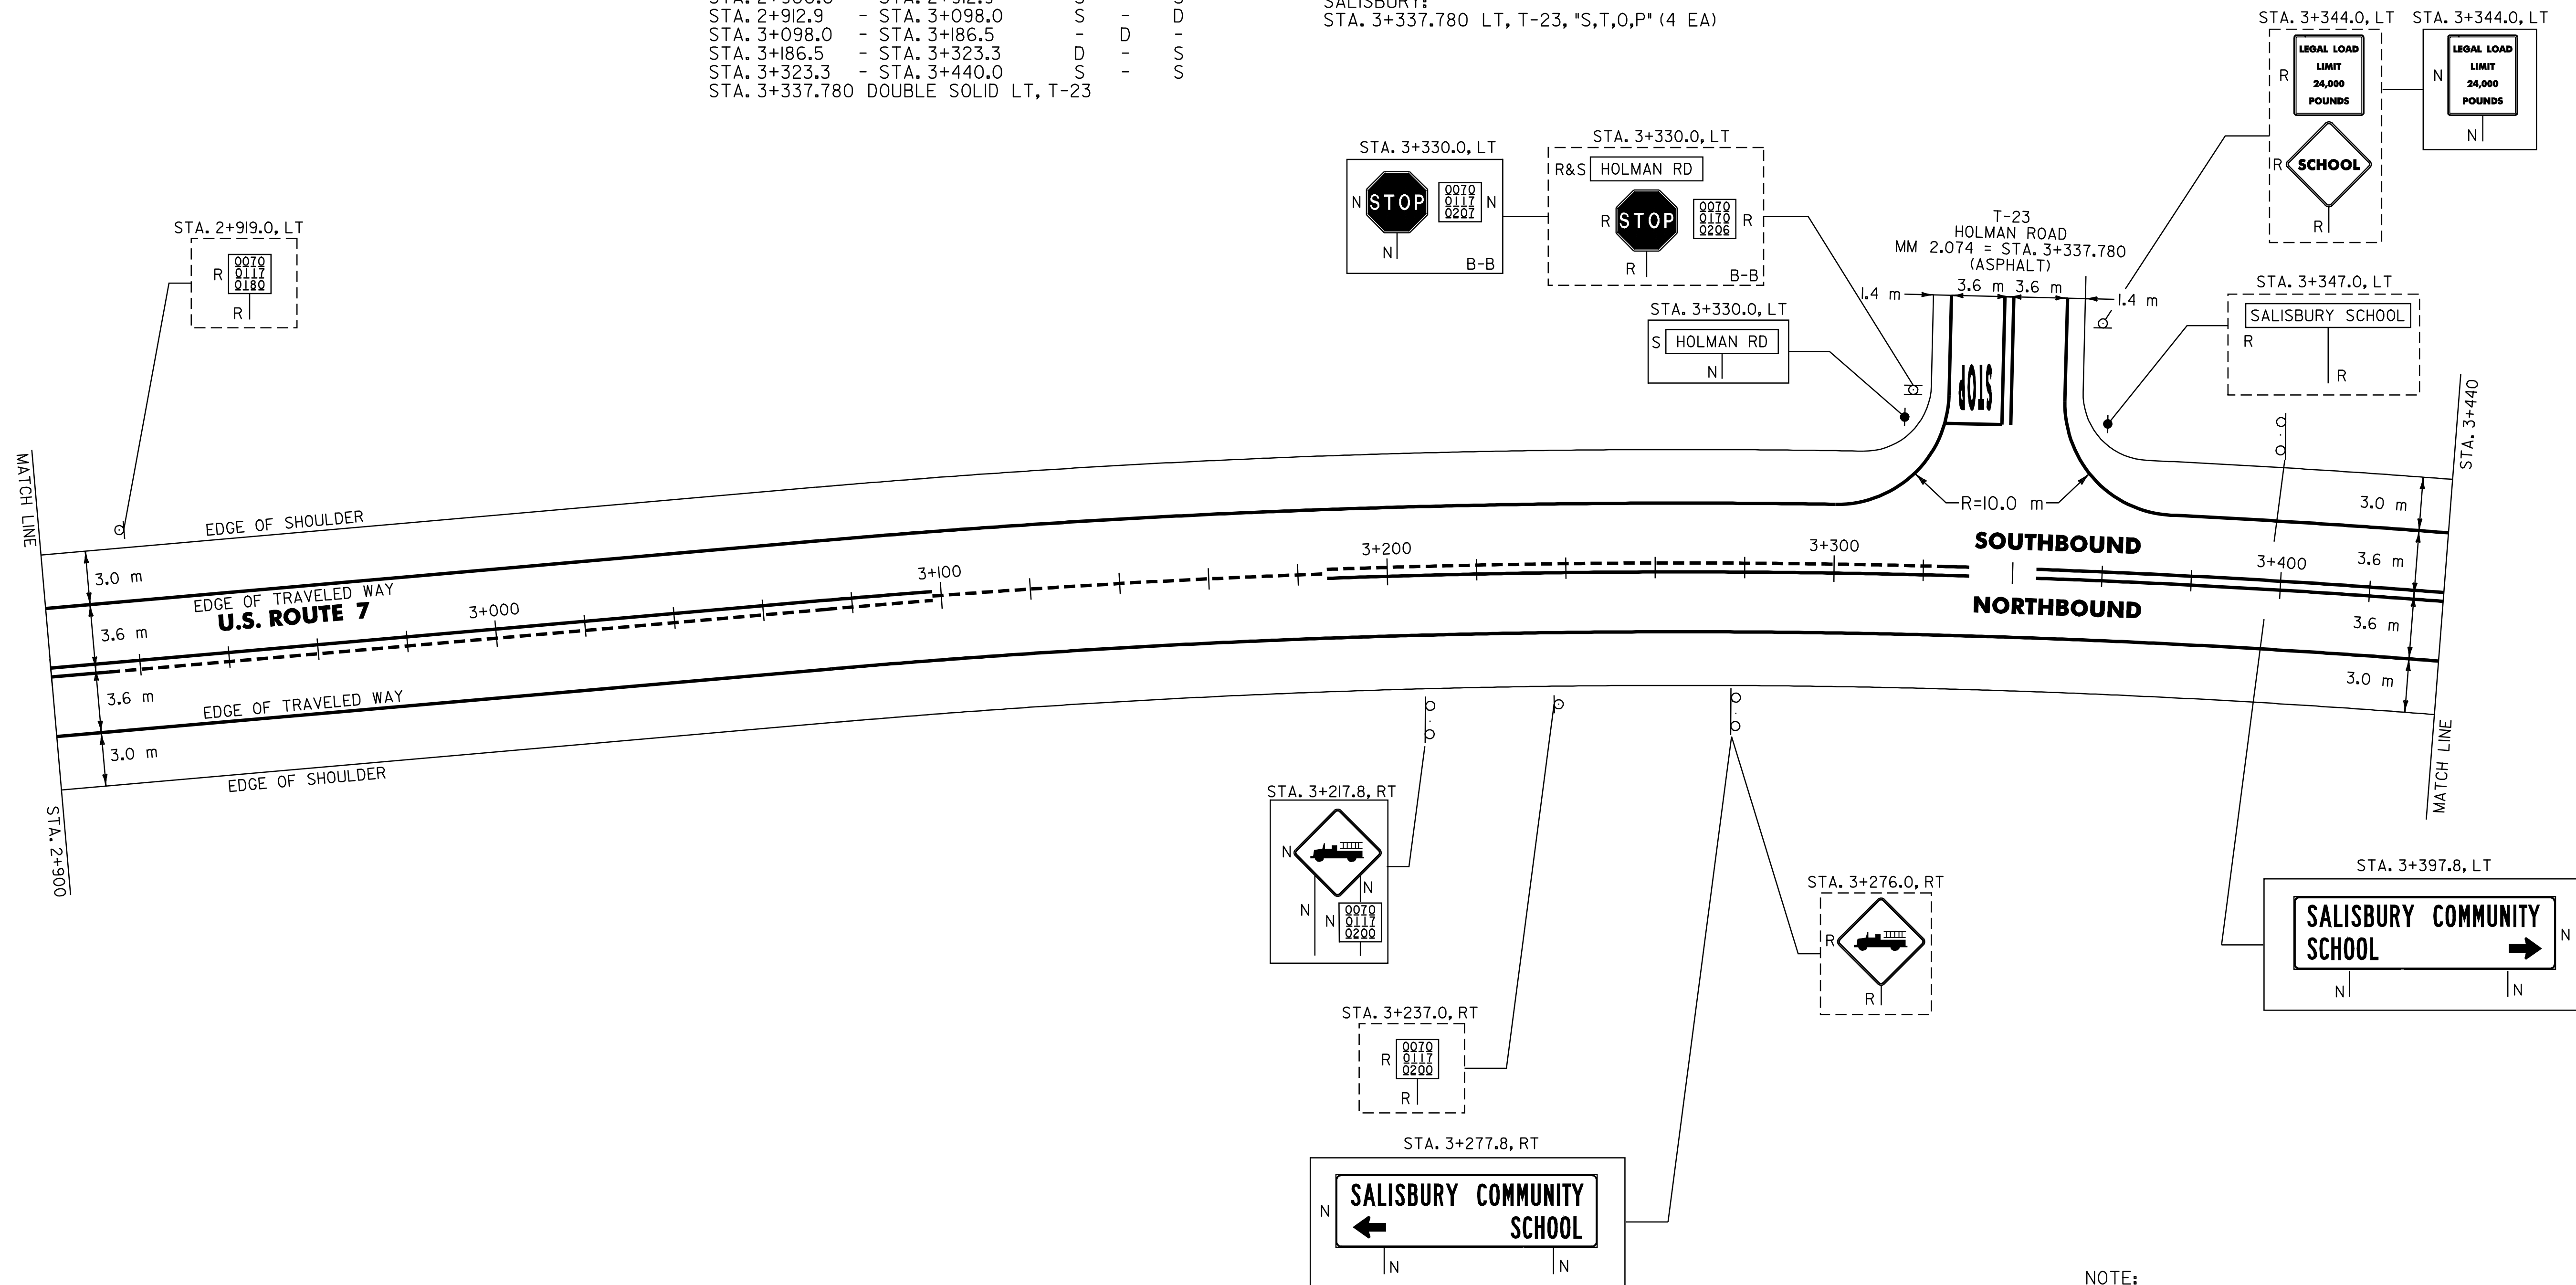

NOTE:
1. PAVING LIMIT ON ALL TOWN HIGHWAYS SHALL BE MEASURED 8 m BACK FROM U.S. ROUTE 7 EDGE OF SHOULDER UNLESS DENOTED OTHERWISE ON THE PLANS OR AS DIRECTED BY THE RESIDENT ENGINEER.

DATUM	
VERTICAL	N/A
HORIZONTAL	N/A

SIGN LEGEND
R= REMOVE
S= SALVAGE
N= NEW
RET= RETAIN
B-B= BACK TO BACK
EXISTING= _____
NEW= _____

PAVING
PROJECT
LAYOUT
3

SURVEYED BY	N/A	DATE	N/A
DRAWN BY	C.A.K.	DATE	2/02
SQUAD LEADER	D.E.G.		
DESIGN FILE NO.	PAVE/01b018/02b018.dgn		
IPARM FILE	02b018p03.i	DATE PLOTTED	10-JUL-2006 13:51
PROJ. NAME	SALISBURY - MIDDLEBURY		
PROJ. NO.	NH_231111		
SHEET	12	OF	67
SHEETS			

646.40 DURABLE 100 mm WHITE LINE
(ALL LINES WILL INCLUDE EDGE LINE BREAKS AND
RADIUS FOR TOWN HIGHWAYS)
SALISBURY:
STA. 3+440.0 - STA. 3+980.0 LT & RT

646.60 TEMPORARY 100 mm WHITE LINE
(ALL LINES WILL INCLUDE EDGE LINE BREAKS AND
RADIUS FOR TOWN HIGHWAYS)
SALISBURY:
STA. 3+440.0 - STA. 3+980.0 LT & RT


646.41 DURABLE 100 mm YELLOW LINE
(ALL LINES WILL INCLUDE C/L BREAKS FOR
TOWN HIGHWAYS) S=SOLID, D=DASHED

SALISBURY: LT CL RT
STA. 3+440.0 - STA. 3+540.6 S - S
STA. 3+540.6 - STA. 3+806.0 S - D
STA. 3+806.0 - STA. 3+980.0 D - S

646.61 TEMPORARY 100 mm YELLOW LINE
(ALL LINES WILL INCLUDE C/L BREAKS FOR
TOWN HIGHWAYS) S=SOLID, D=DASHED

SALISBURY: LT CL RT
STA. 3+440.0 - STA. 3+540.6 S - S
STA. 3+540.6 - STA. 3+806.0 S - D
STA. 3+806.0 - STA. 3+980.0 D - S

675.50 REMOVING SIGNS
AS SHOWN - 7

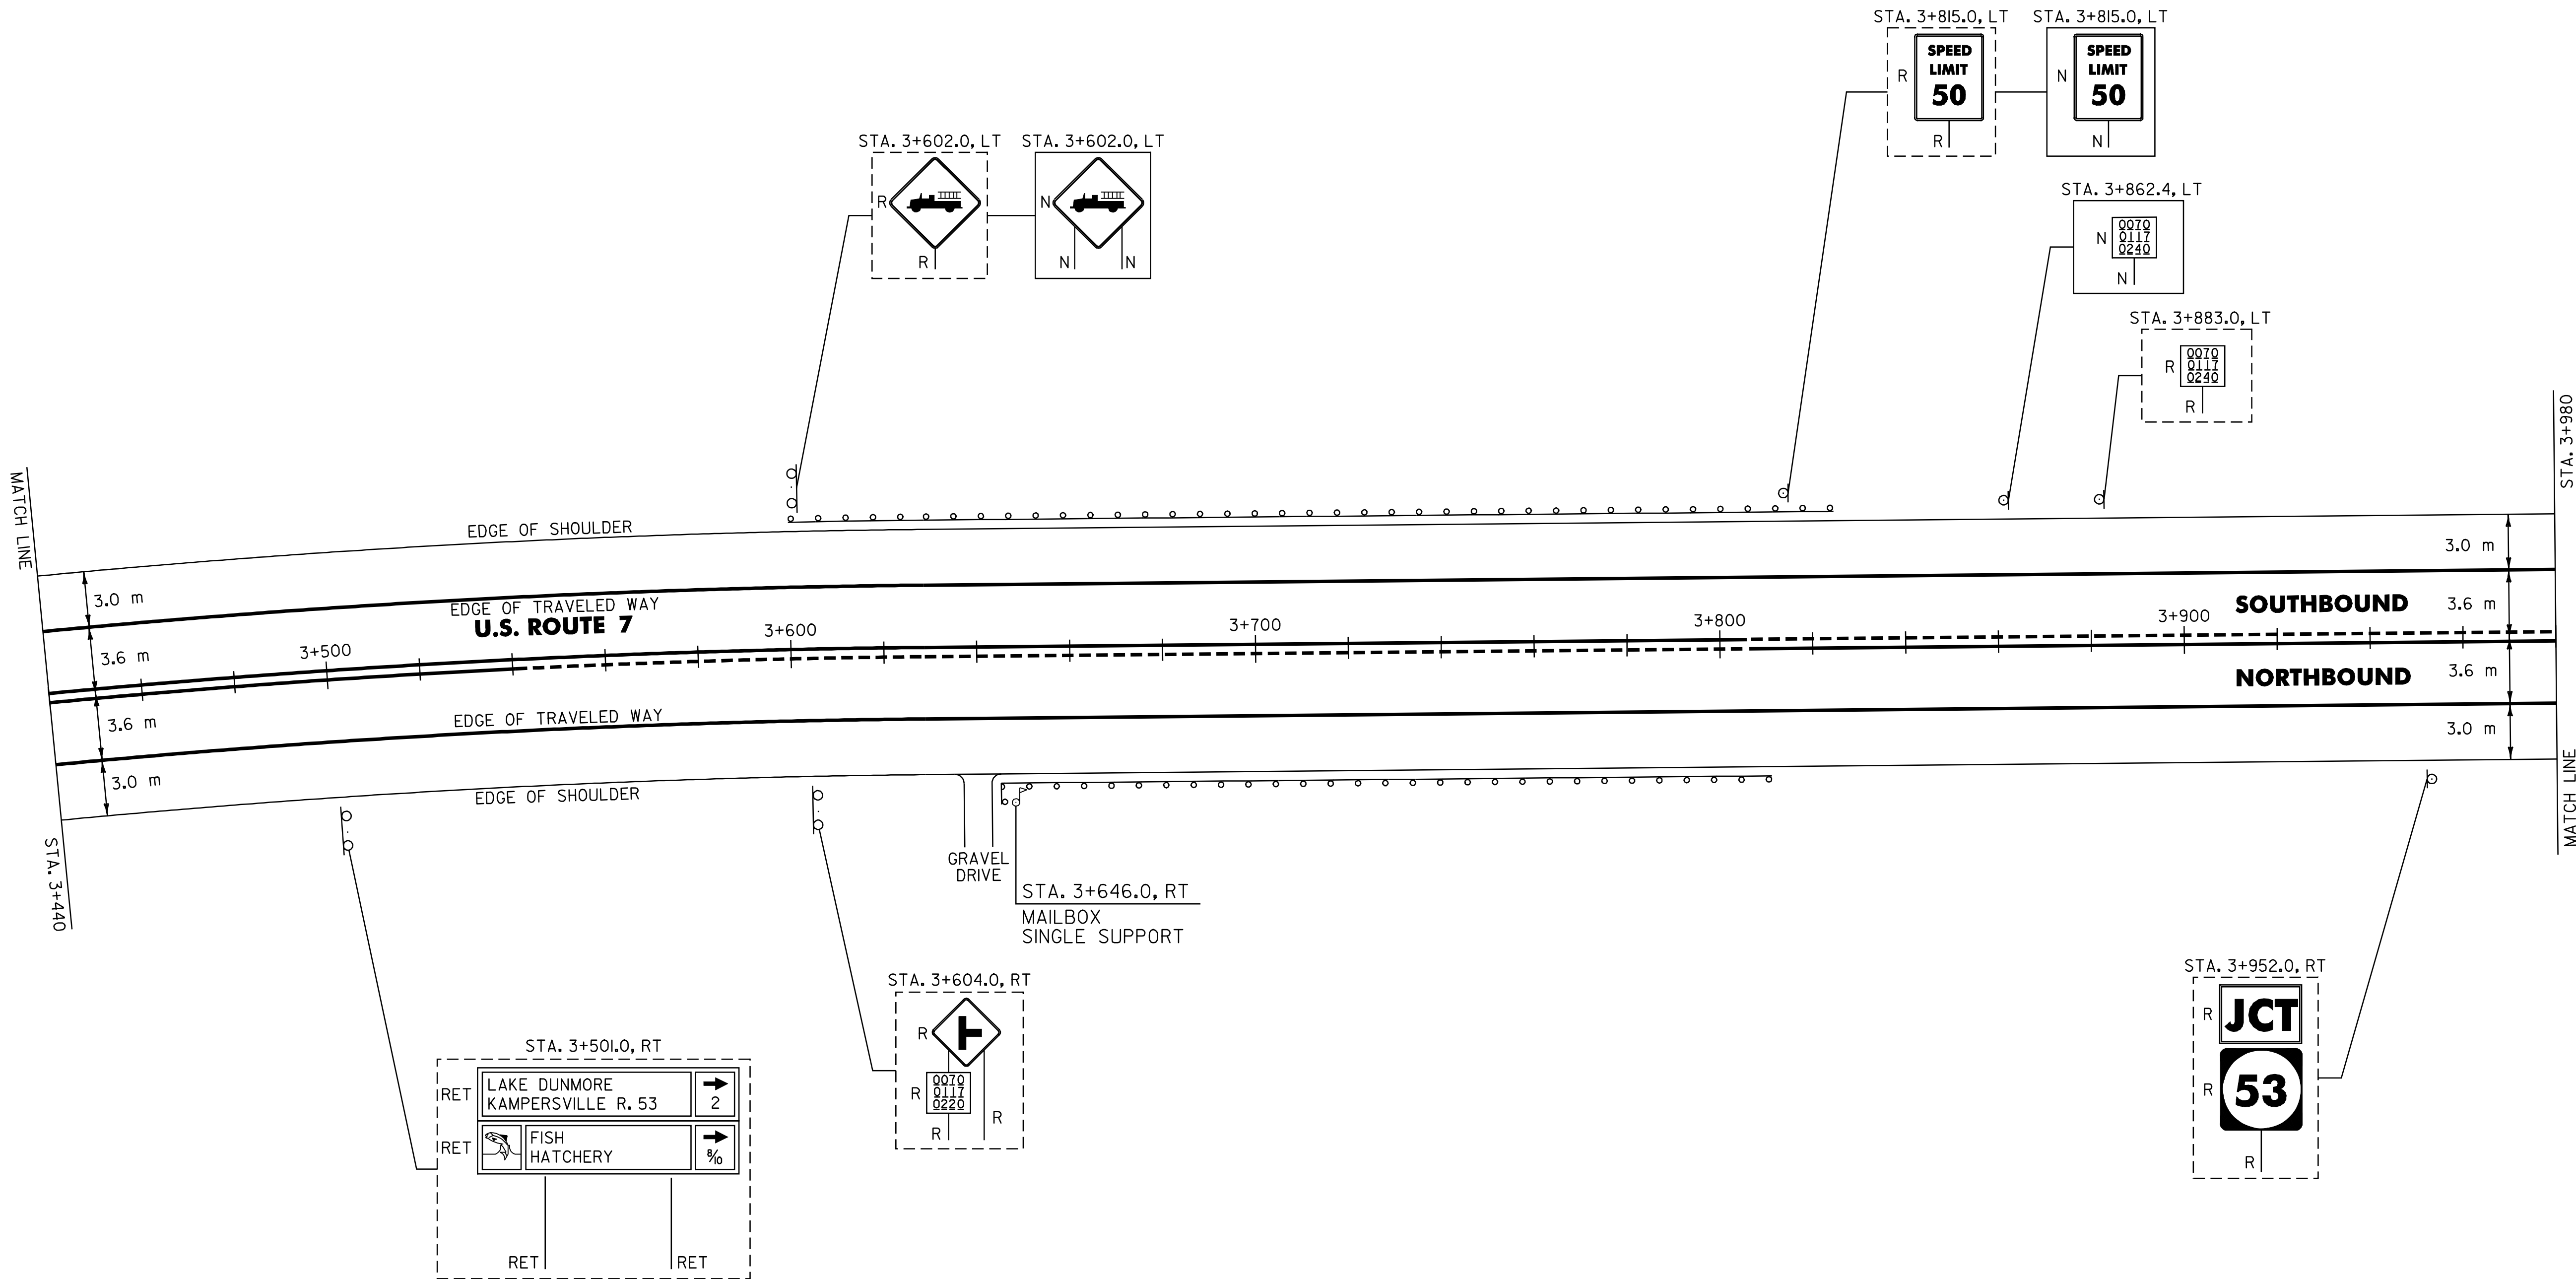

621.20 STEEL BEAM GUARDRAIL

SALISBURY:
STA. 3+605.5 - STA. 3+814.5 LT (~~209.0 m~~) (205.74 m)
STA. 3+654.8 - STA. 3+797.8 RT (~~152.0 m~~) (144.78 m)

621.505 MANUFACTURED TERMINAL SECTION (FLARED)

SALISBURY:
STA. 3+594.1 - STA. 3+605.5 LT
STA. 3+643.4 - STA. 3+654.8 RT
STA. 3+814.5 - STA. 3+825.9 LT
STA. 3+797.8 - STA. 3+809.2 RT

621.80 REMOVAL AND DISPOSAL OF GUARDRAIL

SALISBURY:
STA. 3+595.0 - STA. 3+825.0 LT (230.0 m)
STA. 3+642.0 - STA. 3+806.0 RT (171.6 m)

617.10 RELOCATE MAILBOX, SINGLE SUPPORT

SALISBURY:
STA. 3+646.0 RT

SIGN LEGEND
R= REMOVE
S= SALVAGE
N= NEW
RET= RETAIN
B-B= BACK TO BACK
EXISTING= -----
NEW= _____

PAVING
PROJECT
LAYOUT
4

SURVEYED BY N/A DATE N/A
DRAWN BY C.A.K. DATE 2/02
SQUAD LEADER D.E.G.
DESIGN FILE NO. pave/01b018/pb018.dgn
IPARM pb018p04.1 DATE 10-JUL-2006 13:
FILE 10-JUL-2006 13:
PROJ. NAME SALISBURY - MIDDLEBURY
PROJ. NO. NH_231111
SHEET 13 OF 67 SHEETS -----

DATUM
VERTICAL N/A
HORIZONTAL N/A

SALISBURY:
STA. 3+980.0 - STA. 4+520.0 LT & RT

SALISBURY:
STA. 3+980.0 - STA. 4+520.0 LT & RT

SALISBURY:		LT	Q	RT
STA. 3+980.0 - STA. 4+168.2		D	-	S
STA. 4+168.2 - STA. 4+520.0		S	-	S
STA. 4+240.62	DOUBLE SOLID RT, T-3			

SALISBURY:		LT	Q	RT
STA. 3+980.0 - STA. 4+168.2		D	-	S
STA. 4+168.2 - STA. 4+520.0		S	-	S
STA. 4+240.62	DOUBLE SOLID RT, T-3			

SALISBURY:
STA. 4+240.621 RT, T-3

SALISBURY:
STA. 4+240.62I RT, T-3

SALISBURY:
STA. 4+240.62I RT, T-3, "S,T,O,P" (4 EA)

SALISBURY:
STA. 4+240.62I RT, T-3, "S,T,O,P" (4 EA)


AS SHOWN - 39

SALISBURY:
STA. 4+184.2 - STA. 4+226.0 RT ~~(57.0 m)~~ (60.96 m)
STA. 4+194.4 - STA. 4+373.0 LT ~~(178.6 m)~~ (186.69 m)

SALISBURY:
STA. 4+226.0 RT (ON T-3)

SALISBURY:
STA. 4+172.8 - STA. 4+184.2 RT
STA. 4+183.0 - STA. 4+194.4 LT
~~STA. 4+373.0 - STA. 4+384.4 LT~~
STA. 4+381.1 - STA. 4+392.5 LT

SALISBURY:
STA. 4+175.0 - STA. 4+226.0 RT (81.4 m)
STA. 4+183.0 - STA. 4+383.0 LT (200.0 m)

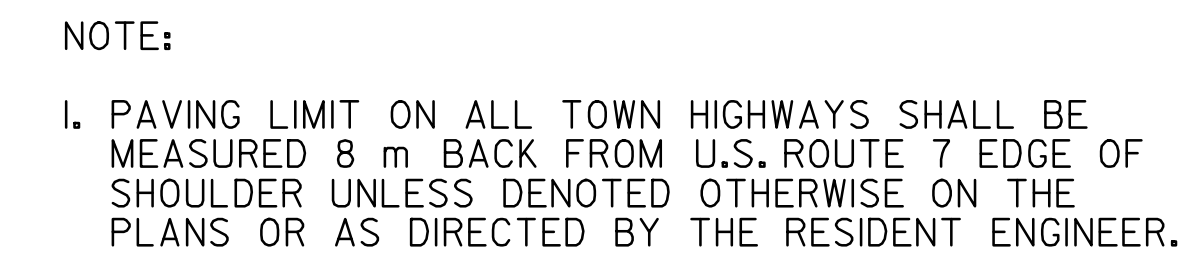

PAVING PROJECT LAYOUT # 5

SURVEYED BY N/A DATE N/A
DRAWN BY C.A.K. DATE 2/02
SQUAD LEADER D.E.G.
DESIGN FILE NO. pave/0lb018/pb018.dgn
IPARM pb018p05.i DATE 10-JUL-2006
FILE 13 PLOTTED
PROJ. NAME SALISBURY -- MIDDLEBURY
PROJ. NO. NH_231(K)S
SHEET 14 OF 67 SHEETS -----

DATUM _____
VERTICAL N/A _____
HORIZONTAL N/A _____

646.40 DURABLE 100 mm WHITE LINE
(ALL LINES WILL INCLUDE EDGE LINE BREAKS AND
RADIUS FOR TOWN HIGHWAYS)
SALISBURY:
STA. 4+520.0 - STA. 5+060.0 LT & RT

646.60 TEMPORARY 100 mm WHITE LINE
(ALL LINES WILL INCLUDE EDGE LINE BREAKS AND
RADIUS FOR TOWN HIGHWAYS)
SALISBURY:
STA. 4+520.0 - STA. 5+060.0 LT & RT


646.41 DURABLE 100 mm YELLOW LINE
(ALL LINES WILL INCLUDE C/L BREAKS FOR
TOWN HIGHWAYS) S=SOLID, D=DASHED

SALISBURY:
STA. 4+520.0 - STA. 4+894.0 LT S
STA. 4+894.0 - STA. 5+060.0 S

646.61 TEMPORARY 100 mm YELLOW LINE
(ALL LINES WILL INCLUDE C/L BREAKS FOR
TOWN HIGHWAYS) S=SOLID, D=DASHED

SALISBURY:
STA. 4+520.0 - STA. 4+894.0 LT S
STA. 4+894.0 - STA. 5+060.0 S

675.50 REMOVING SIGNS
AS SHOWN - 5

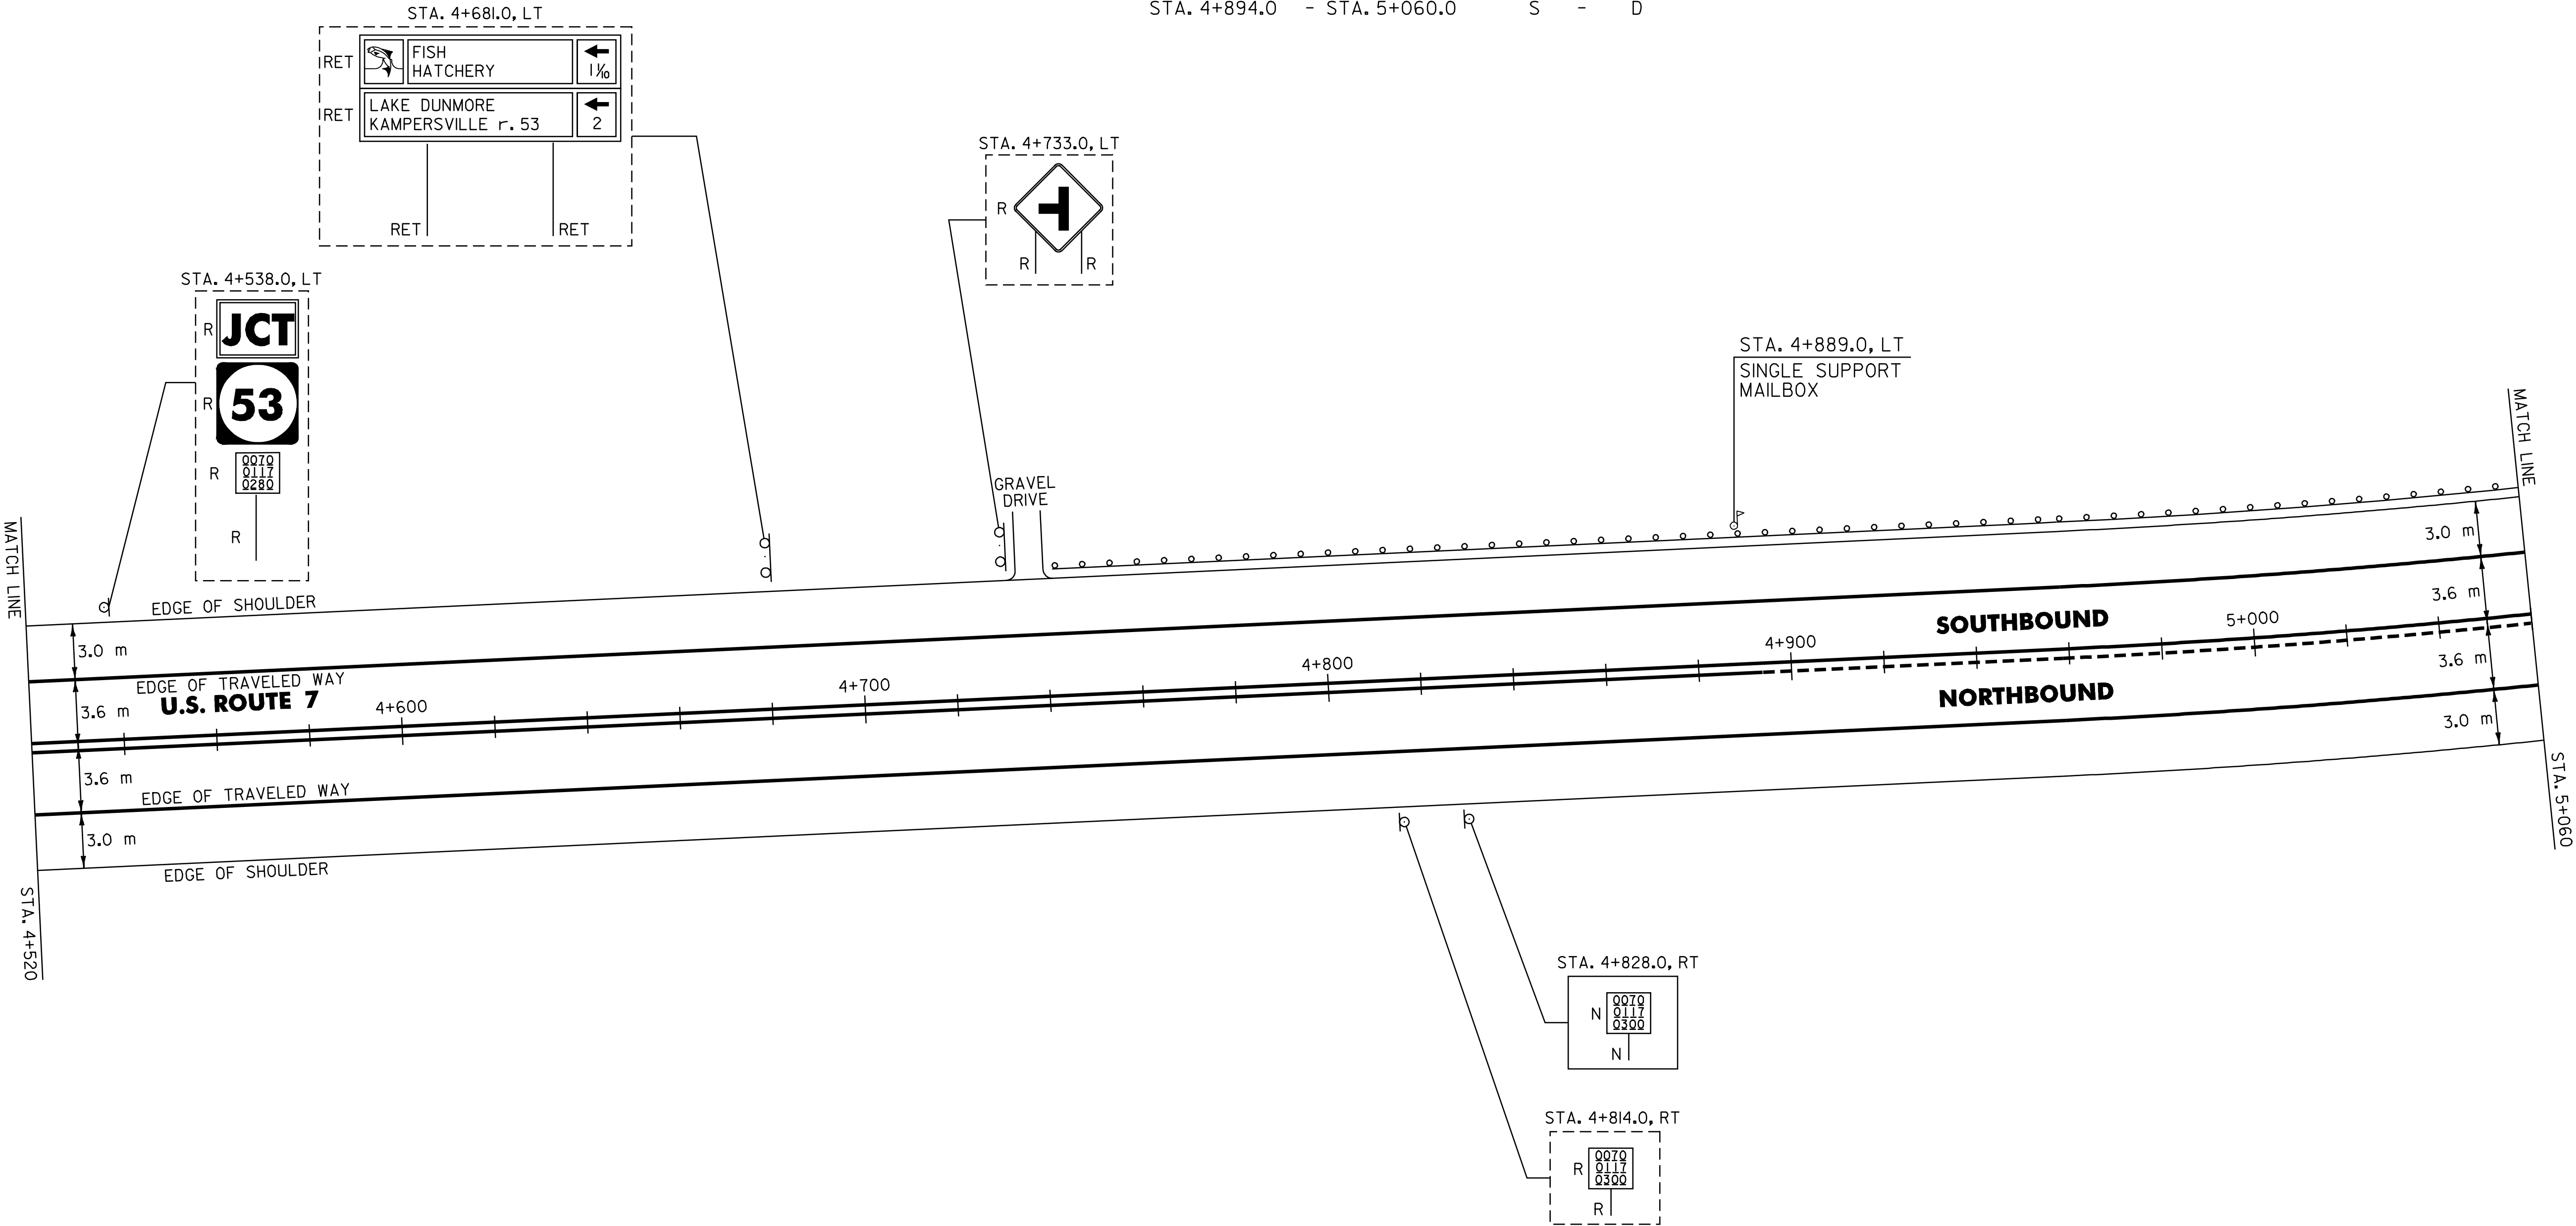

621.20 STEEL BEAM GUARDRAIL
SALISBURY:
STA. 4+754.4 - STA. 5+060.0 LT (305.6 m)
STA. 5+069.8 LT (315.4 m)

621.505 MANUFACTURED TERMINAL SECTION (FLARED)
SALISBURY:
STA. 4+743.0 - STA. 4+754.4 LT

621.80 REMOVAL AND DISPOSAL OF GUARDRAIL
SALISBURY:
STA. 4+743.0 - STA. 5+060.0 LT (317.0 m)

617.10 RELOCATE MAILBOX, SINGLE SUPPORT
SALISBURY:
STA. 4+889.0 LT

SIGN LEGEND
R= REMOVE
S= SALVAGE
N= NEW
RET= RETAIN
B-B= BACK TO BACK
EXISTING= -----
NEW= _____

PAVING
PROJECT
LAYOUT
6

SURVEYED BY N/A DATE N/A
DRAWN BY C.A.K. DATE 2/02
SQUAD LEADER D.E.G.
DESIGN FILE NO. pgve/01b018/pb018.dgn
IPARM pb018p06.i DATE 10-JUL-2006 13:
FILE PLOTTED
PROJ. NAME SALISBURY - MIDDLEBURY
PROJ. NO. NH_231111S
SHEET 15 OF 67 SHEETS -----

DATUM
VERTICAL N/A
HORIZONTAL N/A

646.40 DURABLE 100 mm WHITE LINE
(ALL LINES WILL INCLUDE EDGE LINE BREAKS AND
RADIUS FOR TOWN HIGHWAYS)
SALISBURY:
STA. 5+060.0 - STA. 5+600.0 LT & RT

646.60 TEMPORARY 100 mm WHITE LINE
(ALL LINES WILL INCLUDE EDGE LINE BREAKS AND
RADIUS FOR TOWN HIGHWAYS)
SALISBURY:
STA. 5+060.0 - STA. 5+600.0 LT & RT

646.41 DURABLE 100 mm YELLOW LINE
(ALL LINES WILL INCLUDE C/L BREAKS FOR
TOWN HIGHWAYS) S=SOLID, D=DASHED
SALISBURY:
STA. 5+060.0 - STA. 5+100.0 LT S D RT
STA. 5+100.0 - STA. 5+116.0 S D D
STA. 5+116.0 - STA. 5+296.0 D S S
STA. 5+296.0 - STA. 5+600.0 S S S
STA. 5+309.226 DOUBLE SOLID RT, T-9

646.61 TEMPORARY 100 mm YELLOW LINE
(ALL LINES WILL INCLUDE C/L BREAKS FOR
TOWN HIGHWAYS) S=SOLID, D=DASHED
SALISBURY:
STA. 5+060.0 - STA. 5+100.0 LT S D RT
STA. 5+100.0 - STA. 5+116.0 S D D
STA. 5+116.0 - STA. 5+296.0 D S S
STA. 5+296.0 - STA. 5+600.0 S S S
STA. 5+309.226 DOUBLE SOLID RT, T-9

646.46 DURABLE 600 mm STOP BAR
SALISBURY:
STA. 5+309.226 RT, T-9


646.66 TEMPORARY 600 mm STOP BAR
SALISBURY:
STA. 5+309.226 RT, T-9

646.50 DURABLE LETTER OR SYMBOL
SALISBURY:
STA. 5+309.226 RT, T-9, "S,T,O,P" (4 EA)

646.70 TEMPORARY LETTER OR SYMBOL
SALISBURY:
STA. 5+309.226 RT, T-9, "S,T,O,P" (4 EA)

675.50 REMOVING SIGNS
AS SHOWN - 6

675.60 ERECTING SALVAGED SIGNS
AS SHOWN - 1

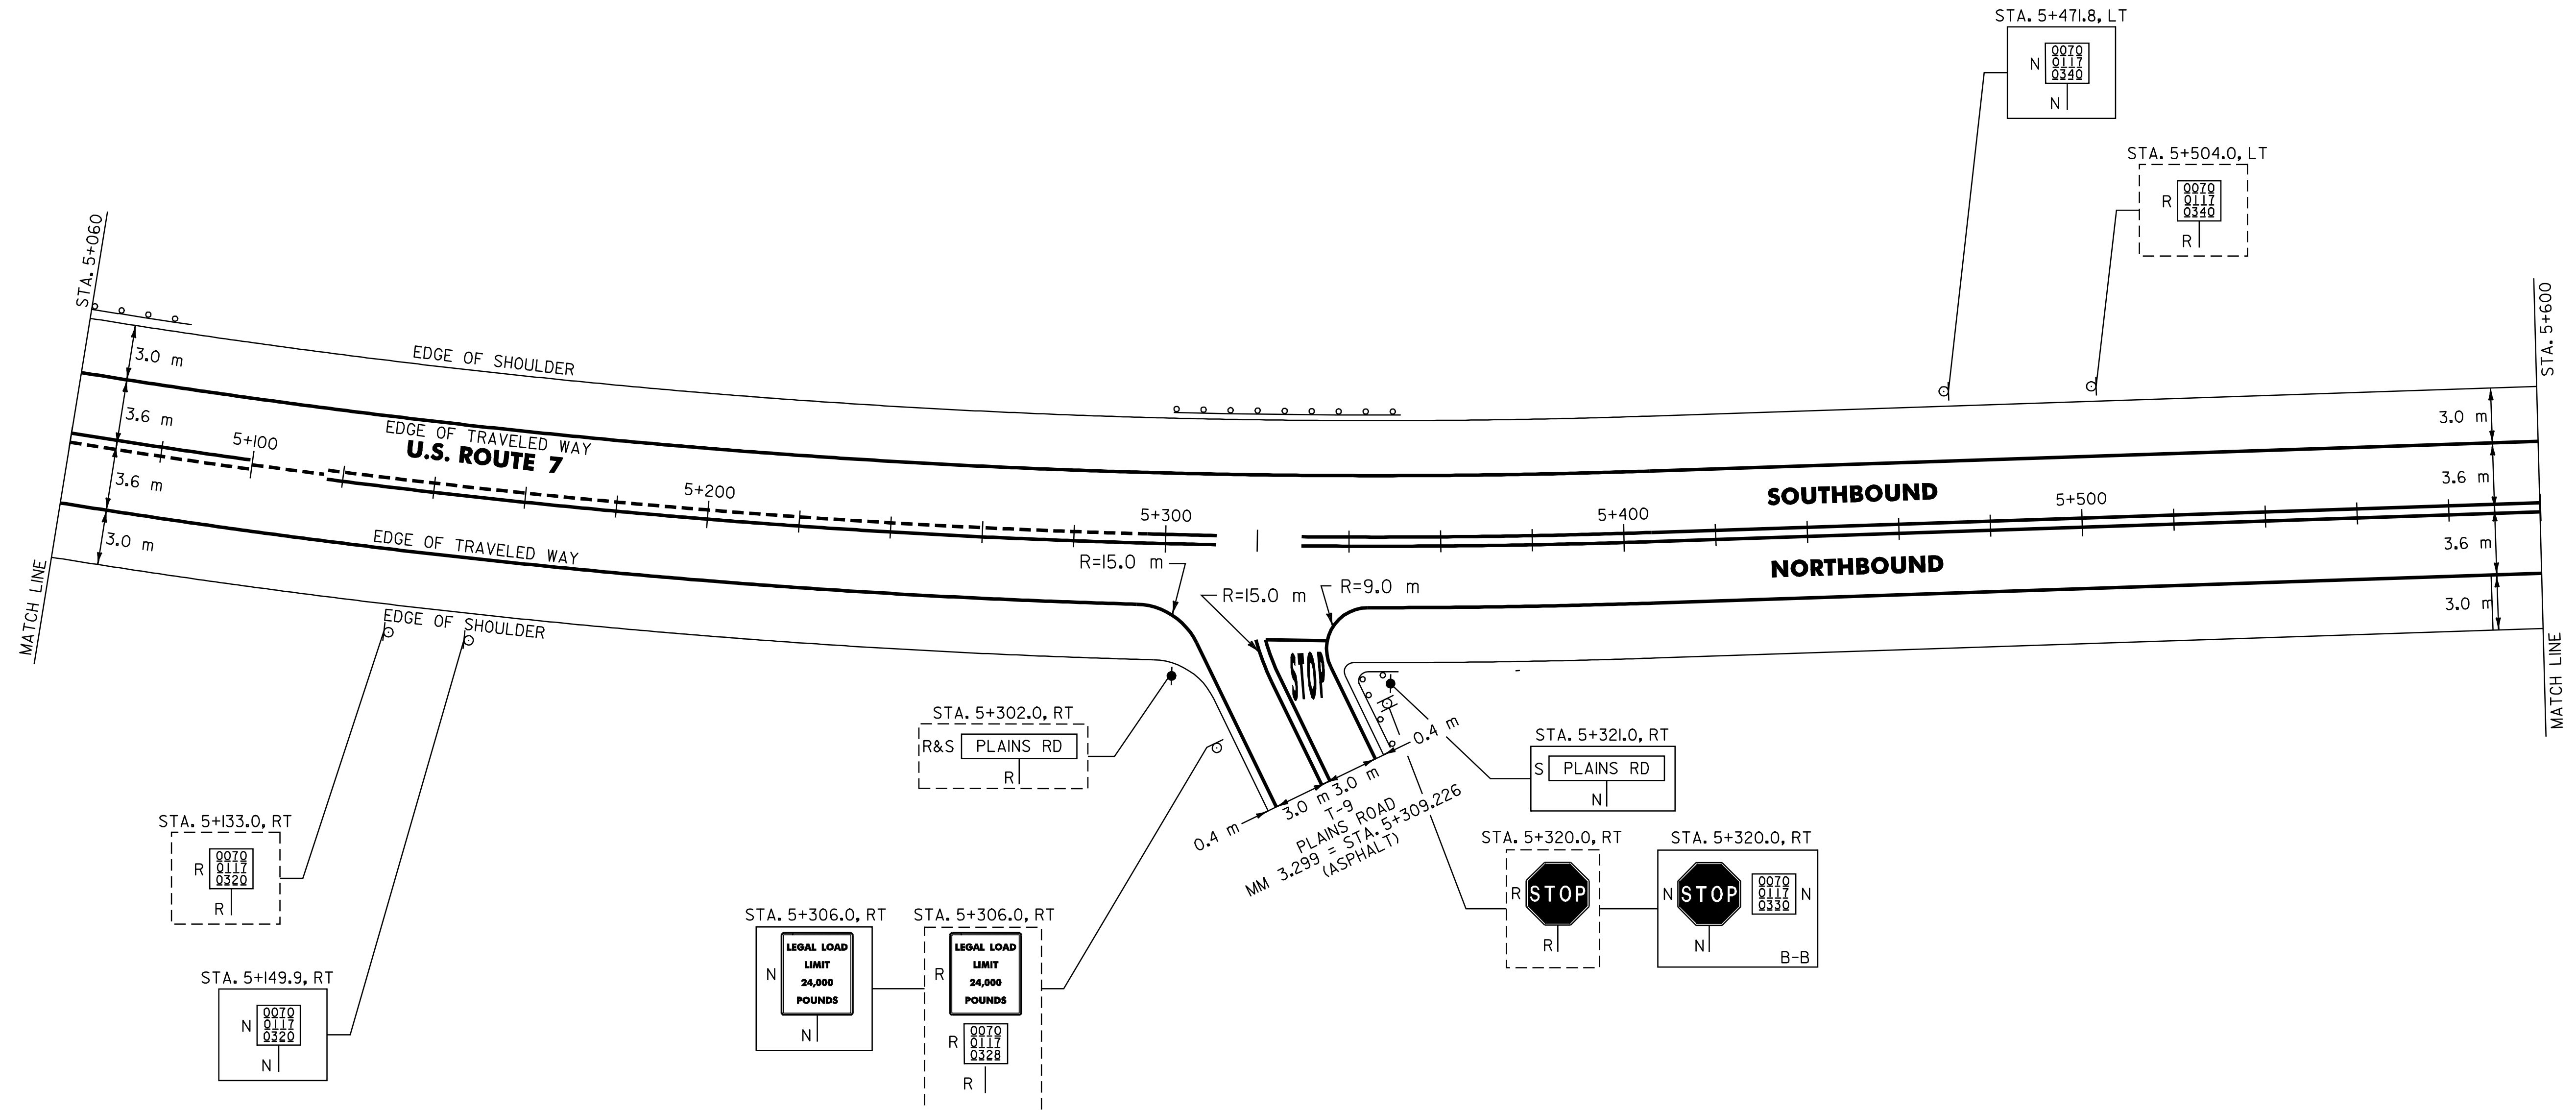

621.20 STEEL BEAM GUARDRAIL
SALISBURY: SEE SHEET 15
~~STA. 5+060.0 - STA. 5+069.8 LT (9.8 m)~~
STA. 5+313.4 - STA. 5+340.0 LT (26.6 m)
STA. 5+323.0 - STA. 5+338.0 RT (26.6 m)
(30.48 m)

621.505 MANUFACTURED TERMINAL SECTION
SALISBURY:
STA. 5+323.0 RT (ON T-9)

621.505 MANUFACTURED TERMINAL SECTION (FLARED)
SALISBURY:
STA. 5+069.8 - STA. 5+081.2 LT
STA. 5+302.0 - STA. 5+313.4 LT
STA. 5+338.0 - STA. 5+349.4 RT
STA. 5+340.0 - STA. 5+351.4 LT

621.80 REMOVAL AND DISPOSAL OF GUARDRAIL
SALISBURY:
STA. 5+060.0 - STA. 5+078.0 LT (18.0 m)
STA. 5+302.0 - STA. 5+349.0 LT (47.0 m)
STA. 5+323.0 - STA. 5+346.0 RT (49.6 m)

NOTE:
1. PAVING LIMIT ON ALL TOWN HIGHWAYS SHALL BE
MEASURED 8 m BACK FROM U.S. ROUTE 7 EDGE OF
SHOULDER UNLESS DENOTED OTHERWISE ON THE
PLANS OR AS DIRECTED BY THE RESIDENT ENGINEER.

DATUM	
VERTICAL	N/A
HORIZONTAL	N/A

SIGN LEGEND
R= REMOVE
S= SALVAGE
N= NEW
RET= RETAIN
B-B= BACK TO BACK
EXISTING= -----
NEW= -----

PAVING
PROJECT
LAYOUT
7

SURVEYED BY N/A DATE N/A
DRAWN BY C.A.K. DATE 2/02
SQUAD LEADER D.E.G.
DESIGN FILE NO. pave/01b018/pb018.dgn
IPARM pb018p07.i DATE 10-JUL-2006 13:5
FILE PLOT
PROJ. NAME SALISBURY - MIDDLEBURY
PROJ. NO. NH_231115
SHEET J6 OF 67 SHEETS


646.40 DURABLE 100 mm WHITE LINE
(ALL LINES WILL INCLUDE EDGE LINE BREAKS AND
RADIUS FOR TOWN HIGHWAYS)
SALISBURY:
STA. 5+600.0 - STA. 6+140.0 LT & RT

646.60 TEMPORARY 100 mm WHITE LINE
(ALL LINES WILL INCLUDE EDGE LINE BREAKS AND
RADIUS FOR TOWN HIGHWAYS)
SALISBURY:
STA. 5+600.0 - STA. 6+140.0 LT & RT

646.41 DURABLE 100 mm YELLOW LINE
(ALL LINES WILL INCLUDE C/L BREAKS FOR
TOWN HIGHWAYS) S=SOLID, D=DASHED
SALISBURY:
STA. 5+600.0 - STA. 5+632.7 LT C RT
STA. 5+632.7 - STA. 5+858.0 S - D
STA. 5+858.0 - STA. 6+035.0 - D -
STA. 6+035.0 - STA. 6+140.0 D - S

646.61 TEMPORARY 100 mm YELLOW LINE
(ALL LINES WILL INCLUDE C/L BREAKS FOR
TOWN HIGHWAYS) S=SOLID, D=DASHED
SALISBURY:
STA. 5+600.0 - STA. 5+632.7 LT C RT
STA. 5+632.7 - STA. 5+858.0 S - D
STA. 5+858.0 - STA. 6+035.0 - D -
STA. 6+035.0 - STA. 6+140.0 D - S

675.50 REMOVING SIGNS
AS SHOWN - I

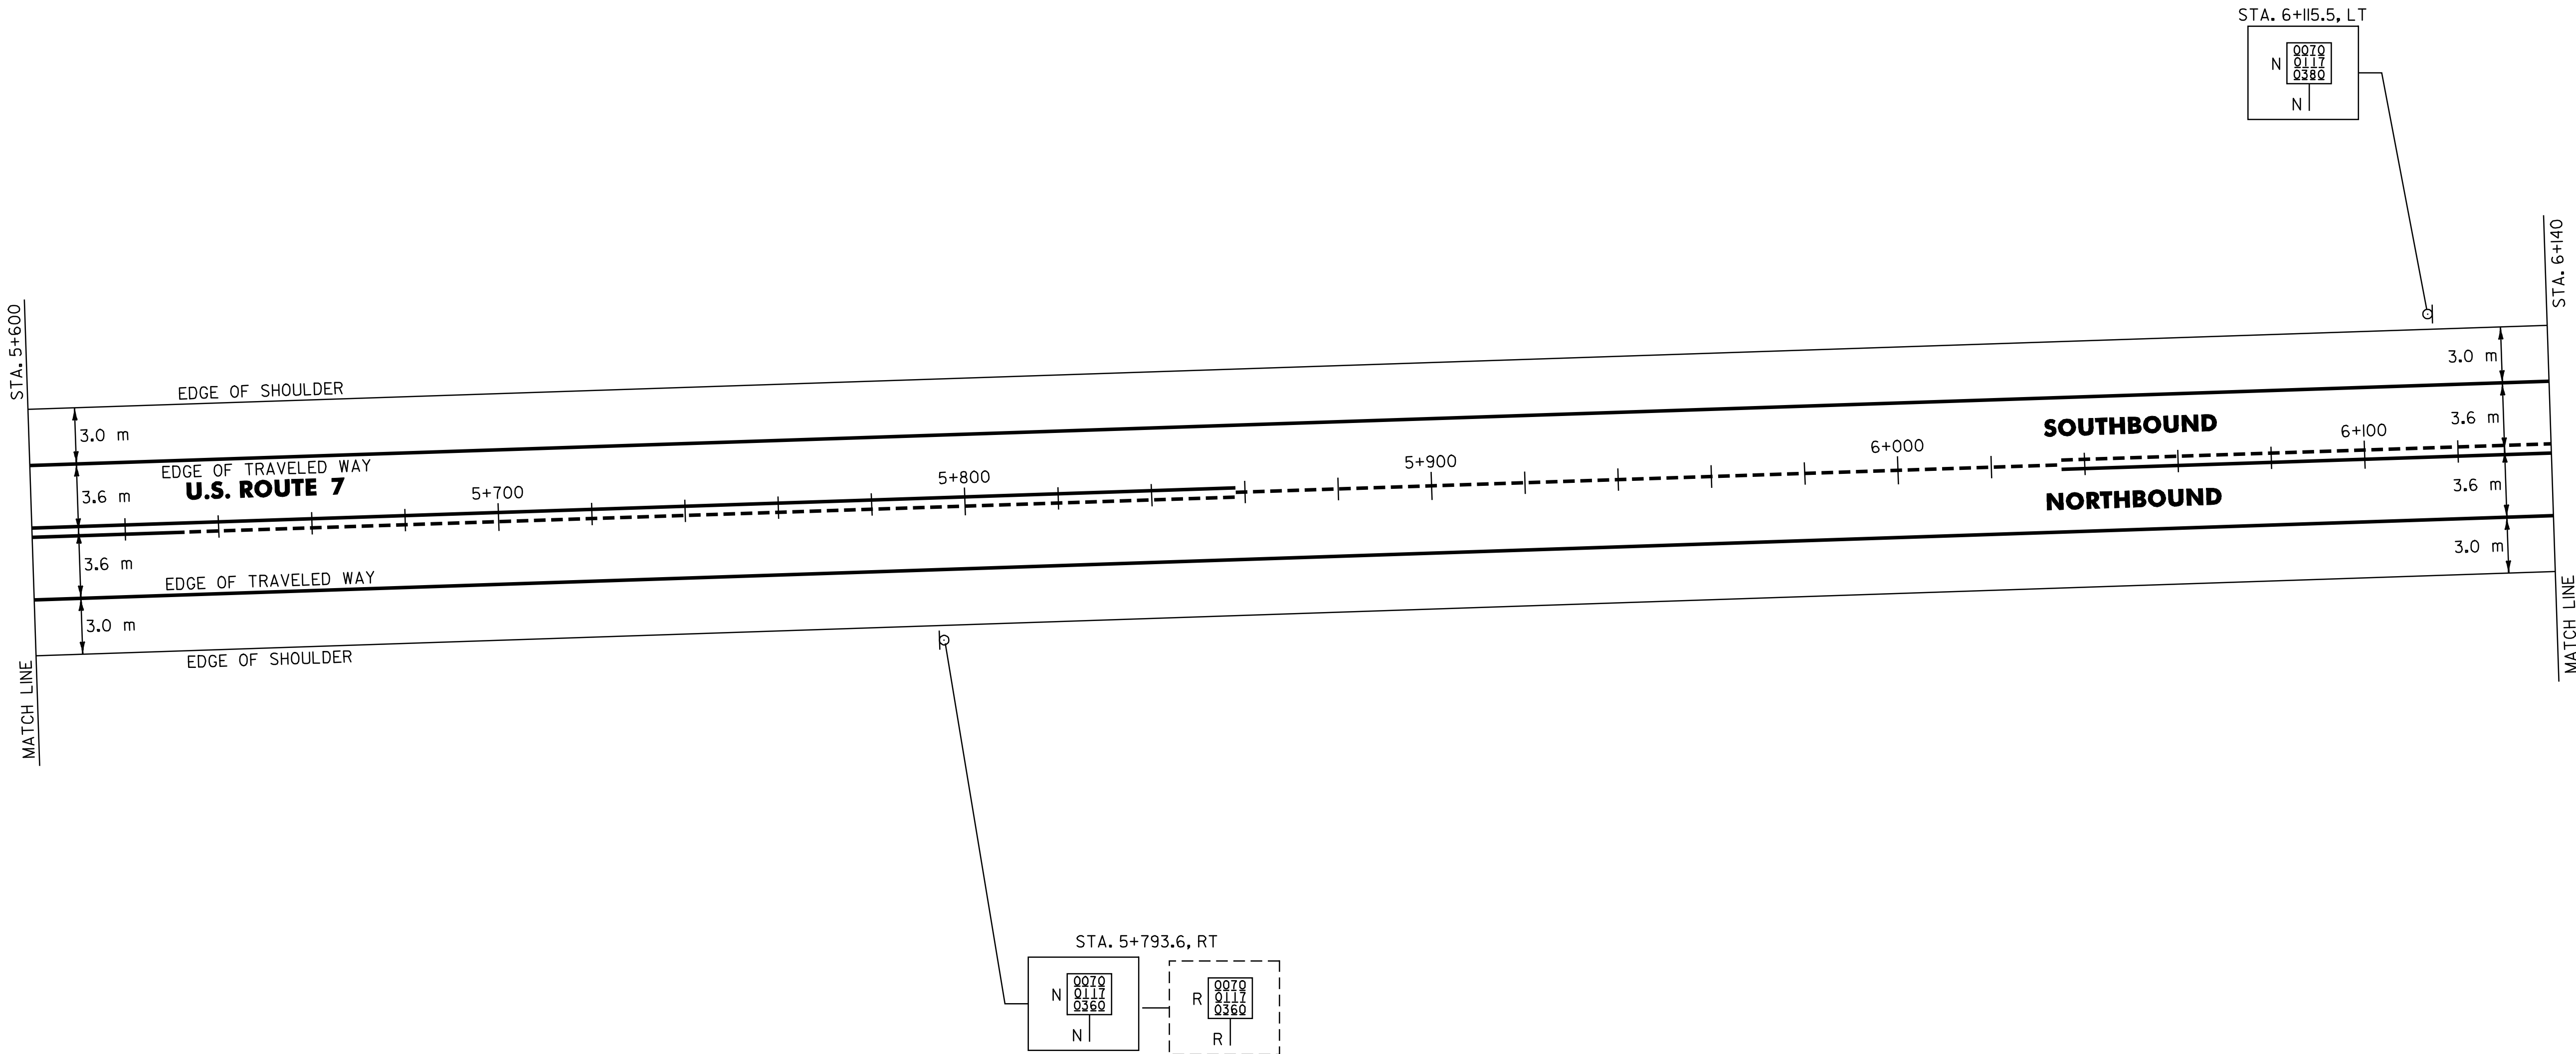

SIGN LEGEND
R= REMOVE
S= SALVAGE
N= NEW
RET= RETAIN
B-B= BACK TO BACK
EXISTING= -----
NEW= _____

PAVING
PROJECT
LAYOUT
8

SURVEYED BY N/A DATE N/A
DRAWN BY C.A.K. DATE 2/02
SQUAD LEADER D.E.G.
DESIGN FILE NO. pb018d08 FILE pb018d08.dgn
IPARM pb018d08 DATE 10-JUL-2006 13:10
FILE 10-JUL-2006 PLOTTER
PROJ. NAME SALISBURY - MIDDLEBURY
PROJ. NO. NH_231111
SHEET 17 OF 67 SHEETS

DATUM
VERTICAL N/A
HORIZONTAL N/A

646.40 DURABLE 100 mm WHITE LINE
(ALL LINES WILL INCLUDE EDGE LINE BREAKS AND RADIUS FOR TOWN HIGHWAYS)
SALISBURY:
STA. 6+140.0 - STA. 6+680.0 LT & RT

646.60 TEMPORARY 100 mm WHITE LINE
(ALL LINES WILL INCLUDE EDGE LINE BREAKS AND RADIUS FOR TOWN HIGHWAYS)
SALISBURY:
STA. 6+140.0 - STA. 6+680.0 LT & RT


646.41 DURABLE 100 mm YELLOW LINE
(ALL LINES WILL INCLUDE C/L BREAKS FOR TOWN HIGHWAYS) S=SOLID, D=DASHED

SALISBURY:		LT	CL	RT
STA. 6+140.0 - STA. 6+248.0	D	-	-	S
STA. 6+248.0 - STA. 6+528.0	S	-	-	D
STA. 6+528.0 - STA. 6+680.0	-	D	-	-

646.61 TEMPORARY 100 mm YELLOW LINE
(ALL LINES WILL INCLUDE C/L BREAKS FOR TOWN HIGHWAYS) S=SOLID, D=DASHED

SALISBURY:		LT	CL	RT
STA. 6+140.0 - STA. 6+248.0	D	-	-	S
STA. 6+248.0 - STA. 6+528.0	S	-	-	D
STA. 6+528.0 - STA. 6+680.0	-	D	-	-

675.50 REMOVING SIGNS
AS SHOWN - I

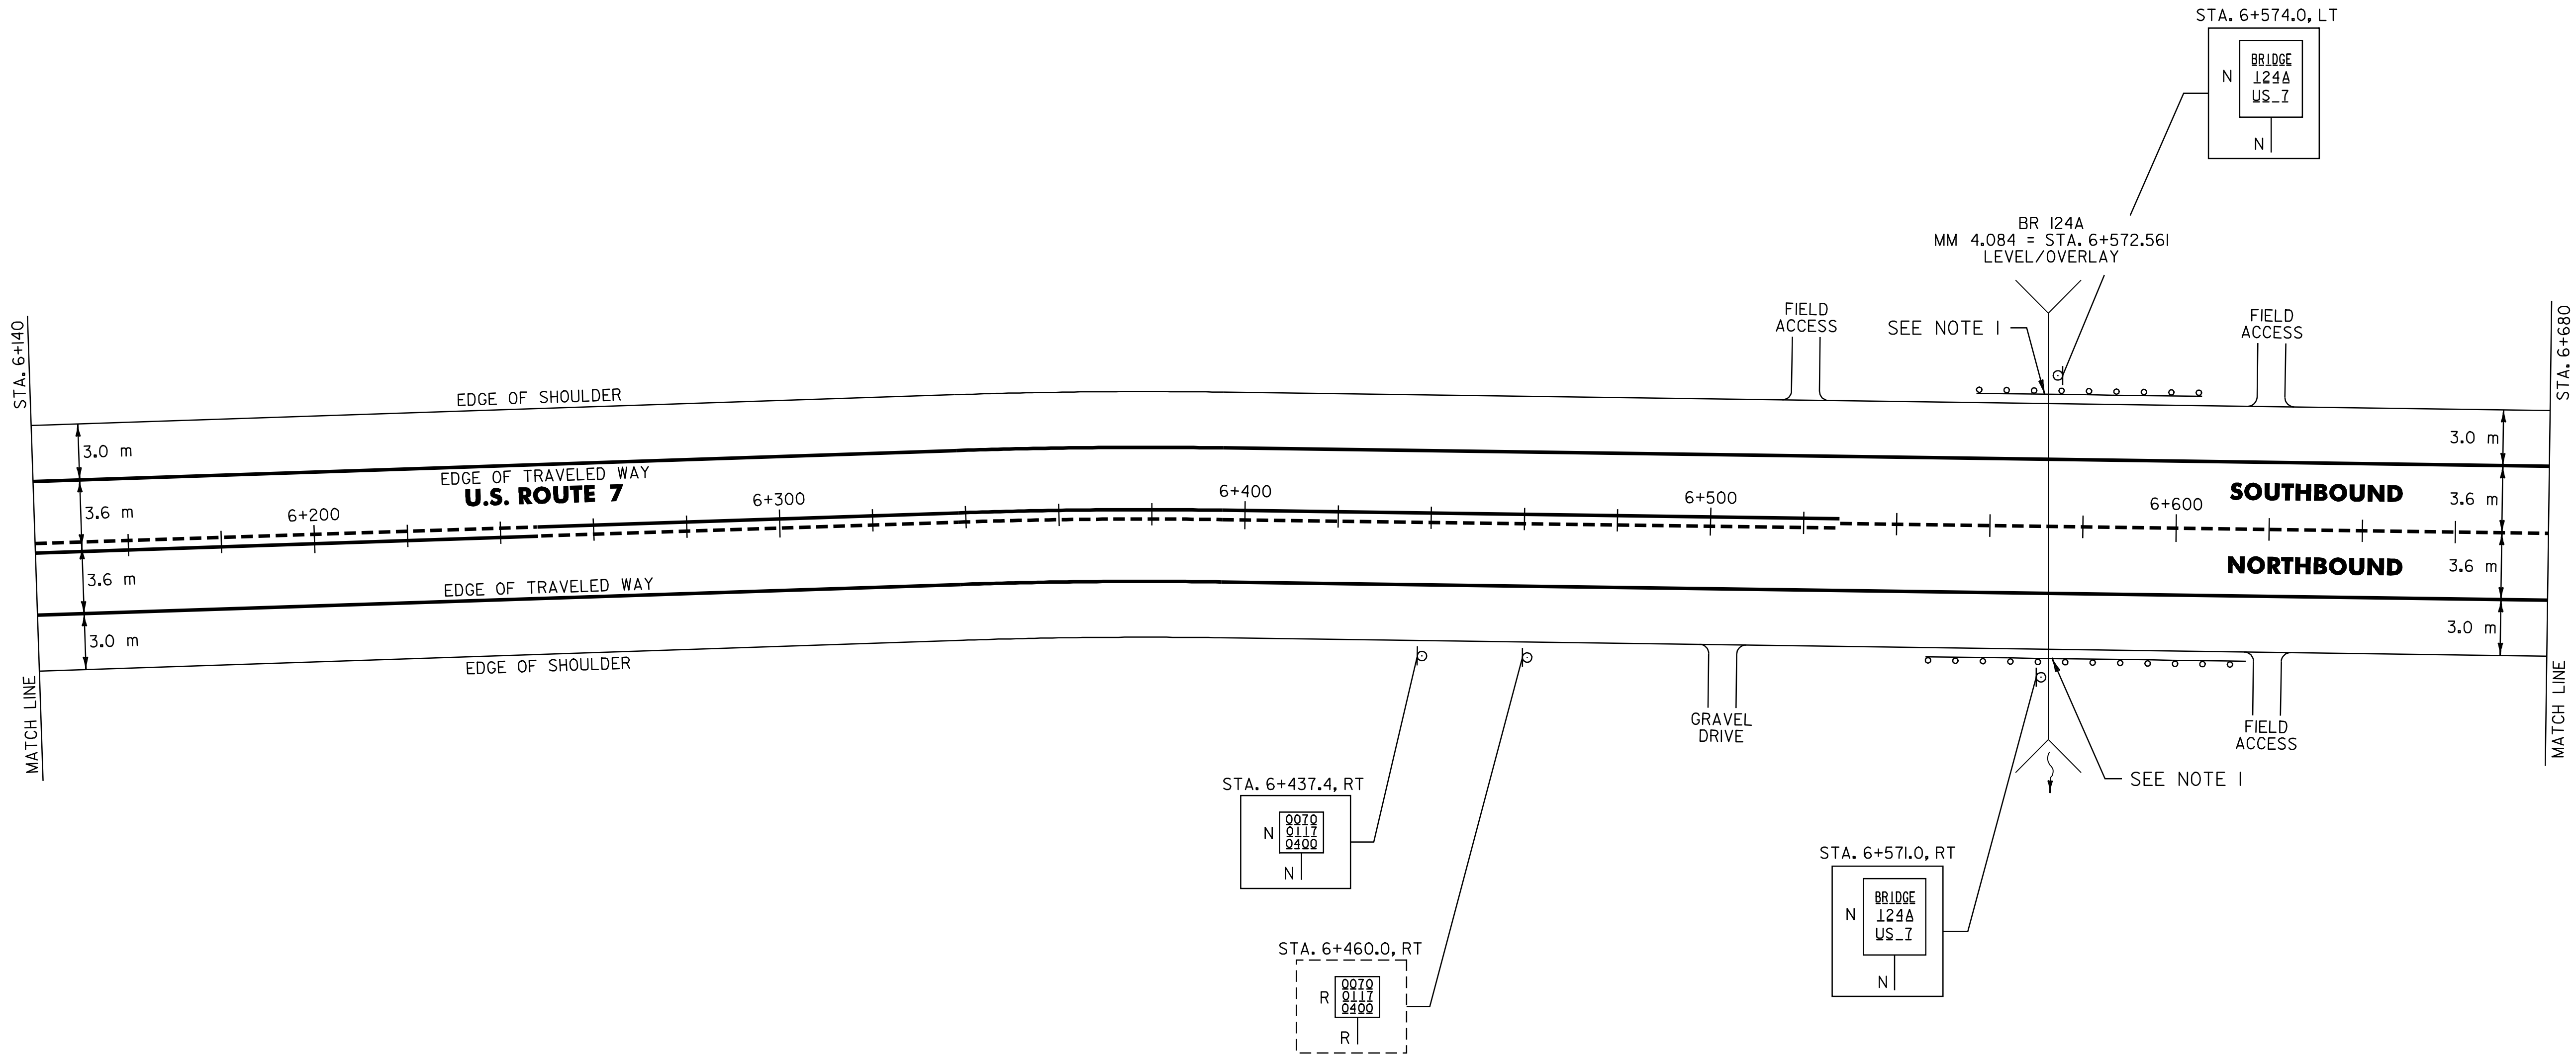

621.20 STEEL BEAM GUARDRAIL

SALISBURY:
STA. 6+556.4 - STA. 6+594.4 RT (38.0 m)
STA. 6+569.4 - STA. 6+592.2 LT (22.8 m)

621.505 MANUFACTURED TERMINAL SECTION (FLARED)

SALISBURY:
STA. 6+545.0 - STA. 6+556.4 RT
STA. 6+558.0 - STA. 6+569.4 LT
STA. 6+592.2 - STA. 6+603.6 LT
STA. 6+594.4 - STA. 6+605.8 RT

621.80 REMOVAL AND DISPOSAL OF GUARDRAIL

SALISBURY:
STA. 6+545.0 - STA. 6+605.0 RT (60.0 m)
STA. 6+558.0 - STA. 6+604.0 LT (46.0 m)

NOTE:
I. SEE SHEET 66 OF 67 FOR STEEL BEAM GUARDRAIL AT SMALL CULVERTS DETAIL.

SIGN LEGEND
R= REMOVE
S= SALVAGE
N= NEW
RET= RETAIN
B-B= BACK TO BACK
EXISTING= -----
NEW= _____

PAVING
PROJECT
LAYOUT
9

SURVEYED BY N/A DATE N/A
DRAWN BY C.A.K. DATE 2/02
SQUAD LEADER D.E.G.
DESIGN FILE NO. pave/01b018/pb018.dgn
IPARM pb018p09.1 DATE 10-JUL-2006 PLOTTER 13:
PROJ. NAME SALISBURY - MIDDLEBURY
PROJ. NO. NH_231111S
SHEET 18 OF 67 SHEETS -----

DATUM
VERTICAL N/A
HORIZONTAL N/A


646.40 DURABLE 100 mm WHITE LINE
(ALL LINES WILL INCLUDE EDGE LINE BREAKS AND
RADIUS FOR TOWN HIGHWAYS)
SALISBURY:
STA. 6+680.0 - STA. 7+220.0 LT & RT

646.60 TEMPORARY 100 mm WHITE LINE
(ALL LINES WILL INCLUDE EDGE LINE BREAKS AND
RADIUS FOR TOWN HIGHWAYS)
SALISBURY:
STA. 6+680.0 - STA. 7+220.0 LT & RT

646.41 DURABLE 100 mm YELLOW LINE
(ALL LINES WILL INCLUDE C/L BREAKS FOR
TOWN HIGHWAYS) S=SOLID, D=DASHED
SALISBURY:
STA. 6+680.0 - STA. 6+984.6 LT C RT
STA. 6+984.6 - STA. 7+220.0 D D S

646.61 TEMPORARY 100 mm YELLOW LINE
(ALL LINES WILL INCLUDE C/L BREAKS FOR
TOWN HIGHWAYS) S=SOLID, D=DASHED
SALISBURY:
STA. 6+680.0 - STA. 6+984.6 LT C RT
STA. 6+984.6 - STA. 7+220.0 D D S

675.50 REMOVING SIGNS
AS SHOWN - 2

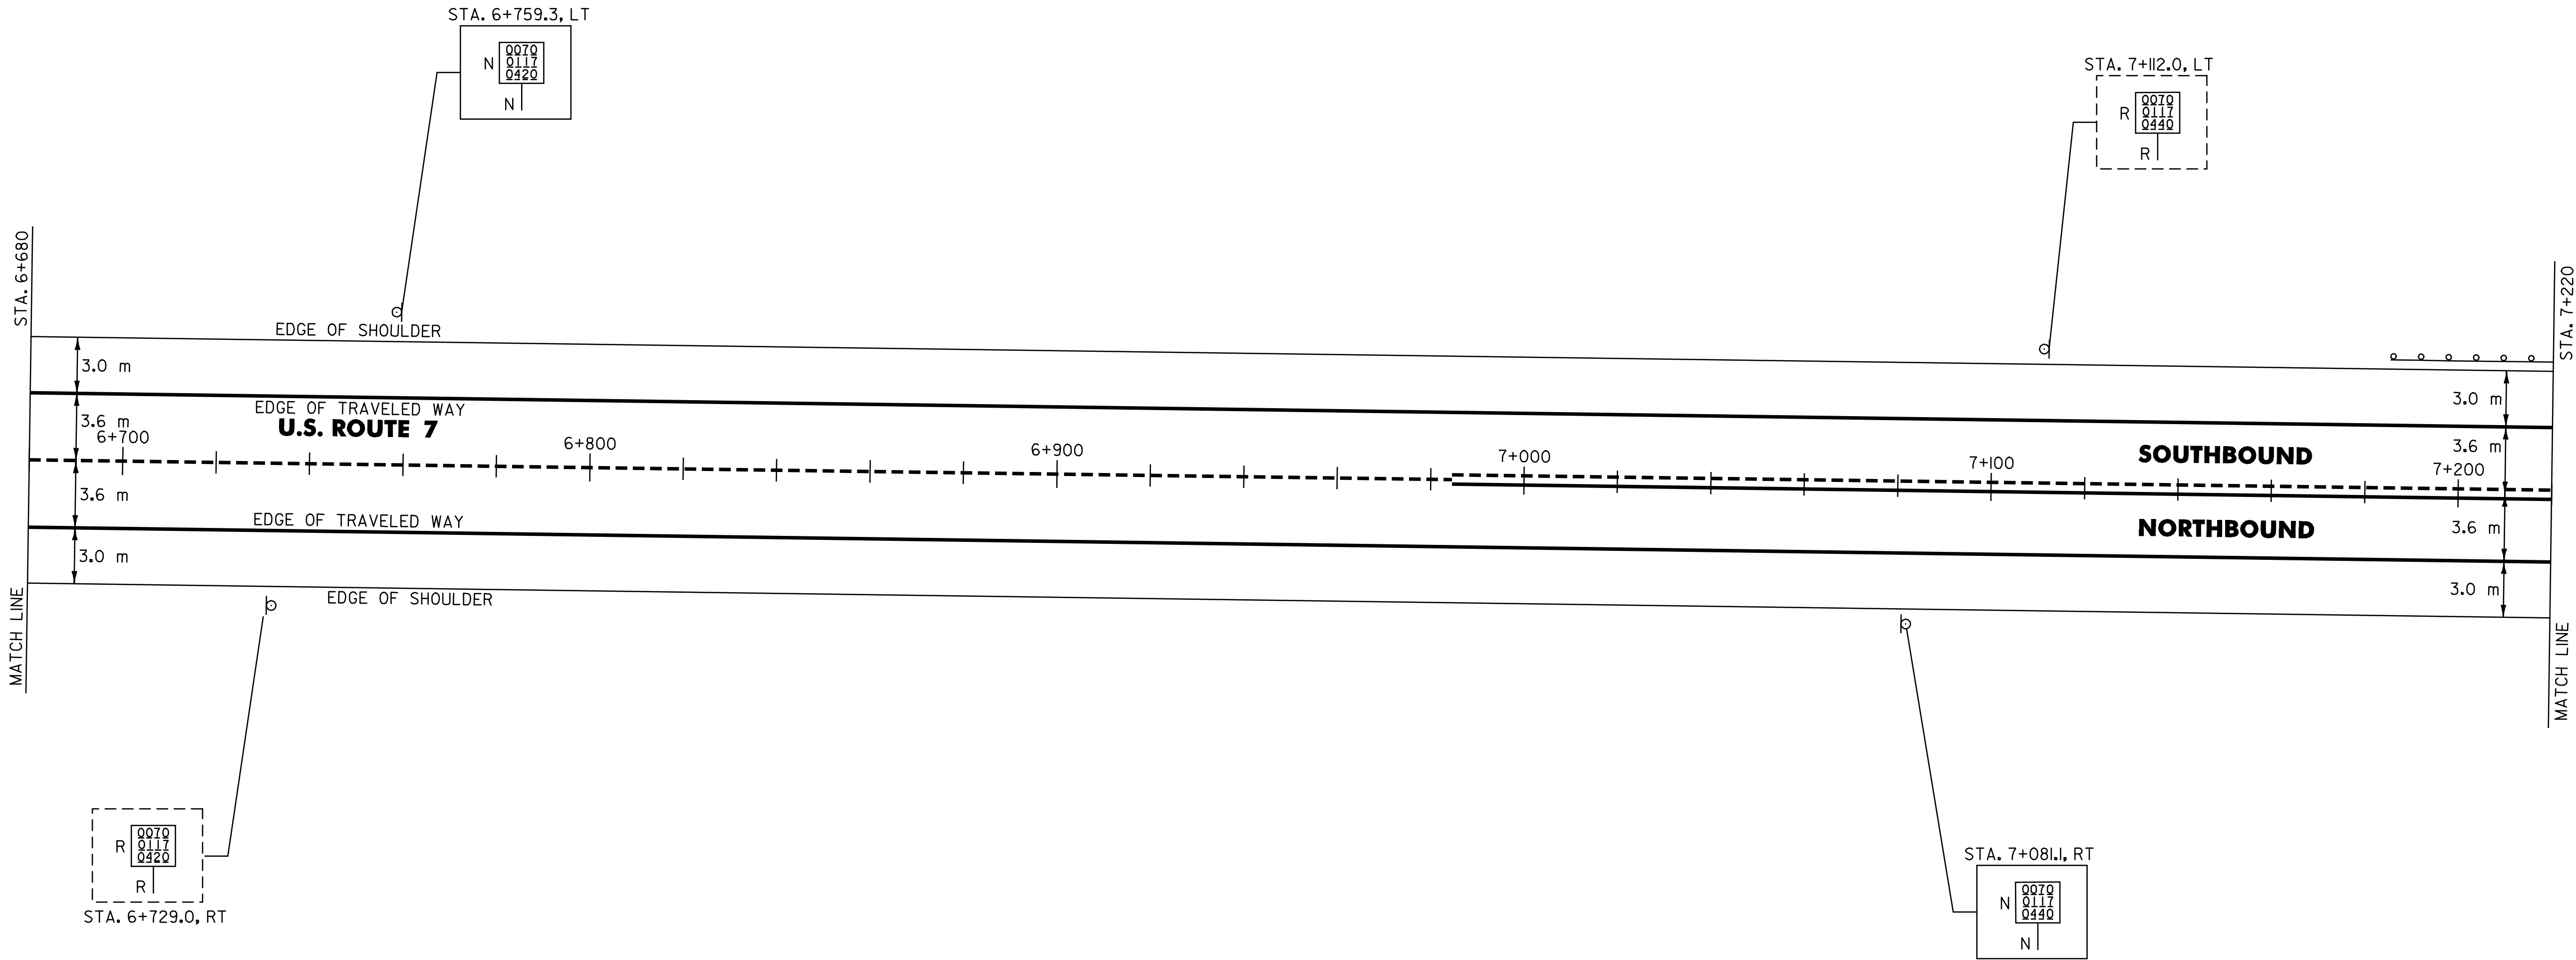

621.20 STEEL BEAM GUARDRAIL

SALISBURY:
STA. 7+197.4 - STA. 7+220.0 LT (22.6 m)
STA. 7+258.36 LT (60.96 m)

621.505 MANUFACTURED TERMINAL SECTION (FLARED)

SALISBURY:
STA. 7+186.0 - STA. 7+197.4 LT

621.80 REMOVAL AND DISPOSAL OF GUARDRAIL

SALISBURY:
STA. 7+186.0 - STA. 7+220.0 LT (34.0 m)

SIGN LEGEND
R= REMOVE
S= SALVAGE
N= NEW
RET= RETAIN
B-B= BACK TO BACK
EXISTING= -----
NEW= _____

PAVING
PROJECT
LAYOUT
10

SURVEYED BY N/A DATE N/A
DRAWN BY C.A.K. DATE 2/02
SQUAD LEADER D.E.G.
DESIGN FILE NO. pgve/01b018/pb018.dgn
IPARM pb018p10.i DATE 10-JUL-2006 13:
FILE 10-JUL-2006 13:
PROJ. NAME SALISBURY - MIDDLEBURY
PROJ. NO. NH_231111S
SHEET 19 OF 67 SHEETS -----

DATUM
VERTICAL N/A
HORIZONTAL N/A

646.40 DURABLE 100 mm WHITE LINE
(ALL LINES WILL INCLUDE EDGE LINE BREAKS AND
RADIUS FOR TOWN HIGHWAYS)
SALISBURY:
STA. 7+220.0 - STA. 7+285.500 LT & RT

MIDDLEBURY:
STA. 0+000.000 - STA. 0+480.0 LT & RT

646.60 TEMPORARY 100 mm WHITE LINE
(ALL LINES WILL INCLUDE EDGE LINE BREAKS AND
RADIUS FOR TOWN HIGHWAYS)
SALISBURY:
STA. 7+220.0 - STA. 7+285.500 LT & RT

MIDDLEBURY:
STA. 0+000.000 - STA. 0+480.0 LT & RT


646.41 DURABLE 100 mm YELLOW LINE
(ALL LINES WILL INCLUDE C/L BREAKS FOR
TOWN HIGHWAYS) S=SOLID, D=DASHED
SALISBURY:
STA. 7+220.0 - STA. 7+226.0 LT S
STA. 7+226.0 - STA. 7+285.5 D S

MIDDLEBURY:
STA. 0+000.000 - STA. 0+209.2 S D
STA. 0+209.2 - STA. 0+284.0 D D
STA. 0+284.0 - STA. 0+480.0 D S

646.61 TEMPORARY 100 mm YELLOW LINE
(ALL LINES WILL INCLUDE C/L BREAKS FOR
TOWN HIGHWAYS) S=SOLID, D=DASHED
SALISBURY:
STA. 7+220.0 - STA. 7+226.0 LT S
STA. 7+226.0 - STA. 7+266.2 D S
STA. 7+266.2 - STA. 7+285.500 S D

MIDDLEBURY:
STA. 0+000.000 - STA. 0+209.2 S D
STA. 0+209.2 - STA. 0+284.0 D D
STA. 0+284.0 - STA. 0+480.0 D S

675.50 REMOVING SIGNS
AS SHOWN - 4

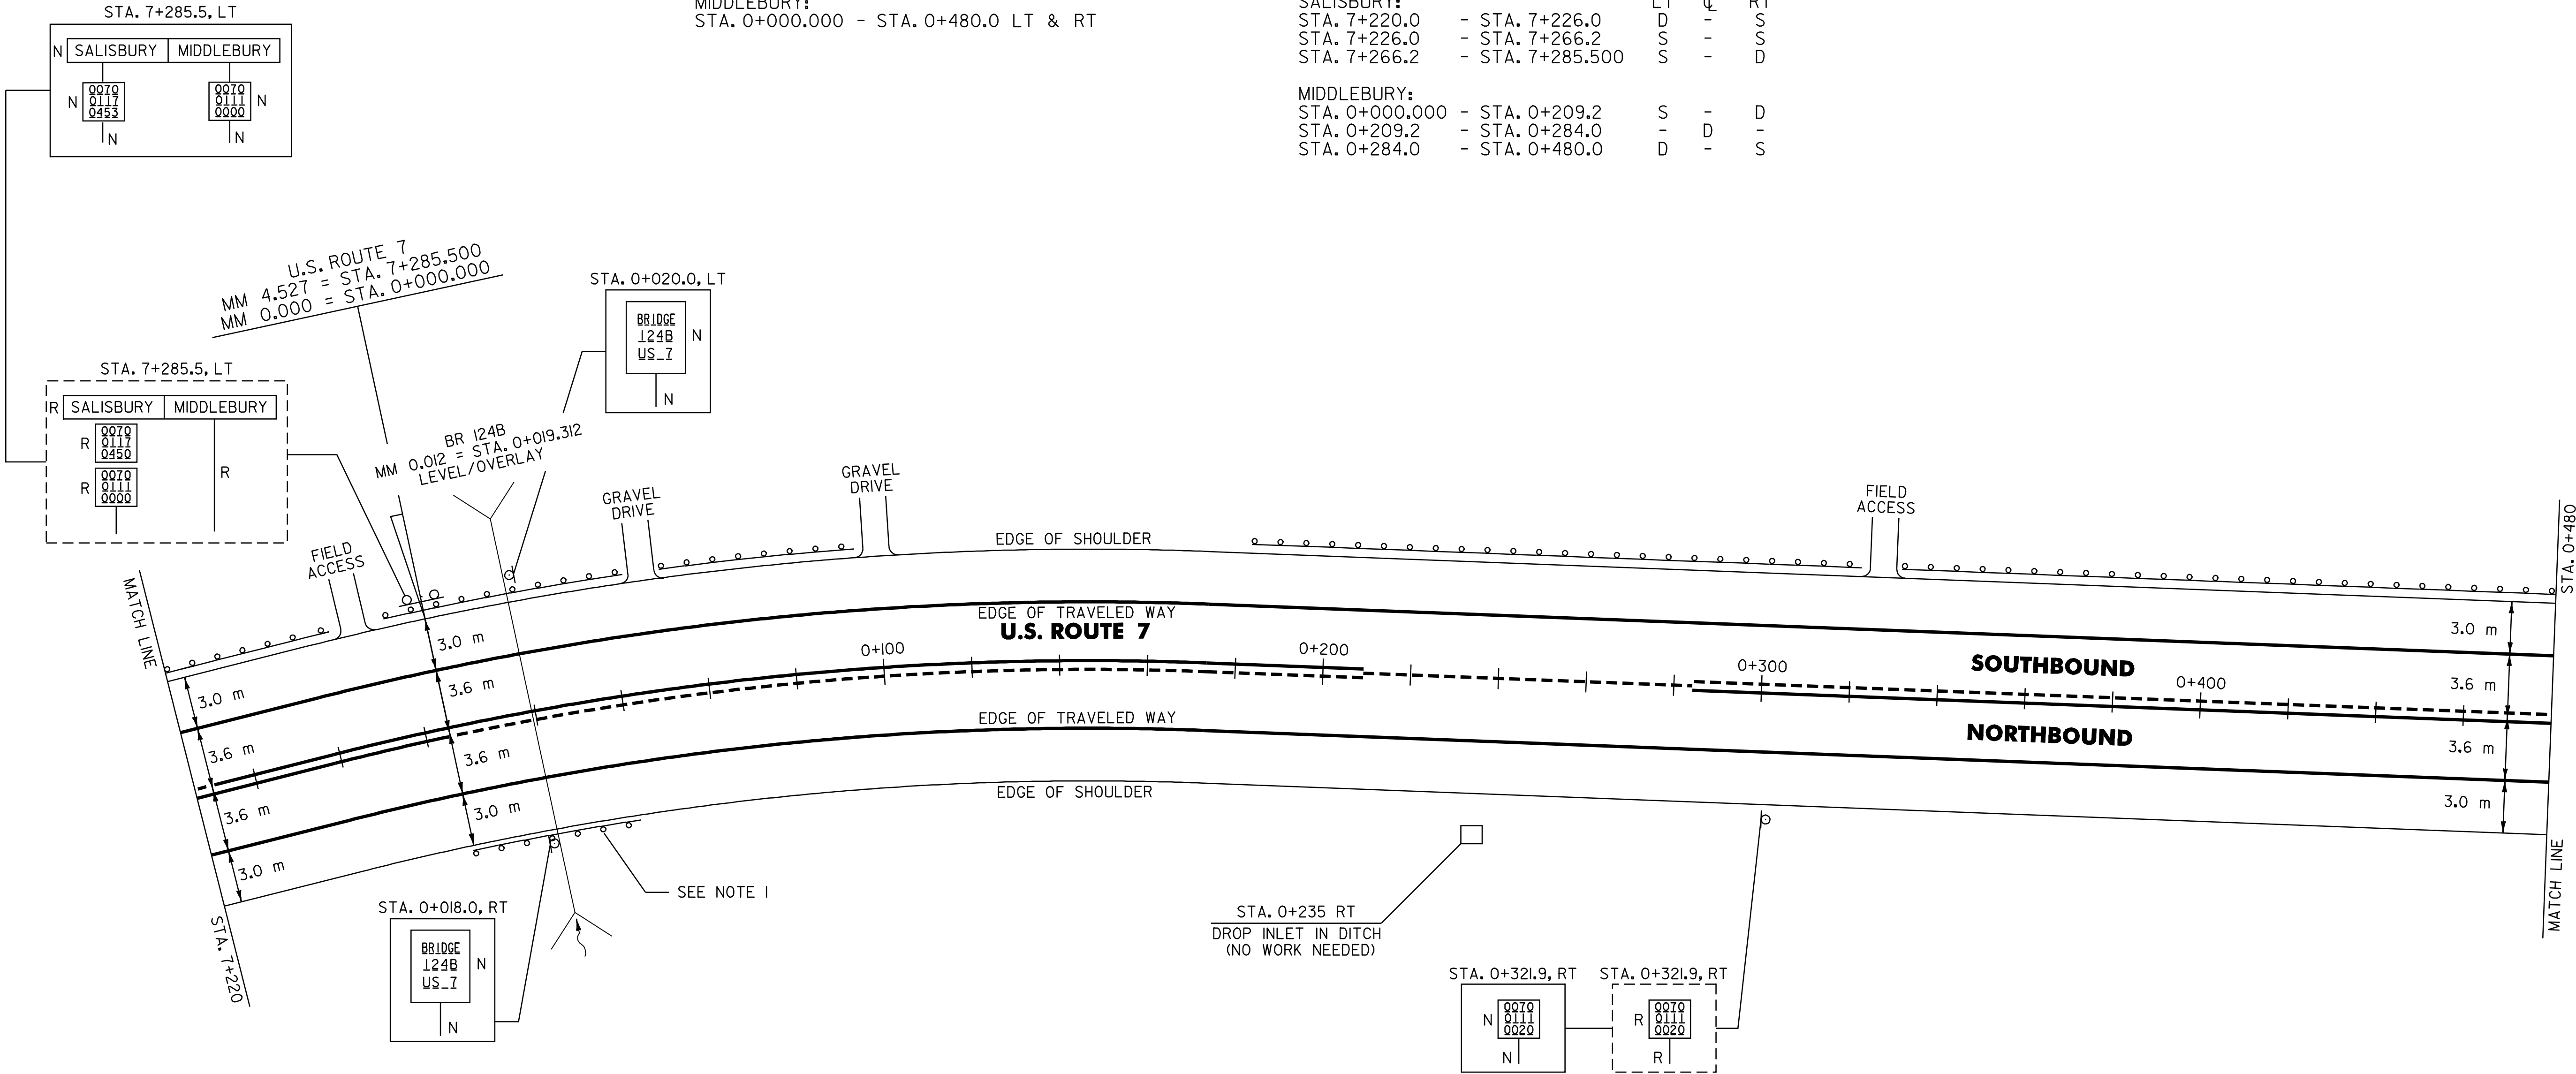

621.20 STEEL BEAM GUARDRAIL

SALISBURY:
~~STA. 7+220.0 - STA. 7+262.0 LT (42.0 m) SEE PG. 19 OF 67~~

MIDDLEBURY:
029.77 26.67
STA. 0+003.1 - STA. 0+033.5 LT (30.4 m)
STA. 0+011.4 - STA. 0+030.4 RT (19.0 m) (0+019.0) (7.62 m)
(0+ 070.96) STA. 0+063.4 - STA. 0+086.2 LT (22.8 m) (15.24 m)
(0+ 196.1) STA. 0+192.6 - STA. 0+310.4 LT (117.8 m) (114.3 m)
(0+ 339.76) STA. 0+336.6 - STA. 0+480.0 LT (143.6 m) (140.24 m)

621.505 MANUFACTURED TERMINAL SECTION (FLARED)

SALISBURY:
STA. 7+262.0 - STA. 7+273.4 LT
STA. 7+277.2 LT - STA. 0+003.1 LT (IN MIDDLEBURY)

MIDDLEBURY:
STA. 0+000.0 - STA. 0+011.4 RT
(0+019.02) STA. 0+030.4 - STA. 0+041.8 RT (0+030.42)
(0+029.77) STA. 0+033.5 - STA. 0+044.9 LT (0+041.17)
(0+059.56) STA. 0+052.0 - STA. 0+063.4 LT (0+070.96)
STA. 0+086.2 - STA. 0+097.6 LT
(0+184.7) STA. 0+181.2 - STA. 0+192.6 LT (0+196.1)
STA. 0+310.4 - STA. 0+321.8 LT
STA. 0+325.2 - STA. 0+336.6 LT
(0+328.36) (0+339.76)

621.80 REMOVAL AND DISPOSAL OF GUARDRAIL

SALISBURY:
STA. 7+220.0 - STA. 7+273.0 LT (53.0 m)
STA. 7+281.0 - STA. 7+285.500 LT (8.3 m)

MIDDLEBURY:
STA. 0+000.000 - STA. 0+044.0 LT (44.0 m)
STA. 0+000.000 - STA. 0+034.2 RT (34.2 m)
STA. 0+052.0 - STA. 0+092.0 LT (47.6 m)
STA. 0+185.0 - STA. 0+316.0 LT (138.6 m)
STA. 0+331.0 - STA. 0+480.0 LT (156.6 m)

SIGN LEGEND

R= REMOVE
S= SALVAGE
N= NEW
RET= RETAIN
B-B= BACK TO BACK
EXISTING= -----
NEW= -----

NOTE:
I. SEE SHEET 66 OF 67 FOR STEEL BEAM
GUARDRAIL AT SMALL CULVERTS DETAIL.

PAVING
PROJECT
LAYOUT
11

SURVEYED BY N/A DATE N/A
DRAWN BY C.A.K. DATE 2/02
SQUAD LEADER D.E.G.
DESIGN FILE NO. pave/01b018/pb018.dgn
IPARM pb018plj DATE 10-JUL-2006 13:
FILE PLOTTED
PROJ. NAME SALISBURY - MIDDLEBURY
PROJ. NO. NH_231113
SHEET 20 OF 67 SHEETS

DATUM
VERTICAL N/A
HORIZONTAL N/A


646.40 DURABLE 100 mm WHITE LINE
(ALL LINES WILL INCLUDE EDGE LINE BREAKS AND
RADIUS FOR TOWN HIGHWAYS)
MIDDLEBURY:
STA. 0+480.0 - STA. 1+020.0 LT & RT

646.60 TEMPORARY 100 mm WHITE LINE
(ALL LINES WILL INCLUDE EDGE LINE BREAKS AND
RADIUS FOR TOWN HIGHWAYS)
MIDDLEBURY:
STA. 0+480.0 - STA. 1+020.0 LT & RT

646.41 DURABLE 100 mm YELLOW LINE
(ALL LINES WILL INCLUDE C/L BREAKS FOR
TOWN HIGHWAYS) S=SOLID, D=DASHED
MIDDLEBURY:
STA. 0+480.0 - STA. 0+587.0 LT C RT
STA. 0+480.0 - STA. 0+587.0 D - S
STA. 0+587.0 - STA. 0+864.0 S - D
STA. 0+864.0 - STA. 1+002.0 - D -
STA. 1+002.0 - STA. 1+020.0 D - S

646.61 TEMPORARY 100 mm YELLOW LINE
(ALL LINES WILL INCLUDE C/L BREAKS FOR
TOWN HIGHWAYS) S=SOLID, D=DASHED
MIDDLEBURY:
STA. 0+480.0 - STA. 0+587.0 LT C RT
STA. 0+480.0 - STA. 0+587.0 D - S
STA. 0+587.0 - STA. 0+864.0 S - D
STA. 0+864.0 - STA. 1+002.0 - D -
STA. 1+002.0 - STA. 1+020.0 D - S

675.50 REMOVING SIGNS
AS SHOWN - 3

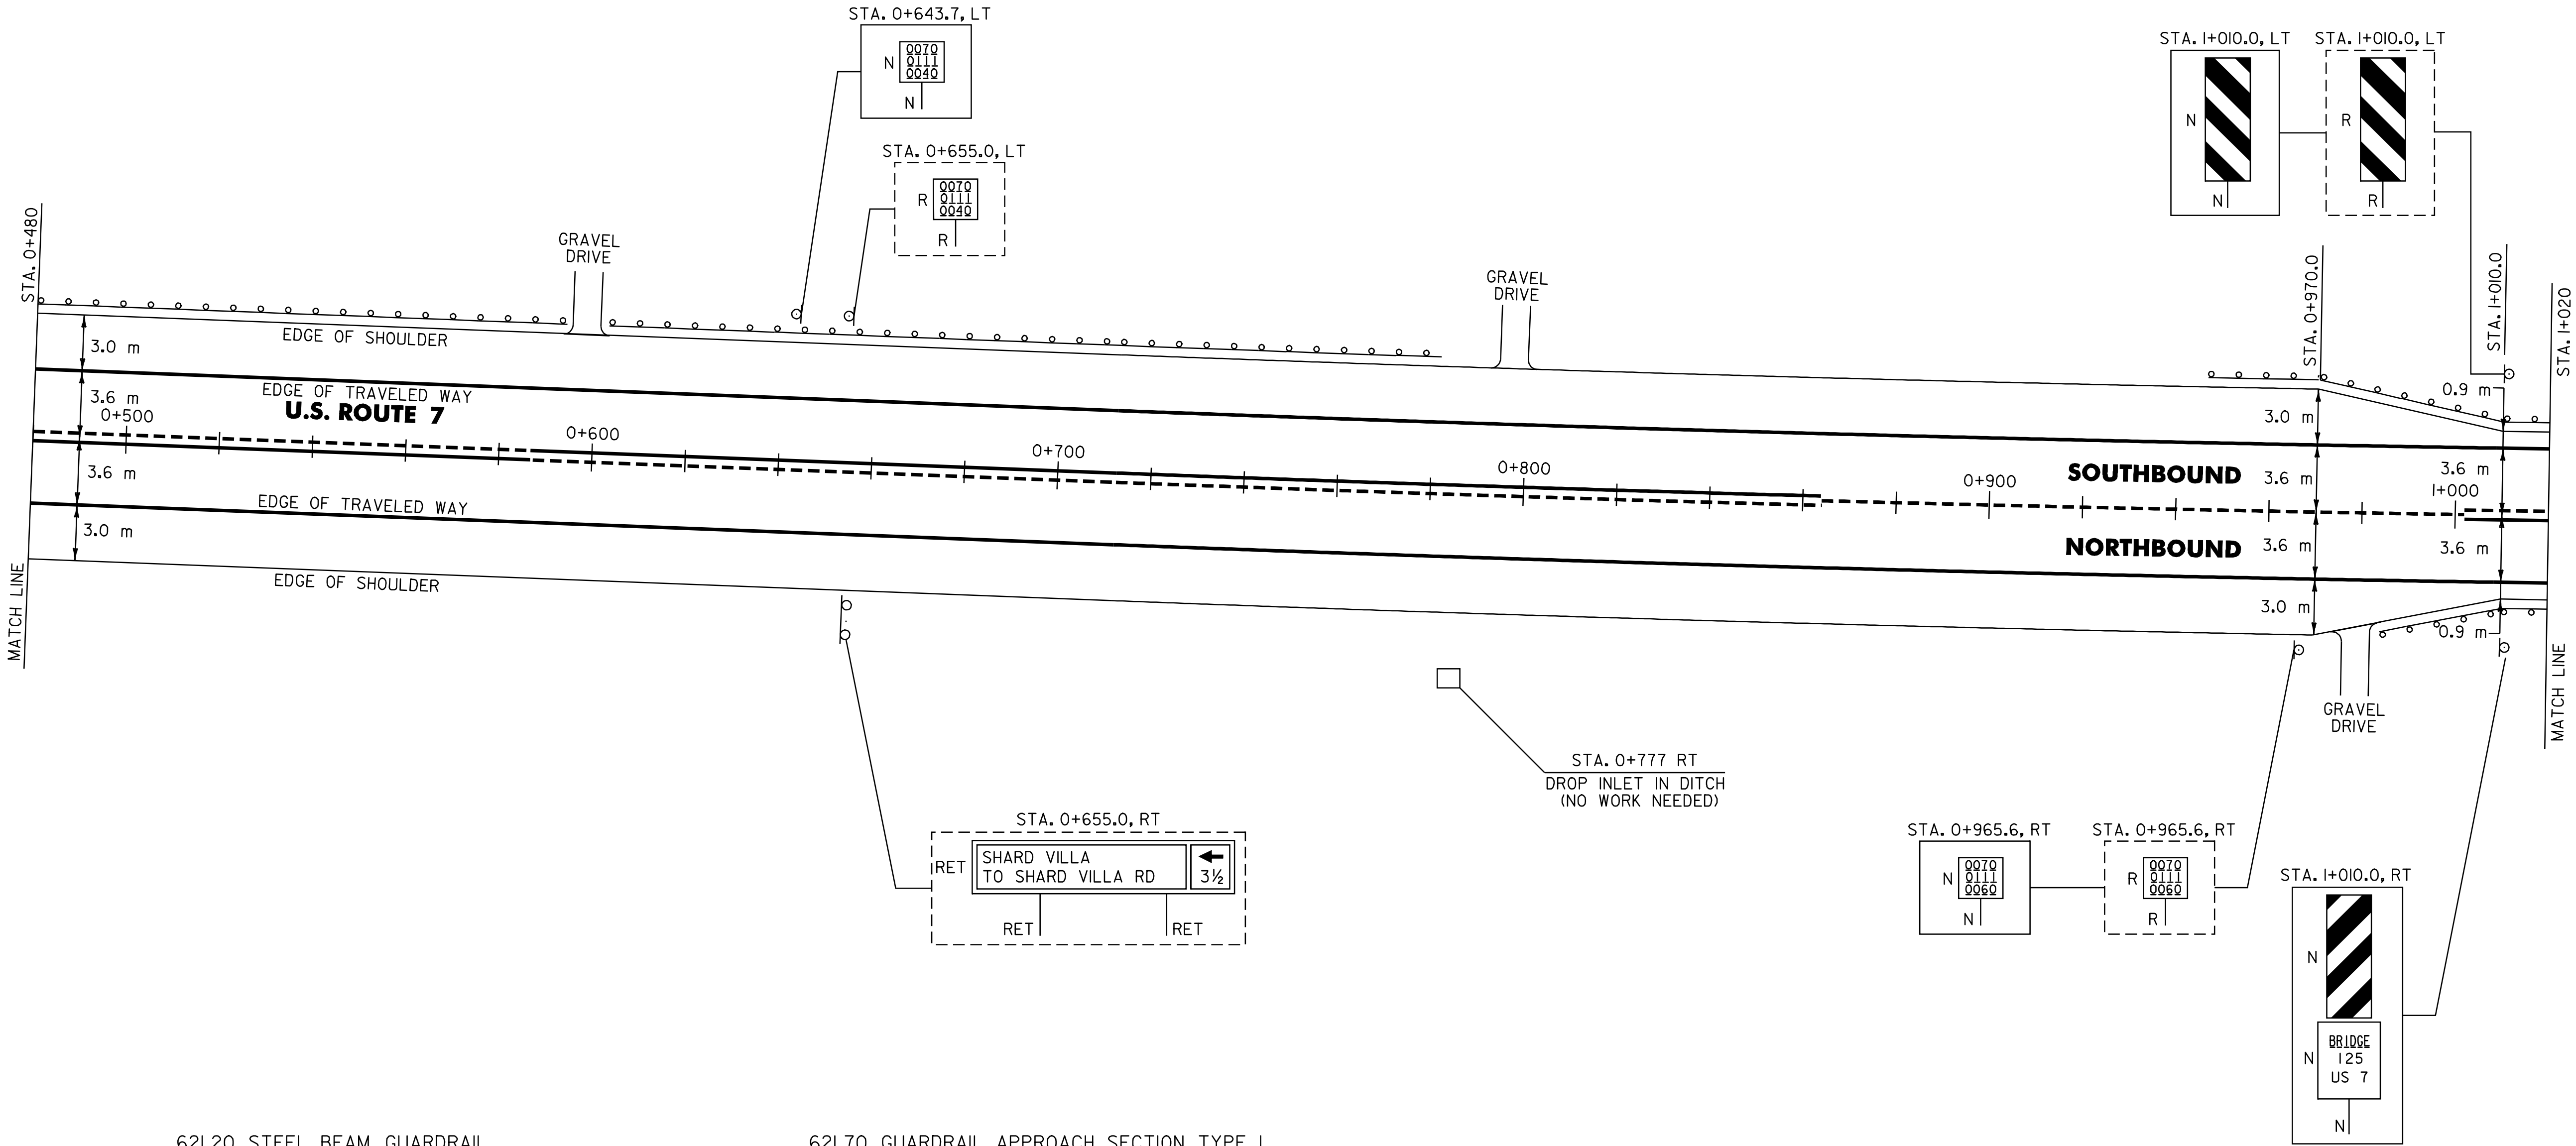

621.20 STEEL BEAM GUARDRAIL

MIDDLEBURY:
STA. 0+480.0 - STA. 0+583.6 LT (103.6 m)
STA. 0+957.3 - STA. 1+006.7 LT (49.4 m)
~~STA. 0+994.9 - STA. 1+006.3 RT (11.4 m)~~
~~STA. 0+616.8 - STA. 0+731.1 LT (114.3 m)~~
621.20 STEEL BEAM GUARDRAIL W/2.4 m POSTS (MOD.)

MIDDLEBURY:
~~STA. 0+613.4 - STA. 0+769.2 LT (155.8 m)~~
~~STA. 0+731.1 - 0+769.2 LT (38.1 m)~~

621.505 MANUFACTURED TERMINAL SECTION (FLARED)

MIDDLEBURY:
STA. 0+583.6 - STA. 0+595.0 LT
~~STA. 0+602.0 - STA. 0+613.4 LT~~ STA. 0+605.4 - STA. 0+616.8
STA. 0+769.2 - STA. 0+780.6 LT
STA. 0+945.9 - STA. 0+957.3 LT
~~STA. 0+983.5 - STA. 0+994.9 RT~~ STA. 0+991.1 - STA. 1+002.5 RT

621.70 GUARDRAIL APPROACH SECTION TYPE I

MIDDLEBURY:
STA. 1+006.3 - STA. 1+021.5 RT (15.2 m)

621.71 GUARDRAIL APPROACH SECTION TYPE II

MIDDLEBURY:
STA. 1+006.7 - STA. 1+010.5 LT (3.8 m)

621.80 REMOVAL AND DISPOSAL OF GUARDRAIL

MIDDLEBURY:
STA. 0+480.0 - STA. 0+595.0 LT (115.0 m)
STA. 0+602.0 - STA. 0+777.0 LT (175.0 m)
STA. 0+949.0 - STA. 1+010.5 LT (61.5 m)
STA. 0+985.0 - STA. 1+020.0 RT (35.0 m)

SIGN LEGEND

R= REMOVE
S= SALVAGE
N= NEW
RET= RETAIN
B-B= BACK TO BACK
EXISTING= -----
NEW= -----

PAVING
PROJECT
LAYOUT
12

SURVEYED BY N/A DATE N/A
DRAWN BY C.A.K. DATE 2/02
SQUAD LEADER D.E.G.
DESIGN FILE NO. PAVE/01b018/pb018.dgn
IPARM pb018p12.1 DATE 10-JUL-2006 13:10
FILE 10-JUL-2006 13:10
PROJ. NAME SALISBURY - MIDDLEBURY
PROJ. NO. NH_231113
SHEET 21 OF 67 SHEETS -----

DATUM
VERTICAL N/A
HORIZONTAL N/A

646.40 DURABLE 100 mm WHITE LINE
(ALL LINES WILL INCLUDE EDGE LINE BREAKS AND
RADIUS FOR TOWN HIGHWAYS)

MIDDLEBURY:
STA. I+020.0 - STA. I+580.0 LT & RT

646.60 TEMPORARY 100 mm WHITE LINE
(ALL LINES WILL INCLUDE EDGE LINE BREAKS AND
RADIUS FOR TOWN HIGHWAYS)

MIDDLEBURY:
STA. I+020.0 - STA. I+580.0 LT & RT

646.41 DURABLE 100 mm YELLOW LINE
(ALL LINES WILL INCLUDE C/L BREAKS FOR
TOWN HIGHWAYS) S=SOLID, D=DASHED

MIDDLEBURY:
STA. I+020.0 - STA. I+182.9 LT $\frac{C}{D}$ RT
STA. I+182.9 - STA. I+580.0 D - S
STA. I+203.789 DOUBLE SOLID RT, T-IO
STA. I+544.970 DOUBLE SOLID RT, VT. ROUTE 116

646.61 TEMPORARY 100 mm YELLOW LINE
(ALL LINES WILL INCLUDE C/L BREAKS FOR
TOWN HIGHWAYS) S=SOLID, D=DASHED

MIDDLEBURY:
STA. I+020.0 - STA. I+182.9 LT $\frac{C}{D}$ RT
STA. I+182.9 - STA. I+580.0 D - S
STA. I+203.789 DOUBLE SOLID RT, T-IO
STA. I+544.970 DOUBLE SOLID RT, VT. ROUTE 116

646.46 DURABLE 600 mm STOP BAR

MIDDLEBURY:
STA. I+203.789 LT, T-IO
STA. I+544.970 RT, VT. ROUTE 116
646.66 TEMPORARY 600 mm STOP BAR

MIDDLEBURY:
STA. I+203.789 LT, T-IO
STA. I+544.970 RT, VT. ROUTE 116
646.50 DURABLE LETTER OR SYMBOL

MIDDLEBURY:
STA. I+203.781 LT, T-IO, "S,T,O,P" (4 EA)
STA. I+544.970 RT, VT. ROUTE 116, "S,T,O,P" (4 EA)
646.70 TEMPORARY LETTER OR SYMBOL


MIDDLEBURY:
STA. I+203.781 LT, T-IO, "S,T,O,P" (4 EA)
STA. I+544.970 RT, VT. ROUTE 116, "S,T,O,P" (4 EA)

675.50 REMOVING SIGNS

AS SHOWN - 40

675.60 ERECTING SALVAGED SIGNS

AS SHOWN - 2

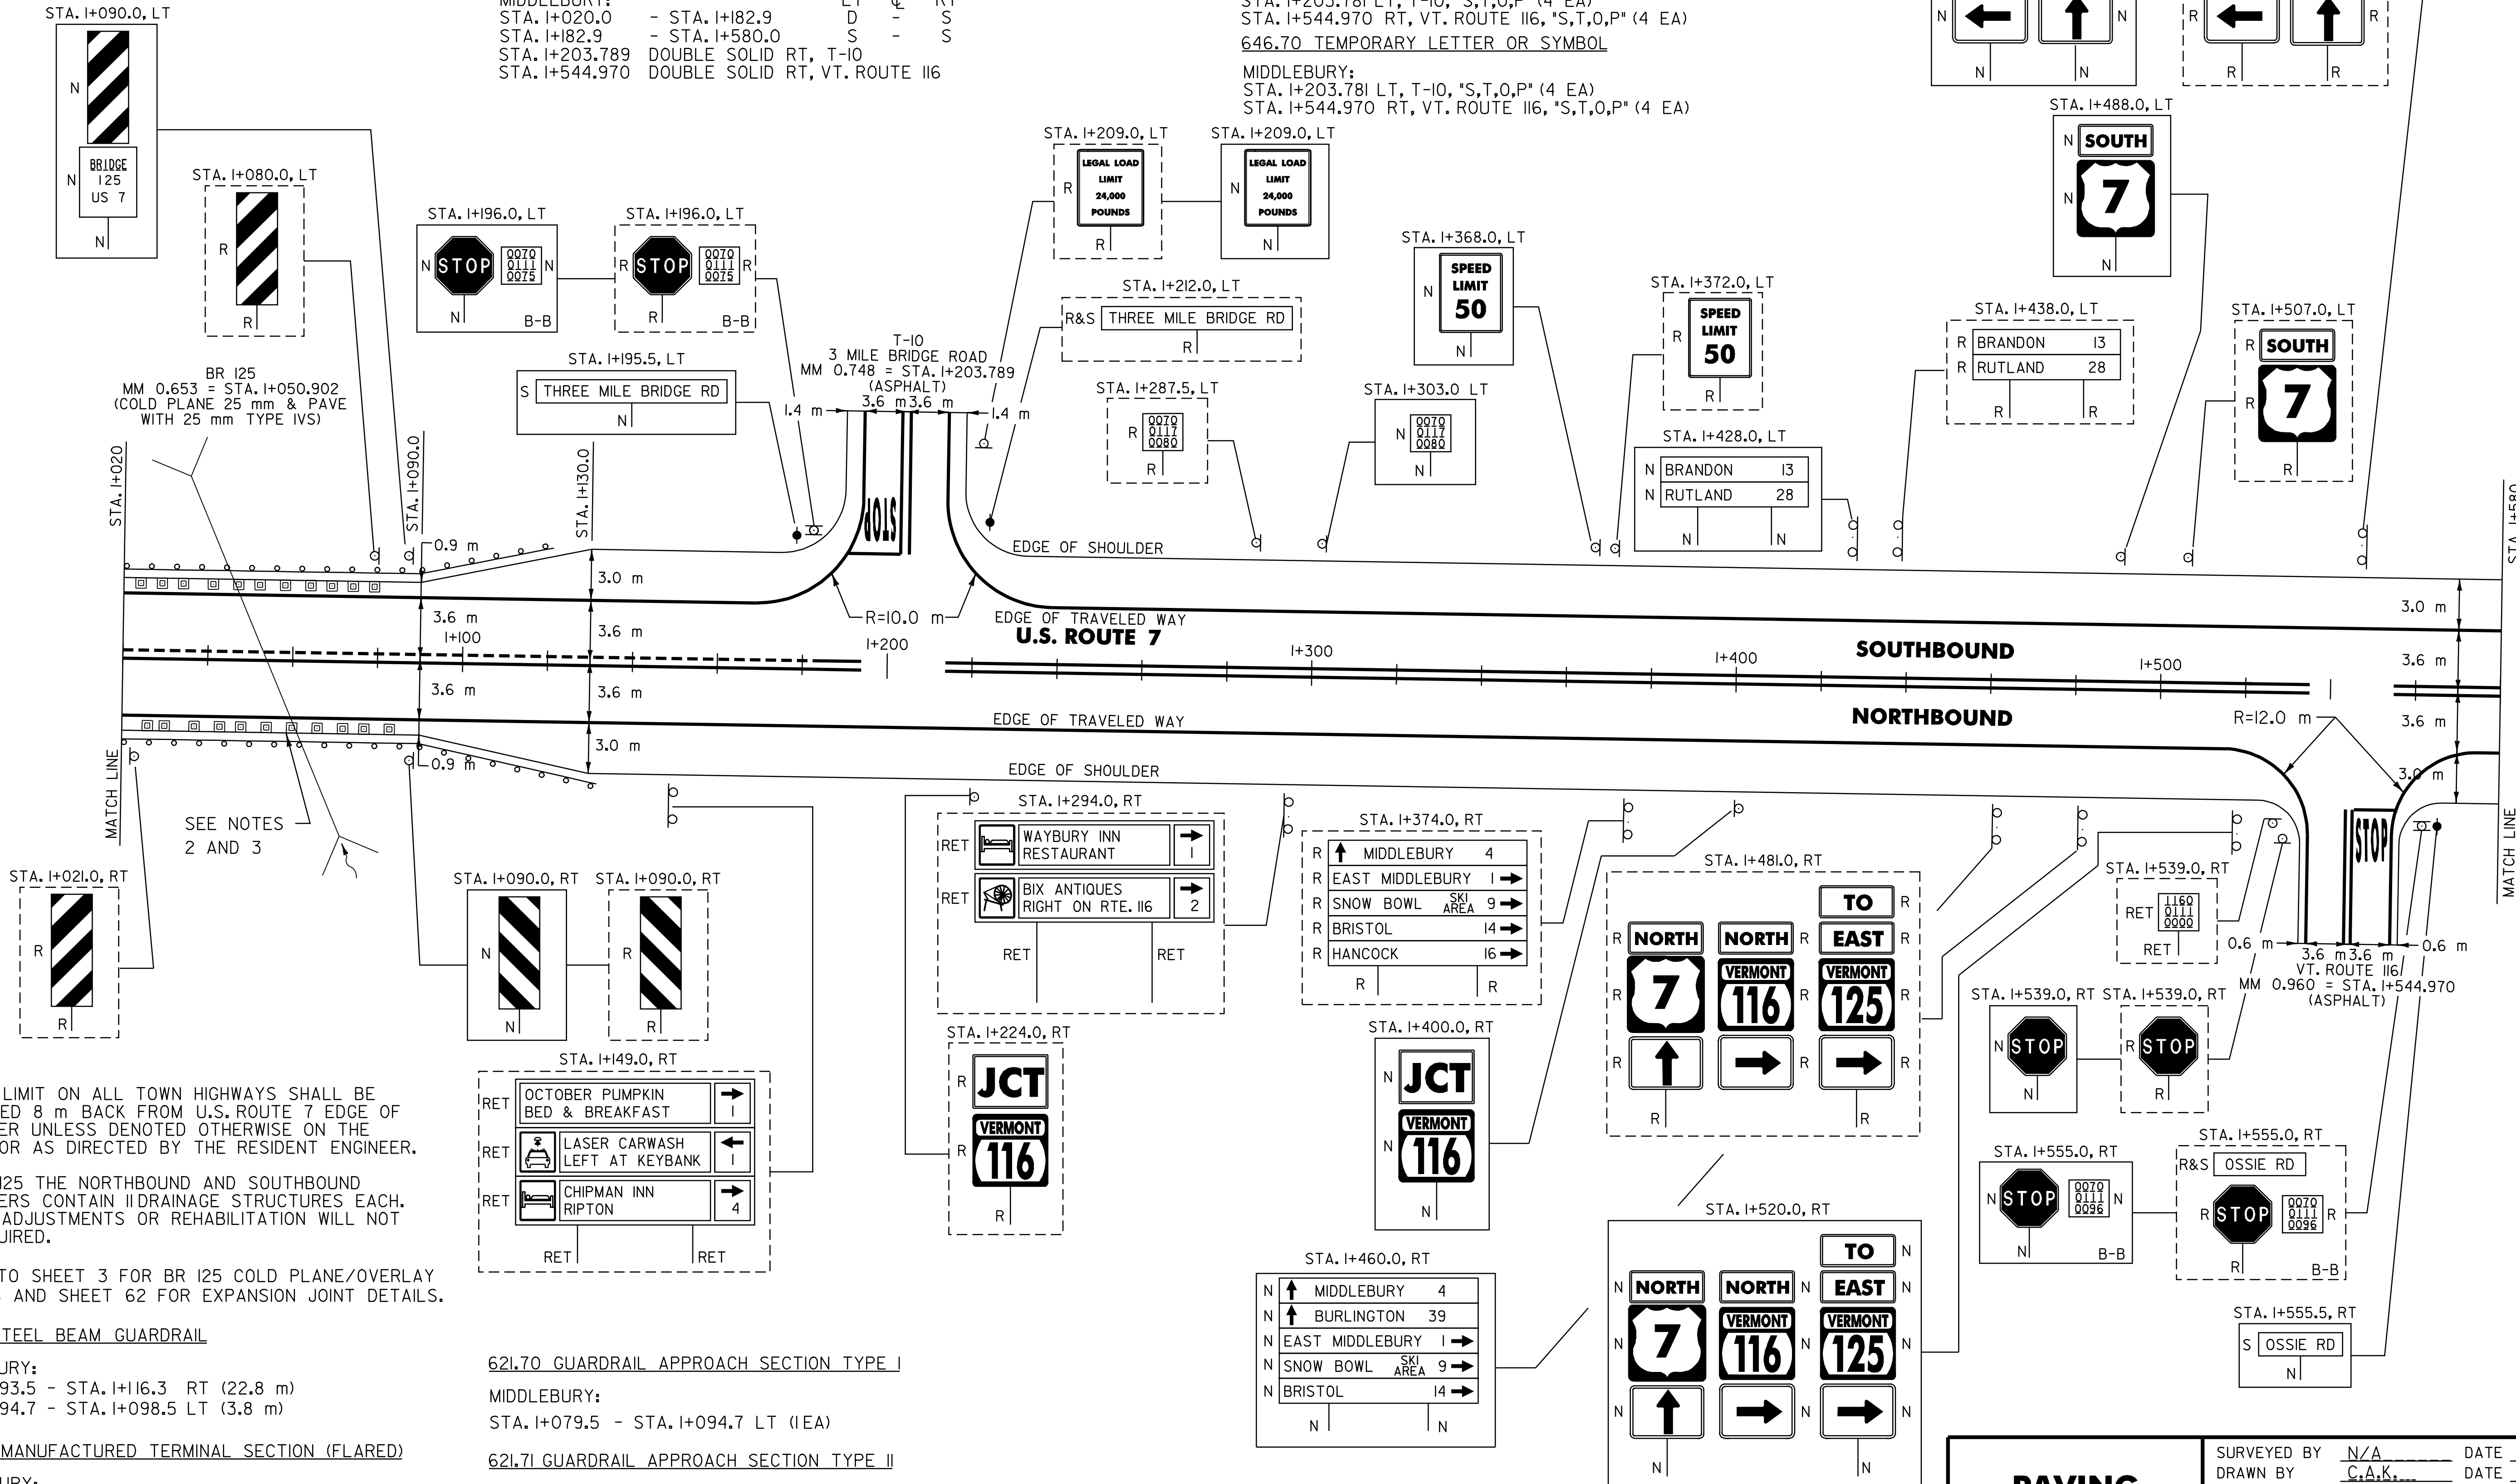

- NOTES:
- PAVING LIMIT ON ALL TOWN HIGHWAYS SHALL BE MEASURED 8 m BACK FROM U.S. ROUTE 7 EDGE OF SHOULDER UNLESS DENOTED OTHERWISE ON THE PLANS OR AS DIRECTED BY THE RESIDENT ENGINEER.
 - ON BR 125 THE NORTHBOUND AND SOUTHBOUND SHOULDERS CONTAIN IIRAINAGE STRUCTURES EACH. HEIGHT ADJUSTMENTS OR REHABILITATION WILL NOT BE REQUIRED.
 - REFER TO SHEET 3 FOR BR 125 COLD PLANE/OVERLAY DETAILS AND SHEET 62 FOR EXPANSION JOINT DETAILS.

621.20 STEEL BEAM GUARDRAIL

MIDDLEBURY:
STA. I+093.5 - STA. I+116.3 RT (22.8 m)
STA. I+094.7 - STA. I+098.5 LT (3.8 m)

621.505 MANUFACTURED TERMINAL SECTION (FLARED)

MIDDLEBURY:
STA. I+116.3 - STA. I+127.7 RT
STA. I+098.5 - STA. I+109.9 LT

621.70 GUARDRAIL APPROACH SECTION TYPE 1

MIDDLEBURY:
STA. I+079.5 - STA. I+094.7 LT (1EA)

621.71 GUARDRAIL APPROACH SECTION TYPE 11

MIDDLEBURY:
STA. I+089.5 - STA. I+093.5 RT (1EA)

621.80 REMOVAL AND DISPOSAL OF GUARDRAIL

MIDDLEBURY:
STA. I+020.0 - STA. I+021.5 RT (1.50 m)
STA. I+079.5 - STA. I+110.0 LT (30.5 m)
STA. I+089.5 - STA. I+128.0 RT (38.5 m)

SIGN LEGEND

R= REMOVE
S= SALVAGE
N= NEW
RET= RETAIN
B-B= BACK TO BACK
EXISTING= _____
NEW= _____

PAVING
PROJECT
LAYOUT
13

SURVEYED BY N/A DATE N/A
DRAWN BY C.A.K. DATE 2/02
SQUAD LEADER D.E.G.
DESIGN FILE NO. pave/01b018/pb018.dgn
IPARM pb018p13.1 DATE 10-JUL-2006 13:5
FILE 10-JUL-2006 13:5
PROJ. NAME SALISBURY - MIDDLEBURY
PROJ. NO. NH_231115
SHEET 22 OF 67 SHEETS _____

646.40 DURABLE 100 mm WHITE LINE
(ALL LINES WILL INCLUDE EDGE LINE BREAKS AND
RADIUS FOR TOWN HIGHWAYS)

MIDDLEBURY:
STA. I+580.0 - STA. I+820.0 LT & RT

646.60 TEMPORARY 100 mm WHITE LINE
(ALL LINES WILL INCLUDE EDGE LINE BREAKS AND
RADIUS FOR TOWN HIGHWAYS)

MIDDLEBURY:
STA. I+580.0 - STA. I+820.0 LT & RT


646.4I DURABLE 100 mm YELLOWLINE
(ALL LINES WILL INCLUDE C/L BREAKS FOR
TOWN HIGHWAYS) S=SOLID, D=DASHED

MIDDLEBURY:
STA. I+580.0 - STA. I+820.0 LT Q RT
S - S

646.6I TEMPORARY 100 mm YELLOW LINE
(ALL LINES WILL INCLUDE C/L BREAKS FOR
TOWN HIGHWAYS) S=SOLID, D=DASHED

MIDDLEBURY:
STA. I+580.0 - STA. I+820.0 LT Q RT
S - S

675.50 REMOVING SIGNS
AS SHOWN - 16

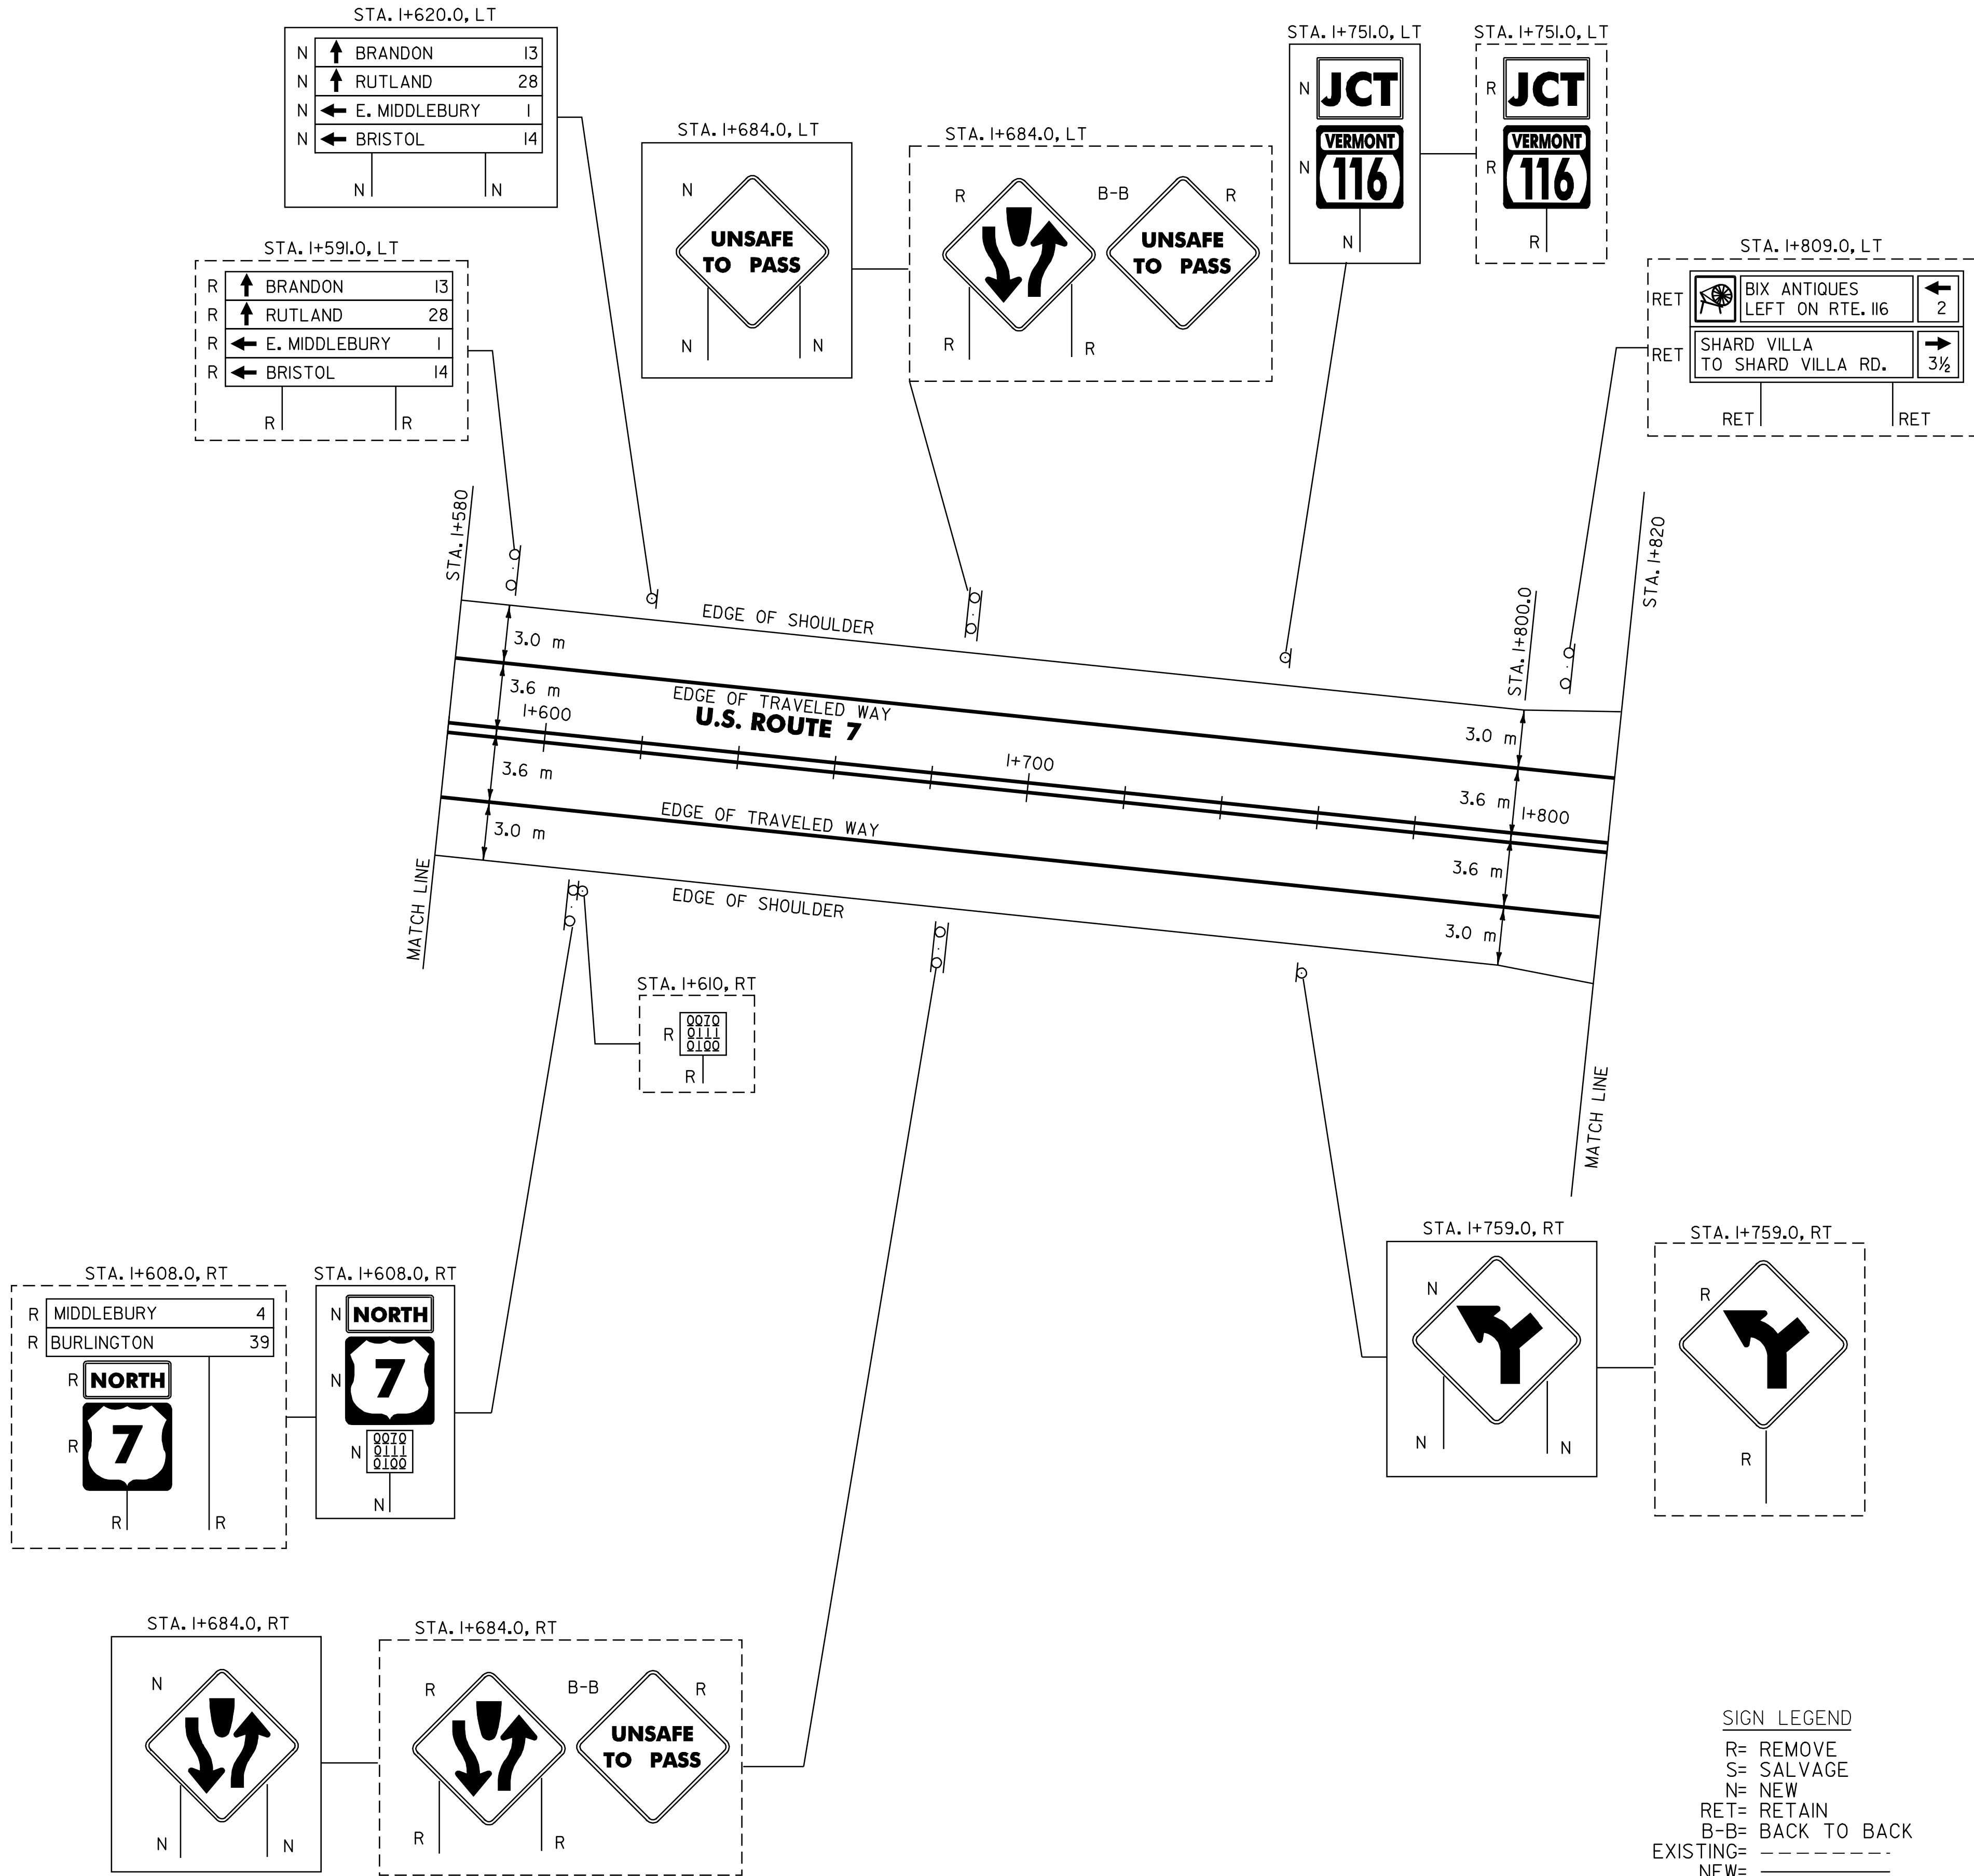

**PAVING
PROJECT
LAYOUT
14**

SURVEYED BY N/A DATE N/A
DRAWN BY C.A.K. DATE 2/02
SQUAD LEADER D.E.G.
DESIGN FILE NO. pave/01b018/pb018.dgn
IPARM pb018p14.i DATE 10-JUL-2006 13:
FILE PLOTTER
PROJ. NAME SALISBURY - MIDDLEBURY
PROJ. NO. NH_231111S
SHEET 23 OF 67 SHEETS

DATUM
VERTICAL N/A
HORIZONTAL N/A

646.40 DURABLE 100 mm WHITE LINE
(ALL LINES WILL INCLUDE EDGE LINE BREAKS AND RADIUS FOR TOWN HIGHWAYS)

MIDDLEBURY:
STA. I+820.0 - STA. 2+100.0 LT & RT
STA. I+983.0 - STA. 2+090.0 LANE LINE 3.6 m LT
STA. I+991.0 - STA. 2+010.0 3.6 m RT
STA. I+991.0 (ALONG VT I25 EDGE OF ISLAND)
STA. 2+090.0 - STA. 2+100.0 DOTTED LINE 3.6 m LT
STA. 2+050.0 - STA. 2+090.0 DASHED LINE 3.6 m RT

646.60 TEMPORARY 100 mm WHITE LINE
(ALL LINES WILL INCLUDE EDGE LINE BREAKS AND RADIUS FOR TOWN HIGHWAYS)

MIDDLEBURY:
STA. I+820.0 - STA. 2+100.0 LT & RT
STA. I+983.0 - STA. 2+090.0 LANE LINE 3.6 m LT
STA. I+991.0 - STA. 2+010.0 3.6 m RT
STA. I+991.0 (ALONG VT I25 EDGE OF ISLAND)
STA. 2+090.0 - STA. 2+100.0 DOTTED LINE 3.6 m LT
STA. 2+050.0 - STA. 2+090.0 DASHED LINE 3.6 m RT

646.41 DURABLE 100 mm YELLOW LINE
(ALL LINES WILL INCLUDE C/L BREAKS FOR TOWN HIGHWAYS) S=SOLID, D=DASHED

MIDDLEBURY:
STA. I+820.0 - STA. I+828.0 LT S RT S
STA. I+828.0 - STA. I+893.0 DOUBLE SOLID LT & RT, (EDGE OF MEDIAN)
STA. I+893.0 - STA. I+963.0 LT & RT, (RAISED ISLAND)
STA. I+982.712 DOUBLE SOLID RT, VT-ROUTE I25
STA. I+991.0 - STA. 2+100.0 SOLID LINE LT & RT
STA. I+994.0 - STA. 2+010.0 (LT EDGE OF RAMP VT I25)

646.61 TEMPORARY 100 mm YELLOW LINE
(ALL LINES WILL INCLUDE C/L BREAKS FOR TOWN HIGHWAYS) S=SOLID, D=DASHED

MIDDLEBURY:
STA. I+820.0 - STA. I+828.0 LT S RT S
STA. I+828.0 - STA. I+893.0 DOUBLE SOLID LT & RT, (EDGE OF MEDIAN)
STA. I+893.0 - STA. I+963.0 LT & RT, (RAISED ISLAND)
STA. I+982.712 DOUBLE SOLID RT, VT-ROUTE I25
STA. I+991.0 - STA. 2+100.0 SOLID LINE LT & RT
STA. I+994.0 - STA. 2+010.0 (LT EDGE OF RAMP VT I25)

646.46 DURABLE 600 mm STOP BAR

MIDDLEBURY:
STA. I+987.712 RT, VT. ROUTE I25

646.66 TEMPORARY 600 mm STOP BAR

MIDDLEBURY:
STA. I+987.712 RT, VT. ROUTE I25

646.50 DURABLE LETTER OR SYMBOL

MIDDLEBURY:
STA. I+987.712 RT, VT. ROUTE I25, "S,T,O,P" (4 EA)
STA. I+991.0 TO I+993.4 LT, ARROW (IEA)
STA. 2+015.2 TO 2+017.6 LT, "O,N,L,Y" (4 EA)
STA. 2+039.3 TO 2+041.7 LT, ARROW (IEA)
STA. 2+063.5 TO 2+065.9 LT, "O,N,L,Y" (4 EA)
STA. 2+087.6 TO 2+090.0 LT, ARROW (IEA)

2+092 ONLY 4 EA
646.70 TEMPORARY LETTER OR SYMBOL

MIDDLEBURY:
STA. I+987.712 RT, VT. ROUTE I25, "S,T,O,P" (4 EA)
STA. I+991.0 TO I+993.4 LT, ARROW (IEA)
STA. 2+039.3 TO 2+041.7 LT, ARROW (IEA)
STA. 2+087.6 TO 2+090.0 LT, ARROW (IEA)

646.42 DURABLE 200 mm WHITE LINE

MIDDLEBURY:
STA. I+991.0 - STA. I+994.0 RT (GORE LINE)
STA. 2+010.0 - STA. 2+050.0 RT (GORE LINE)

646.62 TEMPORARY 200 mm WHITE LINE

MIDDLEBURY:
STA. I+991.0 - STA. I+994.0 RT (GORE LINE)
STA. 2+010.0 - STA. 2+050.0 RT (GORE LINE)

646.43 DURABLE 200 mm YELLOW LINE


MIDDLEBURY:
STA. I+828.0 - STA. I+893.0 RT (DIAGONALS MEDIAN) (150 m)

646.63 TEMPORARY 200 mm YELLOW LINE

MIDDLEBURY:
STA. I+828.0 - STA. I+893.0 RT (DIAGONALS MEDIAN) (150 m)

PAVEMENT CORES

CORE #	POSITION	MM STA.	PLAN STA.	CORE DEPTH(mm)	PCC UNDER
1	NB LANE	I.185	I+907	50	NO
2	NB LANE	I.200	I+931	150	NO
3	SB LANE	I.200	I+931	75	NO

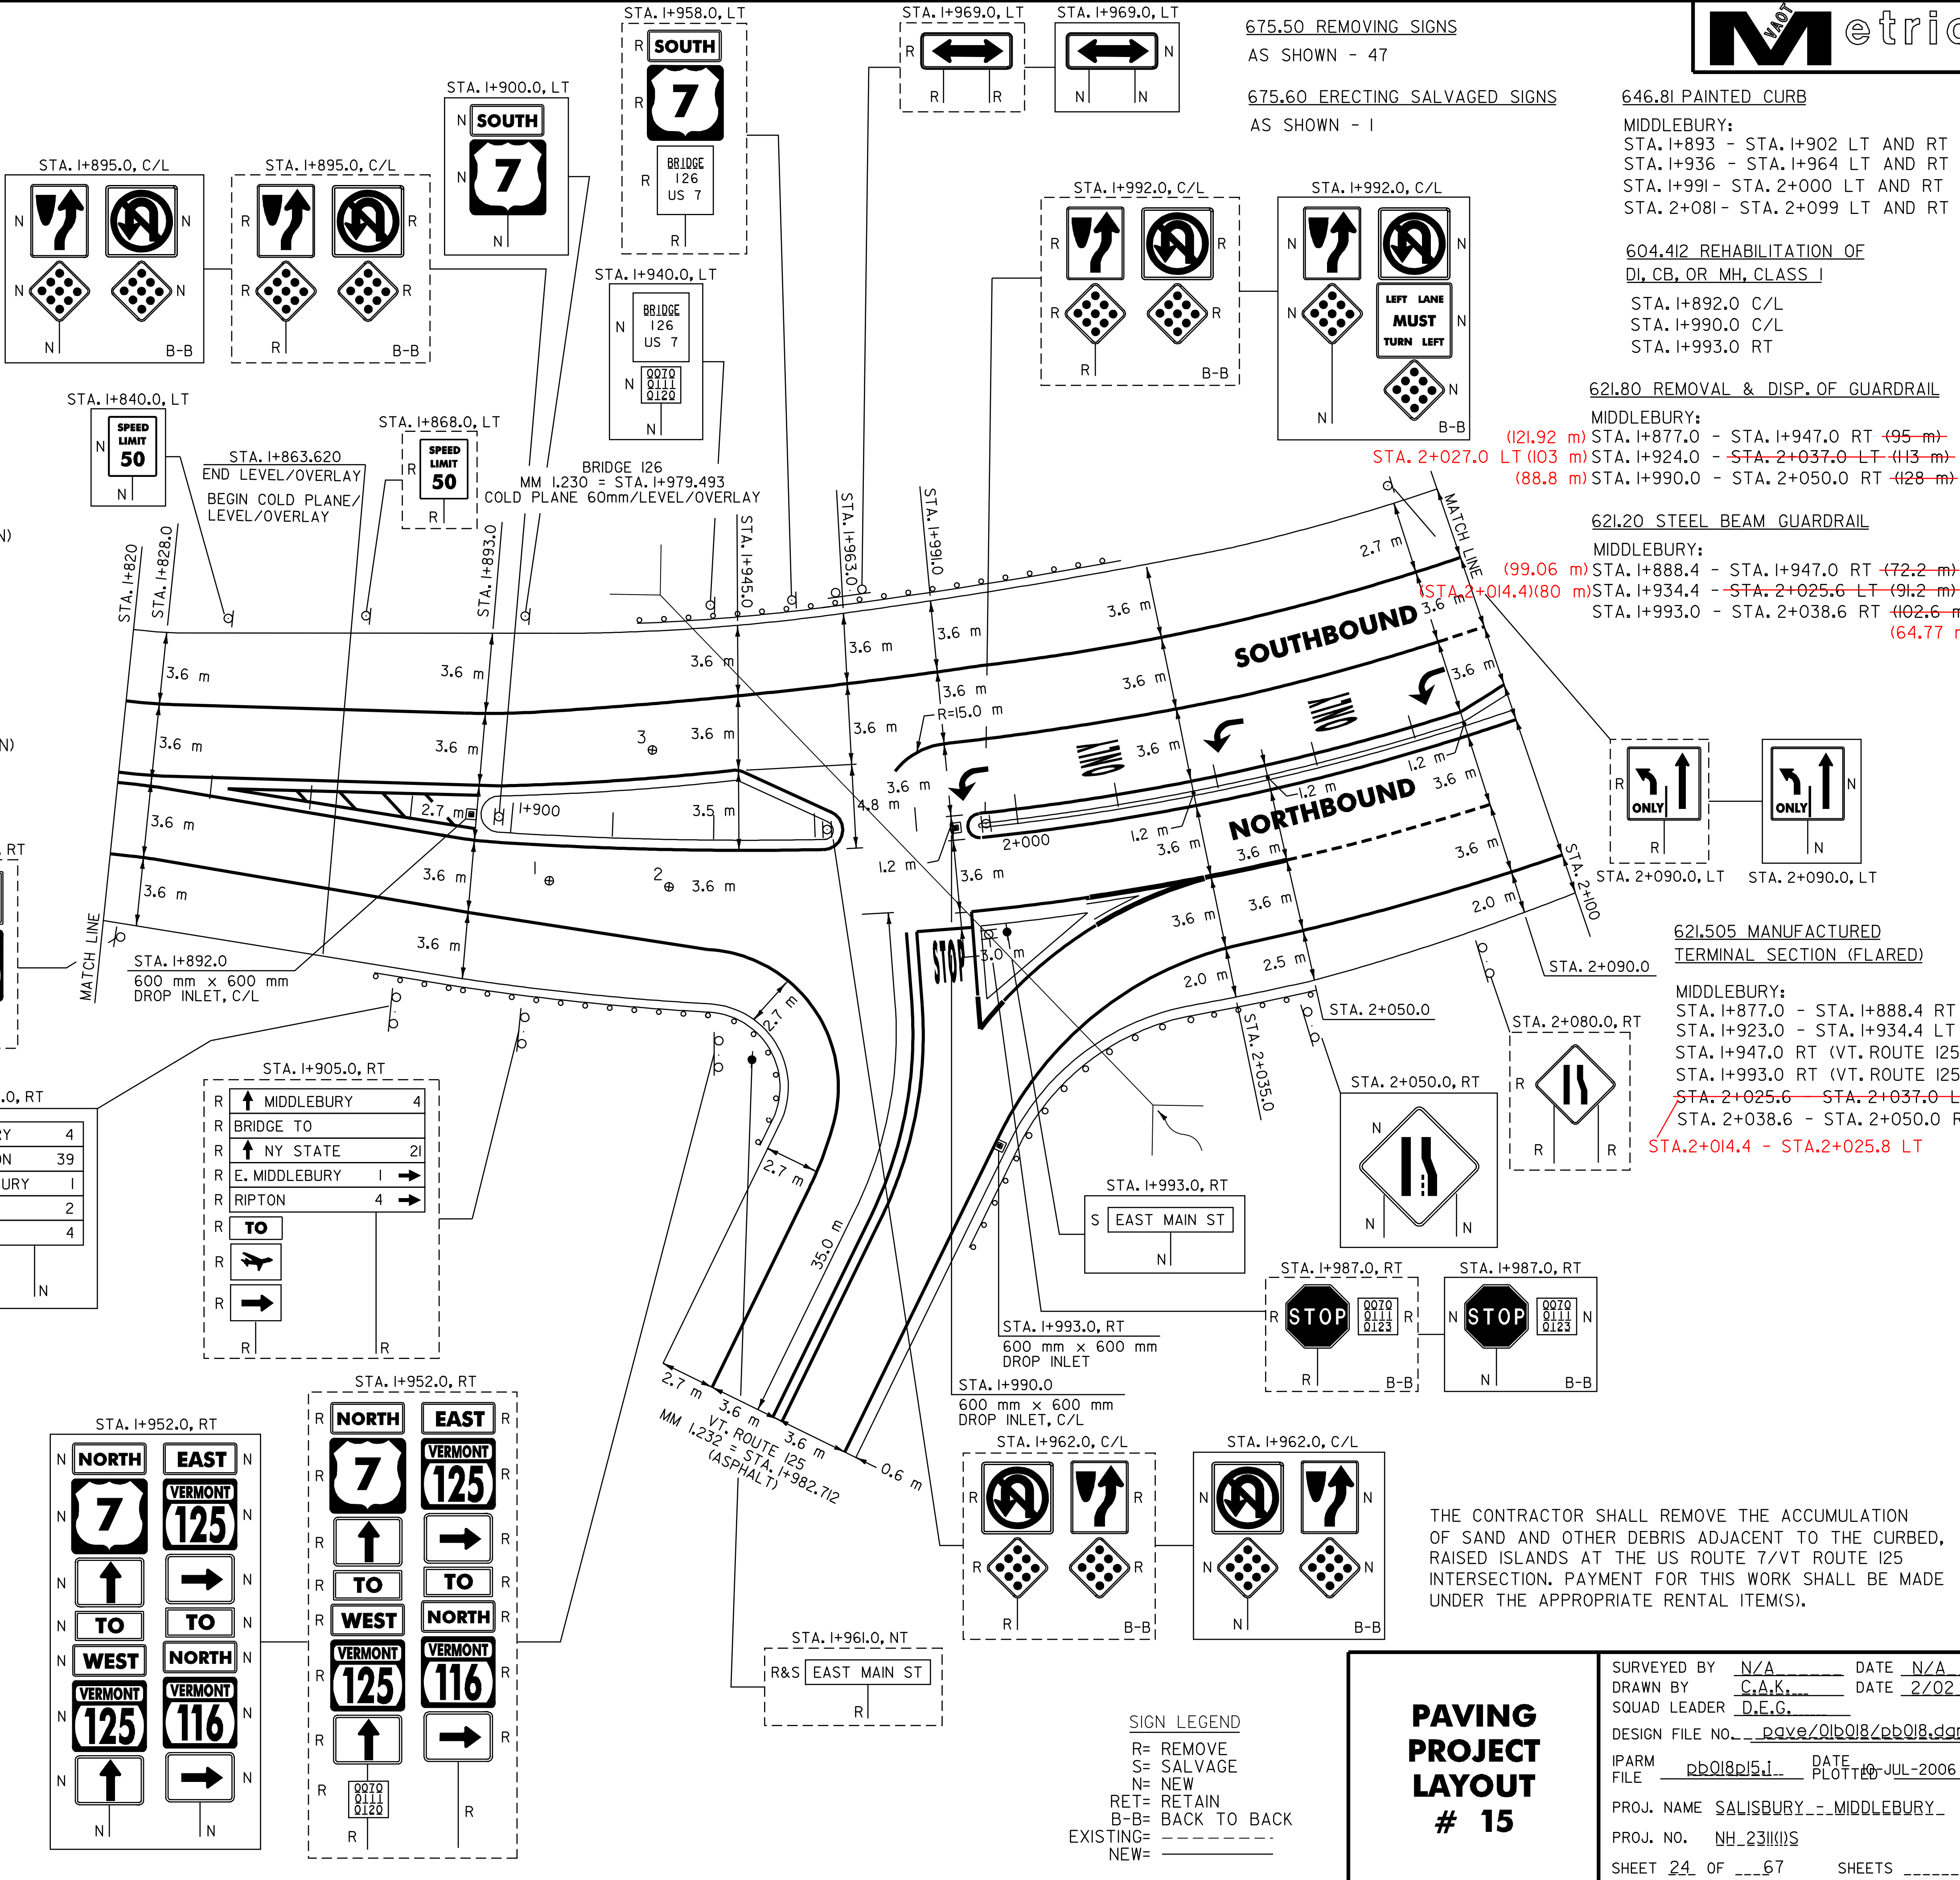

675.50 REMOVING SIGNS
AS SHOWN - 47

675.60 ERECTING SALVAGED SIGNS
AS SHOWN - 1

646.81 PAINTED CURB

MIDDLEBURY:
STA. I+893 - STA. I+902 LT AND RT
STA. I+936 - STA. I+964 LT AND RT
STA. I+991 - STA. 2+000 LT AND RT
STA. 2+081 - STA. 2+099 LT AND RT

604.412 REHABILITATION OF
DI, CB, OR MH, CLASS I

STA. I+892.0 C/L
STA. I+990.0 C/L
STA. I+993.0 RT

621.80 REMOVAL & DISP. OF GUARDRAIL

MIDDLEBURY:
(121.92 m) STA. I+877.0 - STA. I+947.0 RT ~~(95-m)~~
STA. I+924.0 - STA. 2+037.0 LT ~~(113-m)~~
(88.8 m) STA. I+990.0 - STA. 2+050.0 RT ~~(128-m)~~

621.20 STEEL BEAM GUARDRAIL

MIDDLEBURY:
(99.06 m) STA. I+888.4 - STA. I+947.0 RT ~~(72.2-m)~~
STA. I+934.4 - STA. 2+025.6 LT ~~(91.2-m)~~
STA. I+993.0 - STA. 2+038.6 RT ~~(102.6-m)~~
(64.77 m)

621.505 MANUFACTURED
TERMINAL SECTION (FLARED)

MIDDLEBURY:
STA. I+877.0 - STA. I+888.4 RT
STA. I+923.0 - STA. I+934.4 LT
STA. I+947.0 RT (VT. ROUTE I25)
STA. I+993.0 RT (VT. ROUTE I25)
~~STA. 2+025.6 - STA. 2+037.0 LT~~
STA. 2+038.6 - STA. 2+050.0 RT
STA. 2+014.4 - STA. 2+025.8 LT

THE CONTRACTOR SHALL REMOVE THE ACCUMULATION OF SAND AND OTHER DEBRIS ADJACENT TO THE CURBED, RAISED ISLANDS AT THE US ROUTE 7/VT ROUTE I25 INTERSECTION. PAYMENT FOR THIS WORK SHALL BE MADE UNDER THE APPROPRIATE RENTAL ITEM(S).

SIGN LEGEND

R= REMOVE
S= SALVAGE
N= NEW
RET= RETAIN
B-B= BACK TO BACK
EXISTING= _____
NEW= _____

PAVING
PROJECT
LAYOUT
15

SURVEYED BY N/A DATE N/A
DRAWN BY C.A.K. DATE 2/02
SQUAD LEADER D.E.G.
DESIGN FILE NO. paye/01b018/pb018.dgn
IPARM pb018p15.1 DATE 10-JUL-2006 13:
FILE PLOTTED
PROJ. NAME SALISBURY - MIDDLEBURY
PROJ. NO. NH_231111
SHEET 24 OF 67 SHEETS _____

646.40 DURABLE 100 mm WHITE LINE
(ALL LINES WILL INCLUDE EDGE LINE BREAKS AND
RADIUS FOR TOWN HIGHWAYS)
MIDDLEBURY:
STA. 2+100.0 - STA. 2+340.0 LT & RT
STA. 2+100.0 - STA. 2+150.0 DASHED LINE LT
STA. 2+150.0 - STA. 2+182.0 LT & RT (SOLID LINE BETWEEN ISLANDS)
STA. 2+150.0 - STA. 2+182.0 LT & RT (DASHED LINE BETWEEN ISLANDS)

646.60 TEMPORARY 100 mm WHITE LINE
(ALL LINES WILL INCLUDE EDGE LINE BREAKS AND
RADIUS FOR TOWN HIGHWAYS)
MIDDLEBURY:
STA. 2+100.0 - STA. 2+340.0 LT & RT
STA. 2+100.0 - STA. 2+150.0 DASHED LINE LT
STA. 2+150.0 - STA. 2+182.0 LT & RT (SOLID LINE BETWEEN ISLANDS)
STA. 2+150.0 - STA. 2+182.0 LT & RT (DASHED LINE BETWEEN ISLANDS)

646.41 DURABLE 100 mm YELLOW LINE
(ALL LINES WILL INCLUDE C/L BREAKS FOR
TOWN HIGHWAYS) S=SOLID, D=DASHED
MIDDLEBURY:
STA. 2+333.0 - STA. 2+340.0 LT CL RT
STA. 2+100.0 - STA. 2+158.0 SOLID LINE LT & RT (RAISED ISLAND)
STA. 2+180.0 - STA. 2+248.0 SOLID LINE LT & RT (RAISED ISLAND)
STA. 2+248.0 - STA. 2+333.0 DOUBLE SOLID LT & RT (EDGE OF MEDIAN)

646.61 TEMPORARY 100 mm YELLOW LINE
(ALL LINES WILL INCLUDE C/L BREAKS FOR
TOWN HIGHWAYS) S=SOLID, D=DASHED
MIDDLEBURY:
STA. 2+333.0 - STA. 2+340.0 LT CL RT
STA. 2+100.0 - STA. 2+158.0 SOLID LINE LT & RT (RAISED ISLAND)
STA. 2+180.0 - STA. 2+248.0 SOLID LINE LT & RT (RAISED ISLAND)
STA. 2+248.0 - STA. 2+333.0 DOUBLE SOLID LT & RT (EDGE OF MEDIAN)

646.43 DURABLE 200 mm YELLOW LINE
MIDDLEBURY:
STA. 2+248.0 - STA. 2+333.0 (DIAGONALS MEDIAN) (250 m)


646.63 TEMPORARY 200 mm YELLOW LINE
MIDDLEBURY:
STA. 2+248.0 - STA. 2+333.0 (DIAGONALS MEDIAN) (250 m)

675.50 REMOVING SIGNS
AS SHOWN - 33

646.81 PAINTED CURB
MIDDLEBURY:
STA. 2+147 - STA. 2+156 LT AND RT
STA. 2+181 - STA. 2+190 LT AND RT
STA. 2+240 - STA. 2+249 LT AND RT

604.412 REHABILITATION OF
DI, CB, OR MH, CLASS I
STA. 2+181.0 C/L

DATUM
VERTICAL N/A
HORIZONTAL N/A

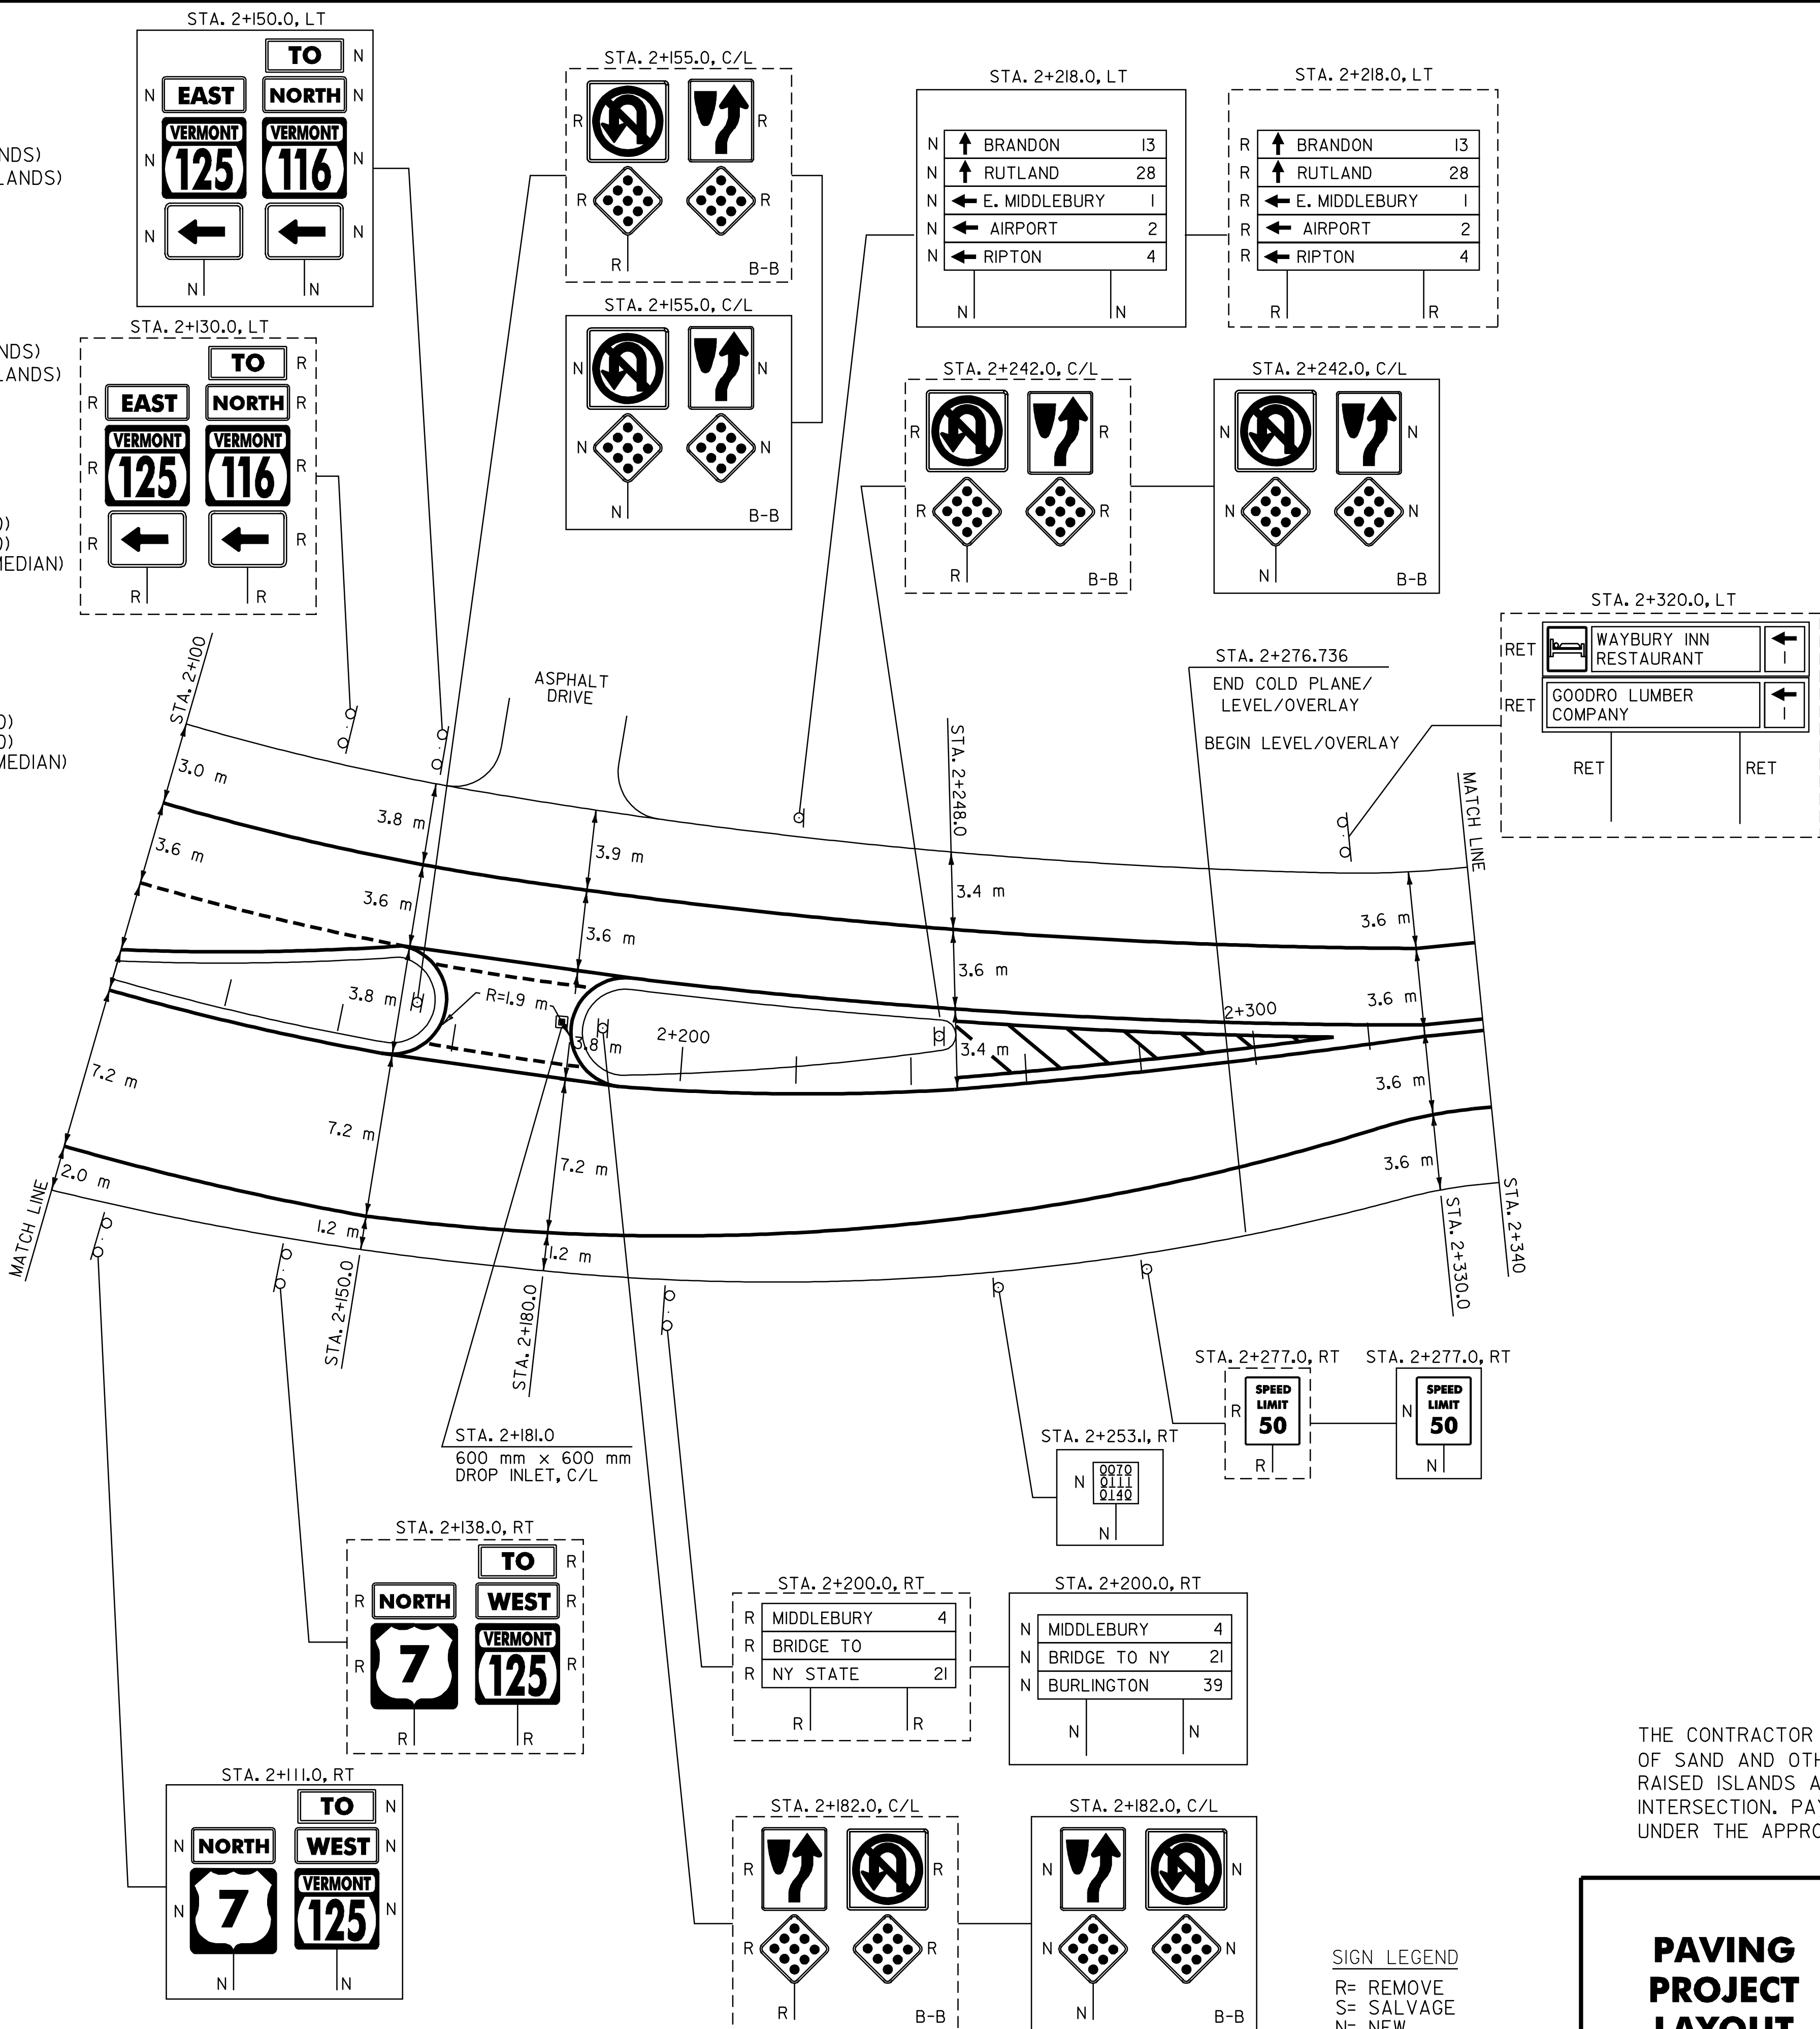

THE CONTRACTOR SHALL REMOVE THE ACCUMULATION
OF SAND AND OTHER DEBRIS ADJACENT TO THE CURBED,
RAISED ISLANDS AT THE US ROUTE 7/VT ROUTE 125
INTERSECTION. PAYMENT FOR THIS WORK SHALL BE MADE
UNDER THE APPROPRIATE RENTAL ITEM(S).

PAVING
PROJECT
LAYOUT
16

SIGN LEGEND
R= REMOVE
S= SALVAGE
N= NEW
RET= RETAIN
B-B= BACK TO BACK
EXISTING= _____
NEW= _____

SURVEYED BY N/A DATE N/A
DRAWN BY C.A.K. DATE 2/02
SQUAD LEADER D.E.G.
DESIGN FILE NO. pave/01b018/pb018.dgn
IPARM pb018pl6.i DATE 10-JUL-2006 13:3
FILE PLOTTED
PROJ. NAME SALISBURY--MIDDLEBURY--
PROJ. NO. NH_231111S
SHEET 25 OF 67 SHEETS

646.40 DURABLE 100 mm WHITE LINE
(ALL LINES WILL INCLUDE EDGE LINE BREAKS AND
RADIUS FOR TOWN HIGHWAYS)
MIDDLEBURY:
STA. 2+340.0 - STA. 2+640.0 LT & RT

646.60 TEMPORARY 100 mm WHITE LINE
(ALL LINES WILL INCLUDE EDGE LINE BREAKS AND
RADIUS FOR TOWN HIGHWAYS)
MIDDLEBURY:
STA. 2+340.0 - STA. 2+640.0 LT & RT


646.41 DURABLE 100 mm YELLOW LINE
(ALL LINES WILL INCLUDE C/L BREAKS FOR
TOWN HIGHWAYS) S=SOLID, D=DASHED

MIDDLEBURY:	LT	CL	RT
STA. 2+340.0 - STA. 2+382.0	S	-	S
STA. 2+382.0 - STA. 2+506.0	S	-	D
STA. 2+506.0 - STA. 2+588.0	-	D	-
STA. 2+588.0 - STA. 2+640.0	D	-	S

646.61 TEMPORARY 100 mm YELLOW LINE
(ALL LINES WILL INCLUDE C/L BREAKS FOR
TOWN HIGHWAYS) S=SOLID, D=DASHED

MIDDLEBURY:	LT	CL	RT
STA. 2+340.0 - STA. 2+382.0	S	-	S
STA. 2+382.0 - STA. 2+506.0	S	-	D
STA. 2+506.0 - STA. 2+588.0	-	D	-
STA. 2+588.0 - STA. 2+640.0	D	-	S

675.50 REMOVING SIGNS
AS SHOWN - 5

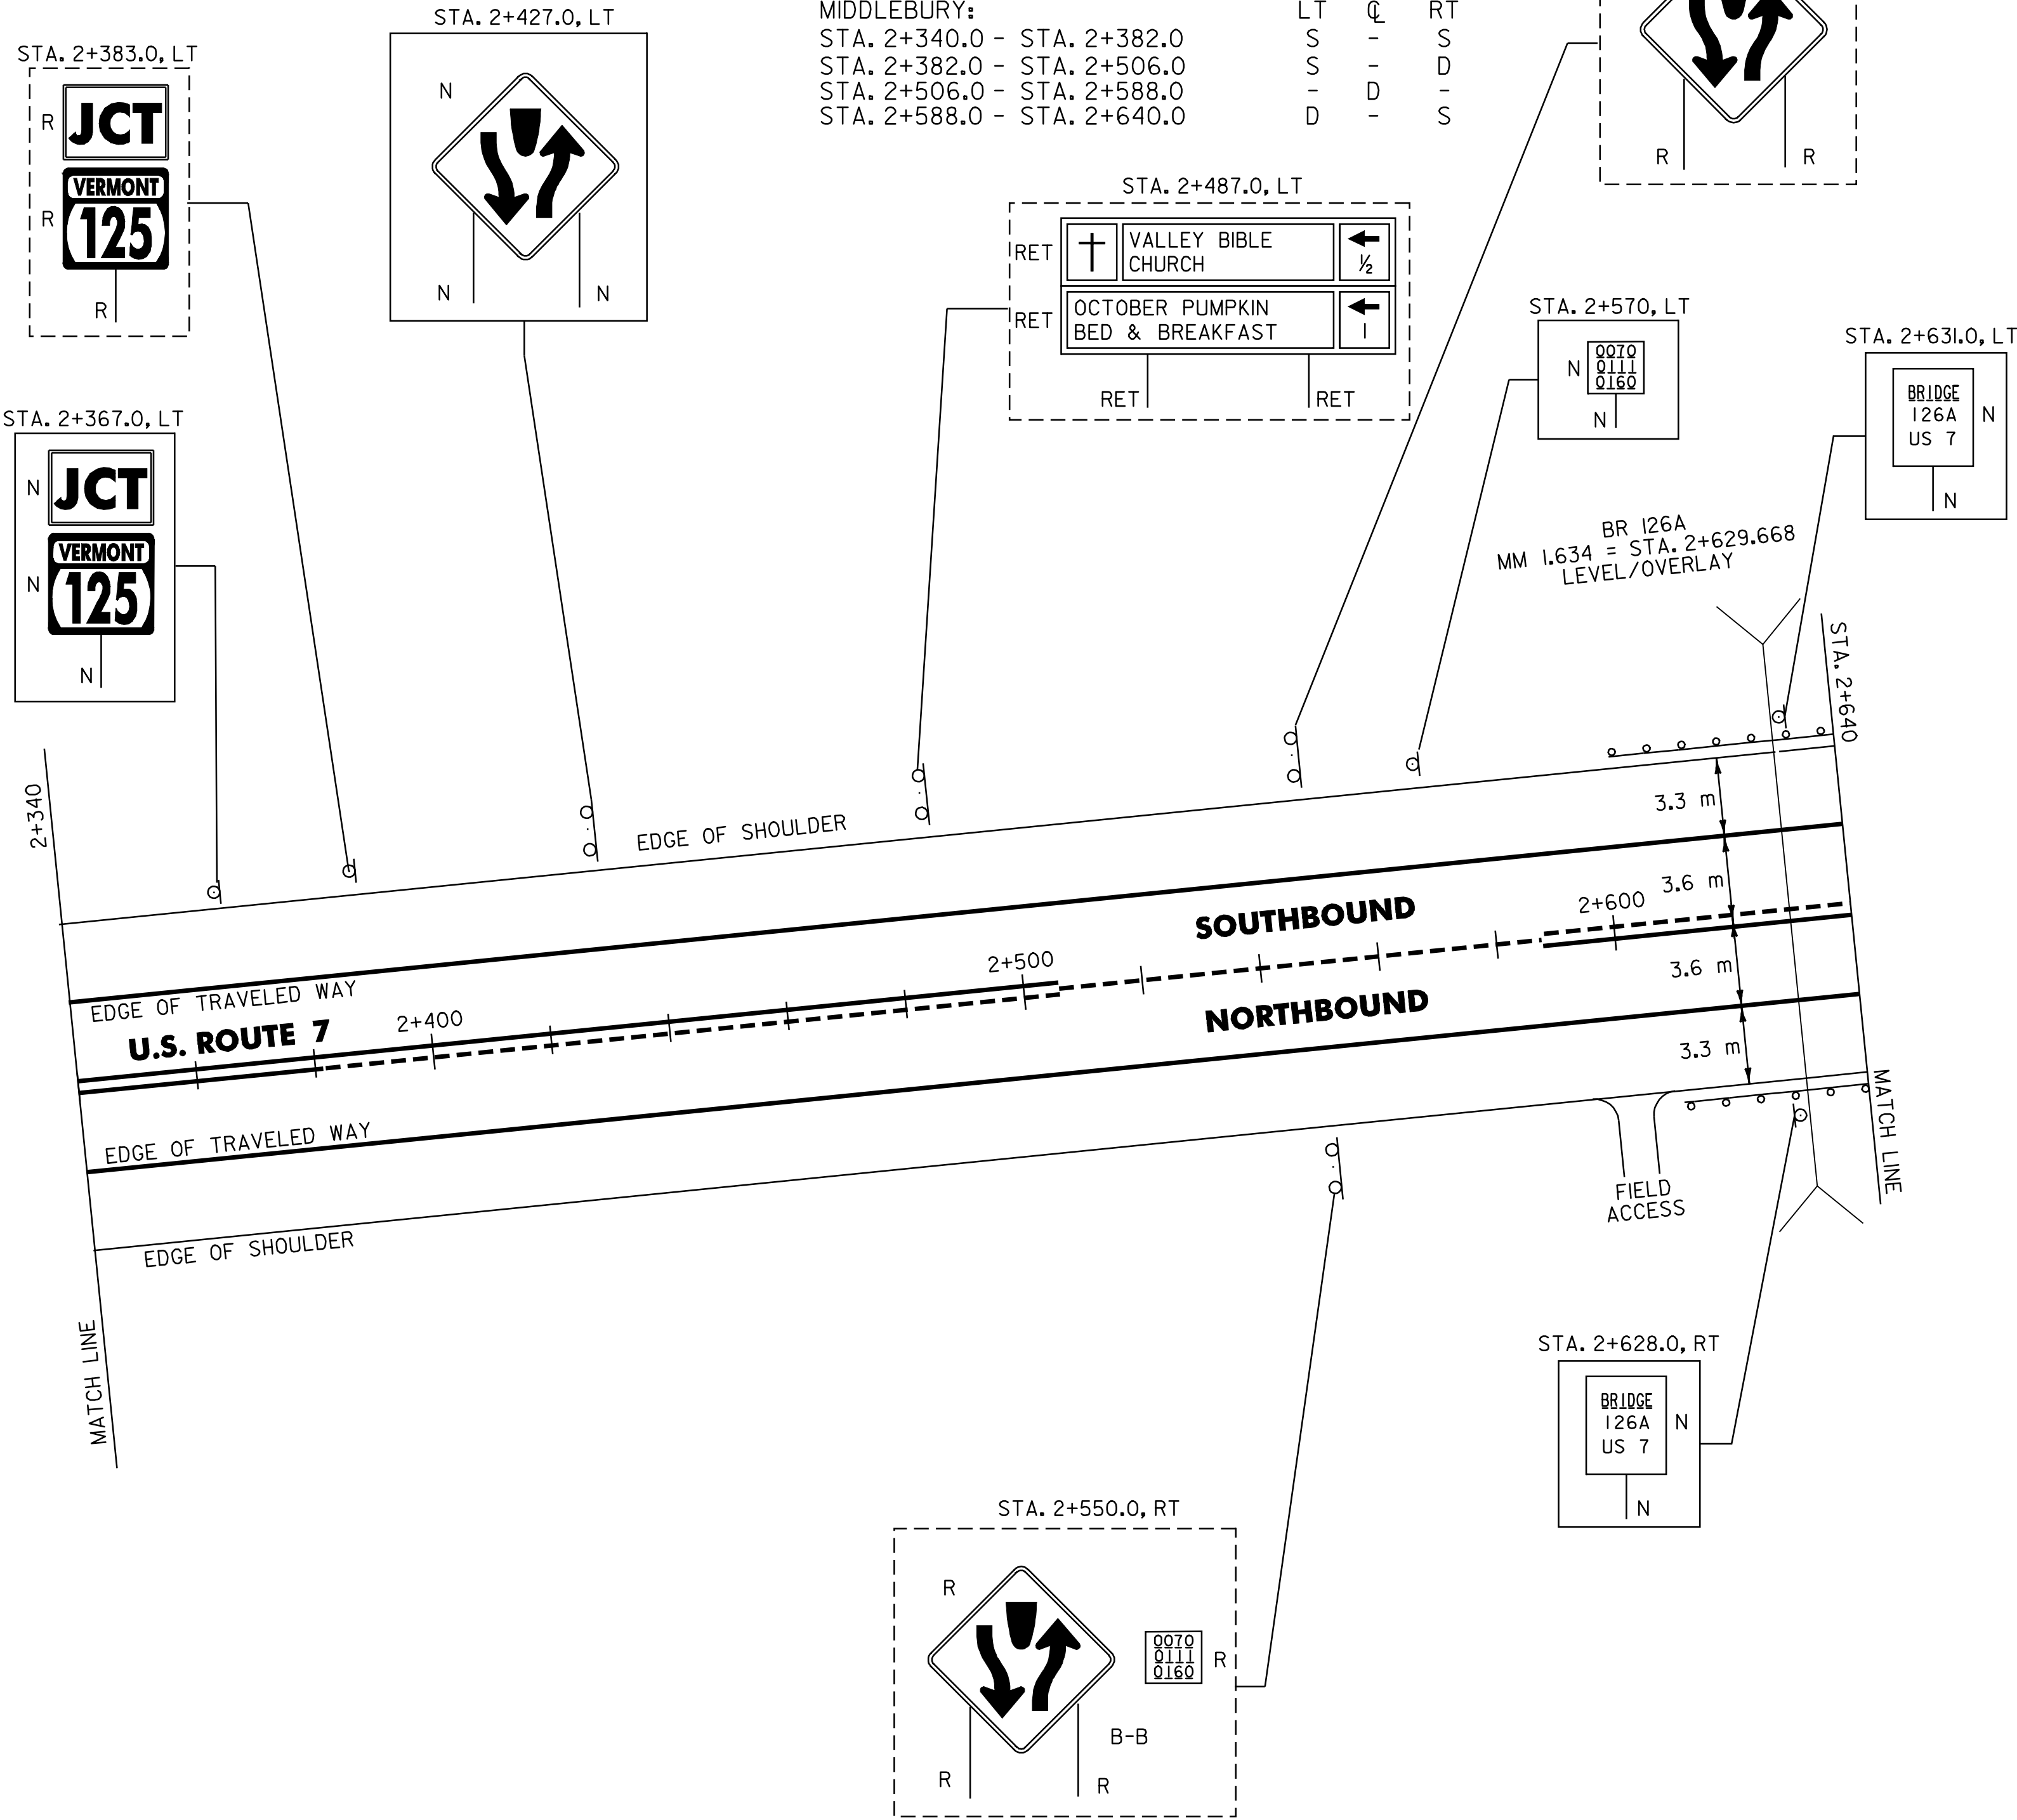

621.20 STEEL BEAM GUARDRAIL

MIDDLEBURY:
STA. 2+612.8 - STA. 2+635.6 LT (22.8 m)
STA. 2+619.3 - STA. 2+630.7 RT (11.4 m)

621.505 MANUFACTURED TERMINAL SECTION (FLARED)

MIDDLEBURY:
STA. 2+601.4 - STA. 2+612.8 LT
STA. 2+607.9 - STA. 2+619.3 RT
STA. 2+630.7 - STA. 2+642.1 RT
STA. 2+635.6 - STA. 2+647.0 LT

621.80 REMOVAL AND DISPOSAL OF GUARDRAIL

MIDDLEBURY:
STA. 2+601.0 - STA. 2+647.0 LT (46.0 m)
STA. 2+608.0 - STA. 2+642.0 RT (34.0 m)

SIGN LEGEND
R= REMOVE
S= SALVAGE
N= NEW
RET= RETAIN
B-B= BACK TO BACK
EXISTING= -----
NEW= -----

PAVING
PROJECT
LAYOUT
17

SURVEYED BY N/A DATE N/A
DRAWN BY C.A.K. DATE 2/02
SQUAD LEADER D.E.G.
DESIGN FILE NO. pave/01b018/pb018.dgn
IPARM pb018p17.i DATE 10-JUL-2006 13:51
FILE 10-JUL-2006 13:51
PROJ. NAME SALISBURY - MIDDLEBURY
PROJ. NO. NH_231111
SHEET 26 OF 67 SHEETS -----

DATUM
VERTICAL N/A
HORIZONTAL N/A

646.40 DURABLE 100 mm WHITE LINE
(ALL LINES WILL INCLUDE EDGE LINE BREAKS AND RADIUS FOR TOWN HIGHWAYS)
MIDDLEBURY:
STA. 2+640.0 - STA. 3+180.0 LT & RT

646.60 TEMPORARY 100 mm WHITE LINE
(ALL LINES WILL INCLUDE EDGE LINE BREAKS AND RADIUS FOR TOWN HIGHWAYS)
MIDDLEBURY:
STA. 2+640.0 - STA. 3+180.0 LT & RT

646.41 DURABLE 100 mm YELLOW LINE
(ALL LINES WILL INCLUDE C/L BREAKS FOR TOWN HIGHWAYS) S=SOLID, D=DASHED
MIDDLEBURY:
STA. 2+640.0 - STA. 2+752.0 LT Q RT
STA. 2+640.0 - STA. 2+752.0 D - S
STA. 2+752.0 - STA. 2+993.4 S - S
STA. 2+993.4 - STA. 3+180.0 S - D
STA. 2+766.462 DOUBLE SOLID RT, T-24

646.61 TEMPORARY 100 mm YELLOW LINE
(ALL LINES WILL INCLUDE C/L BREAKS FOR TOWN HIGHWAYS) S=SOLID, D=DASHED
MIDDLEBURY:
STA. 2+640.0 - STA. 2+752.0 LT Q RT
STA. 2+640.0 - STA. 2+752.0 D - S
STA. 2+752.0 - STA. 2+993.4 S - S
STA. 2+993.4 - STA. 3+180.0 S - D
STA. 2+766.462 DOUBLE SOLID RT, T-24

646.46 DURABLE 600 mm STOP BAR
MIDDLEBURY:
STA. 2+766.462 RT, T-24


646.66 TEMPORARY 600 mm STOP BAR
MIDDLEBURY:
STA. 2+766.462 RT, T-24

646.50 DURABLE LETTER OR SYMBOL
MIDDLEBURY:
STA. 2+766.462 RT, T-24, "S,T,O,P" (4 EA)

646.70 TEMPORARY LETTER OR SYMBOL
MIDDLEBURY:
STA. 2+766.462 RT, T-24, "S,T,O,P" (4 EA)

675.50 REMOVING SIGNS
AS SHOWN - 7

675.60 ERECTING SALVAGED SIGNS
AS SHOWN - 1

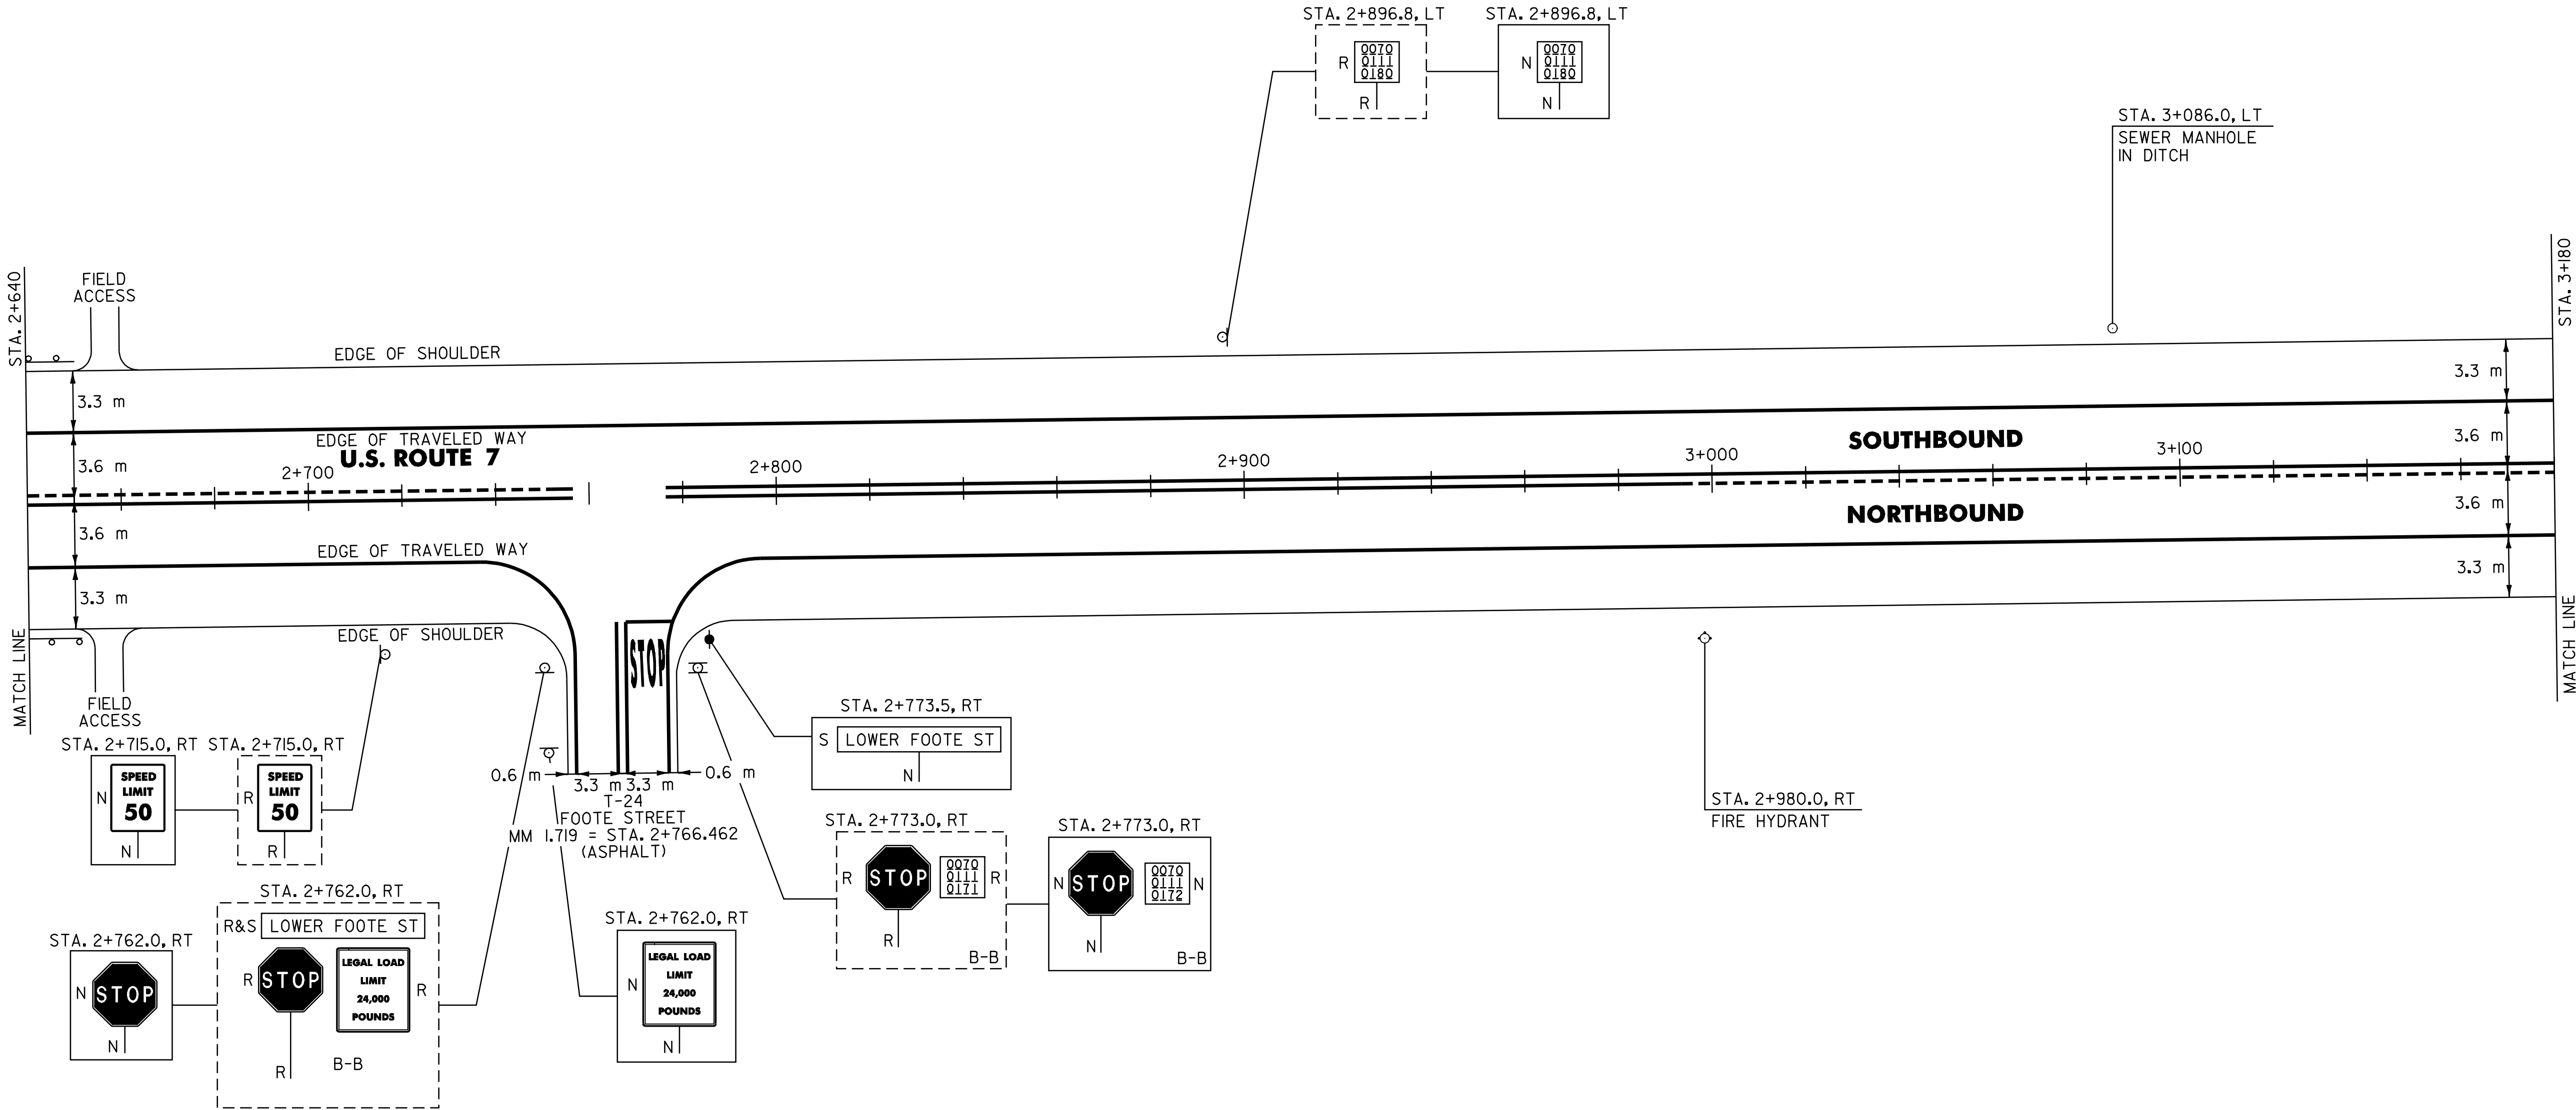

NOTE:
I. PAVING LIMIT ON ALL TOWN HIGHWAYS SHALL BE MEASURED 8 m BACK FROM U.S. ROUTE 7 EDGE OF SHOULDER UNLESS DENOTED OTHERWISE ON THE PLANS OR AS DIRECTED BY THE RESIDENT ENGINEER.

SIGN LEGEND
R= REMOVE
S= SALVAGE
N= NEW
RET= RETAIN
B-B= BACK TO BACK
EXISTING= -----
NEW= -----

PAVING
PROJECT
LAYOUT
18

SURVEYED BY N/A DATE N/A
DRAWN BY C.A.K. DATE 2/02
SQUAD LEADER D.E.G.
DESIGN FILE NO. pave/01b018/pb018.dgn
IPARM p018p1 DATE 10 JUL-2006 13:51
FILE p018p1 PLOTTER
PROJ. NAME SALISBURY - MIDDLEBURY
PROJ. NO. NH_231111S
SHEET 27 OF 67 SHEETS

DATUM
VERTICAL N/A
HORIZONTAL N/A

646.40 DURABLE 100 mm WHITE LINE

(ALL LINES WILL INCLUDE EDGE LINE BREAKS AND RADIUS FOR TOWN HIGHWAYS)

MIDDLEBURY:

STA. 3+180.0 - STA. 3+720.0 LT & RT

646.60 TEMPORARY 100 mm WHITE LINE

(ALL LINES WILL INCLUDE EDGE LINE BREAKS AND RADIUS FOR TOWN HIGHWAYS)

MIDDLEBURY:

STA. 3+180.0 - STA. 3+720.0 LT & RT

646.41 DURABLE 100 mm YELLOW LINE

(ALL LINES WILL INCLUDE C/L BREAKS FOR TOWN HIGHWAYS) S=SOLID, D=DASHED

MIDDLEBURY:

	LT	CL	RT
STA. 3+180.0 - STA. 3+218.7	S	-	D
STA. 3+218.7 - STA. 3+339.4	-	D	-
STA. 3+339.4 - STA. 3+452.0	D	-	S
STA. 3+452.0 - STA. 3+500.0	S	-	S
STA. 3+500.0 - STA. 3+689.0	S	-	D
STA. 3+689.0 - STA. 3+720.0	-	D	-

646.61 TEMPORARY 100 mm YELLOW LINE

(ALL LINES WILL INCLUDE C/L BREAKS FOR TOWN HIGHWAYS) S=SOLID, D=DASHED

MIDDLEBURY:

	LT	CL	RT
STA. 3+180.0 - STA. 3+218.7	S	-	D
STA. 3+218.7 - STA. 3+339.4	-	D	-
STA. 3+339.4 - STA. 3+452.0	D	-	S
STA. 3+452.0 - STA. 3+500.0	S	-	S
STA. 3+500.0 - STA. 3+689.0	S	-	D
STA. 3+689.0 - STA. 3+720.0	-	D	-

STA. 3+482.620 DOUBLE SOLID RT, T-I2

646.46 DURABLE 600 mm STOP BAR**MIDDLEBURY:**

STA. 3+482.620 RT, T-I2

646.66 TEMPORARY 600 mm STOP BAR**MIDDLEBURY:**

STA. 3+482.620 RT, T-I2

646.50 DURABLE LETTER OR SYMBOL**MIDDLEBURY:**


STA. 3+482.620 RT, T-I2, "S,T,O,P" (4 EA)

646.70 TEMPORARY LETTER OR SYMBOL**MIDDLEBURY:**

STA. 3+482.620 RT, T-I2, "S,T,O,P" (4 EA)

675.50 REMOVING SIGNS

AS SHOWN - 7

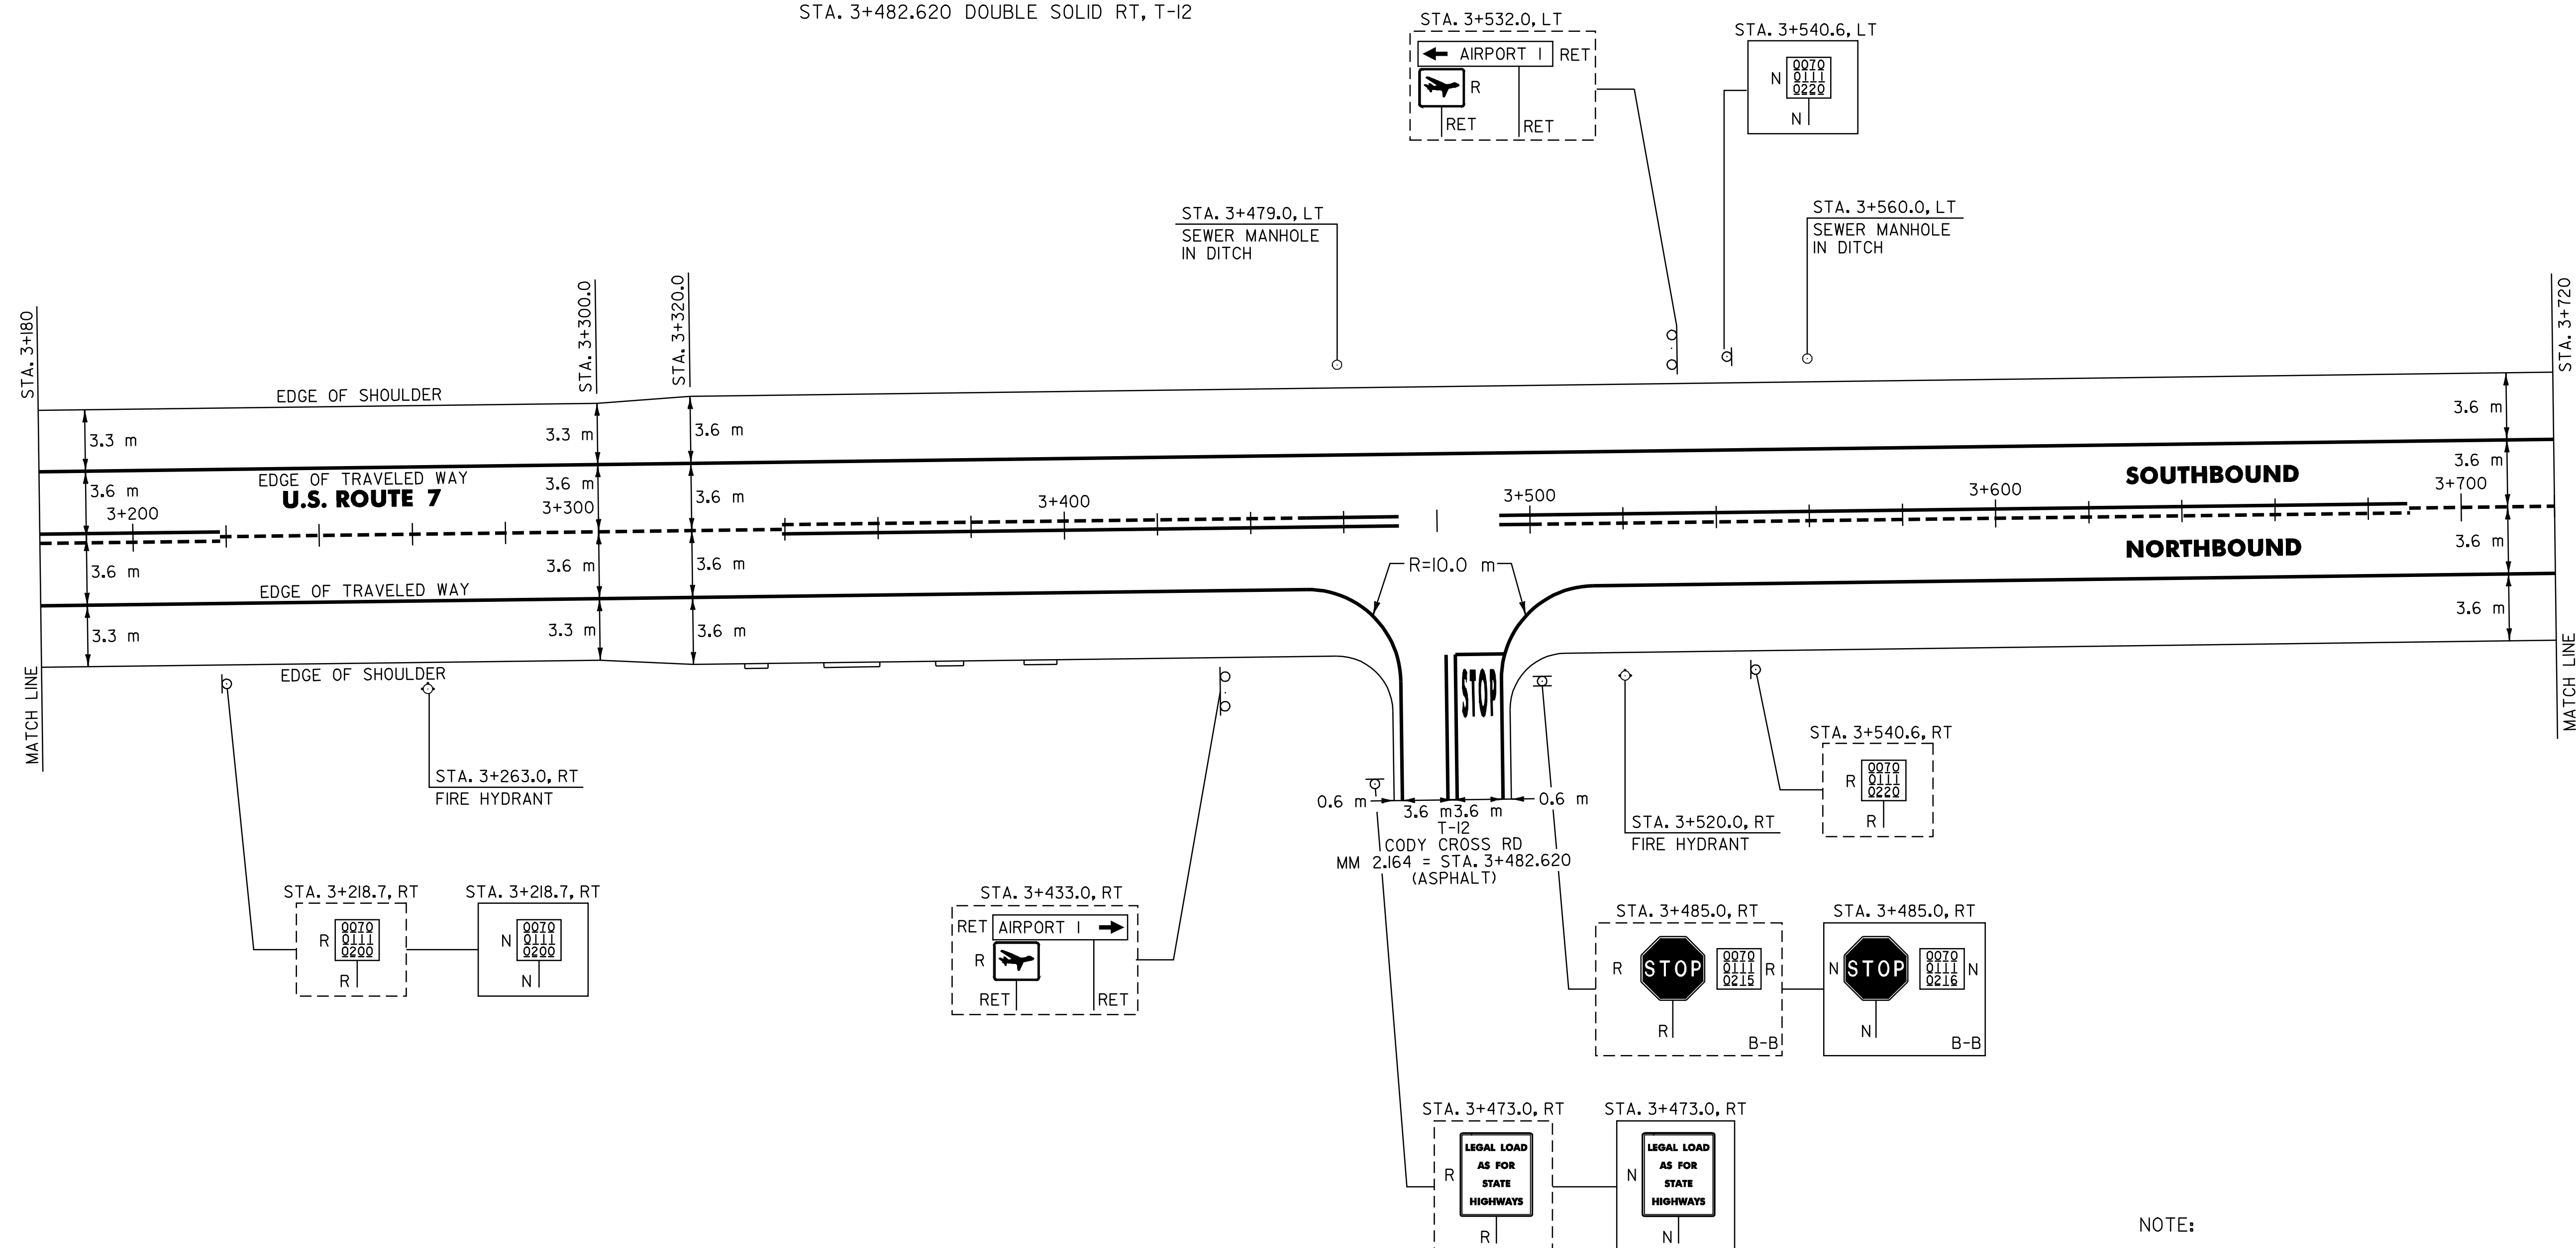**NOTE:**

I. PAVING LIMIT ON ALL TOWN HIGHWAYS SHALL BE MEASURED 8 m BACK FROM U.S. ROUTE 7 EDGE OF SHOULDER UNLESS DENOTED OTHERWISE ON THE PLANS OR AS DIRECTED BY THE RESIDENT ENGINEER.

SIGN LEGEND

R= REMOVE
S= SALVAGE
N= NEW
RET= RETAIN
B-B= BACK TO BACK
EXISTING= _____
NEW= _____

**PAVING
PROJECT
LAYOUT
19**

SURVEYED BY N/A DATE N/A
DRAWN BY C.A.K. DATE 2/02
SQUAD LEADER D.E.G.
DESIGN FILE NO. pave/01b018/pb018.dgn
IPARM pb018p19.i DATE 10-JUL-2006 13:5
FILE 10-JUL-2006 13:5
PROJ. NAME SALISBURY - MIDDLEBURY
PROJ. NO. NH_231111S
SHEET 28 OF 67 SHEETS _____

DATUMVERTICAL N/AHORIZONTAL N/A

646.40 DURABLE 100 mm WHITE LINE
(ALL LINES WILL INCLUDE EDGE LINE BREAKS AND RADIUS FOR TOWN HIGHWAYS)
MIDDLEBURY:
STA. 3+720.0 - STA. 4+260.0 LT & RT

646.60 TEMPORARY 100 mm WHITE LINE
(ALL LINES WILL INCLUDE EDGE LINE BREAKS AND RADIUS FOR TOWN HIGHWAYS)
MIDDLEBURY:
STA. 3+720.0 - STA. 4+260.0 LT & RT

646.41 DURABLE 100 mm YELLOW LINE
(ALL LINES WILL INCLUDE C/L BREAKS FOR TOWN HIGHWAYS) S=SOLID, D=DASHED
MIDDLEBURY:
STA. 3+720.0 - STA. 3+887.0 LT - D RT - D
STA. 3+887.0 - STA. 4+063.6 D - S
STA. 4+063.6 - STA. 4+128.0 S - S
STA. 4+128.0 - STA. 4+260.0 S - D
STA. 4+092.562 DOUBLE SOLID LT, T-26
STA. 4+115.093 DOUBLE SOLID RT, T-7

646.61 TEMPORARY 100 mm YELLOW LINE
(ALL LINES WILL INCLUDE C/L BREAKS FOR TOWN HIGHWAYS) S=SOLID, D=DASHED
MIDDLEBURY:
STA. 3+720.0 - STA. 3+887.0 LT - D RT - D
STA. 3+887.0 - STA. 4+063.6 D - S
STA. 4+063.6 - STA. 4+128.0 S - S
STA. 4+128.0 - STA. 4+260.0 S - D
STA. 4+092.562 DOUBLE SOLID LT, T-26
STA. 4+115.093 DOUBLE SOLID RT, T-7

646.46 DURABLE 600 mm STOP BAR
MIDDLEBURY:
STA. 4+092.562 LT, T-26
STA. 4+115.093 RT, T-7

646.66 TEMPORARY 600 mm STOP BAR
MIDDLEBURY:
STA. 4+092.562 LT, T-26
STA. 4+115.093 RT, T-7


675.50 REMOVING SIGNS
AS SHOWN - 12

675.60 ERECTING SALVAGED SIGNS
AS SHOWN - 7

604.42 CHANGING ELEVATION OF SEWER MANHOLES
STA. 4+092.6 LT.

646.50 DURABLE LETTER OR SYMBOL
MIDDLEBURY:
STA. 4+092.562 LT, T-26, "S,T,O,P" (4 EA)
STA. 4+115.093 RT, T-7, "S,T,O,P" (4 EA)

646.70 TEMPORARY LETTER OR SYMBOL
MIDDLEBURY:
STA. 4+092.562 LT, T-26, "S,T,O,P" (4 EA)
STA. 4+115.093 RT, T-7, "S,T,O,P" (4 EA)

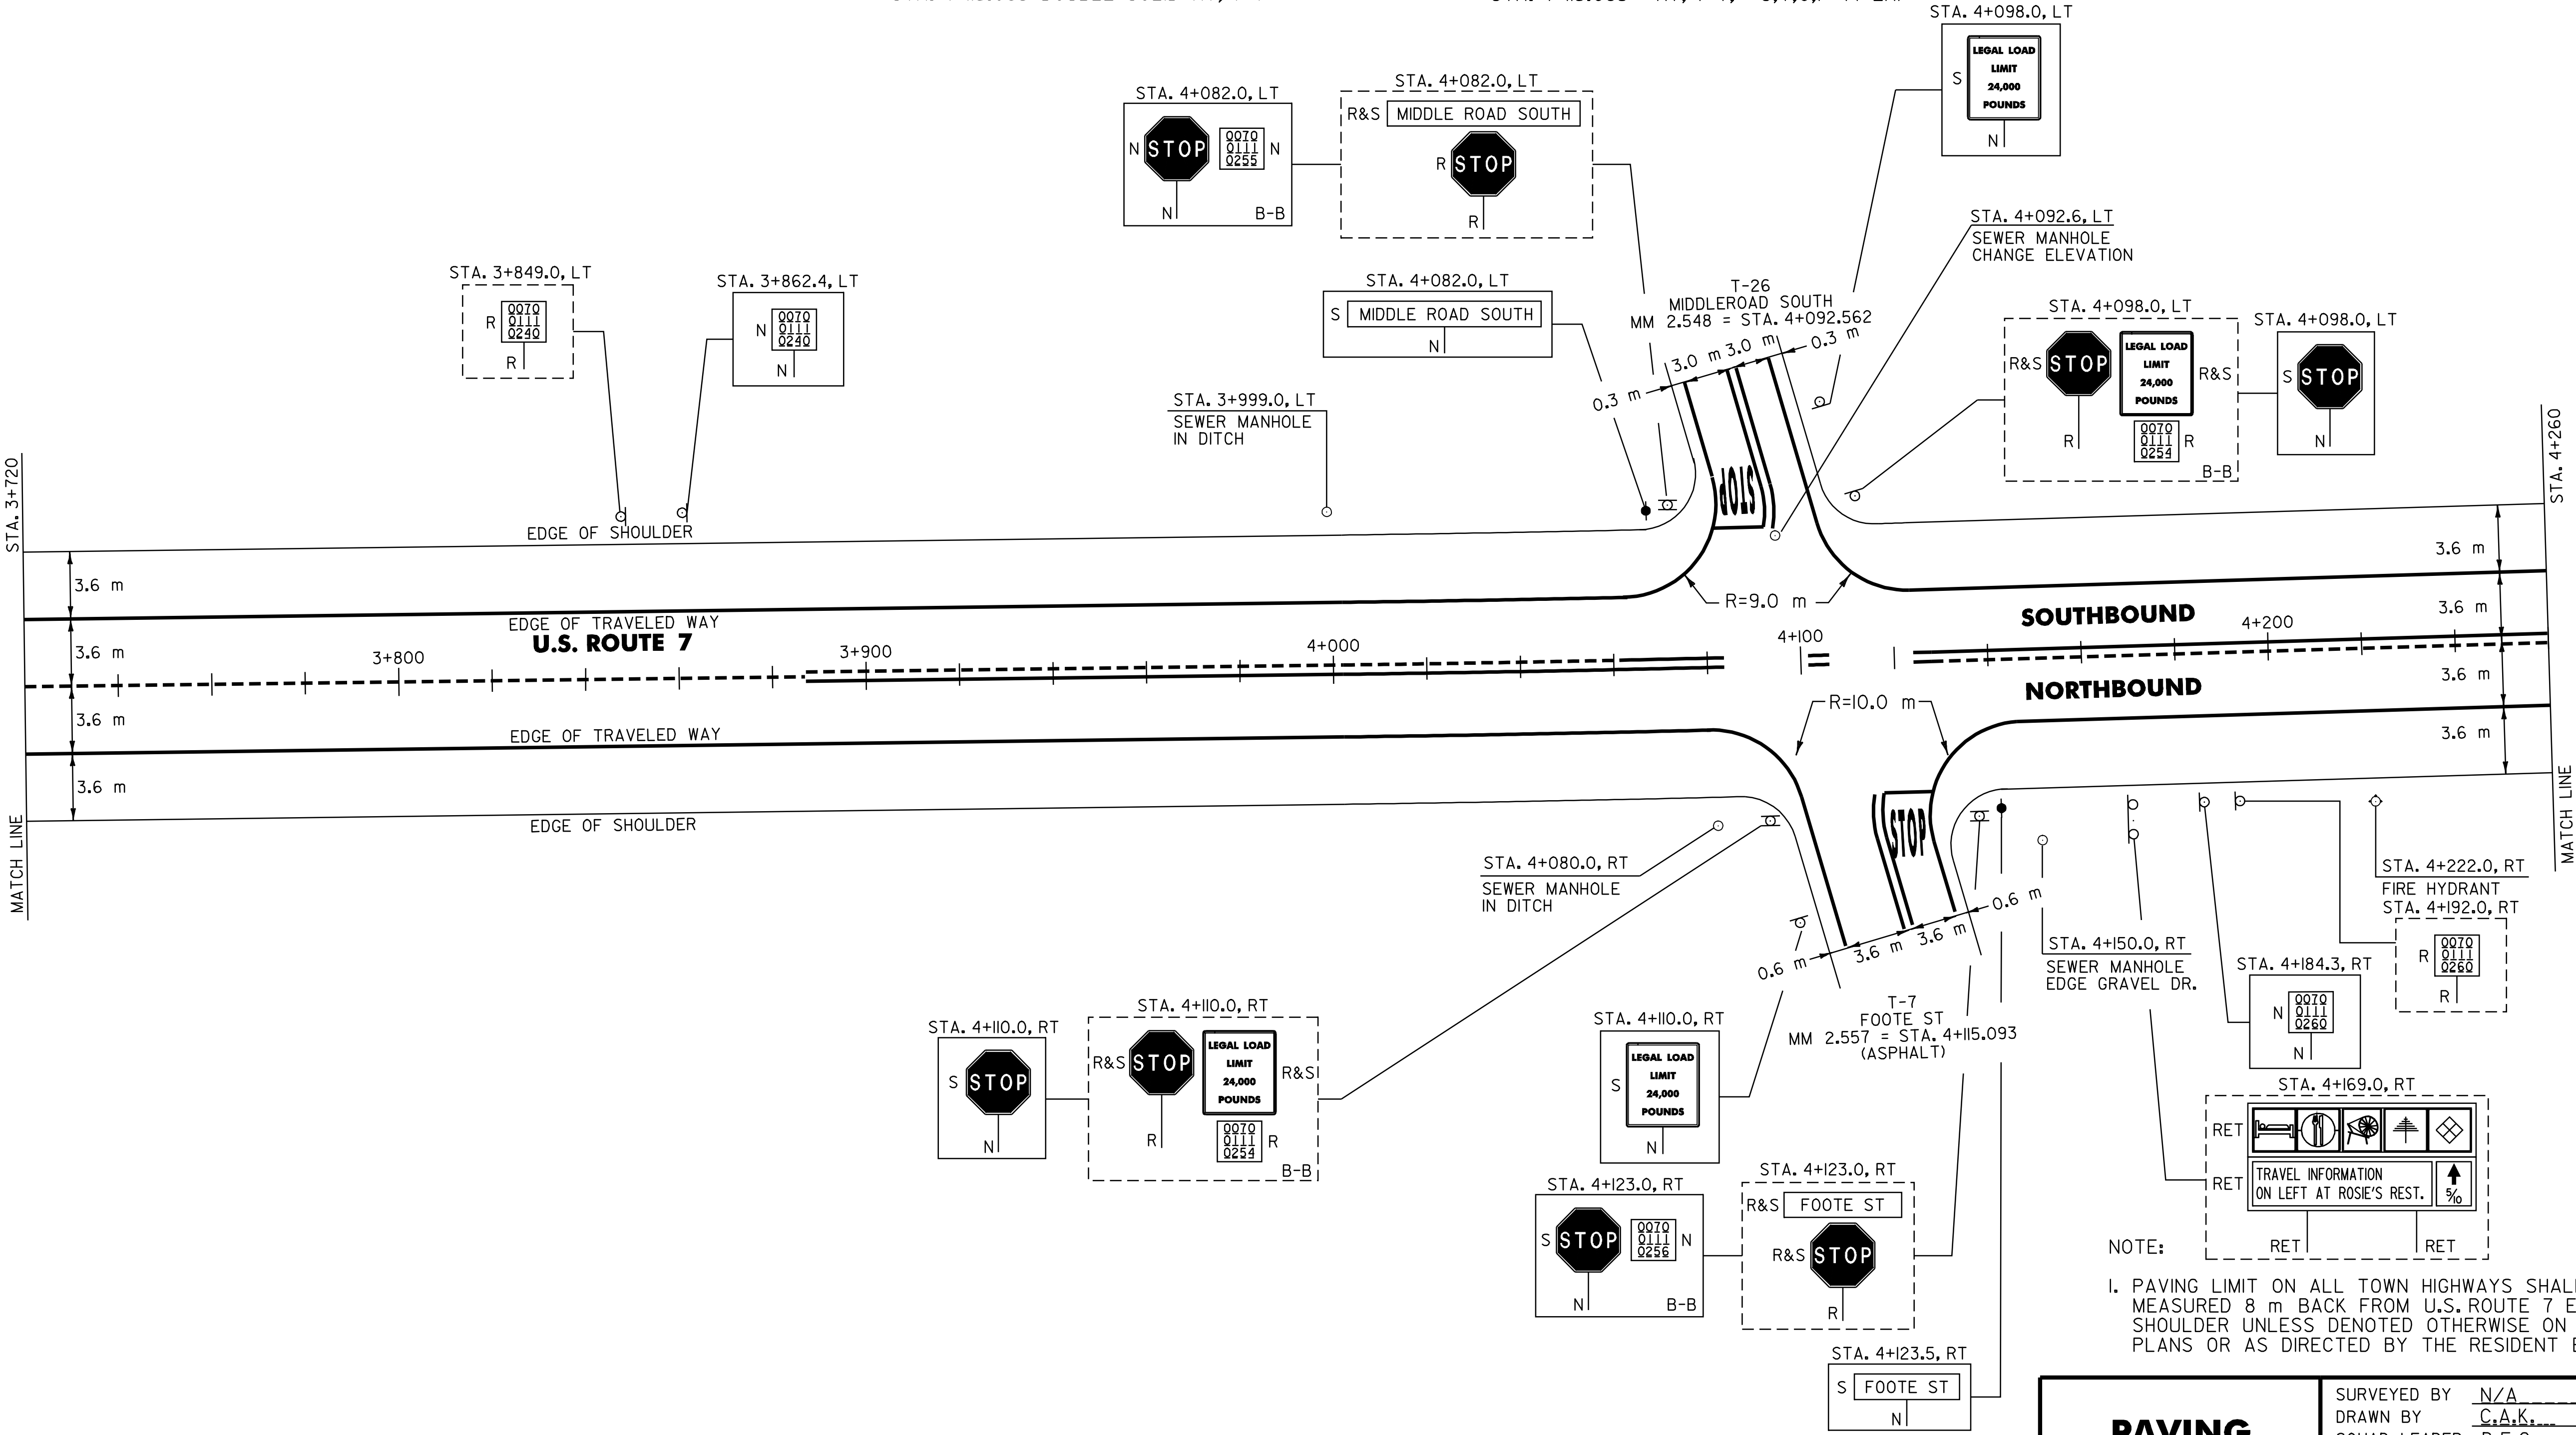

NOTE:
I. PAVING LIMIT ON ALL TOWN HIGHWAYS SHALL BE MEASURED 8 m BACK FROM U.S. ROUTE 7 EDGE OF SHOULDER UNLESS DENOTED OTHERWISE ON THE PLANS OR AS DIRECTED BY THE RESIDENT ENGINEER.

DATUM	
VERTICAL	N/A
HORIZONTAL	N/A

SIGN LEGEND
R= REMOVE
S= SALVAGE
N= NEW
RET= RETAIN
B-B= BACK TO BACK
EXISTING= _____
NEW= _____

PAVING
PROJECT
LAYOUT
20

SURVEYED BY	N/A	DATE	N/A
DRAWN BY	C.A.K.	DATE	2/02
SQUAD LEADER	D.E.G.		
DESIGN FILE NO.	pave/01b018/pb018.dgn		
IPARM FILE	pb018p20.1	DATE	10-JUL-2006 13:40
PROJ. NAME	SALISBURY - MIDDLEBURY		
PROJ. NO.	NH_231111		
SHEET	29	OF	67
SHEETS			

646.40 DURABLE 100 mm WHITE LINE
(ALL LINES WILL INCLUDE EDGE LINE BREAKS AND RADIUS FOR TOWN HIGHWAYS)
MIDDLEBURY:
STA. 4+260.0 - STA. 4+800.0 LT & RT

646.60 TEMPORARY 100 mm WHITE LINE
(ALL LINES WILL INCLUDE EDGE LINE BREAKS AND RADIUS FOR TOWN HIGHWAYS)
MIDDLEBURY:
STA. 4+260.0 - STA. 4+800.0 LT & RT

646.41 DURABLE 100 mm YELLOW LINE
(ALL LINES WILL INCLUDE C/L BREAKS FOR TOWN HIGHWAYS) S=SOLID, D=DASHED
MIDDLEBURY:
STA. 4+260.0 - STA. 4+300.0 S - D
STA. 4+300.0 - STA. 4+313.0 - D - S
STA. 4+313.0 - STA. 4+554.4 D - S
STA. 4+554.4 - STA. 4+800.0 S - S
STA. 4+654.223 DOUBLE SOLID LT, T-9

646.61 TEMPORARY 100 mm YELLOW LINE
(ALL LINES WILL INCLUDE C/L BREAKS FOR TOWN HIGHWAYS) S=SOLID, D=DASHED
MIDDLEBURY:
STA. 4+260.0 - STA. 4+300.0 S - D
STA. 4+300.0 - STA. 4+313.0 - D - S
STA. 4+313.0 - STA. 4+554.4 D - S
STA. 4+554.4 - STA. 4+800.0 S - S
STA. 4+654.223 DOUBLE SOLID LT, T-9

646.46 DURABLE 600 mm STOP BAR
MIDDLEBURY:
STA. 4+654.223 LT, T-9


646.66 TEMPORARY 600 mm STOP BAR
MIDDLEBURY:
STA. 4+654.223 LT, T-9

646.50 DURABLE LETTER OR SYMBOL
MIDDLEBURY:
STA. 4+654.223 LT, T-9, "S,T,O,P" (4 EA)

646.70 TEMPORARY LETTER OR SYMBOL
MIDDLEBURY:
STA. 4+654.223 LT, T-9, "S,T,O,P" (4 EA)

675.50 REMOVING SIGNS
AS SHOWN - 6

675.60 ERECTING SALVAGED SIGNS
AS SHOWN - 3

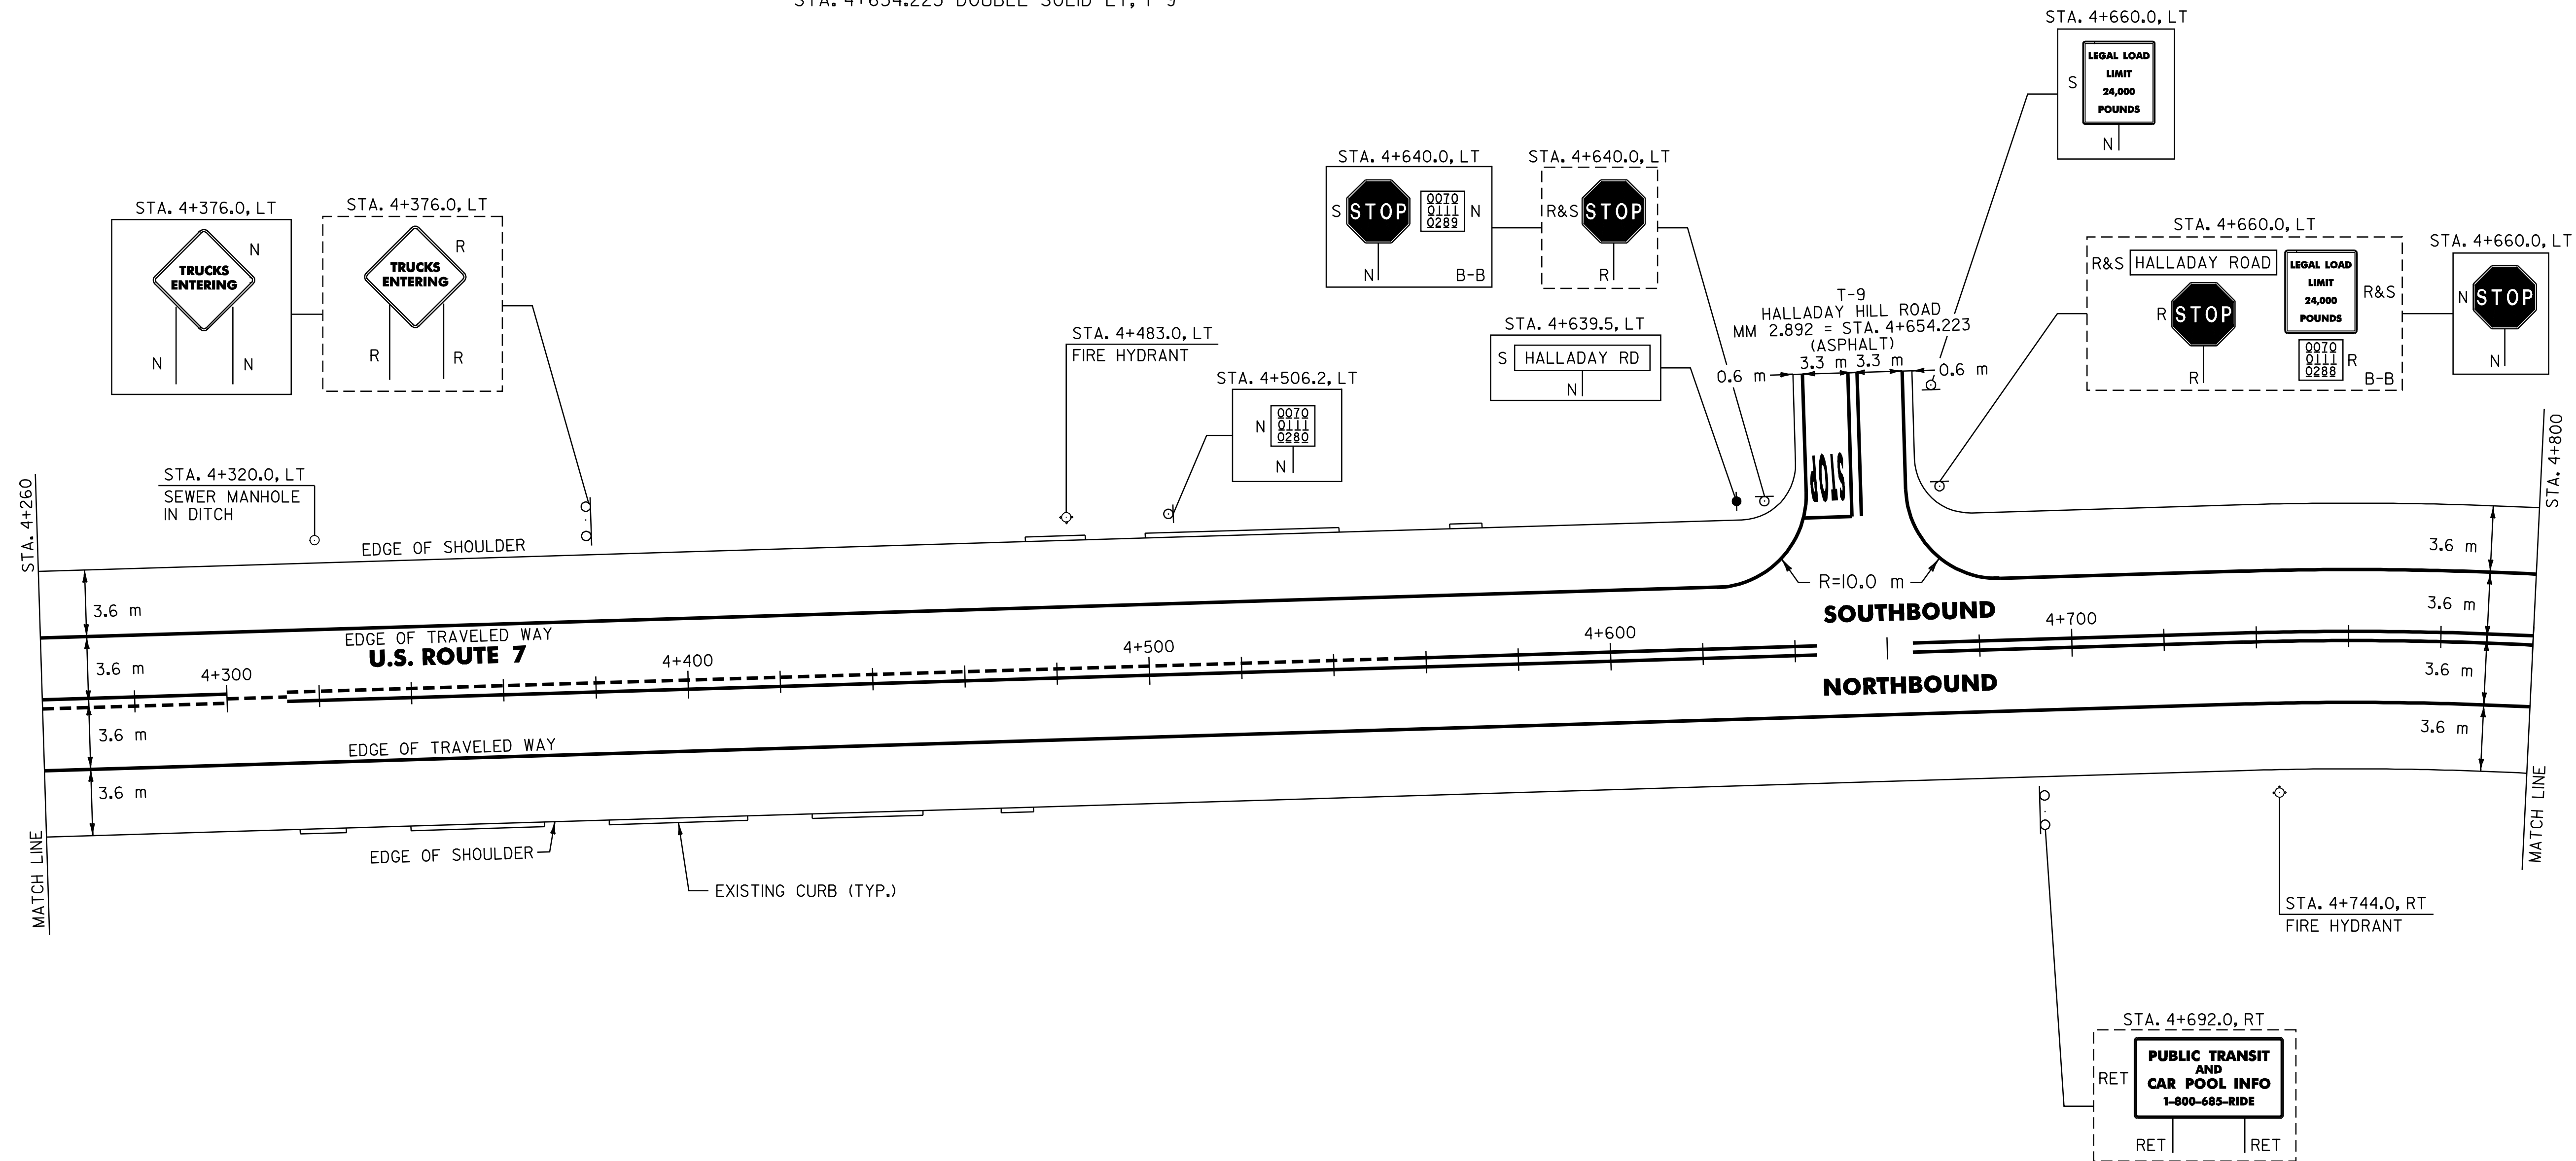

NOTE:
I. PAVING LIMIT ON ALL TOWN HIGHWAYS SHALL BE MEASURED 8 m BACK FROM U.S. ROUTE 7 EDGE OF SHOULDER UNLESS DENOTED OTHERWISE ON THE PLANS OR AS DIRECTED BY THE RESIDENT ENGINEER.

SIGN LEGEND
R= REMOVE
S= SALVAGE
N= NEW
RET= RETAIN
B-B= BACK TO BACK
EXISTING= -----
NEW= _____

**PAVING
PROJECT
LAYOUT
21**

SURVEYED BY N/A DATE N/A
DRAWN BY C.A.K. DATE 2/02
SQUAD LEADER D.E.G.
DESIGN FILE NO. pave/01b018/pb018.dgn
IPARM FILE pb018p21.i DATE 10-JUL-2006 13: 10
PROJ. NAME SALISBURY - MIDDLEBURY
PROJ. NO. NH_23111111
SHEET 30 OF 67 SHEETS -----

DATUM
VERTICAL N/A
HORIZONTAL N/A


646.40 DURABLE 100 mm WHITE LINE
(ALL LINES WILL INCLUDE EDGE LINE BREAKS AND
RADIUS FOR TOWN HIGHWAYS)
MIDDLEBURY:
STA. 4+800.0 - STA. 5+340.0 LT & RT

646.60 TEMPORARY 100 mm WHITE LINE
(ALL LINES WILL INCLUDE EDGE LINE BREAKS AND
RADIUS FOR TOWN HIGHWAYS)
MIDDLEBURY:
STA. 4+800.0 - STA. 5+340.0 LT & RT

646.41 DURABLE 100 mm YELLOW LINE
(ALL LINES WILL INCLUDE C/L BREAKS FOR
TOWN HIGHWAYS) S=SOLID, D=DASHED
MIDDLEBURY:
STA. 4+800.0 - STA. 5+340.0 LT S - RT S

646.61 TEMPORARY 100 mm YELLOW LINE
(ALL LINES WILL INCLUDE C/L BREAKS FOR
TOWN HIGHWAYS) S=SOLID, D=DASHED
MIDDLEBURY:
STA. 4+800.0 - STA. 5+340.0 LT S - RT S

675.50 REMOVING SIGNS
AS SHOWN - 5

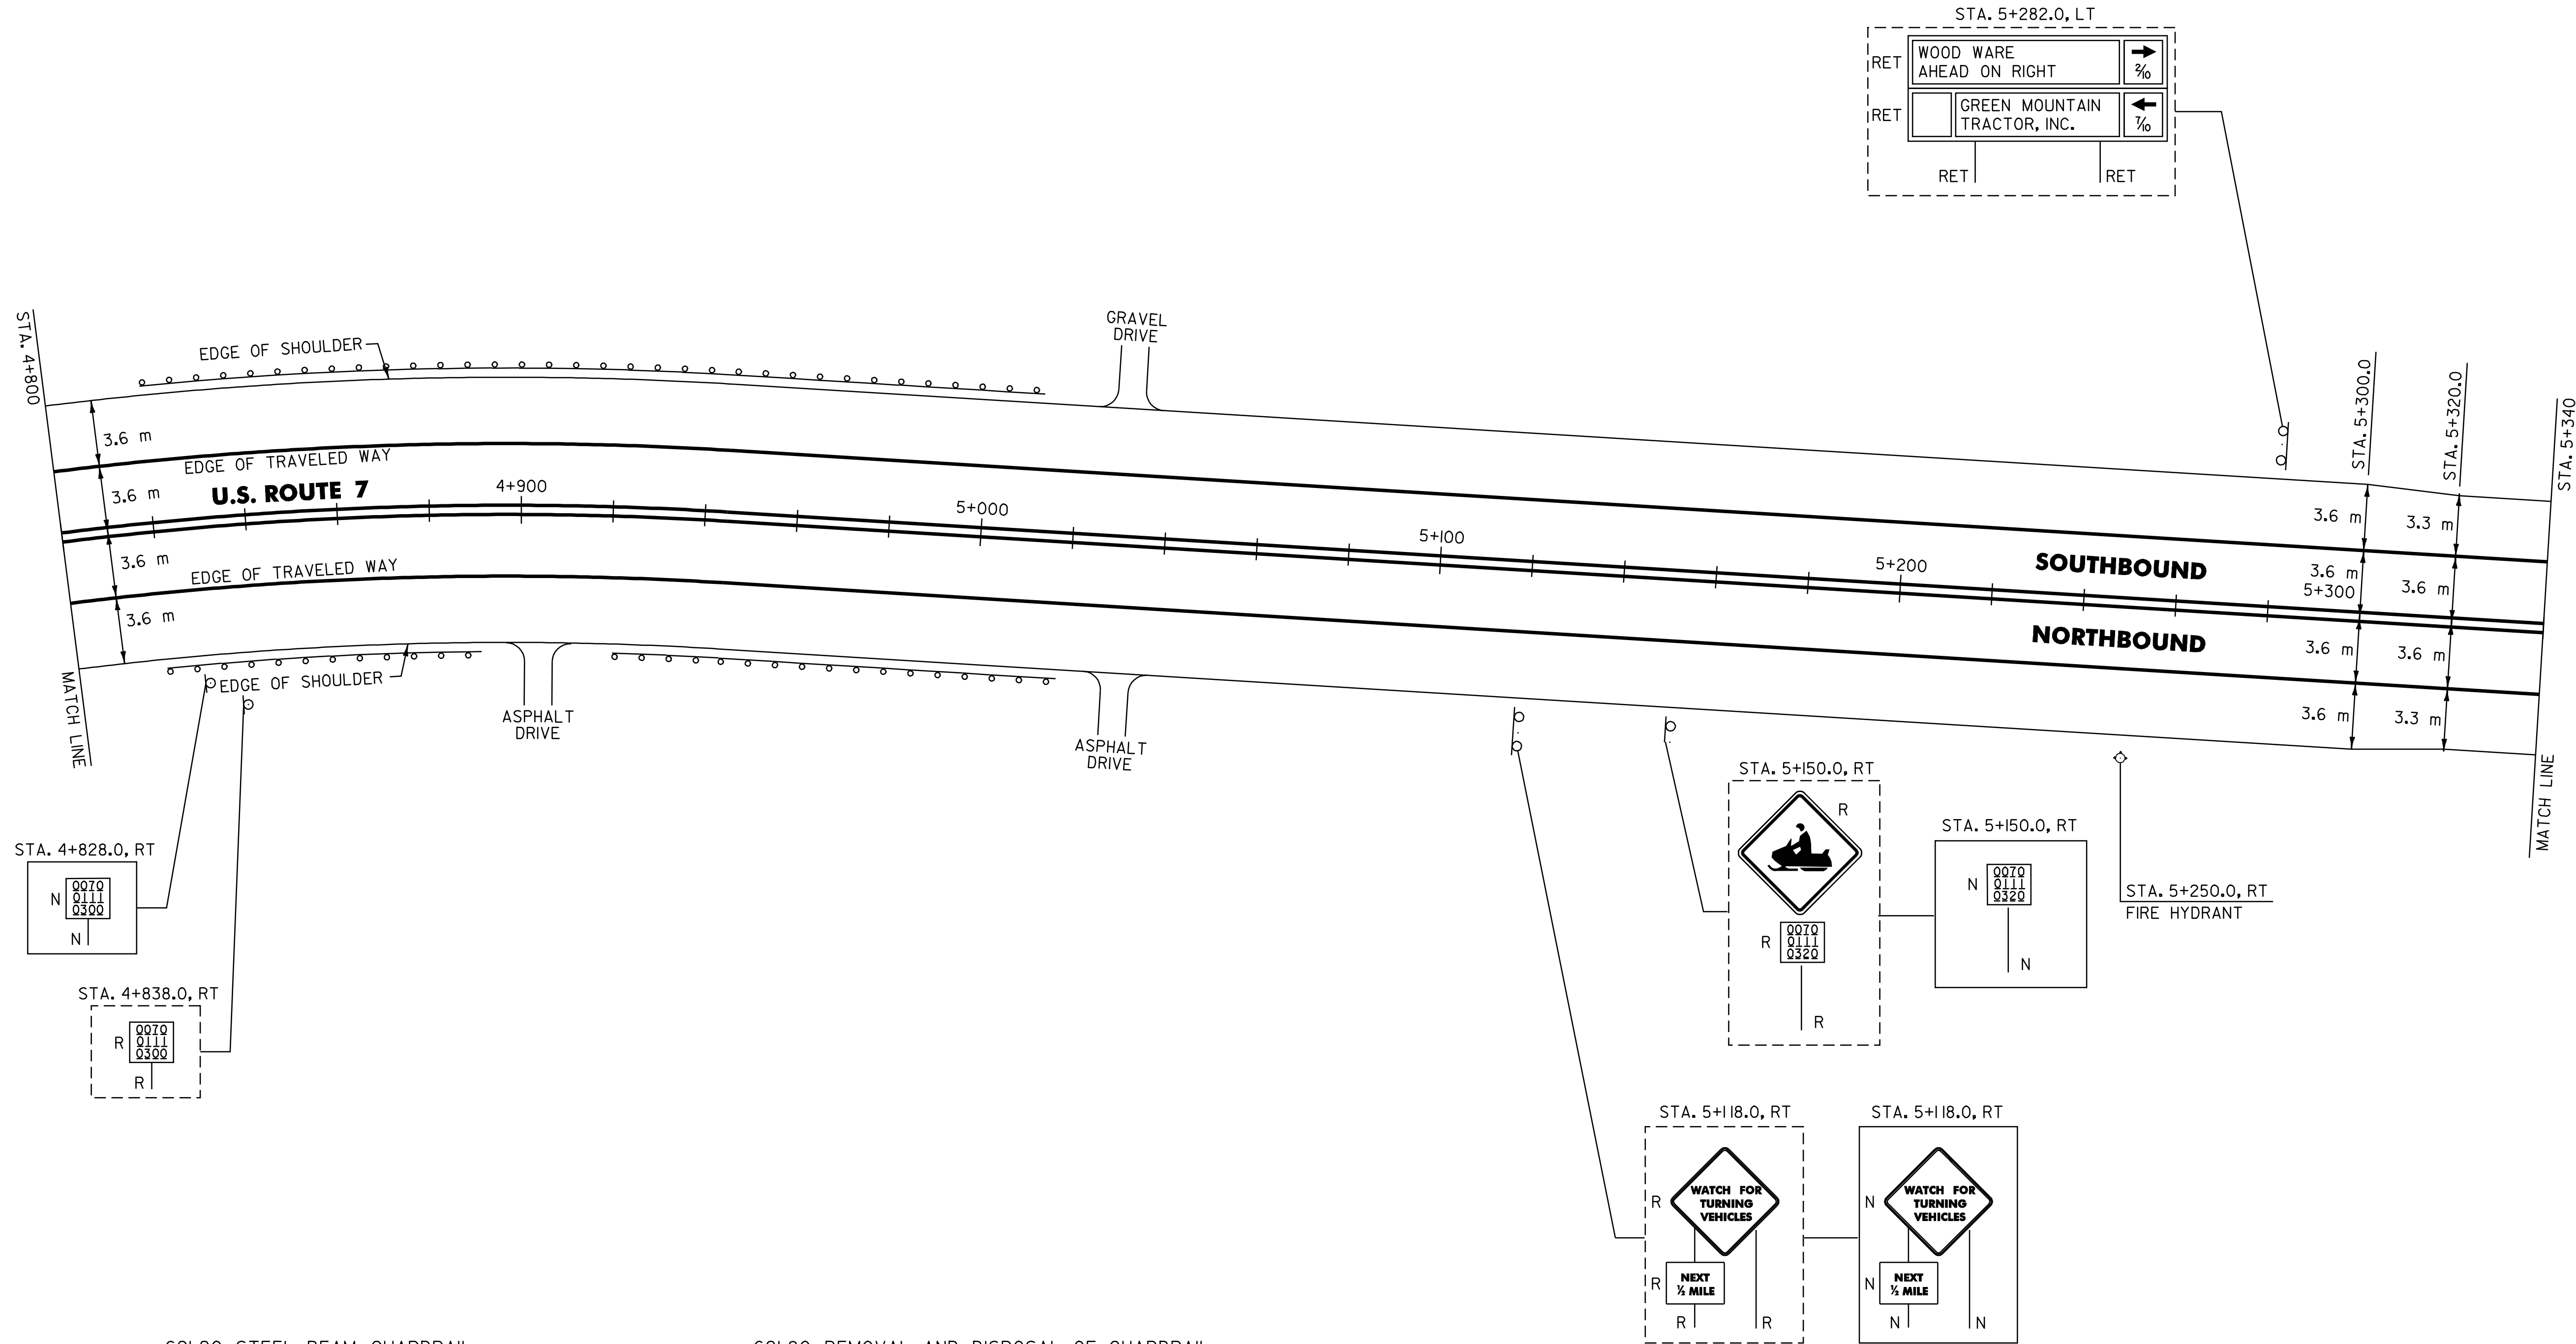

621.20 STEEL BEAM GUARDRAIL

MIDDLEBURY:
4+835.88 STA. 4+832.2 - STA. 4+881.6 RT (49.4 m) (45.7 m)
STA. 4+833.4 - STA. 5+000.6 LT (167.2 m) (167.6 m)
STA. 4+930.4 - STA. 5+006.4 RT (76.0 m) (76.2 m)

621.505 MANUFACTURED TERMINAL SECTION (FLARED)

MIDDLEBURY:
4+824.48 STA. 4+820.8 - STA. 4+832.2 RT 835.8
STA. 4+822.0 - STA. 4+833.4 LT
STA. 4+881.6 - STA. 4+893.0 RT
STA. 4+919.0 - STA. 4+930.4 RT
STA. 5+000.6 - STA. 5+012.0 LT
STA. 5+006.4 - STA. 5+017.8 RT

621.80 REMOVAL AND DISPOSAL OF GUARDRAIL

MIDDLEBURY:
STA. 4+822.0 - STA. 5+012.0 LT (190.0 m) (191.7 m)
STA. 4+824.0 - STA. 4+893.0 RT (69.0 m)
STA. 4+919.0 - STA. 5+017.0 RT (98.0 m)

SIGN LEGEND
R= REMOVE
S= SALVAGE
N= NEW
RET= RETAIN
B-B= BACK TO BACK
EXISTING= _____
NEW= _____

PAVING
PROJECT
LAYOUT
22

SURVEYED BY N/A DATE N/A
DRAWN BY C.A.K. DATE 2/02
SQUAD LEADER D.E.G.
DESIGN FILE NO. pb018/pb018.dgn
IPARM pb018p22.1 DATE 10-JUL-2006 13:
FILE PLT
PROJ. NAME SALISBURY - MIDDLEBURY
PROJ. NO. NH_231111
SHEET 31 OF 67 SHEETS _____

DATUM
VERTICAL N/A
HORIZONTAL N/A

646.40 DURABLE 100 mm WHITE LINE
(ALL LINES WILL INCLUDE EDGE LINE BREAKS AND RADIUS FOR TOWN HIGHWAYS)
MIDDLEBURY:
STA. 5+340.0 - STA. 5+880.0 LT & RT

646.60 TEMPORARY 100 mm WHITE LINE
(ALL LINES WILL INCLUDE EDGE LINE BREAKS AND RADIUS FOR TOWN HIGHWAYS)
MIDDLEBURY:
STA. 5+340.0 - STA. 5+880.0 LT & RT

646.41 DURABLE 100 mm YELLOW LINE
(ALL LINES WILL INCLUDE C/L BREAKS FOR TOWN HIGHWAYS) S=SOLID, D=DASHED
MIDDLEBURY:
STA. 5+340.0 - STA. 5+880.0 LT S
STA. 5+648.797 DOUBLE SOLID RT, T-II5
STA. 5+858.012 DOUBLE SOLID LT, T-II3

646.61 TEMPORARY 100 mm YELLOW LINE
(ALL LINES WILL INCLUDE C/L BREAKS FOR TOWN HIGHWAYS) S=SOLID, D=DASHED
MIDDLEBURY:
STA. 5+340.0 - STA. 5+880.0 LT S
STA. 5+648.797 DOUBLE SOLID RT, T-II5
STA. 5+858.012 DOUBLE SOLID LT, T-II3

646.46 DURABLE 600 mm STOP BAR
MIDDLEBURY:
STA. 5+648.797 RT, T-II5
STA. 5+858.012 RT, T-II3


646.66 TEMPORARY 600 mm STOP BAR
MIDDLEBURY:
STA. 5+648.797 RT, T-II5
STA. 5+858.012 RT, T-II3

646.50 DURABLE LETTER OR SYMBOL
MIDDLEBURY:
STA. 5+648.797 RT, T-II5, "S,T,O,P" (4 EA)
STA. 5+858.012 RT, T-II3, "S,T,O,P" (4 EA)

675.50 REMOVING SIGNS
AS SHOWN - 12

675.60 ERECTING SALVAGED SIGNS
AS SHOWN - 2

646.70 TEMPORARY LETTER OR SYMBOL
MIDDLEBURY:
STA. 5+648.797 RT, T-II5, "S,T,O,P" (4 EA)
STA. 5+858.012 RT, T-II3, "S,T,O,P" (4 EA)

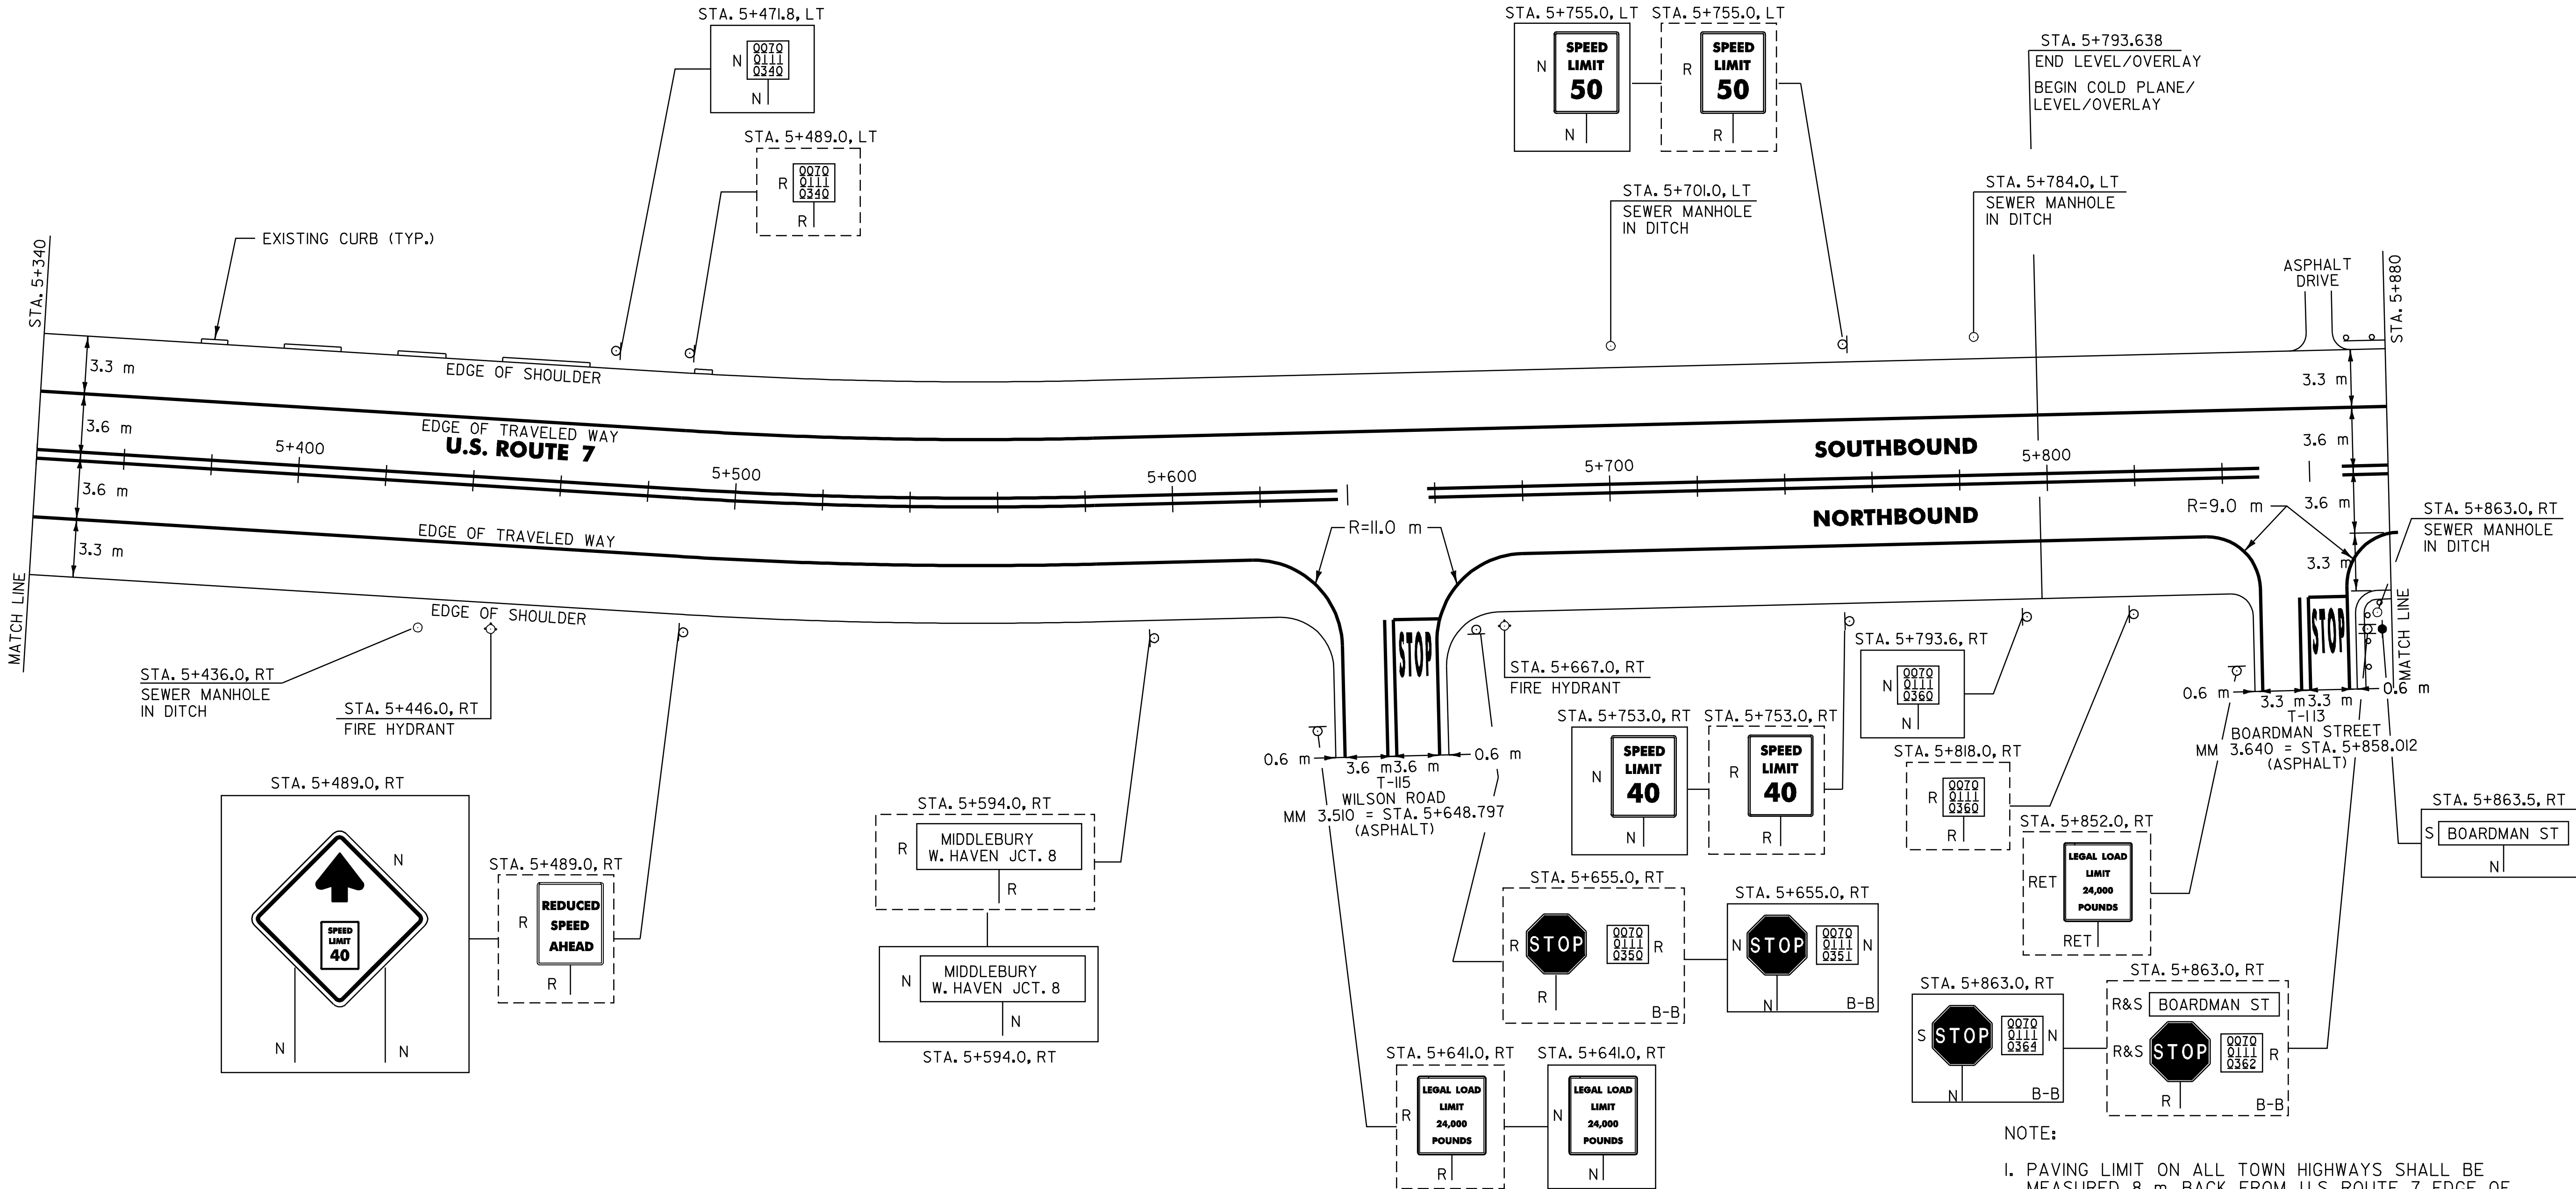

621.20 STEEL BEAM GUARDRAIL
MIDDLEBURY:
~~STA. 5+869.0 - STA. 5+880.0 RT (36.2 m)~~ SEE PG 33 OF 67

621.505 MANUFACTURED TERMINAL SECTION (FLARED)
MIDDLEBURY:
STA. 5+869.0 RT (ON T-II3)

621.80 REMOVAL AND DISPOSAL OF GUARDRAIL
MIDDLEBURY:
STA. 5+869.0 - STA. 5+880.0 LT (11.0 m)
STA. 5+869.0 - STA. 5+880.0 RT (45.2 m)

NOTE:
I. PAVING LIMIT ON ALL TOWN HIGHWAYS SHALL BE MEASURED 8 m BACK FROM U.S. ROUTE 7 EDGE OF SHOULDER UNLESS DENOTED OTHERWISE ON THE PLANS OR AS DIRECTED BY THE RESIDENT ENGINEER.

SIGN LEGEND
R= REMOVE
S= SALVAGE
N= NEW
RET= RETAIN
B-B= BACK TO BACK
EXISTING= _____
NEW= _____

PAVING
PROJECT
LAYOUT
23

SURVEYED BY N/A DATE N/A
DRAWN BY C.A.K. DATE 2/02
SQUAD LEADER D.E.G.
DESIGN FILE NO. pave/01b018/pb018.dgn
IPARM pb018p23.i DATE 10-JUL-2006 13:
FILE 10-JUL-2006 PLOTTER
PROJ. NAME SALISBURY - MIDDLEBURY
PROJ. NO. NH_231111
SHEET 32 OF 67 SHEETS _____

DATUM
VERTICAL N/A
HORIZONTAL N/A

646.40 DURABLE 100 mm WHITE LINE
(ALL LINES WILL INCLUDE EDGE LINE BREAKS AND RADIUS FOR TOWN HIGHWAYS)

MIDDLEBURY:
STA. 5+880.0 - STA. 6+440.0 LT & RT
STA. 6+275.0 - STA. 6+329.0 RT, DOTTED LINE
STA. 6+329.0 - STA. 6+393.7 RT, SOLID LINE (LANE LINE)
STA. 6+429.3 - STA. 6+440.0 LT, SOLID LINE (LANE LINE)
STA. 6+429.3 - STA. 6+440.0 LT, SOLID LINE (LANE LINE)
BROOKS DRUG DR. - SOLID EDGE LINE LT & RT
BROOKS DRUG DR. - SOLID LANE LINE
AMES PLAZA ENTRANCE - SOLID EDGE LINE LT & RT
AMES PLAZA ENTRANCE - SOLID LANE LINE

646.60 TEMPORARY 100 mm WHITE LINE
(ALL LINES WILL INCLUDE EDGE LINE BREAKS AND RADIUS FOR TOWN HIGHWAYS)

MIDDLEBURY:
STA. 5+880.0 - STA. 6+440.0 LT & RT
STA. 6+275.0 - STA. 6+329.0 RT, DOTTED LINE
STA. 6+329.0 - STA. 6+393.7 RT, SOLID LINE (LANE LINE)
STA. 6+429.3 - STA. 6+440.0 LT, SOLID LINE (LANE LINE)
STA. 6+429.3 - STA. 6+440.0 LT, SOLID LINE (LANE LINE)
BROOKS DRUG DR. - SOLID EDGE LINE LT & RT
BROOKS DRUG DR. - SOLID LANE LINE
AMES PLAZA ENTRANCE - SOLID EDGE LINE LT & RT
AMES PLAZA ENTRANCE - SOLID LANE LINE

646.41 DURABLE 100 mm YELLOW LINE
(ALL LINES WILL INCLUDE C/L BREAKS FOR TOWN HIGHWAYS) S=SOLID, D=DASHED

MIDDLEBURY:
STA. 5+880.0 - STA. 6+145.0 S - S
STA. 6+145.0 - STA. 6+329.0 DOUBLE SOLID LT & RT (MEDIAN)
STA. 6+329.0 - STA. 6+394.0 DOUBLE SOLID LT
STA. 6+429.0 - STA. 6+440.0 DOUBLE SOLID RT
BROOKS DRUG DR. DOUBLE SOLID C/L
AMES PLAZA ENTRANCE BOTH SIDES OF RAISED ISLAND

646.61 TEMPORARY 100 mm YELLOW LINE
(ALL LINES WILL INCLUDE C/L BREAKS FOR TOWN HIGHWAYS) S=SOLID, D=DASHED

MIDDLEBURY:
STA. 5+880.0 - STA. 6+145.0 S - S
STA. 6+145.0 - STA. 6+329.0 DOUBLE SOLID LT & RT (MEDIAN)
STA. 6+329.0 - STA. 6+394.0 DOUBLE SOLID LT
STA. 6+429.0 - STA. 6+440.0 DOUBLE SOLID RT
BROOKS DRUG DR. DOUBLE SOLID C/L
AMES PLAZA ENTRANCE BOTH SIDES OF RAISED ISLAND

646.81 PAINTED CURB

MIDDLEBURY:
STA. 6+412.0 LT (AMES PLAZA ENTRANCE)

646.50 DURABLE LETTER OR SYMBOL


STA. 6+201.8 TO 6+216.2 RT, "S,I,G,N,A,L A,H,E,A,D" (11EA)
STA. 6+329.0 TO 6+333.0 RT, DOUBLE ARROW (2 EA)
STA. 6+329.0 TO 6+331.4 RT, ARROW (1EA)
STA. 6+358.3 TO 6+362.3 RT, DOUBLE ARROW (2 EA)
STA. 6+349.0 TO 6+351.4 RT, "O,N,L,Y" (4 EA)
STA. 6+387.5 TO 6+391.5 RT, DOUBLE ARROW (2 EA)
STA. 6+369.0 TO 6+371.4 RT, ARROW (1EA)
STA. 6+389.1 TO 6+391.5 RT, "O,N,L,Y" (4 EA)
STA. 6+411 LT, ARROW (SIDEROAD) (1EA)
STA. 6+411 LT, DBL. ARROW (SIDEROAD) (2 EA)
STA. 6+415 RT, DBL. ARROW (SIDEROAD) (2 EA)
STA. 6+415 RT, ARROW (SIDEROAD) (1EA)
STA. 6+415 RT, "O,N,L,Y" (SIDEROAD) (4 EA)
STA. 6+431.5 TO 6+433.9 LT, ARROW (2 SETS) (2 EA)

646.70 TEMPORARY LETTER OR SYMBOL

STA. 6+201.8 TO 6+216.2 RT, "S,I,G,N,A,L A,H,E,A,D" (11EA)
STA. 6+329.0 TO 6+333.0 RT, DOUBLE ARROW (2 EA)
STA. 6+329.0 TO 6+331.4 RT, ARROW (1EA)
STA. 6+358.3 TO 6+362.3 RT, DOUBLE ARROW (2 EA)
STA. 6+387.5 TO 6+391.5 RT, ARROW (1EA)
STA. 6+389.1 TO 6+391.5 LT, ARROW (SIDEROAD) (1EA)
STA. 6+411 LT, DBL. ARROW (SIDEROAD) (2 EA)
STA. 6+415 RT, DBL. ARROW (SIDEROAD) (2 EA)
STA. 6+415 RT, ARROW (SIDEROAD) (1EA)
STA. 6+431.5 TO 6+433.9 LT, ARROW (2 SETS) (2 EA)

675.50 REMOVING SIGNS

AS SHOWN - IT

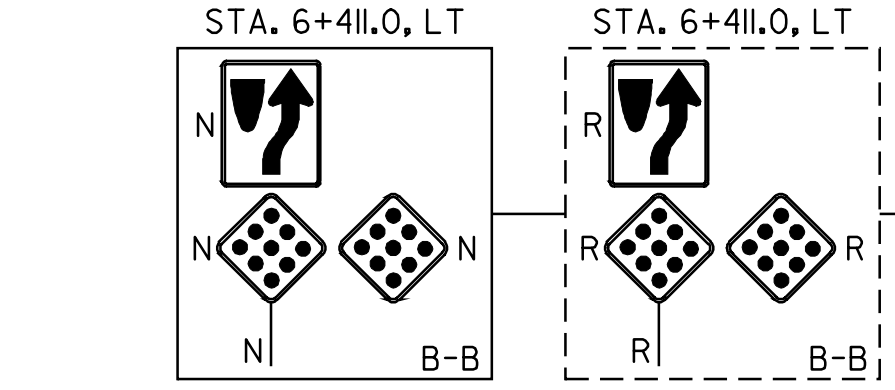









646.46 DURABLE 600 mm STOP BAR

MIDDLEBURY:
STA. 6+394.0 RT STA. 6+415 RT (SIDEROAD)
STA. 6+411 LT (SIDEROAD) STA. 6+429.0 LT

646.66 TEMPORARY 600 mm STOP BAR

MIDDLEBURY:
STA. 6+394.0 RT STA. 6+415 RT (SIDEROAD)
STA. 6+411 LT (SIDEROAD) STA. 6+429.0 LT

REFER TO DETAIL A ON THIS SHEET FOR PAVEMENT MARKING DETAILS ON THIS SIDEROAD.

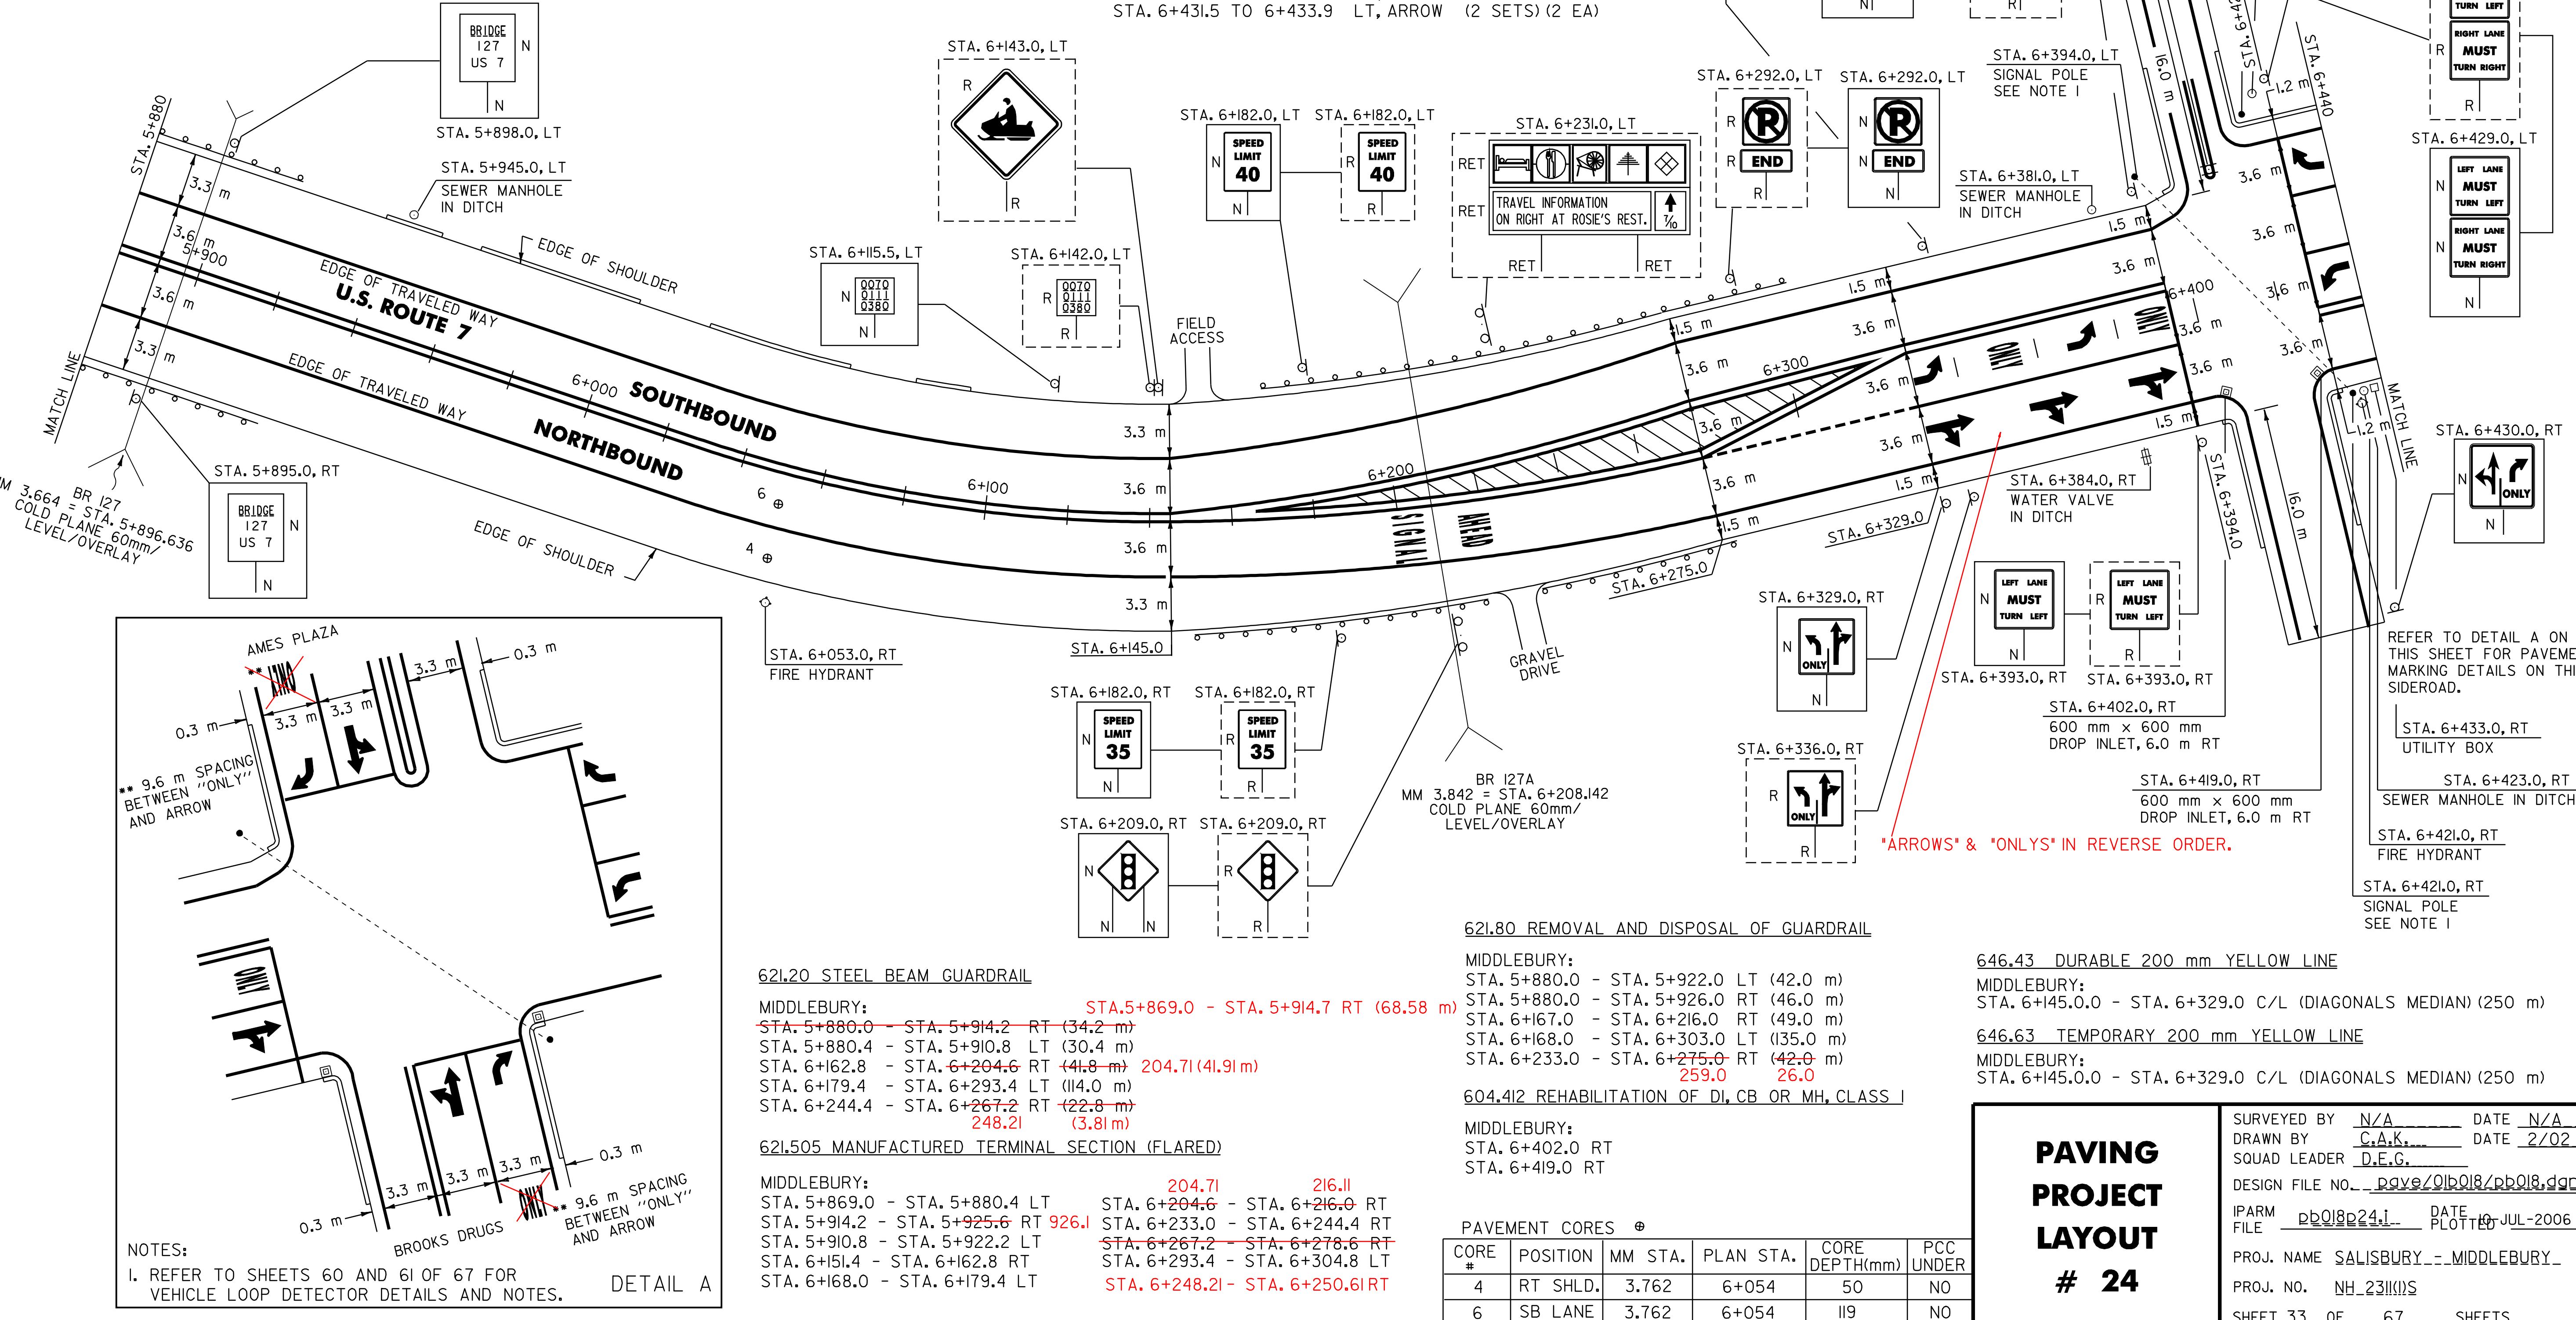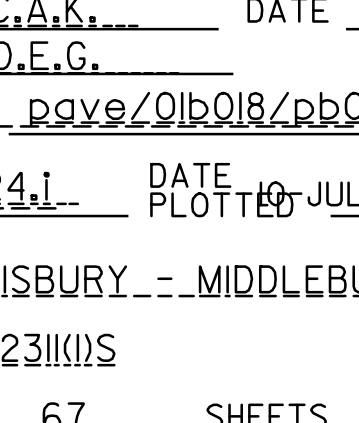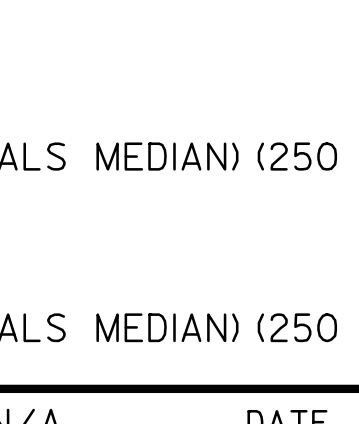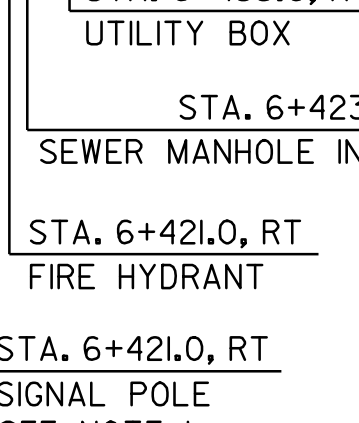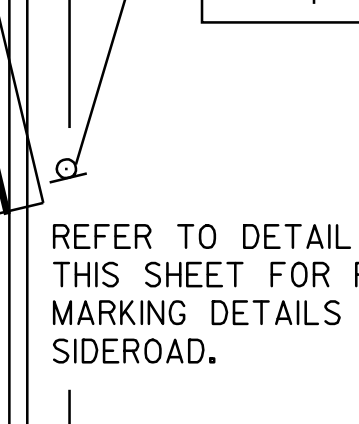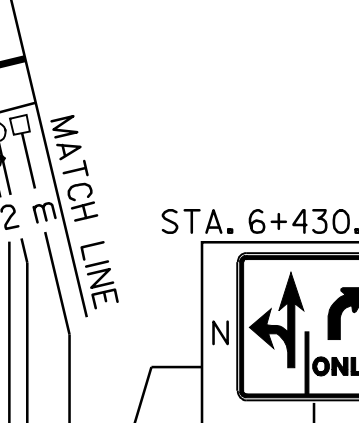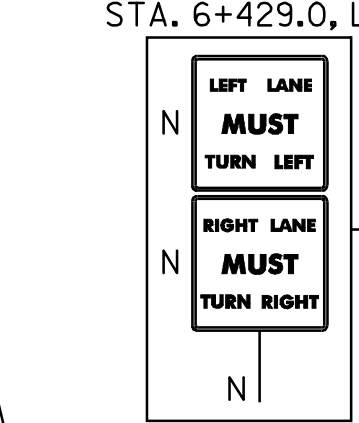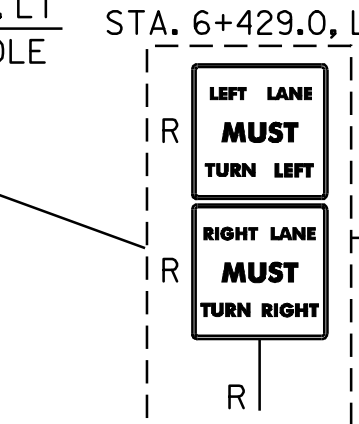

NOTES:
1. REFER TO SHEETS 60 AND 61 OF 67 FOR VEHICLE LOOP DETECTOR DETAILS AND NOTES.

DETAIL A

621.20 STEEL BEAM GUARDRAIL

MIDDLEBURY:
STA. 5+880.0 - STA. 5+914.2 RT (34.2 m)
STA. 5+880.4 - STA. 5+910.8 LT (30.4 m)
STA. 6+162.8 - STA. 6+204.6 RT (41.8 m) 204.71 (41.91 m)
STA. 6+179.4 - STA. 6+293.4 LT (114.0 m)
STA. 6+244.4 - STA. 6+267.2 RT (22.8 m) 248.21 (3.81 m)
STA. 5+869.0 - STA. 5+914.7 RT (68.58 m)

621.505 MANUFACTURED TERMINAL SECTION (FLARED)

MIDDLEBURY:
STA. 5+869.0 - STA. 5+880.4 LT 204.71 216.11
STA. 5+914.2 - STA. 5+925.6 RT 926.1
STA. 5+910.8 - STA. 5+922.2 LT
STA. 6+151.4 - STA. 6+162.8 RT
STA. 6+168.0 - STA. 6+179.4 LT
STA. 6+204.6 - STA. 6+216.0 RT
STA. 6+233.0 - STA. 6+244.4 RT
STA. 6+267.2 - STA. 6+278.6 RT
STA. 6+293.4 - STA. 6+304.8 LT
STA. 6+248.21 - STA. 6+250.6 RT

621.80 REMOVAL AND DISPOSAL OF GUARDRAIL

MIDDLEBURY:
STA. 5+880.0 - STA. 5+922.0 LT (42.0 m)
STA. 5+880.0 - STA. 5+926.0 RT (46.0 m)
STA. 6+167.0 - STA. 6+216.0 RT (49.0 m)
STA. 6+168.0 - STA. 6+303.0 LT (135.0 m)
STA. 6+233.0 - STA. 6+275.0 RT (42.0 m) 259.0 26.0

604.412 REHABILITATION OF DI, CB OR MH, CLASS 1

MIDDLEBURY:
STA. 6+402.0 RT
STA. 6+419.0 RT

PAVEMENT CORES

CORE #	POSITION	MM STA.	PLAN STA.	CORE DEPTH(mm)	PCC UNDER
4	RT SHLD.	3.762	6+054	50	NO
6	SB LANE	3.762	6+054	119	NO

646.43 DURABLE 200 mm YELLOW LINE

MIDDLEBURY:
STA. 6+145.0.0 - STA. 6+329.0 C/L (DIAGONALS MEDIAN) (250 m)

646.63 TEMPORARY 200 mm YELLOW LINE

MIDDLEBURY:
STA. 6+145.0.0 - STA. 6+329.0 C/L (DIAGONALS MEDIAN) (250 m)

PAVING PROJECT LAYOUT # 24

SURVEYED BY N/A DATE N/A
DRAWN BY C.A.K. DATE 2/02
SQUAD LEADER D.E.G.
DESIGN FILE NO. PAVE/01b018/pb018.dgn
IPARM FILE pb018p24.i DATE 10-JUL-2006 13:53
PROJ. NAME SALISBURY - MIDDLEBURY
PROJ. NO. NH_2311111
SHEET 33 OF 67 SHEETS

646.40 DURABLE 100 mm WHITE LINE
(ALL LINES WILL INCLUDE EDGE LINE BREAKS AND RADIUS FOR TOWN HIGHWAYS)

MIDDLEBURY:
STA. 6+440.0 - STA. 6+881.555 LT & RT
STA. 6+440.0 - STA. 6+458.0 LT, SOLID LINE (LANE LINE)
STA. 6+440.0 - STA. 6+498.0 LT, SOLID LINE (LANE LINE)
STA. 6+458.0 - STA. 6+526.8 LT, DOTTED LINE
STA. 6+498.0 - STA. 6+539.0 LT, DOTTED LINE
STA. 6+458.0 - STA. 6+539.0 RT, DOTTED LINE
STA. 6+539.0 - STA. 6+580.0 RT, SOLID LINE (LANE LINE)
STA. 6+591.873 LT, T-20 (LANE LINE)
STA. 6+606.0 - STA. 6+660.3 LT, SOLID LINE (LANE LINE)
STA. 6+660.3 - STA. 6+706.0 LT, DOTTED LINE

646.41 DURABLE 100 mm YELLOW LINE
(ALL LINES WILL INCLUDE C/L BREAKS FOR TOWN HIGHWAYS) S=SOLID, D=DASHED

MIDDLEBURY:
STA. 6+680.0 - STA. 6+881.555 LT S RT S
STA. 6+440.0 - STA. 6+458.0 DOUBLE SOLID RT
STA. 6+458.0 - STA. 6+526.8 DOUBLE SOLID LT & RT (MEDIAN)
STA. 6+539.0 - STA. 6+580.0 DOUBLE SOLID LT
STA. 6+606.0 - STA. 6+680.0 DOUBLE SOLID LT & RT (MEDIAN)
STA. 6+532.327 DOUBLE SOLID RT, T-15
STA. 6+591.873 DOUBLE SOLID LT, T-20

646.43 DURABLE 200 mm YELLOW LINE

MIDDLEBURY:
STA. 6+458.0 - STA. 6+526.8 (DIAGONALS MEDIAN) (175.0 m)
STA. 6+606.0 - STA. 6+680.0 (DIAGONALS MEDIAN) (175.0 m)

646.63 TEMPORARY 200 mm YELLOW LINE

MIDDLEBURY:
STA. 6+458.0 - STA. 6+526.8 (DIAGONALS MEDIAN) (175.0 m)
STA. 6+606.0 - STA. 6+680.0 (DIAGONALS MEDIAN) (175.0 m)

646.50 DURABLE LETTER OR SYMBOL

MIDDLEBURY:
STA. 6+443.7 TO 6+446.1 LT, "O,N,L,Y" (4 EA)
STA. 6+447.5 TO 6+449.9 LT, "O,N,L,Y" (4 EA)
STA. 6+455.8 TO 6+458.0 LT, ARROW (1EA)
STA. 6+463.5 TO 6+465.9 LT, ARROW (1EA)
STA. 6+479.5 TO 6+481.9 LT, "O,N,L,Y" (4 EA)
STA. 6+495.6 TO 6+498.0 LT, ARROW (1EA)
STA. 6+532.327 RT, T-15 "S,T,O,P" (4 EA)
STA. 6+539.0 TO 6+541.4 RT, ARROW (1EA)
STA. 6+557.1 TO 6+559.5 RT, "O,N,L,Y" (4 EA)
STA. 6+575.1 TO 6+577.5 RT, ARROW (1EA)
STA. 6+591.873 LT, T-20, ARROW (2 SETS) (2 EA)
~~STA. 6+591.873 LT, T-20, "O,N,L,Y" (2 SETS) (8 EA) ELIM~~
STA. 6+611.5 TO 6+613.9 LT, ARROW (1EA)
STA. 6+634.7 TO 6+637.1 LT, "O,N,L,Y" (4 EA)
STA. 6+657.9 TO 6+660.3 LT, ARROW (1EA)
STA. 6+801.8 TO 6+816.2 LT, "S,I,G,N,A,L A,H,E,A,D" (11EA)
ADDED 6+481 LT ONLY 4EA
ADDED 6+497 LT ARROW 1EA

675.50 REMOVING SIGNS
AS SHOWN - 25

675.60 ERECTING SALVAGED SIGNS
AS SHOWN - 4

646.60 TEMPORARY 100 mm WHITE LINE
(ALL LINES WILL INCLUDE EDGE LINE BREAKS AND RADIUS FOR TOWN HIGHWAYS)

MIDDLEBURY:
STA. 6+440.0 - STA. 6+881.555 LT & RT
STA. 6+440.0 - STA. 6+458.0 LT, SOLID LINE (LANE LINE)
STA. 6+440.0 - STA. 6+498.0 LT, SOLID LINE (LANE LINE)
STA. 6+458.0 - STA. 6+526.8 LT, DOTTED LINE
STA. 6+498.0 - STA. 6+539.0 LT, DOTTED LINE
STA. 6+458.0 - STA. 6+539.0 RT, DOTTED LINE
STA. 6+539.0 - STA. 6+580.0 RT, SOLID LINE (LANE LINE)
STA. 6+591.873 LT, T-20 (LANE LINE)
STA. 6+606.0 - STA. 6+660.3 LT, SOLID LINE (LANE LINE)
STA. 6+660.3 - STA. 6+706.0 LT, DOTTED LINE

646.61 TEMPORARY 100 mm YELLOW LINE
(ALL LINES WILL INCLUDE C/L BREAKS FOR TOWN HIGHWAYS) S=SOLID, D=DASHED

MIDDLEBURY:
STA. 6+680.0 - STA. 6+881.555 LT S RT S
STA. 6+440.0 - STA. 6+458.0 DOUBLE SOLID RT
STA. 6+458.0 - STA. 6+526.8 DOUBLE SOLID LT & RT (MEDIAN)
STA. 6+539.0 - STA. 6+580.0 DOUBLE SOLID LT
STA. 6+606.0 - STA. 6+680.0 DOUBLE SOLID LT & RT (MEDIAN)
STA. 6+532.327 DOUBLE SOLID RT, T-15
STA. 6+591.873 DOUBLE SOLID LT, T-20

646.70 TEMPORARY LETTER OR SYMBOL


MIDDLEBURY:
STA. 6+455.8 TO 6+458.0 LT, ARROW (1EA)
STA. 6+463.5 TO 6+465.9 LT, ARROW (1EA)
STA. 6+495.6 TO 6+498.0 LT, ARROW (1EA)
STA. 6+532.327 RT, T-15 "S,T,O,P" (4 EA)
STA. 6+539.0 TO 6+541.4 RT, ARROW (1EA)
STA. 6+575.1 TO 6+577.5 RT, ARROW (1EA)
STA. 6+591.873 LT, T-20, ARROW (2 SETS) (2 EA)
STA. 6+611.5 TO 6+613.9 LT, ARROW (1EA)
STA. 6+657.9 TO 6+660.3 LT, ARROW (1EA)
STA. 6+801.8 TO 6+816.2 LT, "S,I,G,N,A,L A,H,E,A,D" (11EA)

646.46 DURABLE 600 mm STOP BAR

MIDDLEBURY:
STA. 6+532.327 RT, T-115
STA. 6+580.0 RT
STA. 6+591.873 LT, T-20
STA. 6+609.0 LT

646.66 TEMPORARY 600 mm STOP BAR

MIDDLEBURY:
STA. 6+532.327 RT, T-115
STA. 6+580.0 RT
STA. 6+591.873 LT, T-20
STA. 6+609.0 LT

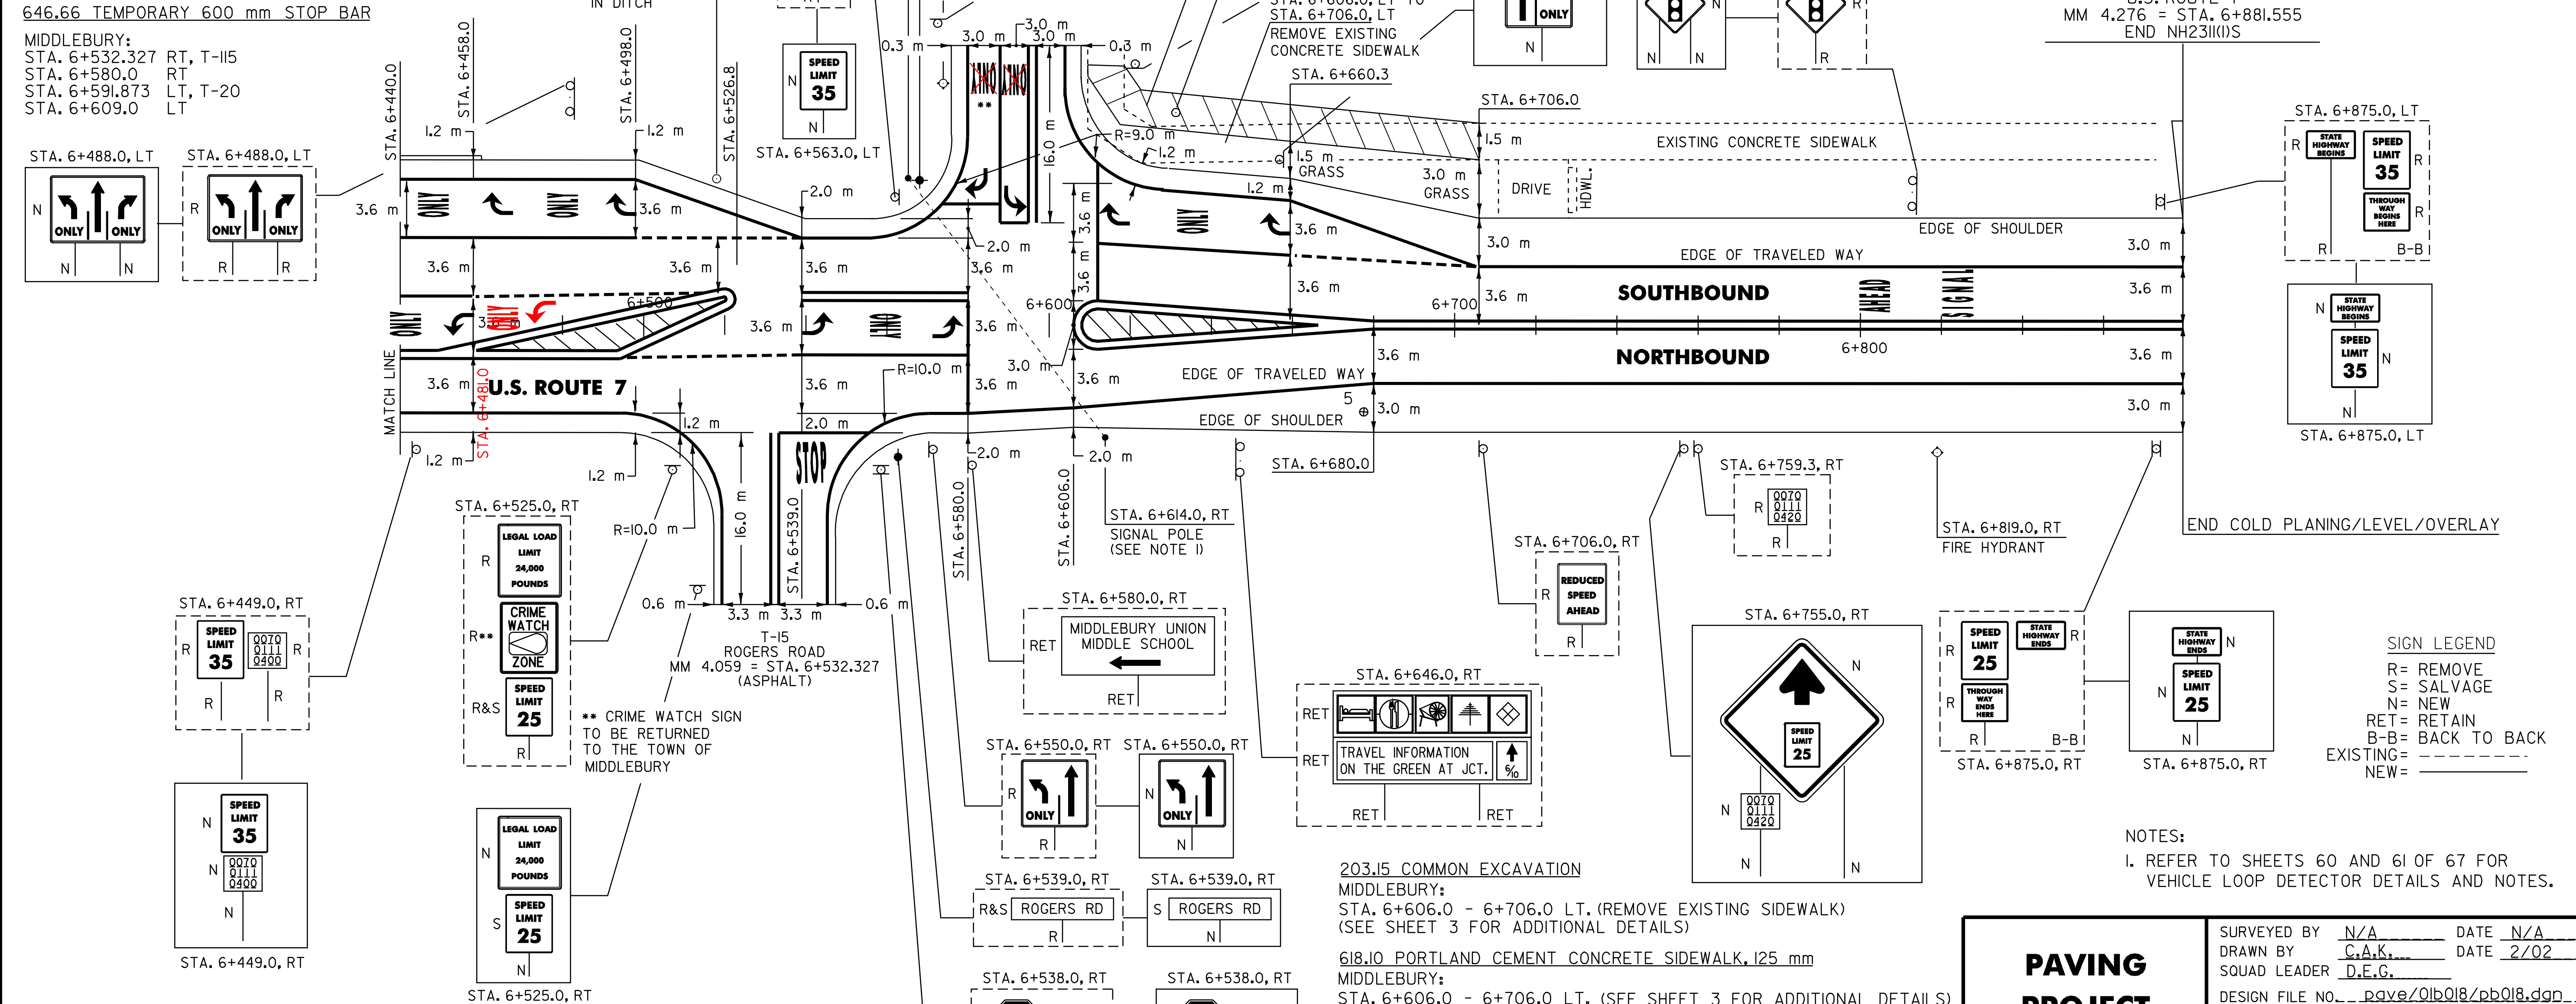

SIGN LEGEND
R= REMOVE
S= SALVAGE
N= NEW
RET= RETAIN
B-B= BACK TO BACK
EXISTING= -----
NEW= _____

NOTES:
1. REFER TO SHEETS 60 AND 61 OF 67 FOR VEHICLE LOOP DETECTOR DETAILS AND NOTES.

DATUM	PAVEMENT CORES	Core #	Position	MM STA.	PLAN STA.	CORE DEPTH(mm)	PCC UNDER
VERTICAL	N/A	5	RT SHLD.	4.153	6+684	81	NO
HORIZONTAL	N/A						

203.15 COMMON EXCAVATION
MIDDLEBURY:
STA. 6+606.0 - 6+706.0 LT. (REMOVE EXISTING SIDEWALK) (SEE SHEET 3 FOR ADDITIONAL DETAILS)

618.10 PORTLAND CEMENT CONCRETE SIDEWALK, 125 mm
MIDDLEBURY:
STA. 6+606.0 - 6+706.0 LT. (SEE SHEET 3 FOR ADDITIONAL DETAILS)

604.42 CHANGING ELEVATION OF SEWER MANHOLES
MIDDLEBURY 6+613.0 LT. (SEE SHEET 3 FOR ADDITIONAL DETAILS)

616.28 CAST-IN-PLACE CONCRETE CURB, TYPE B
MIDDLEBURY:
STA. 6+606.0 - 6+706.0 LT. (SEE SHEET 3 FOR ADDITIONAL DETAILS)

PAVING PROJECT LAYOUT

25

SURVEYED BY N/A DATE N/A

DRAWN BY C.A.K. DATE 2/02

DESIGN LEADER D.E.G.

DESIGN FILE NO. pave/01b018/pb018.dgn

IPARM FILE pb018p25.i DATE 10-JUL-2006 13:







PROJ. NAME SALISBURY - MIDDLEBURY

PROJ. NO. NH_231111S







SHEET 34 OF 67 SHEETS

KILOMETER MARKER, STATION, OR SIGN NUMBER	SIGN LEGEND	SIGN DIMENSIONS			NEW & SALVAGED SIGNS				EXIST POST RETAIN SALVAGE	NO. OF POSTS	FLANGED CHANNEL			SQUARE STEEL (mm)			ANCHOR	SLEEVE	NEW SIGN POSTS TUBULAR ALUMINUM Ø (mm)			TUBULAR STEEL Ø (mm)				W-SHAPE STEEL				SIGN FRAMING REQUIRED	REMARKS	SIGN DETAIL																																																																																																																																																																																																																																																																																																																																																																																																																																																																																																																																																																																																																																																																																																																																																																																																																																										
											kg/m			44	50	63			kg/m			FOUND- ATION	75	100	100 MOD	75	89	100	125			FTG. SIZE		WEIGHT	POST SIZE	DETAIL ON SHEET NUMBER	STD. SHEET NUMBER																																																																																																																																																																																																																																																																																																																																																																																																																																																																																																																																																																																																																																																																																																																																																																																																																																					
		1.7	3.0	4.5	3.4	3.9	5.0	kg/m			1.9	2.5	2.5	kg/m					600 mm	750 mm																																																																																																																																																																																																																																																																																																																																																																																																																																																																																																																																																																																																																																																																																																																																																																																																																																																						
		EA	WIDTH (mm)	HEIGHT (mm)	“A”	“A” MOD.	SALV SIGN	SALV TIS			kg/m	kg/m	
KILOMETER MARKER, STATION, OR SIGN NUMBER	SIGN LEGEND	SIGN DIMENSIONS			NEW & SALVAGED SIGNS				EXIST POST RETAIN	SALVAGE	NO. OF POSTS	FLANGED CHANNEL			SQUARE STEEL (mm)			ANCHOR	SLEEVE	NEW SIGN POSTS			TUBULAR STEEL Ø (mm)				W-SHAPE STEEL				REQUIRE D SIGN	REMARKS	SIGN DETAIL																																																																																																																																																																																																																																																																																																																																																																																																																																																																																																																																																																																																																																																																																																																																																																																																																																																																																																																																																																																																																																																																																																																																																																																																																															
																				TUBULAR ALUMINUM Ø (mm)													FOUND- ATION	TUBULAR STEEL Ø (mm)				FTG. SIZE		WEIGHT	POST SIZE	DETAIL ON SHEET NUMBER	STD. SHEET NUMBER																																																																																																																																																																																																																																																																																																																																																																																																																																																																																																																																																																																																																																																																																																																																																																																																																																																																																																																																																																																																																																																																																																																																																																																																																					
		75	100	100 MOD	75	89	100	125				600 mm	750 mm																																																																																																																																																																																																																																																																																																																																																																																																																																																																																																																																																																																																																																																																																																																																																																																																																																																																																																																																																																																																																																																																																																																																																																																																																																																			
		kg/m	kg/m	kg/m	kg/m	kg/m	kg/m	kg/m				kg/m	kg/m	kg/m																																																																																																																																																																																																																																																																																																																																																																																																																																																																																																																																																																																																																																																																																																																																																																																																																																																																																																																																																																																																																																																																																																																																																																																																																																																		


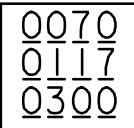
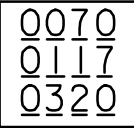
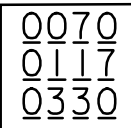
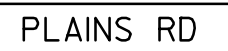
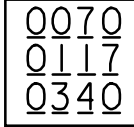
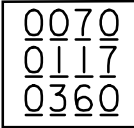
KILOMETER MARKER, STATION, OR SIGN NUMBER	SIGN LEGEND	SIGN DIMENSIONS			NEW & SALVAGED SIGNS							EXIST POST RETAIN	SALVAGE	NO. OF POSTS	FLANGED CHANNEL			SQUARE STEEL (mm)			ANCHOR	SLEEVE	NEW SIGN POSTS			TUBULAR STEEL Ø (mm)				W-SHAPE STEEL				REQUIRED SIGN	REMARKS	SIGN DETAIL	
					"A"	"A" MOD.	SALV SIGN	SALV TIS	kg/m	44	50				63	kg/m	TUBULAR ALUMINUM Ø (mm)			FOUND- ATION			75	89	100	125	FTG. SIZE		WEIGHT	POST SIZE	DETAIL ON SHEET NUMBER	STD. SHEET NUMBER					
		kg/m	75	100						100 MOD	600 mm				750 mm																						
																	1.7	3.0	4.5				3.4	3.9	5.0	1.9	2.5	2.5					11.3			13.4	16.1
SALISBURY: 4+828.0, RT		I	150	200	0.03							I	X			X																		E-138M			
5+149.9, RT		I	150	200	0.03							I	X			X																		E-138M			
5+306.0, RT		I	600	750	0.45							I			X		X																	E-141M			
5+320.0, RT	 	I I	750 150	750 200	0.56 0.03							I			X		X														BACK-TO-BACK		E-143M E-138M				
5+321.0, RT								I				I		X			X													SALVAGED SIGN TO BE MOUNTED ON NEW POST. TOP MOUNTING BRACKET REQUIRED TO INSTALL SALVAGED SIGN ON FLANGED CHANNEL SIGN POST.	-	-					
5+471.8, LT		I	150	200	0.03							I	X			X																		E-138M			
5+793.6, RT		I	150	200	0.03							I	X			X																		E-138M			
FINAL POST LENGTHS ARE TO BE DETERMINED IN THE FIELD. POST SIZES ARE COMPUTED BASED ON INFORMATION FURNISHED ON THE STANDARD SHEETS AND THE TRAFFIC & SAFETY DIVISION'S "SIGN POST DESIGN GUIDELINE."												m	m	m	m	m	m		EA	kg	kg	kg		kg	kg	kg	kg										
												18.4	4.6	9.2	18.4	13.8																					







KILOMETER MARKER, STATION, OR SIGN NUMBER	SIGN LEGEND	SIGN DIMENSIONS			NEW & SALVAGED SIGNS				EXIST POST RETAIN	SALVAGE	NO. OF POSTS	FLANGED CHANNEL			SQUARE STEEL (mm)			ANCHOR	SLEEVE	NEW SIGN POSTS			TUBULAR STEEL Ø (mm)				W-SHAPE STEEL				REQUIRE D SIGN	REMARKS	SIGN DETAIL											
		E A	WIDTH (mm)	HEIGHT (mm)	"A"	"A" MOD.	SALV SIGN	SALV TIS				kg/m		3.4	3.9	5.0			TUBULAR ALUMINUM Ø (mm)			FOUND- ATION	TUBULAR STEEL Ø (mm)				FTG. SIZE		WEIGHT	POST SIZE			DETAIL ON SHEET NUMBER	STD. SHEET NUMBER										
																			75	100	100 MOD		75	89	100	125	600 mm	750 mm																
																			kg/m				kg/m																					
												1.7	3.0	4.5	3.4	3.9	5.0		1.9	2.5	2.5	11.3	13.4	16.1	21.7																			
SALISBURY: 6+115.5, LT	0070 0117 0380	I	150	200	0.03						I	X			X																			E-138M										
6+437.4, RT	0070 0117 0400	I	150	200	0.03						I	X			X																			E-138M										
6+571.0, RT	BRIDGE 124A US 7	I	150	200	0.03						I	X			X																			E-134M										
6+574.0, LT	BRIDGE 124A US 7	I	150	200	0.03						I	X			X																			E-134M										
6+759.3, LT	0070 0117 0420	I	150	200	0.03						I	X			X																			E-138M										
7+081.1, RT	0070 0117 0440	I	150	200	0.03						I	X			X																			E-138M										
7+285.5, LT	SALISBURY MIDDLEBURY	I	1500	190	0.29						2			X		X																		E-124M										
	0070 0117 0453 0070 0111 0000	I I	150 150	200 200	0.03 0.03																													E-138M E-138M										
FINAL POST LENGTHS ARE TO BE DETERMINED IN THE FIELD. POST SIZES ARE COMPUTED BASED ON INFORMATION FURNISHED ON THE STANDARD SHEETS AND THE TRAFFIC & SAFETY DIVISION'S "SIGN POST DESIGN GUIDELINE."												m	m	m	m	m	m		EA	kg	kg	kg		kg	kg	kg	kg																	
												27.6	9.2	27.6	9.2																													
												m			m					kg			EA	kg				EA	EA	kg														
												m			m					kg				kg				EA	EA	kg														
												m			m					kg				kg				EA	EA	kg														
												m																																

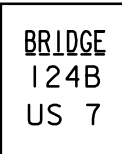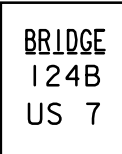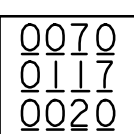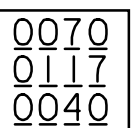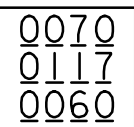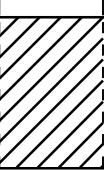KILOMETER MARKER, STATION, OR SIGN NUMBER	SIGN LEGEND	SIGN DIMENSIONS			NEW & SALVAGED SIGNS				EXIST POST RETAIN SALVAGE	NO. OF POSTS	FLANGED CHANNEL			SQUARE STEEL (mm)			ANCHOR	SLEEVE	NEW SIGN POSTS			TUBULAR STEEL Ø (mm)				W-SHAPE STEEL				REQUIRE D SIGN	REMARKS	SIGN DETAIL																																																																																																																																																																																																																																																																																																																																																																																																																																																																																																																																																																																																																																																																																																																																
																			TUBULAR ALUMINUM Ø (mm)		FOUND- ATION											TUBULAR STEEL Ø (mm)				FTG. SIZE		WEIGHT	POST SIZE	DETAIL ON SHEET NUMBER	STD. SHEET NUMBER																																																																																																																																																																																																																																																																																																																																																																																																																																																																																																																																																																																																																																																																																																																							
		75	100	100 MOD	75	89	100	125			600 mm	750 mm																																																																																																																																																																																																																																																																																																																																																																																																																																																																																																																																																																																																																																																																																																																																																				
		kg/m			kg/m			kg/m				600 mm	750 mm																																																																																																																																																																																																																																																																																																																																																																																																																																																																																																																																																																																																																																																																																																																																																			
		1.9	2.5	2.5	11.3	13.4	16.1	21.7																																																																																																																																																																																																																																																																																																																																																																																																																																																																																																																																																																																																																																																																																																																																																								
MIDDLEBURY: 0+018.0, RT		I	150	200	0.03					I	X			X																			E-134M																																																																																																																																																																																																																																																																																																																																																																																																																																																																																																																																																																																																																																																																																																																															
0+020.0, LT		I	150	200	0.03					I	X			X																			E-134M																																																																																																																																																																																																																																																																																																																																																																																																																																																																																																																																																																																																																																																																																																																															
0+321.9, RT		I	150	200	0.03					I	X			X																			E-138M																																																																																																																																																																																																																																																																																																																																																																																																																																																																																																																																																																																																																																																																																																																															
0+643.7, LT		I	150	200	0.03					I	X			X																			E-138M																																																																																																																																																																																																																																																																																																																																																																																																																																																																																																																																																																																																																																																																																																																															
0+965.6, RT		I	150	200	0.03					I	X			X																			E-138M																																																																																																																																																																																																																																																																																																																																																																																																																																																																																																																																																																																																																																																																																																																															
1+010.0, LT		I	300	900	0.27					I			X		X																		E-107M																																																																																																																																																																																																																																																																																																																																																																																																																																																																																																																																																																																																																																																																																																																															
1+010.0, RT		I	300	900	0.27					I			X		X																		E-107M																																																																																																																																																																																																																																																																																																																																																																																																																																																																																																																																																																																																																																																																																																																															
		I	150	200	0.03																												E-134M																																																																																																																																																																																																																																																																																																																																																																																																																																																																																																																																																																																																																																																																																																																															
1+090.0, LT		I	300	900	0.27					I			X		X																		E-107M																																																																																																																																																																																																																																																																																																																																																																																																																																																																																																																																																																																																																																																																																																																															
		I	150	200	0.03																												E-134M																																																																																																																																																																																																																																																																																																																																																																																																																																																																																																																																																																																																																																																																																																																															
FINAL POST LENGTHS ARE TO BE DETERMINED IN THE FIELD. POST SIZES ARE COMPUTED BASED ON INFORMATION FURNISHED ON THE STANDARD SHEETS AND THE TRAFFIC & SAFETY DIVISION'S "SIGN POST DESIGN GUIDELINE."											m	m	m	m	m	m		EA	kg	kg	kg		kg	kg	kg	kg																																																																																																																																																																																																																																																																																																																																																																																																																																																																																																																																																																																																																																																																																																																																						

KILOMETER MARKER, STATION, OR SIGN NUMBER	SIGN LEGEND	SIGN DIMENSIONS			NEW & SALVAGED SIGNS				EXIST POST RETAIN SALVAGE	NO. OF POSTS	NEW SIGN POSTS																		REMARKS	SIGN DETAIL																																																																																																																																																																																																																																																																																																																																																																																																																																																																																																																																																																																																																																																																													
											FLANGED CHANNEL			SQUARE STEEL (mm)			TUBULAR ALUMINUM Ø (mm)			TUBULAR STEEL Ø (mm)				W-SHAPE STEEL				DETAIL ON SHEET NUMBER		STD. SHEET NUMBER																																																																																																																																																																																																																																																																																																																																																																																																																																																																																																																																																																																																																																																																													
		EA	WIDTH (mm)	HEIGHT (mm)	"A"	"A" MOD.	SALV SIGN	SALV TIS			kg/m	44	50	63	ANCHOR	SLEEVE	75	100	100 MOD	FOUND- ATION	75	89	100	125	FTG. SIZE		WEIGHT				POST SIZE																																																																																																																																																																																																																																																																																																																																																																																																																																																																																																																																																																																																																																																																												
												1.7	3.0	4.5			3.4	3.9	5.0		1.9	2.5	2.5	11.3	13.4	16.1						21.7	600 mm	750 mm																																																																																																																																																																																																																																																																																																																																																																																																																																																																																																																																																																																																																																																																									
MIDDLEBURY: I+428.0, LT	BRANDON I3	I	1800	250	0.45						2			X		X																		E-I23M																																																																																																																																																																																																																																																																																																																																																																																																																																																																																																																																																																																																																																																																									
	RUTLAND 28	I	1800	250	0.45																												E-I23M																																																																																																																																																																																																																																																																																																																																																																																																																																																																																																																																																																																																																																																																										
I+488.0, LT	SOUTH	I	600	300	0.18						I			X		X																	E-I36AM																																																																																																																																																																																																																																																																																																																																																																																																																																																																																																																																																																																																																																																																										
	7	I	600	600	0.36																												E-I36AM																																																																																																																																																																																																																																																																																																																																																																																																																																																																																																																																																																																																																																																																										
I+520.0, RT	TO	I	600	300	0.18						2								2	82.2										X			E-I36BM																																																																																																																																																																																																																																																																																																																																																																																																																																																																																																																																																																																																																																																																										
	NORTH NORTH EAST	I I I	600 600 600	300 300 300	0.18 0.18 0.18																												E-I36AM E-I36BM E-I36BM																																																																																																																																																																																																																																																																																																																																																																																																																																																																																																																																																																																																																																																																										
	7 VERMONT 116 VERMONT 125	I I I	600 750 750	600 600 600	0.36 0.45 0.45																												E-I36AM E-I36BM E-I36BM																																																																																																																																																																																																																																																																																																																																																																																																																																																																																																																																																																																																																																																																										
	↑ → →	I I I	525 525 525	375 375 375	0.20 0.20 0.20																												E-I36AM E-I36BM E-I36BM																																																																																																																																																																																																																																																																																																																																																																																																																																																																																																																																																																																																																																																																										
I+539.0, RT	STOP	I	750	750	0.56						I			X		X																	E-I43M																																																																																																																																																																																																																																																																																																																																																																																																																																																																																																																																																																																																																																																																										
I+548.0, LT	NORTH SOUTH	I I	600 600	300 300	0.18 0.18						2			X		X													X				E-I36BM E-I36AM																																																																																																																																																																																																																																																																																																																																																																																																																																																																																																																																																																																																																																																																										
	VERMONT 116 7	I I	750 600	600 600	0.45 0.36																												E-I36BM E-I36AM																																																																																																																																																																																																																																																																																																																																																																																																																																																																																																																																																																																																																																																																										
	← ↑	I I	525 525	375 375	0.20 0.20																												E-I36BM E-I36AM																																																																																																																																																																																																																																																																																																																																																																																																																																																																																																																																																																																																																																																																										
I+555.0, RT	STOP 0070 0111 0096	I I	750 150	750 200	0.56 0.03						I			X		X															BACK-TO-BACK																																																																																																																																																																																																																																																																																																																																																																																																																																																																																																																																																																																																																																																																												
I+555.5, RT	OSSIE RD							I			I		X		X																SALVAGED SIGN TO BE MOUNTED ON NEW POST. TOP MOUNTING BRACKET REQUIRED TO INSTALL SALVAGED SIGN ON FLANGED CHANNEL SIGN POST.	-	-																																																																																																																																																																																																																																																																																																																																																																																																																																																																																																																																																																																																																																																																										
FINAL POST LENGTHS ARE TO BE DETERMINED IN THE FIELD. POST SIZES ARE COMPUTED BASED ON INFORMATION FURNISHED ON THE STANDARD SHEETS AND THE TRAFFIC & SAFETY DIVISION'S "SIGN POST DESIGN GUIDELINE."												m	m	m	m	m	m	EA	kg	kg	kg		kg	kg	kg	kg																																																																																																																																																																																																																																																																																																																																																																																																																																																																																																																																																																																																																																																																																	</









KILOMETER MARKER, STATION, OR SIGN NUMBER	SIGN LEGEND	SIGN DIMENSIONS			NEW & SALVAGED SIGNS				EXIST POST RETAIN SALVAGE	NO. OF POSTS	FLANGED CHANNEL			SQUARE STEEL (mm)			ANCHOR	SLEEVE	NEW SIGN POSTS			TUBULAR STEEL Ø (mm)				W-SHAPE STEEL				REQUIRE D SIGN	REMARKS	SIGN DETAIL																																																																																																																																																																																																																																																																																																																																																																																																																																																																																																																																																																																																																																																																																																																																																																																																																																																																																																																																																																																																																																																																																																																																																																																																																																			
																			TUBULAR ALUMINUM Ø (mm)													FOUND- ATION	TUBULAR STEEL Ø (mm)				FTG. SIZE		WEIGHT	POST SIZE	DETAIL ON SHEET NUMBER	STD. SHEET NUMBER																																																																																																																																																																																																																																																																																																																																																																																																																																																																																																																																																																																																																																																																																																																																																																																																																																																																																																																																																																																																																																																																																																																																																																																																																									
		75	100	100 MOD	75	89	100	125			600	750																																																																																																																																																																																																																																																																																																																																																																																																																																																																																																																																																																																																																																																																																																																																																																																																																																																																																																																																																																																																																																																																																																																																																																																																																																																							
		kg/m	kg/m	kg/m	kg/m	kg/m	kg/m	kg/m			600 mm	750 mm																																																																																																																																																																																																																																																																																																																																																																																																																																																																																																																																																																																																																																																																																																																																																																																																																																																																																																																																																																																																																																																																																																																																																																																																																																																							
																																																																																																																																																																																																																																																																																																																																																																																																																																																																																																																																																																																																																																																																																																																																																																																																																																																																																																																																																																																																																																																																																																																																																																																																																																																																			</

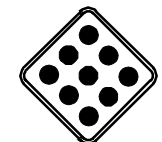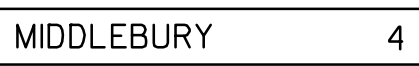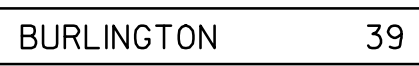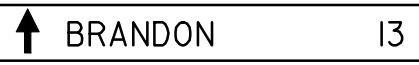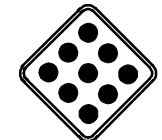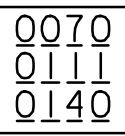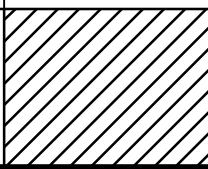
KILOMETER MARKER, STATION, OR SIGN NUMBER	SIGN LEGEND	SIGN DIMENSIONS			NEW & SALVAGED SIGNS				EXIST POST RETAIN	SALVAGE	NO. OF POSTS	NEW SIGN POSTS											REMARKS										SIGN DETAIL															
												FLANGED CHANNEL			SQUARE STEEL (mm)			ANCHOR	SLEEVE	TUBULAR ALUMINUM Ø (mm)													TUBULAR STEEL Ø (mm)				W-SHAPE STEEL											
		E A	WIDTH (mm)	HEIGHT (mm)	"A"	"A" MOD.	SALV SIGN	SALV TIS				kg/m	44	50	63	kg/m	FOUND- ATION			75	89	100											125	FTG. SIZE		WEIGHT	POST SIZE											
													1.7	3.0	4.5					3.4	3.9	5.0											1.9	2.5	2.5			11.3	13.4	16.1	21.7	600 mm	750 mm					
MIDDLEBURY: 2+182.0, C/L	 	I	600	750	0.45						I			X		X																	SLEEVE REQUIRED FOR SIGN POST; INCIDENTAL TO SIGN POST ITEM BACK - TO - BACK		E-144M E-143M													
	 	I	450	450	0.20																												BACK - TO - BACK		E-150M E-150M													
2+200.0, RT		I	1800	250	0.45						2			X		X																		E-123M														
		I	1800	250	0.45																													E-123M														
		I	1800	250	0.45																													E-123M														
2+218.0, LT		I	1800	250	0.45						2			X		X																		E-123M														
		I	1800	250	0.45																													E-123M														
		I	1800	250	0.45																													E-123M														
		I	1800	250	0.45																													E-123M														
		I	1800	250	0.45																													E-123M														
2+242.0, C/L	 	I	600	600	0.36						I			X		X			X														SLEEVE REQUIRED FOR SIGN POST; INCIDENTAL TO SIGN POST ITEM BACK - TO - BACK		E-143M E-144M													
	 	I	450	450	0.20																													E-150M E-150M														
2+253.1, RT		I	150	200	0.03						I	X			X																			E-138M														
FINAL POST LENGTHS ARE TO BE DETERMINED IN THE FIELD. POST SIZES ARE COMPUTED BASED ON INFORMATION FURNISHED ON THE STANDARD SHEETS AND THE TRAFFIC & SAFETY DIVISION'S "SIGN POST DESIGN GUIDELINE."												m	m	m	m	m	m		EA	kg	kg	kg		kg	kg	kg	kg																					
												4.6	27.6	4.6	27.6																																	
												m			m			EA	kg			EA	kg				EA	EA	kg																			
					TOTALS	m ² 6.05	m ²	EA	m ²			m			m			EA	kg			EA	kg				EA	EA	kg																			
												32.2			32.2																																	

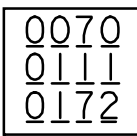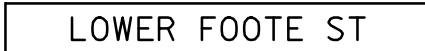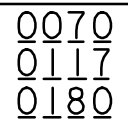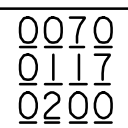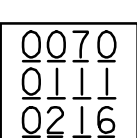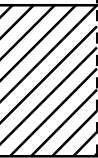KILOMETER MARKER, STATION, OR SIGN NUMBER	SIGN LEGEND	SIGN DIMENSIONS			NEW & SALVAGED SIGNS							EXIST POST RETAIN	NO. OF POSTS	NEW SIGN POSTS												REMARKS	SIGN DETAIL								
														FLANGED CHANNEL			SQUARE STEEL (mm)			TUBULAR ALUMINUM Ø (mm)			TUBULAR STEEL Ø (mm)						W-SHAPE STEEL						
		EA	WIDTH (mm)	HEIGHT (mm)	"A"	"A" MOD.	SALV SIGN	SALV TIS	kg/m	44	50			63	ANCHOR	SLEEVE	75	100	100 MOD	FOUND- ATION	75	89	100	125	FTG. SIZE		WEIGHT	POST SIZE	FRAMING REQUIRED						
																	kg/m	kg/m	kg/m		kg/m	600 mm	750 mm												
1.7	3.0	4.5	3.4	3.9	5.0	1.9	2.5	2.5	11.3	13.4	16.1	21.7																							
MIDDLEBURY: 2+715.0, RT		I	600	750	0.45						I			X		X																			E-142M
2+762.0, RT		I	750	750	0.56						I			X		X																		E-143M	
2+762.0, RT		I	600	750	0.45						I			X		X																		E-141M	
2+773.0, RT	 	I I	750 150	750 200	0.56 0.03						I			X		X														BACK-TO-BACK			E-143M E-138M		
2+773.5, RT							I				I		X		X															SALVAGED SIGN TO BE MOUNTED ON NEW POST. TOP MOUNTING BRACKET REQUIRED TO INSTALL SALVAGED SIGN ON FLANGED CHANNEL SIGN POST.	-		-		
2+896.8, LT		I	150	200	0.03						I	X		X																				E-138M	
3+218.7, RT		I	150	200	0.03						I	X		X																				E-138M	
3+473.0, RT		I	600	750	0.45						I			X		X																		E-141M	
3+485.0, RT	 	I I	750 150	750 200	0.56 0.03						I			X		X														BACK-TO-BACK			E-143M E-138M		
FINAL POST LENGTHS ARE TO BE DETERMINED IN THE FIELD. POST SIZES ARE COMPUTED BASED ON INFORMATION FURNISHED ON THE STANDARD SHEETS AND THE TRAFFIC & SAFETY DIVISION'S "SIGN POST DESIGN GUIDELINE."												m	m	m	m	m	m		EA	kg	kg	kg		kg	kg	kg	kg								
												9.2	4.6	27.6	9.2	32.2																			
																																</			



KILOMETER MARKER, STATION, OR SIGN NUMBER	SIGN LEGEND	SIGN DIMENSIONS			NEW & SALVAGED SIGNS				EXIST POST RETAIN	SALVAGE	NO. OF POSTS	FLANGED CHANNEL			SQUARE STEEL (mm)			ANCHOR	SLEEVE	NEW SIGN POSTS			TUBULAR STEEL Ø (mm)				W-SHAPE STEEL				REQUIRE FRAMING	REMARKS	SIGN DETAIL		
																				TUBULAR Ø (mm)	ALUMINUM MOD	FOUND- ATION											DETAIL ON SHEET NUMBER	STD. SHEET NUMBER	
		75	100	100 MOD	75	89	100	125				FTG. SIZE	WEIGHT	POST SIZE																					
		kg/m	kg/m	kg/m	600 mm	750 mm																													
		E A	WIDTH (mm)	HEIGHT (mm)	“A”	“A” MOD.	SALV SIGN	SALV TIS				kg/m	kg/m	kg/m	3.4	3.9	5.0																		
MIDDLEBURY: 3+540.6, LT		I	150	200	0.03						I	X			X																		E-138M		
3+862.4, LT		I	150	200	0.03						I	X			X																		E-138M		
4+082.0, LT								I			I		X			X																SALVAGED SIGN TO BE MOUNTED ON NEW POST. TOP MOUNTING BRACKET REQUIRED TO INSTALL SALVAGED SIGN ON FLANGED CHANNEL SIGN POST.	-	-	
4+082.0, LT		I I	750 150	750 200	0.56 0.03						I			X		X																BACK-TO-BACK		E-143M E-138M	
4+098.0, LT								I			I			X		X																SALVAGED SIGN TO BE MOUNTED ON NEW POST.	-	-	
4+098.0, LT								I			I			X		X																SALVAGED SIGN TO BE MOUNTED ON NEW POST.	-	-	
4+110.0, RT								I			I			X		X																SALVAGED SIGN TO BE MOUNTED ON NEW POST.	-	-	
4+110.0, RT								I			I			X		X																SALVAGED SIGN TO BE MOUNTED ON NEW POST.	-	-	
4+123.0, RT		I	150	200	0.03			I			I			X		X																SALVAGED SIGN TO BE MOUNTED ON NEW POST. BACK-TO-BACK		E-138M	
FINAL POST LENGTHS ARE TO BE DETERMINED IN THE FIELD. POST SIZES ARE COMPUTED BASED ON INFORMATION FURNISHED ON THE STANDARD SHEETS AND THE TRAFFIC & SAFETY DIVISION'S "SIGN POST DESIGN GUIDELINE."												m	m	m	m	m	m		EA	kg	kg	kg		kg	kg	kg	kg								
												9.2	4.6	27.6	9.2	32.2																			
												m			m					kg		EA	kg				EA	EA	kg						
												m			m									kg				EA	EA	kg					
												m			m									kg				EA	EA	kg					
												m																							

KILOMETER MARKER, STATION, OR SIGN NUMBER	SIGN LEGEND	SIGN DIMENSIONS			NEW & SALVAGED SIGNS				EXIST POST RETAIN	SALVAGE	NO. OF POSTS	FLANGED CHANNEL			SQUARE STEEL (mm)			ANCHOR	SLEEVE	NEW SIGN POSTS			TUBULAR STEEL Ø (mm)				W-SHAPE STEEL				REQUIRE D SIGN	REMARKS	SIGN DETAIL																																																																																																																																																																																																																																																																																																																																																																																																																																																																																																																																																																																																																																																																																																																																																																																																																																																																																																																																																																																																																																																																																																																																																																																																																														
																				TUBULAR ALUMINUM Ø (mm)		FOUND- ATION											TUBULAR STEEL Ø (mm)				FTG. SIZE		WEIGHT	POST SIZE	DETAIL ON SHEET NUMBER	STD. SHEET NUMBER																																																																																																																																																																																																																																																																																																																																																																																																																																																																																																																																																																																																																																																																																																																																																																																																																																																																																																																																																																																																																																																																																																																																																																																																																					
		75	100	100 MOD	75	89	100	125	600 mm	750 mm																																																																																																																																																																																																																																																																																																																																																																																																																																																																																																																																																																																																																																																																																																																																																																																																																																																																																																																																																																																																																																																																																																																																																																																																																																																					
		kg/m	kg/m	kg/m	kg/m	kg/m	kg/m	kg/m	kg/m	kg/m		kg/m																																																																																																																																																																																																																																																																																																																																																																																																																																																																																																																																																																																																																																																																																																																																																																																																																																																																																																																																																																																																																																																																																																																																																																																																																																																			

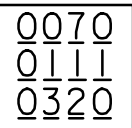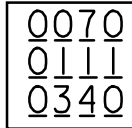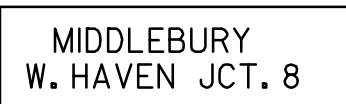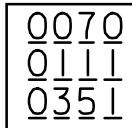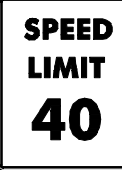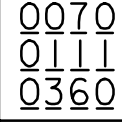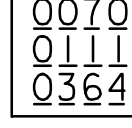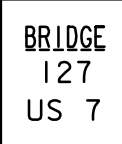
KILOMETER MARKER, STATION, OR SIGN NUMBER	SIGN LEGEND	SIGN DIMENSIONS			NEW & SALVAGED SIGNS						EXIST POST RETAIN SALVAGE	NO. OF POSTS	FLANGED CHANNEL			SQUARE STEEL (mm)			NEW SIGN POSTS			TUBULAR ALUMINUM Ø (mm)			TUBULAR STEEL Ø (mm)				W-SHAPE STEEL				REQUIR- ED SIGN- AGE	REMARKS	SIGN DETAIL																																																																																																																																																																																																																																																																																																																																																																																																																																																																																																																																																																																														
					E A	WIDTH (mm)	HEIGHT (mm)	"A"	"A" MOD.	SALV SIGN			SALV TIS	kg/m	44	50	63	ANCHOR	SLEEVE	75	100	100 MOD	FOUND- ATION	75	89	100	125	FTG. SIZE		WEIGHT	POST SIZE	DETAIL ON SHEET NUMBER			STD. SHEET NUMBER																																																																																																																																																																																																																																																																																																																																																																																																																																																																																																																																																																																														
		600 mm	750 mm	kg/m																								kg/m																																																																																																																																																																																																																																																																																																																																																																																																																																																																																																																																																																																																					
																													1.7							3.0	4.5	3.4	3.9	5.0	1.9	2.5	2.5	11.3	13.4	16.1	21.7																																																																																																																																																																																																																																																																																																																																																																																																																																																																																																																																																																																		
MIDDLEBURY: 5+150.0, RT		I	150	200	0.03						I	X			X																			E-138M																																																																																																																																																																																																																																																																																																																																																																																																																																																																																																																																																																																															
5+471.8, LT		I	150	200	0.03						I	X			X																			E-138M																																																																																																																																																																																																																																																																																																																																																																																																																																																																																																																																																																																															
5+489.0, RT		I	900	900	0.81						2			X		X																59																																																																																																																																																																																																																																																																																																																																																																																																																																																																																																																																																																																																	
5+594.0, RT		I	750	450	0.34						I			X		X																		E-128AM																																																																																																																																																																																																																																																																																																																																																																																																																																																																																																																																																																																															
5+641.0, RT		I	600	750	0.45						I			X		X																		E-141M																																																																																																																																																																																																																																																																																																																																																																																																																																																																																																																																																																																															
5+655.0, RT	 	I I	750 150	750 200	0.56 0.03						I			X		X																		E-143M E-138M																																																																																																																																																																																																																																																																																																																																																																																																																																																																																																																																																																																															
5+753.0, RT		I	600	750	0.45						I			X		X																		E-142M																																																																																																																																																																																																																																																																																																																																																																																																																																																																																																																																																																																															
5+755.0, LT		I	600	750	0.45						I			X		X																		E-142M																																																																																																																																																																																																																																																																																																																																																																																																																																																																																																																																																																																															
5+793.6, RT		I	150	200	0.03						I	X			X																			E-138M																																																																																																																																																																																																																																																																																																																																																																																																																																																																																																																																																																																															
5+863.0, RT	 	I	150	200	0.03			I			I			X		X																		SALVAGED SIGN TO BE MOUNTED ON NEW POST. BACK-TO-BACK	-	- E-138M																																																																																																																																																																																																																																																																																																																																																																																																																																																																																																																																																																																													
5+863.5, RT								I			I		X		X																			SALVAGED SIGN TO BE MOUNTED ON NEW POST.TOP MOUNTING BRACKET REQUIRED TO INSTALL SALVAGED SIGN ON FLANGED CHANNEL SIGN POST.	-	-																																																																																																																																																																																																																																																																																																																																																																																																																																																																																																																																																																																													
5+895.0, RT		I	150	200	0.03						I	X			X																			E-134M																																																																																																																																																																																																																																																																																																																																																																																																																																																																																																																																																																																															
5+898.0, LT		I	150	200	0.03						I	X			X																			E-134M																																																																																																																																																																																																																																																																																																																																																																																																																																																																																																																																																																																															
FINAL POST LENGTHS ARE TO BE DETERMINED IN THE FIELD. POST SIZES ARE COMPUTED BASED ON INFORMATION FURNISHED ON THE STANDARD SHEETS AND THE TRAFFIC & SAFETY DIVISION'S "SIGN POST DESIGN GUIDELINE."											m	m	m	m	m	m		EA	kg	kg	kg			kg	kg	kg	kg																																																																																																																																																																																																																																																																																																																																																																																																																																																																																																																																																																																																						

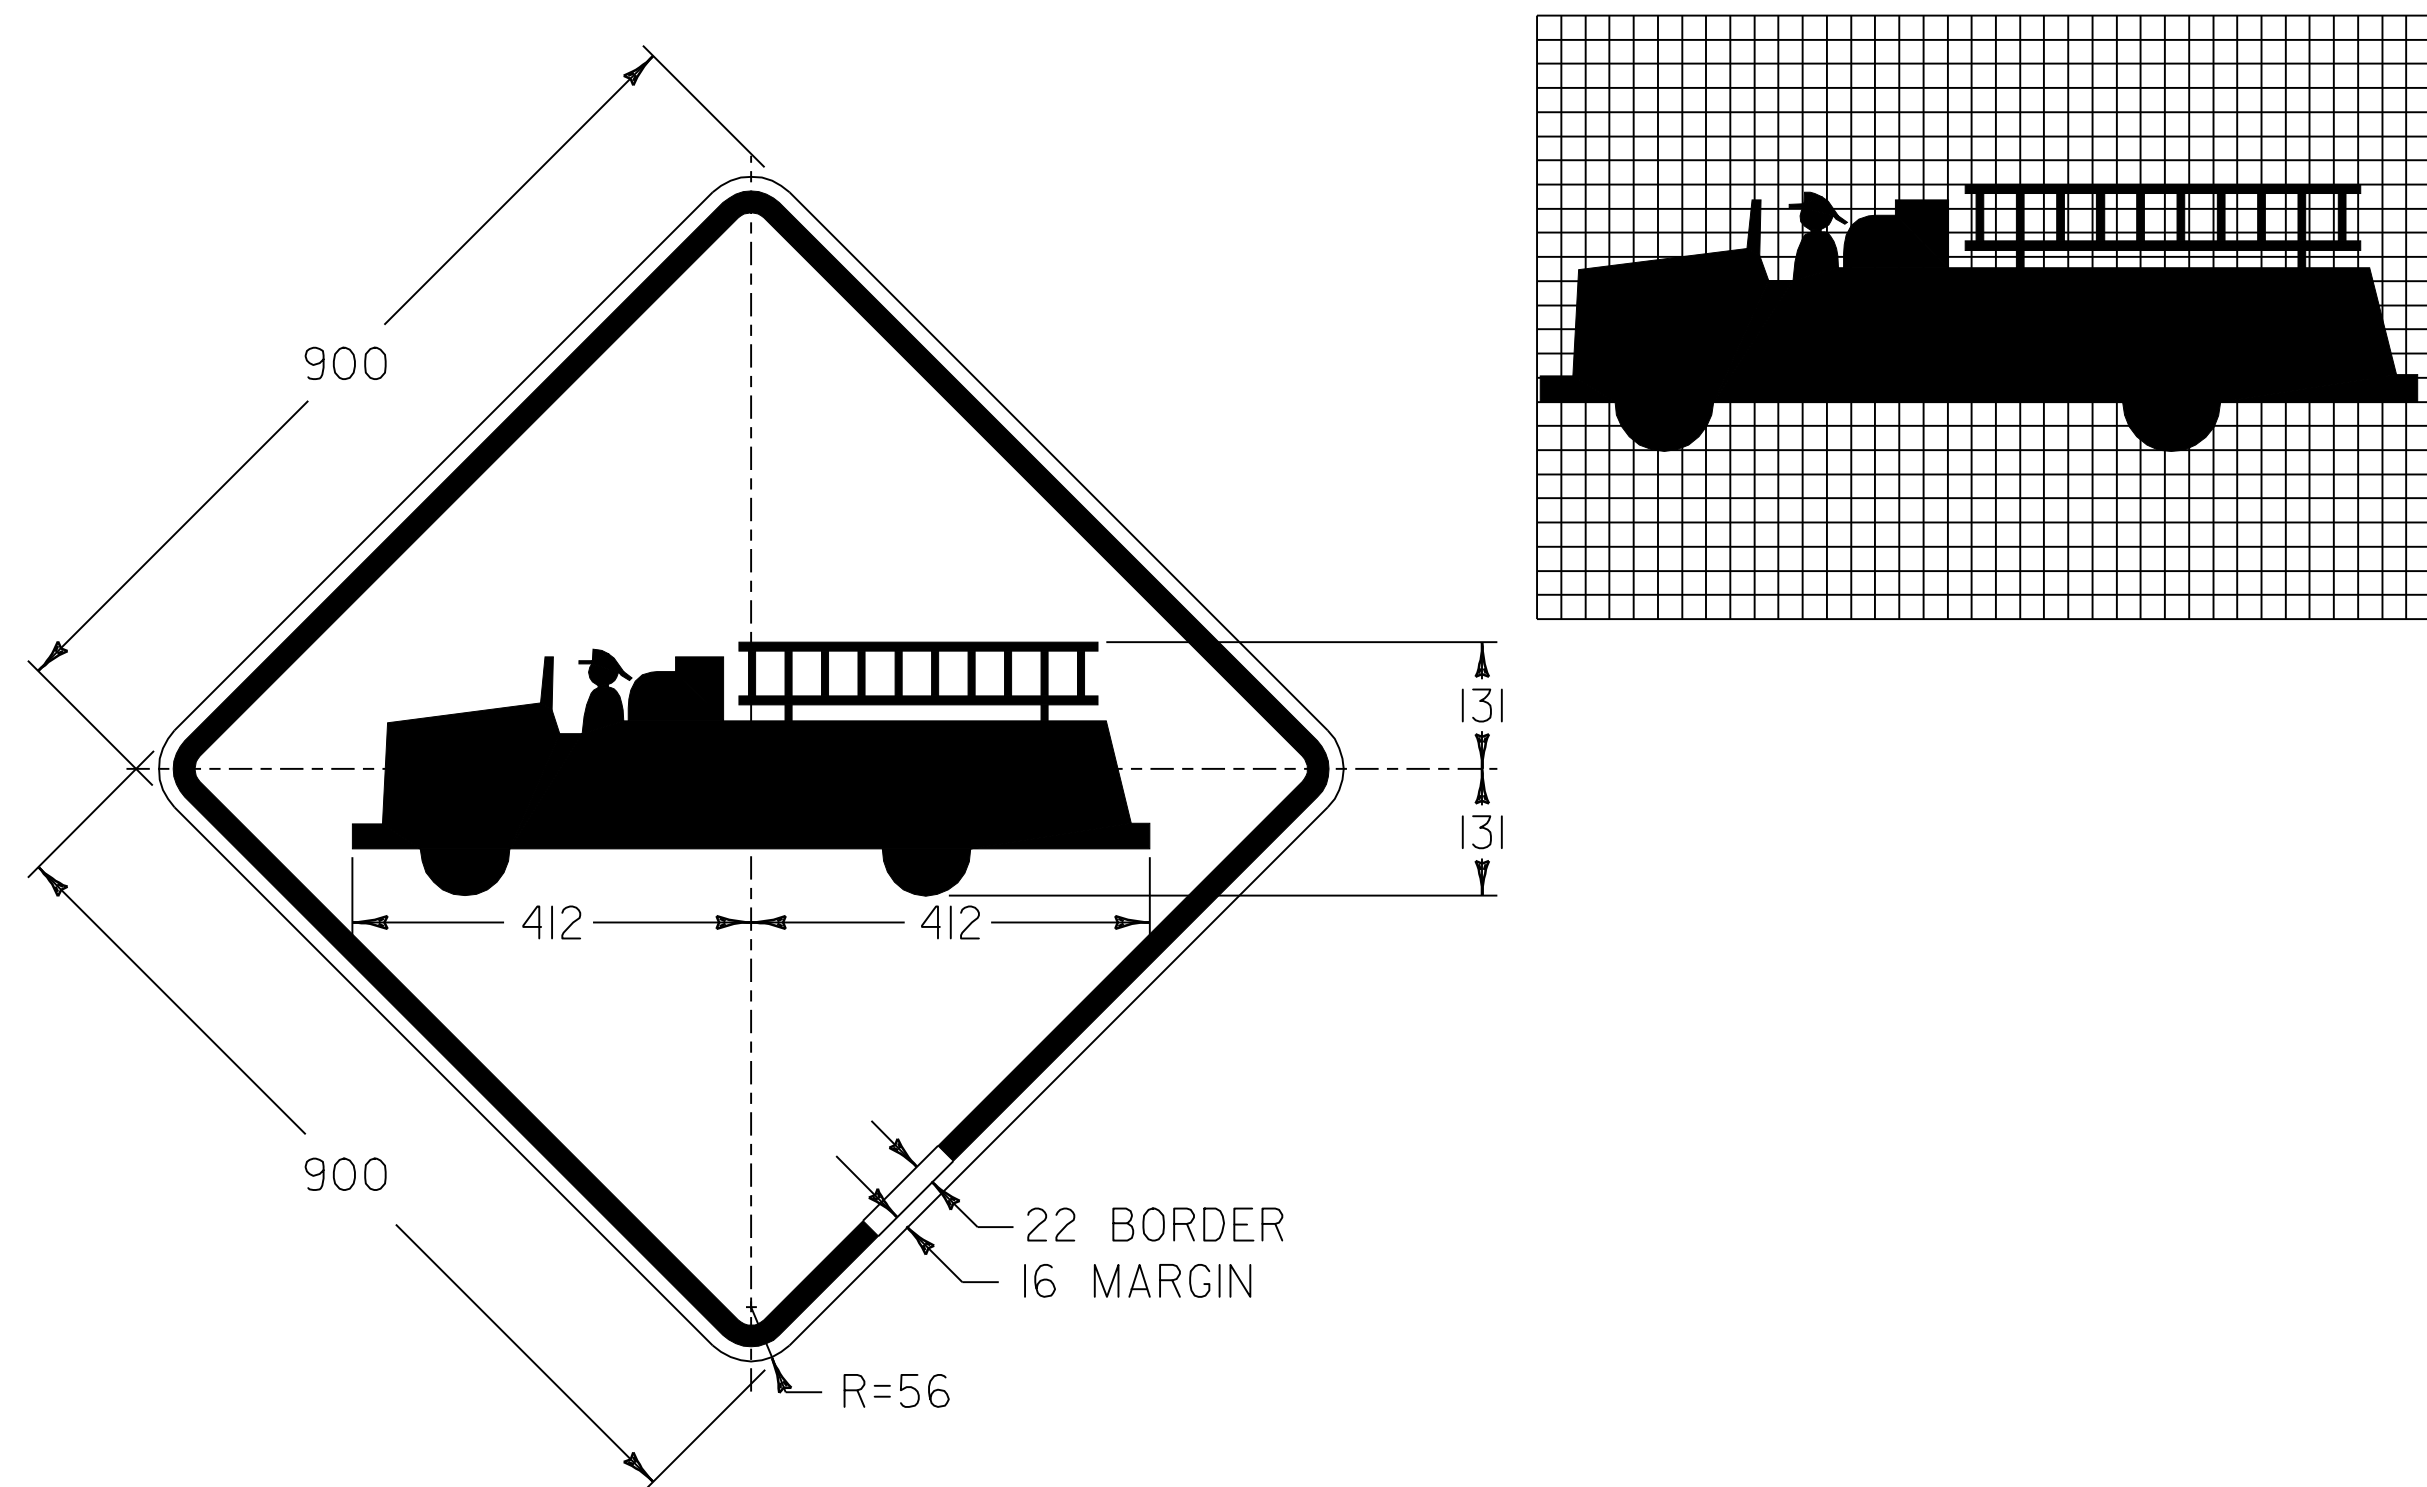


COLORS: BORDER & SYMBOL - BLACK (NON-REFL.)
BACKGROUND - YELLOW (REFL.).
REFER TO STD. E-I53M FOR MATERIALS

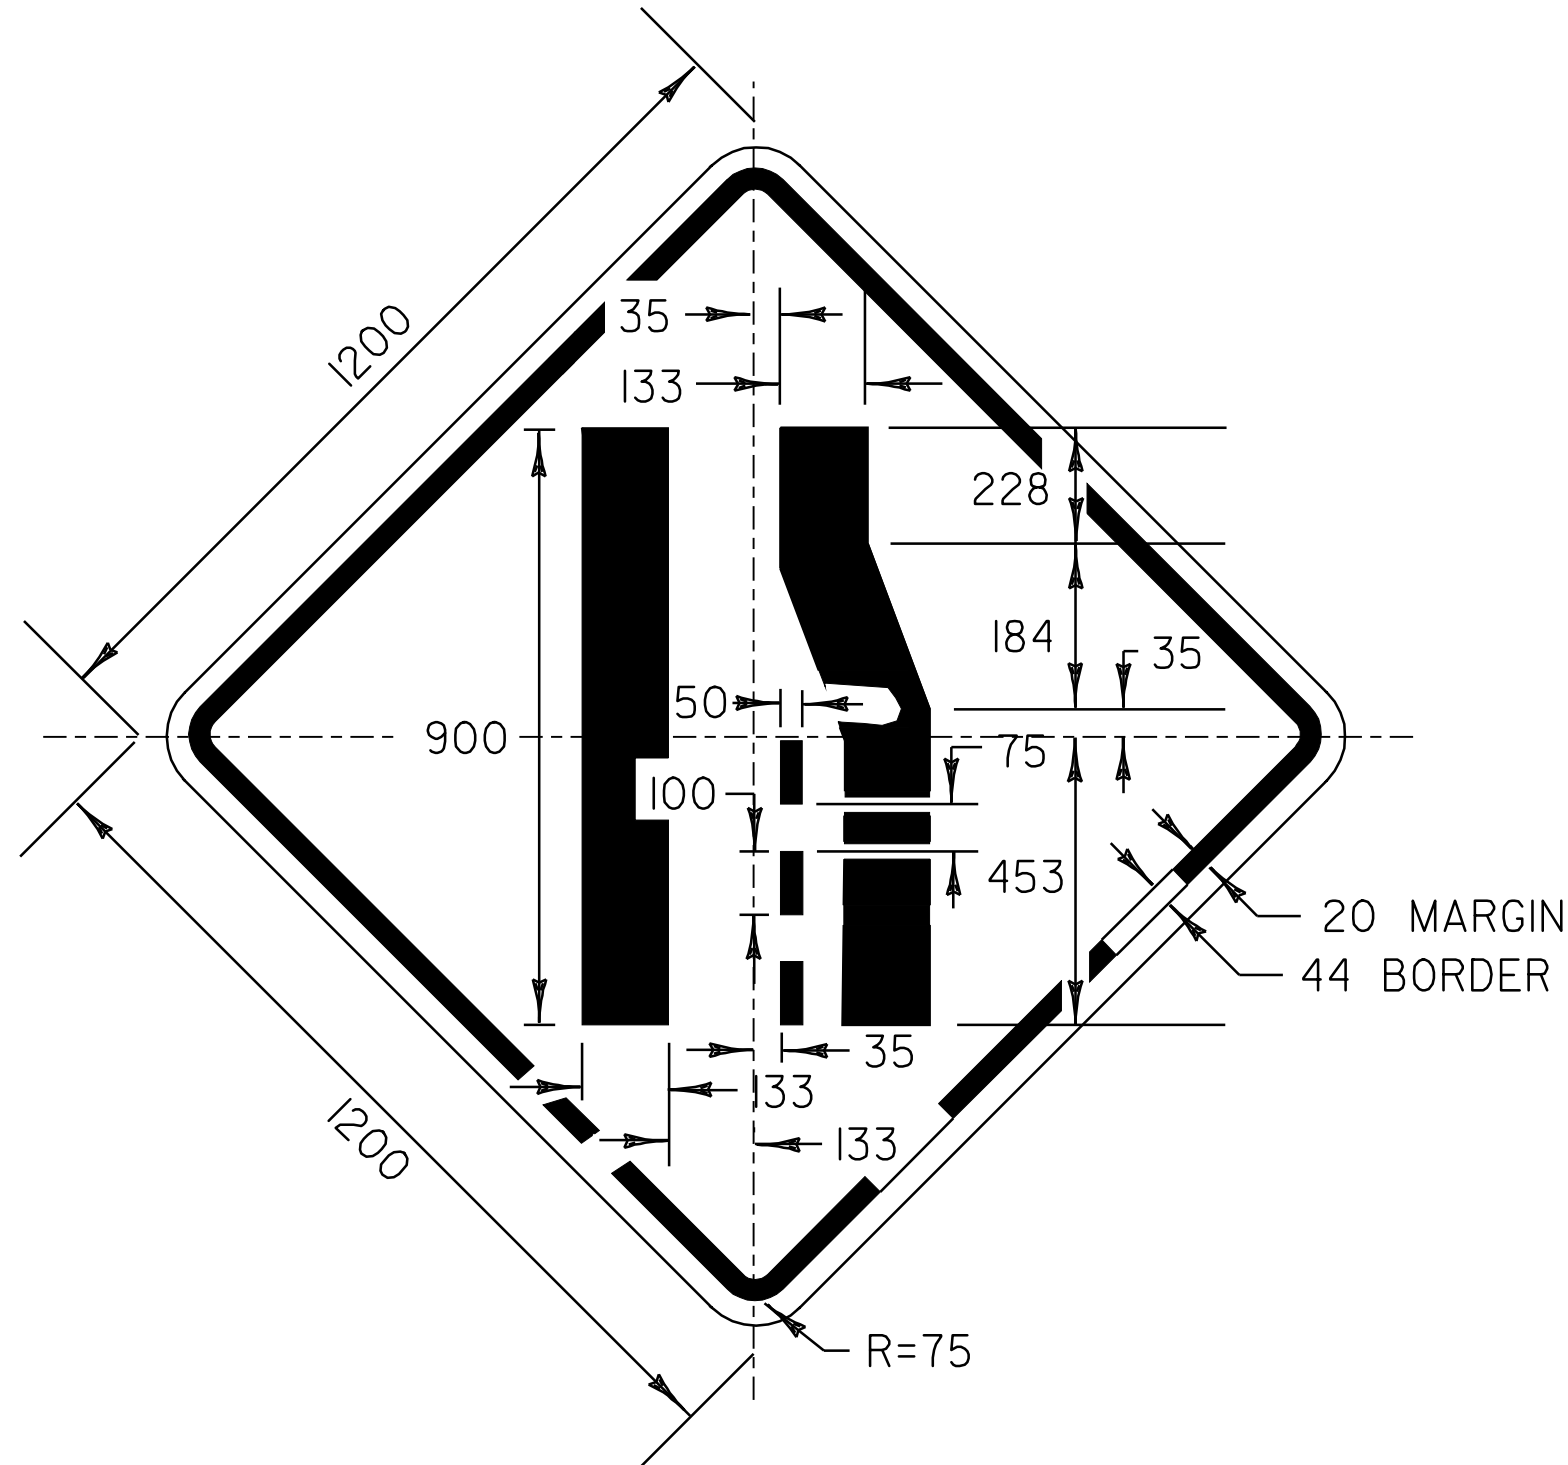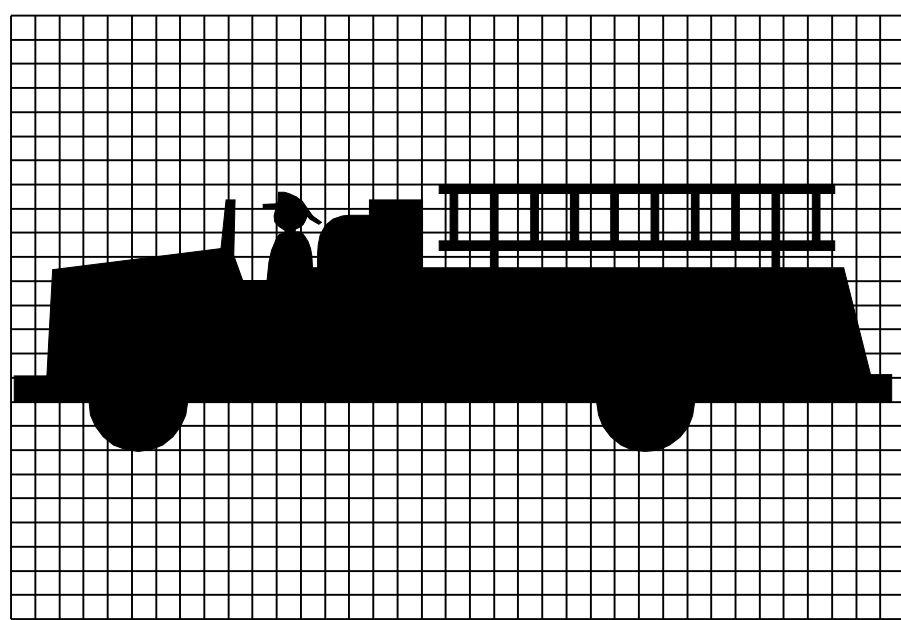


COLORS: BORDER & SYMBOL - BLACK (NON-REFL.)
BACKGROUND - YELLOW (REFL.).
REFER TO STD. E-I51M FOR MATERIALS

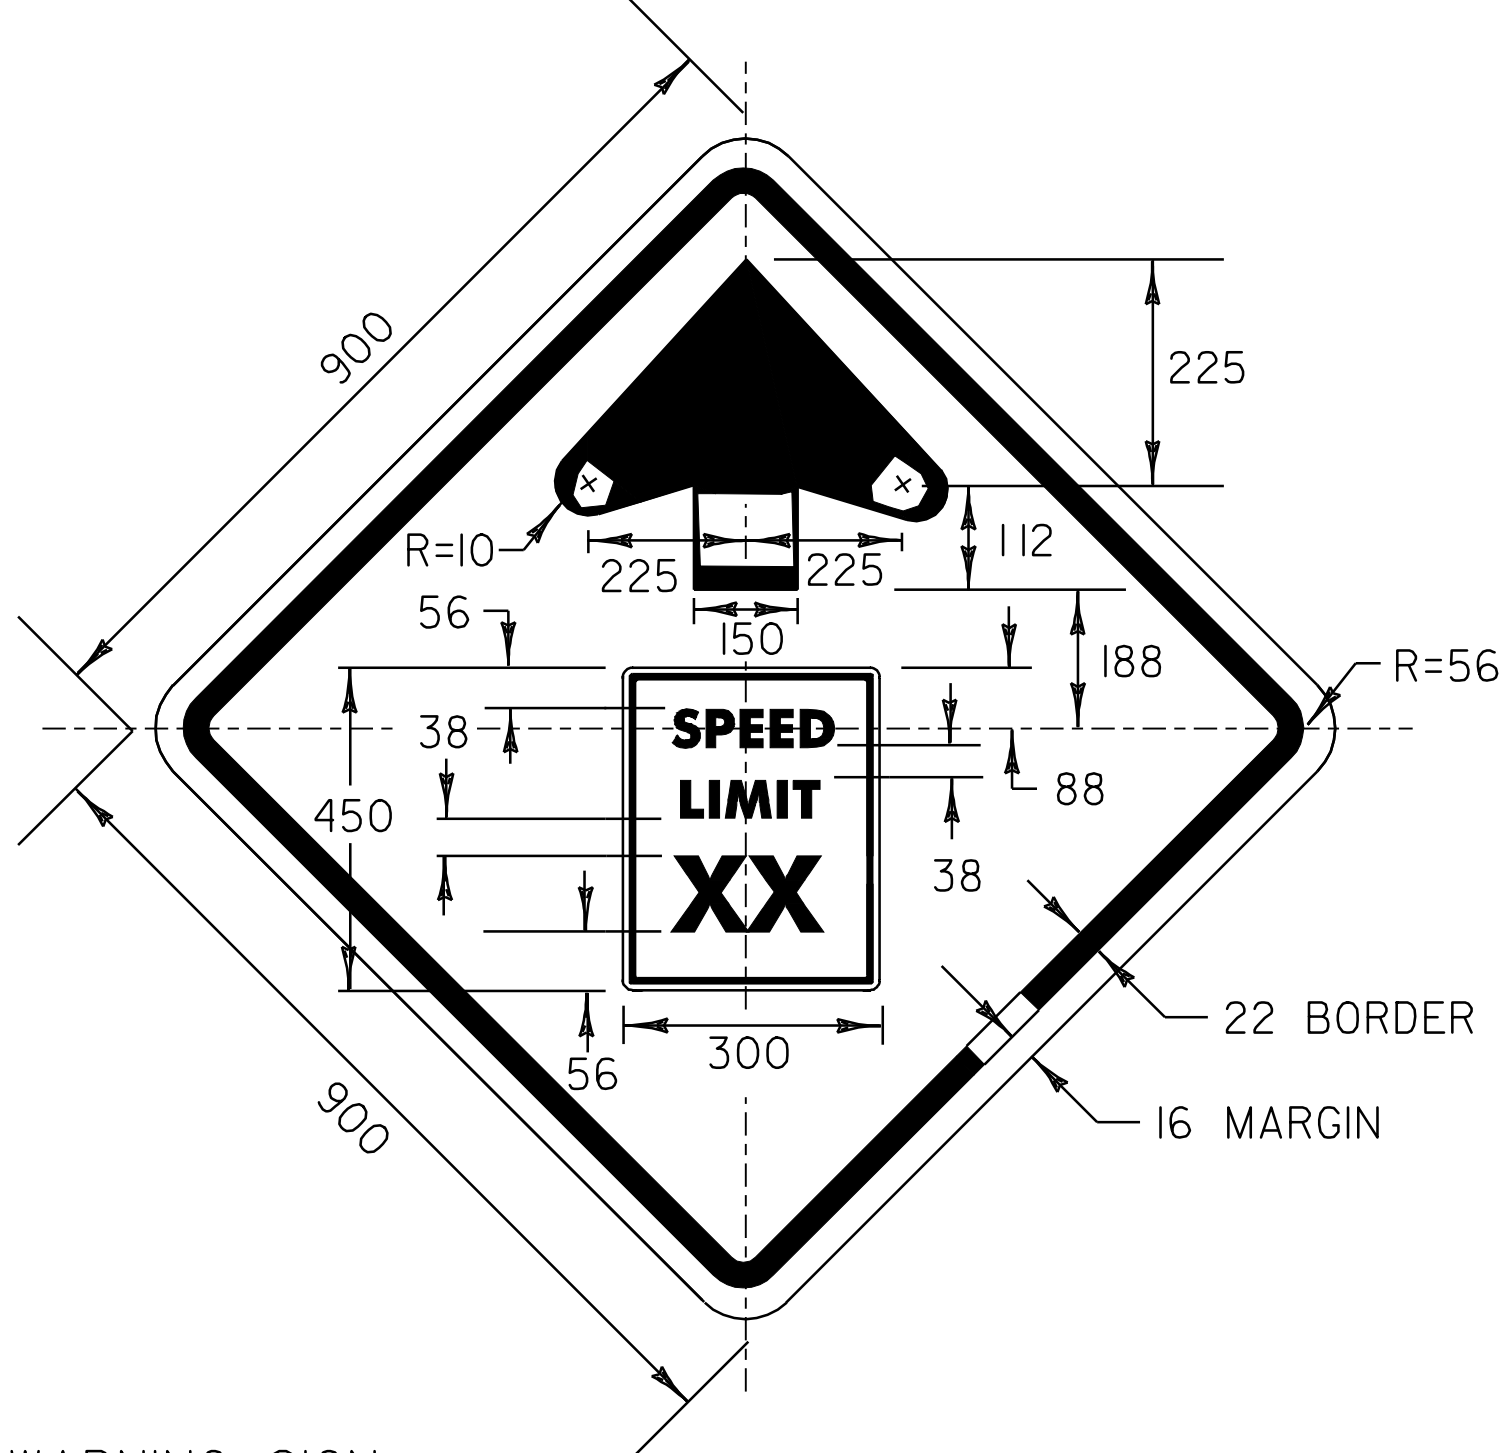


WARNING SIGN
COLORS: BORDER & SYMBOL - BLACK (NON-REFL.)
BACKGROUND - YELLOW (REFL.).
REFER TO STD. E-I51M FOR MATERIALS

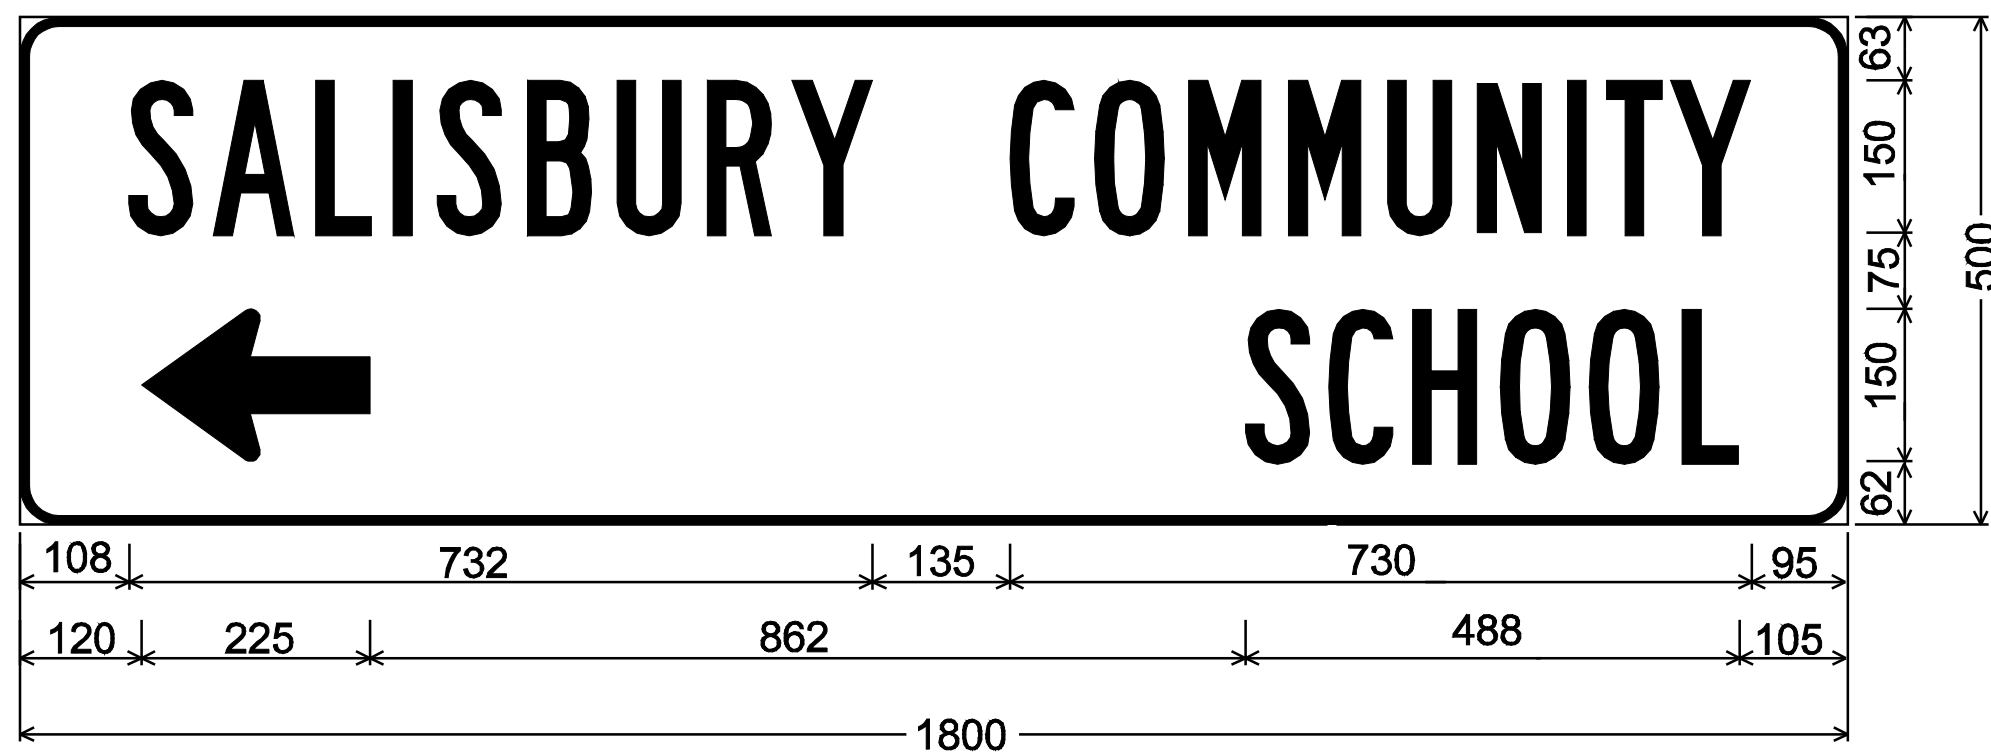


38mm Radius, 10mm Border, White on Green; Refer to Standard E 123M for material requirements and notes.
[SALISBURY COMMUNITY] B 90% spacing; Standard Arrow Custom 225mm X 150mm 180°;
[SCHOOL] B 85% spacing;

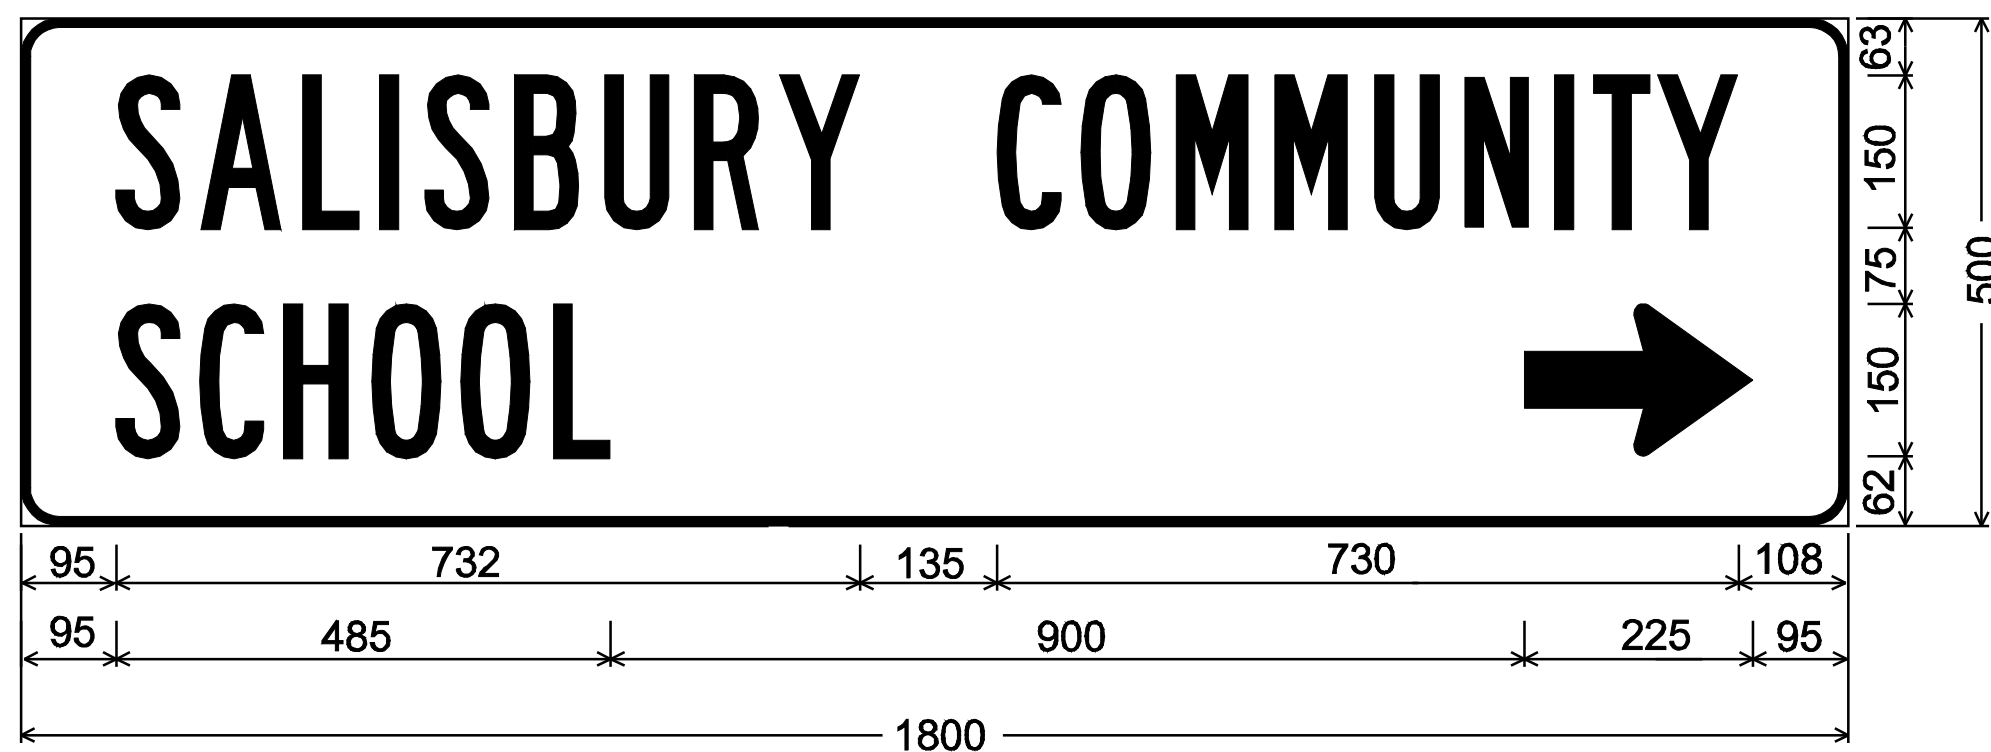

38mm Radius, 10mm Border, White on Green; Refer to Standard E 123M for material requirements and notes.
[SALISBURY COMMUNITY] B 90% spacing; [SCHOOL] B 85% spacing;
Standard Arrow Custom 225mm X 150mm 0°;

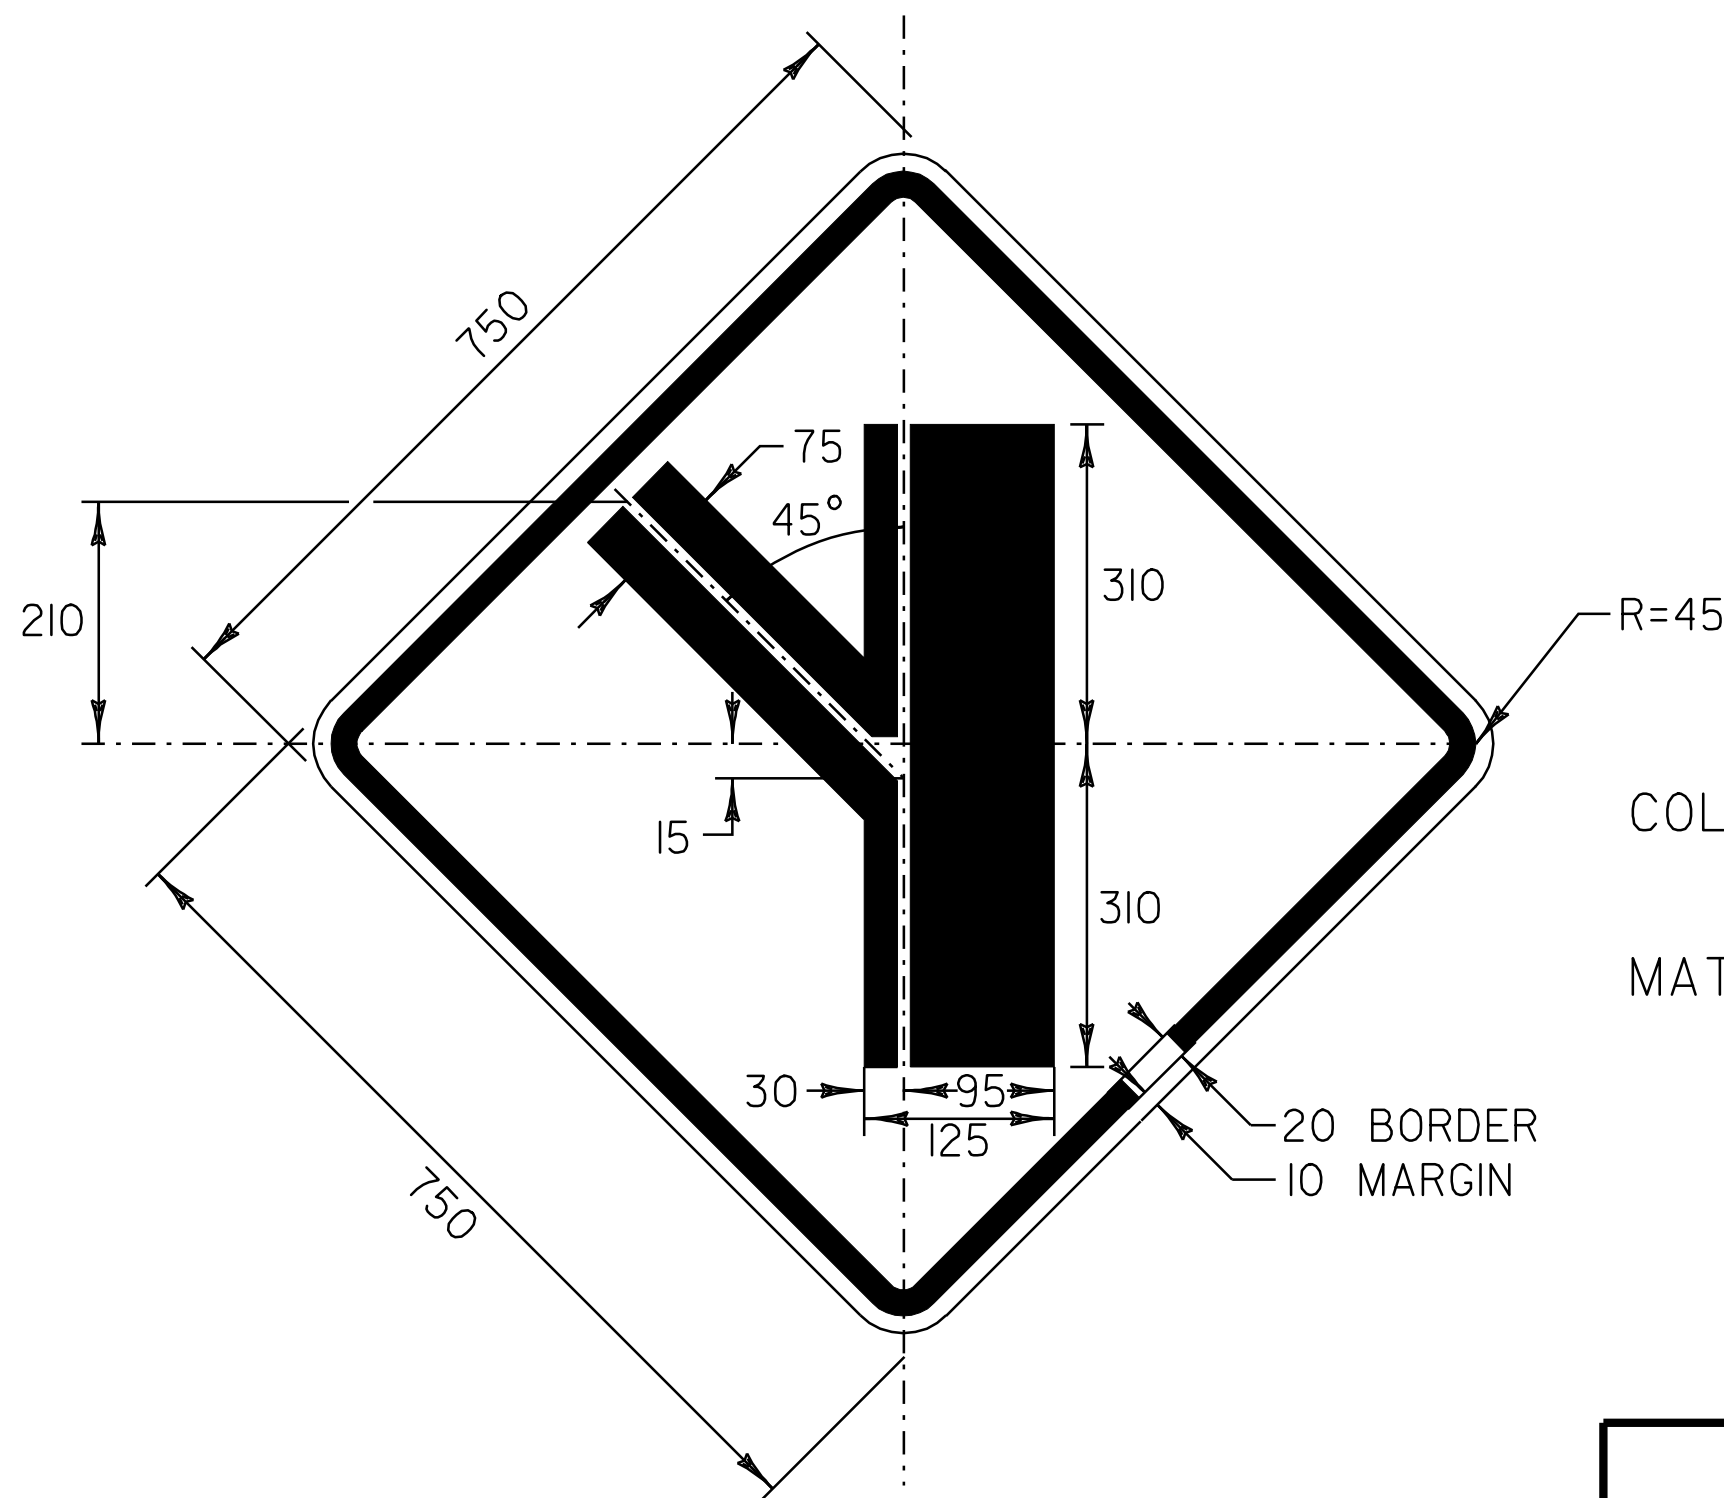


COLOR: BLACK BORDER & SYMBOL
YELLOW BACKGROUND (REFLECTORIZED)
MATERIAL: PER VAOT STANDARD E-I55M

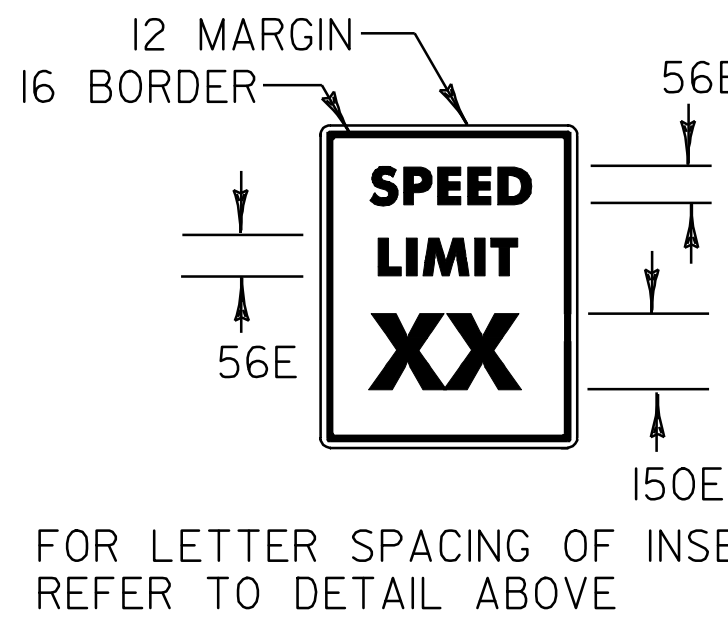

NOTE: ALL DIMENSIONS IN MILLIMETERS
UNLESS OTHERWISE NOTED.

TRAFFIC SIGN DETAIL SHEET	DESIGNED BY	WHEELER	DATE	12-02
	DRAWN BY	WHEELER	DATE	12-02
	DESIGN FILE NO.	pave/01b018/pb018.dgn		
	PRF FILE	pb018125.1	DATE PLOTTED	19-JUL-2006 13:3
	PROJ. NAME	SALISBURY - MIDDLEBURY		
	PROJ. NO.	NH 2311(1)S		
	SHEET	59	OF	67 SHEETS

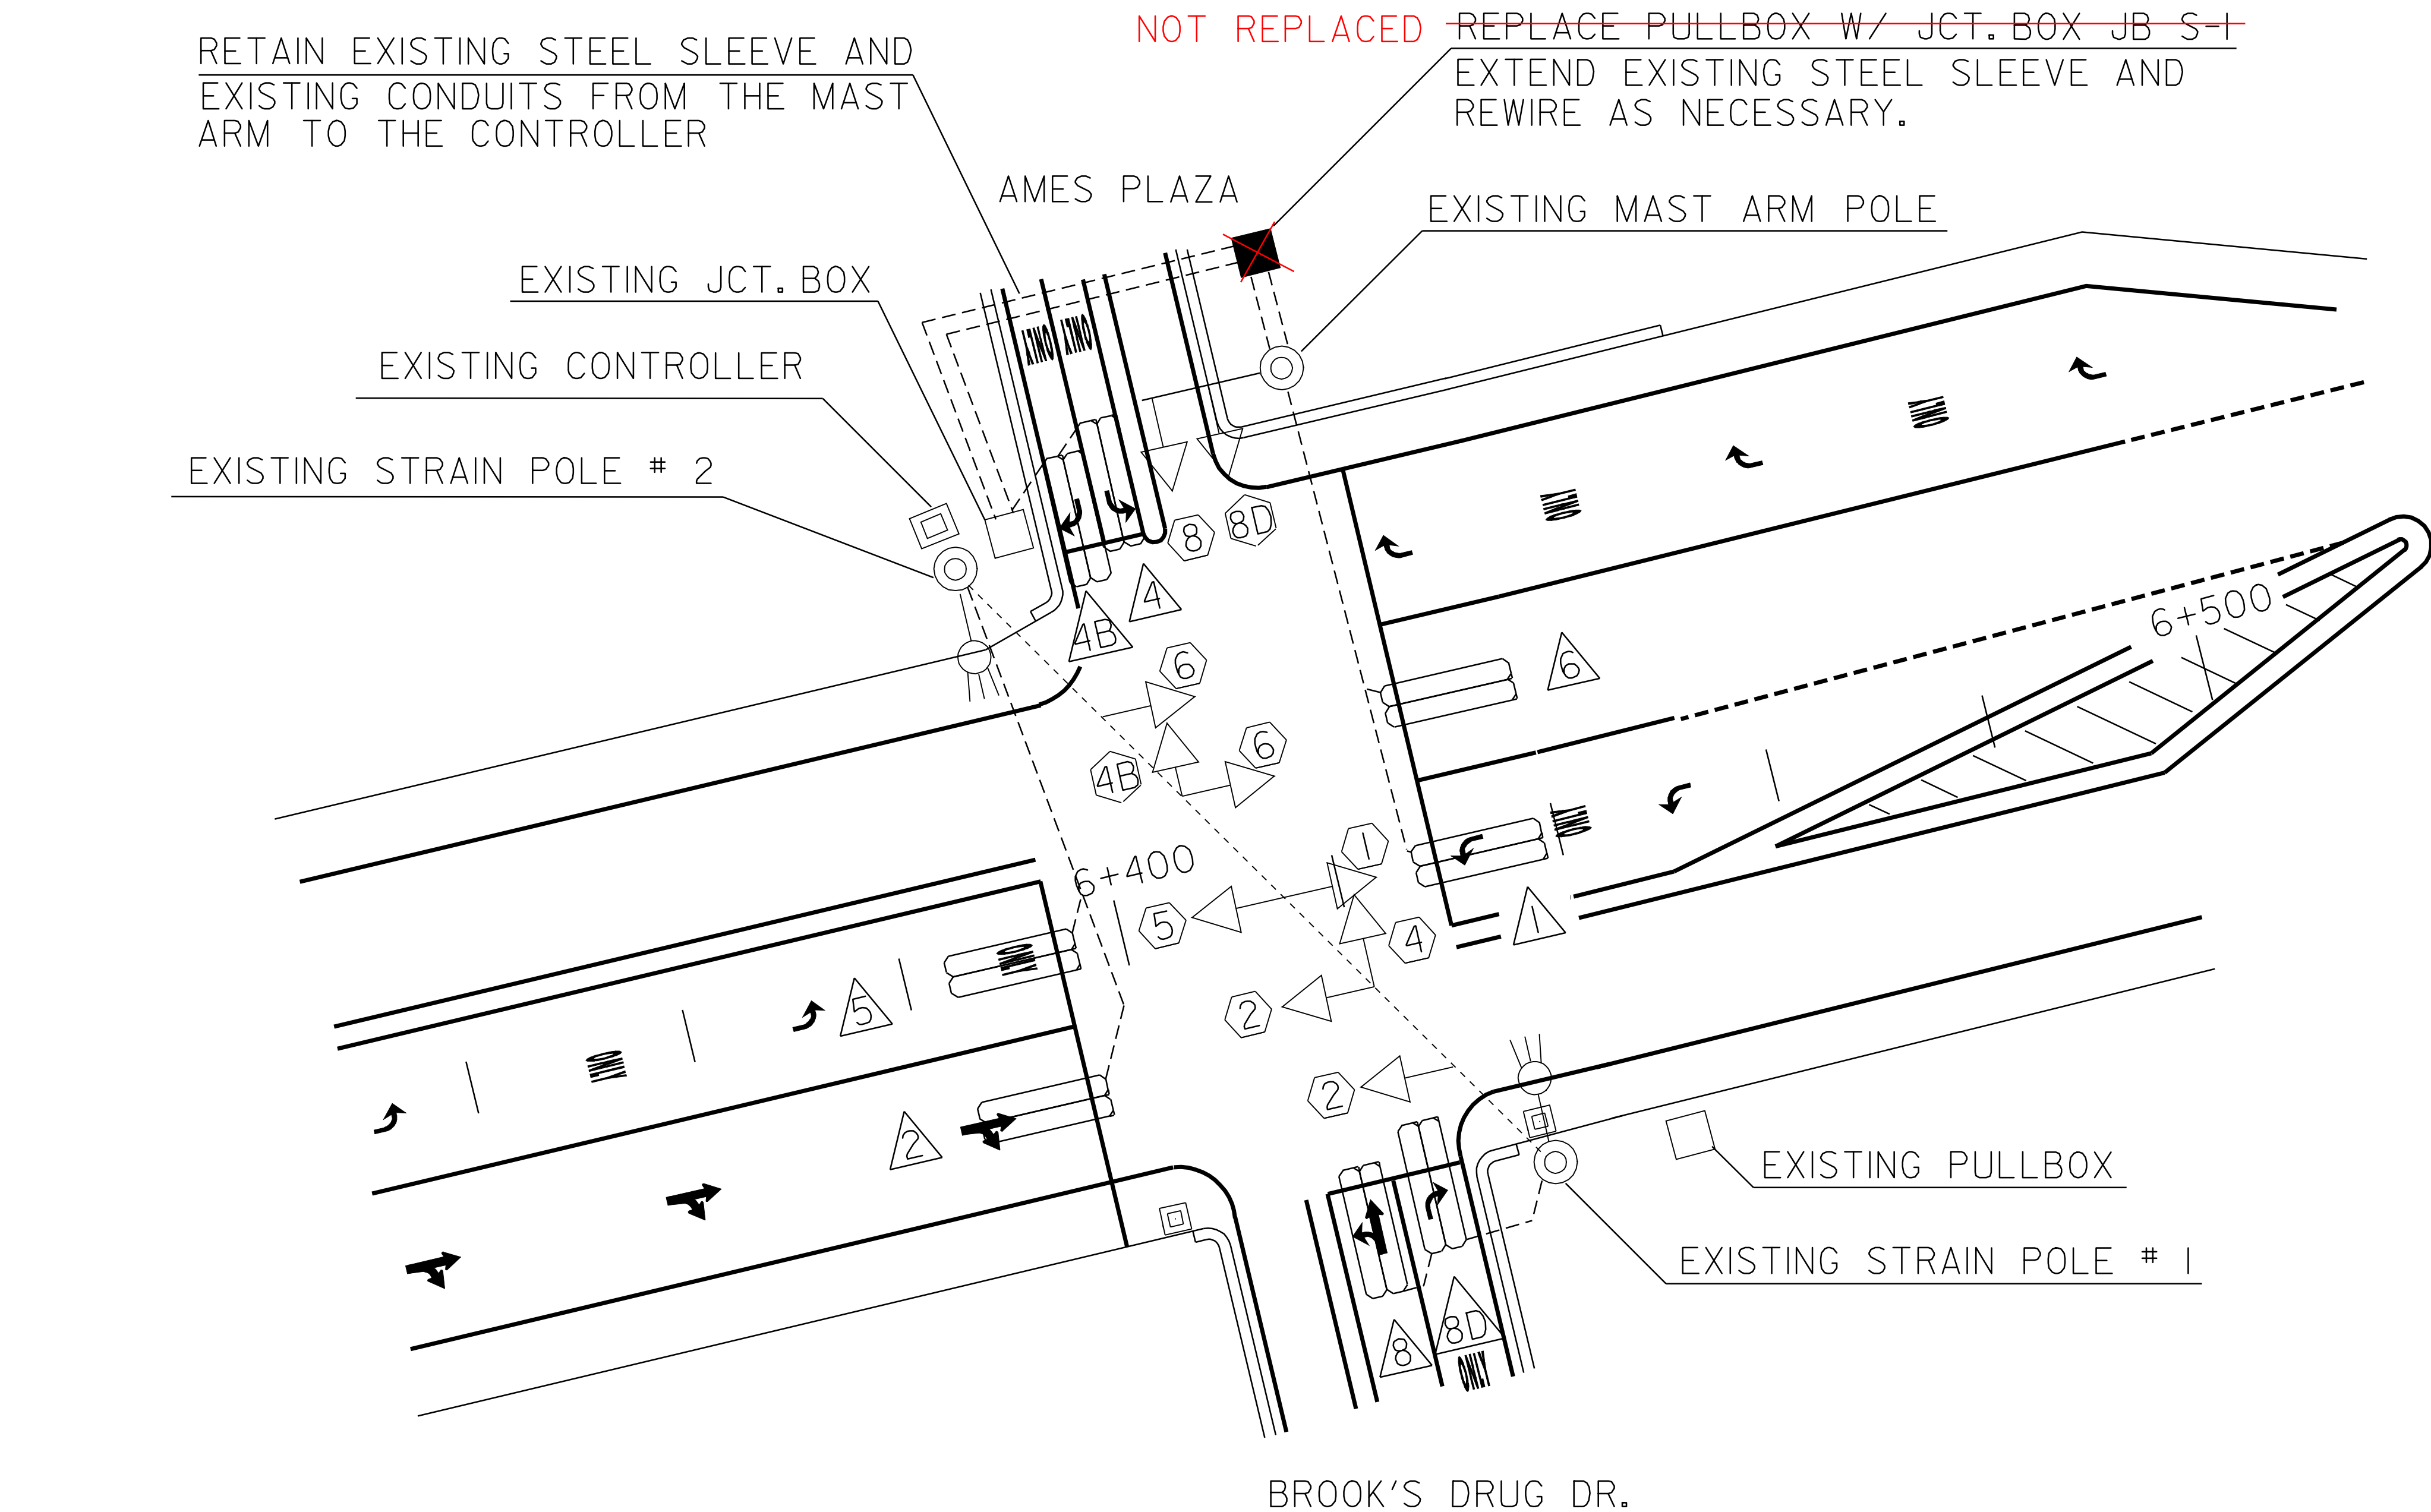

U.S. ROUTE 7 / AMES PLAZA / BROOK'S DRUG DRIVE
(SEE SHEET 33 OF 67)

NOTES:

THIS PLAN SHEET SHALL ONLY BE USED AS A GUIDE FOR LOOP AND JUNCTION BOX PLACEMENT. THE CONTRACTOR SHALL CONFIRM ALL LOCATIONS IN THE FIELD WITH THE RESIDENT ENGINEER PRIOR TO INSTALLATION.

PRIOR TO COLD PLANING, ANY EXISTING VEHICLE DETECTOR LOOPS SHALL BE DISCONNECTED IN THE CONTROLLER CABINET AND CUT AT THE CURB.

ONCE A LOOP IS DISCONNECTED, THE SIGNAL PHASE THAT IT WAS CALLING SHALL BE PUT ON MAX RECALL OR THE SIGNAL PUT ON FLASH AND TRAFFIC CONTROLLED BY A UNIFORMED TRAFFIC OFFICER.

ALL BITUMINOUS AREAS TO RECEIVE NEW VEHICLE DETECTOR LOOPS SHALL BE LEVELED WITH TYPE IVS SUPERPAVE BITUMINOUS CONCRETE PAVEMENT AS DIRECTED BY THE RESIDENT ENGINEER PRIOR TO THE INSTALLATION OF THE NEW DETECTOR LOOPS. LOOPS SHALL BE INSTALLED PRIOR TO THE PLACEMENT OF THE WEARING COURSE.

IF WATER VALVES, DROP INLETS OR OTHER OBSTRUCTIONS ARE ENCOUNTERED WITHIN THE AREA OF A PROPOSED LOOP, THE CONTRACTOR SHALL TAKE SPECIAL CARE TO AVOID THE OBSTRUCTION DURING LOOP INSTALLATION. IF LOOP SIZES OR SHAPES ARE TO BE MODIFIED DUE TO OBSTRUCTIONS THE RESIDENT ENGINEER MUST APPROVE LAYOUT PRIOR TO INSTALLATION.

AFTER THE NEW LOOPS ARE INSTALLED, THE INDUCTANCE RESISTANCE AND LEAKAGE TO GROUND SHALL BE TESTED USING PROPERLY CALIBRATED EQUIPMENT. THE TEST RESULTS SHALL BE COMPARED WITH THE CALCULATED VALUES AND RECORDED ON THE PLANS. ALL LOAD TESTING SHALL BE PERFORMED AS PER VTrans STANDARD E-I72M.

CALCULATED VALUES AT CONTROLLER ARE BASED ON DIRECT CONDUIT ROUTING TO THE NEAREST SIGNAL POLE AND CROSSING THE SPAN WIRE OR EXISTING CONDUIT AS NECESSARY TO THE EXISTING CONTROLLER LOCATION. ANY SIGNAL MODIFICATION AND OR CONTROLLER RELOCATION PRIOR TO LOOP CONNECTION WILL REQUIRE RECALCULATION OF THESE VALUES.

AFTER ACCEPTANCE OF THE LOOP INSTALLATION BY THE RESIDENT ENGINEER, RETURN THE SIGNAL TO NORMAL OPERATION. ALL WORK REQUIRED SHALL BE SUBSIDIARY TO ITEM 678.22, VEHICLE DETECTOR LOOP.

FOR ADDITIONAL DETAILS, SEE VTrans STANDARD E-I72M.

ALL DIMENSIONS IN MILLIMETERS EXCEPT WHERE OTHERWISE INDICATED.

THE REPLACEMENT/INSTALLATION OF LOOPS DETECTORS, JUNCTION BOXES AND WIRED CONDUIT IS IN ANTICIPATION OF FUTURE PROJECT NHG 019-3(52)S.

	VEHICLE DETECTOR LOOPS											
LOOP NO.	LANE	CALL Ø	SIZE (M)	TYPE & NO. TURNS	EST. QTY. (M)	DELAY OR PRESENCE	INDUCTANCE (uH)		RESISTANCE (OHMS)		LEAKAGE TO GROUND (MEGOHMS)	LOCKING MEMORY
							CALC.	ACT.	CALC.	ACT.		
1	SOUTHBOUND LEFT ONLY (U.S. ROUTE 7)		1.8 X 12.0	QUAD - 2	55.2	PRESENCE						YES
2	NORTHBOUND THRU/RIGHT TURN (U.S. ROUTE 7)		1.8 X 12.0	QUAD - 2	55.2	PRESENCE						SOFT
4	AMES PLAZA THRU/LEFT TURN		1.8 X 12.0	QUAD - 2	55.2	PRESENCE						NO
4B	AMES PLAZA RIGHT TURN ONLY		1.8 X 12.0	QUAD - 2	55.2	DELAY						NO
5	NORTHBOUND LEFT TURN ONLY (U.S. ROUTE 7)		1.8 X 12.0	QUAD - 2	55.2	PRESENCE						YES
6	SOUTHBOUND THRU (U.S. ROUTE 7)		1.8 X 12.0	QUAD - 2	55.2	PRESENCE						SOFT
8	BROOK'S DRUG DR. THRU/LEFT TURN		1.8 X 12.0	QUAD - 2	55.2	PRESENCE						NO
8D	BROOK'S DRUG DR. RIGHT TURN ONLY		1.8 X 12.0	QUAD - 2	55.2	DELAY						NO

JUNCTION BOX

LOCATION & DESCRIPTION

JB S-I 6+424 LT


ELECTRICAL CONDUIT SLEEVE (200mm)

6+424 LT 2m

EXISTING	NEW	LEGEND
		UTILITY POLE
		LUMINAIRE
		LIGHT OR WOOD POLE
		STRAIN POLE
		CONTROLLER CABINET
		PULLBOX/JUNCTION BOX
		SIGNAL HEAD
		CONDUIT
		VEHICLE LOOPS
		PEDESTAL POST
		STANCHION
		SWEEP
		LOOP NUMBER

VEHICLE DETECTOR LOOP LAYOUT DETAIL #1

PROJECT NAME:	SALISBURY - MIDDLEBURY
PROJECT NUMBER:	NH_2311(1)S
FILE NAME:	ZpqveZQibQI8ZpbQI8.dgn
PROJECT LEADER:	LEW
DESIGNED BY:	LEW
IPARM FILE NAME:	pbQI8dt1.i
PLOT DATE:	10-JUL-2006 13:33
DRAWN BY:	LEW
CHECKED BY:	
SHEET	_60_ OF _67_

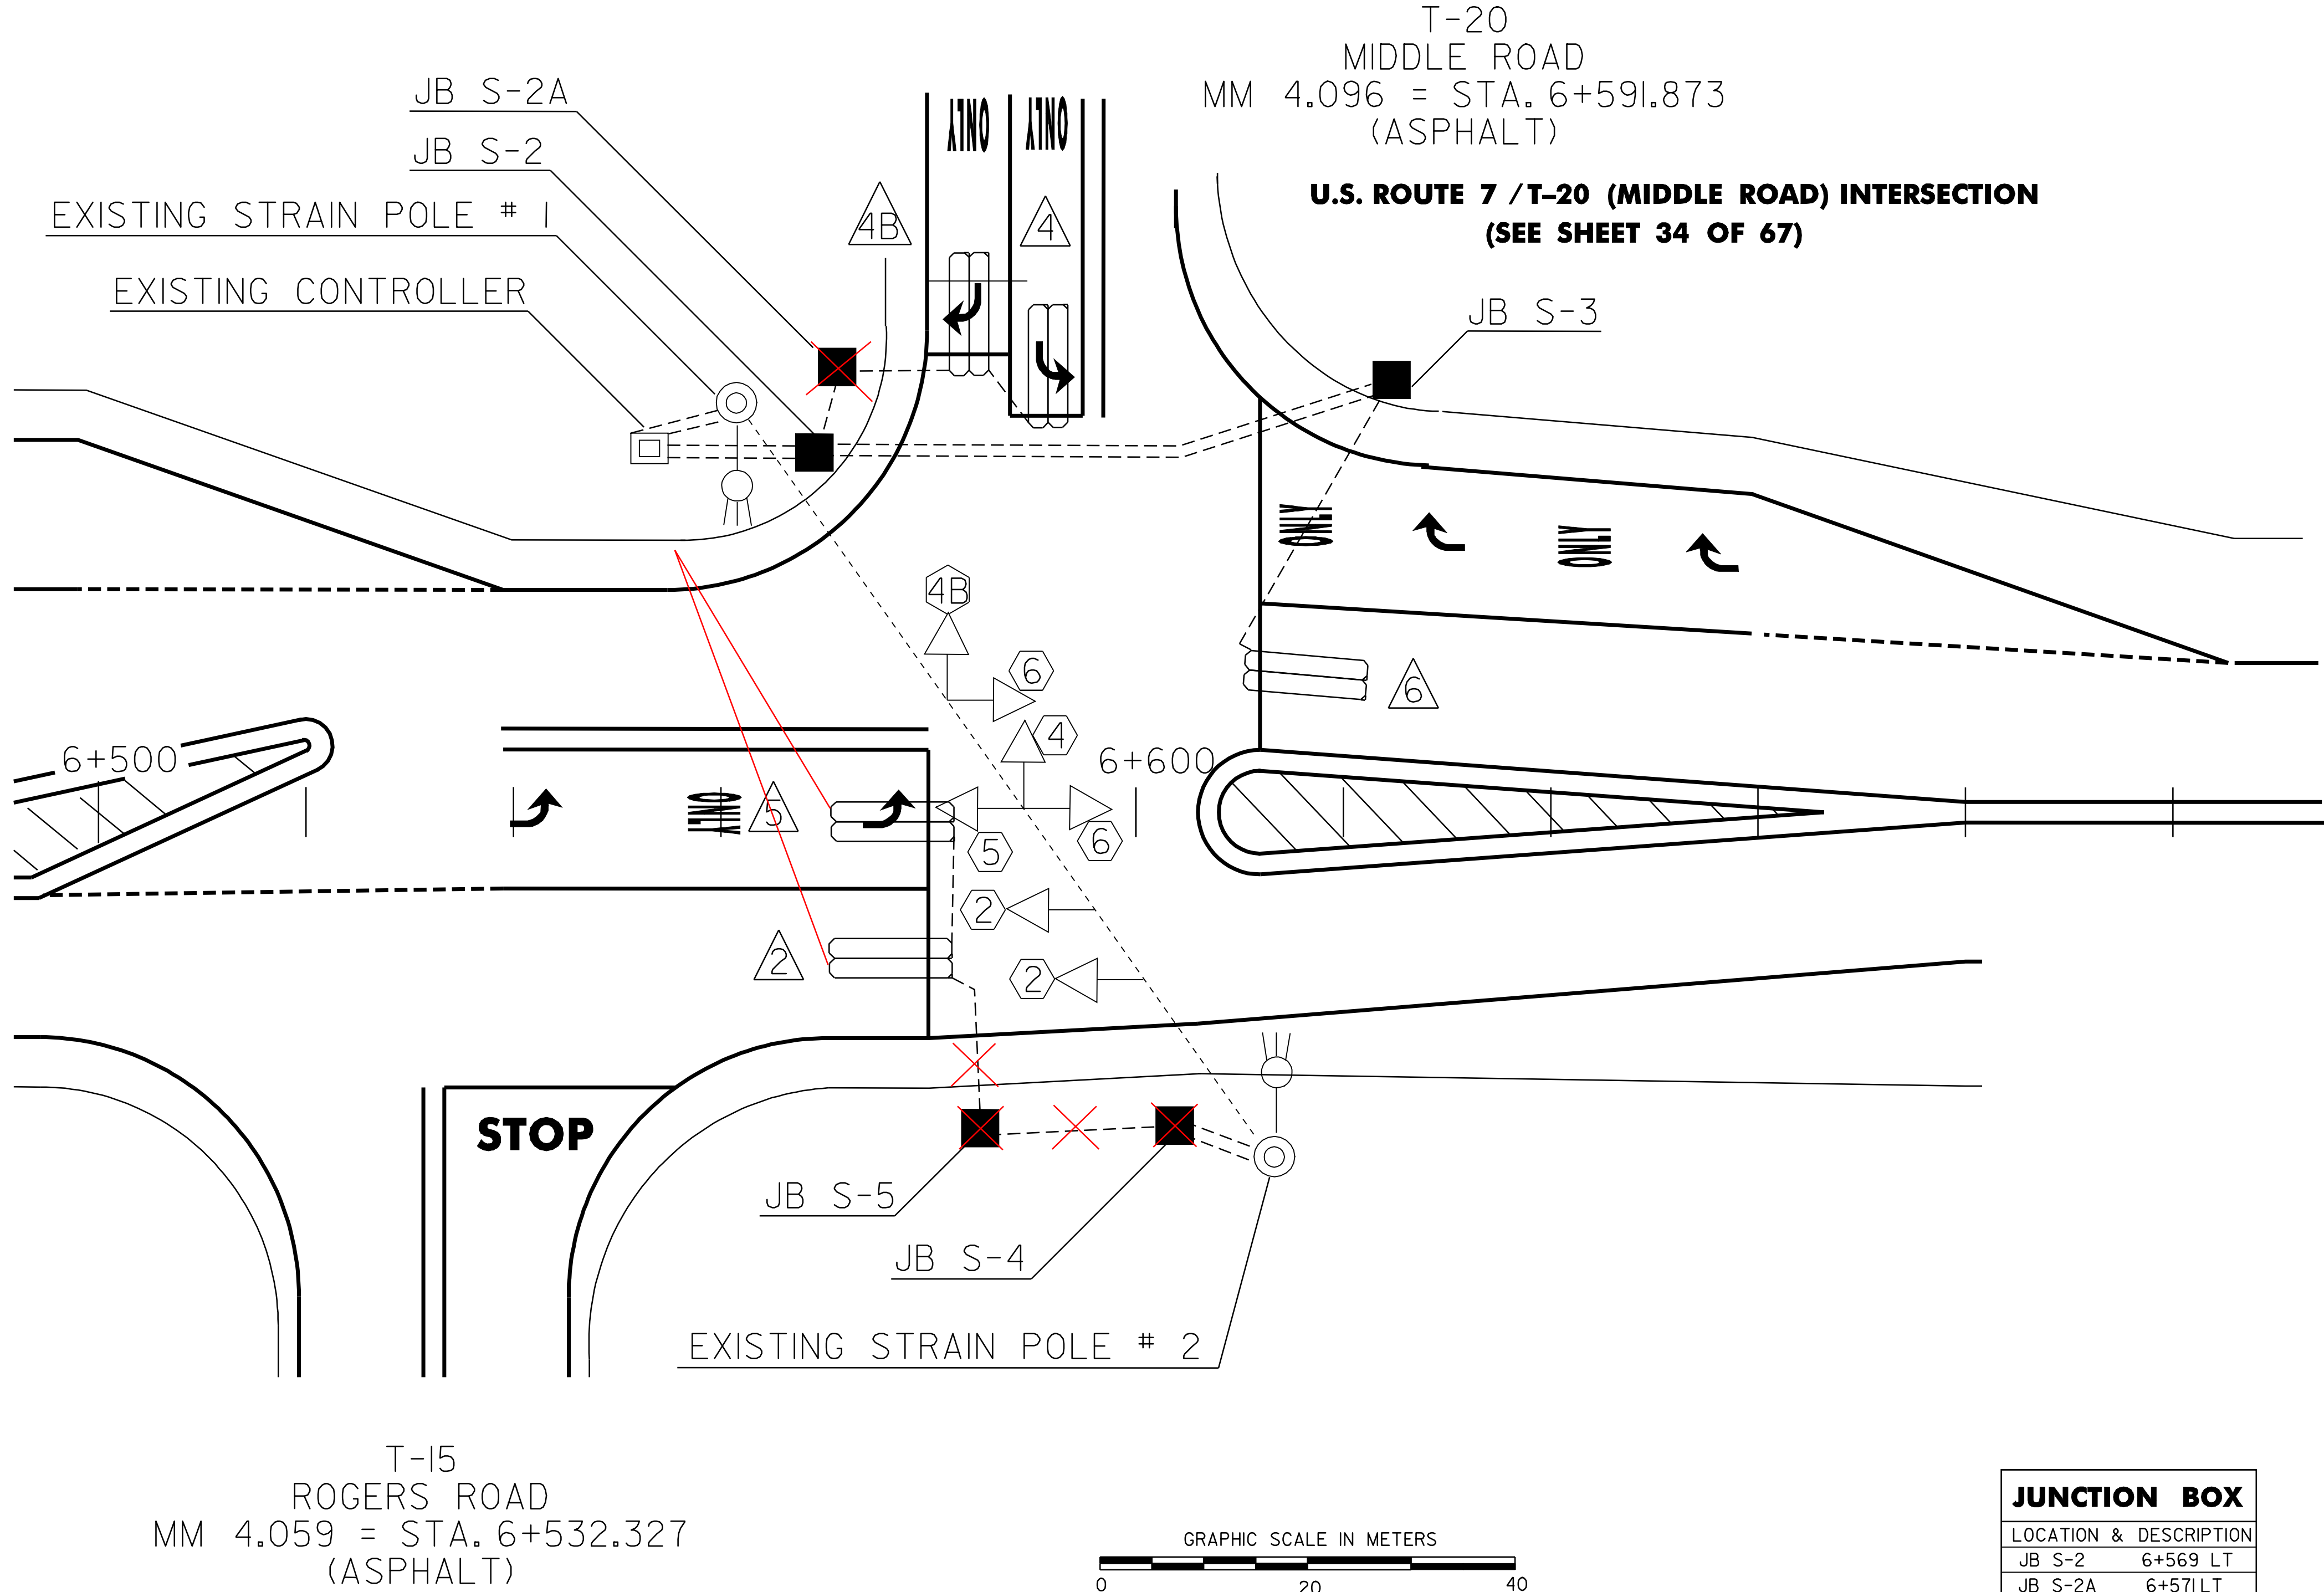

NOTES:

THIS PLAN SHEET SHALL ONLY BE USED AS A GUIDE FOR LOOP AND JUNCTION BOX PLACEMENT. THE CONTRACTOR SHALL CONFIRM ALL LOCATIONS IN THE FIELD WITH THE RESIDENT ENGINEER PRIOR TO INSTALLATION.

PRIOR TO COLD PLANING, ANY EXISTING VEHICLE DETECTOR LOOPS SHALL BE DISCONNECTED IN THE CONTROLLER CABINET AND CUT AT THE CURB. DETECTOR LOOPS # 4, # 4B AND # 5 ARE ALL EXISTING LOOPS.

ONCE A LOOP IS DISCONNECTED, THE SIGNAL PHASE THAT IT WAS CALLING SHALL BE PUT ON MAX RECALL OR THE SIGNAL PUT ON FLASH AND TRAFFIC CONTROLLED BY A UNIFORMED TRAFFIC OFFICER.

ALL BITUMINOUS AREAS TO RECEIVE NEW VEHICLE DETECTOR LOOPS SHALL BE LEVELED WITH TYPE IVS SUPERPAVE BITUMINOUS CONCRETE PAVEMENT AS DIRECTED BY THE RESIDENT ENGINEER PRIOR TO THE INSTALLATION OF THE NEW DETECTOR LOOPS. LOOPS SHALL BE INSTALLED PRIOR TO THE PLACEMENT OF THE WEARING COURSE.

IF WATER VALVES, DROP INLETS OR OTHER OBSTRUCTIONS ARE ENCOUNTERED WITHIN THE AREA OF A PROPOSED LOOP, THE CONTRACTOR SHALL TAKE SPECIAL CARE TO AVOID THE OBSTRUCTION DURING LOOP INSTALLATION. IF LOOP SIZES OR SHAPES ARE TO BE MODIFIED DUE TO OBSTRUCTIONS THE RESIDENT ENGINEER MUST APPROVE LAYOUT PRIOR TO INSTALLATION.

AFTER THE NEW LOOPS ARE INSTALLED, THE INDUCTANCE RESISTANCE AND LEAKAGE TO GROUND SHALL BE TESTED USING PROPERLY CALIBRATED EQUIPMENT. THE TEST RESULTS SHALL BE COMPARED WITH THE CALCULATED VALUES AND RECORDED ON THE PLANS. ALL LOAD TESTING SHALL BE PERFORMED AS PER VTrans STANDARD E-172M.

CALCULATED VALUES AT CONTROLLER ARE BASED ON DIRECT CONDUIT ROUTING TO THE NEAREST SIGNAL POLE AND CROSSING THE SPAN WIRE OR EXISTING CONDUIT AS NECESSARY TO THE EXISTING CONTROLLER LOCATION. ANY SIGNAL MODIFICATION AND OR CONTROLLER RELOCATION PRIOR TO LOOP CONNECTION WILL REQUIRE RECALCULATION OF THESE VALUES.

AFTER ACCEPTANCE OF THE LOOP INSTALLATION BY THE RESIDENT ENGINEER, RETURN THE SIGNAL TO NORMAL OPERATION. ALL WORK REQUIRED SHALL BE SUBSIDIARY TO ITEM 678.22, VEHICLE DETECTOR LOOP.

FOR ADDITIONAL DETAILS, SEE VTrans STANDARD E-172M.

ALL DIMENSIONS IN MILLIMETERS EXCEPT WHERE OTHERWISE INDICATED.

THE REPLACEMENT/INSTALLATION OF LOOPS DETECTORS, JUNCTION BOXES AND WIRED CONDUIT IS IN ANTICIPATION OF FUTURE PROJECT NHG 019-3(52)S.

JUNCTION BOX	
LOCATION &	DESCRIPTION
JB S-2	6+569 LT
JB S-2A	6+571 LT
JB S-5	6+585 RT
JB S-4	6+604 RT
JB S-3	6+614 LT

ELECTRICAL CONDUIT SLEEVE (200mm)		
6+571 TO	6+614 LT	42m

	VEHICLE DETECTOR LOOPS											
LOOP NO.	LANE	CALL Ø	SIZE (M)	TYPE & NO. TURNS	EST. QTY. (M)	DELAY OR PRESENCE	INDUCTANCE (uH)		RESISTANCE (OHMS)		LEAKAGE TO GROUND (MEGOHMS)	LOCKING MEMORY
							CALC.	ACT.	CALC.	ACT.		
2	NORTHBOUND THRU (U.S. ROUTE 7)		1.8 X 12.0	QUAD - 2	55.2	PRESENCE	338		1.45			SOFT
5	NORTHBOUND LEFT ONLY (U.S. ROUTE 7)		1.8 X 12.0	QUAD - 2	55.2	PRESENCE	341		1.49			YES
4B	MIDDLE ROAD RIGHT TURN ONLY		1.8 X 12.0	QUAD - 2	55.2	DELAYED	272		0.59			NO
4	MIDDLE ROAD LEFT TURN ONLY		1.8 X 12.0	QUAD - 2	55.2	PRESENCE	338		0.63			NO
6	SOUTHBOUND THRU/RIGHT TURN (U.S. ROUTE 7)		1.8 X 12.0	QUAD - 2	55.2	PRESENCE	291		0.84			SOFT

WIRED CONDUIT (PVC)				
	# WIRES	DIA. (mm)	LENGTH (EACH) (m)	REMARKS
JB S-5 - JB S-4	1	50	18	LOOPS
JB S-4 - STRAIN POLE # 2	2	50	8	LOOPS & SIGNALS
JB S-3 - JB S-2	2	50	42	LOOPS & SIGNALS
JB S-2 - CONTROLLER	2	50	14	LOOPS & SIGNALS
JB S-2A - JB S-2	1	50	8	LOOPS
CURB - JB S-3	1	50	10	LOOPS
STR. POLE # 1 - CONTROLLER	2	50	6	LOOPS

EXISTING	NEW	LEGEND
		UTILITY POLE
		LUMINAIRE
		LIGHT OR WOOD POLE
		STRAIN POLE
		CONTROLLER CABINET
		PULLBOX/JUNCTION BOX
		SIGNAL HEAD
		CONDUIT
		VEHICLE LOOPS
		PEDESTAL POST
		STANCHION
		SWEEP
		LOOP NUMBER

VEHICLE DETECTOR LOOP LAYOUT DETAIL #2	PROJECT NAME: SALISBURY - MIDDLEBURY
	PROJECT NUMBER: NH_2311(1)S
	FILE NAME: ZpqveZQibQI8ZpbQI8.dgn
	PLOT DATE: 10-JUL-2006 13:30
	PROJECT LEADER: LEW
	DRAWN BY: LEW
	DESIGNED BY: LEW
	CHECKED BY:
	IPARM FILE NAME: pbQI8dt2.1
	SHEET 61 OF 67

[illegible]

* REFER TO SPECIAL PROVISIONS
FOR BASIS OF PAYMENT


Diagram illustrating the cross-section of a bridge deck joint, showing the asphaltic plug type joint, bitum. conc. pavement, binder, steel plate (galvanized), heat resistant backer rod, 40mm closed cell foam, and approach slab/bridge deck.

LOCATION

MIDDLEBURY

BRIDGE #125 (9.2m) - STA I+022.696
BRIDGE #125 (9.2m) - STA I+037.436
BRIDGE #125 (9.2m) - STA I+064.368
BRIDGE #125 (9.2m) - STA I+079.108


DESIGNED BY WHEELER DATE 12-02
DRAWN BY WHEELER DATE 12-02
DESIGN FILE NO. pave/01b018/pb018.dgn
PRF pb018pr1.i DATE PLOTTED 18-JUL-2006 13
PROJ. NAME **SALISBURY - MIDDLEBURY**
PROJ. NO. **NH 2311(1)S**
SHEET **62** OF **67** SHEETS

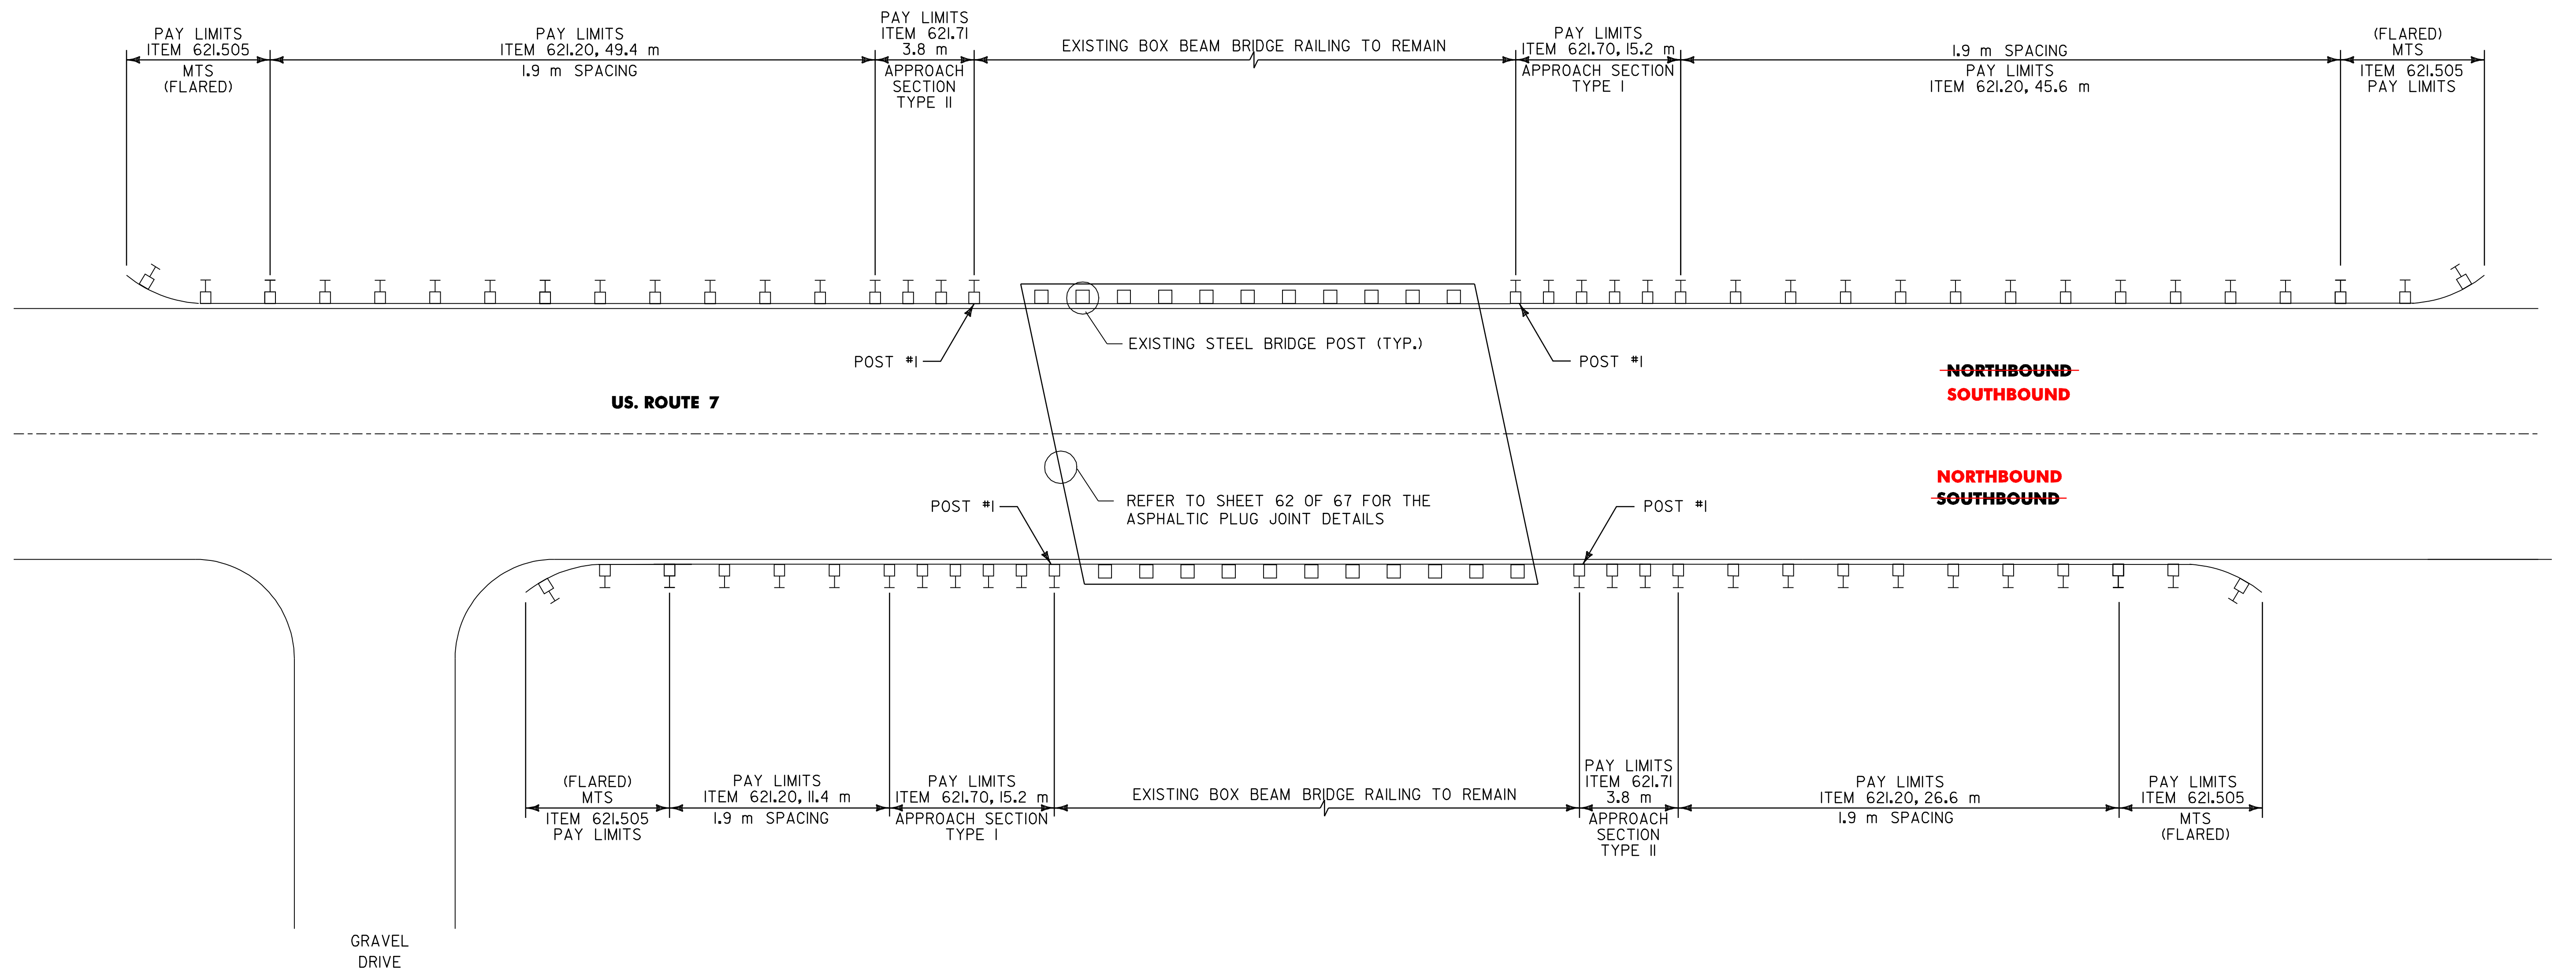

BR 125 MIDDLEBURY MM 0.653 = STA. 1+050.902
NOT TO SCALE

BRIDGE DETAIL SHEET 2	SURVEYED BY	N/A	DATE	N/A
	DRAWN BY	C.A.K.	DATE	2/02
	SQUAD LEADER	D.E.G.		
	DESIGN FILE NO.	pave/01b018/pb018.dgn		
	IPARM FILE	pb018br2.1	DATE	10-JUL-2006 13:3
			PLOTTED	
	PROJ. NAME	SALISBURY - MIDDLEBURY		
	PROJ. NO.	NH_231111S		
	SHEET	63	OF	67
	SHEETS			

DATUM	
VERTICAL	N/A
HORIZONTAL	N/A

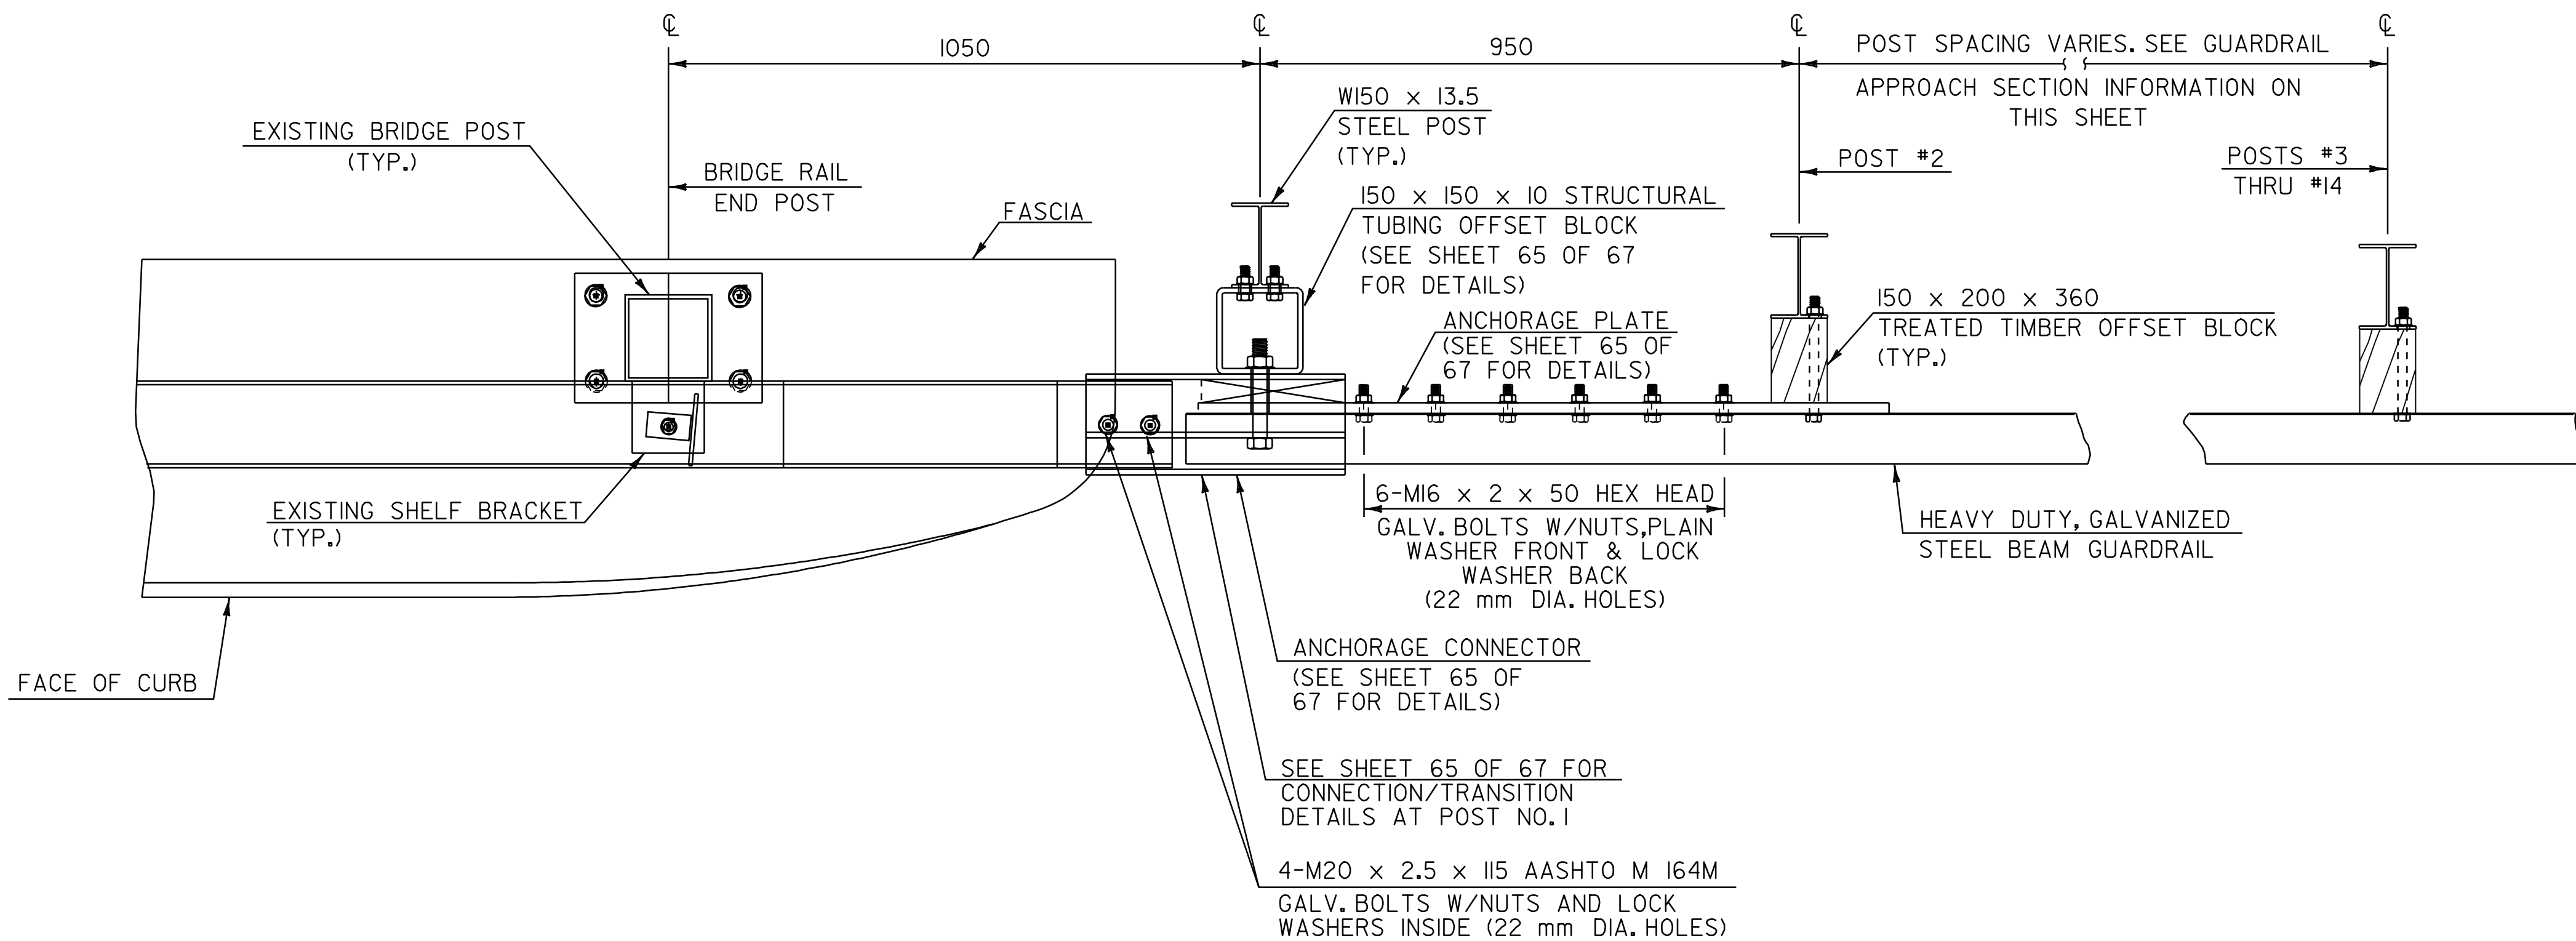


PLAN

GUARDRAIL
APPROACH SECTION
TYPE I

POST NO.	SPACING
1	950
2	950
3	950
4	950
5	950
6	950
7	950
8	950
9	1.27 m
10	1.27 m
11	1.27 m
12	1.9 m
13	1.9 m
14	

15.2 m PAY LENGTH GUARDRAIL APPROACH SECTION, TYPE I

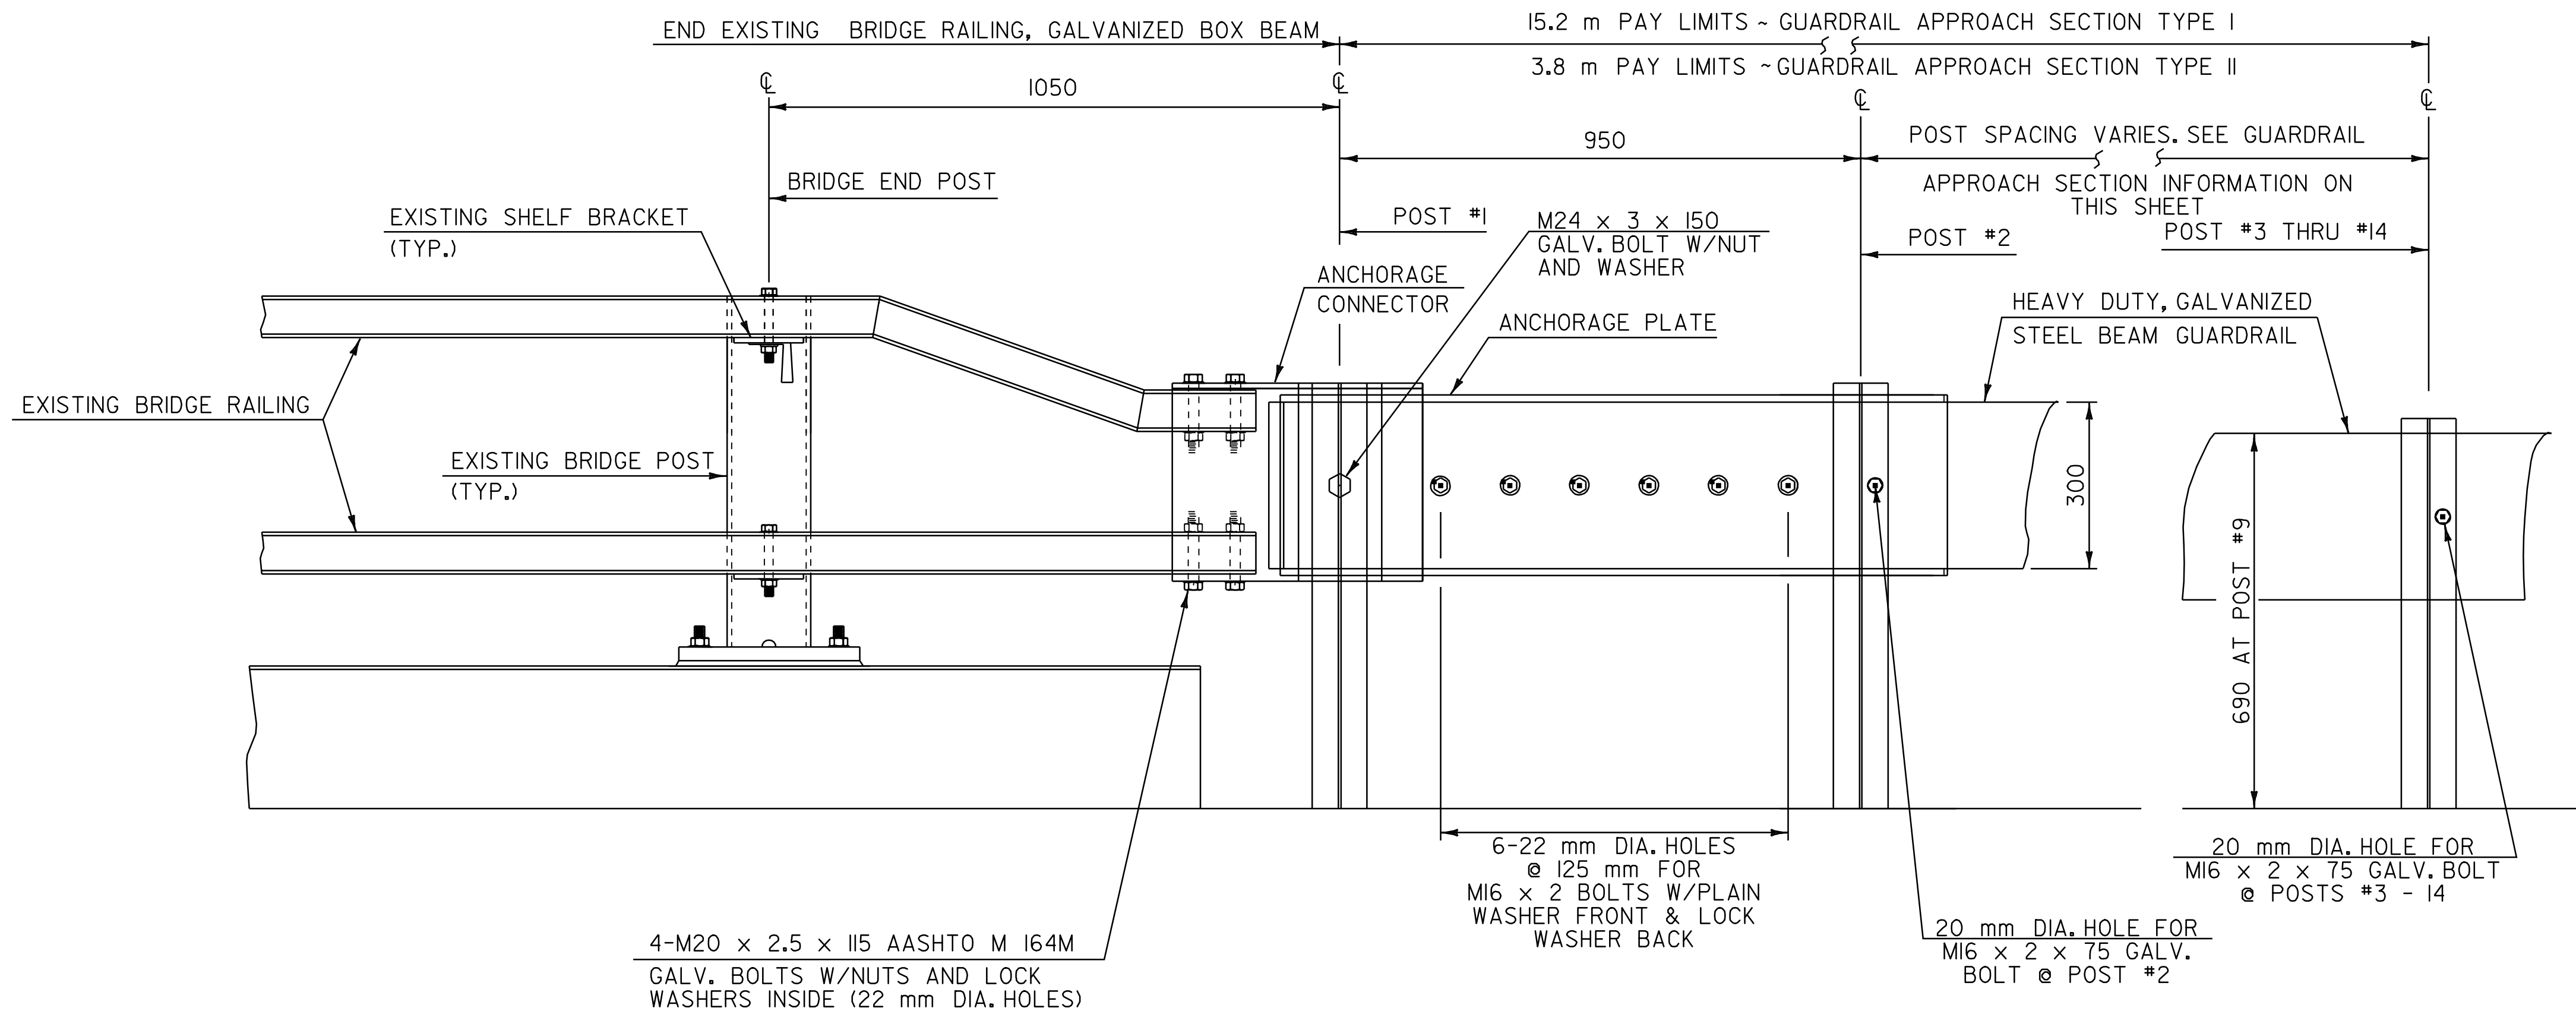

ELEVATION
BRIDGE APPROACH DETAIL
NOT TO SCALE

GUARDRAIL
APPROACH SECTION
TYPE II

POST NO.	SPACING
1	950
2	1.43 m
3	1.43 m
4	

3.8 m PAY LENGTH GUARDRAIL APPROACH SECTION TYPE II

NOTE:
ALL DIMENSIONS IN MILLIMETERS EXCEPT WHERE OTHERWISE NOTED.


BRIDGE
APPROACH
SECTION
DETAIL
SHEET 1

SURVEYED BY N/A DATE N/A
DRAWN BY C.A.K. DATE 2/02
SQUAD LEADER D.E.G.
DESIGN FILE NO. pgve/Q1b018/pb018.dgn
IPARM pb018brc3.1 DATE 10-JUL-2006 13:53
FILE pb018brc3.1 PLOTTED
PROJ. NAME SALISBURY - MIDDLEBURY
PROJ. NO. NH_23111115
SHEET 64 OF 67 SHEETS


DATUM
VERTICAL N/A
HORIZONTAL N/A

NOTES


1. REFER TO STANDARD G-IM FOR ADDITIONAL RAIL DETAILS.
2. ALL POSTS FOR HEAVY DUTY STEEL BEAM GUARDRAIL SHALL BE STEEL IN ACCORDANCE WITH SECTION 728 "GUARDRAIL, GUIDE POSTS AND BARRIERS" UNLESS OTHERWISE SPECIFIED IN THE CONTRACT.
3. APPROACH RAIL SPLICES SHALL LAP IN DIRECTION OF TRAFFIC FLOW.
4. ANCHORAGE CONNECTOR AND ANCHORAGE PLATE SHALL BE AASHTO M 270/M 270M, GRADE 250 GALVANIZED TO AASHTO M III/M IIIM AFTER FABRICATION.
5. ALL BOLTS, NUTS AND WASHERS SHALL BE AASHTO M 164/M 164M GALVANIZED TO AASHTO M 232/M 232M AFTER FABRICATION.
6. STRUCTURAL TUBING OFFSET BLOCK SHALL BE AASHTO M 183/M 183M GALVANIZED TO AASHTO M III/M IIIM AFTER FABRICATION.
7. APPROACH RAILING SHALL BE HEAVY DUTY STEEL BEAM FOR EITHER TYPE OF GUARDRAIL APPROACH SECTION.
8. ALLOWABLE DIMENSIONAL TOLERANCE FOR BENT SECTIONS IS ± 1.6 mm.
9. THE UNIT PRICES BID FOR EITHER TYPE OF GUARDRAIL APPROACH SECTION SHALL INCLUDE ANCHORAGE CONNECTOR, ANCHORAGE PLATE, HEAVY DUTY STEEL BEAM GUARDRAIL, POSTS, OFFSET BLOCKS, BLOCKING, BOLTS, AND ALL NECESSARY HARDWARE.

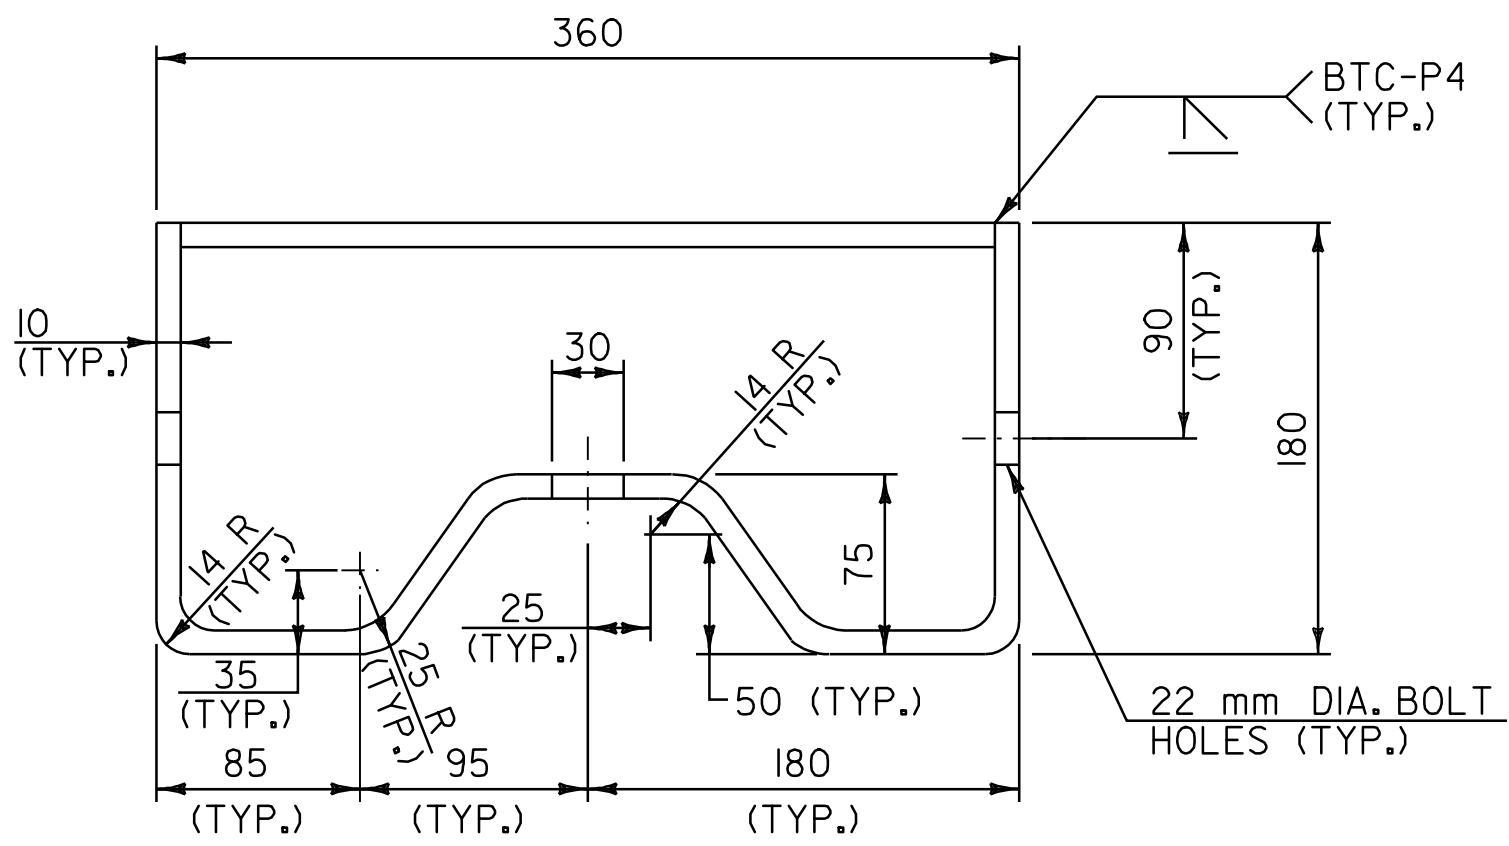


ANCHORAGE CONNECTOR DETAIL
(SEE NOTE 7)
NOT TO SCALE

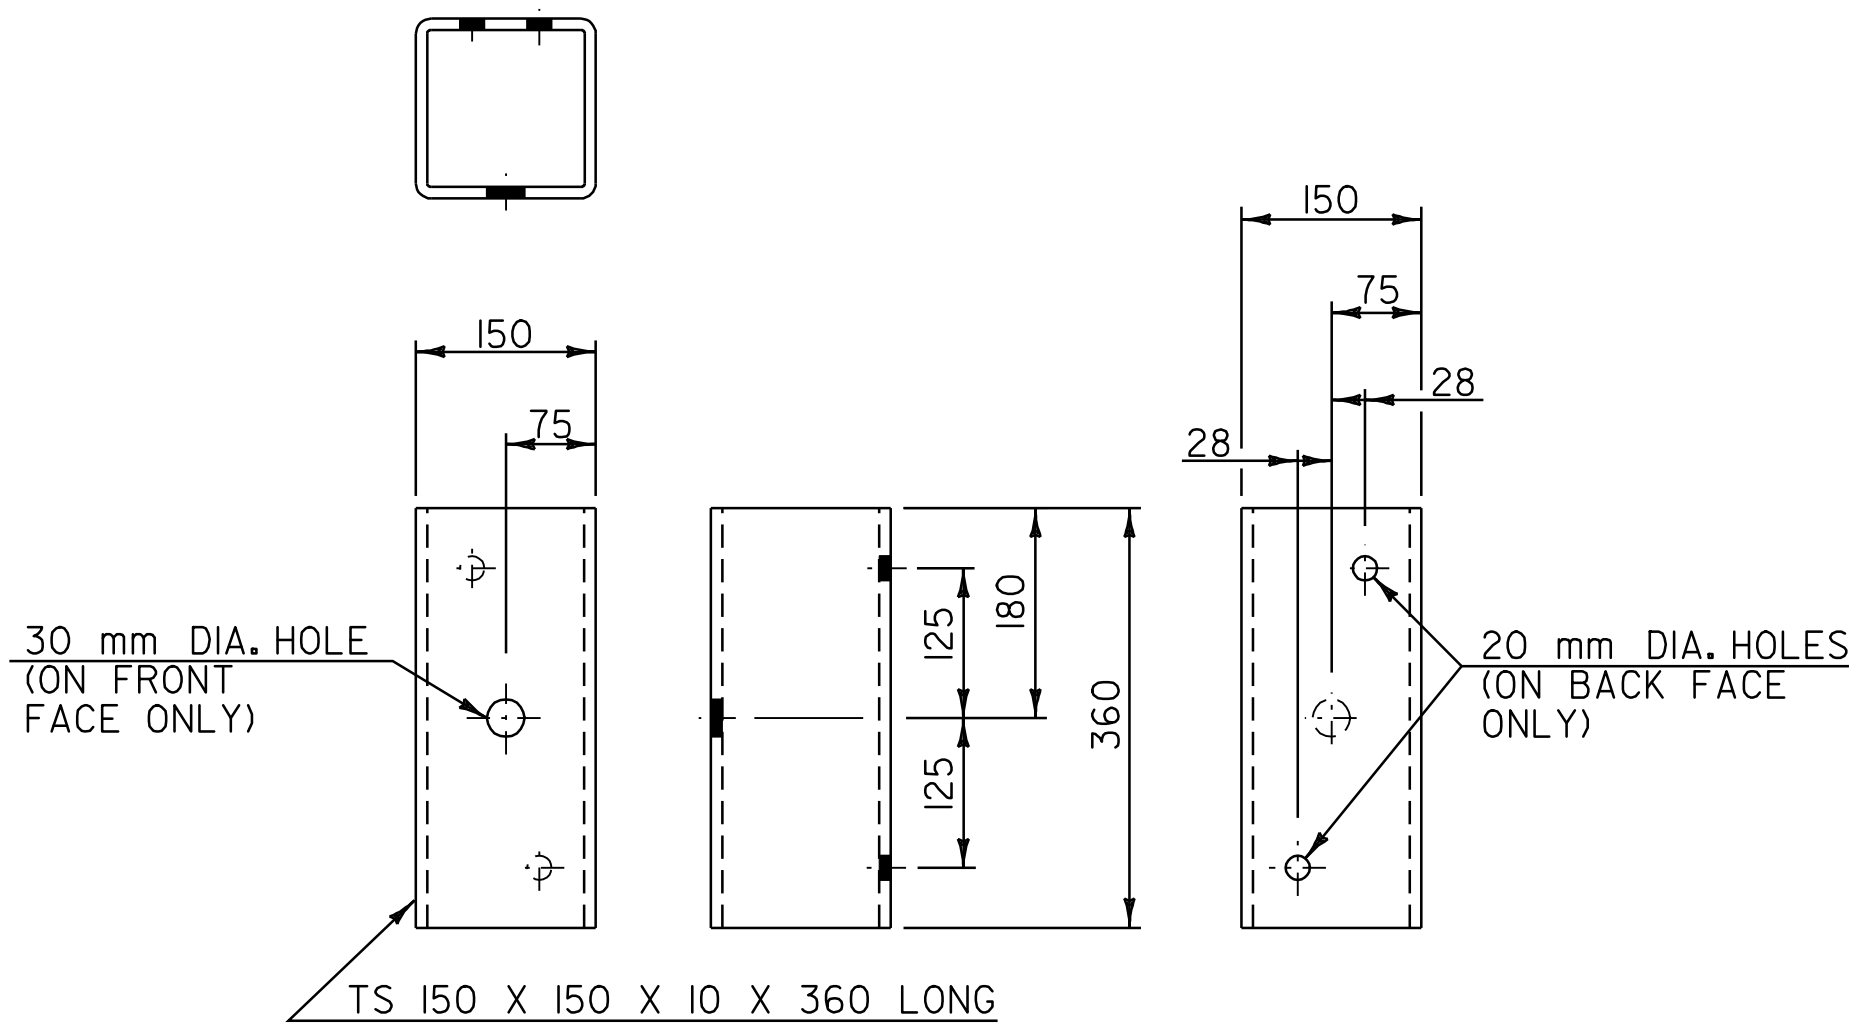

STRUCTURAL TUBING OFFSET BLOCK DETAILS
(OCCURS AT POST NO. 1 WHEN USING APPROACH RAIL UTILIZING STEEL POSTS)
NOT TO SCALE

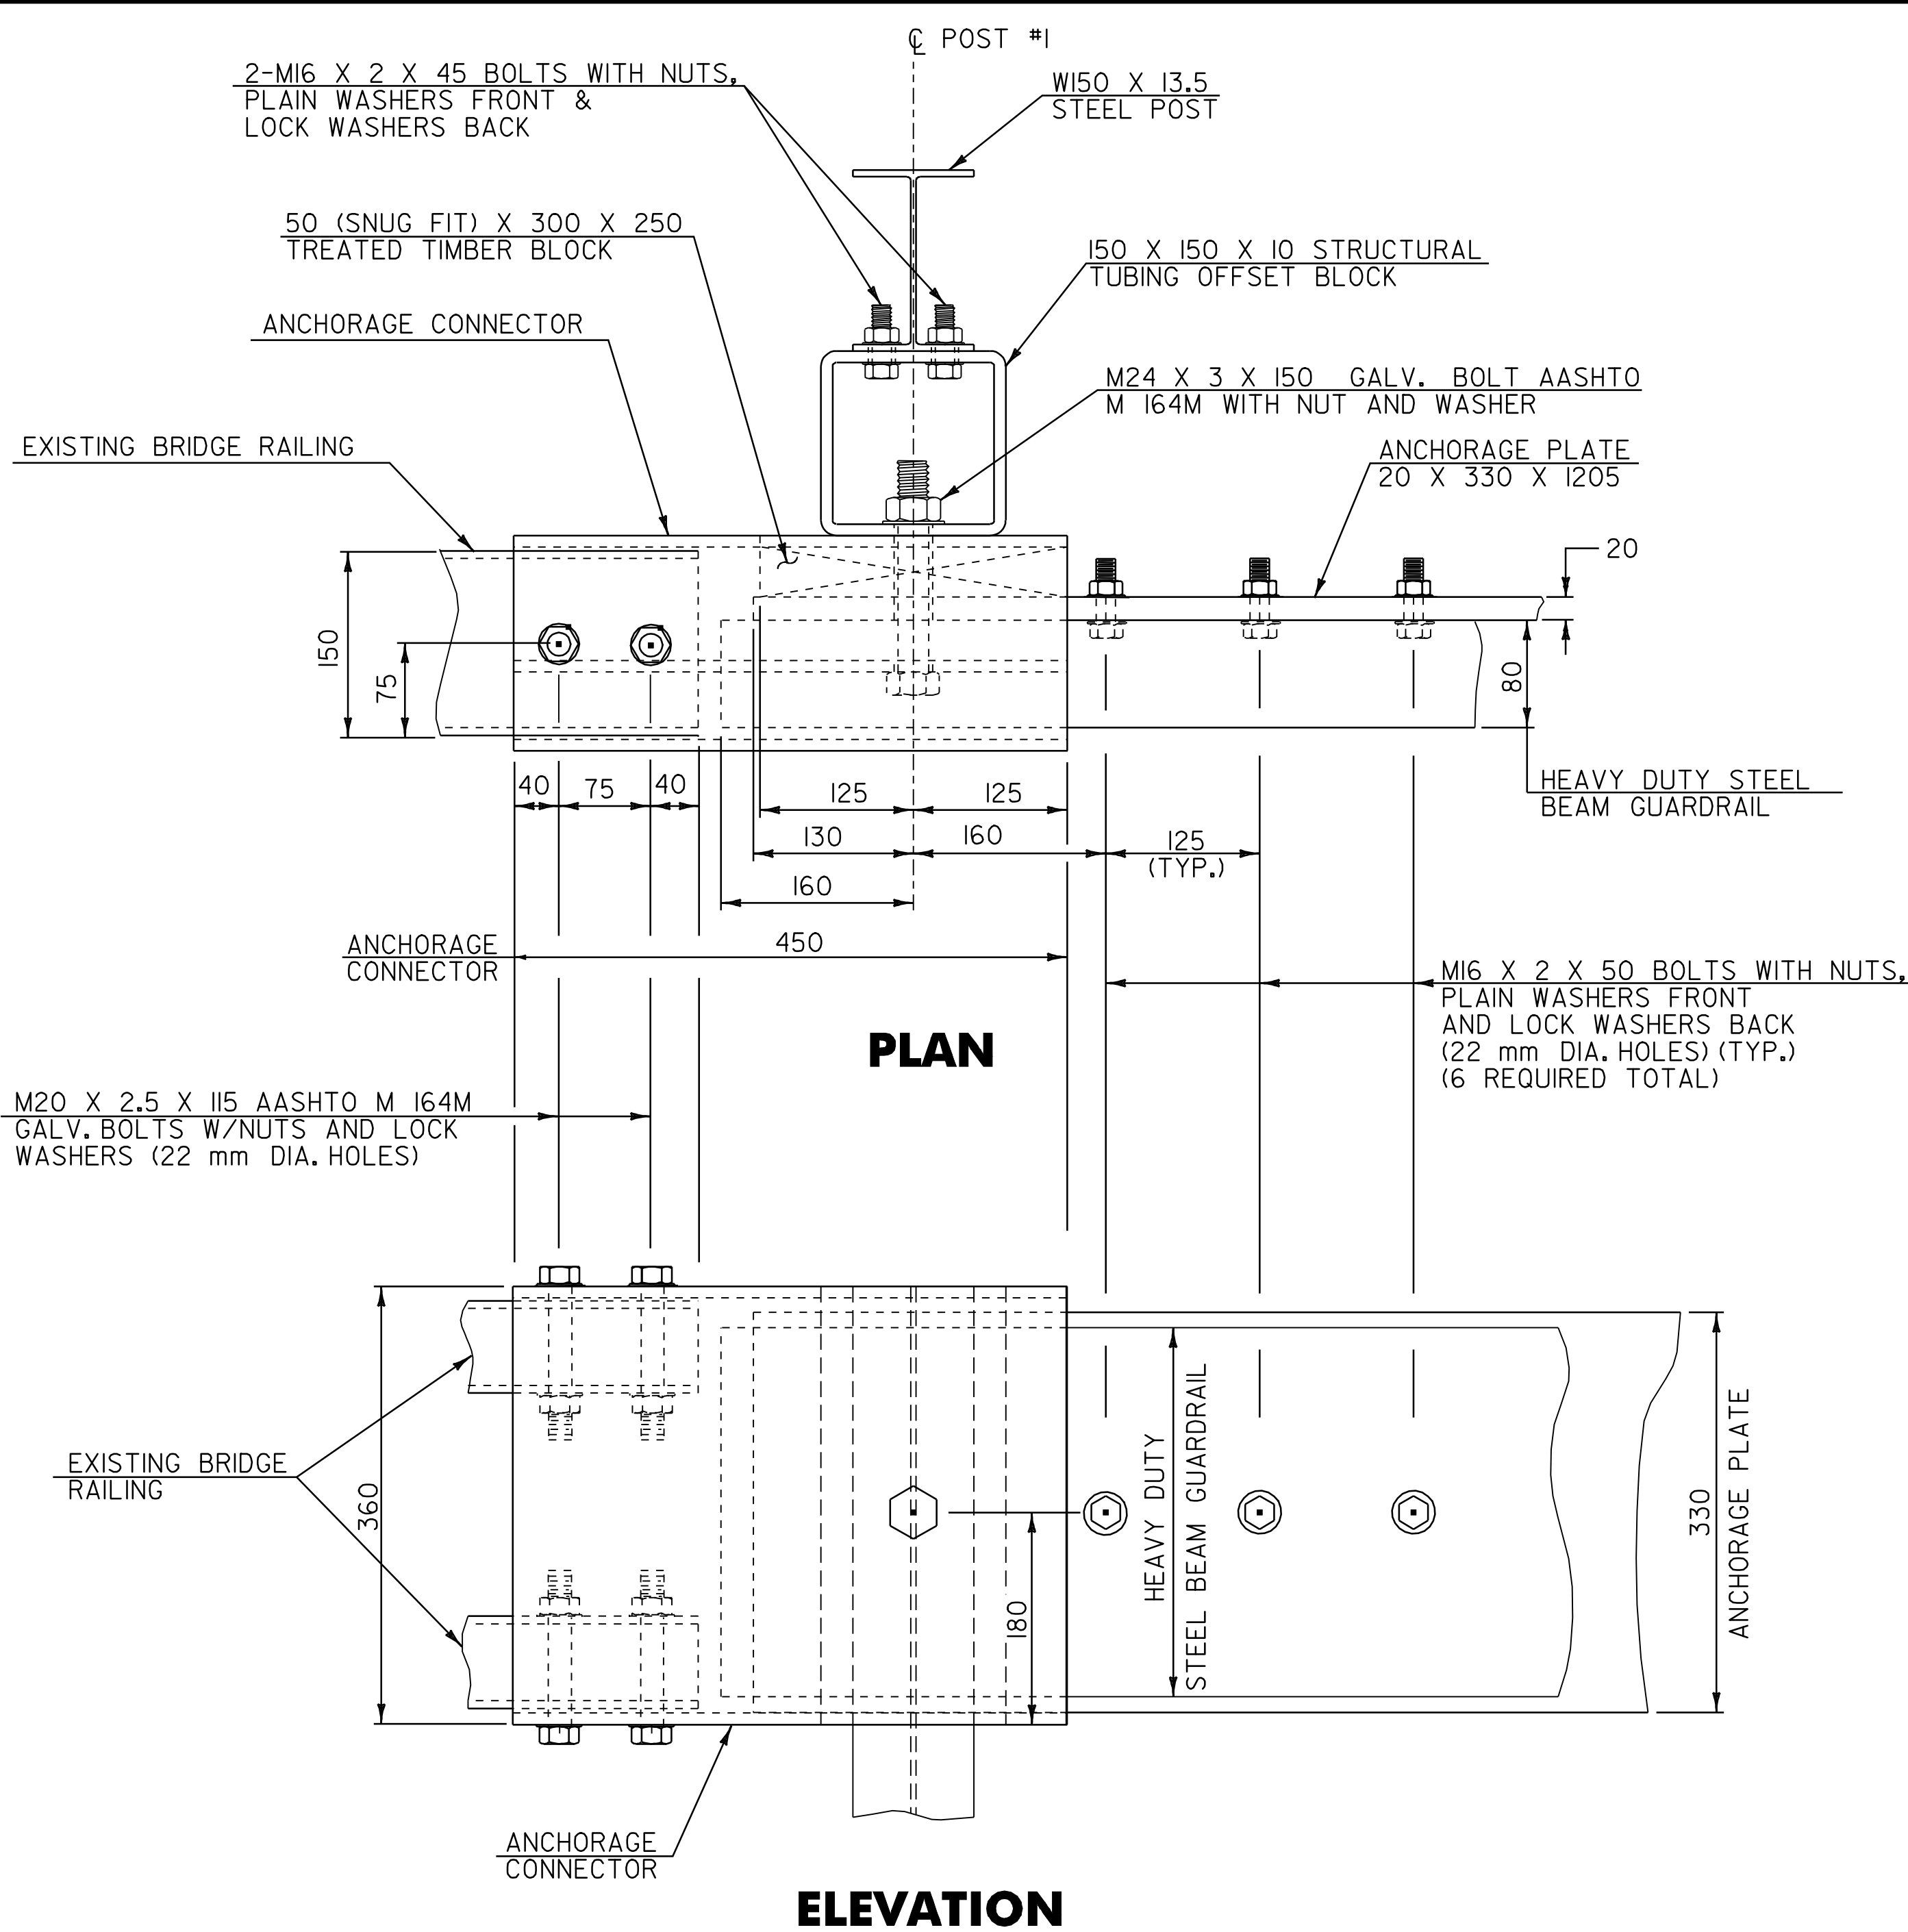

CONNECTION/TRANSITION DETAILS AT POST NO. 1
NOT TO SCALE

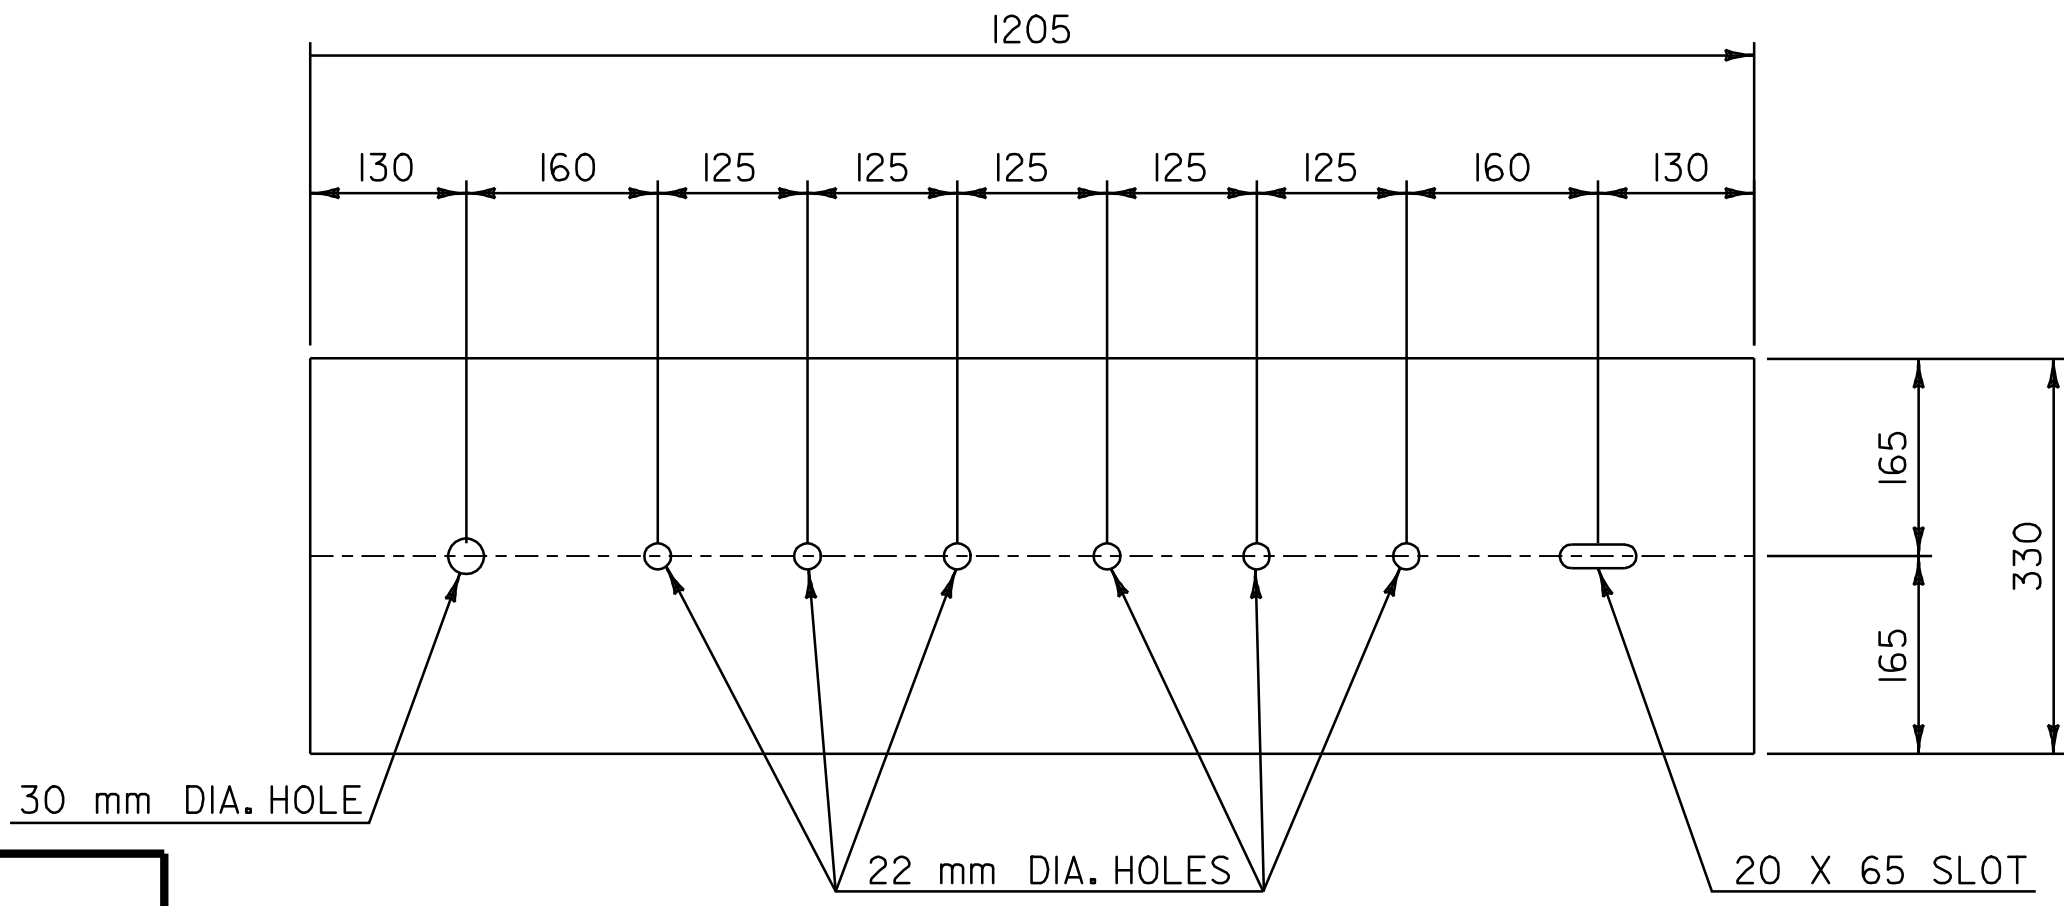


ANCHORAGE PLATE DETAIL
NOT TO SCALE

DATUM	
VERTICAL	N/A
HORIZONTAL	N/A

NOTE:
ALL DIMENSIONS IN MILLIMETERS EXCEPT WHERE OTHERWISE INDICATED.

BRIDGE APPROACH SECTION DETAIL SHEET 2


SURVEYED BY	N/A	DATE	N/A
DRAWN BY	C.A.K.	DATE	2/02
SQUAD LEADER	D.E.G.		
DESIGN FILE NO.	page 01b018/pb018.dgn		
IPARM FILE	pb018b018	DATE	10-JUL-2006 13:3
PROJ. NAME	SALISBURY - MIDDLEBURY		
PROJ. NO.	NH_231111S		
SHEET	65	OF	67
SHEETS			

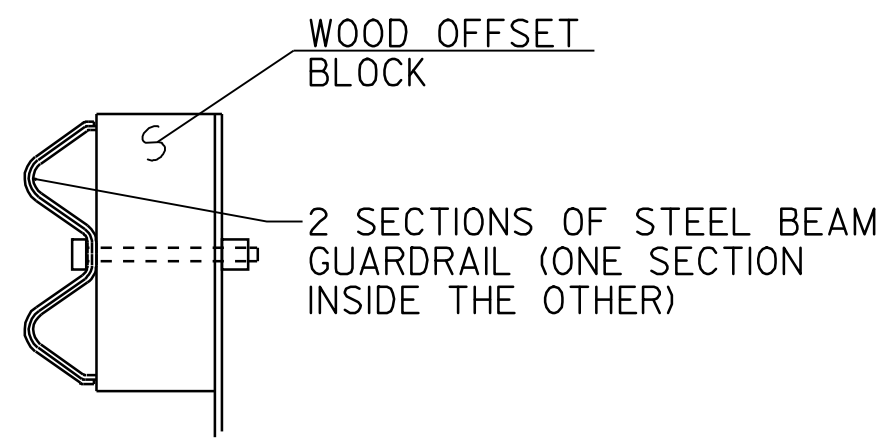


DETAIL A
NOT TO SCALE

NOTES

1. SEE STANDARD G-1M FOR STEEL BEAM GUARDRAIL DETAILS.
2. THIS WORK SHALL BE PAID UNDER ITEM 621.20 STEEL BEAM GUARDRAIL AT A PAY FACTOR OF 1.0.
3. THIS DETAIL TO BE USED AS INDICATED ON THE ITEM DETAIL SUMMARY SHEETS OR AS DIRECTED BY THE RESIDENT ENGINEER.

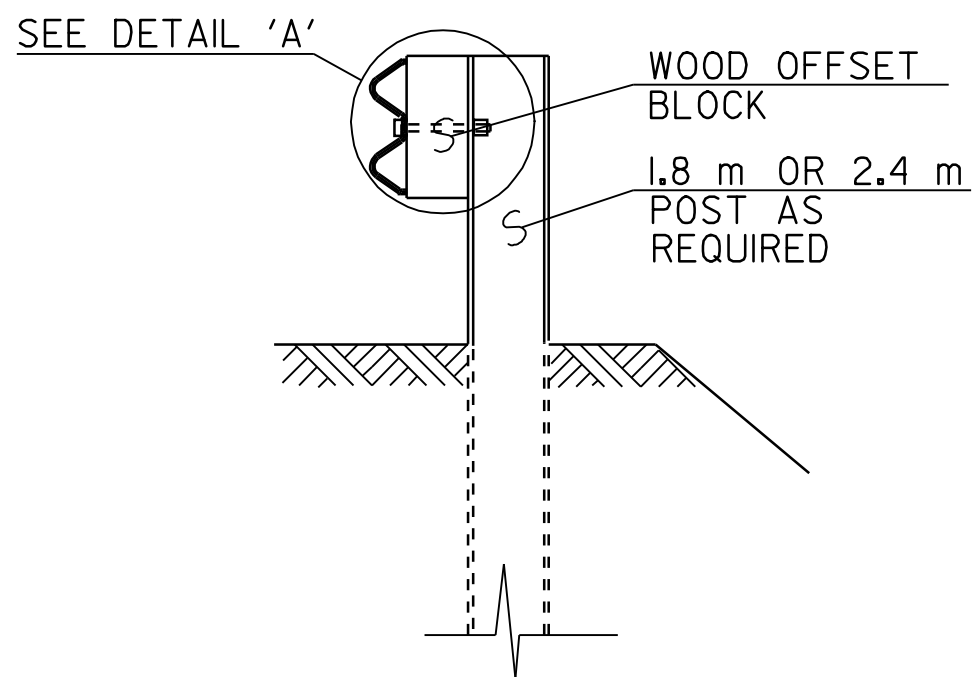

SECTION A-A
NOT TO SCALE

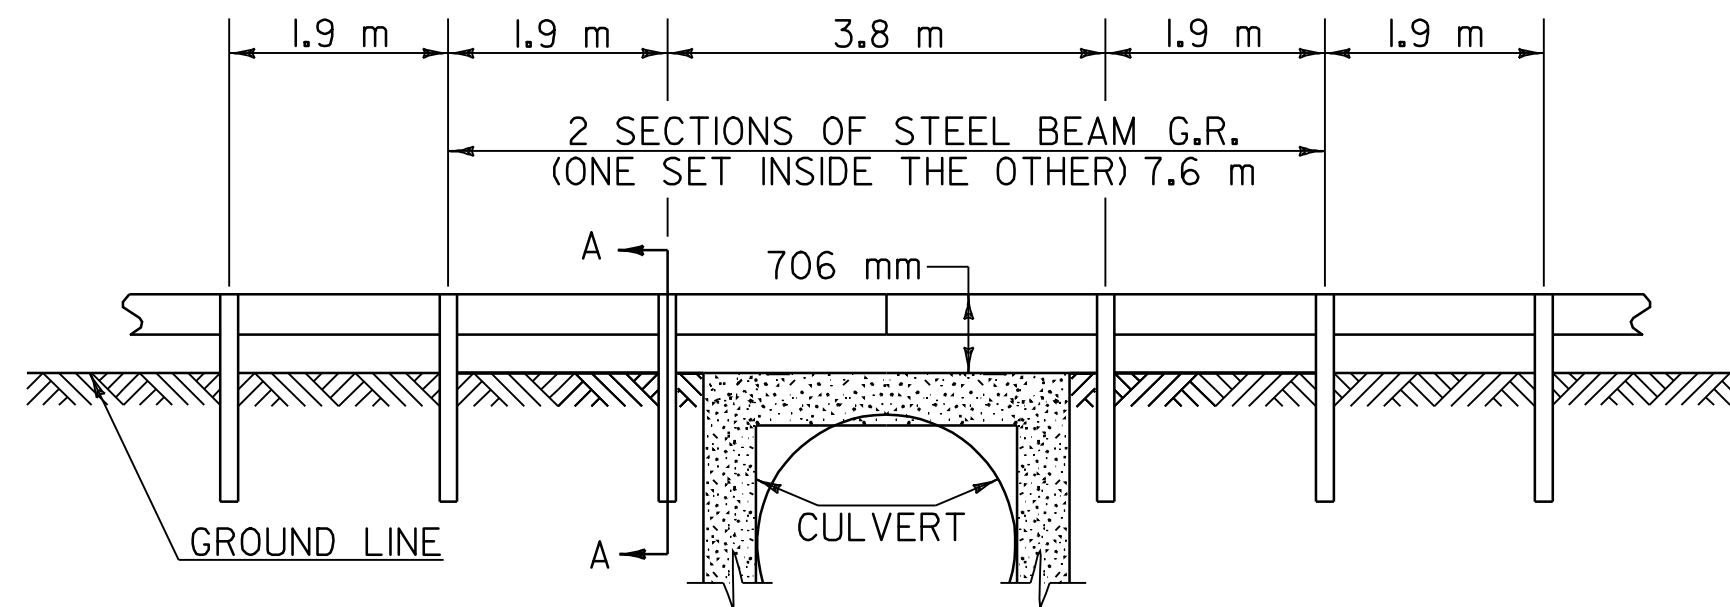


DETAIL OF STEEL BEAM GUARDRAIL AT SMALL CULVERTS
BR 124A SALISBURY STA. 6+572.561 LT & RT
NOT TO SCALE

GUARDRAIL AND MISC. DETAIL SHEET

SURVEYED BY N/A DATE N/A
DRAWN BY C.A.K. DATE 2/02
SQUAD LEADER D.E.G.
DESIGN FILE NO. pave/01b018/pb018.dgn
IPARM pb018gr1.i DATE 10-JUL-2006 13:3
FILE PLOTTED
PROJ. NAME SALISBURY - MIDDLEBURY
PROJ. NO. NH_231111S
SHEET 66 OF 67 SHEETS _____

DATUM
VERTICAL N/A
HORIZONTAL N/A

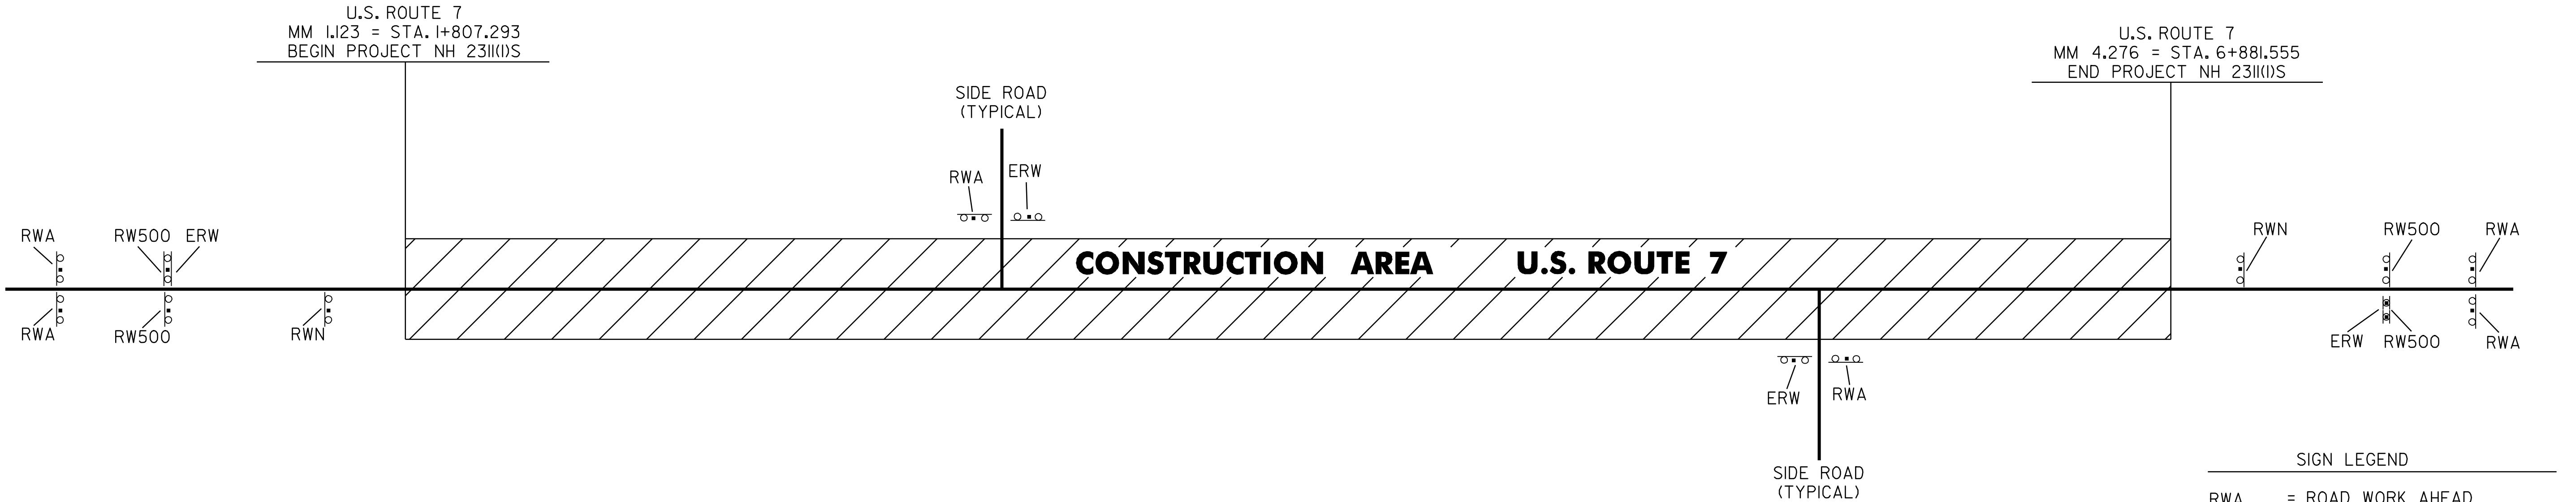

CONSTRUCTION APPROACH SIGNING

SEE STD. E-100M FOR ADDITIONAL SIGN PLACEMENT

LIST OF TOWN HIGHWAYS FOR CONSTRUCTION SIGNS			
TOWN HIGHWAY NUMBER	ROAD WORK AHEAD	END ROAD WORK	OTHER
BEGIN PROJECT	2	1	2 - RW500 1 - RWN
T-23	1	1	
T-23	1	1	
T-3	1	1	
T-9	1	1	
T-10	1	1	
VT. ROUTE 116	1	1	
VT. ROUTE 125	1	1	
T-24	1	1	
T-12	1	1	
T-26	1	1	
T-7	1	1	
T-9	1	1	
T-115	1	1	
T-113	1	1	
T-115	1	1	
T-20	1	1	
END PROJECT	2	1	2 - RW500 1 - RWN
TOTAL	20	18	6

CONSTRUCTION
APPROACH
SIGNING
SHEET

SURVEYED BY N/A DATE N/A
DRAWN BY C.A.K. DATE 2/02
SQUAD LEADER D.E.G.

DESIGN FILE NO. pave/01b018/pb018.dgn
IPARM FILE pb018cgs.i DATE 10-JUL-2006 13:35
PLOTTER
PROJ. NAME SALISBURY - MIDDLEBURY
PROJ. NO. NH_2311(1)S
SHEET 67 OF 67 SHEETS

DATUM

VERTICAL N/A

HORIZONTAL N/A