


TEMPORARY 100mm WHITE LINE, PAINT
DURABLE 100mm WHITE LINE, THERMOPLASTIC
STA 1+140 TO 1+280 SOLID LT & RT

TEMPORARY 100mm YELLOW LINE, PAINT
DURABLE 100mm YELLOW LINE, THERMOPLASTIC
STA 1+140 TO 1+280 SOLID LT & RT

* NOTE
STA 1+140 TO 1+280 HOLD LEFT
EDGE OF PAVEMENT AND WIDEN
ON RIGHT SIDE ONLY.

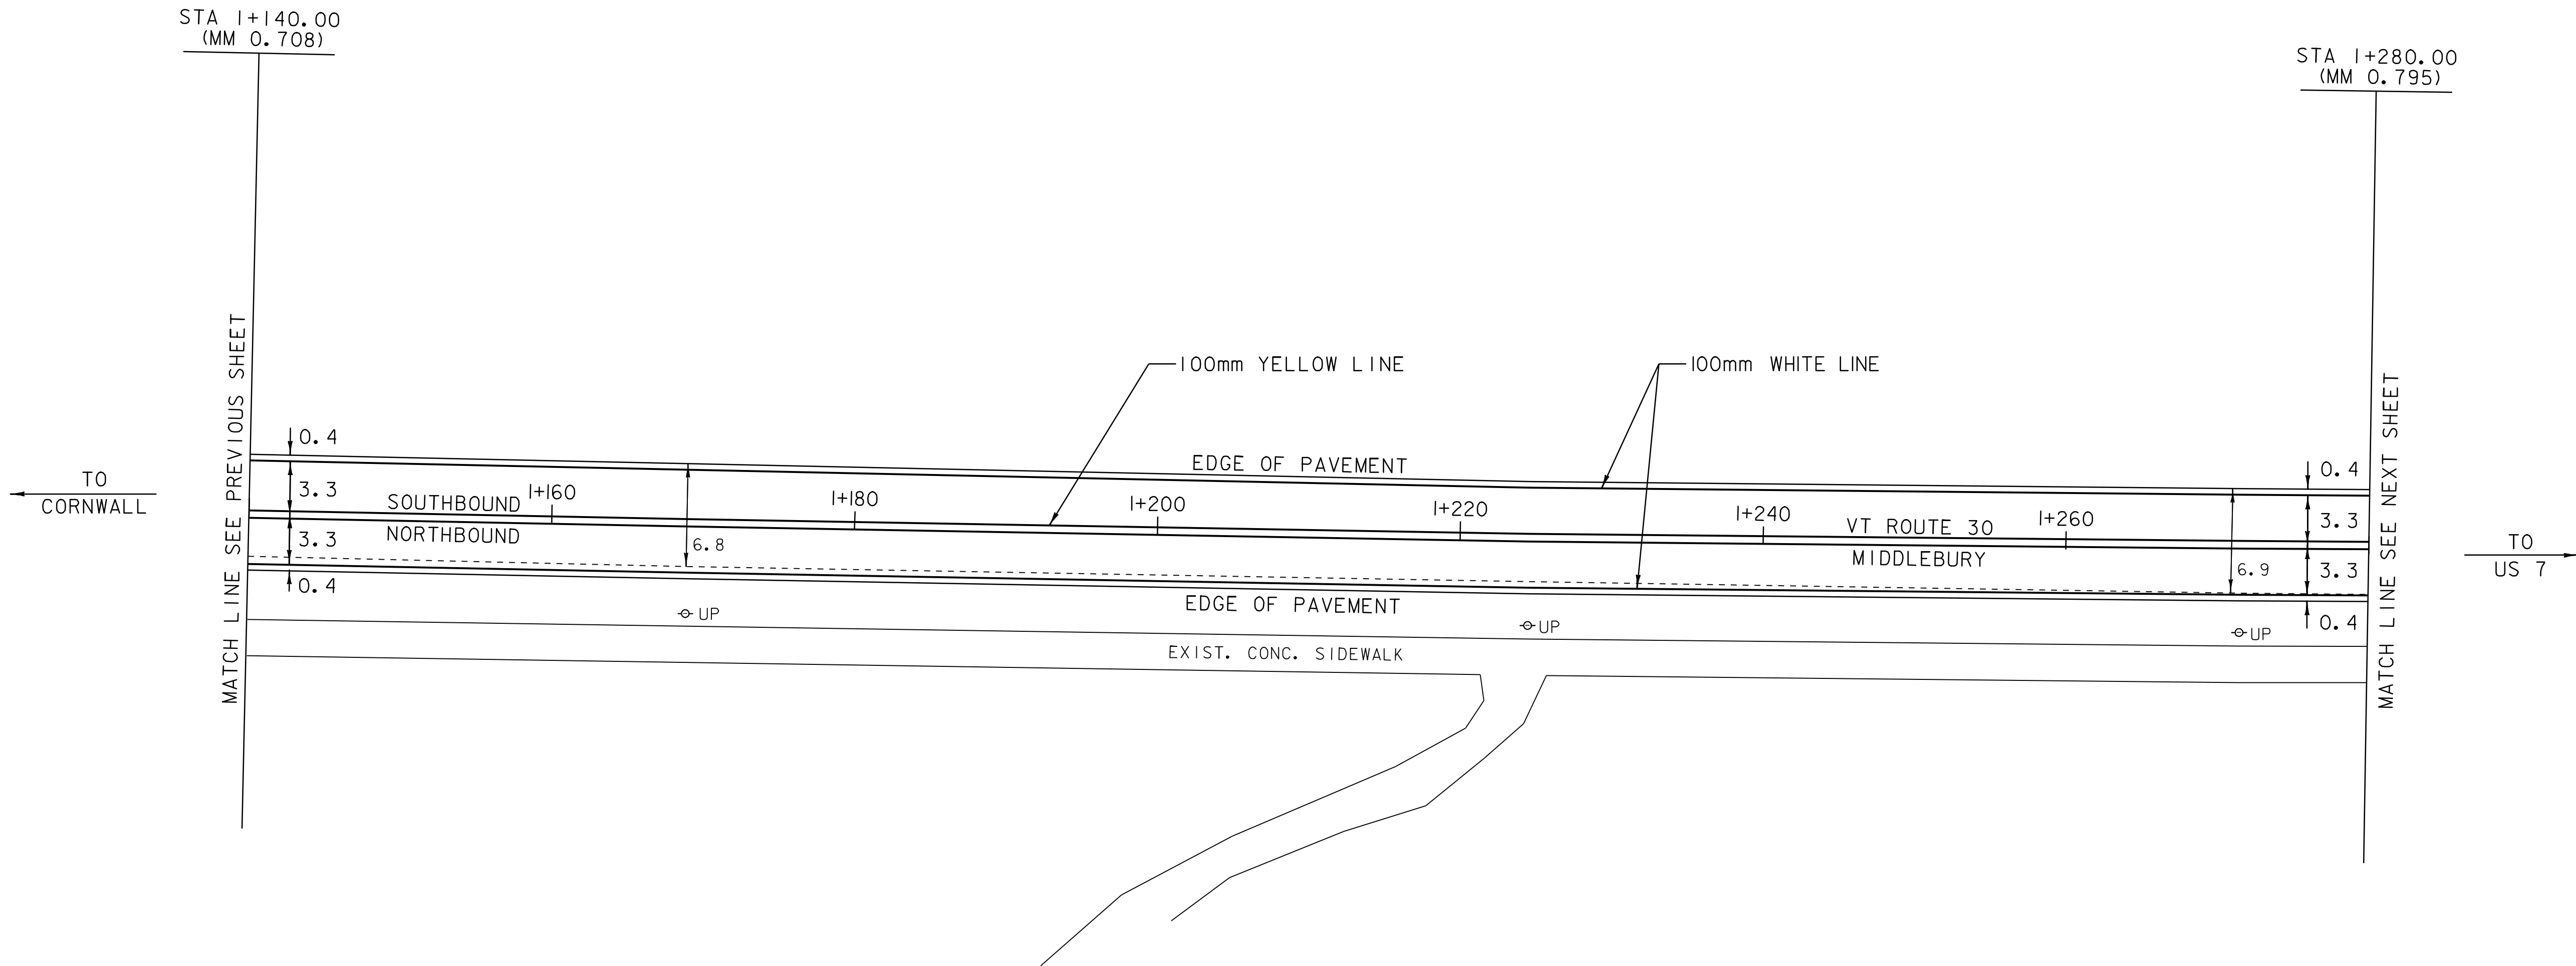

- LEGEND
- R = REMOVE EXISTING
 - S = SALVAGE
 - R&S = REMOVE AND SALVAGE
 - N = NEW
 - RET = RETAIN
 - B-B = BACK TO BACK

PAVING LAYOUT 3		
PROJECT NAME:	MIDDLEBURY	
PROJECT NUMBER:	STP 2304(I)S	
FILE NAME:	/pave/0ld048/pd048.dgn	PLOT DATE: 06-OCT-2008 13:0
PROJECT LEADER:	PTS	DRAWN BY: MRS
IPARM FILE NAME:	pd048I03.I	CHECKED BY: NLL
		SHEET 21 OF 103

NOT TO SCALE

NOTE: ALL DIMENSIONS IN METERS EXCEPT AS INDICATED