


TEMPORARY 100mm WHITE LINE, PAINT
 STA 6+950 TO 7+071 SOLID LT
 STA 6+950 TO 7+071 SOLID RT
 STA 7+039 TO 7+071 DOTTED RT LANE LINE
 DURABLE 100mm WHITE LINE, THERMOPLASTIC
 STA 6+950 TO 7+071 SOLID LT
 STA 6+950 TO 7+071 SOLID RT
 DURABLE 100mm WHITE LINE, TYPE ITAPE
 STA 7+039 TO 7+071 DOTTED RT LANE LINE

TEMPORARY 100mm YELLOW LINE, PAINT
 DURABLE 100mm YELLOW LINE, THERMOPLASTIC
 STA 6+950 TO 6+959 SOLID LT & RT
 STA 6+959 TO 7+071 DOUBLE SOLID LT & RT
 DURABLE 200mm YELLOW LINE, THERMOPLASTIC
 STA 6+983 TO 7+071 SOLID LT & RT (GORE)
 TEMPORARY LETTER OR SYMBOL, PAINT
 DURABLE LETTER OR SYMBOL, TYPE ITAPE
 STA 6+964 RT - "SCHOOL"

REHABILITATION OF
~~CHANGING ELEVATION OF DROP INLETS,~~
~~CATCH BASINS, OR MANHOLES~~
 STA 6+993 RT (CB)
 STA 6+995 LT (CB)
 STA 7+025 RT (CB)
 STA 7+033 LT (CB)
 STA 7+071 LT (CB)

REMOVING SIGNS
 AS SHOWN - 5
 ERECTING SALVAGED SIGNS
 AS SHOWN - 1

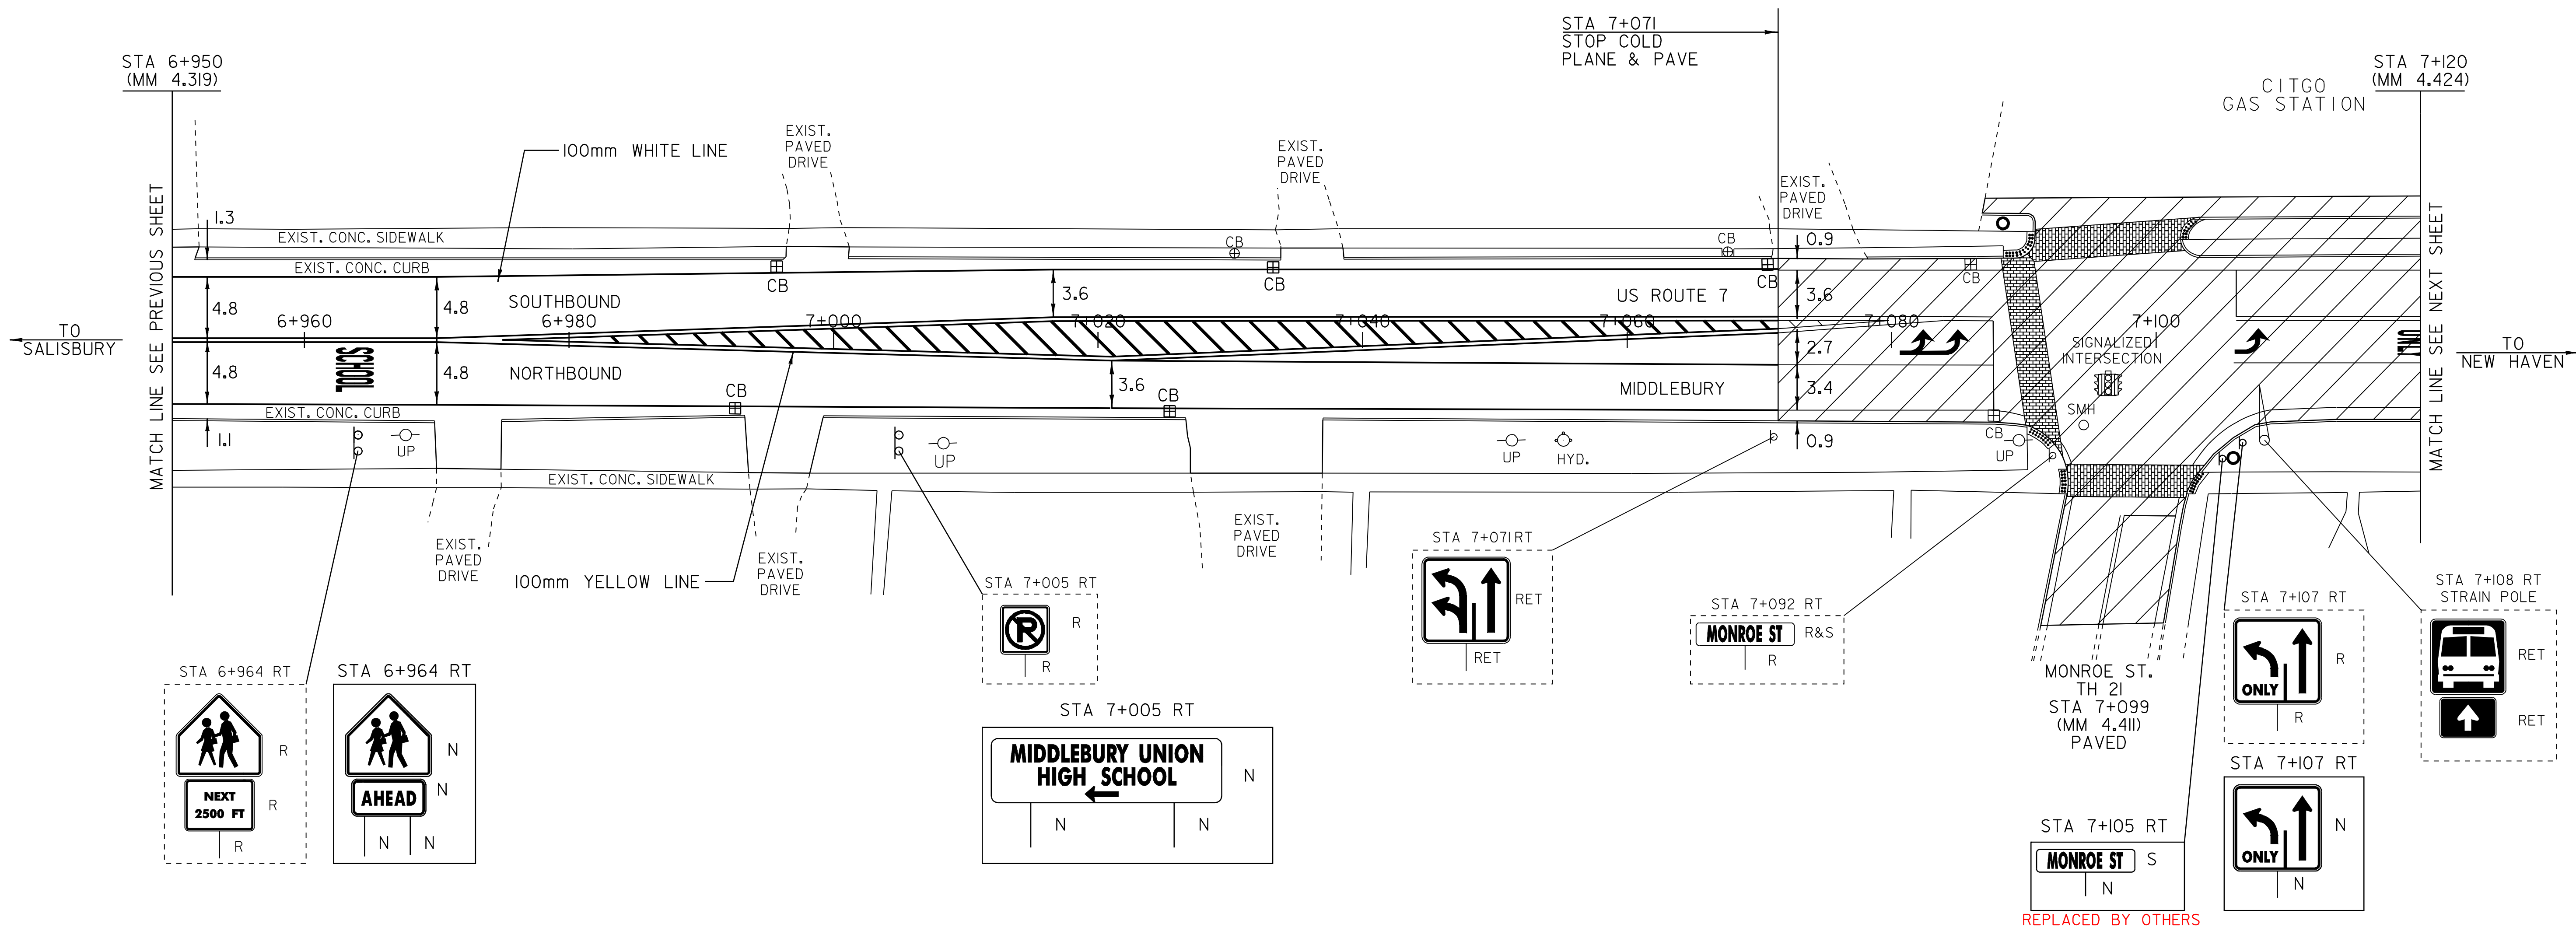

LEGEND
 R = REMOVE EXISTING
 S = SALVAGE
 R&S = REMOVE AND SALVAGE
 N = NEW
 RET = RETAIN
 B-B = BACK TO BACK
 WORK TO BE PERFORMED UNDER NHG 019-3 (52) S

PAVING LAYOUT 2

PROJECT NAME: MIDDLEBURY
 PROJECT NUMBER: NH 2603(I)S
 FILE NAME: /pave/06b032/p06b032.dgn
 PROJECT LEADER: PTS
 DESIGNED BY: NLL
 IPARM FILE NAME: p06b032la02.1
 PLOT DATE: 06-OCT-2008 13:1
 DRAWN BY: MRS
 CHECKED BY: NLL
 SHEET 67 OF 103

NOT TO SCALE

NOTE: ALL DIMENSIONS IN METERS EXCEPT AS INDICATED