

STONE FILL, TYPE II (IN DITCHES)
GEOTEXTILE UNDER STONE FILL
STA 17+010 - 17+030 LT

TEMPORARY STONE CHECK DAM, TYPE I
STA 17+010 - 17+095 LT

INLET PROTECTION DEVICE, TYPE I
STA 17+100 RT
STA 17+160 RT

TEMPORARY EROSION MATTING (IN DITCHES)
STA 17+030 - 17+095 LT

TEMPORARY EROSION MATTING (ON SLOPES)
STA 17+010 - 17+020 LT
STA 17+130 - 17+170 LT


GEOTEXTILE FOR SILT FENCE
STA 17+044 - 17+047 RT
STA 17+055 - 17+065 RT (2)
STA 17+071 - 17+073 RT
STA 17+098 - 17+170 LT (9)

PROJECT DEMARCATION FENCE
STA 17+010 - 17+115 LT
STA 17+010 - 17+077 RT
STA 17+106 - 17+170 RT

BARRIER FENCE
STA 17+111 - 17+170 LT

MATCH LINE STA 17+010

MATCH LINE STA 17+170

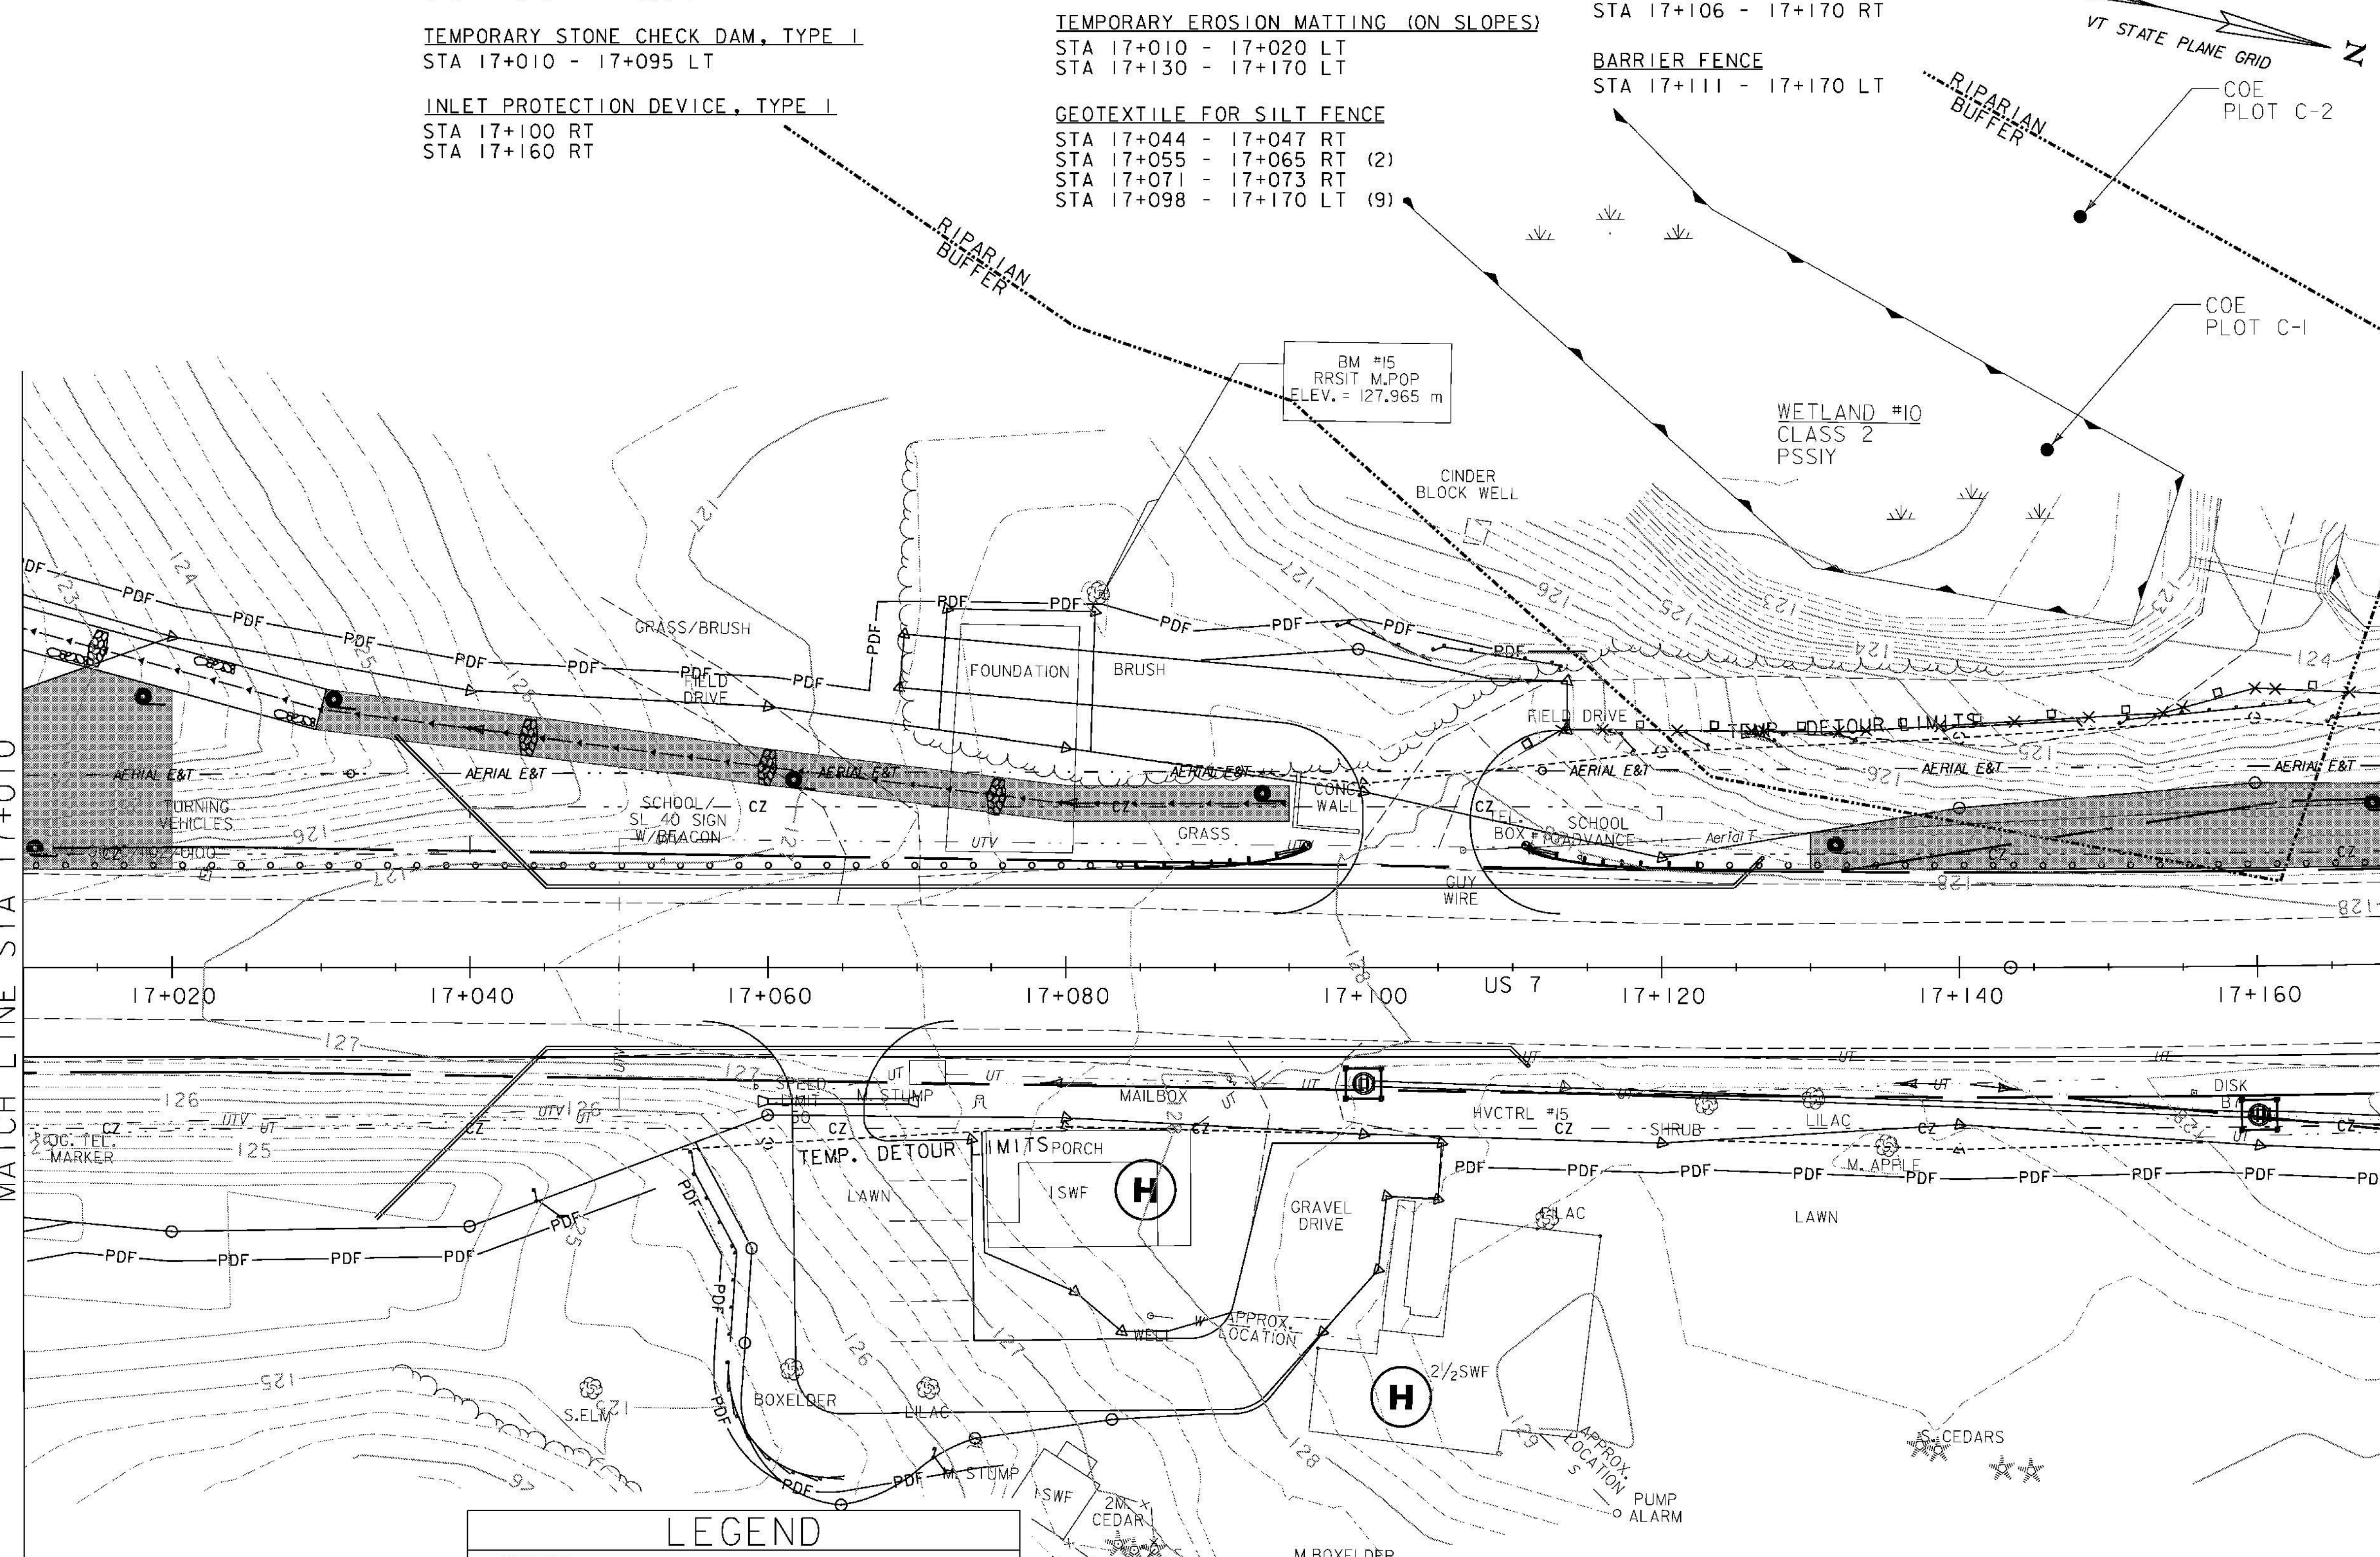

LEGEND

- ROADSIDE DITCH/SLOPE PROTECTION
- DETOUR SLOPE LIMITS
- PERMANENT SLOPE LIMITS
- SILT FENCE
- INLET PROTECTION DEVICE, TYPE I
- PIPE INLET PROTECTION
- EROSION MATTING
- CHECK DAM - TEMPORARY
- BARRIER FENCE
- PROJECT DEMARCATION FENCE
- FILTER CURTAIN

NOTES:

- SILT FENCE LOCATIONS SHOWN ON THIS DRAWING ARE APPROXIMATE. THE CONTRACTOR IS RESPONSIBLE FOR INSTALLING THE SILT FENCE IN ACCORDANCE WITH THE GUIDELINES SET FORTH IN THE VERMONT GENERAL PERMIT FOR STORMWATER RUNOFF FROM CONSTRUCTION SITES. THE RESIDENT ENGINEER AND ON SITE COORDINATOR SHALL APPROVE ALL SILT FENCE LOCATIONS PRIOR TO PLACEMENT.
- FOR EROSION PREVENTION AND SEDIMENT CONTROL PLAN GENERAL NOTES, SEE SHEETS 147 - 148, AND DETAILS, SEE SHEETS 177 - 180.



EROSION CONTROL PLAN 5

PROJECT NAME:	BRANDON
PROJECT NUMBER:	NH 019-3(495)
FILE NAME:	zb008s5-ec05.dgn
PROJECT LEADER:	CRB
DESIGNED BY:	NLL
CLD 02-0149	
PLOT DATE:	9/3/2009
DRAWN BY:	NLL
CHECKED BY:	PTS
SHEET	153 OF 546