
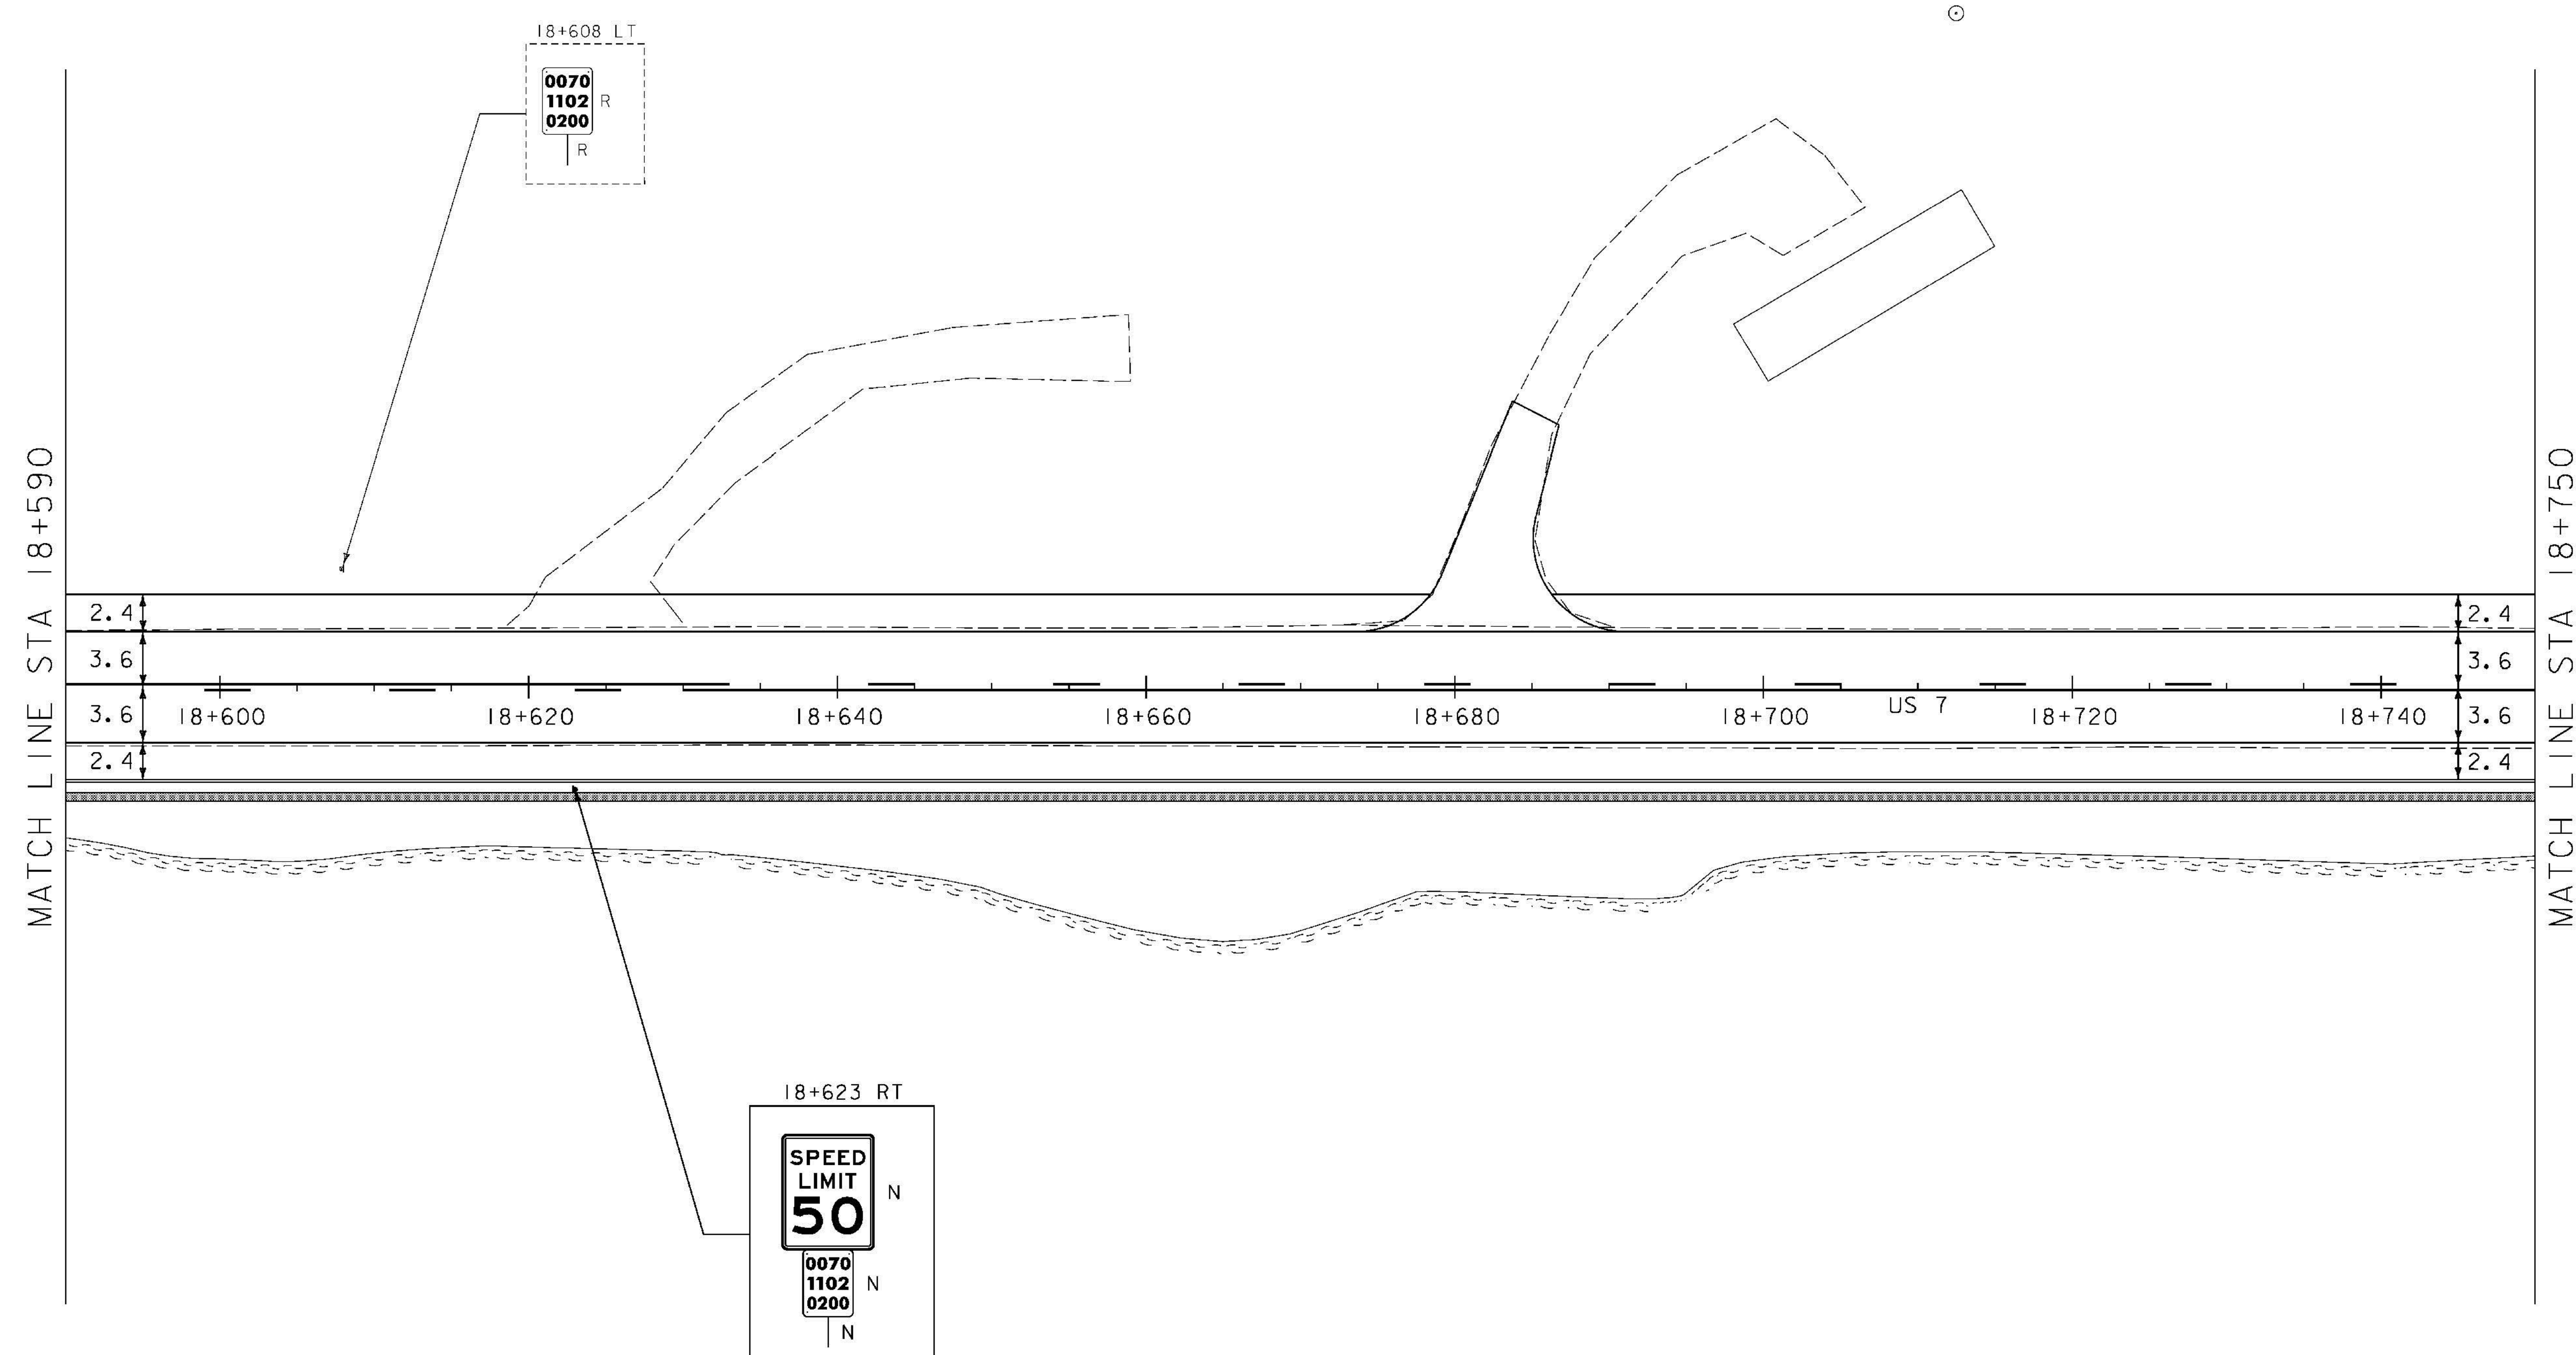


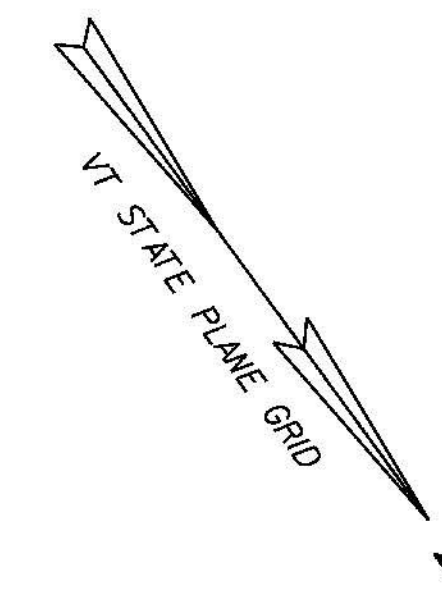


TEMPORARY 100mm WHITE LINE, PAINT
DURABLE 100mm WHITE LINE, THERMOPLASTIC
STA 18+590 TO 18+750 SOLID LT & RT

TEMPORARY 100mm YELLOW LINE, PAINT
DURABLE 100mm YELLOW LINE, THERMOPLASTIC
STA 18+590 TO 18+630 SOLID LT, DASHED RT
STA 18+630 TO 18+750 DASHED LT, SOLID RT

REMOVING SIGNS
AS SHOWN - I

SIGN LEGEND

R	= REMOVE
S	= SALVAGE
N	= NEW
RET	= RETAIN
T&T	= THINNING & TRIMMING
B-B	= BACK TO BACK
EXISTING	-----
NEW	_____

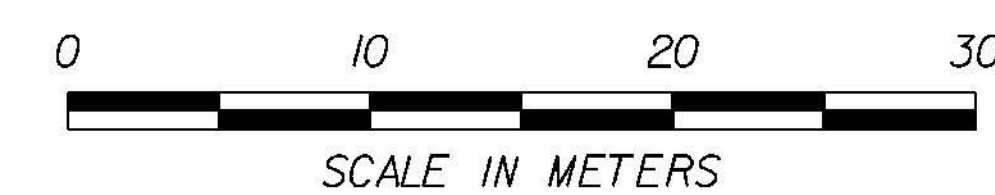

SIGNING & PAVEMENT MARKING 15

PROJECT NAME:	BRANDON	PLOT DATE:	9/3/2009
PROJECT NUMBER:	NH 019-3(495)	DRAWN BY:	HJC
FILE NAME:	zb008s5-+sl5.dgn	CHECKED BY:	PTS
PROJECT LEADER:	CRB	SHEET	256 OF 546
DESIGNED BY:	NLL		
CLD 02-0149			