


TEMPORARY 100mm WHITE LINE, PAINT
DURABLE 100mm WHITE LINE, THERMOPLASTIC
STA 19+230 TO 19+390 SOLID LT & RT
REMOVING SIGNS
AS SHOWN - 1
TEMPORARY 100mm YELLOW LINE, PAINT
DURABLE 100mm YELLOW LINE, THERMOPLASTIC
STA 19+230 TO 19+290 SOLID LT & RT
STA 19+290 TO 19+390 SOLID LT, DASHED RT

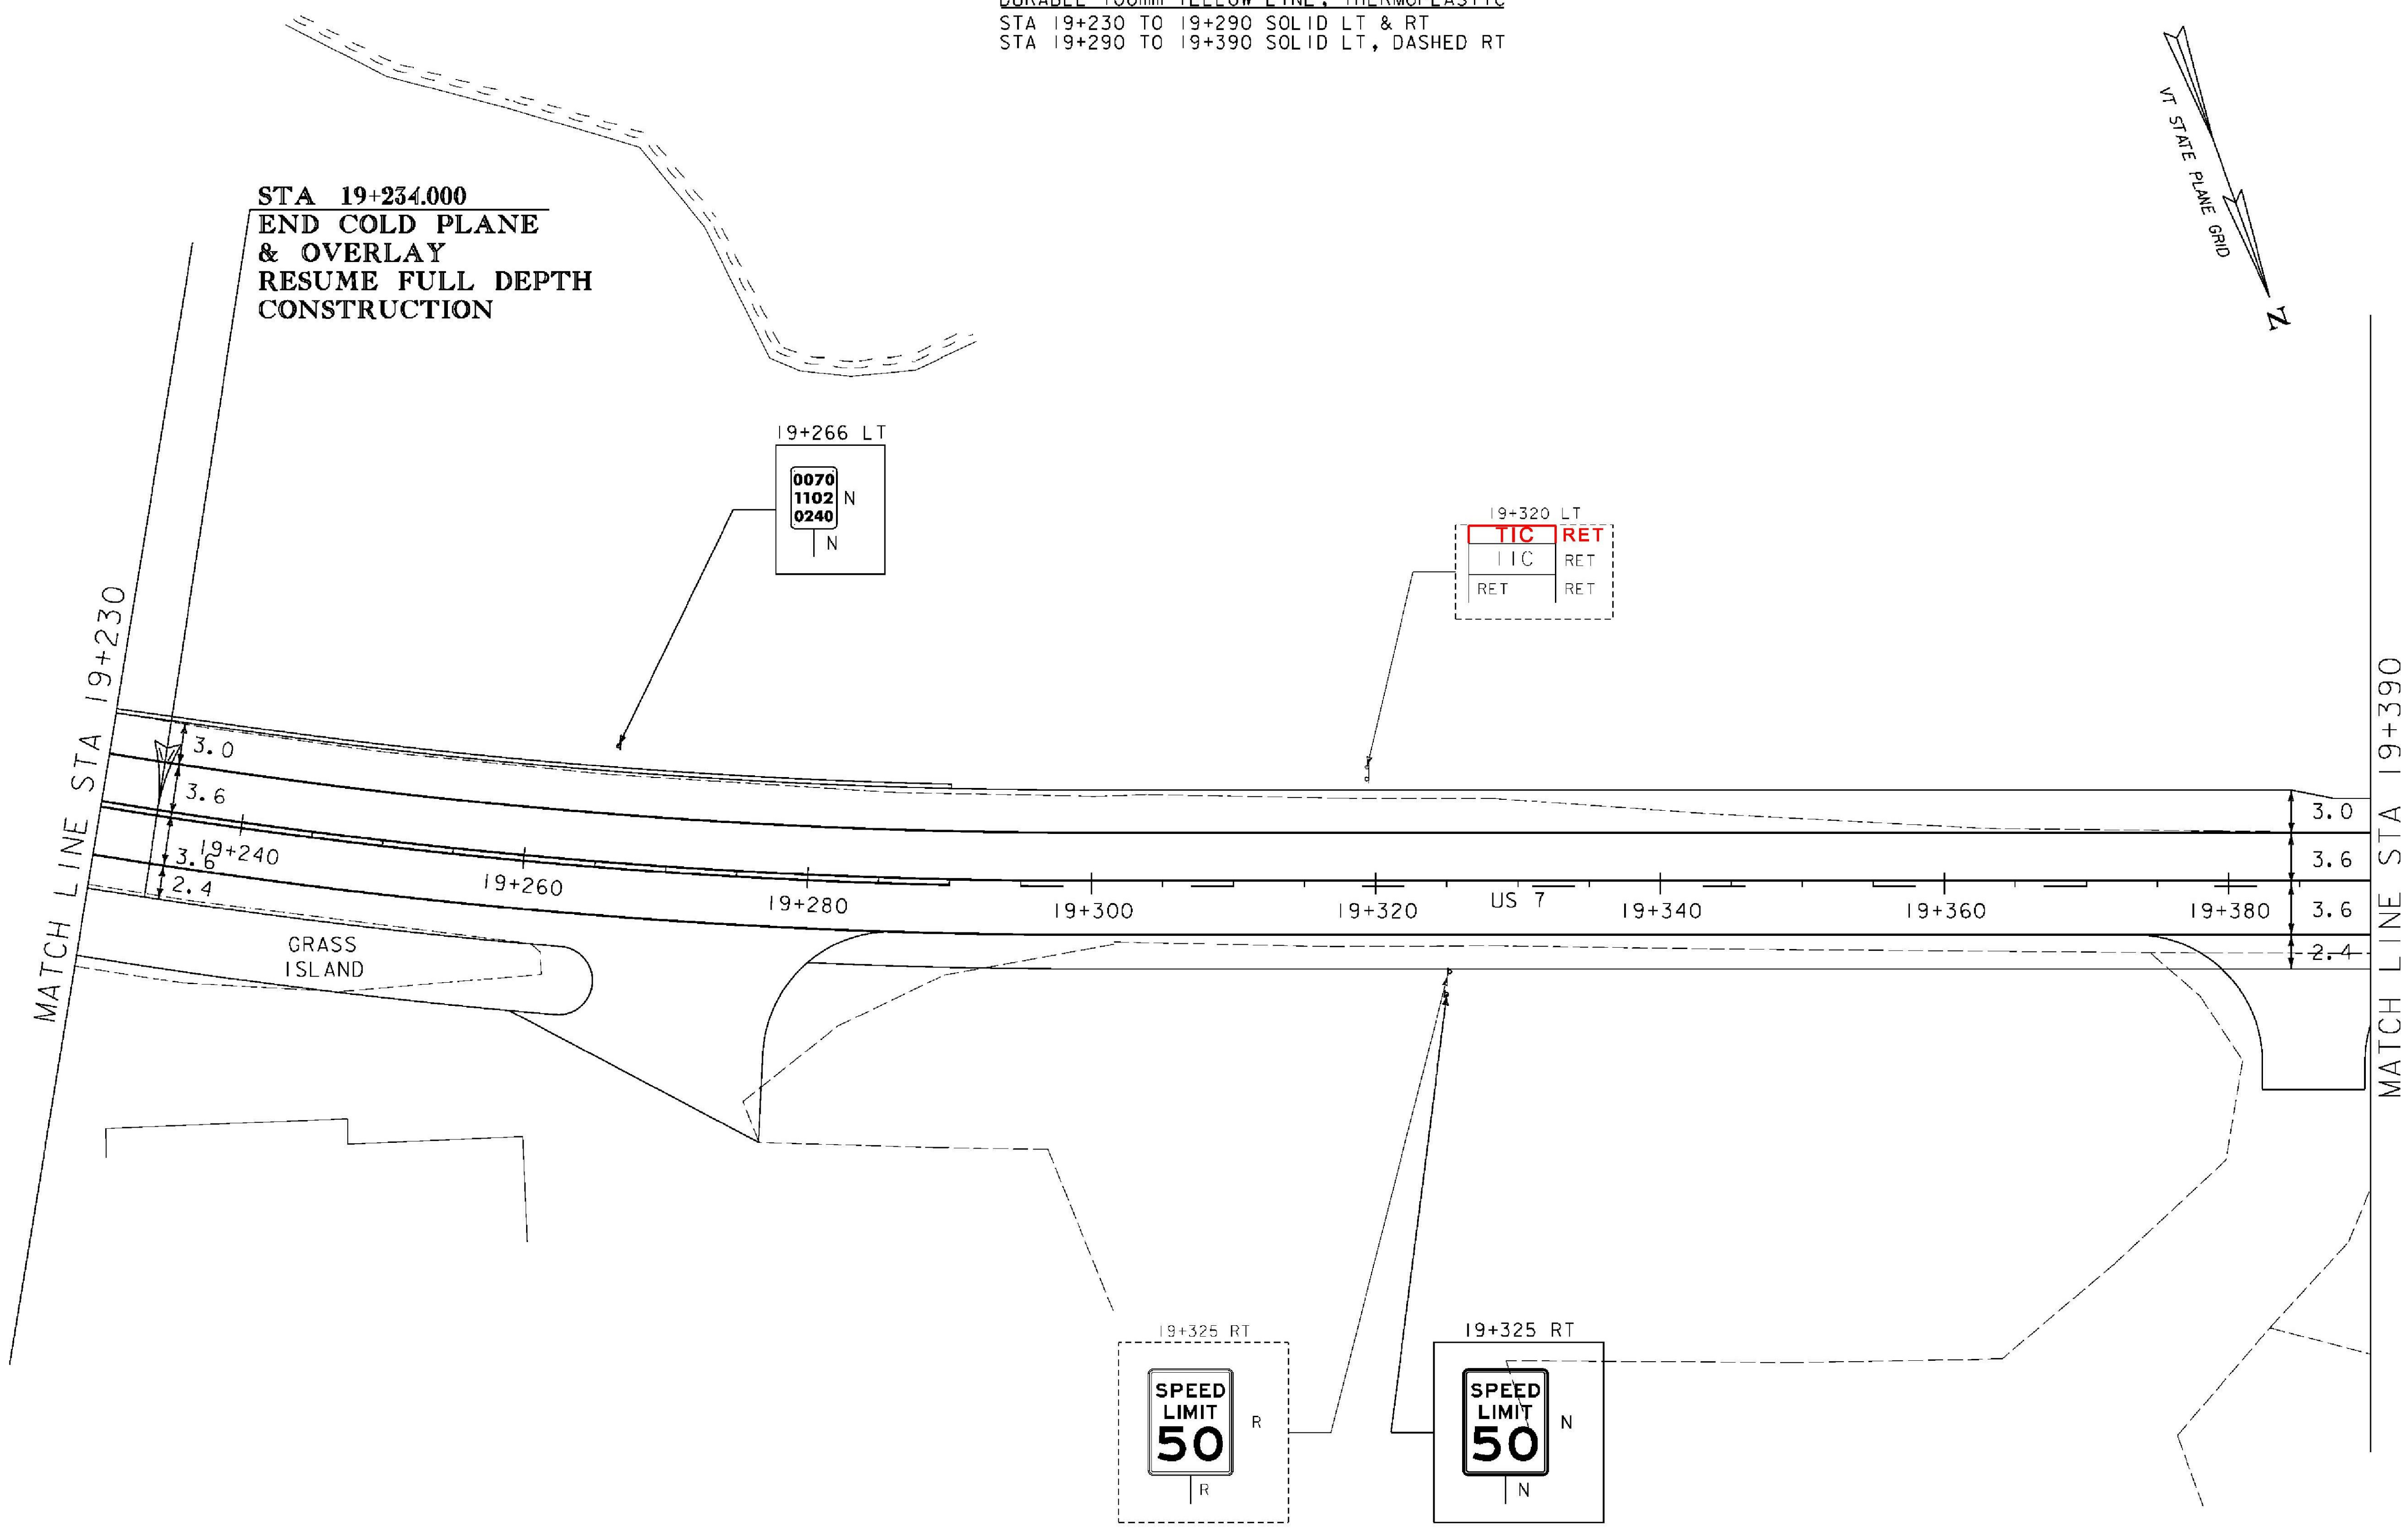

SIGN LEGEND
R = REMOVE
S = SALVAGE
N = NEW
RET = RETAIN
T&T = THINNING & TRIMMING
B-B = BACK TO BACK
EXISTING = DASHED LINE
NEW = SOLID LINE



SIGNING & PAVEMENT MARKING 19

PROJECT NAME: BRANDON	
PROJECT NUMBER: NH 019-3(495)	
FILE NAME: zb008s5-+sl9.dgn	PLOT DATE: 9/3/2009
PROJECT LEADER: CRB	DRAWN BY: HJC
DESIGNED BY: NLL	CHECKED BY: PTS
CLD 02-0149	SHEET 260 OF 546