

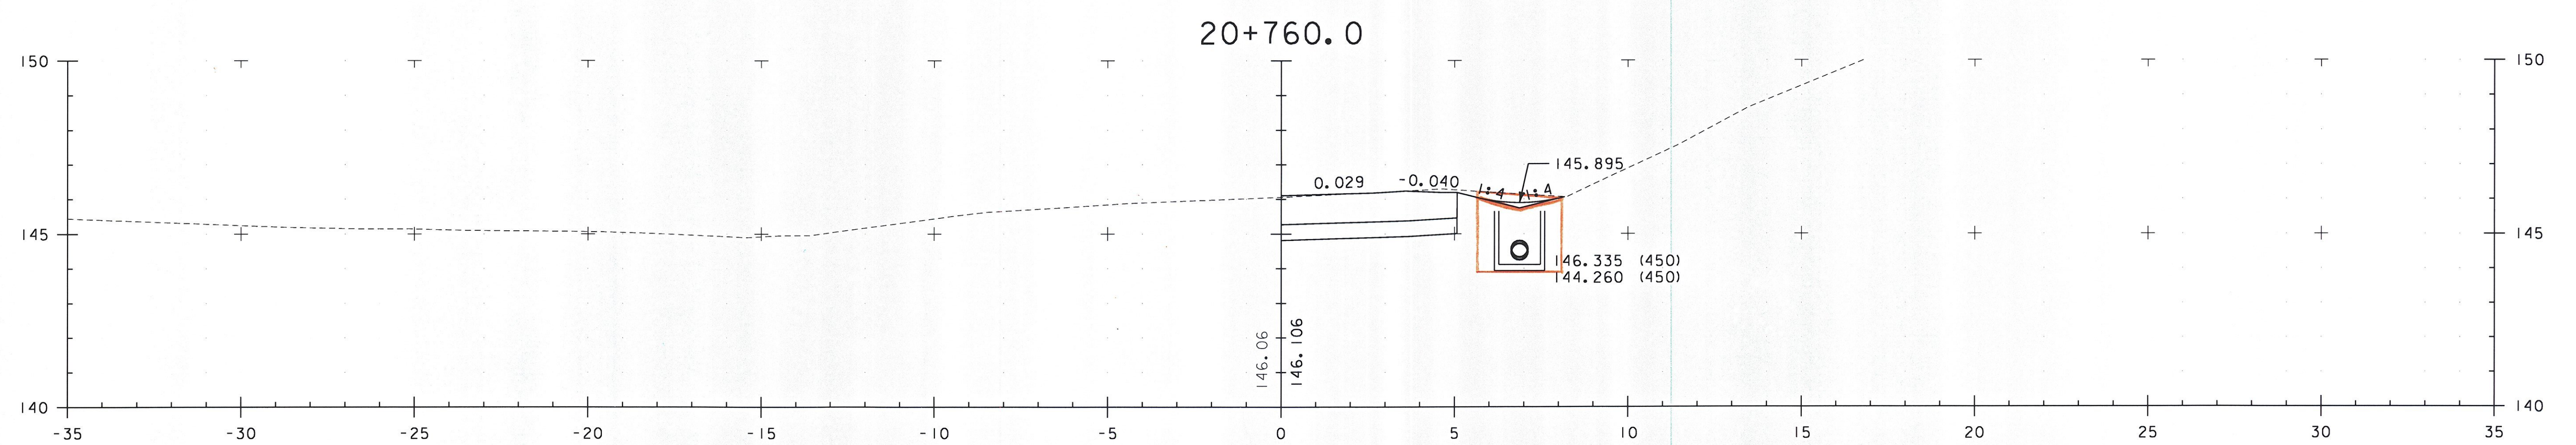


20+780.0
 POT 20+777.617 (BK)
 POT 20+778.000 (AHD)
 EQ = -0.383 m

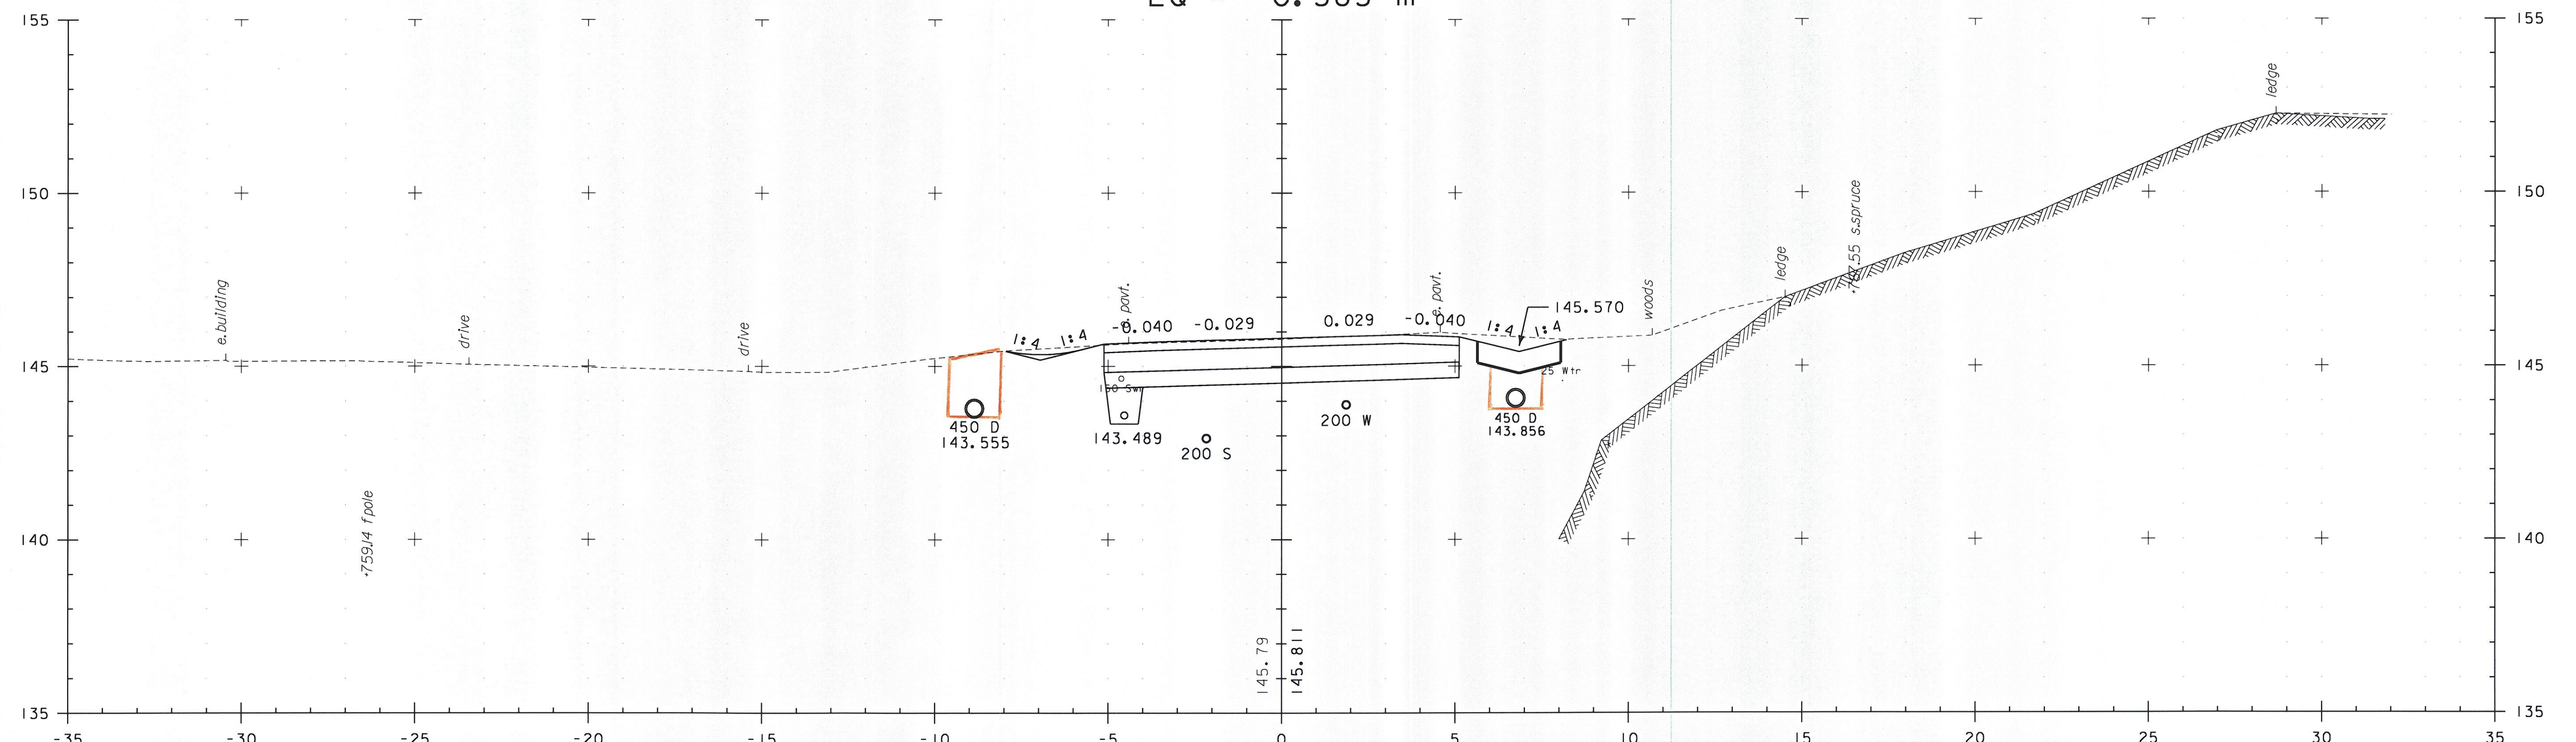

US 7

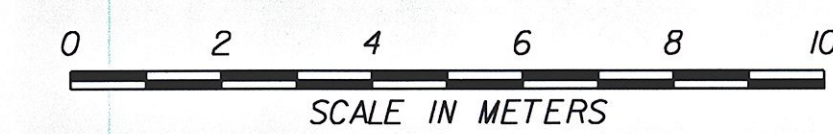

PROJECT NAME: BRANDON	PLOT DATE: 9/3/2009
PROJECT NUMBER: NH 019-3(495)	DRAWN BY: NLL
FILE NAME: zb008s5-xs270.dgn	CHECKED BY: DAM
PROJECT LEADER: CRB	SHEET 541 OF 546
DESIGNED BY: PTS	
CLD 02-0149	