
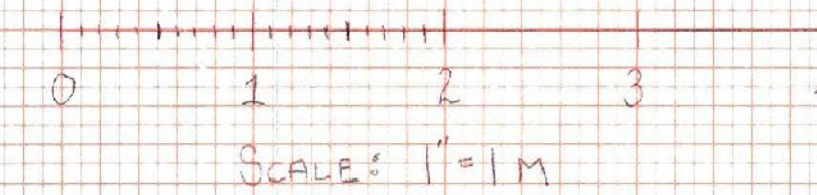


ORIGINAL SURVEY NOTE BOOK		BY	DATE
SURVEYED			
PLOTTED			
TEMPLE			
AREAS			
AREAS CHECKED			

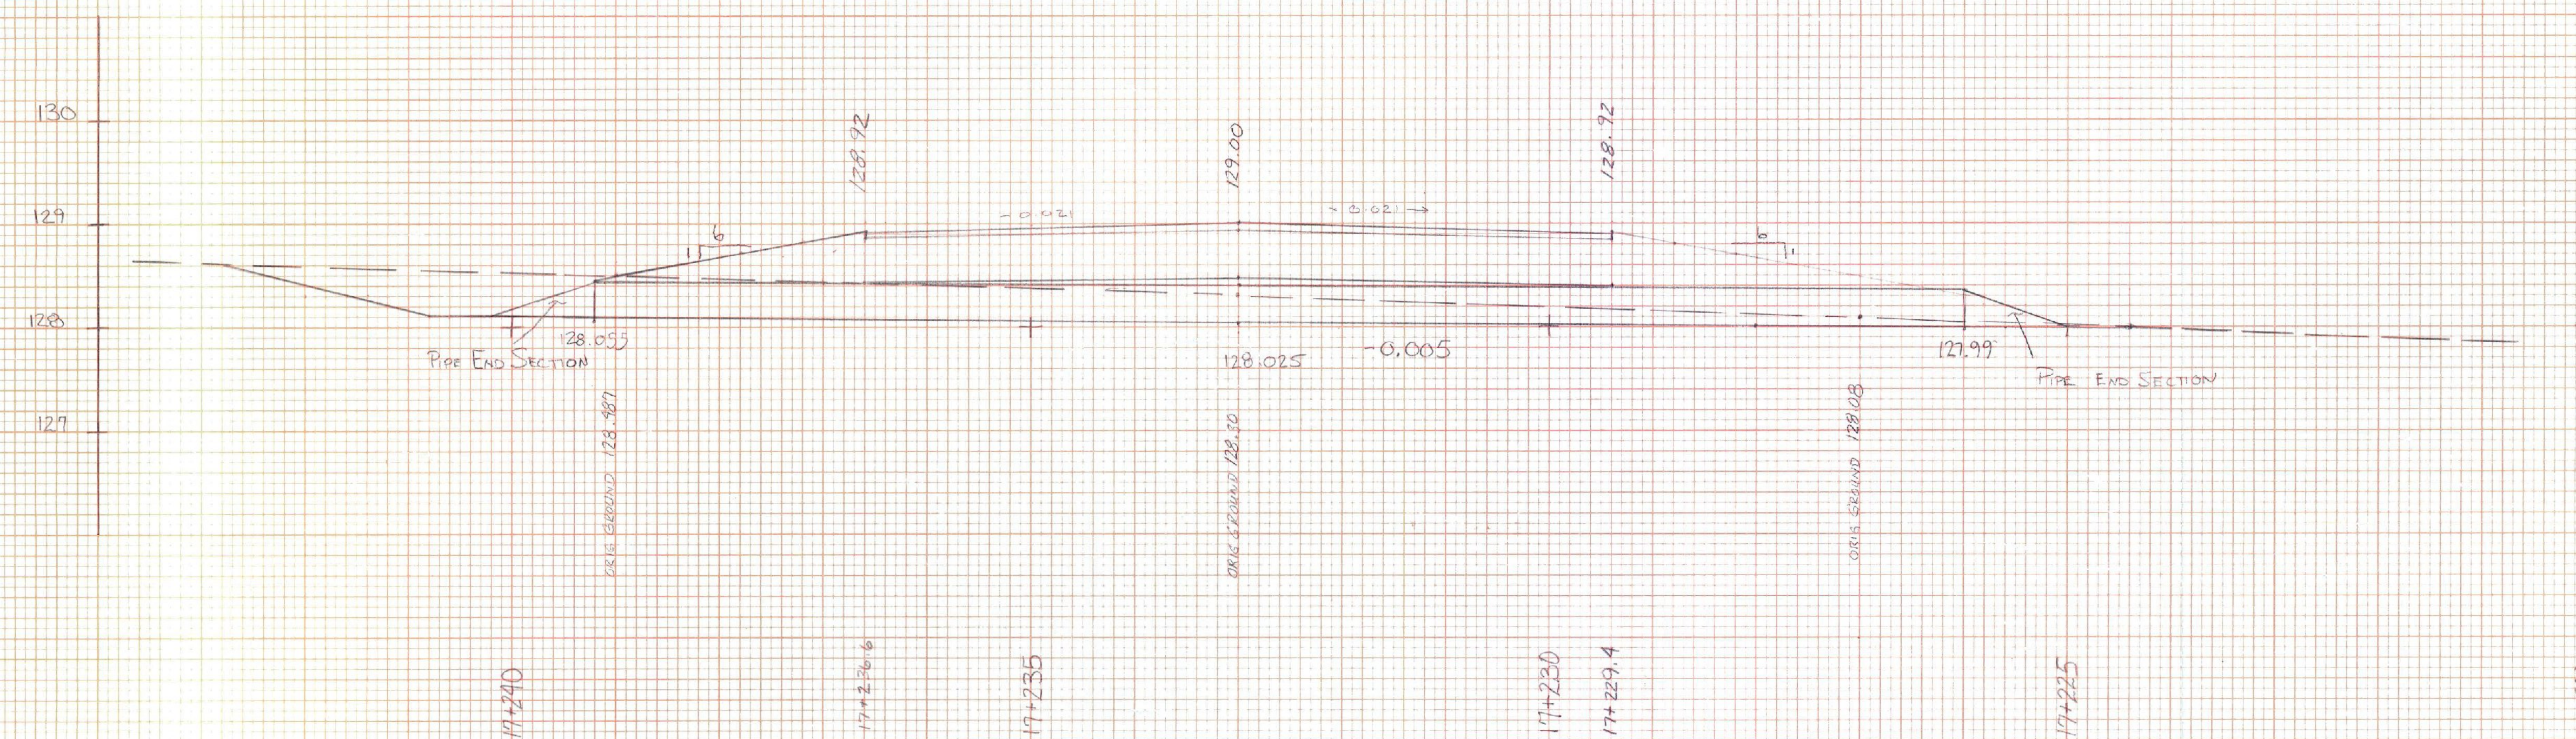

BRANDON NH 019-3(495)
G-STONE Motors DRIVE
SITUATION 17-233
SHEET 405B
BY: TIMOTHY POCKETTE 07-25-11