




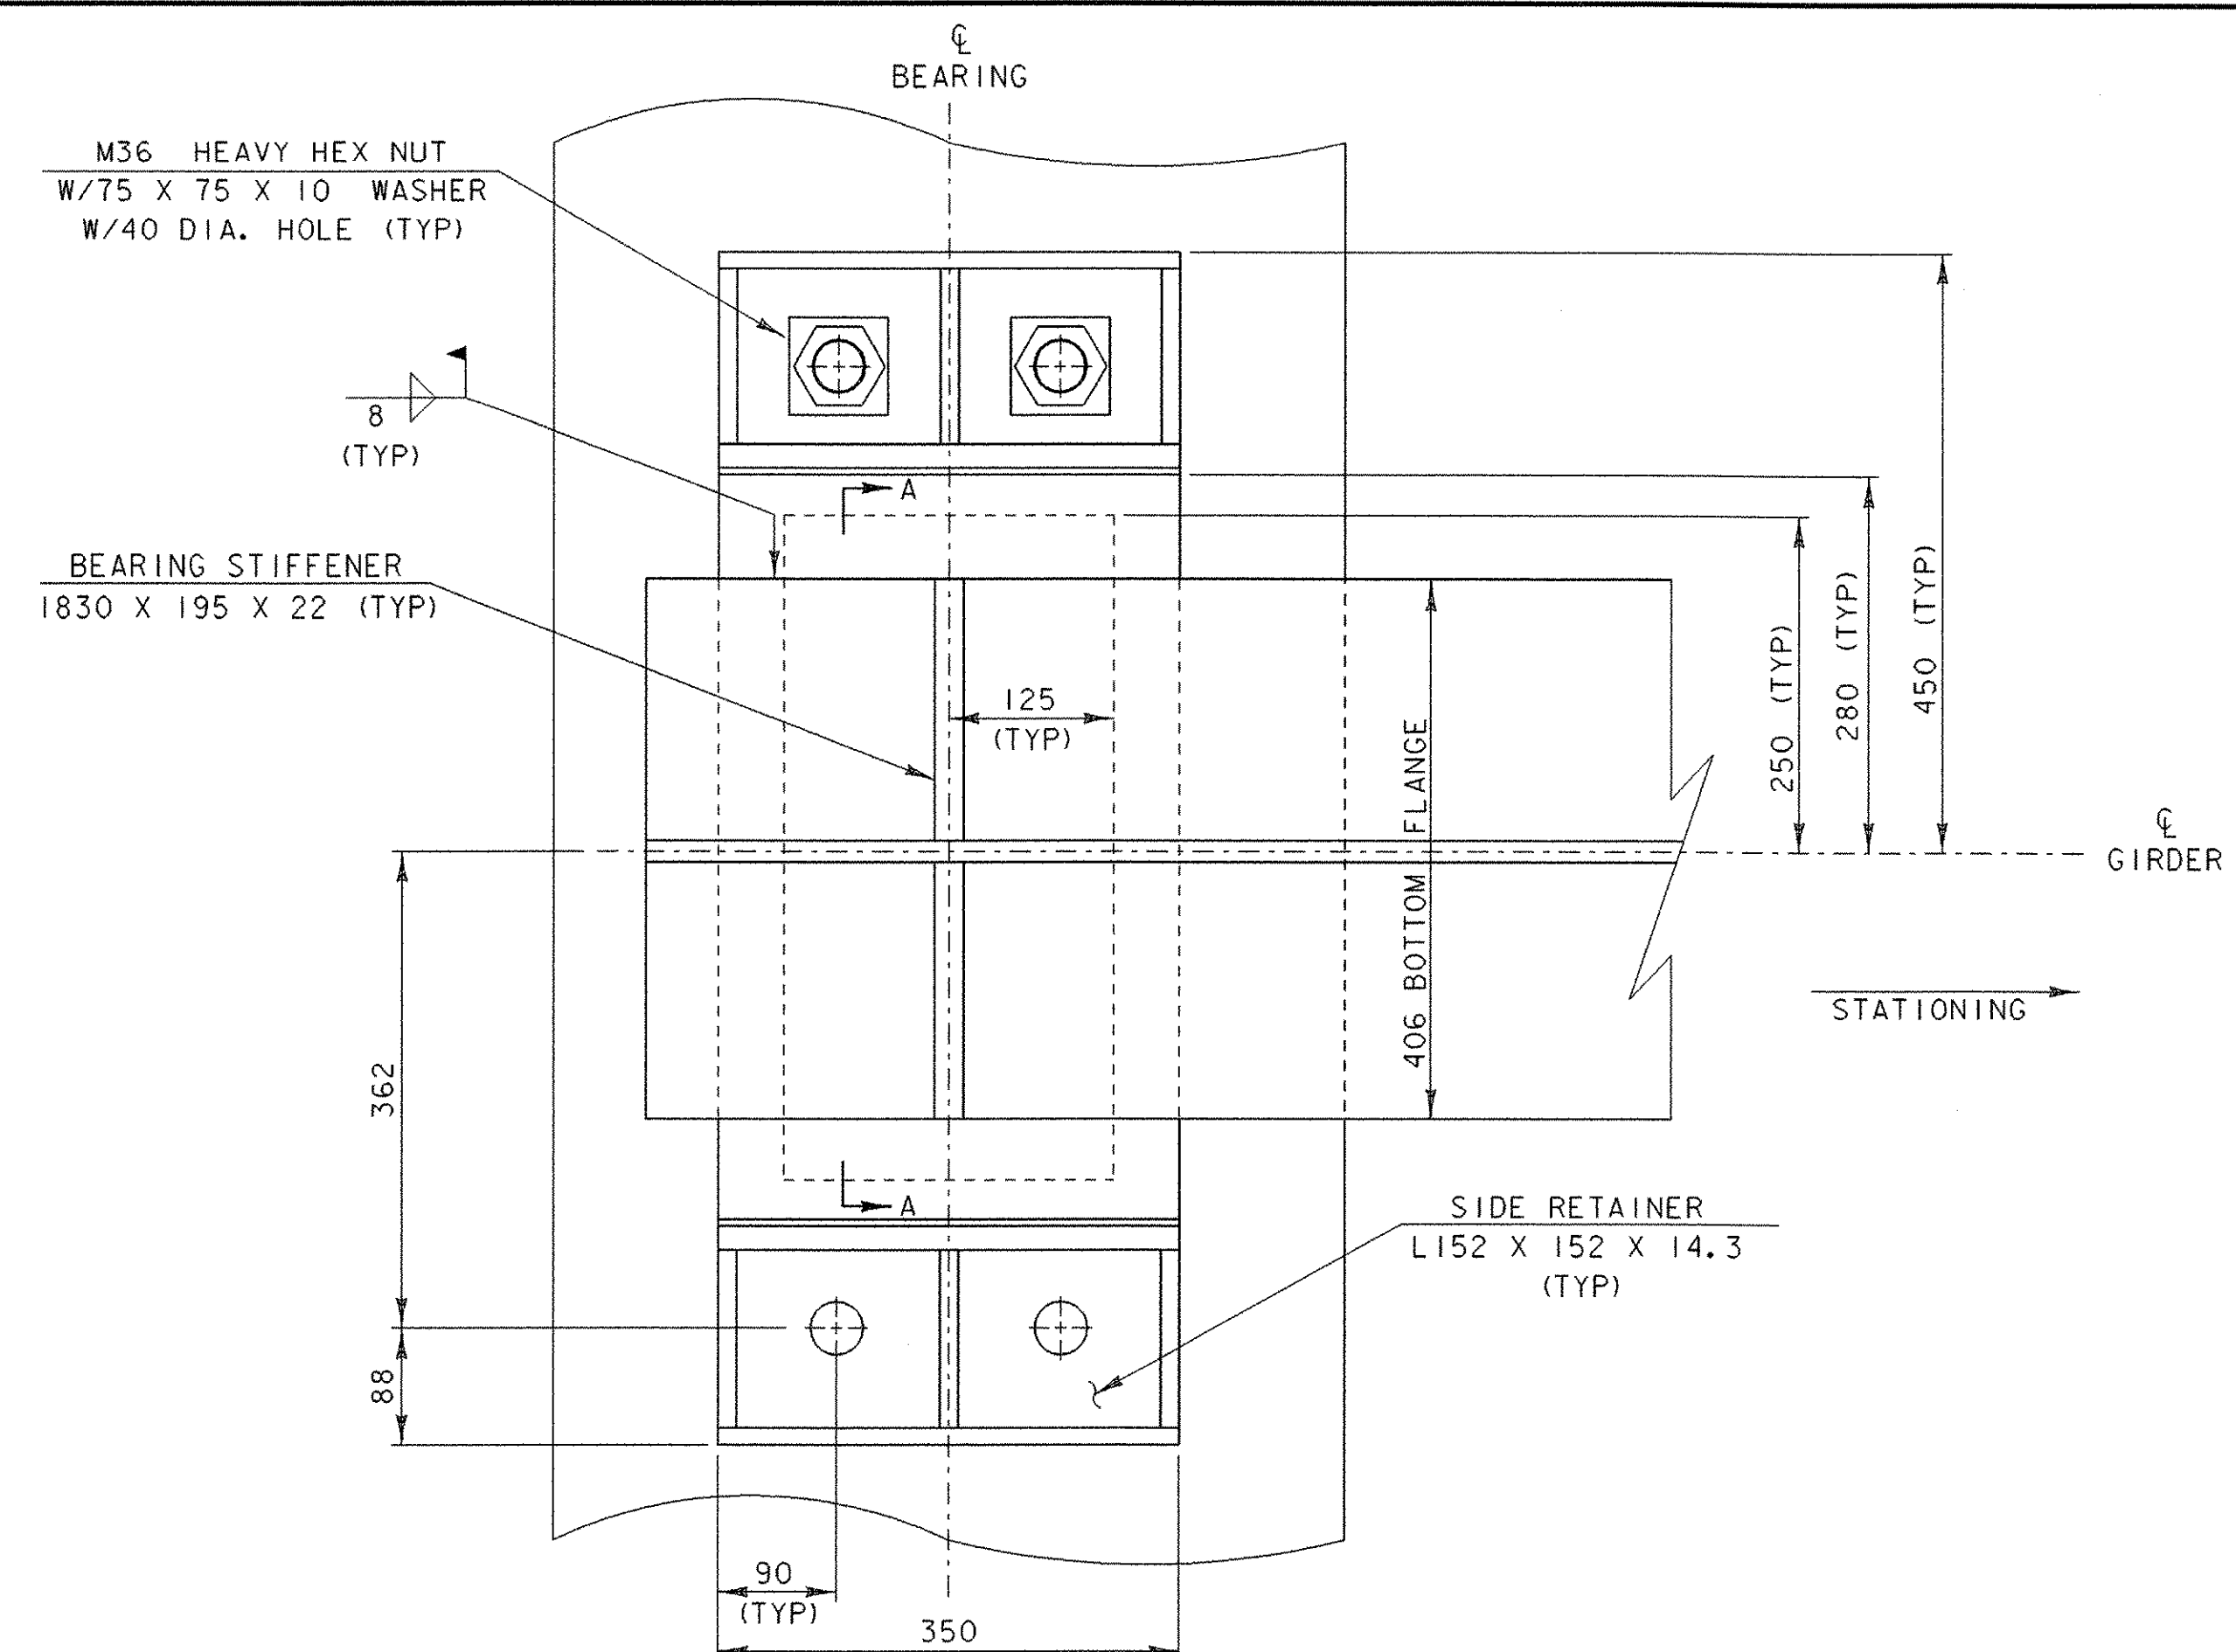


PLAN VIEW
SCALE 1 : 5

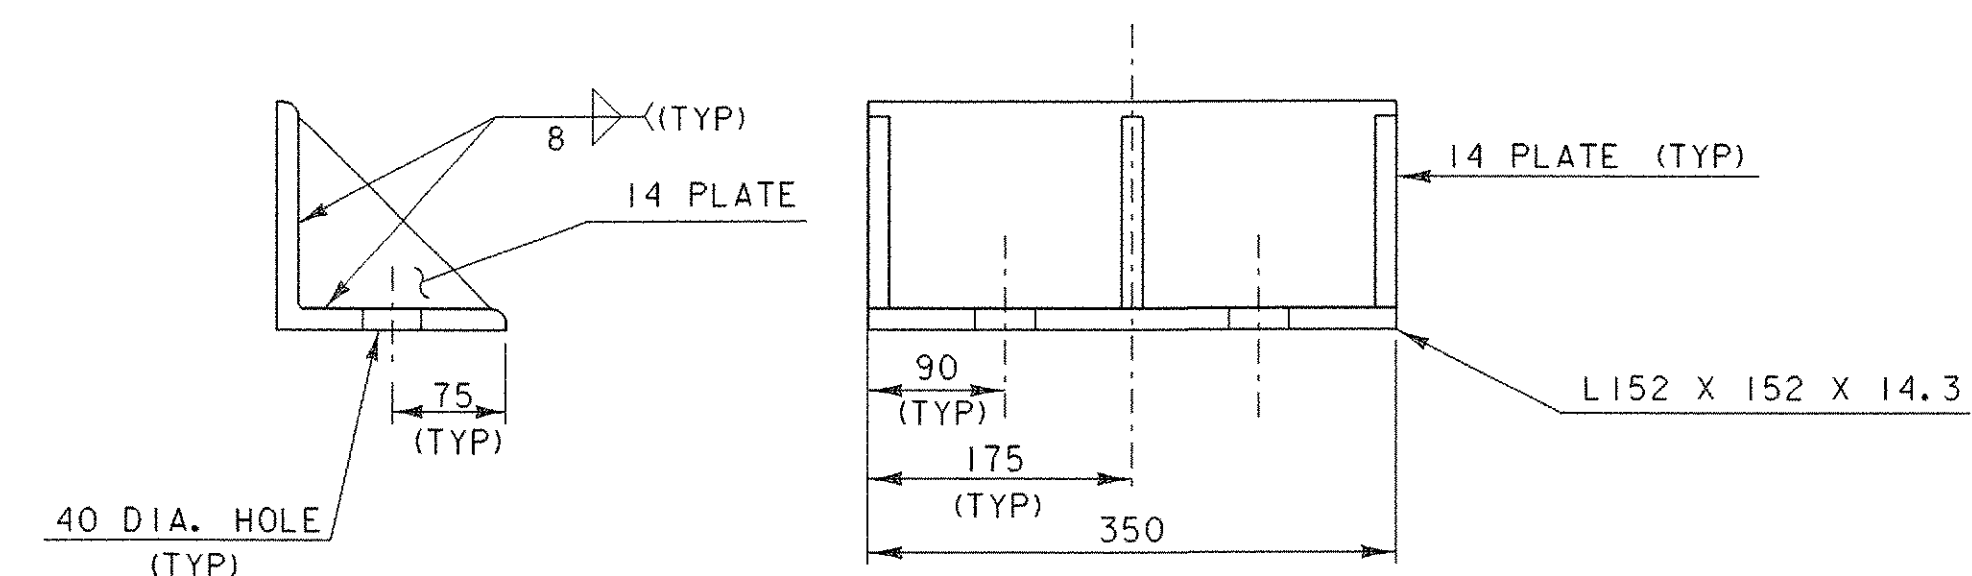

SIDE RETAINER
SCALE 1 : 5

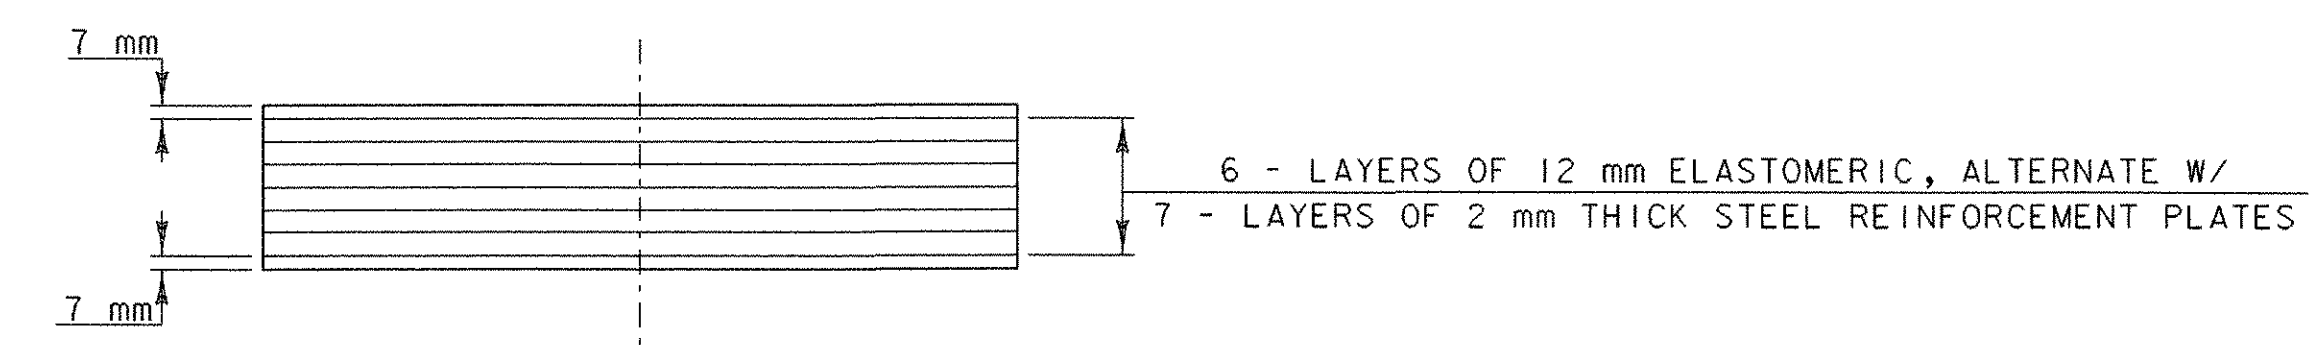


SECTION A-A
SCALE 1 : 5

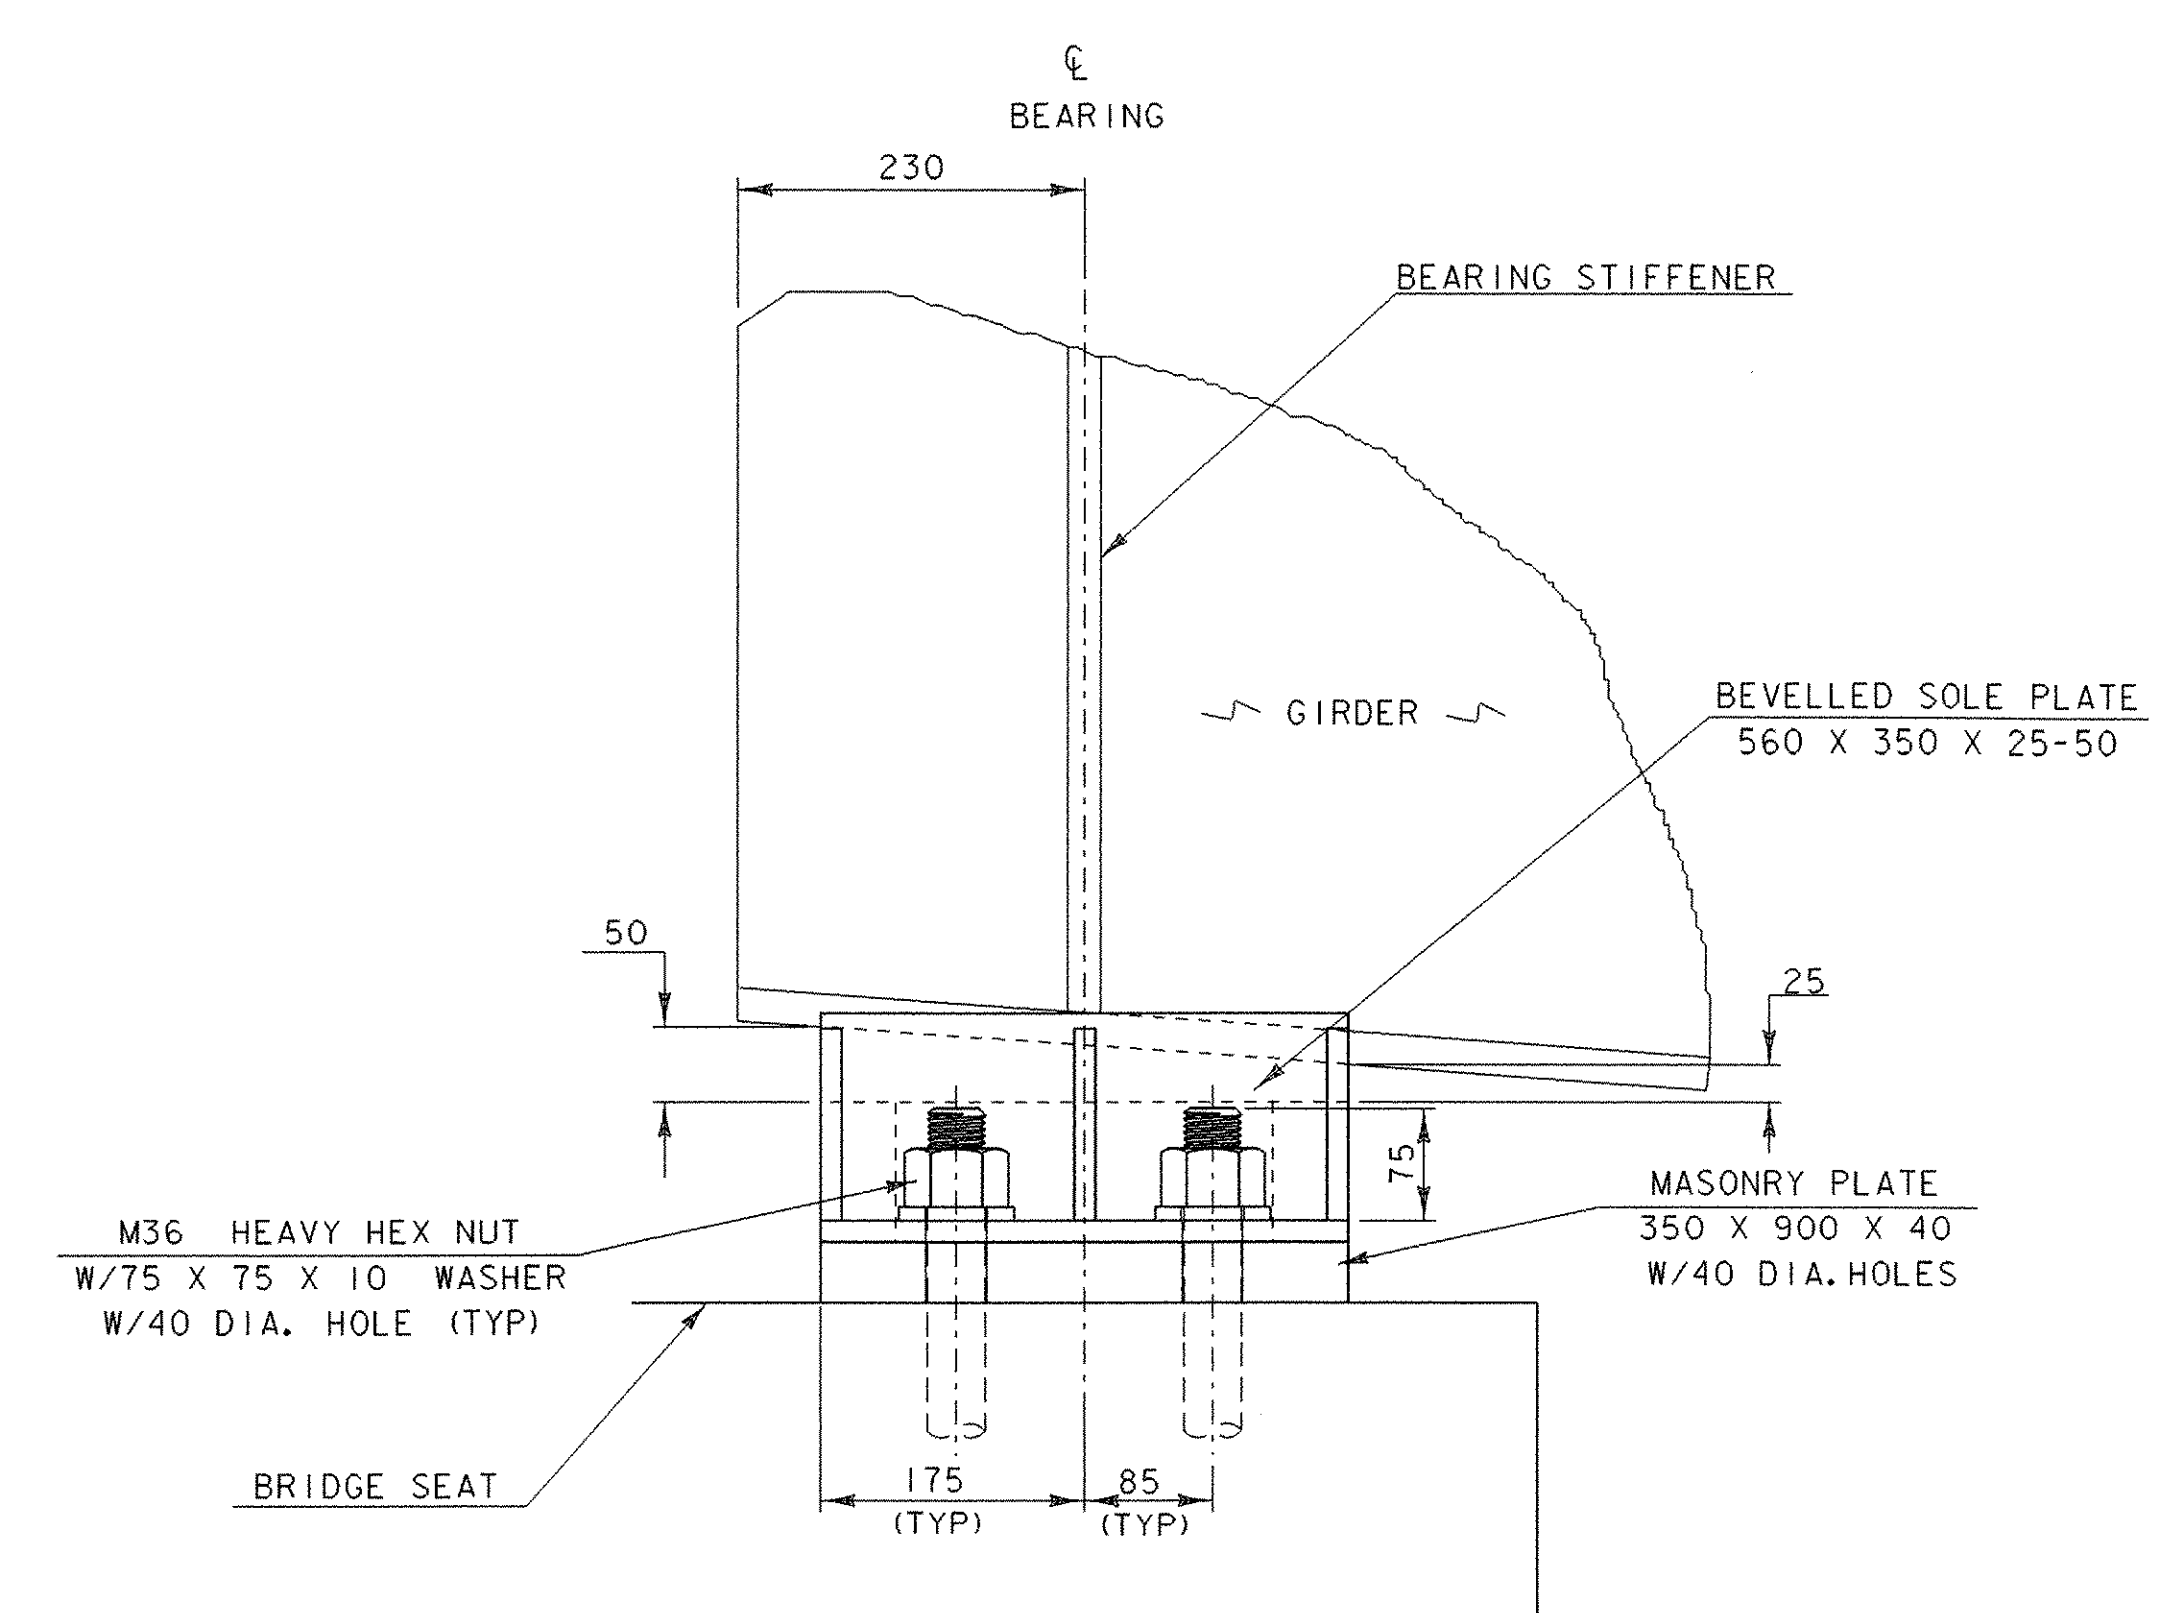

SIDE ELEVATION
SCALE 1 : 5

PIER EXPANSION BEARING DETAILS
0 0.25 0.5
SCALE = 1:5

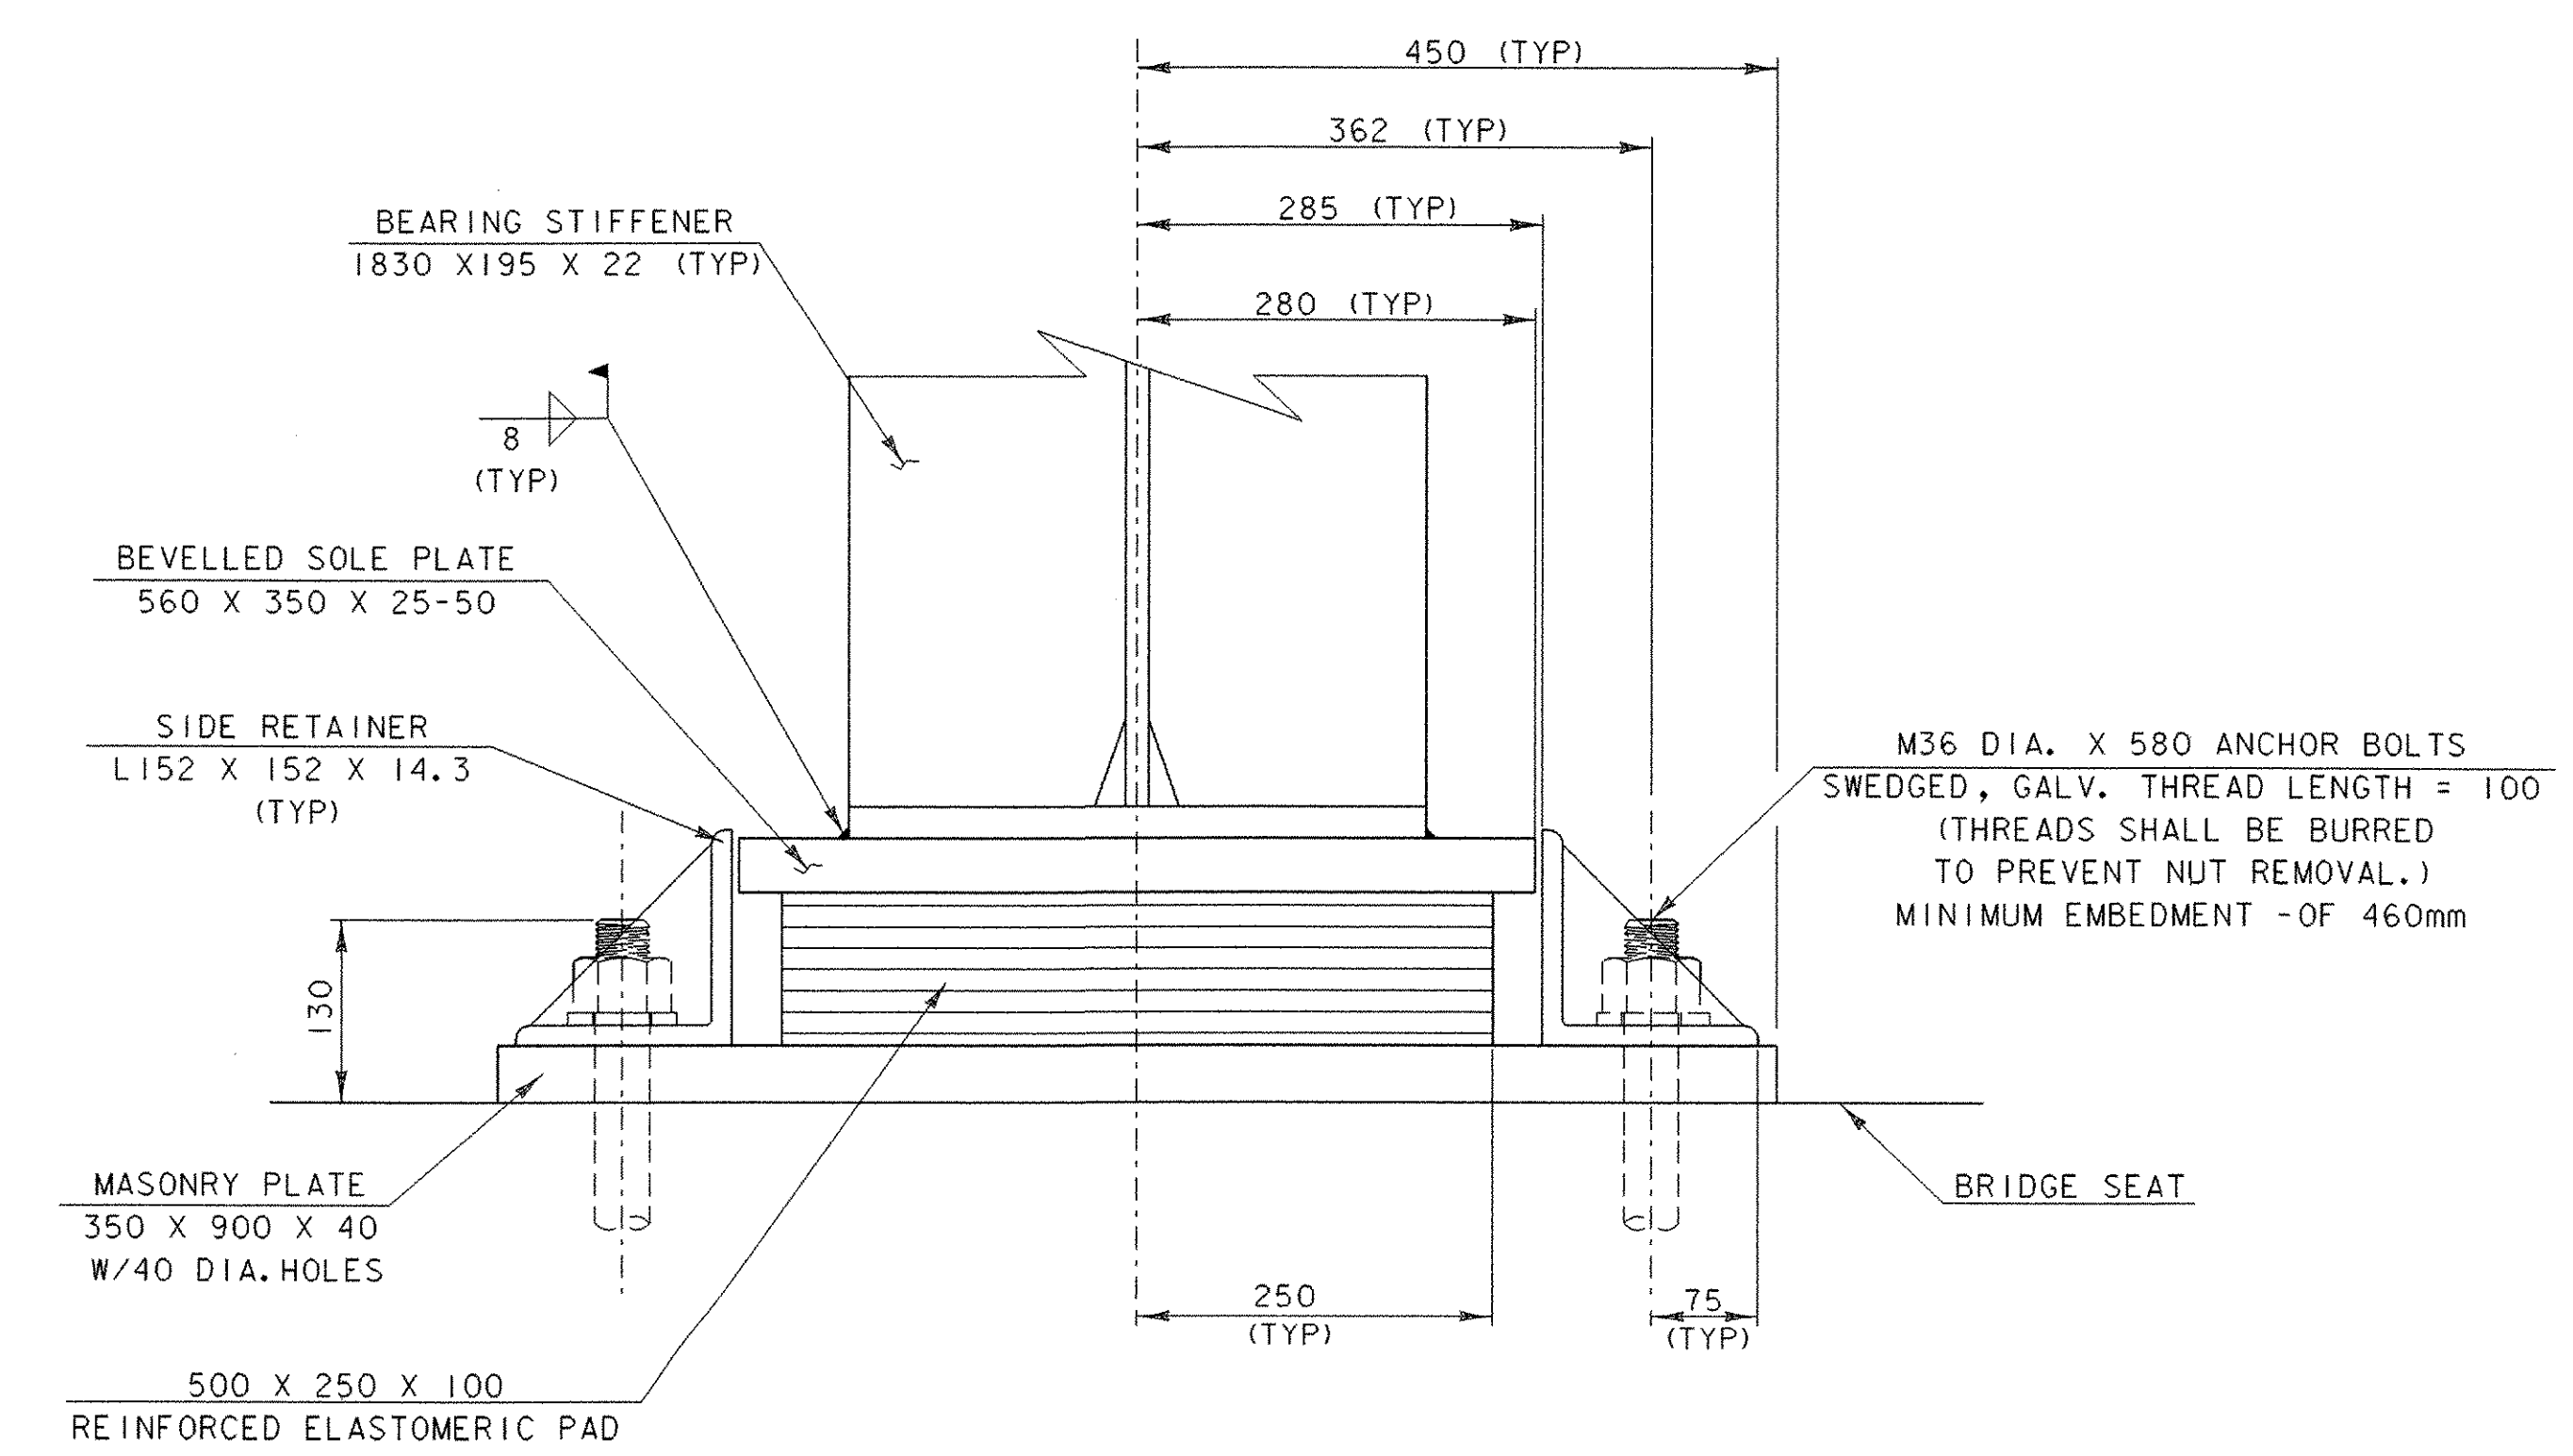

END ELEVATION
SCALE 1 : 5

SEE SHEET 43 FOR BEARING NOTES

PROJECT:	BETHEL	PROJECT NO.:	BRF0241 (33) C/2
DESIGN FILE NAME:	02c180/structures/s02c180brg.dgn	IPARM FILE NAME:	02c180expbrg.i
DESIGNED BY:	K. M. HIGGINS	DRAWN BY:	K. M. HIGGINS
SQUAD LEADER:	C. P. WILLIAMS	CHECKED BY:	M. LONGSTREET
EXPANSION BEARING DETAILS (PIER)		SHEET:	41 OF 130