



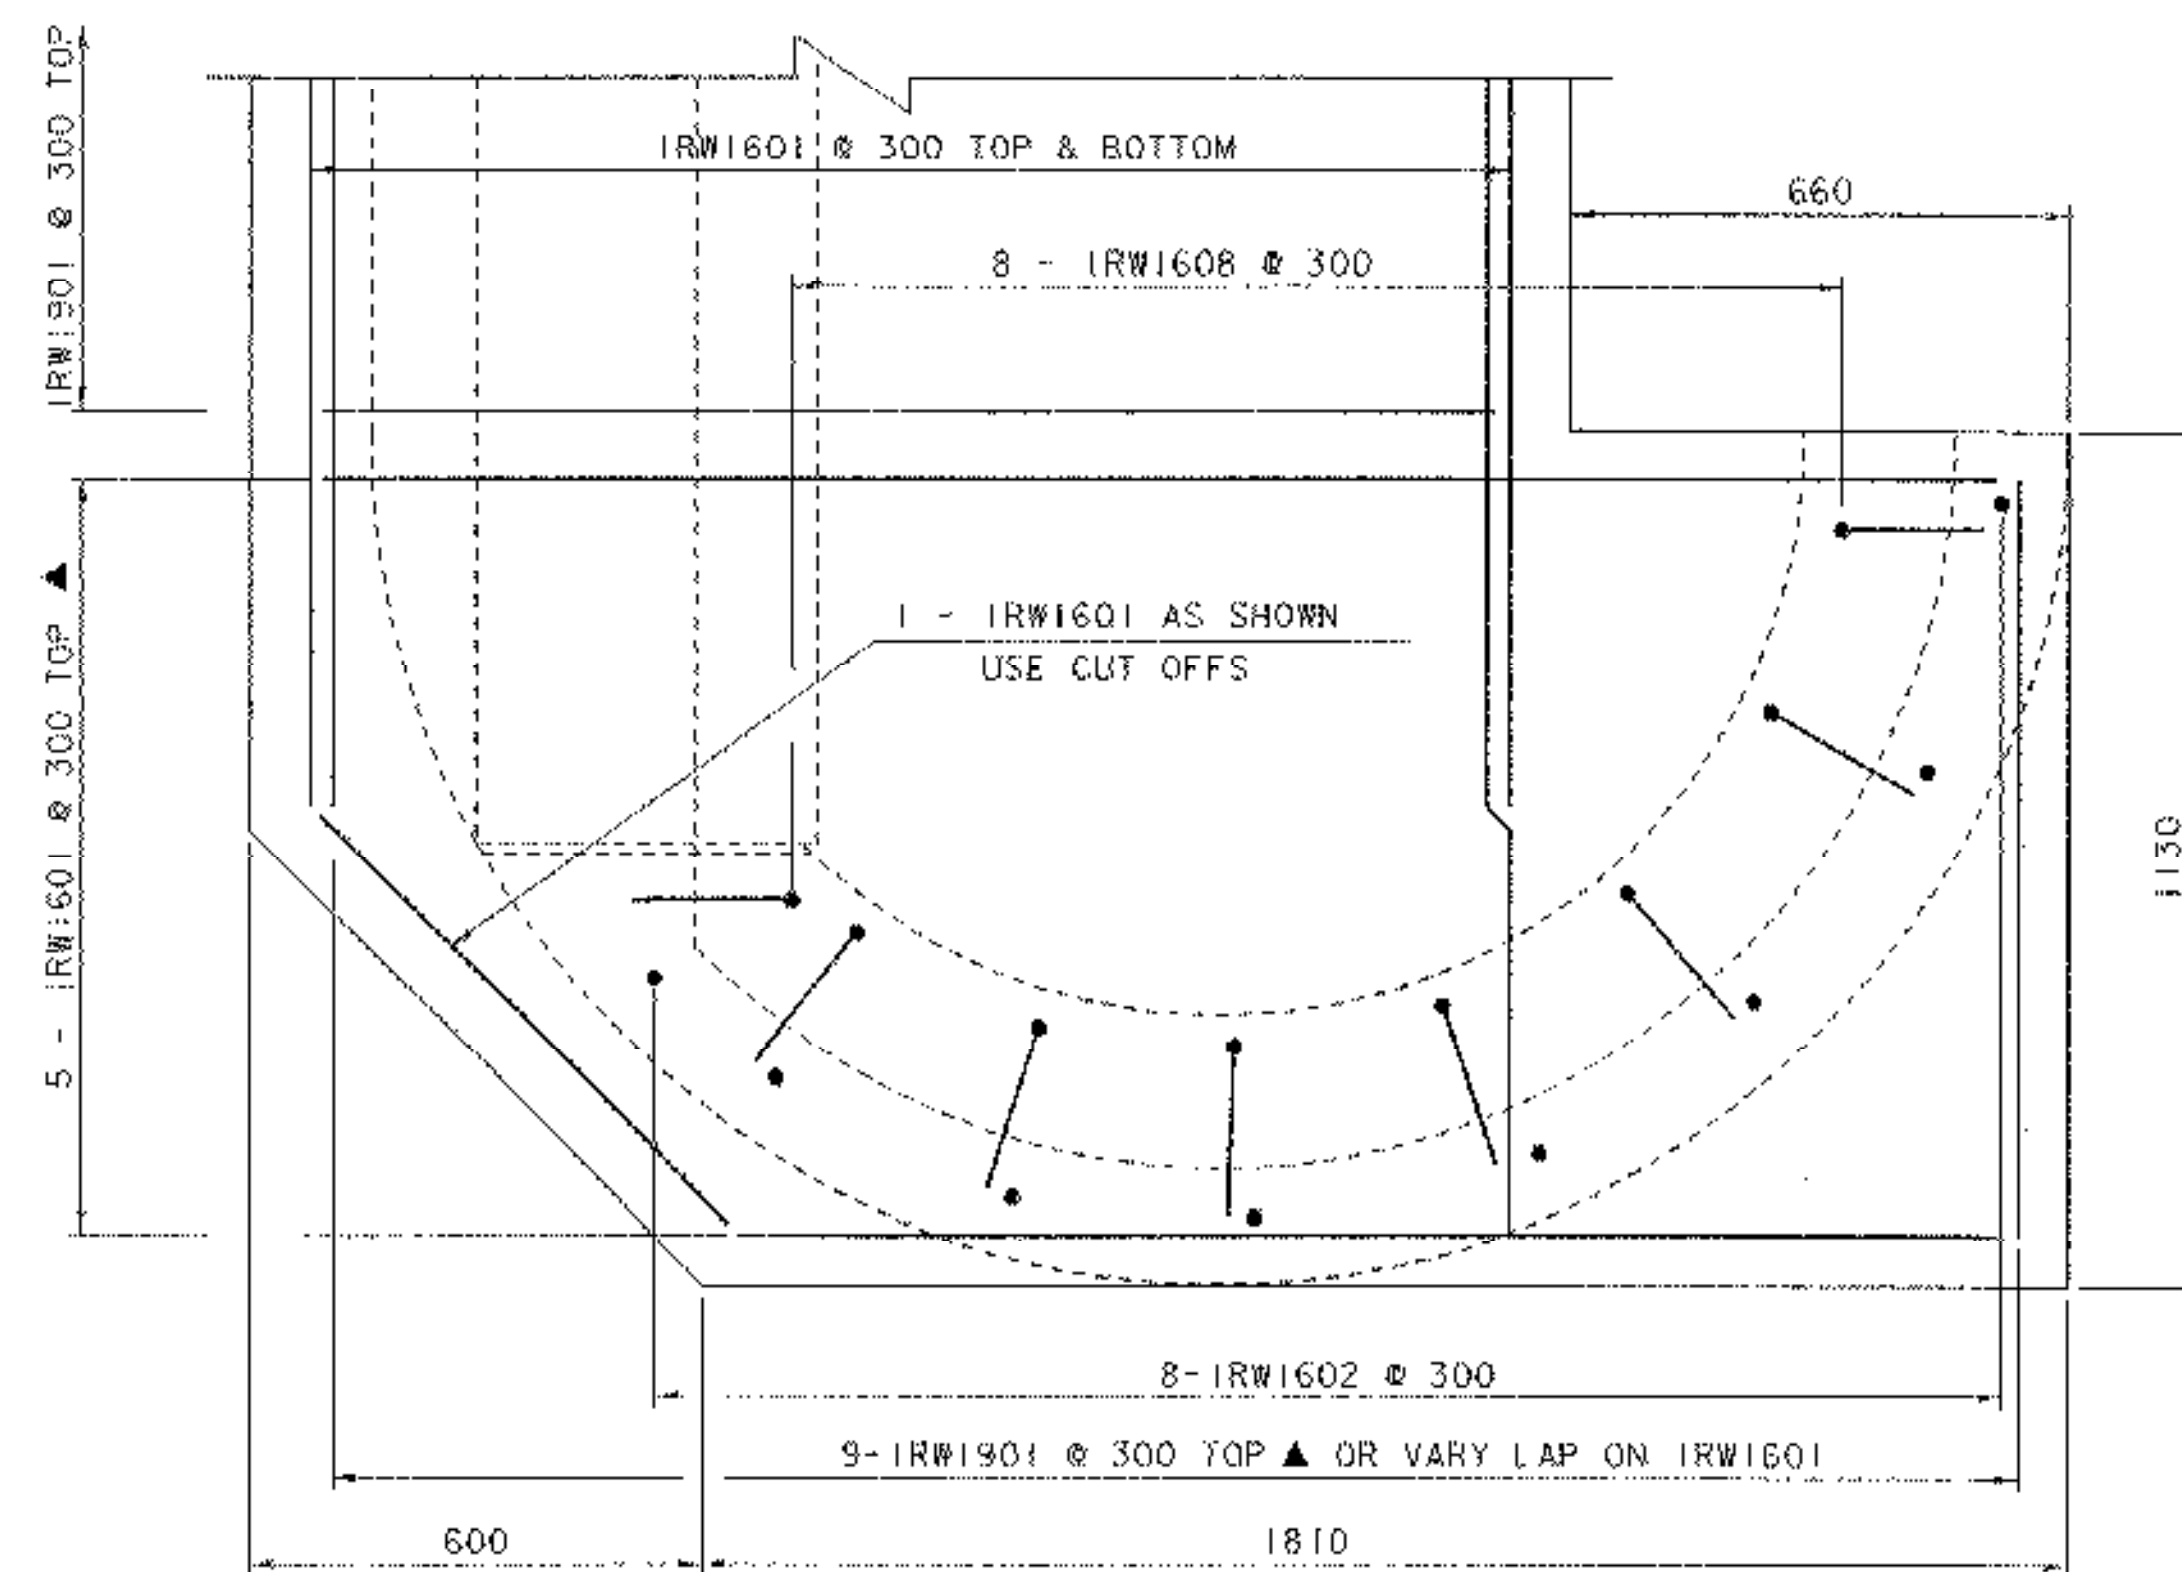


RETAINING WALL # 1-SEGMENT "E"
FOOTING REINFORCEMENT PLAN

SCALE 1 : 10

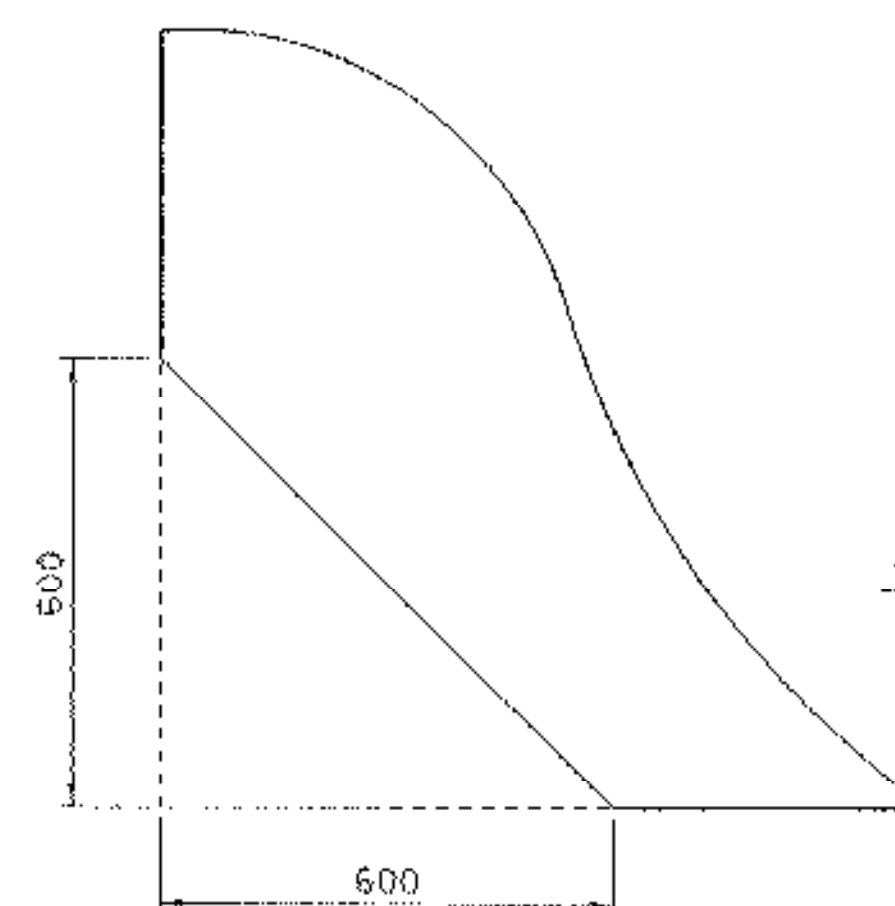


FOOTING CLIP DETAIL

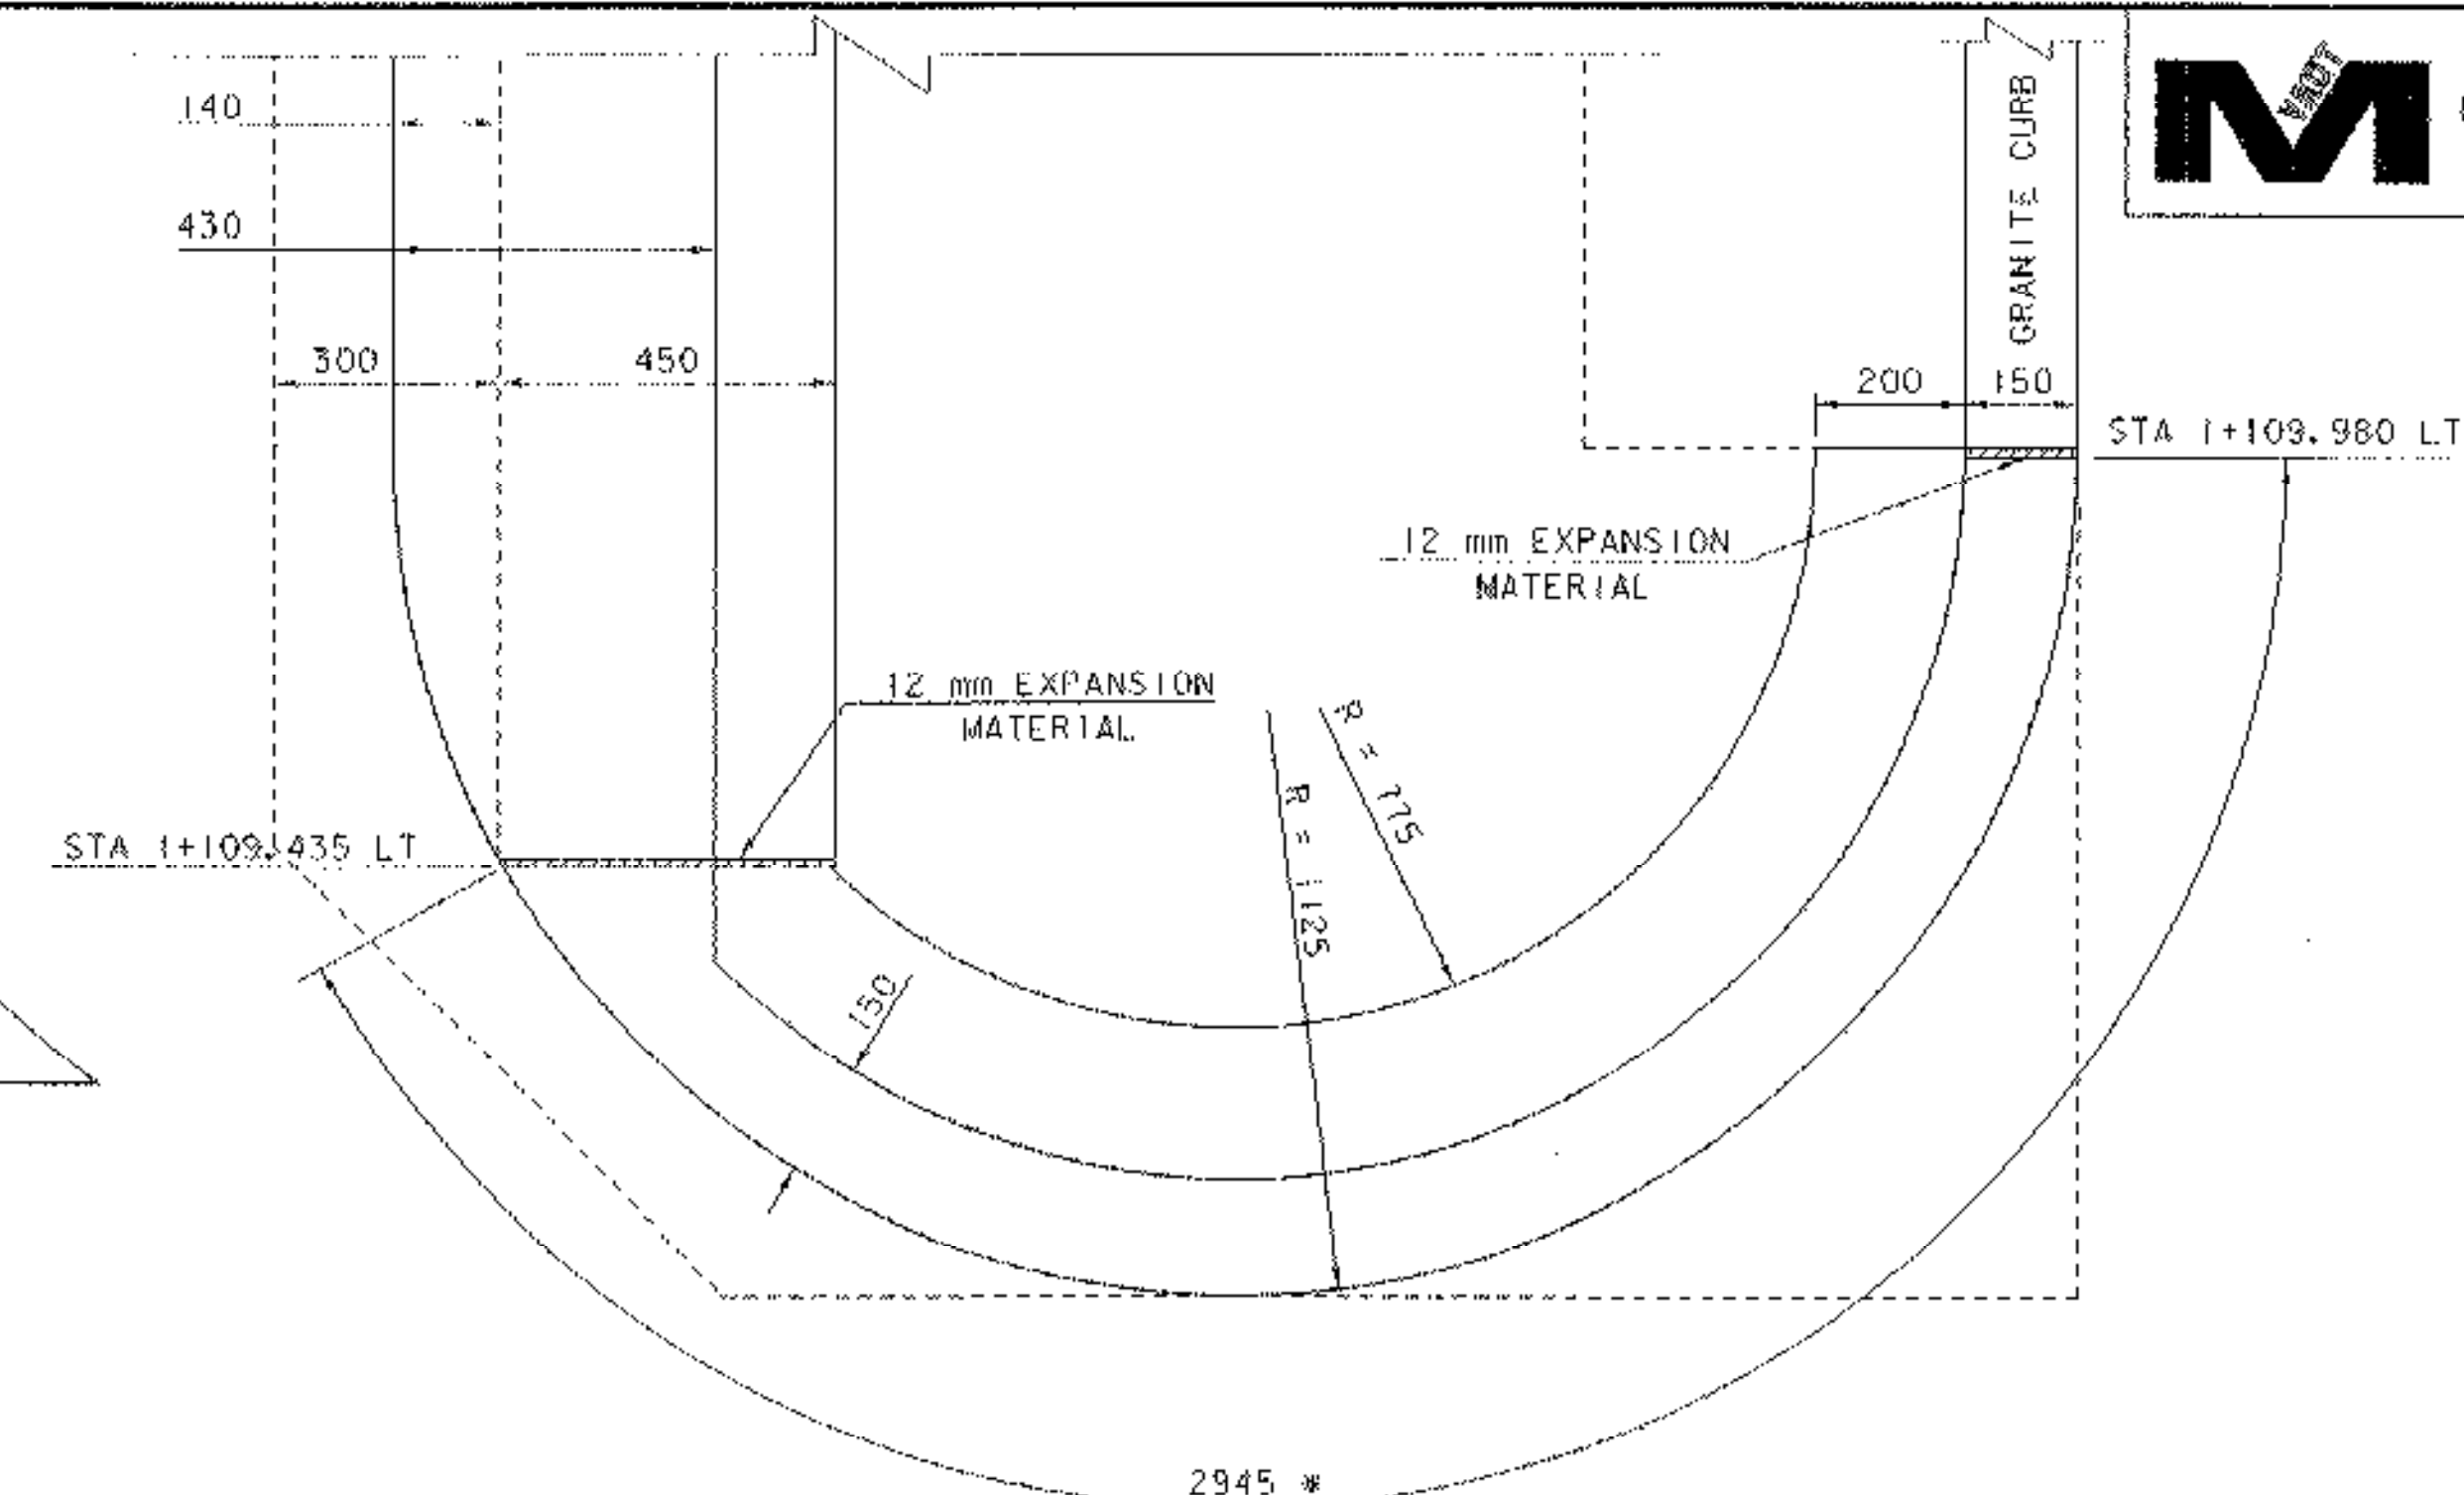

RETAINING WALL # 1-SEGMENT "E" PLAN


SCALE 1 : 10

* LENGTH MEASURED ALONG FACE OF WALL.
ADJUST LENGTH AS REQUIRED TO CONNECT
GRANITE CURB ON VT. RTE 12 AND TH66
RETAINING WALL.

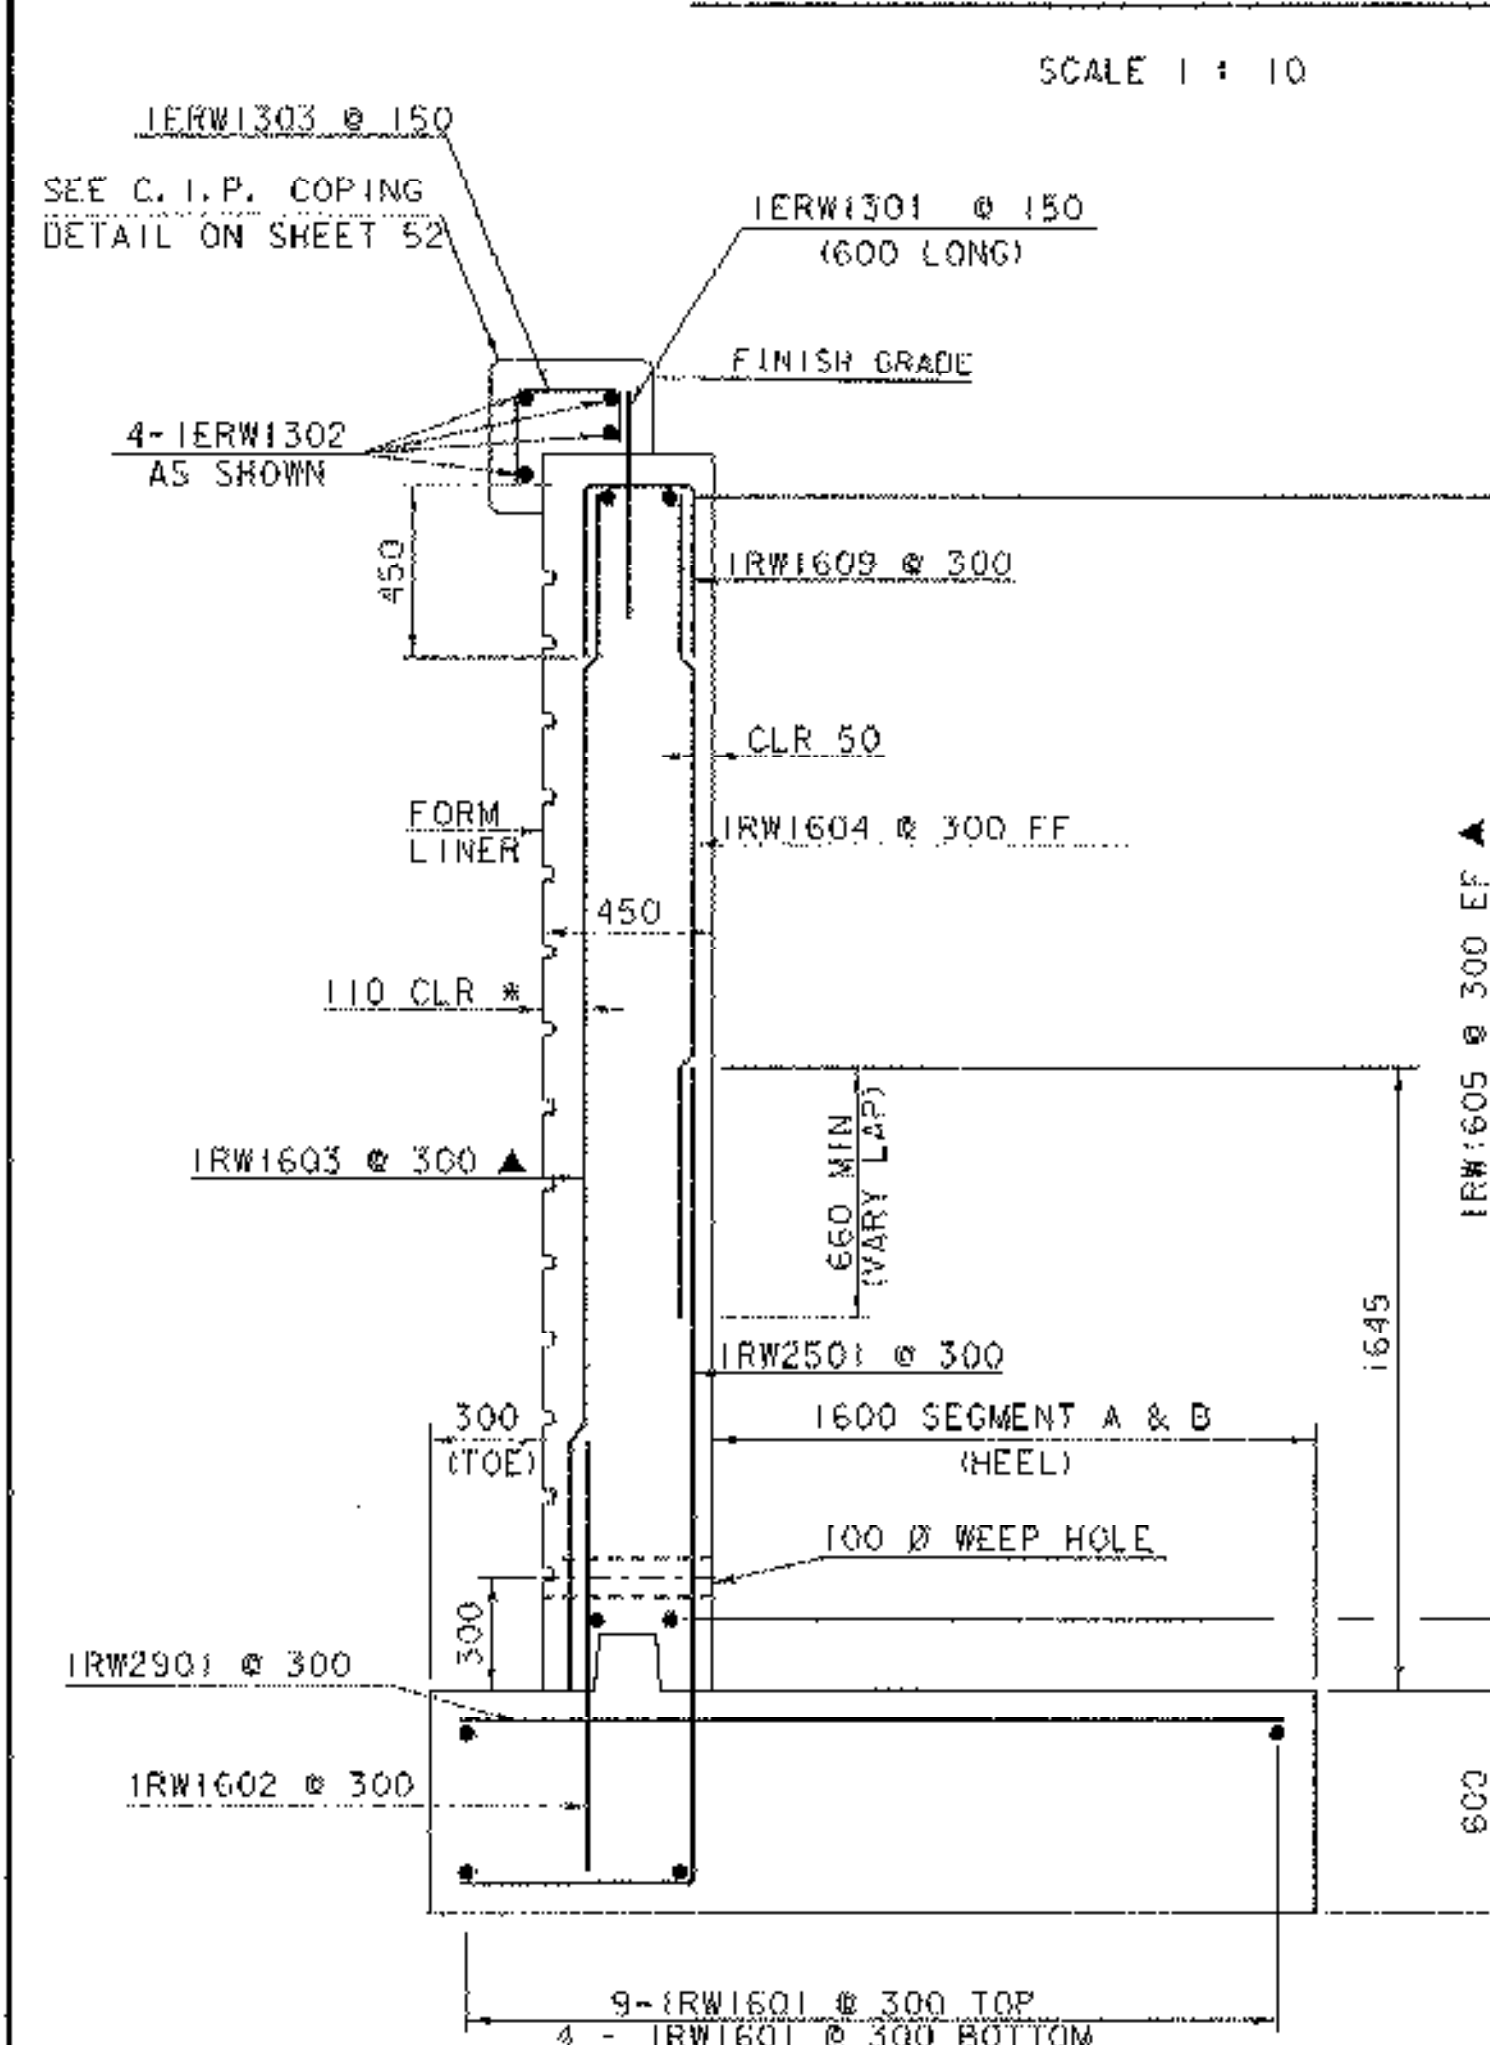

RETAINING WALL # 1
SEGMENTS A & B


SCALE 1 : 20

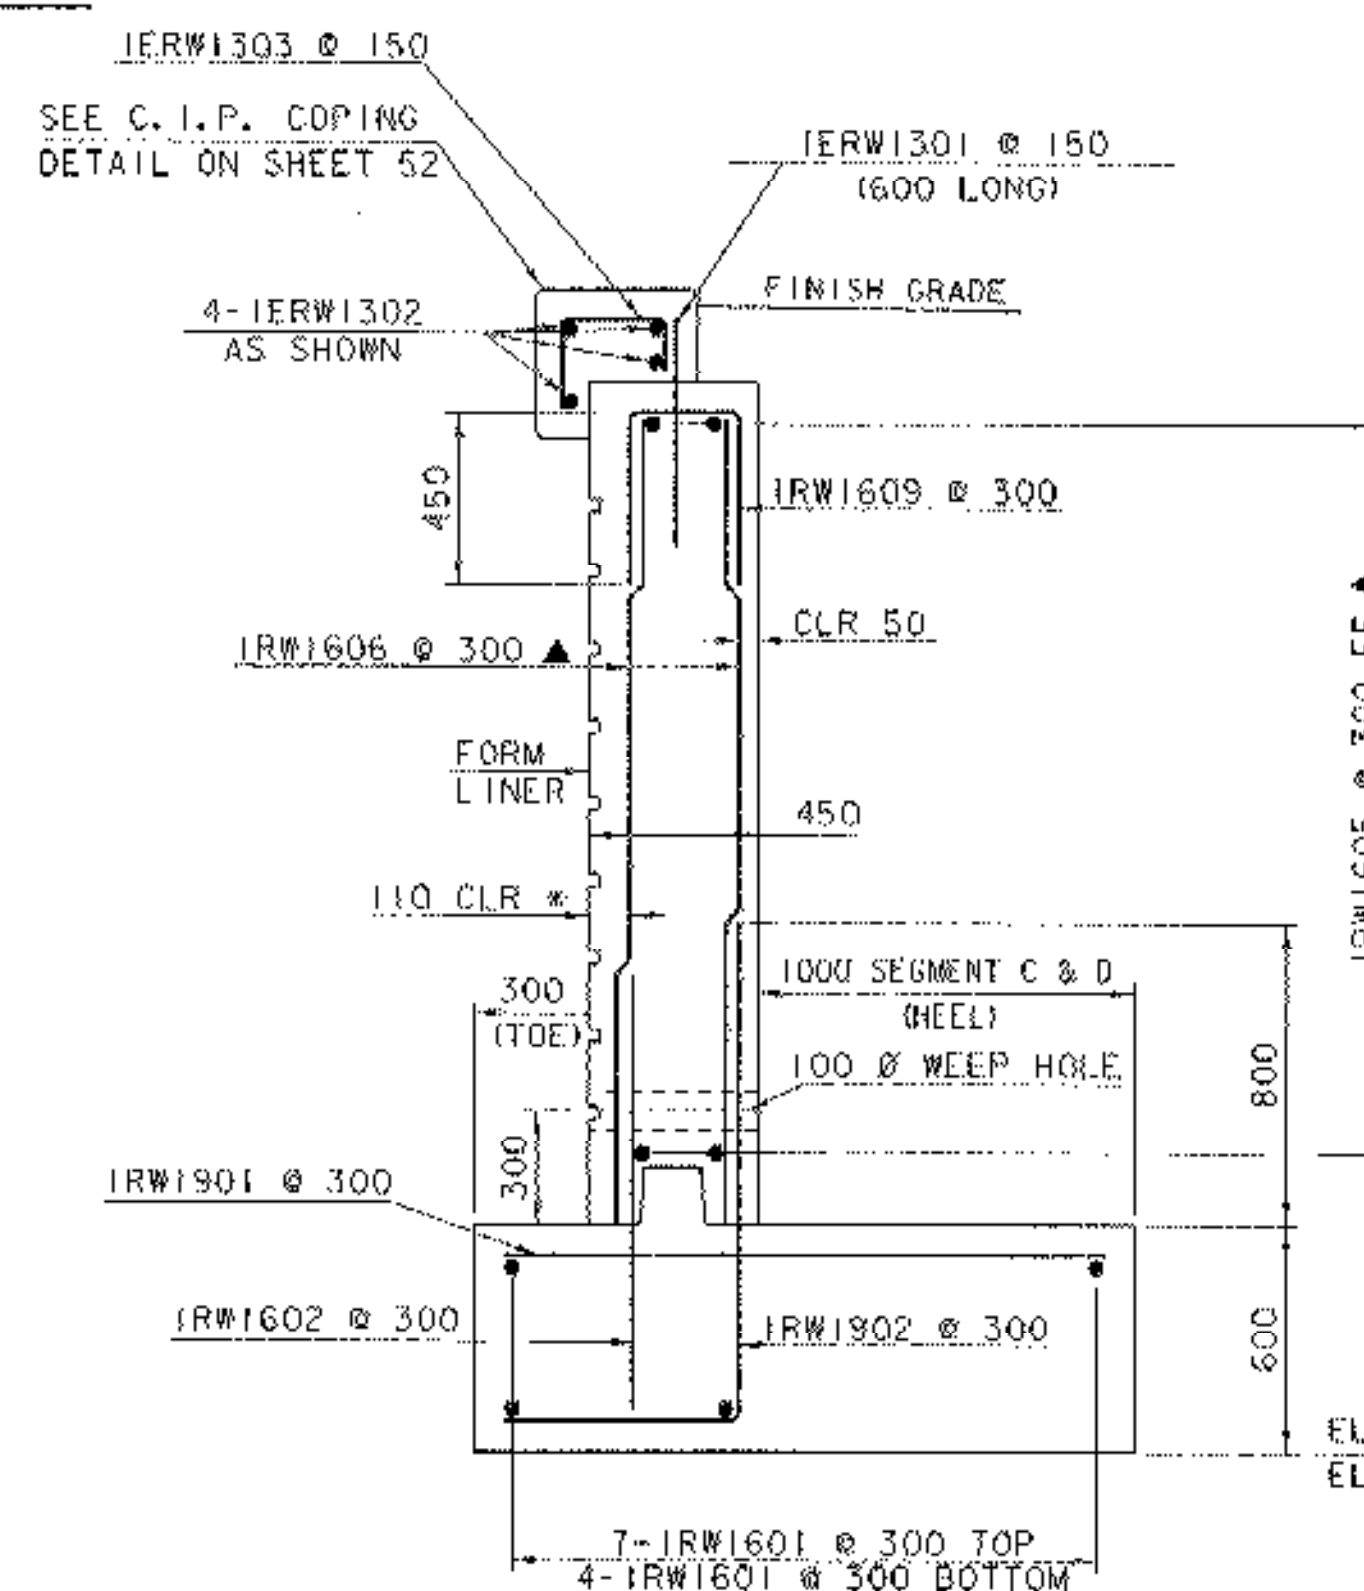

RETAINING WALL # 1
SEGMENTS C & D

SCALE 1 : 20


STA 1+109.435
END RETAINING WALL #1
SEGMENT "E"

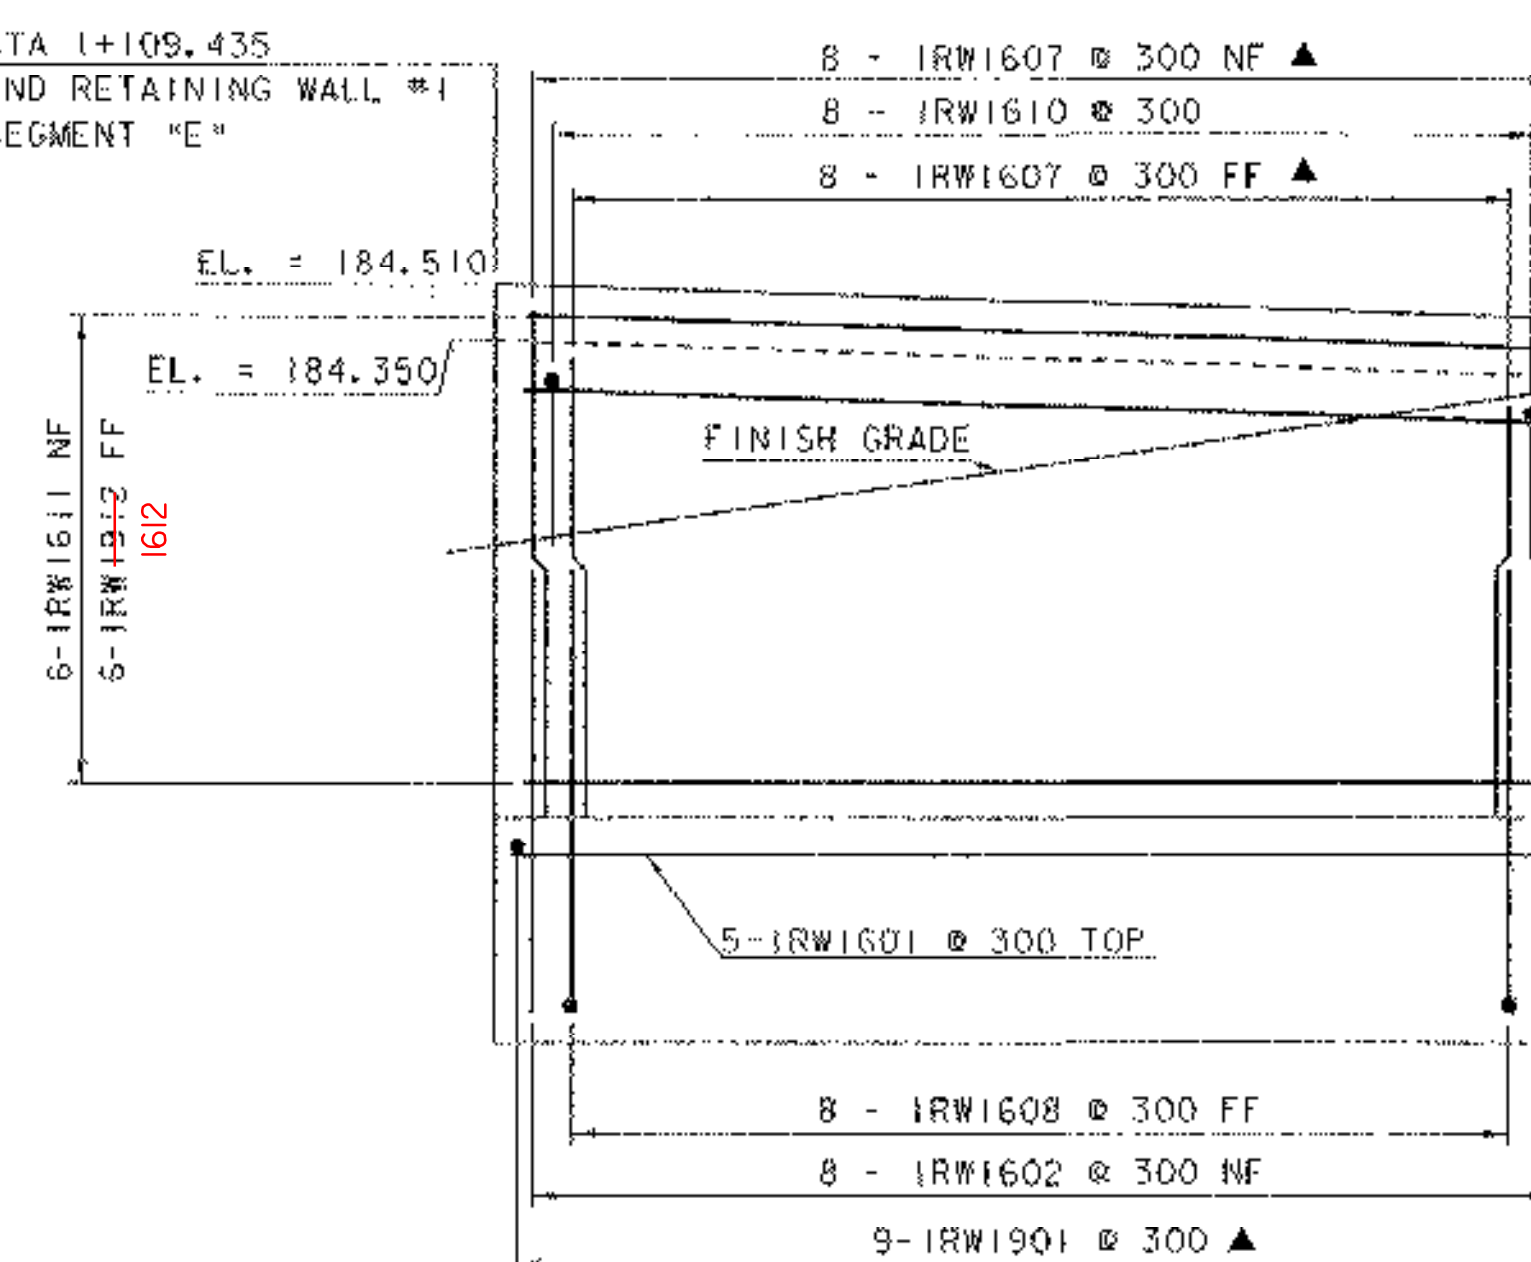

RETAINING WALL # 1-SEGMENT "E"
ELEVATION VIEW

SCALE 1 : 20

STA 1+109.980 LT
BEGIN RETAINING WALL #1
SEGMENT "E"

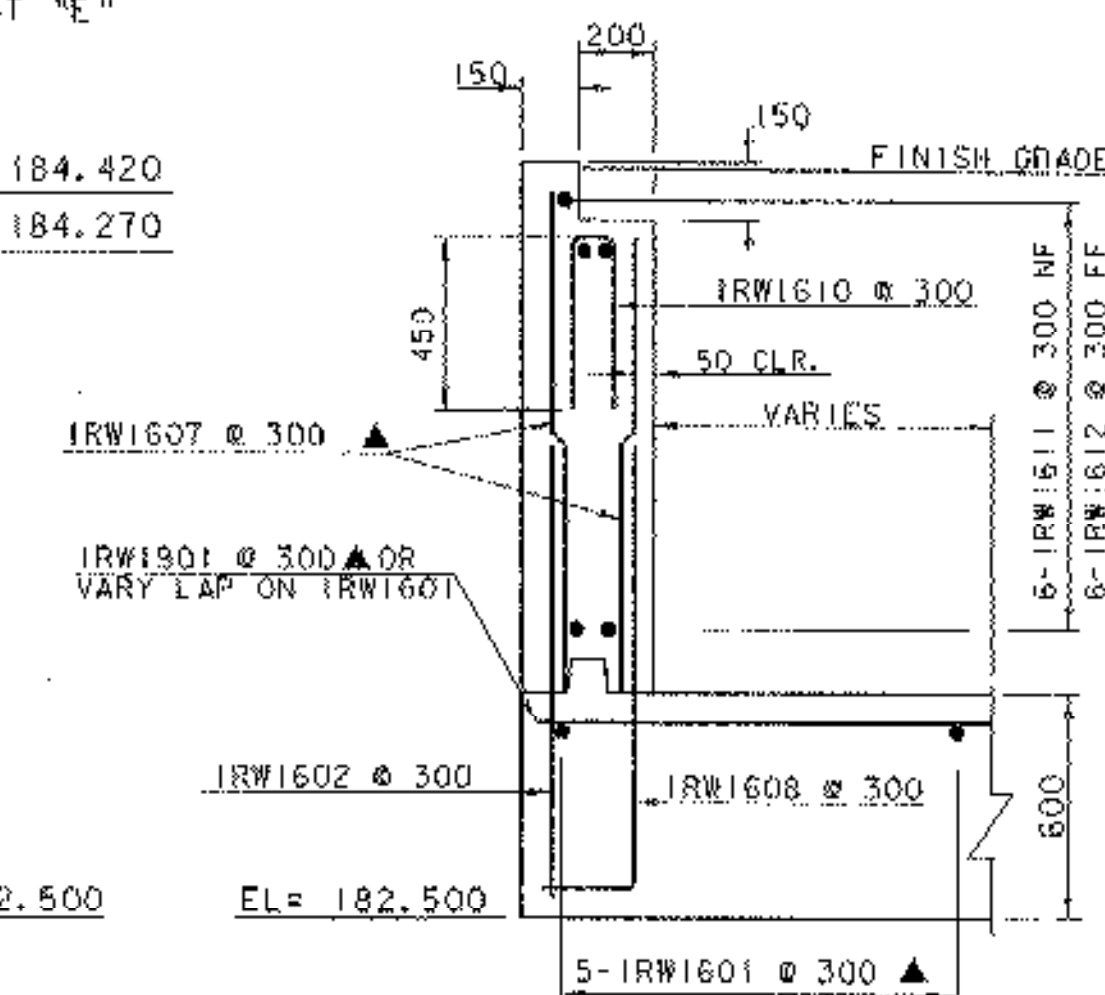


RETAINING WALL # 1-SEGMENT "E"
TYPICAL SECTION

SCALE 1 : 20



SCALE = 1:20

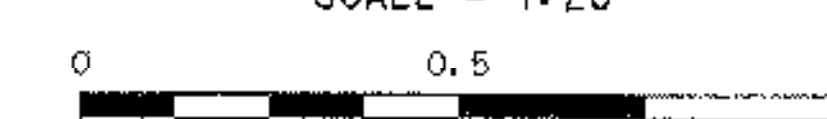

SCALE = 1:10

* CLEAR COVER INCLUDES 30 mm FOR
MAXIMUM FORM LINER RELIEF

NOTE:

NF = NEAR FACE
FF = FAR FACE
EF = EACH FACE
▲ = CUT TO FIT IN FIELD
80 CLR. UNLESS OTHERWISE
SPECIFIED ON THE PLANS.

PROJECT:	BETHEL	PROJECT NO.:	BRF0241 (33) C/2
DESIGN FILE NAME:	02c180/structures/s02c180retainingwall.dgn		
IPARM FILE NAME:	s02c180retwall-2	PLOT DATE:	14-APR-2005
DESIGNED BY:	M. GAGULIC	DRAWN BY:	M. FESSEI
SQUAD LEADER:	C.P. WILLIAMS	CHECKED BY:	M. GAGULIC
RETAINING WALL 1 DETAILS		SHEET:	68 OF 130