




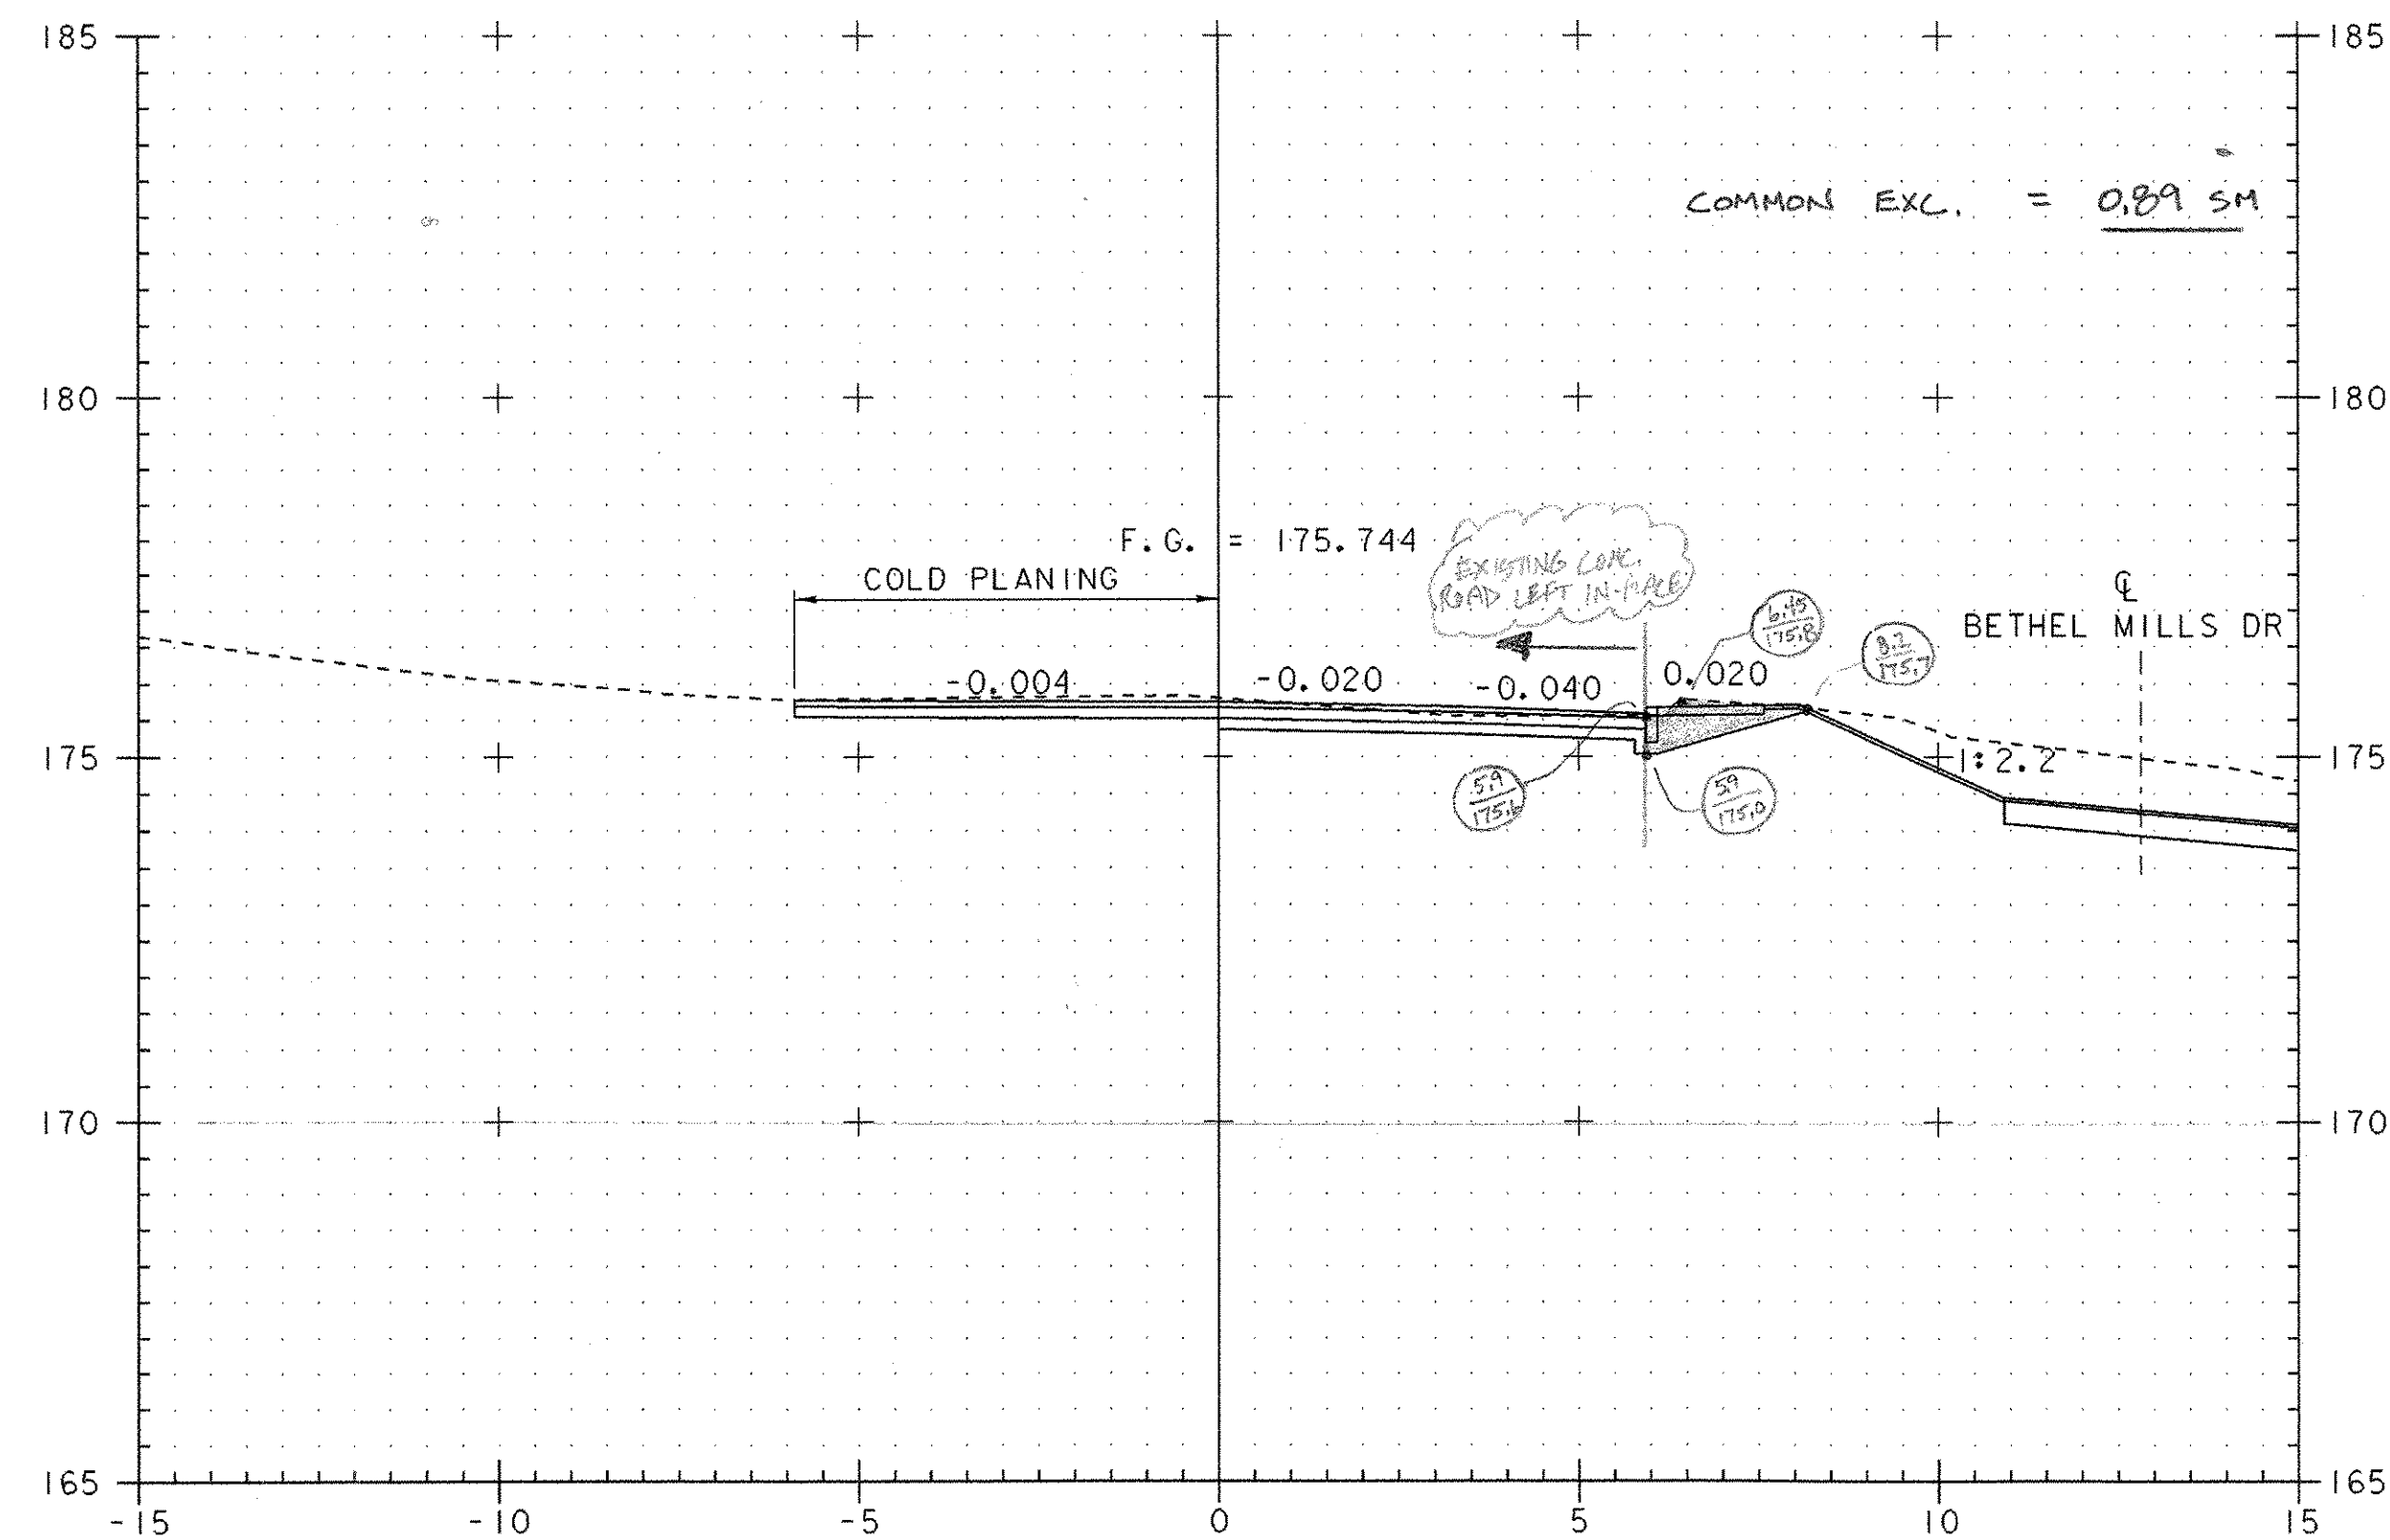


1+280
BEGIN COLD PLANING

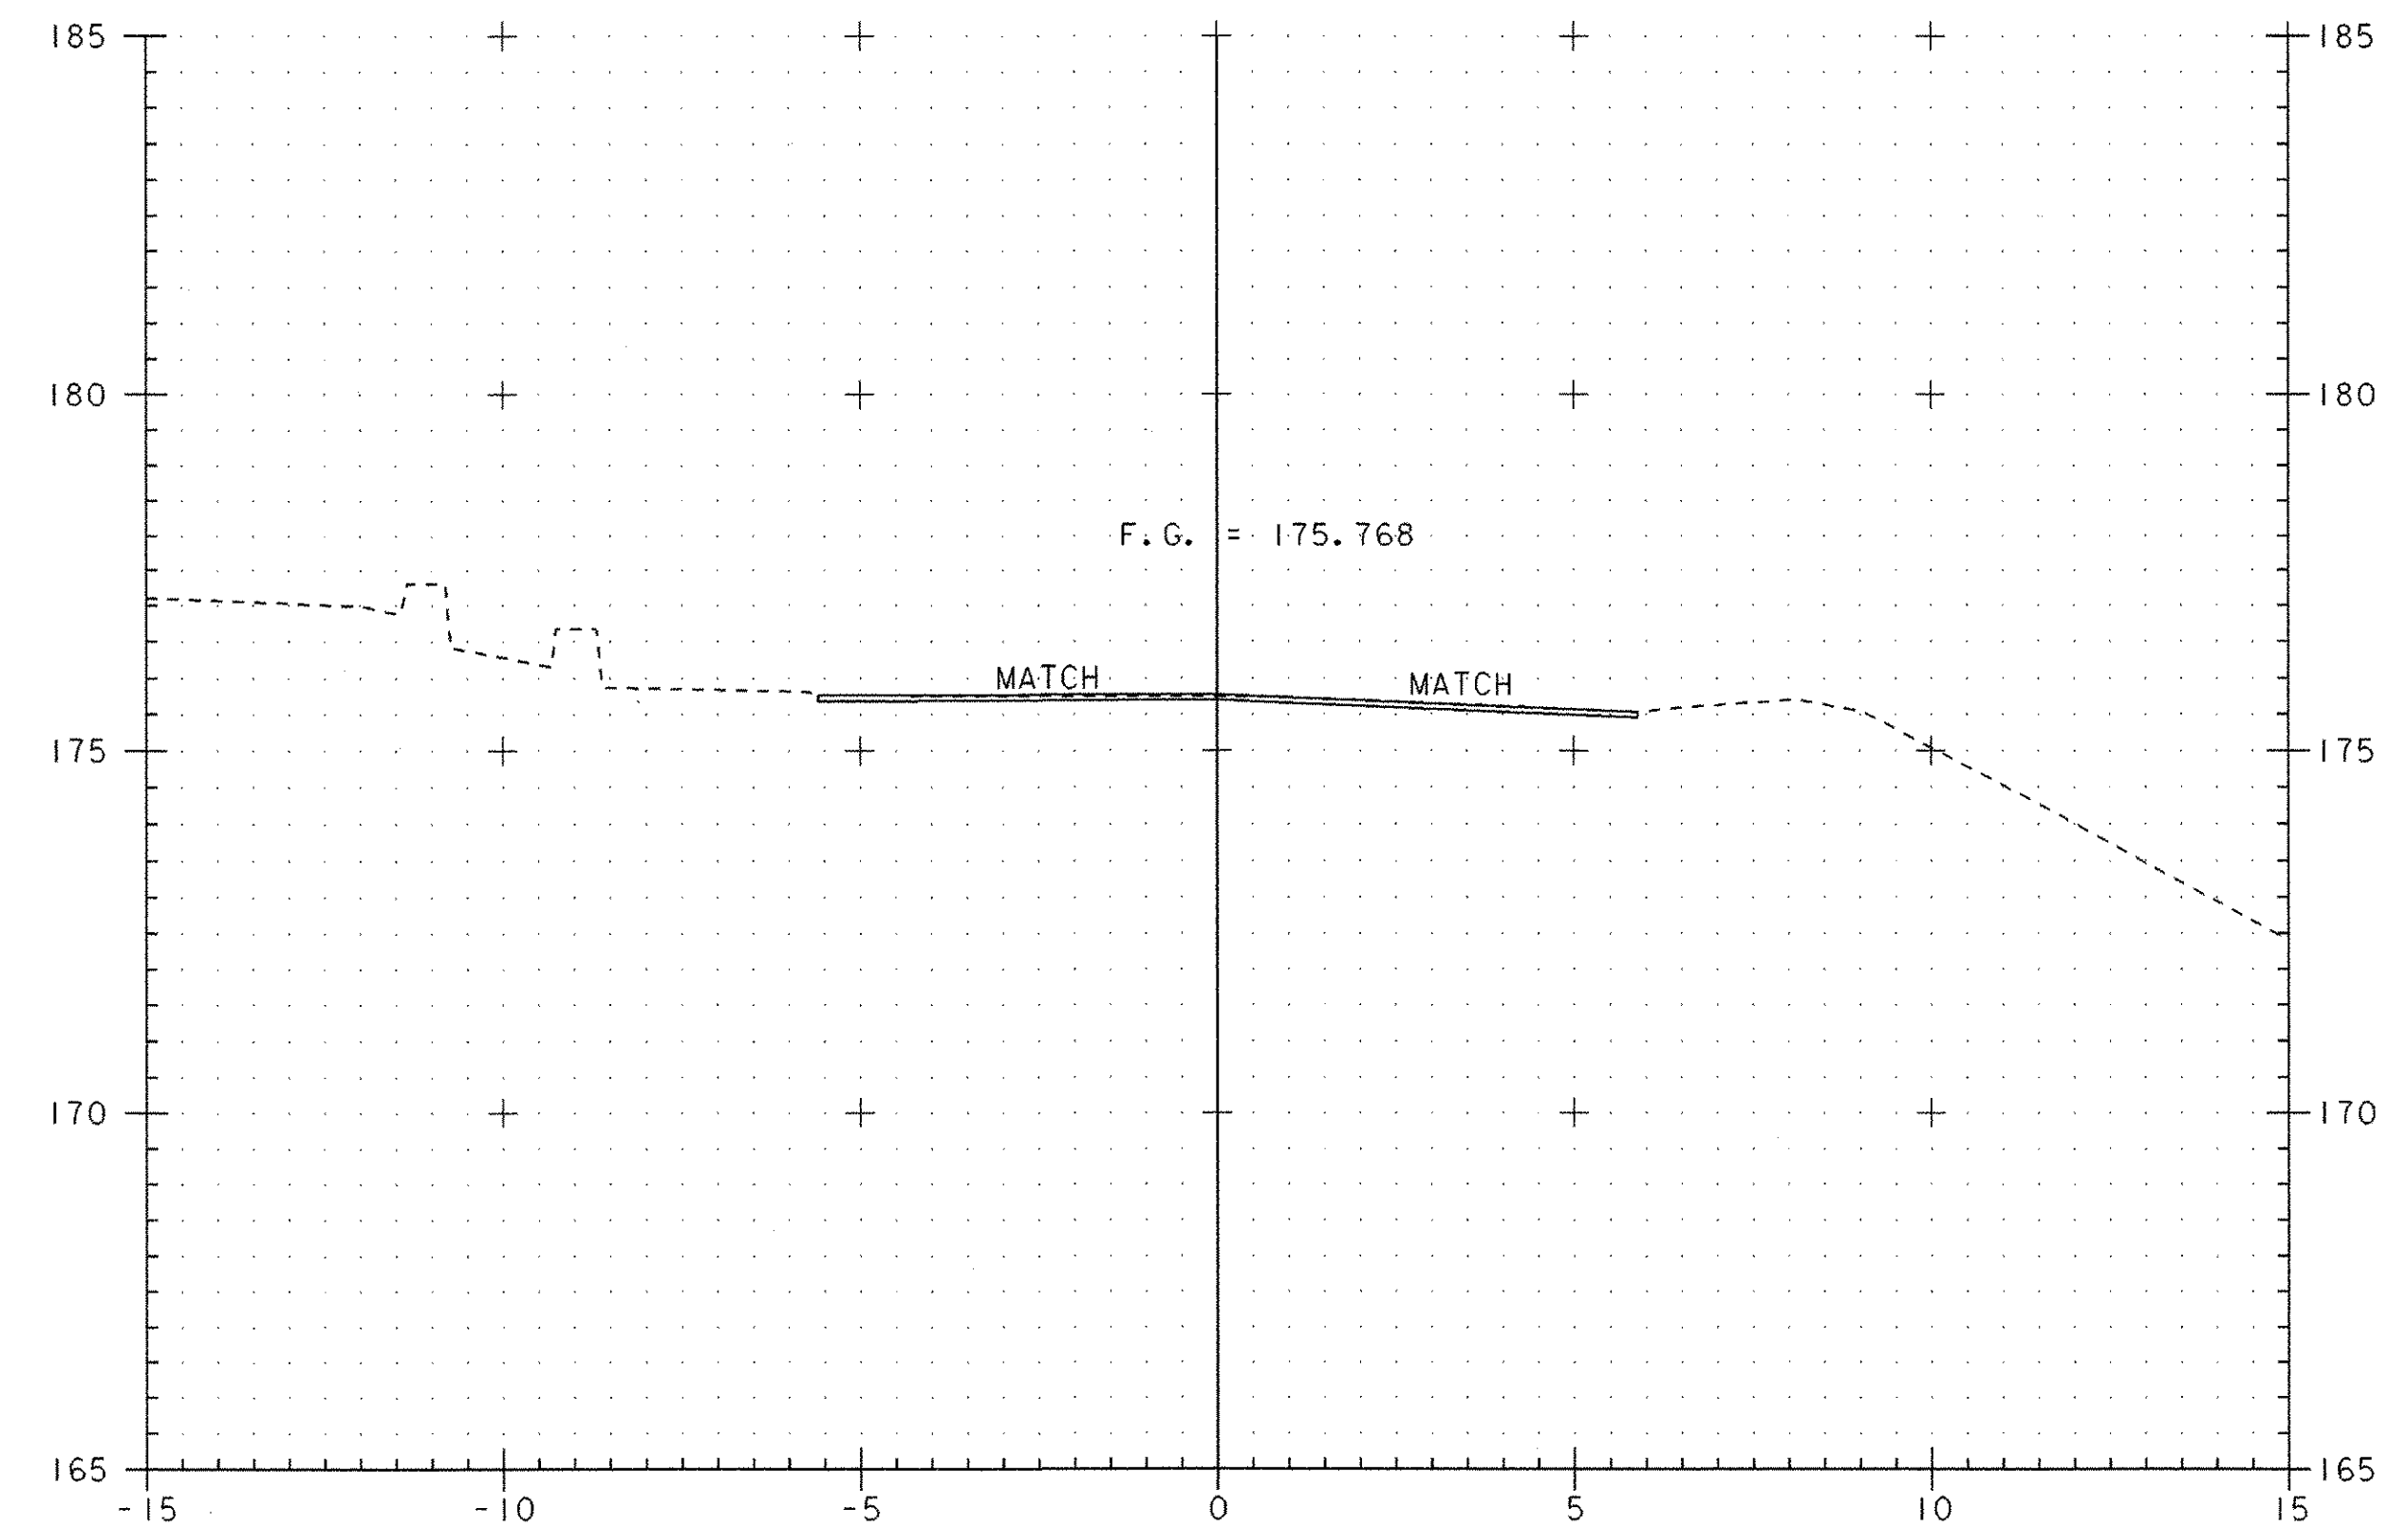

1+300

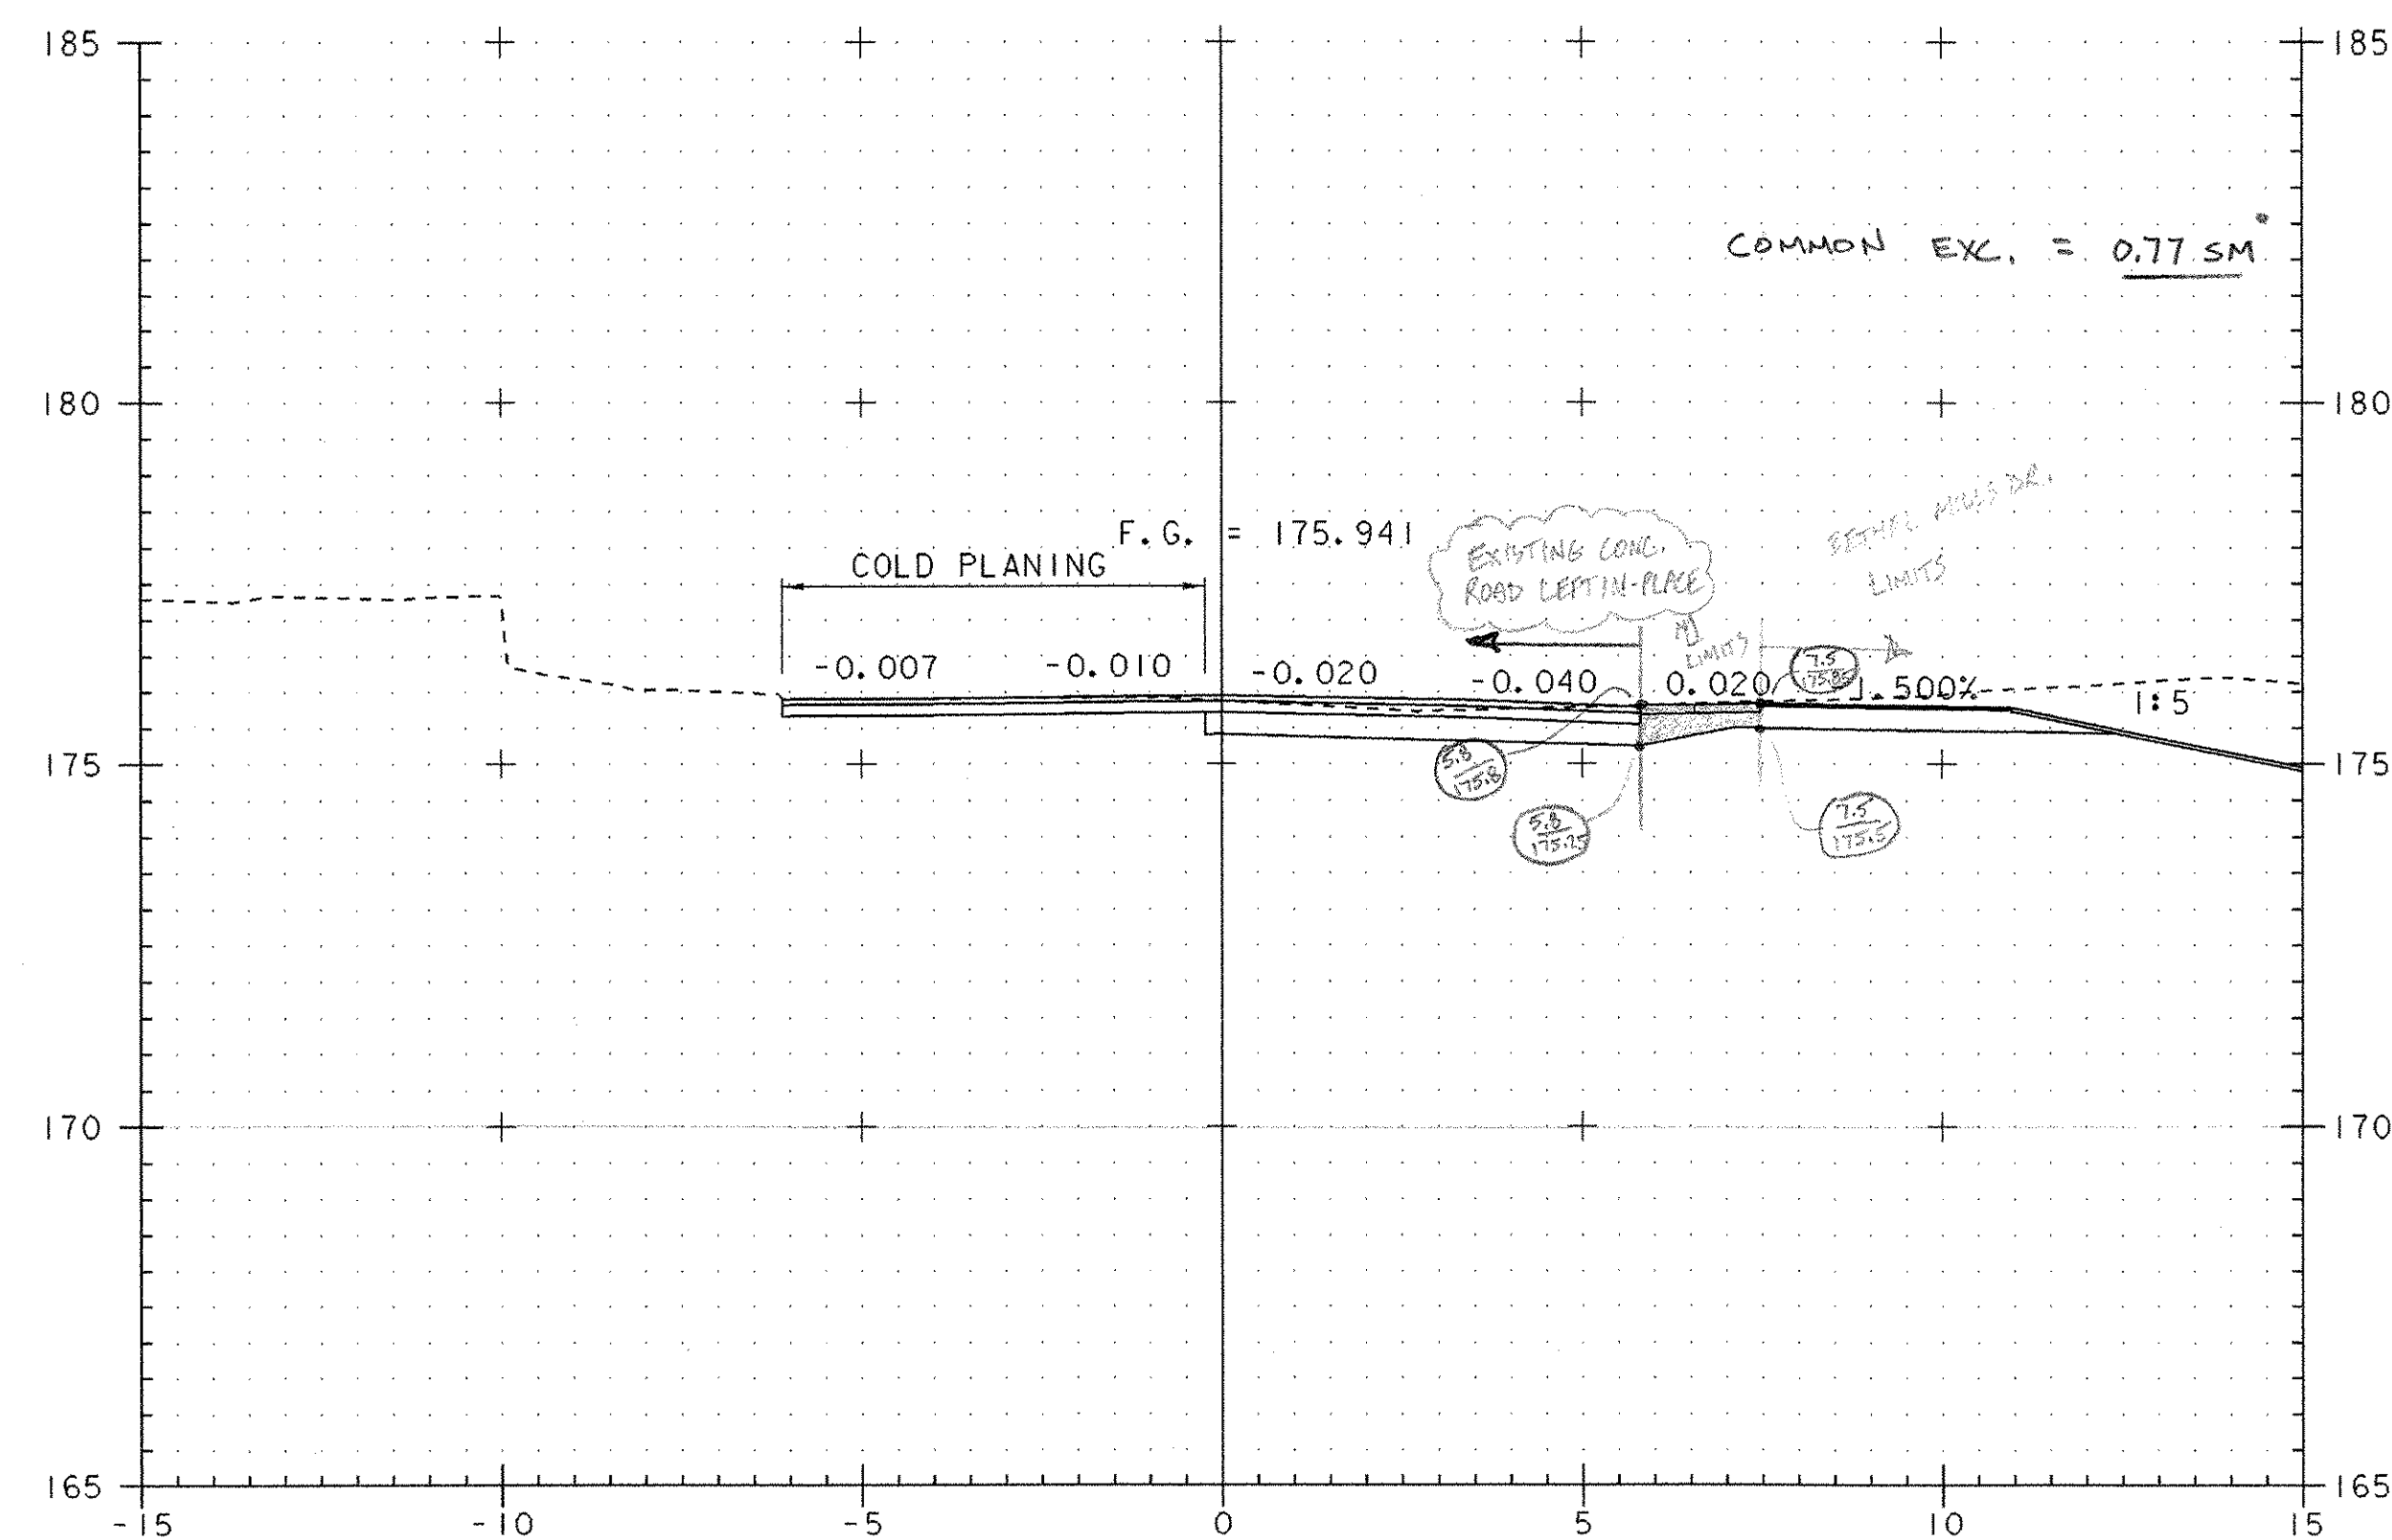


1+270

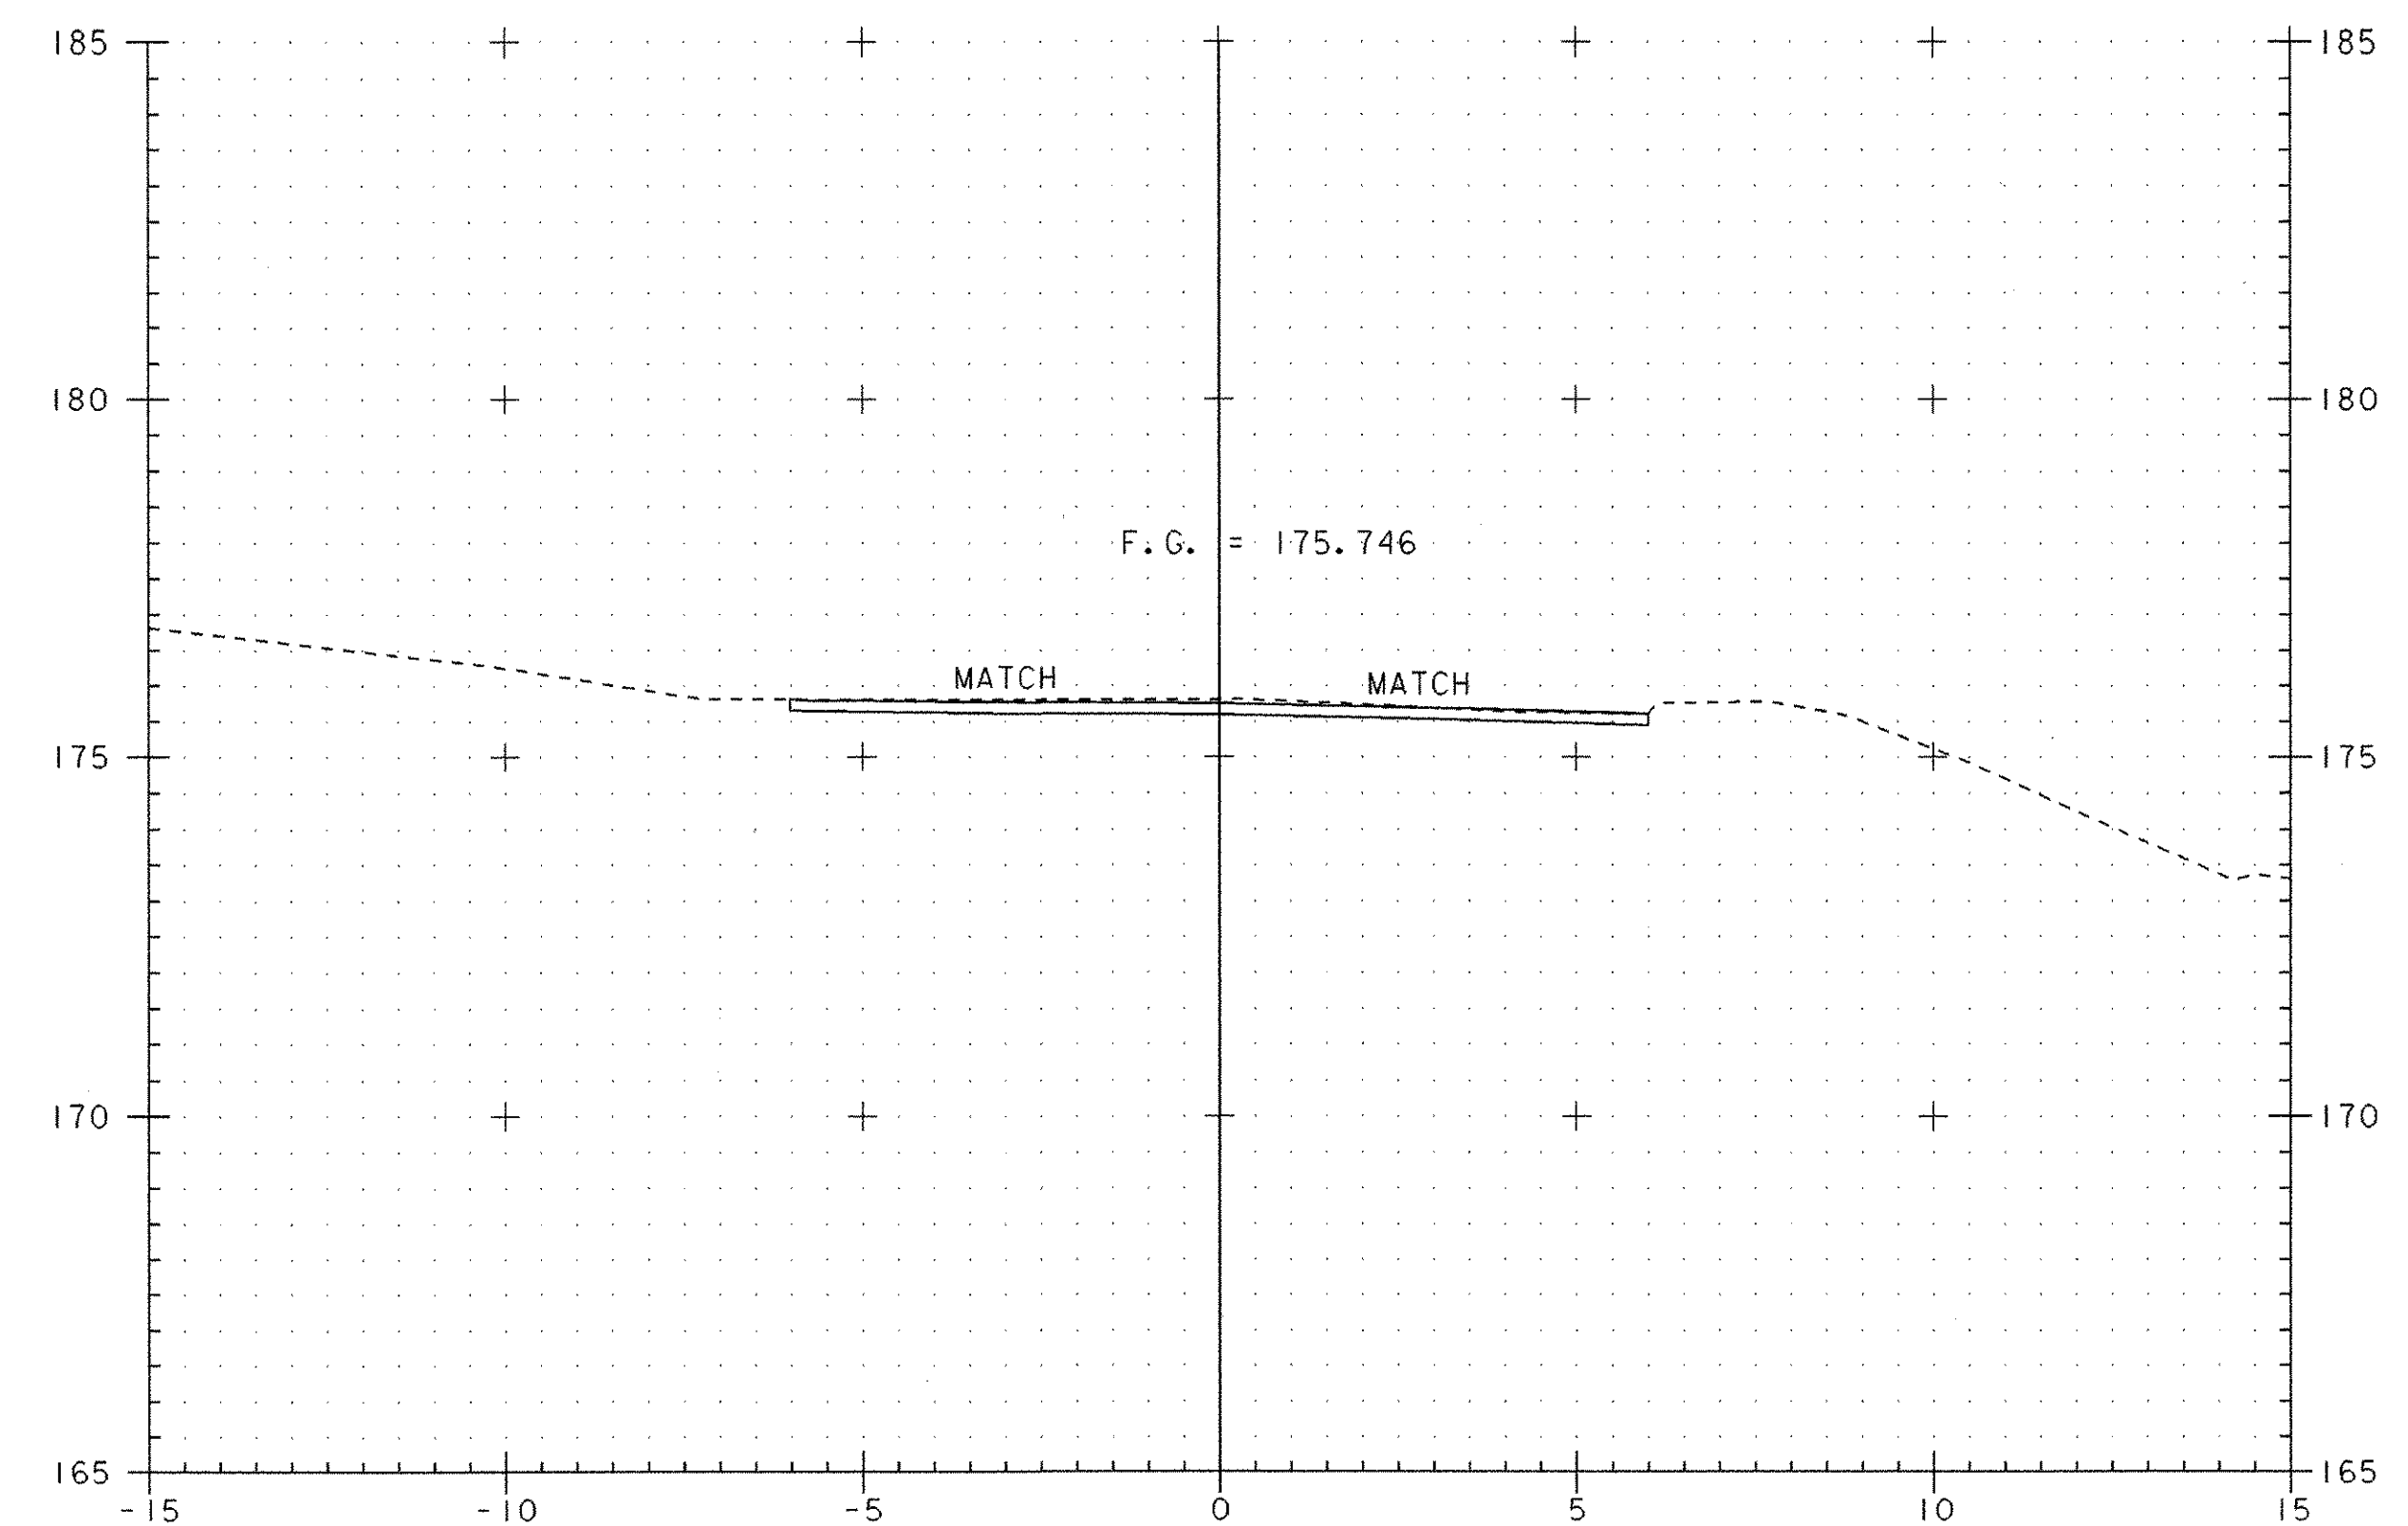

1+290

Rev
4-9-07 SGP
7/10/07

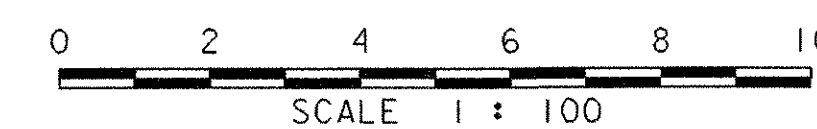

PROJECT: BETHEL	PROJECT NO.: BRF0241 (33) C/2
DESIGN FILE NAME: 02c180/Structures/s02c180xsec.dgn	IPARM FILE NAME: sc180m17.i
MAINLINE CROSS SECTIONS	PLOT DATE: 14-APR-2005
STA 1+270 Thru STA 1+300	SHEET: 90 OF 130