

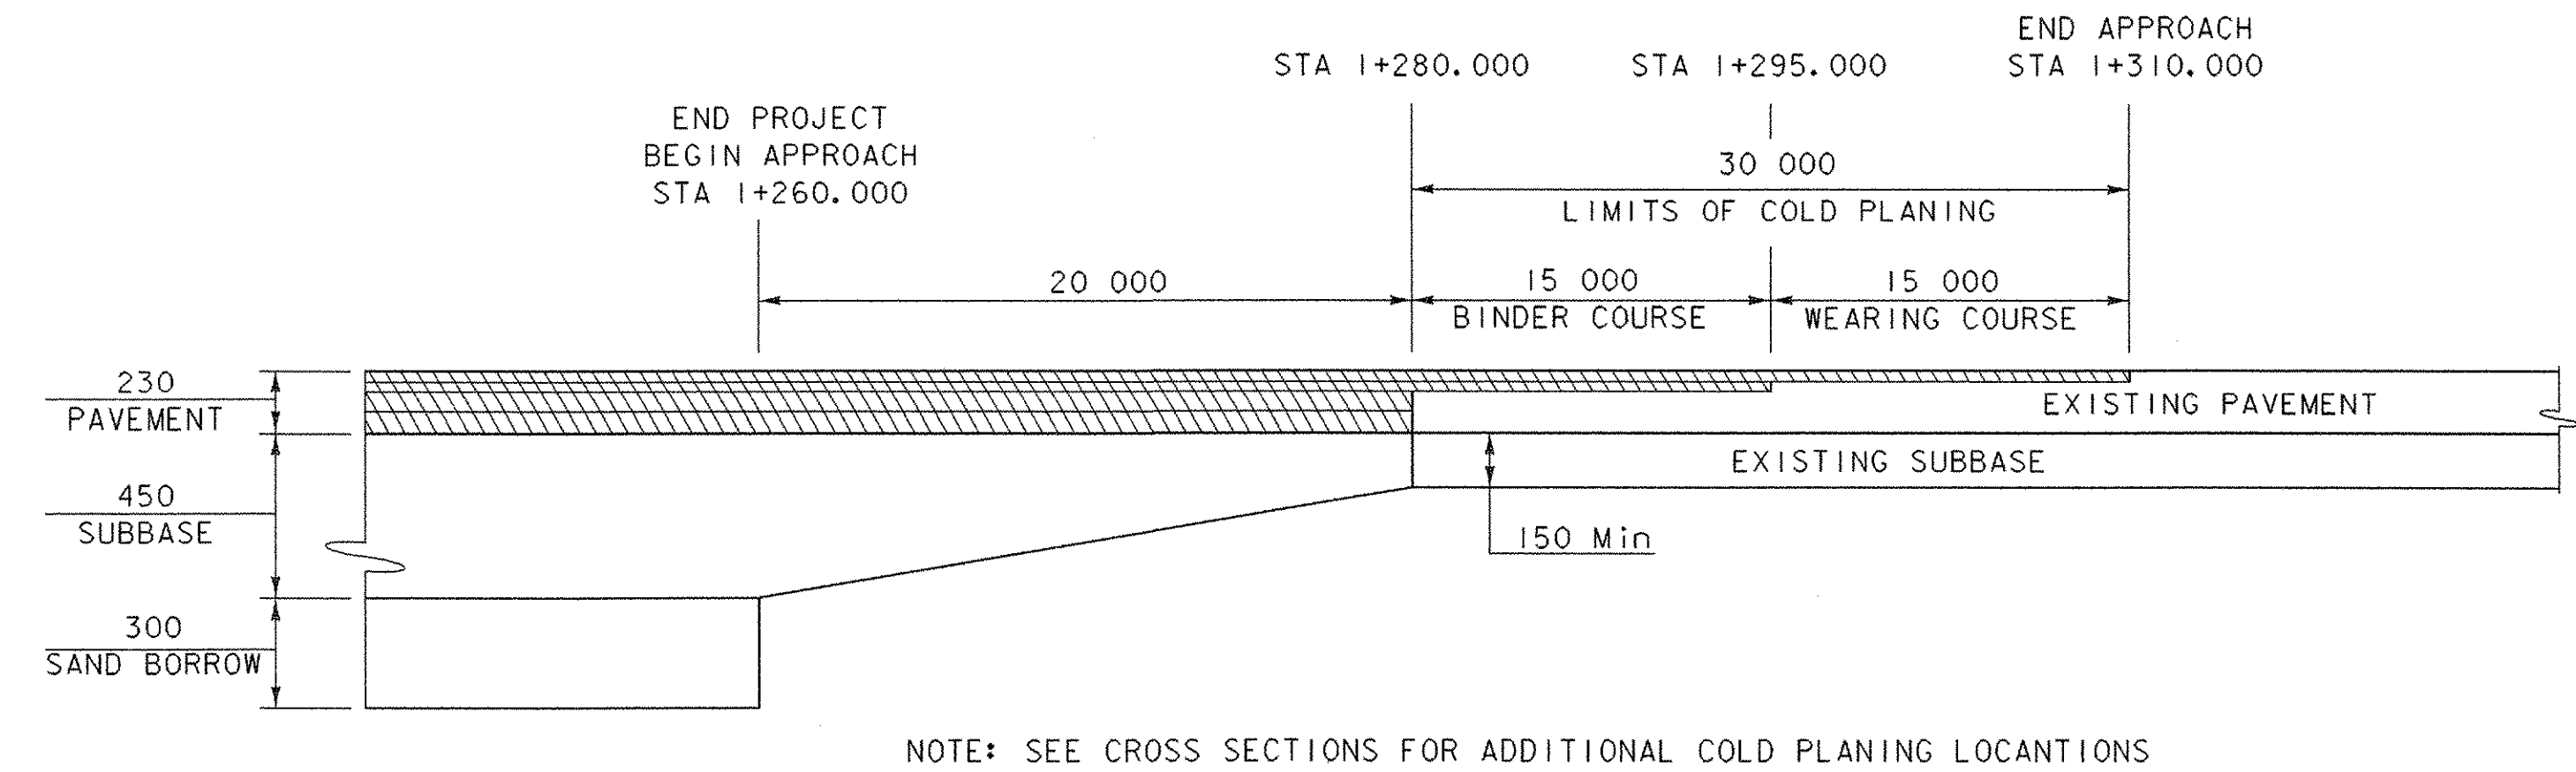
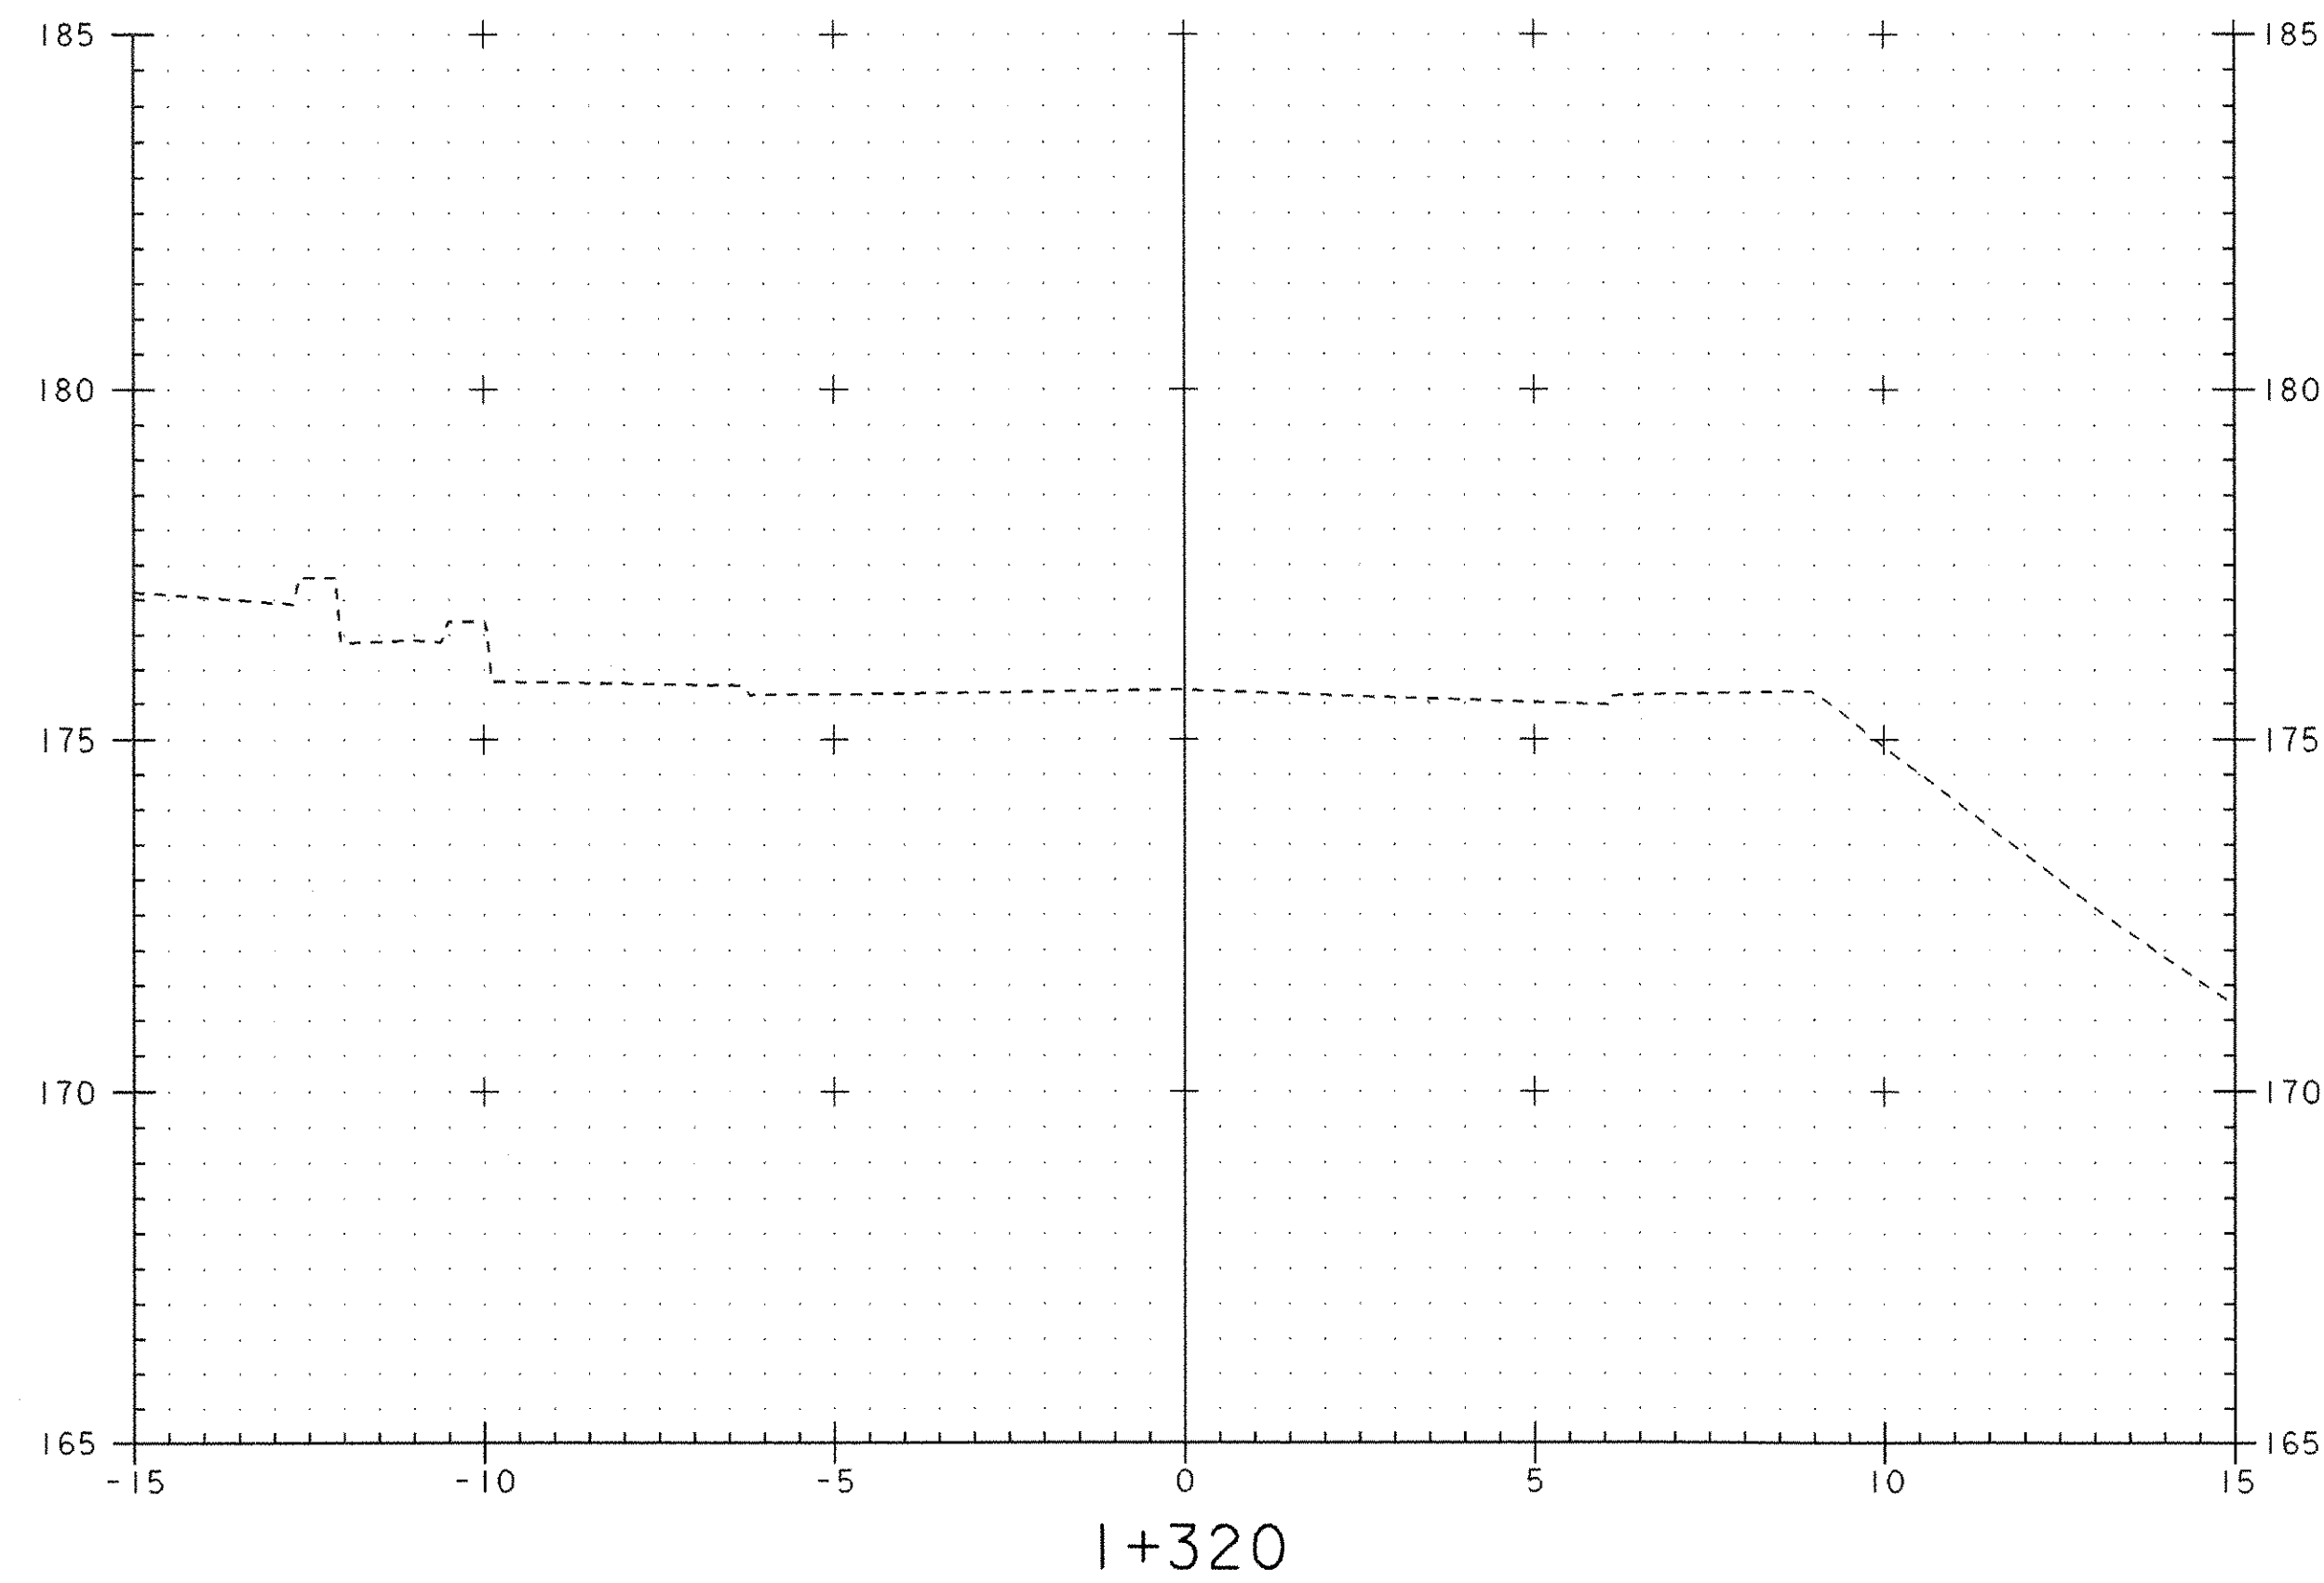


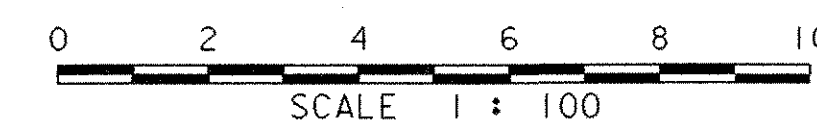

SUBBASE TAPER AT END PROJECT

NTS

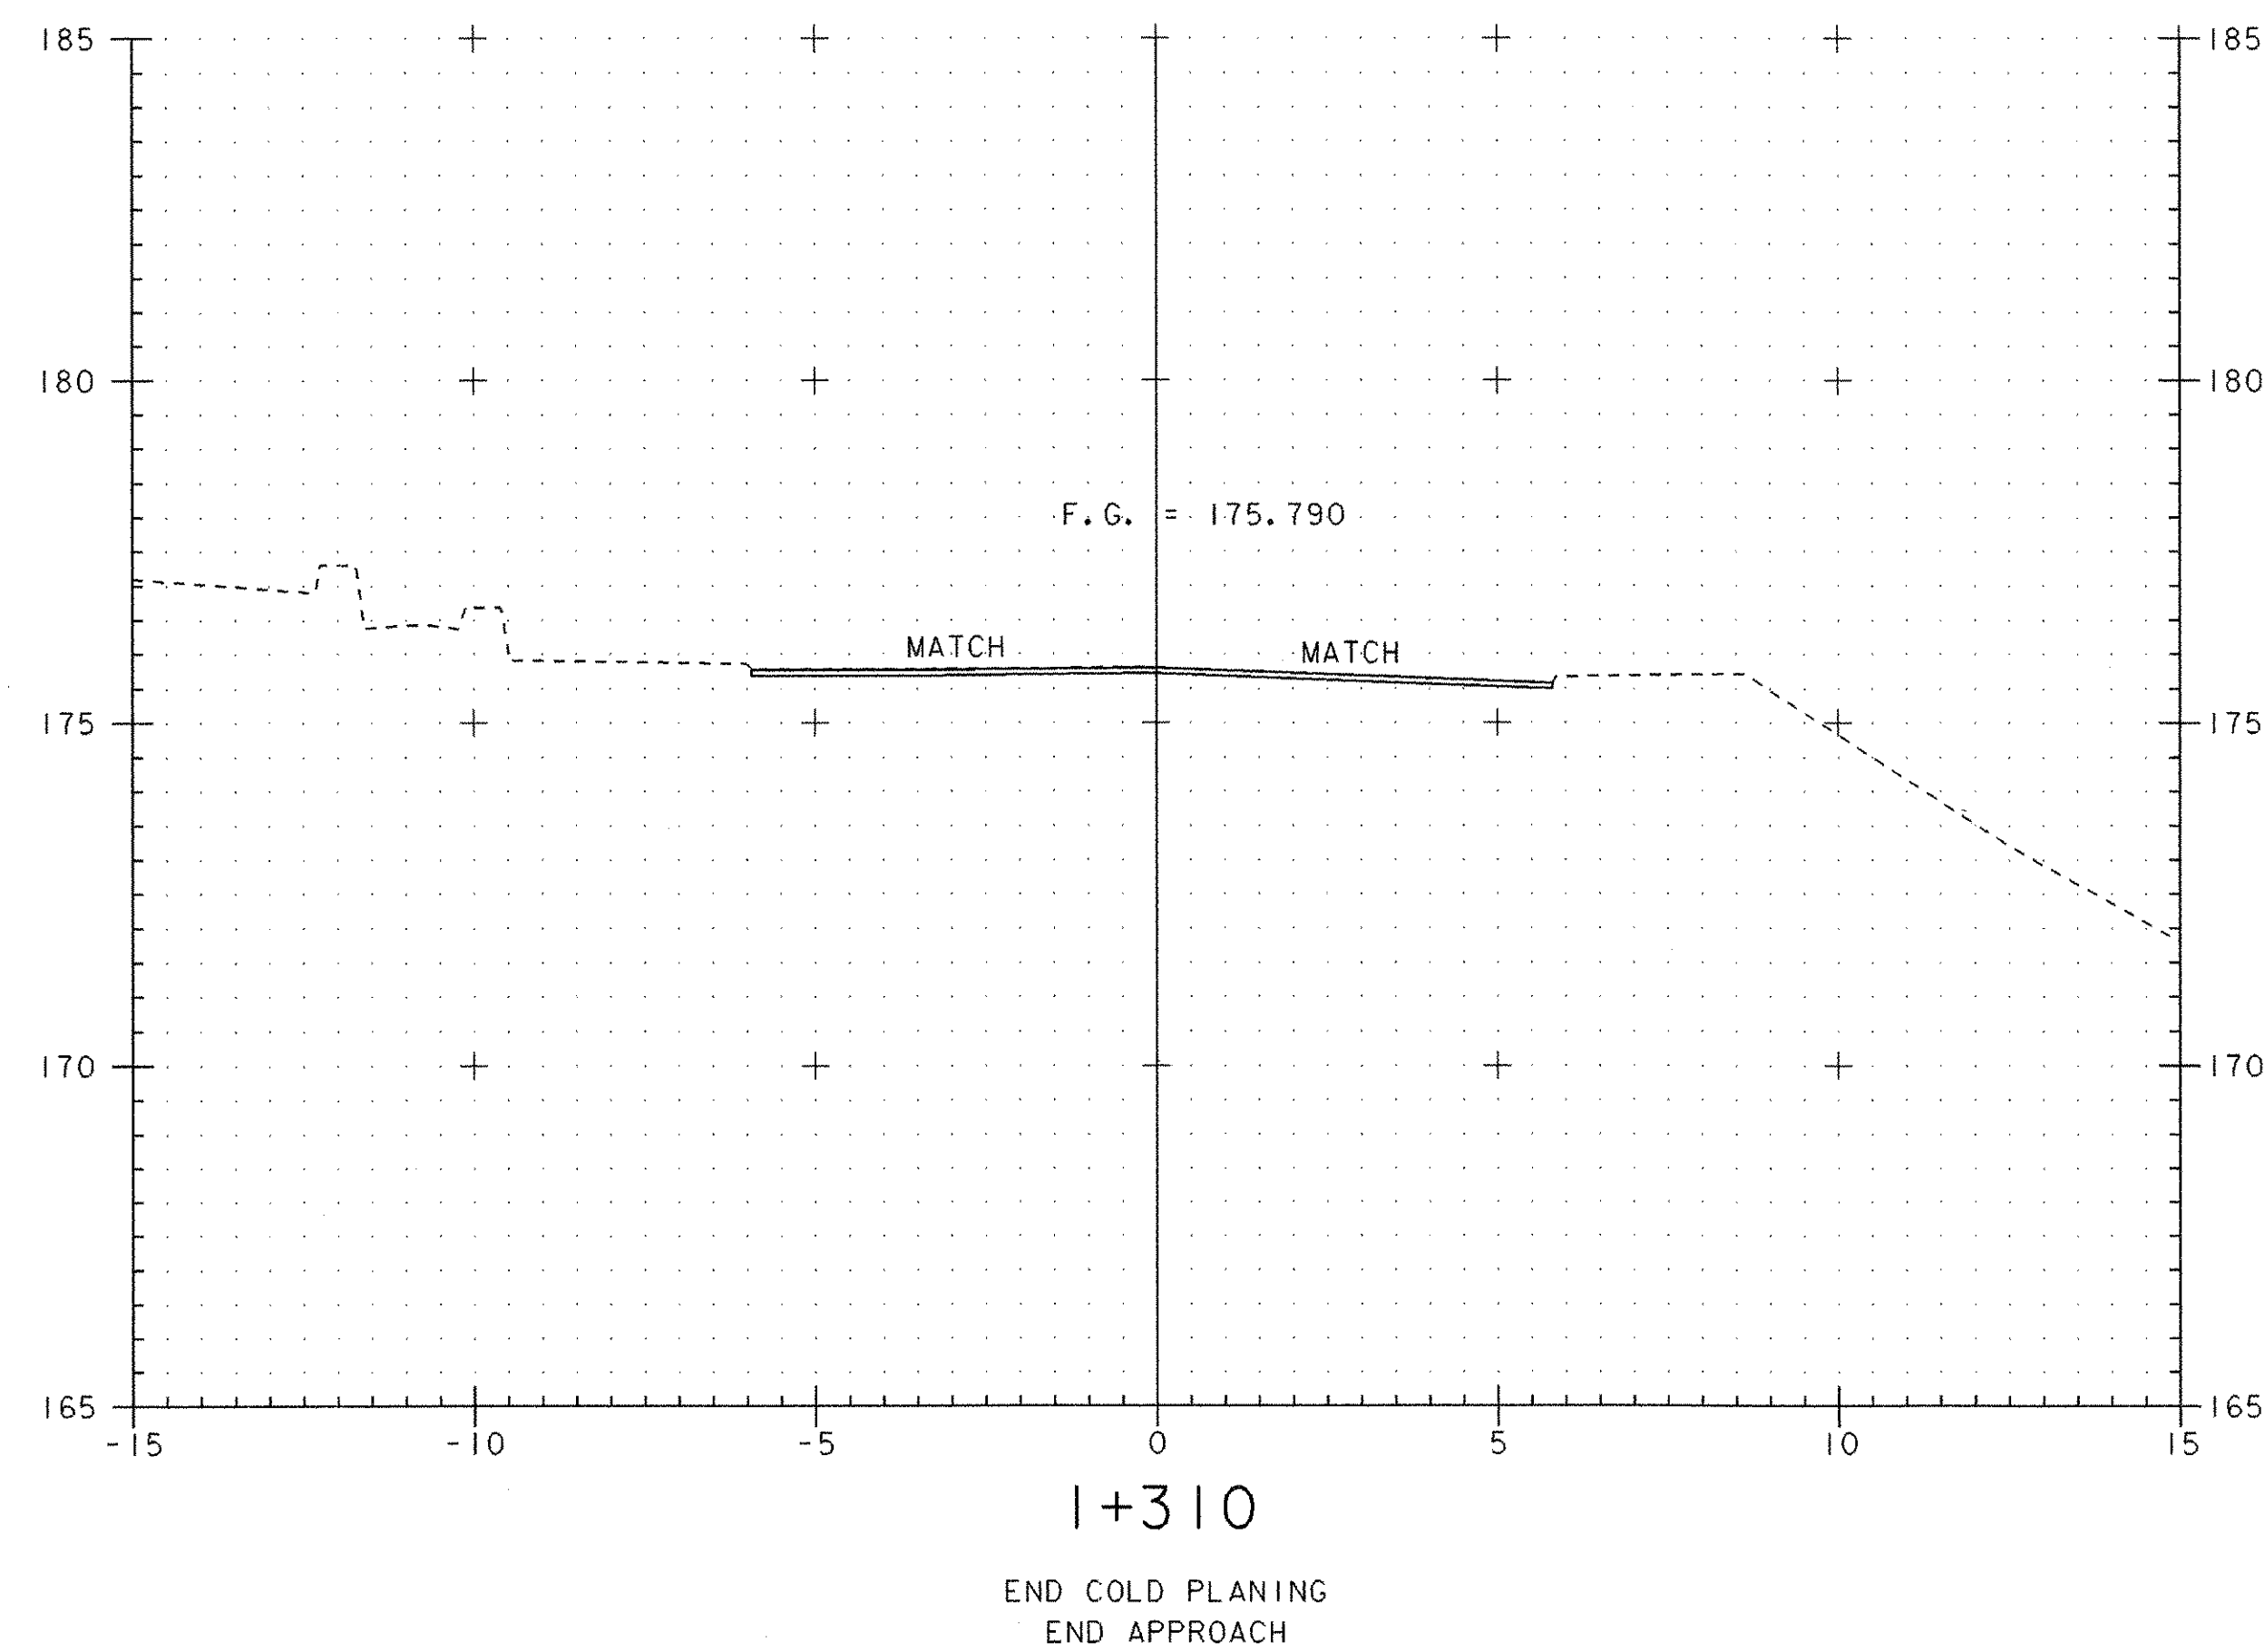

PROJECT: BETHEL	PROJECT NO.: BRF0241 (33) C/2
DESIGN FILE NAME: 02c180/Structures/s02c180xsec.dgn	IPARM FILE NAME: sc180m18.i
MAINLINE CROSS SECTIONS	PLAT DATE: 14-APR-2005
STA 1+310 Thru STA 1+310	SHEET: 91 OF 130