



HANDRAIL @ RETAINING WALL #6

SHOP TO PROVIDE 12mm HOLES
FOR SPLICE LOCKS.

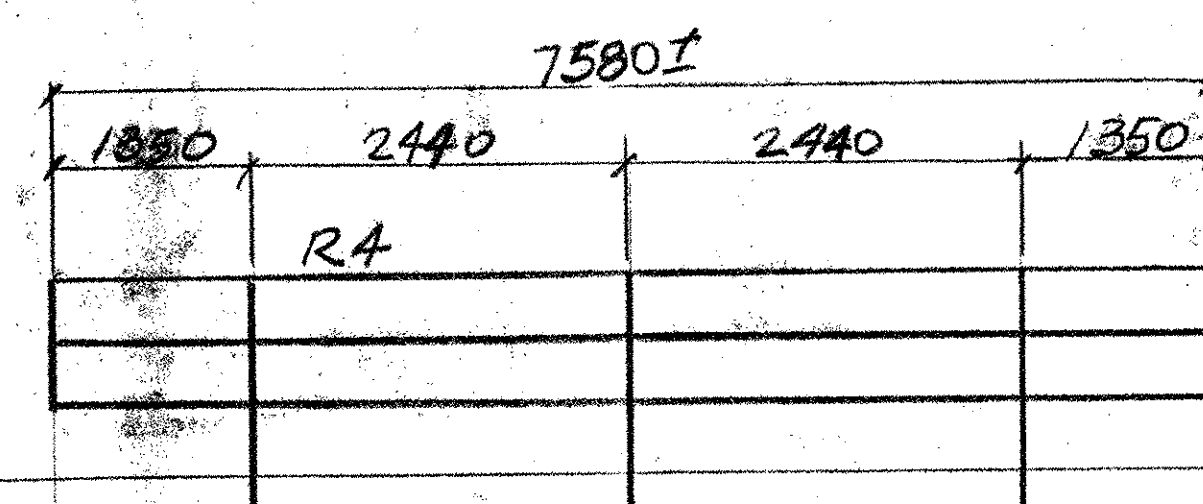


HANDRAIL @ RETAINING WALL #3

GC-VERIFY ALL DIM'S IN THE FIELD
TO MATCH EXISTING HANDRAIL

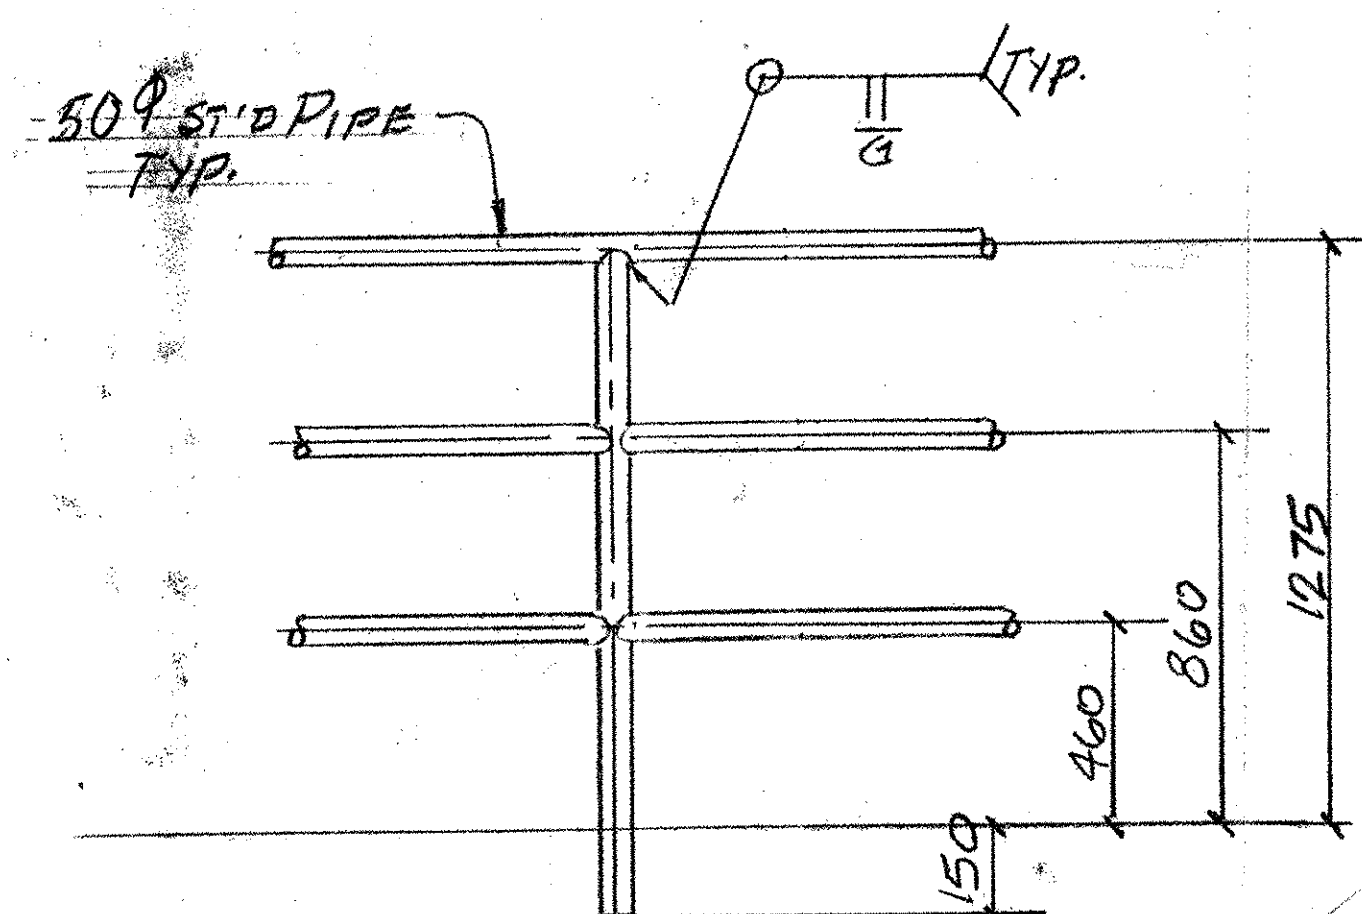

TYP. HANDRAIL DETAIL

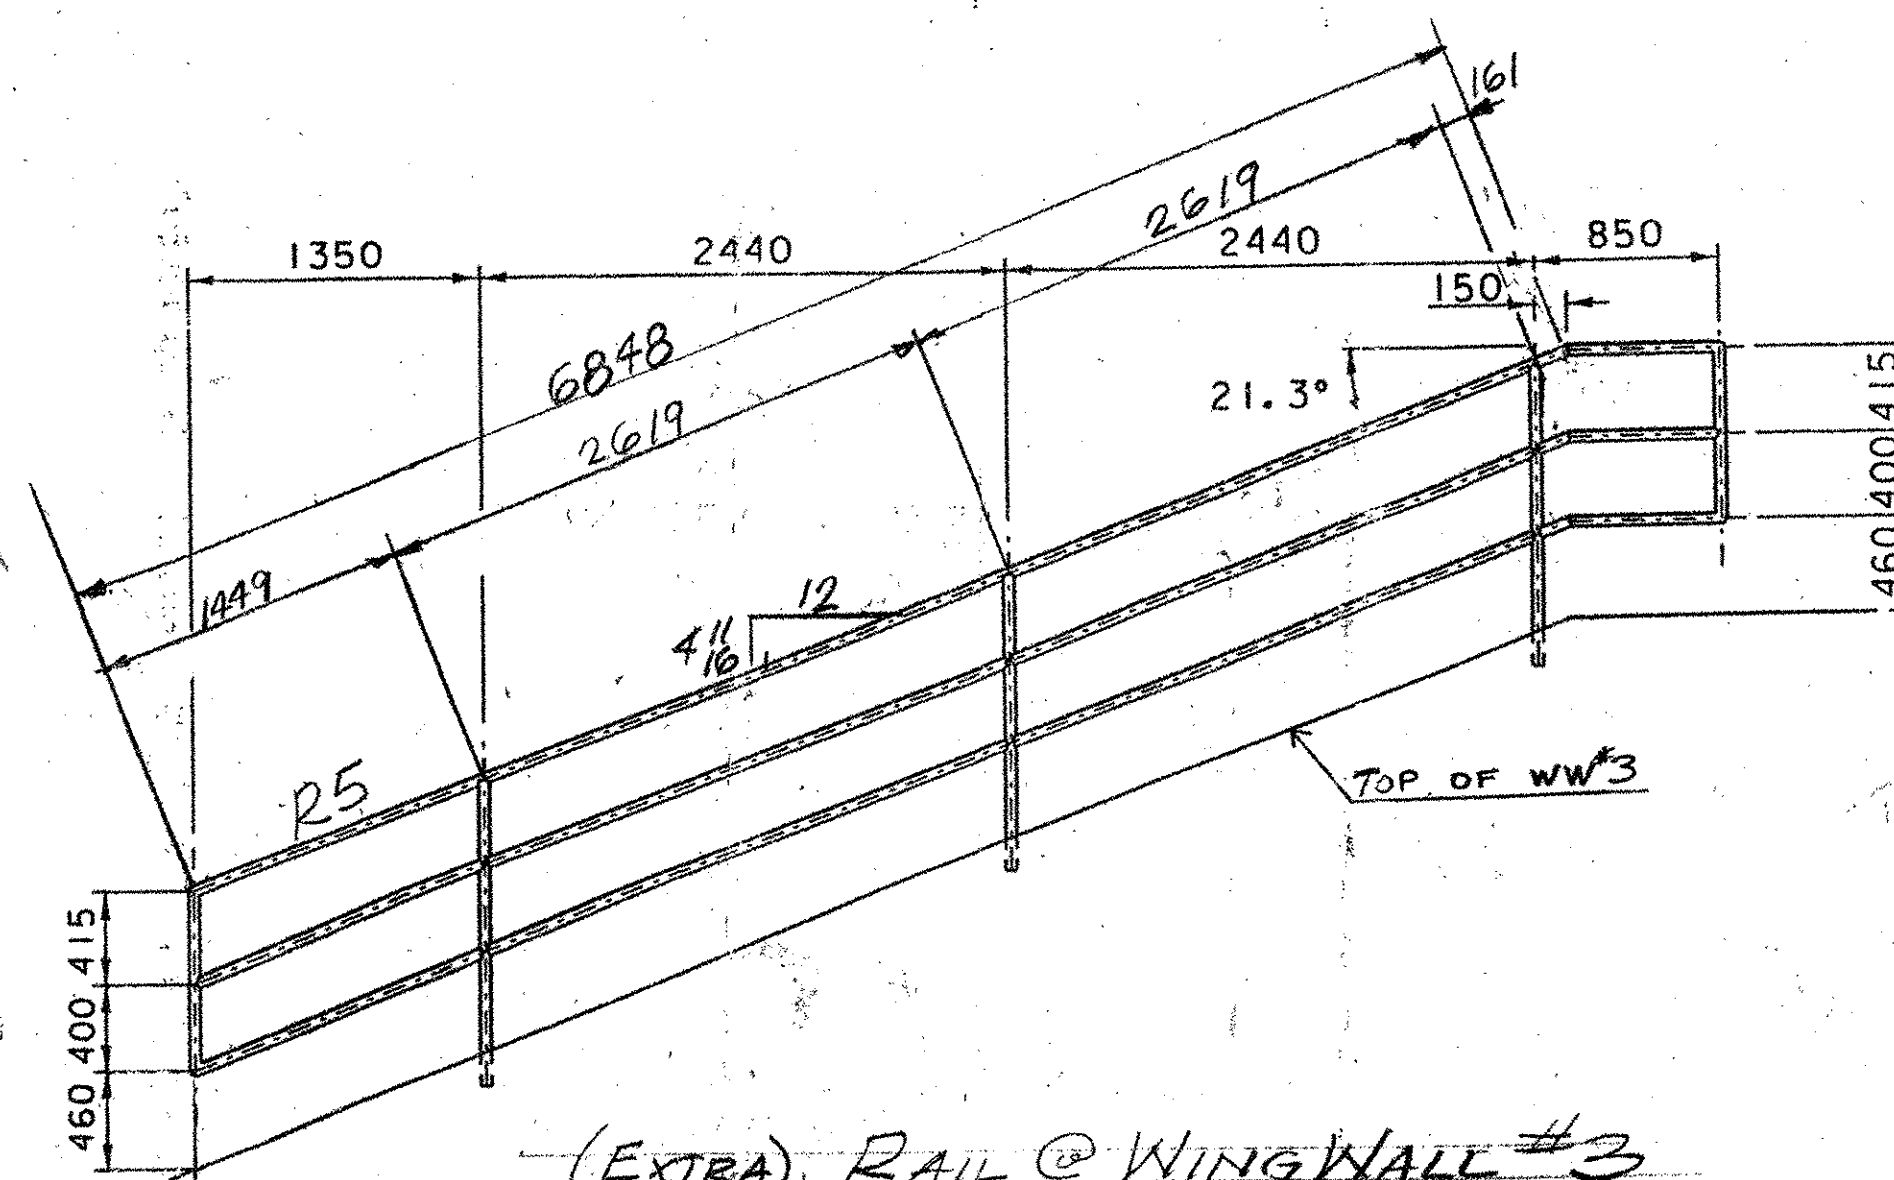

(EXTRA) RAIL @ WING WALL #3

RECEIVED
CKD BY: KMH OK'D BY:
SEP 19 2006
RESUBMIT: _____ APPROVED: _____
BY: CPW DATE 9/22/06

PLANS DRAWN USING
METRIC
DIMENSIONS

ABM INFO		SHOP BILL		JOB NO. 279	DRG. NO. M1		
PAGE	LINE	NO.	DESCRIPTION	ASSEM. MARK	SHIPPING MARK	REMARKS	WEIGHT
		1	HANDRAIL	6690E	R1		—
		1	DO	7800	R2		—
		1	DO	8120	R3		—
		1	DO	7800	R4		—
			50# STD P	1E	105045 SMT		
		6	50# SPLICE	1050	1050	FIELD RAILING NEE	
		1	SLOPED R	1L	R5	EXTRA	
			50# STD P	1E	20#50 SMT		
PAY I, EM 525.15							