


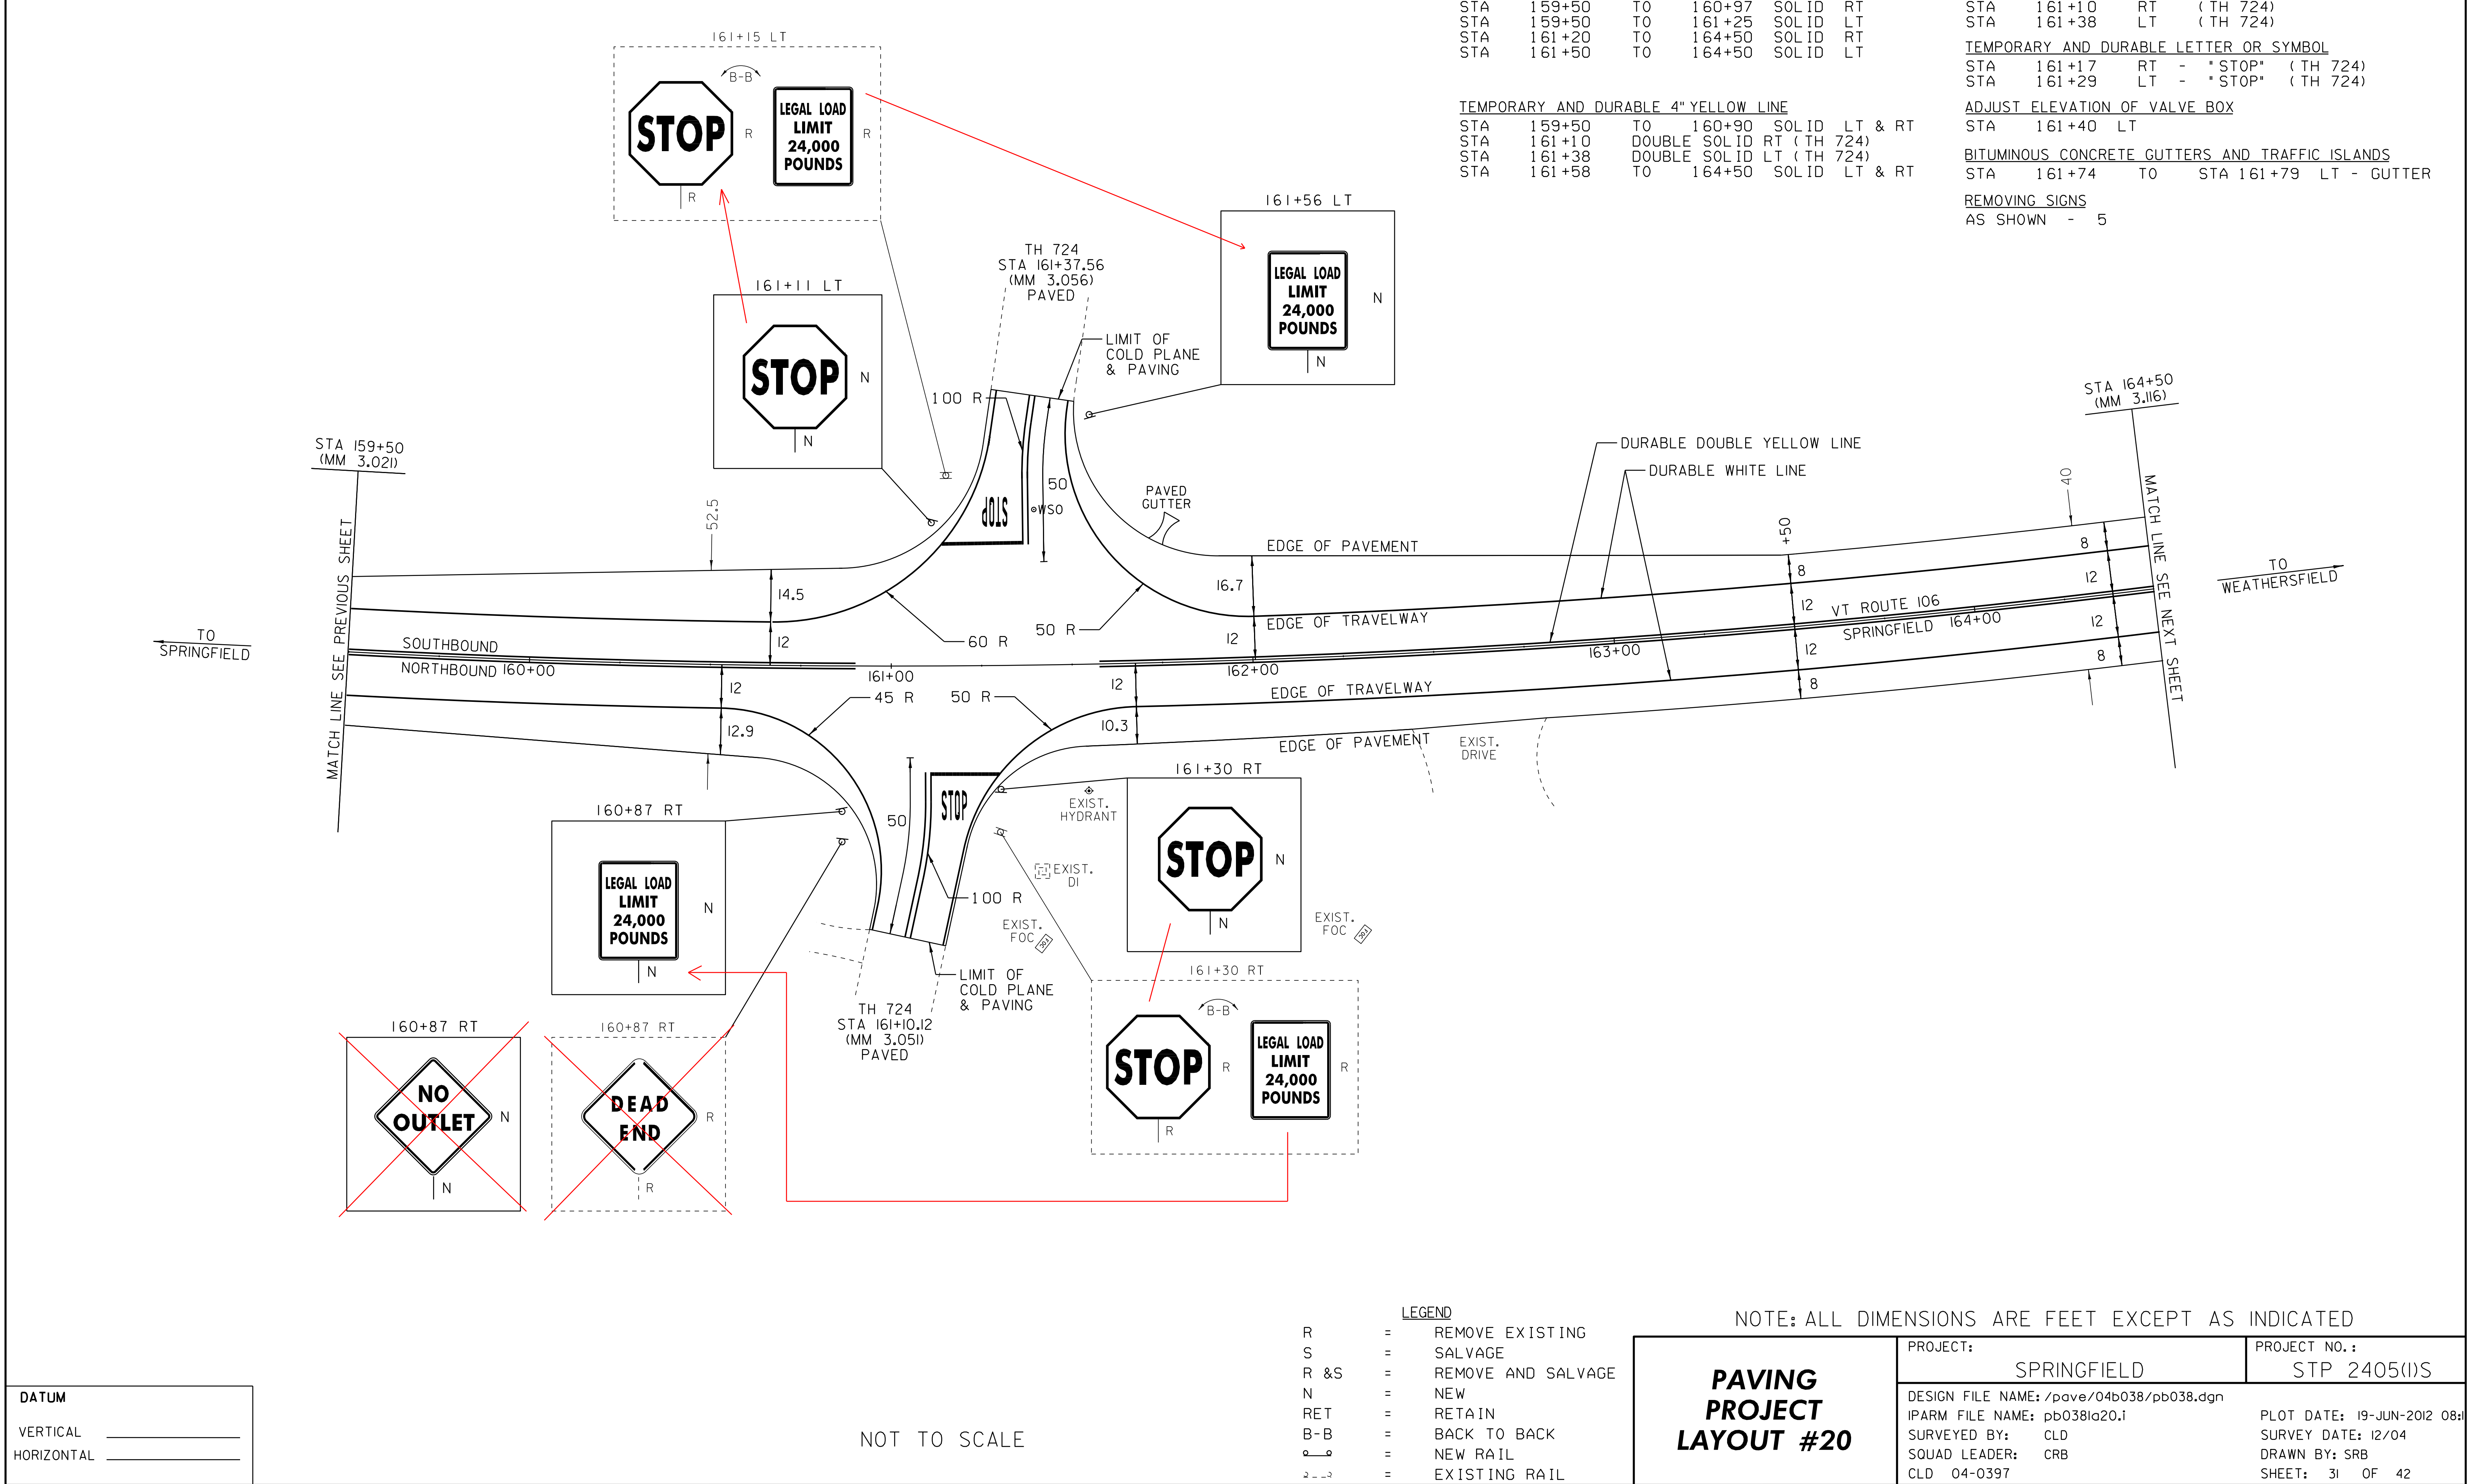

TEMPORARY AND DURABLE 4" WHITE LINE					
STA 159+50	TO	160+97	SOLID	RT	
STA 159+50	TO	161+25	SOLID	LT	
STA 161+20	TO	164+50	SOLID	RT	
STA 161+50	TO	164+50	SOLID	LT	

TEMPORARY AND DURABLE 4" YELLOW LINE					
STA 159+50	TO	160+90	SOLID	LT & RT	
STA 161+10	DOUBLE SOLID	RT (TH 724)			
STA 161+38	DOUBLE SOLID	LT (TH 724)			
STA 161+58	TO	164+50	SOLID	LT & RT	

TEMPORARY AND DURABLE 24" STOP BAR					
STA 161+10	RT	(TH 724)			
STA 161+38	LT	(TH 724)			
TEMPORARY AND DURABLE LETTER OR SYMBOL					
STA 161+17	RT	-	*STOP*	(TH 724)	
STA 161+29	LT	-	*STOP*	(TH 724)	
ADJUST ELEVATION OF VALVE BOX					
STA 161+40	LT				
BITUMINOUS CONCRETE GUTTERS AND TRAFFIC ISLANDS					
STA 161+74	TO	STA 161+79	LT -	GUTTER	
REMOVING SIGNS					
AS SHOWN	-	5			

DATUM	
VERTICAL	_____
HORIZONTAL	_____

NOT TO SCALE

LEGEND	
R	= REMOVE EXISTING
S	= SALVAGE
R & S	= REMOVE AND SALVAGE
N	= NEW
RET	= RETAIN
B-B	= BACK TO BACK
—	= NEW RAIL
—	= EXISTING RAIL

NOTE: ALL DIMENSIONS ARE FEET EXCEPT AS INDICATED	
PAVING PROJECT LAYOUT #20	
PROJECT: SPRINGFIELD	PROJECT NO.: STP 2405(I)S
DESIGN FILE NAME: /pave/04b038/pb038.dgn	PLOT DATE: 19-JUN-2012 08:11
IPARM FILE NAME: pb038la20.i	SURVEY DATE: 12/04
SURVEYED BY: CLD	DRAWN BY: SRB
SQUAD LEADER: CRB	SHEET: 31 OF 42
CLD 04-0397	