

INDEX OF SHEETS  
SEE SHEET 2

# STATE OF VERMONT AGENCY OF TRANSPORTATION

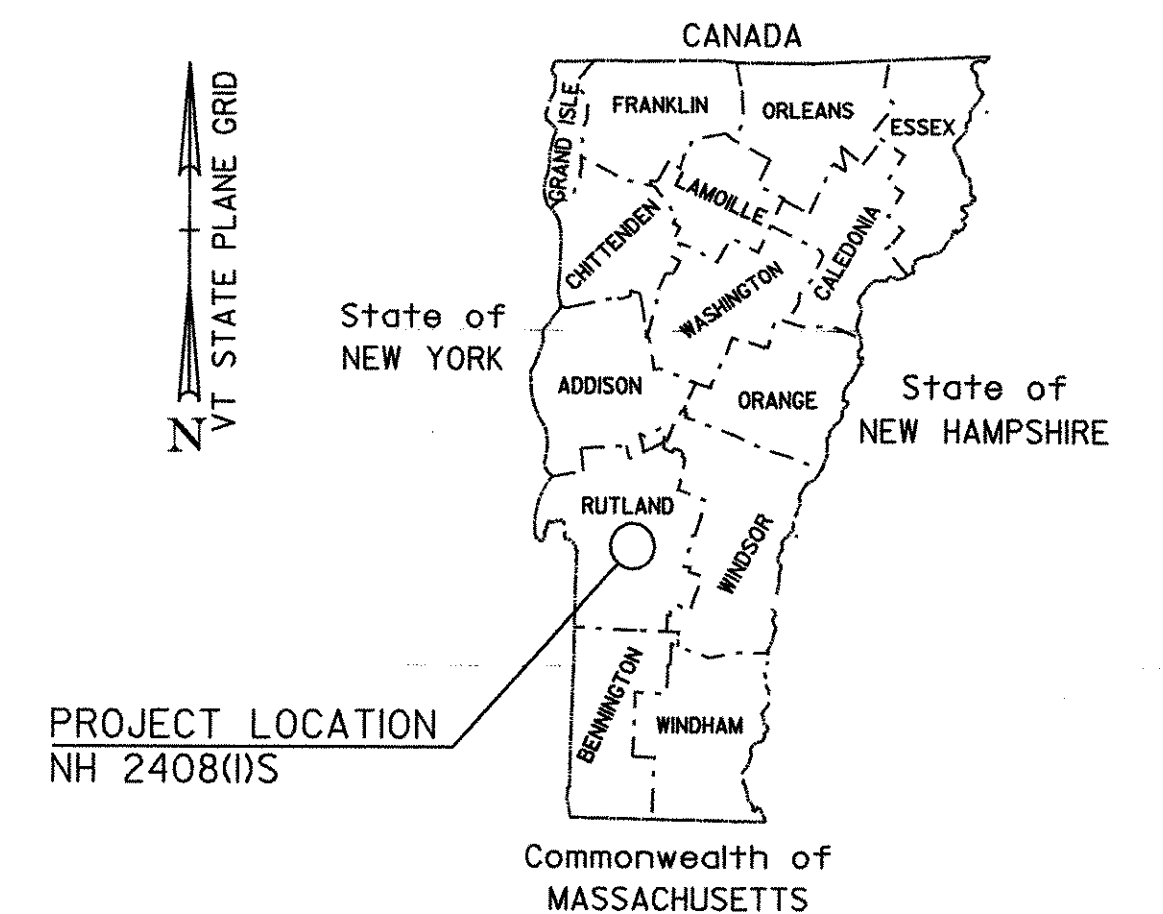


## PROPOSED IMPROVEMENT TOWNS OF WALLINGFORD, CLARENDON & RUTLAND COUNTY OF RUTLAND U.S. ROUTE 7

BEGINNING IN THE TOWN OF WALLINGFORD ON U.S. ROUTE 7 AT MILE MARKER 6.532 = STA. 344+88.96 AND EXTENDING NORTHERLY FOR A DISTANCE OF 36,384.48 FEET (6.891 MILES) TO A POINT IN RUTLAND TOWN AT MILE MARKER 0.674 = STA. 35+58.72.


LENGTH OF ROADWAY 36,384.48 FT (6.891 MILES)  
LENGTH OF PROJECT 36,384.48 FT (6.891 MILES)

WORK TO BE PERFORMED UNDER THIS PROJECT INCLUDES COLD PLANING AND RESURFACING OF THE EXISTING HIGHWAY WITH A SHIM/LEVELING COURSE AND WEARING COURSE, NEW PAVEMENT MARKINGS, DRAINAGE IMPROVEMENTS, GUARDRAIL IMPROVEMENTS, VEHICLE DETECTOR LOOPS, NEW SIGNS AND INCIDENTAL ITEMS.



| BITUMINOUS CONCRETE PAVEMENT<br>SUPERPAVE MIXTURE DESIGN CRITERIA |           |
|-------------------------------------------------------------------|-----------|
| DESIGN LANE/DESIGN LIFE ESALS                                     | 7,348,000 |
| DESIGN NUMBER OF GYRATIONS                                        | 75        |
| PERFORMANCE GRADED ASPHALT BINDER                                 | 64-28     |

|                                                                                                                                                                        |                                    |
|------------------------------------------------------------------------------------------------------------------------------------------------------------------------|------------------------------------|
| RECORD PLANS                                                                                                                                                           |                                    |
| CONTRACTOR:                                                                                                                                                            | PIKE INDUSTRIES, INC. - BERLIN, VT |
| RESIDENT ENGINEER:                                                                                                                                                     | TIM POCKETTE                       |
| CONSTRUCTION BEGAN:                                                                                                                                                    | APRIL 20, 2006                     |
| CONSTRUCTION COMPLETE:                                                                                                                                                 | OCTOBER 3, 2006                    |
| RECORD PLANS BY:                                                                                                                                                       | TIM POCKETTE & J. GILMORE          |
| I HEREBY CERTIFY THAT ALL THE CONSTRUCTION REQUIRED BY THIS SET OF DRAWINGS HAS BEEN ACCOMPLISHED AS INDICATED HEREIN.                                                 |                                    |
| BY:                                                                                                                                                                    | RESIDENT ENGINEER                  |
| DATE:                                                                                                                                                                  | 03-01-2007                         |
| NOTE: Any further information concerning final quantities, amounts or other details relative to this project may be found at Central Files in the electronic archives. |                                    |

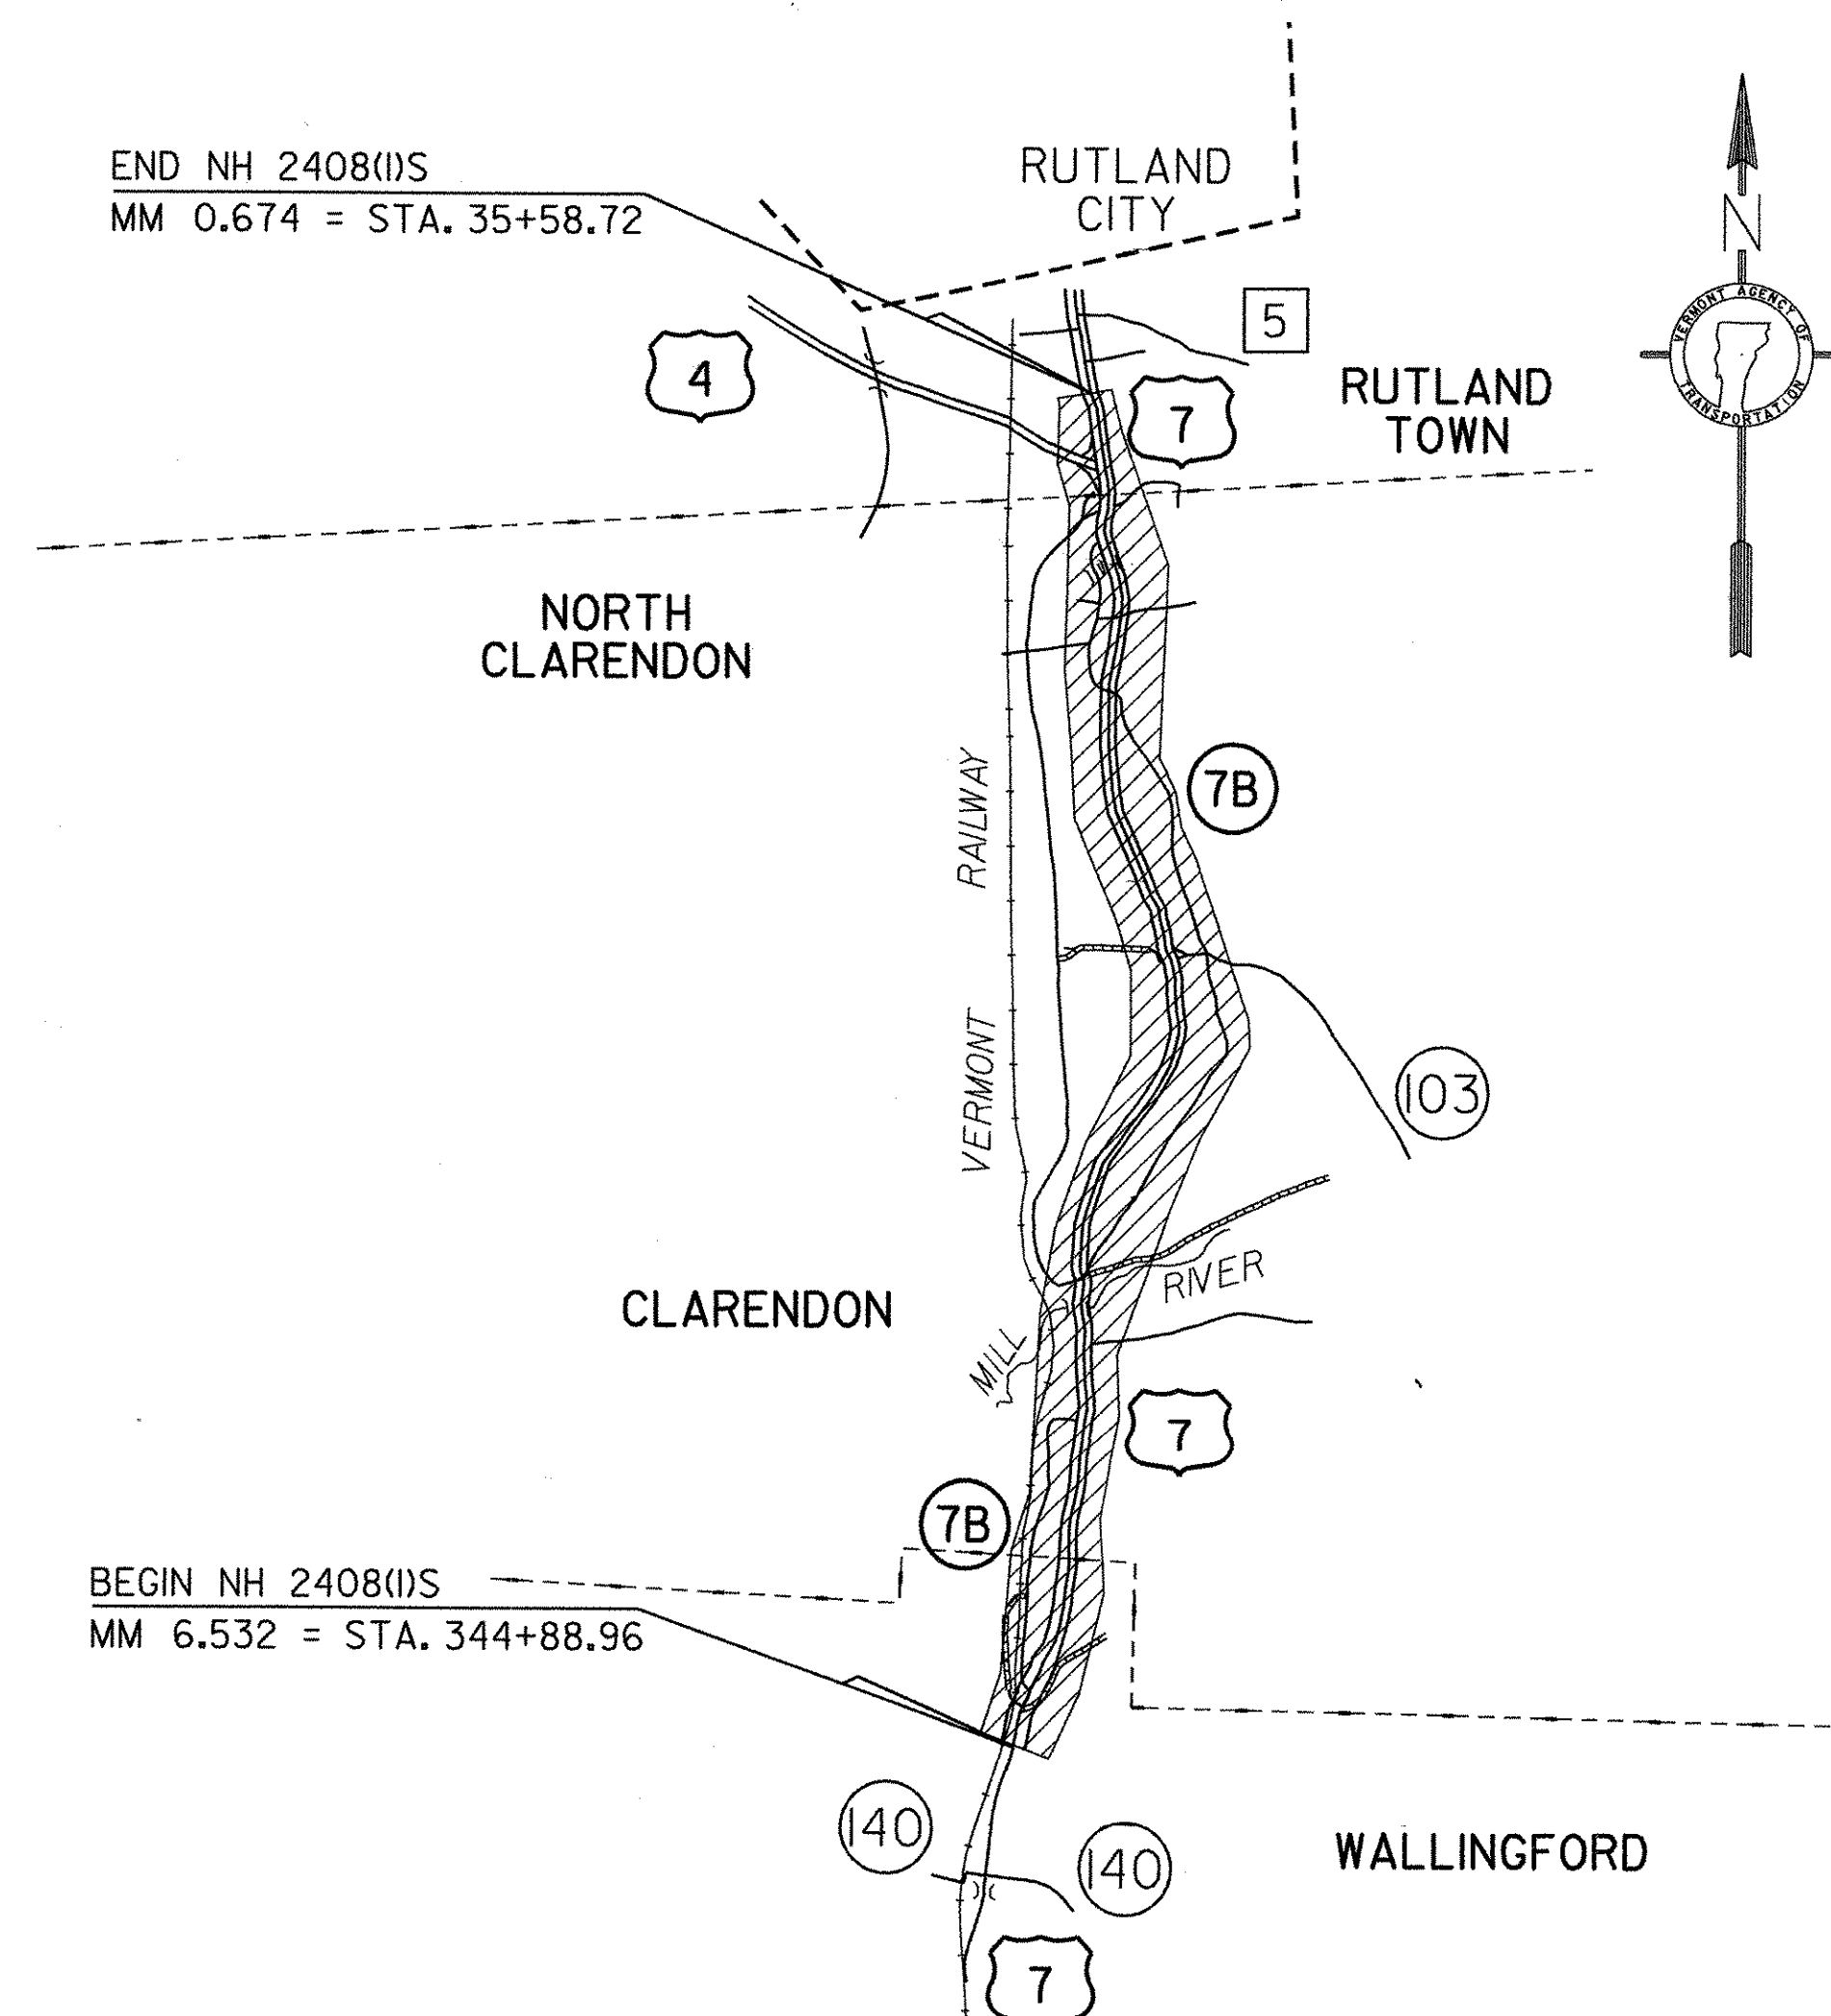

### TRAFFIC DATA

| LOCATION                                                      | ADT    |        | DHV  |      | ESALS     | ESALS     |
|---------------------------------------------------------------|--------|--------|------|------|-----------|-----------|
|                                                               | 2005   | 2015   | 2005 | 2015 | 2005-2015 | 2005-2025 |
| WALLINGFORD MM 6.532 TO CLARENDON MM 0.752 (SOUTHBOUND LANES) | 3700   | 4000   | 370  | 400  | 857,000   | 2,219,000 |
| CLARENDON MM 0.752 TO CLARENDON MM 1.466 (SOUTHBOUND LANES)   | 4500   | 4800   | 450  | 480  | 912,000   | 2,345,000 |
| CLARENDON MM 1.466 TO CLARENDON MM 3.334 (SOUTHBOUND LANES)   | 4200   | 4500   | 420  | 450  | 1,009,000 | 2,600,000 |
| CLARENDON MM 3.334 TO CLARENDON MM 5.189 (SOUTHBOUND LANES)   | 7200   | 7800   | 710  | 770  | 2,148,000 | 5,541,000 |
| CLARENDON MM 5.189 TO RUTLAND MM 0.108 (SOUTHBOUND LANES)     | 8500   | 9100   | 840  | 900  | 2,363,000 | 6,068,000 |
| RUTLAND MM 0.108 TO RUTLAND MM 0.366 (SOUTHBOUND LANES)       | 8600   | 9200   | 850  | 910  | 2,596,000 | 6,644,000 |
| RUTLAND MM 0.366 TO RUTLAND MM 0.674 (SOUTHBOUND LANES)       | 11,400 | 12,300 | 1100 | 1200 | 2,859,000 | 7,348,000 |

### CONVENTIONAL SYMBOLS

|                    |           |
|--------------------|-----------|
| COUNTY LINE        | ---       |
| TOWN LINE          | ---       |
| LIMITS OF ACCESS   | ---       |
| POINT OF ACCESS    | X         |
| FENCE LINE         | X X X X X |
| STONE WALL         | -----     |
| TRAVELED WAY       | -----     |
| GUARD RAIL         | -----     |
| RAILROAD           | -----     |
| SURVEY LINE        | ---       |
| CULVERT            | ---       |
| POWER POLE         | ---       |
| TELEPHONE POLE     | ---       |
| TREES              | ---       |
| CONTROL OF ACCESS  | ---       |
| PROPERTY LINE      | ---       |
| R.O.W. TAKING LINE | SR        |
| SLOPE RIGHTS       | ---       |
| TOP OF CUT         | ---       |
| TOE OF SLOPE       | ---       |

PLANS PREPARED BY

**CHA**

CLOUGH HARBOUR & ASSOCIATES LLP  
111 Winemans Circle, PO Box 5289, Albany, NY 12205  
Main: (518) 453-4500 • www.cloughharbour.com

BY:

SURVEYED BY : NA  
SURVEYED DATE : NA

DATUM

VERTICAL NA  
HORIZONTAL NA

THESE PLANS ARE SUBJECT TO SUCH ENGINEERING CHANGES AS MAY BE REQUIRED BY THE FEDERAL HIGHWAY ADMINISTRATION OR THE DIRECTOR OF PROGRAM DEVELOPMENT.

CONSTRUCTION IS TO BE CARRIED ON IN ACCORDANCE WITH THESE PLANS AND THE STANDARD SPECIFICATIONS FOR CONSTRUCTION DATED 2001, AS APPROVED BY THE FEDERAL HIGHWAY ADMINISTRATION ON JANUARY 4, 2001 FOR USE ON THIS PROJECT, INCLUDING ALL SUBSEQUENT REVISIONS AND SUCH REVISED SPECIFICATIONS AND SPECIAL PROVISIONS AS ARE INCORPORATED IN THESE PLANS.

|                                         |
|-----------------------------------------|
| DIRECTOR OF PROGRAM DEVELOPMENT         |
| APPROVED  DATE 11-10-05                 |
| PROJECT MANAGER : WOOLAVER              |
| PROJECT NAME : WALLINGFORD-RUTLAND TOWN |
| PROJECT NUMBER : NH 2408 (1) S          |
| SHEET 1 OF 80 SHEETS                    |



INDEX OF SHEETS

INDEX OF SHEETS

|       |                                            |
|-------|--------------------------------------------|
| 1     | TITLE SHEET                                |
| 2     | INDEX OF SHEETS                            |
| 3     | PROJECT TYPICAL SHEET                      |
| 4-5   | PAVING DETAIL SHEETS                       |
| 6-8   | QUANTITY SHEETS                            |
| 9-II  | ITEM DETAIL SUMMARY SHEETS                 |
| 12    | DITCH CLEANING DETAIL SHEET                |
| 13-35 | LAYOUT SHEETS                              |
| 36    | PARKING AREA DETAIL SHEET                  |
| 37-40 | TRAFFIC LOOP LAYOUT SHEETS                 |
| 41-62 | TRAFFIC SIGN SUMMARY SHEETS                |
| 63-67 | TRAFFIC SIGN DETAIL SHEETS                 |
| 68-71 | TRAFFIC SIGN CROSS SECTIONS                |
| 72-74 | ALUMINUM APPROACH RAILING DETAIL SHEETS    |
| 75-76 | BRIDGE DETAIL SHEETS                       |
| 77-78 | MILLED RUMBLE STRIP DETAIL SHEETS          |
| 79    | MISCELLANEOUS DETAIL SHEET                 |
| 80    | CONSTRUCTION APPROACH SIGNING DETAIL SHEET |

VAOT STANDARDS

|        |                                                                            |
|--------|----------------------------------------------------------------------------|
| B-17   | DETAIL OF U-TURN                                                           |
| C-1    | TREATED TIMBER CURB                                                        |
| D-6    | REINFORCED CONCRETE DROP INLET W/GRATE (DITCHES)                           |
| D-9    | REINFORCED CONCRETE DROP INLET WITH VERTICAL CURB AND THROAT ADAPTER       |
| D-15   | CAST IRON GRATE WITH FRAME, TYPE D                                         |
| E-100  | CONSTRUCTION APPROACH SIGNS                                                |
| E-101  | CONSTRUCTION SIGN DETAILS                                                  |
| E-102  | CONSTRUCTION SIGN DETAILS                                                  |
| E-102A | CONSTRUCTION SIGN DETAILS                                                  |
| E-103  | MAINLINE TRAFFIC CONTROL DIVIDED HIGHWAY, ONE LANE CLOSED                  |
| E-105  | TRAFFIC CONTROL FOR CONSTRUCTION VEHICLE U-TURNS ON DIVIDED HIGHWAY        |
| E-106  | TRAFFIC CONTROL - MISCELLANEOUS DETAILS                                    |
| E-107  | DELINEATION, BARRICADES AND DETOURS FOR CONSTRUCTION AREAS                 |
| E-107A | BREAKAWAY BARRICADE DETAILS                                                |
| E-108  | CONSTRUCTION ZONE LONGITUDINAL DROP OFFS                                   |
| E-110  | MAJOR MAINTENANCE OPERATION LANE CLOSURE                                   |
| E-111  | MINOR MAINTENANCE OPERATION                                                |
| E-120  | STANDARD SIGN PLACEMENT - EXPRESSWAY AND FREEWAY                           |
| E-121  | STANDARD SIGN PLACEMENT - CONVENTIONAL ROAD                                |
| E-123  | GUIDE SIGN PLACEMENT - MISCELLANEOUS DETAILS                               |
| E-126  | TYPICAL FREEWAY INTERCHANGE SIGNING                                        |
| E-127  | ROUTE MARKINGS AT RURAL INTERSECTIONS                                      |
| E-128B | VILLAGE SIGNS N-W                                                          |
| E-130  | TYPE "B" GUIDE SIGN ATTACHMENT DETAILS                                     |
| E-131  | GUIDE SIGN DETAILS                                                         |
| E-134  | BRIDGE NUMBER PLAQUE                                                       |
| E-136A | U.S. ROUTE MARKER SIGN DETAILS                                             |
| E-136B | STATE ROUTE MARKER SIGN DETAILS                                            |
| E-138  | MILE MARKER DETAILS, STATE AND TOWN HIGHWAYS                               |
| E-140  | REGULATORY SIGNS DETAILS                                                   |
| E-141  | REGULATORY SIGNS DETAILS                                                   |
| E-142  | REGULATORY SIGNS DETAILS                                                   |
| E-143  | REGULATORY SIGNS DETAILS                                                   |
| E-144  | REGULATORY SIGNS DETAILS                                                   |
| E-145A | REGULATORY SIGN DETAILS LANE USE CONTROL SIGNS TWO AND FOUR LANE APPROACHS |
| E-145B | REGULATORY SIGN DETAILS LANE USE CONTROL SIGNS THREE LANE APPROACHS        |
| E-150  | WARNING SIGN DETAILS                                                       |
| E-151  | WARNING SIGN DETAILS                                                       |
| E-152  | WARNING SIGN DETAILS                                                       |
| E-155  | WARNING SIGN DETAILS                                                       |
| E-160  | FLANGED CHANNEL STEEL SIGN POST                                            |
| E-161  | W-SHAPED STEEL SIGN POST                                                   |
| E-163  | TUBULAR STEEL SIGN POST                                                    |
| E-164  | SQUARE STEEL SIGN POST                                                     |
| E-172  | VEHICLE DETECTOR LOOP DETAILS                                              |
| E-191  | PAVEMENT MARKING DETAILS                                                   |
| E-192  | PAVEMENT MARKING DETAILS                                                   |
| E-193  | PAVEMENT MARKING DETAILS                                                   |
| E-197  | DELINEATOR PLACEMENT TYPICAL                                               |
| E-198  | EXPRESSWAY DELINEATORS AND MILE POSTS                                      |
| E-199  | EXPRESSWAY DELINEATOR AND MILE POST MOUNTING ON BRIDGE RAIL                |
| G-1    | STEEL BEAM GUARDRAIL WITH STEEL POSTS                                      |
| G-1D   | ANCHOR FOR STEEL BEAM GUARDRAIL                                            |
| G-19   | GENERIC PLANS FOR GUARDRAIL END TERMINALS                                  |

|          |
|----------|
| 02-23-95 |
| 01-03-00 |
| 06-01-94 |
| 06-01-94 |
| 06-01-94 |
| 01-02-04 |
| 05-30-03 |
| 06-30-03 |
| 05-01-04 |
| 03-01-04 |
| 05-01-04 |
| 03-01-04 |
| 06-30-03 |
| 08-08-95 |
| 08-18-95 |
| 08-08-95 |
| 03-11-97 |
| 08-08-95 |
| 08-08-95 |
| 03-16-04 |
| 02-01-00 |
| 08-08-95 |
| 08-08-95 |
| 05-30-03 |
| 08-30-96 |
| 09-20-95 |
| 09-20-95 |
| 06-15-04 |
| 03-29-99 |
| 12-23-94 |
| 12-23-94 |
| 05-01-04 |
| 05-01-04 |
| 05-01-04 |
| 05-01-04 |
| 05-20-99 |
| 08-18-95 |
| 05-20-99 |
| 05-20-99 |
| 08-09-95 |
| 02-01-99 |
| 10-12-00 |
| 08-18-95 |
| 04-01-05 |
| 04-01-05 |
| 04-01-05 |
| 01-03-00 |
| 01-03-00 |
| 11-15-02 |

|                       |                                                                                                    |                                                                                |
|-----------------------|----------------------------------------------------------------------------------------------------|--------------------------------------------------------------------------------|
| INDEX<br>OF<br>SHEETS | PROJECT NAME: WALLINGFORD - RUTLAND TOWN                                                           |                                                                                |
|                       | PROJECT NUMBER: NH 2408(I)S                                                                        |                                                                                |
|                       | FILE NAME: p04b050.dgn<br>PROJECT LEADER: D.E.G.<br>DESIGNED BY: J.S.P.<br>IPARM FILE: p04b0501s.i | PLOT DATE: \$DATE\$<br>DRAWN BY: C.A.K.<br>CHECKED BY: D.E.G.<br>SHEET 2 OF 80 |



NOTES

- I. THE WEARING COURSE SHALL BE TYPE IIIS SUPERPAVE BITUMINOUS CONCRETE PAVEMENT. THE LEVELING COURSE SHALL BE TYPE IVS SUPERPAVE BITUMINOUS CONCRETE PAVEMENT. ASPHALT CEMENT USED IN THE SUPERPAVE BITUMINOUS CONCRETE PAVEMENT SHALL BE PG 64-28.

2. EMULSIFIED ASPHALT SHALL BE APPLIED ON ALL EXISTING PAVEMENT SURFACES, BETWEEN ALL COURSES OF PAVEMENT AND ON COLD PLANED SURFACES AT THE RATE OF 0.015 GAL/SY OR AS DIRECTED BY THE RESIDENT ENGINEER.

3. SUPERPAVE BITUMINOUS CONCRETE PAVEMENT TOLERANCE = +/- 1/4" (TOTAL PAVEMENT THICKNESS EXCLUDING LEVELING).

4. COLD PLANING TO BE COMPLETED ACCORDING TO THE TYPICAL OR AS NOTED OTHERWISE ON THE PLANS. A FULL-DEPTH BUTT JOINT SHALL BE CONSTRUCTED AT ALL RAMP AND SIDE ROAD APPROACHES AS DENOTED ON THE PROJECT PLANS OR AS DIRECTED BY THE RESIDENT ENGINEER.

5. ALL EDGES OF PAVEMENT AND TREATED TIMBER CURB SHALL BE BACKED UP TO FULL HEIGHT WITH COLD PLANE GRINDINGS AS DIRECTED BY THE RESIDENT ENGINEER AND WILL BE PAID FOR UNDER ITEM 402.12 AGGREGATE SHOULDERS (MOD.).

6. ITEM 616.47 BITUMINOUS CONCRETE GUTTERS AND TRAFFIC ISLANDS WILL BE PAID ONLY WHERE SPECIFIED IN THE PLANS OR AS DIRECTED BY THE RESIDENT ENGINEER. ALL OTHER BITUMINOUS CONCRETE PAVEMENT WORK WHICH COULD INVOLVE SOME HAND-WORK (SUCH AS DRIVEWAYS AND AROUND DROP INLETS ETC.) SHALL BE PAID FOR AT THE CONTRACT PRICE FOR ITEM 490.30 SUPERPAVE BITUMINOUS CONCRETE PAVEMENT (PG 64-28).

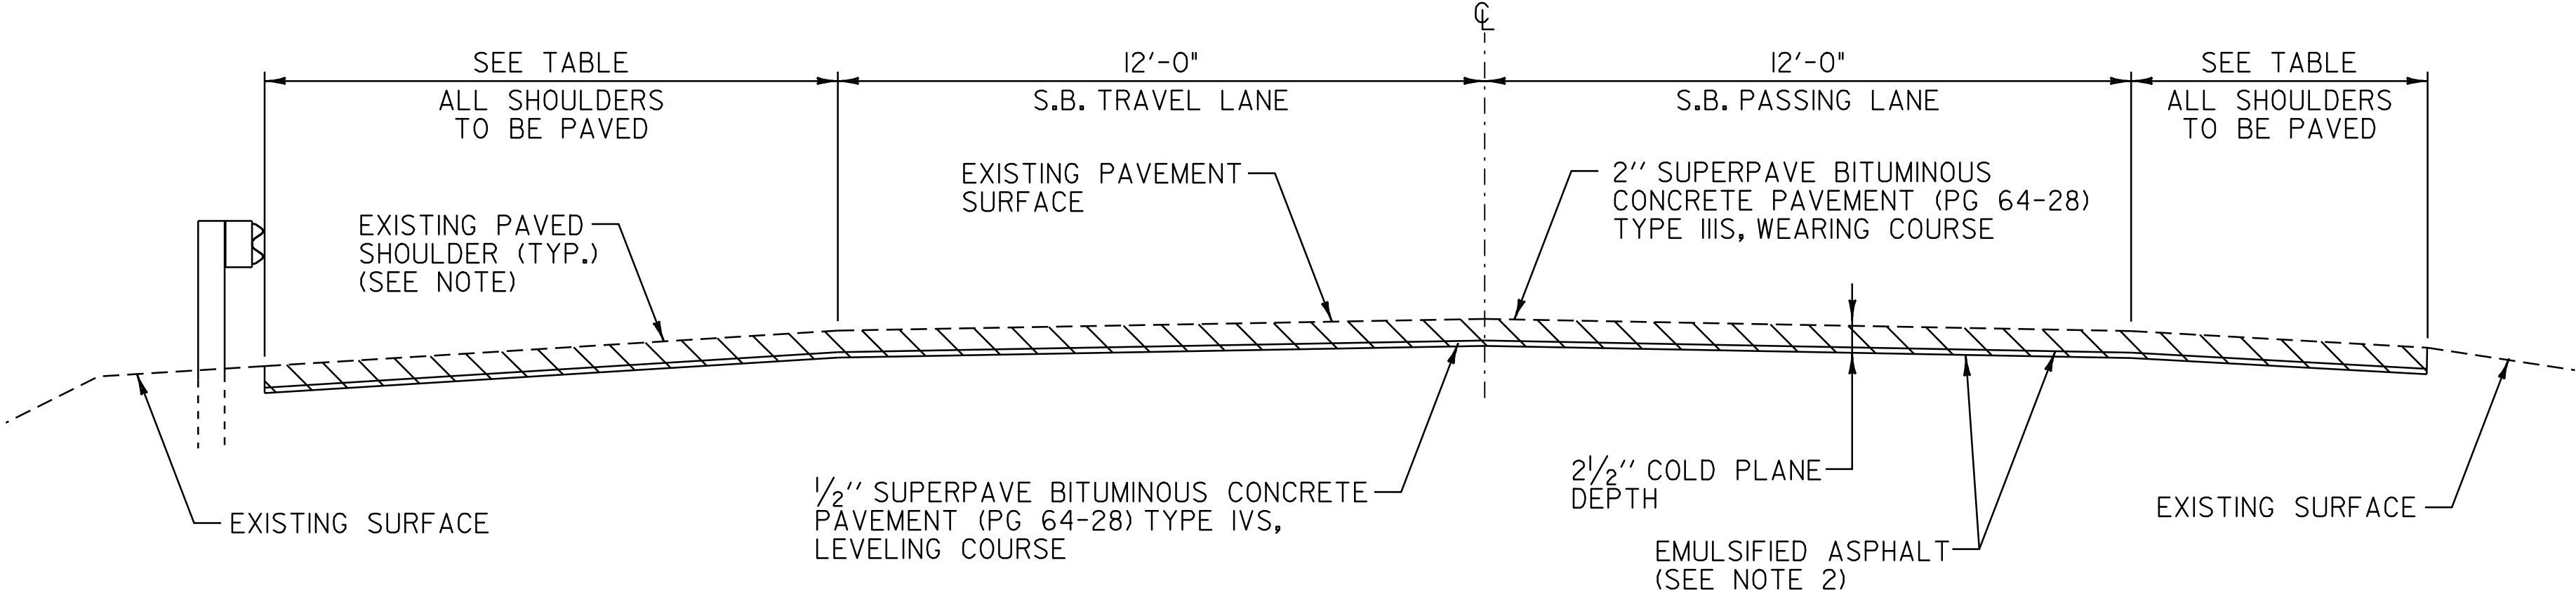
7. PIPE INLET AND OUTLET AREAS AND AREAS OF DITCH CLEANING THROUGHOUT THE PROJECT SHALL BE PERFORMED AT LOCATIONS SPECIFIED ON PLANS OR AS DIRECTED BY THE RESIDENT ENGINEER. PAYMENT SHALL BE MADE UNDER APPLICABLE RENTAL ITEM(S).

8. DITCHING MATERIAL OR EARTH BORROW SHALL BE USED FOR THE CONSTRUCTION OF MANUFACTURED TERMINAL FLARES WHICH SHALL BE CAPPED WITH AN ESTIMATED 3" DEPTH OF AGGREGATE SHOULDER MATERIAL (MOD.) AS DIRECTED BY THE RESIDENT ENGINEER. THE QUANTITIES INCLUDED REFLECT 5 TONS OF AGGREGATE SHOULDER MATERIAL (MOD.) AND 25 CUBIC YARDS OF DITCHING MATERIAL OR EARTH BORROW FOR EACH GUARDRAIL TERMINAL.

9. ALL SALVAGEABLE STEEL BEAM GUARDRAIL AND 1500 TONS OF COLD PLANE GRINDINGS SHALL REMAIN THE PROPERTY OF THE STATE OF VERMONT. THE CONTRACTOR SHALL LOAD THESE MATERIALS ONTO SUITABLE TRANSPORT AND DELIVER THEM TO THE STATE OF VERMONT MAINTENANCE FACILITIES IN RUTLAND. THE CONTRACTOR SHALL CONTACT DISTRICT #3 ADMINISTRATOR DAVE LATHROP AT (802) 786-5826 AT LEAST TWO WEEKS PRIOR TO DELIVERY TO COORDINATE ACCESS, ETC. THE STATE OF VERMONT WILL PROVIDE THE LOCATION, EQUIPMENT AND PERSONNEL TO STOCKPILE THESE MATERIALS. ALL COSTS WILL NOT BE PAID DIRECTLY BUT WILL BE CONSIDERED INCIDENTAL TO THE ITEM(S) UNDER WHICH THEY WERE REMOVED.

10. AN ESTIMATED QUANTITY OF ITEM 619.17 YIELDING MARKER POSTS HAS BEEN INCLUDED TO DELINEATE PIPE INLETS, PIPE OUTLETS AND DROP INLETS LOCATED OUTSIDE OF THE PAVEMENT SURFACE OR AS DIRECTED BY THE RESIDENT ENGINEER.

II. THE PROPOSED GUARDRAIL SHALL BE INSTALLED IN A LOCATION THAT MAXIMIZES THE DISTANCE FROM THE CENTER OF THE ROAD TO THE FACE OF GUARDRAIL. 3' OF BACKING IS REQUIRED BEHIND THE FACE OF GUARDRAIL WITH 6' POSTS. IF THIS CANNOT BE OBTAINED, THEN 8' POSTS SHALL BE USED.



MAINLINE TYPICAL SECTION  
SOUTHBOUND

|              |                |                 |                |
|--------------|----------------|-----------------|----------------|
| WALLINGFORD  | STA. 344+88.96 | TO WALLINGFORD  | STA. 374+66.88 |
| CLARENDON    | STA. 0+00.00   | TO CLARENDON    | STA. 68+94.00  |
| CLARENDON    | STA. 72+31.00  | TO CLARENDON    | STA. 288+13.00 |
| CLARENDON    | STA. 289+42.00 | TO CLARENDON    | STA. 298+47.84 |
| RUTLAND TOWN | STA. 0+00.00   | TO RUTLAND TOWN | STA. 35+58.72  |

NOTE:  
SHOULDERS HAVE APPROXIMATELY 1" TO 3" OF EXISTING PAVEMENT, SEE PAVEMENT CORE INFORMATION ON LAYOUT SHEETS FOR MORE DETAILS.

PROJECT PAVING LIMITS

| TOWN & ROUTE  | BEGIN STATION | END STATION | LANE TYPICAL                     | WEARING DEPTH | LEVELING TON | NOTES                                                                |
|---------------|---------------|-------------|----------------------------------|---------------|--------------|----------------------------------------------------------------------|
| WALLINGFORD:  |               |             |                                  |               |              |                                                                      |
| U.S. ROUTE 7  | 344+88.96     | 359+00.00   | 10'-0" - 12'-0" - 12'-0" - 1'-0" | 2"            | 147          | COLD PLANE 2 1/2", LEVEL WITH 1/2" TYPE IVS & PAVE WITH 2" TYPE IIIS |
| U.S. ROUTE 7  | 359+00.00     | 374+66.88   | 10'-0" - 12'-0" - 12'-0" - 4'-0" | 2"            | 186          | COLD PLANE 2 1/2", LEVEL WITH 1/2" TYPE IVS & PAVE WITH 2" TYPE IIIS |
|               |               |             |                                  |               |              |                                                                      |
| CLARENDON:    |               |             |                                  |               |              |                                                                      |
| U.S. ROUTE 7  | 0+00.00       | 39+30.00    | 10'-0" - 12'-0" - 12'-0" - 4'-0" | 2"            | 466          | COLD PLANE 2 1/2", LEVEL WITH 1/2" TYPE IVS & PAVE WITH 2" TYPE IIIS |
| U.S. ROUTE 7  | 39+30.00      | 45+00.00    | VARIES - SEE LAYOUT              | 2"            | 74           | COLD PLANE 2 1/2", LEVEL WITH 1/2" TYPE IVS & PAVE WITH 2" TYPE IIIS |
| U.S. ROUTE 7  | 45+00.00      | 60+30.00    | 10'-0" - 12'-0" - 12'-0" - 4'-0" | 2"            | 182          | COLD PLANE 2 1/2", LEVEL WITH 1/2" TYPE IVS & PAVE WITH 2" TYPE IIIS |
| U.S. ROUTE 7  | 60+30.00      | 68+94.00    | VARIES - SEE LAYOUT              | 2"            | 115          | COLD PLANE 2 1/2", LEVEL WITH 1/2" TYPE IVS & PAVE WITH 2" TYPE IIIS |
| U.S. ROUTE 7  | 68+94.00      | 72+31.00    | 3'-0" - 12'-0" - 12'-0" - 3'-0"  | 1 1/4"        | -            | BR 90 COLD PLANE 1 1/4", PAVE WITH 1 1/4" TYPE IVS                   |
| U.S. ROUTE 7  | 72+31.00      | 82+75.00    | VARIES - SEE LAYOUT              | 2"            | 177          | COLD PLANE 2 1/2", LEVEL WITH 1/2" TYPE IVS & PAVE WITH 2" TYPE IIIS |
| U.S. ROUTE 7  | 82+75.00      | 118+00.00   | 10'-0" - 12'-0" - 12'-0" - 4'-0" | 2"            | 419          | COLD PLANE 2 1/2", LEVEL WITH 1/2" TYPE IVS & PAVE WITH 2" TYPE IIIS |
| U.S. ROUTE 7  | 118+00.00     | 140+50.00   | VARIES - SEE LAYOUT              | 2"            | 295          | COLD PLANE 2 1/2", LEVEL WITH 1/2" TYPE IVS & PAVE WITH 2" TYPE IIIS |
| U.S. ROUTE 7  | 140+50.00     | 175+00.00   | 10'-0" - 12'-0" - 12'-0" - 4'-0" | 2"            | 410          | COLD PLANE 2 1/2", LEVEL WITH 1/2" TYPE IVS & PAVE WITH 2" TYPE IIIS |
| U.S. ROUTE 7  | 175+00.00     | 177+25.00   | NO PAVING                        |               |              | NHG SGNL(24)                                                         |
| U.S. ROUTE 7  | 177+25.00     | 182+70.00   | VARIES - SEE LAYOUT              | 2"            | 80           | COLD PLANE 2 1/2", LEVEL WITH 1/2" TYPE IVS & PAVE WITH 2" TYPE IIIS |
| U.S. ROUTE 7  | 182+70.00     | 231+25.00   | 10'-0" - 12'-0" - 12'-0" - 4'-0" | 2"            | 576          | COLD PLANE 2 1/2", LEVEL WITH 1/2" TYPE IVS & PAVE WITH 2" TYPE IIIS |
| U.S. ROUTE 7  | 231+25.00     | 250+80.00   | 10'-0" - 12'-0" - 12'-0" - 1'-0" | 2"            | 214          | COLD PLANE 2 1/2", LEVEL WITH 1/2" TYPE IVS & PAVE WITH 2" TYPE IIIS |
| U.S. ROUTE 7  | 250+80.00     | 256+60.00   | VARIES - SEE LAYOUT              | 2"            | 79           | COLD PLANE 2 1/2", LEVEL WITH 1/2" TYPE IVS & PAVE WITH 2" TYPE IIIS |
| U.S. ROUTE 7  | 256+60.00     | 273+35.00   | 10'-0" - 12'-0" - 12'-0" - 1'-0" | 2"            | 183          | COLD PLANE 2 1/2", LEVEL WITH 1/2" TYPE IVS & PAVE WITH 2" TYPE IIIS |
| U.S. ROUTE 7  | 273+35.00     | 279+00.00   | VARIES - SEE LAYOUT              | 2"            | 80           | COLD PLANE 2 1/2", LEVEL WITH 1/2" TYPE IVS & PAVE WITH 2" TYPE IIIS |
| U.S. ROUTE 7  | 279+00.00     | 288+13.00   | 10'-0" - 12'-0" - 12'-0" - 1'-0" | 2"            | 99           | COLD PLANE 2 1/2", LEVEL WITH 1/2" TYPE IVS & PAVE WITH 2" TYPE IIIS |
| U.S. ROUTE 7  | 288+13.00     | 289+42.00   | 2'-6" - 12'-0" - 12'-0" - 1'-0"  | 1 1/4"        | -            | BR 96 COLD PLANE 1 1/4", PAVE WITH 1 1/4" TYPE IVS                   |
| U.S. ROUTE 7  | 289+42.00     | 298+47.84   | VARIES - SEE LAYOUT              | 2"            | 80           | COLD PLANE 2 1/2", LEVEL WITH 1/2" TYPE IVS & PAVE WITH 2" TYPE IIIS |
|               |               |             |                                  |               |              |                                                                      |
| RUTLAND TOWN: |               |             |                                  |               |              |                                                                      |
| U.S. ROUTE 7  | 0+00.00       | 1+00.00     | VARIES - SEE LAYOUT              | 2"            | 12           | COLD PLANE 2 1/2", LEVEL WITH 1/2" TYPE IVS & PAVE WITH 2" TYPE IIIS |
| U.S. ROUTE 7  | 1+00.00       | 5+20.00     | 10'-0" - 12'-0" - 12'-0" - 1'-0" | 2"            | 46           | COLD PLANE 2 1/2", LEVEL WITH 1/2" TYPE IVS & PAVE WITH 2" TYPE IIIS |
| U.S. ROUTE 7  | 5+20.00       | 26+75.00    | VARIES - SEE LAYOUT              | 2"            | 318          | COLD PLANE 2 1/2", LEVEL WITH 1/2" TYPE IVS & PAVE WITH 2" TYPE IIIS |
| U.S. ROUTE 7  | 26+75.00      | 35+58.72    | 10'-0" - 12'-0" - 12'-0" - 1'-0" | 2"            | 105          | COLD PLANE 2 1/2", LEVEL WITH 1/2" TYPE IVS & PAVE WITH 2" TYPE IIIS |

CONSERVATION SEED MIX

| RURAL AREA - SEED MIXTURE |         |                     |       |        |
|---------------------------|---------|---------------------|-------|--------|
| % WT.                     | LBS./A. | NAME                | PUR.% | GERM.% |
| 37.5                      | 22.5    | CREEPING RED FESCUE | 98    | 85     |
| 37.5                      | 22.5    | TALL FESCUE         | 95    | 90     |
| 5.0                       | 3.0     | RED TOP             | 95    | 90     |
| 15.0                      | 9.0     | BIRDSFOOT TREFOIL   | 98    | 85     |
| 5.0                       | 3.0     | ANNUAL RYEGRASS     | 95    | 85     |
| 100.0                     | 60.0    |                     |       |        |

SEED MIXTURE:  
SHALL NOT HAVE A WEED CONTENT EXCEEDING 0.40% BY WEIGHT AND SHALL BE FREE OF ALL NOXIOUS WEED SEED.

SEED:  
TO BE APPLIED PER SEEDING FORMULA OR AS DIRECTED BY THE RESIDENT ENGINEER.

FERTILIZER:  
FORMULA 10-20-10 TO BE USED WITH SEED, APPLIED AT THE RATE OF 500 LBS/ACRE (HYDRO SEEDERS MAY USE 19-19-19 FORMULA).

AGRICULTURAL LIMESTONE:  
TO BE APPLIED AT THE RATE OF 2 TONS/ACRE OR AS DIRECTED BY THE RESIDENT ENGINEER.


HAY MULCH:  
TO BE APPLIED ON EARTH SLOPES AT THE RATE OF 2 TONS/ACRE OR AS DIRECTED BY THE RESIDENT ENGINEER.

TOPSOIL:  
TO BE USED WITH SEED AS INDICATED ON THE PLANS OR AS DIRECTED BY THE RESIDENT ENGINEER.

PROJECT  
TYPICAL  
SHEET

|                          |                            |
|--------------------------|----------------------------|
| PROJECT NAME:            | WALLINGFORD - RUTLAND TOWN |
| PROJECT NUMBER:          | NH 2408(1)S                |
| FILE NAME: p04b050.dgn   | PLOT DATE: \$DATE\$        |
| PROJECT LEADER: D.E.G.   | DRAWN BY: C.A.K.           |
| DESIGNED BY: J.S.P.      | CHECKED BY: D.E.G.         |
| IPARM FILE: p04b050+ts.i | SHEET 3 OF 80              |



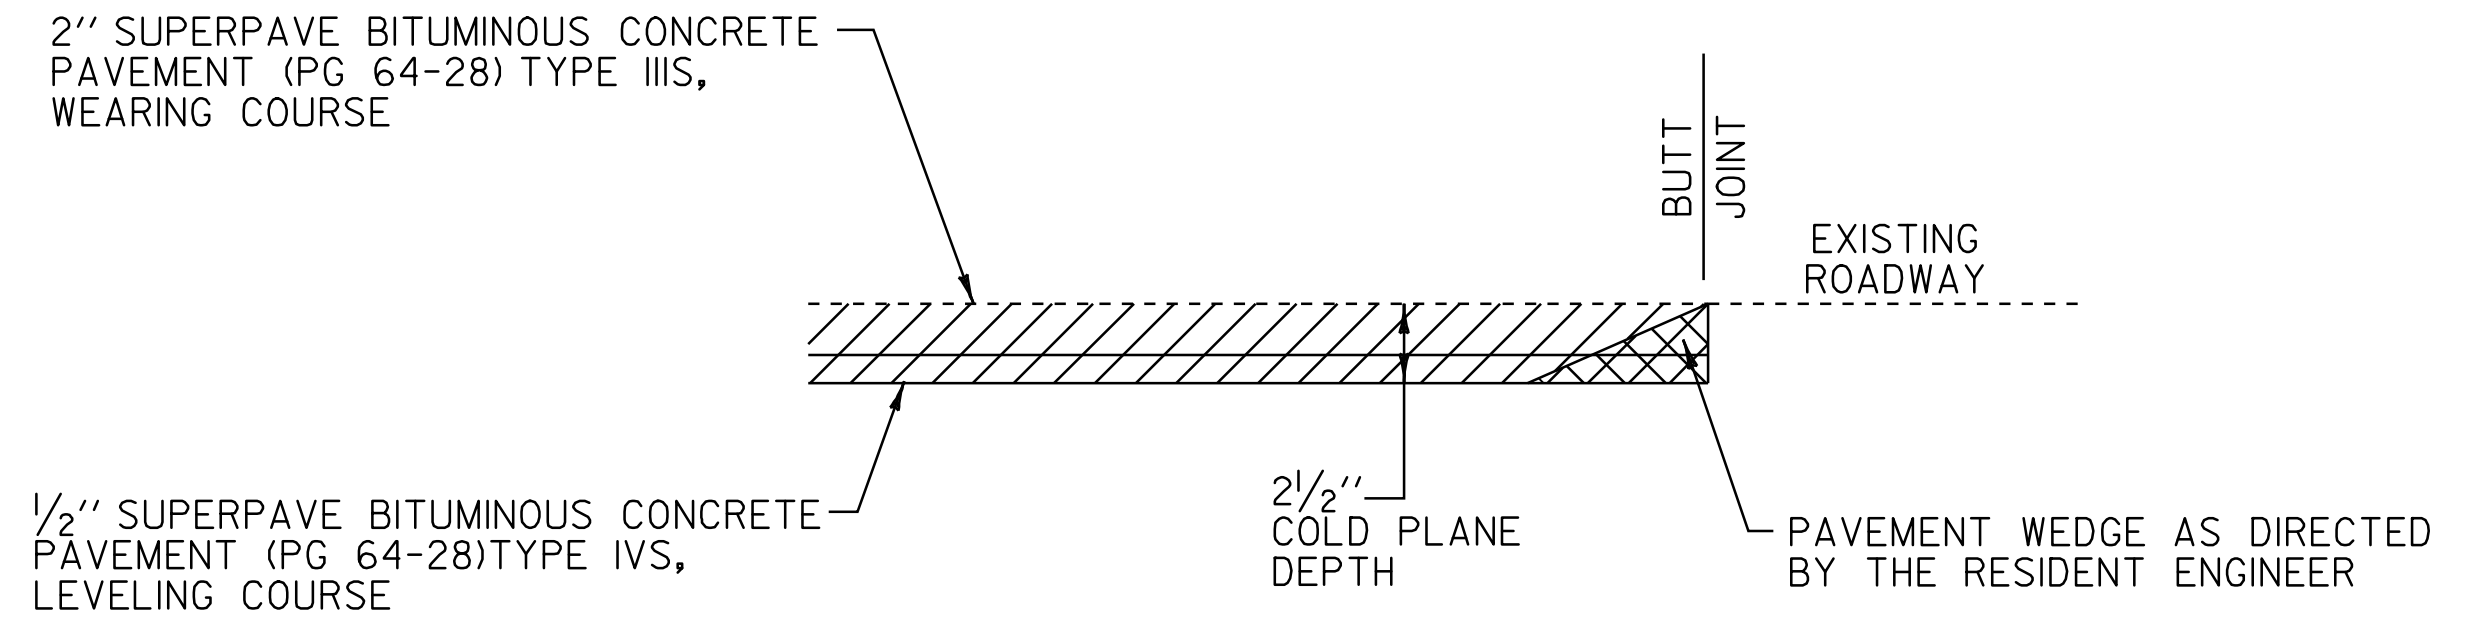

## MAINLINE APPROACH AREA DETAIL

## LOCATION

N.T.S.

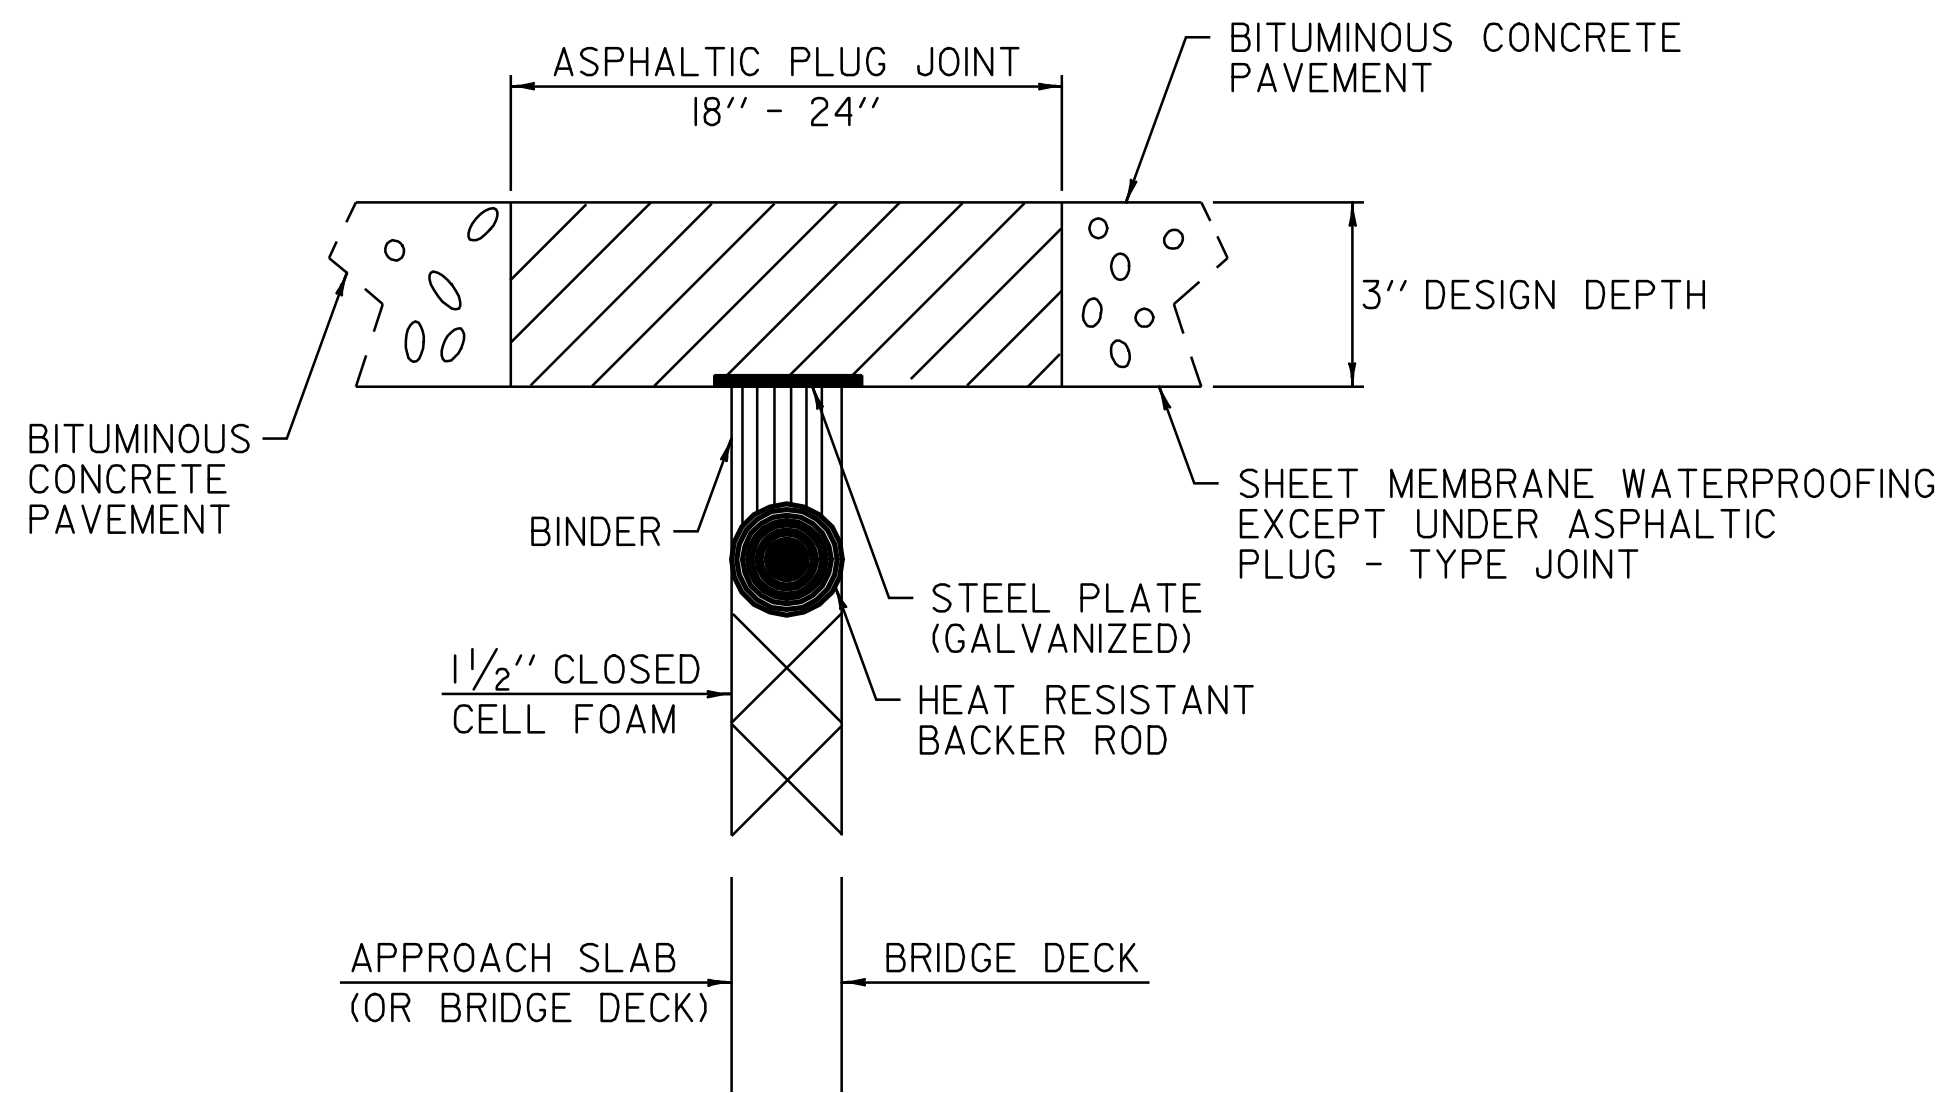
WALLINGFORD STA 344+88.96 - BEGINNING OF PROJECT  
RUTLAND TOWN STA. 35+58.72 - END OF PROJECT

## IN PROJECT ATION TIES




# PAVING DETAIL SHEET #1





**ASPHALTIC PLUG-TYPE  
JOINT DETAIL**

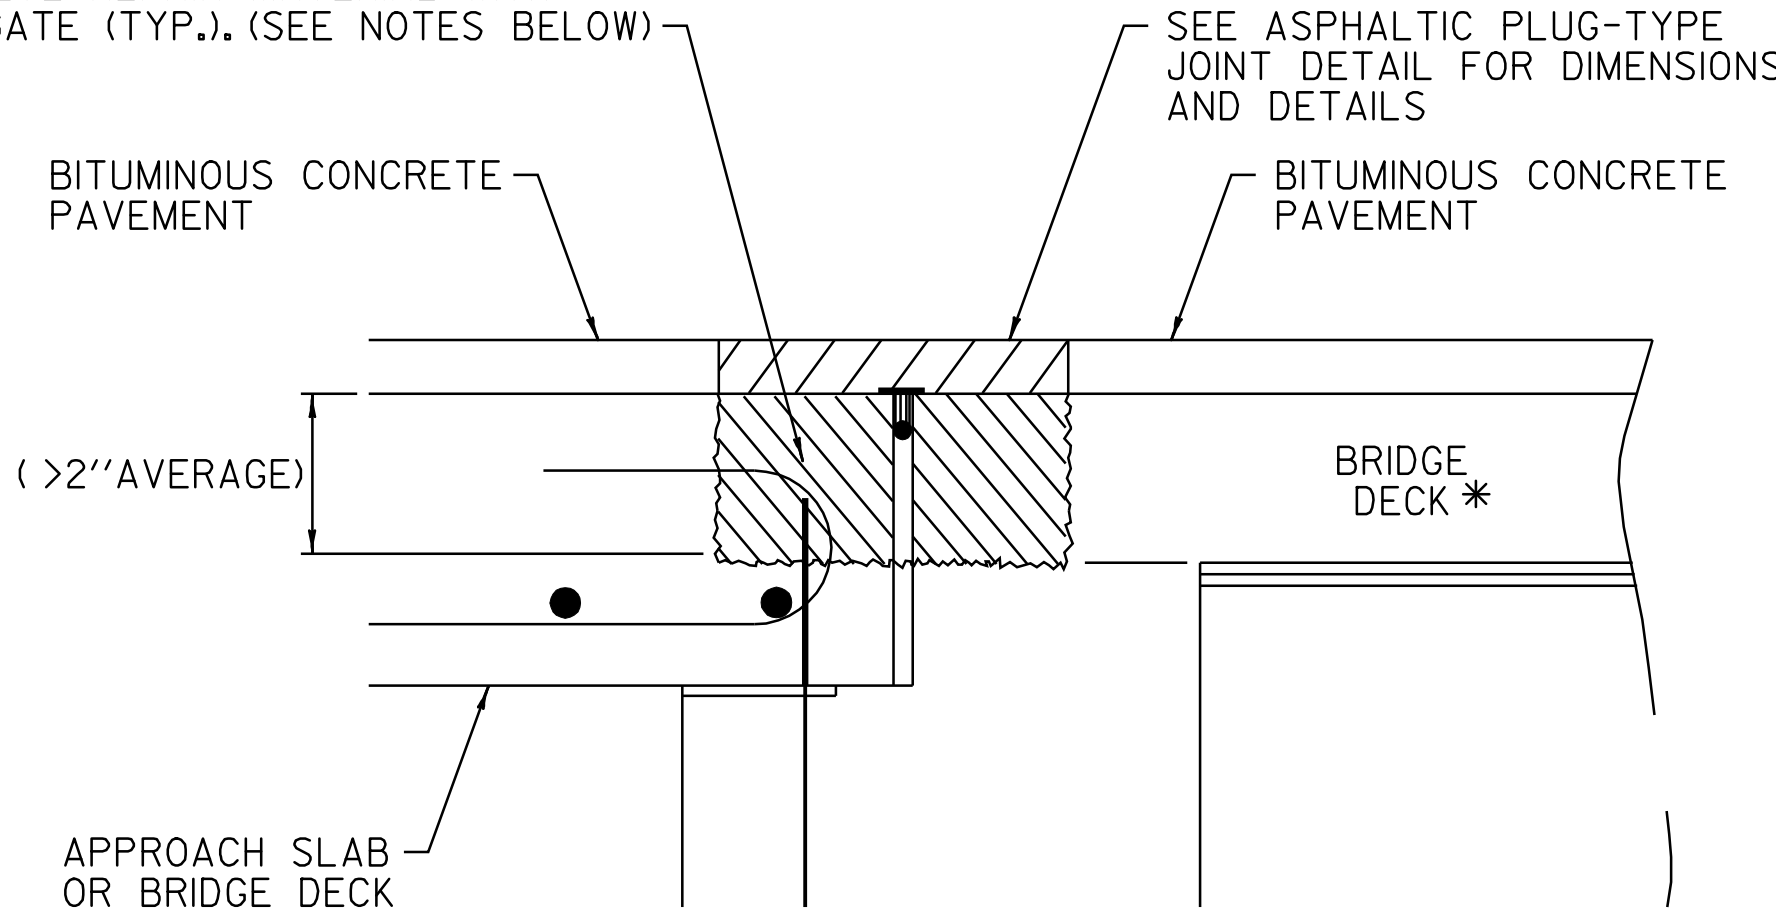DETERIORATED CONCRETE TO BE REMOVED  
AND FORMED TO EXISTING ELEV. WITH RAPID  
SETTING CONCRETE REPAIR MATERIAL WITH  
COARSE AGGREGATE (TYP.). (SEE NOTES BELOW)




\*BRIDGE DECK REINFORCEMENT  
NOT SHOWN FOR CLARITY

**ASPHALTIC PLUG-TYPE  
JOINT DETAIL  
REMOVAL OF >2"  
DETERIORATED CONCRETE**

NOTES:

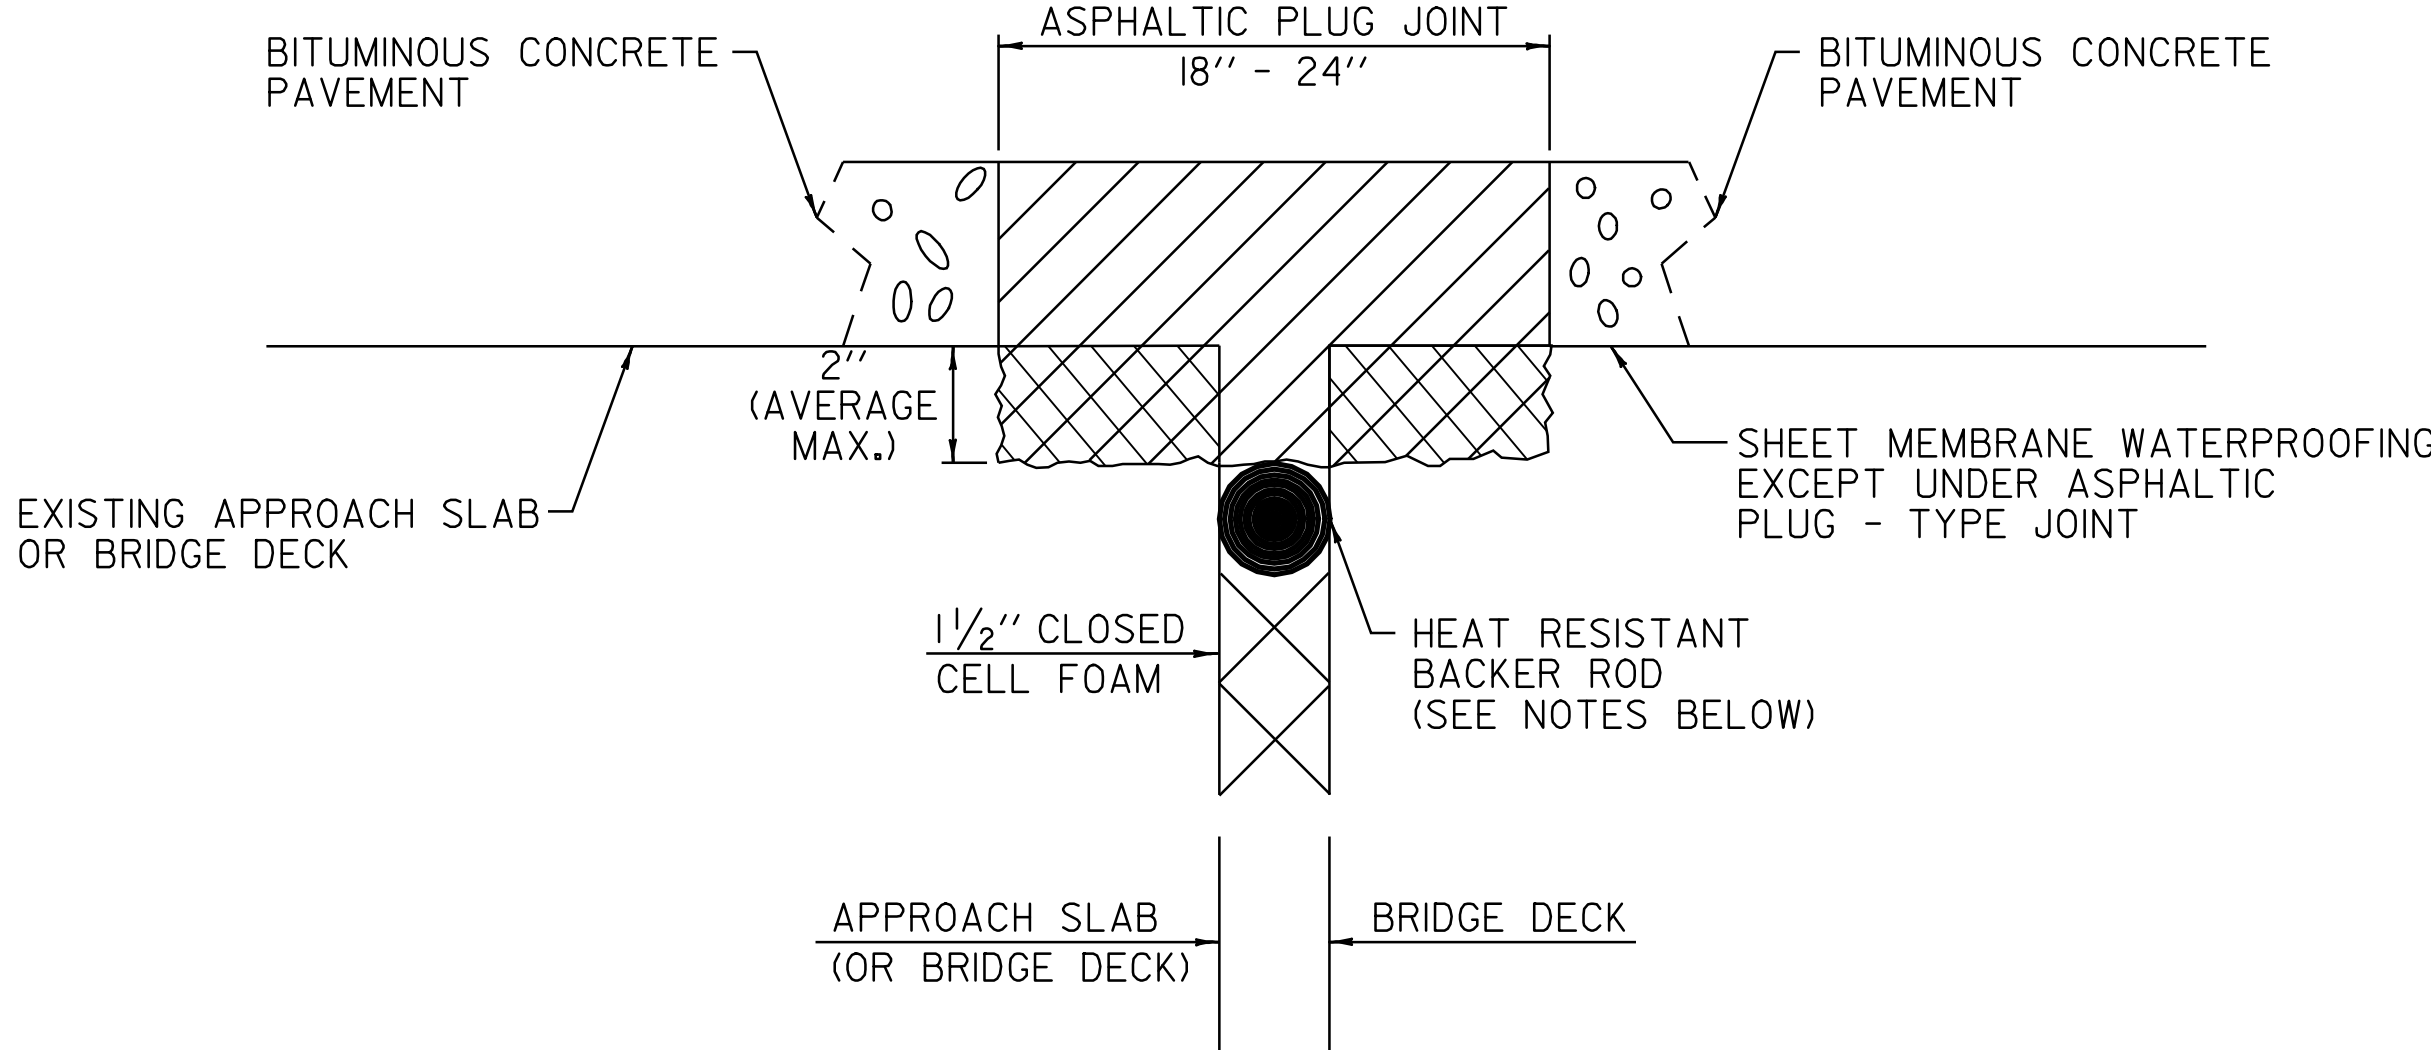- UPON ENCOUNTERING GREATER THAN 2" AVERAGE OF DETERIORATED CONCRETE, THE CONTRACTOR SHALL REMOVE THE DETERIORATED MATERIAL AND REPLACE IT WITH RAPID SETTING CONCRETE REPAIR MATERIAL WITH COARSE AGGREGATE.
- REMOVAL OF THE DETERIORATED CONCRETE WILL BE INCLUDED IN THE UNIT BID PRICE FOR ITEM 580.20 "RAPID SETTING CONCRETE REPAIR MATERIAL WITH COARSE AGGREGATE".
- THE STEEL PLATE IN THE ASPHALTIC PLUG JOINT MAY BE OMITTED ONLY IF THE REPAIRED SURFACE IS SO IRREGULAR IT WILL CAUSE VERTICAL MOVEMENT AND IT IS DIRECTED BY THE RESIDENT ENGINEER.




**ASPHALTIC PLUG-TYPE  
JOINT DETAIL  
REMOVAL OF UP TO  
2" DETERIORATED CONCRETE**

NOTES:

- UPON ENCOUNTERING UP TO 2" AVERAGE OF DETERIORATED CONCRETE, THE CONTRACTOR SHALL REMOVE THE DETERIORATED MATERIAL AND REPLACE IT WITH THE ASPHALTIC PLUG JOINT MATERIAL AS DIRECTED BY THE RESIDENT ENGINEER.
- REMOVAL OF THE DETERIORATED CONCRETE WILL NOT BE PAID SEPARATELY BUT WILL BE CONSIDERED INCIDENTAL TO THE UNIT BID PRICE FOR THE ITEM 516.10. THE ADDITIONAL PLUG JOINT MATERIAL BELOW THE DESIGN DEPTH TO REPLACE THE DETERIORATED CONCRETE WILL BE CONSIDERED INCIDENTAL TO THE UNIT BID PRICE FOR THE ITEM 516.10.
- THE STEEL PLATE IN THE ASPHALTIC PLUG JOINT MAY BE OMITTED AS SHOWN IN THE DETAIL ABOVE IF DIRECTED BY THE RESIDENT ENGINEER.

**BRIDGE JOINTS**

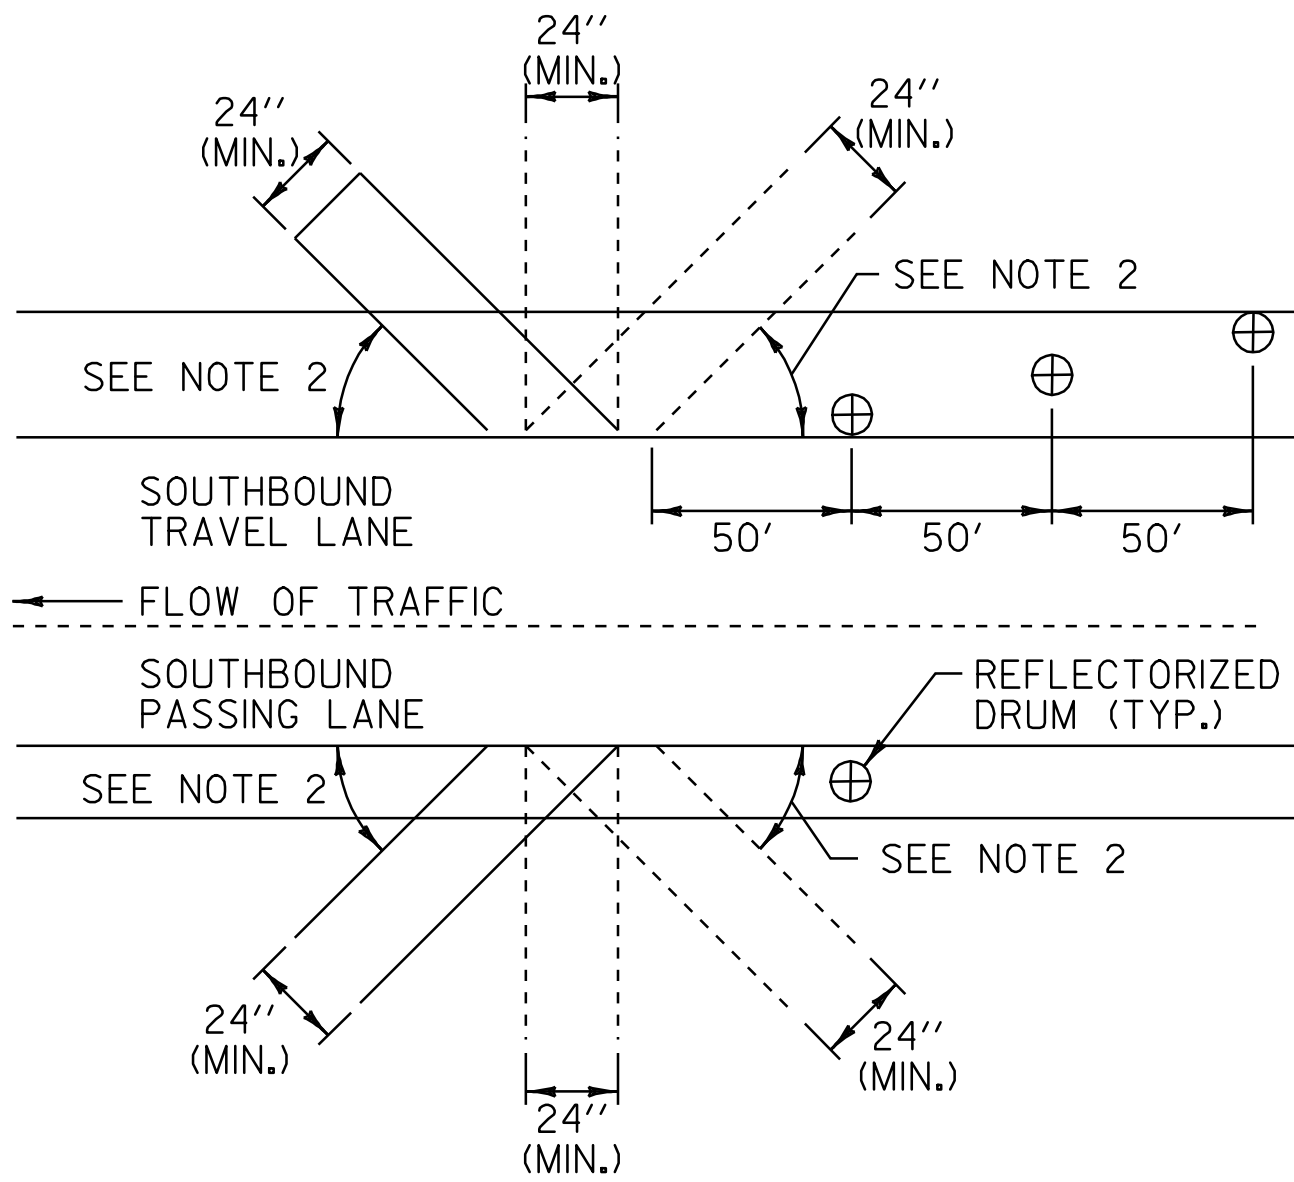BR 90 U.S. ROUTE 7 CLARENDON STA. 68+94 (30 FT)  
BR 90 U.S. ROUTE 7 CLARENDON STA. 72+31 (30 FT)  
BR 96 U.S. ROUTE 7 CLARENDON STA. 288+13 (28 FT)



**BLEEDER DETAIL**  
N.T.S.

NOTES:

- BLEEDERS ARE TO BE CUT WHILE COLD PLANING AT LOCATIONS SPECIFIED BY THE RESIDENT ENGINEER.
- ANGLE BLEEDERS TO BEST ACCEPT WATER FLOW.
- CUT ALL BLEEDERS TO THE DEPTH OF COLD PLANING AND GRADE TO DRAIN. PAYMENT INCIDENTAL TO ITEM 210.10.
- BLEEDERS ARE TO BE FILLED DURING PAVING WITH ITEM 490.30 OR AS DIRECTED BY THE RESIDENT ENGINEER.
- REFLECTORIZED DRUMS MUST BE PLACED AS SHOWN TO WARN MOTORISTS OF THE GAP IN THE SHOULDER.
- BLEEDERS SHALL NOT BE REQUIRED IF THE COLD PLANED AREAS ARE PAVED BACK THE SAME DAY AS DIRECTED BY THE RESIDENT ENGINEER.

**PAVING  
DETAIL  
SHEET #2**

PROJECT NAME: WALLINGFORD - RUTLAND TOWN  
PROJECT NUMBER: NH 2408(1)S

FILE NAME: p04b050.dgn  
PROJECT LEADER: D.E.G.  
DESIGNED BY: J.S.P.  
IPARM FILE: p04b050pd2.i  
PLOT DATE: \$DATE\$  
DRAWN BY: C.A.K.  
CHECKED BY: D.E.G.  
SHEET 5 OF 80



**STATE OF VERMONT**  
**AGENCY OF TRANSPORTATION**

[illegible][illegible]



**STATE OF VERMONT**  
**AGENCY OF TRANSPORTATION**

[illegible][illegible]



# QUANTITY SHEET 3

**STATE OF VERMONT**  
**AGENCY OF TRANSPORTATION**

[illegible][illegible][illegible]



# ITEM DETAIL SUMMARY SHEET 1

[illegible]



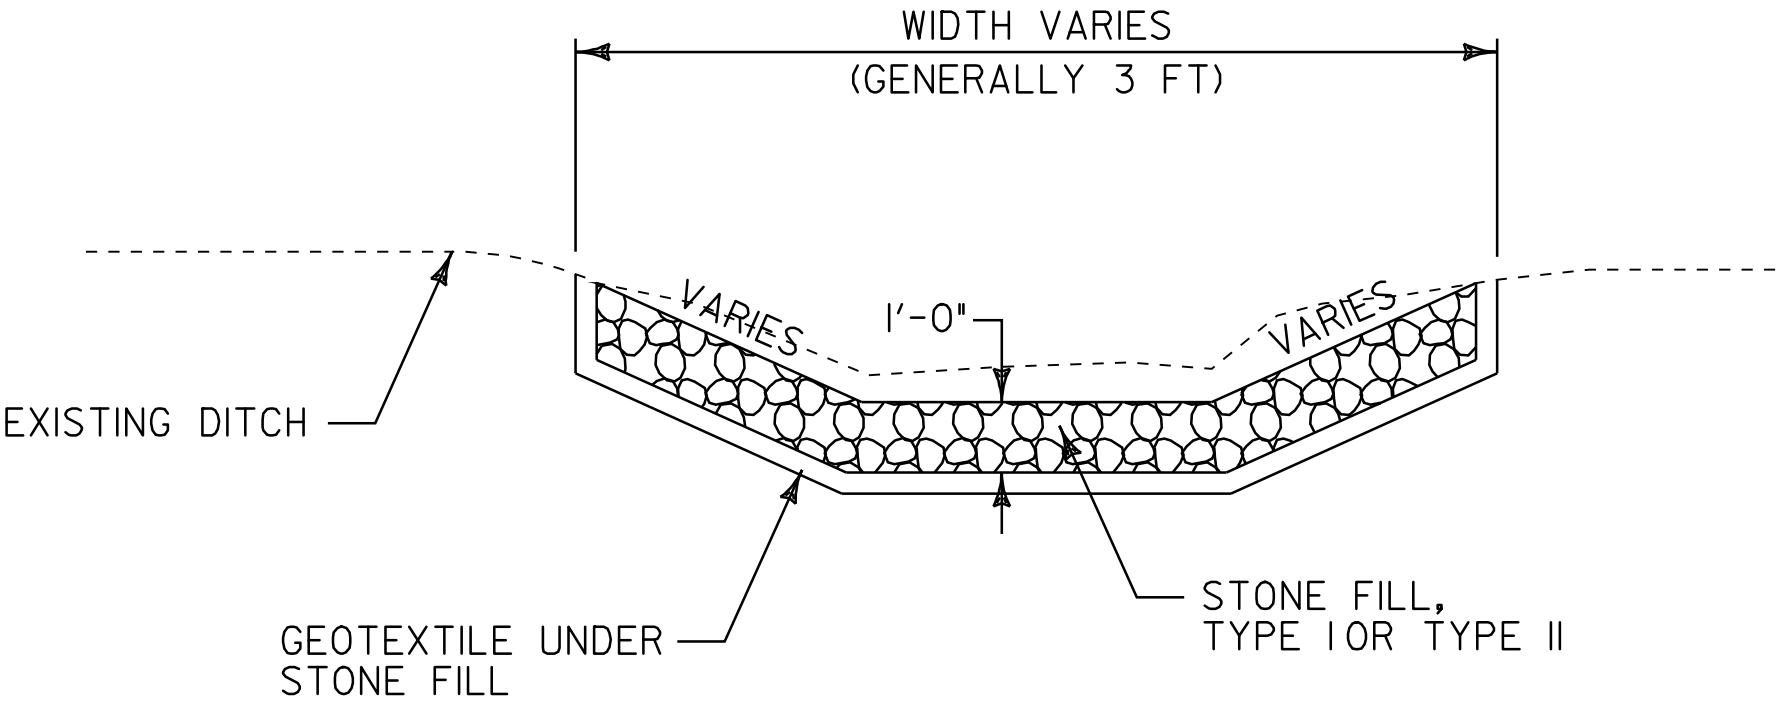




# ITEM DETAIL SUMMARY SHEET 3

| LOCATION      |             |      | GUARDRAIL                                               |                                                       |                                                |                                                    |                                             |                                            |                                                 | MISCELLANEOUS                                      |                                                    |                                           |                                                 | REMARKS                                                                                                                                                                                                                                                                           |                                                |
|---------------|-------------|------|---------------------------------------------------------|-------------------------------------------------------|------------------------------------------------|----------------------------------------------------|---------------------------------------------|--------------------------------------------|-------------------------------------------------|----------------------------------------------------|----------------------------------------------------|-------------------------------------------|-------------------------------------------------|-----------------------------------------------------------------------------------------------------------------------------------------------------------------------------------------------------------------------------------------------------------------------------------|------------------------------------------------|
| BEGIN STATION | END STATION | POS. | 621.20<br>STEEL BEAM<br>GUARDRAIL<br>(GALVANIZED)<br>LF | 621.20<br>SB GR (GALV.)<br>(MOD. W/8'<br>POSTS)<br>LF | 621.505<br>MANUF.<br>TERMINAL<br>SECTION<br>EA | 621.505<br>MANUF.<br>TERM. SECT.<br>(FLARED)<br>EA | 621.52<br>TRAILING<br>END<br>TERMINAL<br>EA | 621.60<br>ANCHOR<br>FOR<br>S.B. RAIL<br>EA | 621.74<br>ALUMINUM<br>APPROACH<br>RAILING<br>LF | 621.80<br>REMOVAL<br>& DISPOSAL<br>GUARDRAIL<br>LF | 604.412<br>REHABING<br>DI, CB, MH<br>CLASS I<br>EA | 616.35<br>TREATED<br>TIMBER<br>CURB<br>LF | 616.40<br>REMOVING &<br>RESETTING<br>CURB<br>LF |                                                                                                                                                                                                                                                                                   | 616.41<br>REMOVAL<br>OF EXISTING<br>CURB<br>LF |
| CLARENDON:    |             |      |                                                         |                                                       |                                                |                                                    |                                             |                                            |                                                 |                                                    |                                                    |                                           |                                                 |                                                                                                                                                                                                                                                                                   |                                                |
|               |             |      |                                                         |                                                       |                                                |                                                    |                                             |                                            |                                                 |                                                    |                                                    |                                           |                                                 |                                                                                                                                                                                                                                                                                   |                                                |
| 252+58.0      |             | LT   |                                                         |                                                       |                                                |                                                    |                                             |                                            |                                                 |                                                    | I                                                  |                                           |                                                 |                                                                                                                                                                                                                                                                                   |                                                |
| 255+60.0      |             | LT   |                                                         |                                                       |                                                |                                                    |                                             |                                            |                                                 |                                                    | I                                                  |                                           |                                                 |                                                                                                                                                                                                                                                                                   |                                                |
|               |             |      |                                                         |                                                       |                                                |                                                    |                                             |                                            |                                                 |                                                    |                                                    |                                           |                                                 |                                                                                                                                                                                                                                                                                   |                                                |
| 257+95.0      | 265+59.0    | LT   |                                                         | 712.5                                                 |                                                | I                                                  | I                                           |                                            |                                                 | 754                                                |                                                    |                                           |                                                 | INSTALL NEW TRAILING END TERMINAL FROM STA. 257+95.0 TO STA. 258+09.0. INSTALL NEW MANUFACTURED TERMINAL SECTION (FLARED) FROM STA. 265+21.5 TO STA. 265+59.0.                                                                                                                    |                                                |
| 279+27.0      | 282+66.0    | LT   | 287.5                                                   |                                                       |                                                | I                                                  | I                                           |                                            |                                                 | 152                                                |                                                    |                                           |                                                 | INSTALL NEW TRAILING END TERMINAL FROM STA. 279+27.0 TO STA. 279+41.0. INSTALL NEW MANUFACTURED TERMINAL SECTION (FLARED) FROM STA. 282+28.5 TO STA. 282+66.0.                                                                                                                    |                                                |
| 281+72.0      |             | LT   |                                                         |                                                       |                                                |                                                    |                                             |                                            |                                                 |                                                    | I                                                  |                                           |                                                 |                                                                                                                                                                                                                                                                                   |                                                |
| 287+33.7      | 288+00.0    | LT   | 25                                                      |                                                       |                                                |                                                    | I                                           |                                            | 27.3                                            | 64                                                 |                                                    |                                           |                                                 | INSTALL NEW TRAILING END TERMINAL FROM STA. 287+33.7 TO STA. 287+47.7. BEGIN ALUMINUM APPROACH RAILING AT STA. 287+72.7 AND CONNECT TO EXISTING BRIDGE RAILING AT STA. 288+00.0. SEE SHEETS 72 TO 74 FOR ALUMINUM APPROACH RAILING DETAILS. SEE SHEET 76 FOR BRIDGE 96-S DETAILS. |                                                |
| 289+53.0      | 293+30.0    | LT   | 350                                                     |                                                       |                                                |                                                    |                                             |                                            | 27.3                                            | 387                                                |                                                    |                                           |                                                 | CONNECT ALUMINUM APPROACH RAILING TO EXISTING BRIDGE RAILING AT STA. 289+53.0 AND END AT STA. 289+80.3. SEE SHEETS 72 TO 74 FOR ALUMINUM APPROACH RAILING DETAILS. SEE SHEET 76 FOR BRIDGE 96-S DETAILS. CONNECT TO EXISTING GUARDRAIL AT STA. 293+30.0.                          |                                                |
| 293+72.0      |             | RT   |                                                         |                                                       |                                                |                                                    |                                             |                                            |                                                 |                                                    | I                                                  |                                           |                                                 |                                                                                                                                                                                                                                                                                   |                                                |
| 294+16.0      |             | LT   |                                                         |                                                       |                                                |                                                    |                                             |                                            |                                                 |                                                    | I                                                  |                                           |                                                 |                                                                                                                                                                                                                                                                                   |                                                |
| RUTLAND TOWN: |             |      |                                                         |                                                       |                                                |                                                    |                                             |                                            |                                                 |                                                    |                                                    |                                           |                                                 |                                                                                                                                                                                                                                                                                   |                                                |
| 2+52.0        |             | LT   |                                                         |                                                       |                                                |                                                    |                                             |                                            |                                                 |                                                    | I                                                  |                                           |                                                 |                                                                                                                                                                                                                                                                                   |                                                |
| 4+54.0        |             | RT   |                                                         |                                                       |                                                |                                                    |                                             |                                            |                                                 |                                                    | I                                                  |                                           |                                                 |                                                                                                                                                                                                                                                                                   |                                                |
| 5+96.0        | 16+60.0     | LT   | 1012.5                                                  |                                                       |                                                | I                                                  | I                                           |                                            |                                                 | 1055                                               |                                                    | 816                                       |                                                 | INSTALL NEW TRAILING END TERMINAL FROM STA. 5+96.0 TO STA. 6+10.0. INSTALL TREATED TIMBER CURB FROM STA. 8+20.0 TO STA. 16+36.0.<br>INSTALL NEW MANUFACTURED TERMINAL SECTION (FLARED) FROM STA. 16+22.5 TO STA. 16+60.0.                                                         |                                                |
| 6+32.0        |             | LT   |                                                         |                                                       |                                                |                                                    |                                             |                                            |                                                 |                                                    | I                                                  |                                           |                                                 |                                                                                                                                                                                                                                                                                   |                                                |
| 9+67.0        |             | RT   |                                                         |                                                       |                                                |                                                    |                                             |                                            |                                                 |                                                    | I                                                  |                                           |                                                 |                                                                                                                                                                                                                                                                                   |                                                |
| 12+88.0       |             | LT   |                                                         |                                                       |                                                |                                                    |                                             |                                            |                                                 |                                                    | I                                                  |                                           |                                                 |                                                                                                                                                                                                                                                                                   |                                                |
| 16+18.0       |             | LT   |                                                         |                                                       |                                                |                                                    |                                             |                                            |                                                 |                                                    | I                                                  |                                           |                                                 |                                                                                                                                                                                                                                                                                   |                                                |
| 18+63.0       |             | LT   |                                                         |                                                       |                                                |                                                    |                                             |                                            |                                                 |                                                    | I                                                  |                                           |                                                 |                                                                                                                                                                                                                                                                                   |                                                |
| 20+71.0       |             | RT   |                                                         |                                                       |                                                |                                                    |                                             |                                            |                                                 |                                                    | I                                                  |                                           |                                                 |                                                                                                                                                                                                                                                                                   |                                                |
| 21+69.0       |             | LT   |                                                         |                                                       |                                                |                                                    |                                             |                                            |                                                 |                                                    | I                                                  |                                           |                                                 |                                                                                                                                                                                                                                                                                   |                                                |
| 23+00.0       |             | LT   |                                                         |                                                       |                                                |                                                    |                                             |                                            |                                                 |                                                    | I                                                  |                                           |                                                 |                                                                                                                                                                                                                                                                                   |                                                |
| 23+90.0       |             | LT   |                                                         |                                                       |                                                |                                                    |                                             |                                            |                                                 |                                                    | I                                                  |                                           |                                                 |                                                                                                                                                                                                                                                                                   |                                                |
| 30+06.0       | 34+95.0     | LT   | 437.5                                                   |                                                       |                                                | I                                                  | I                                           |                                            |                                                 | 478                                                |                                                    |                                           |                                                 | INSTALL NEW TRAILING END TERMINAL FROM STA. 30+06.0 TO STA. 30+20.0. INSTALL NEW MANUFACTURED TERMINAL SECTION (FLARED) FROM STA. 34+57.5 TO STA. 34+95.0.                                                                                                                        |                                                |
|               |             |      |                                                         |                                                       |                                                |                                                    |                                             |                                            |                                                 |                                                    |                                                    |                                           |                                                 |                                                                                                                                                                                                                                                                                   |                                                |
|               |             |      |                                                         |                                                       |                                                |                                                    |                                             |                                            |                                                 |                                                    |                                                    |                                           |                                                 |                                                                                                                                                                                                                                                                                   |                                                |
[illegible]

# DITCH DETAIL

---

N.T.S.

NOTES:

1. PIPE INLET AND OUTLET AREAS AND DITCH CLEANING THROUGHOUT THE PROJECT SHALL BE PERFORMED AT LOCATIONS AND AS DIRECTED BY THE RESIDENT ENGINEER. PAYMENT WILL BE UNDER THE APPLICABLE EQUIPMENT RENTAL ITEM(S).
2. ESTIMATED QUANTITIES OF EROSION MATTING, SEED, STONE FILL TYPE I AND STONE FILL TYPE II HAVE BEEN INCLUDED AS REQUIRED. DITCHES WITH GRADES LESS THAN 1 PERCENT SHALL BE SEED. EROSION MATTING SHALL BE USED IN ALL DITCHES WITH GRADES BETWEEN 1 AND 2.5 PERCENT. STONE FILL TYPE I SHALL BE USED IN ALL DITCHES WITH GRADES BETWEEN 2.5 AND 10 PERCENT. STONE FILL TYPE II SHALL BE USED IN ALL DITCHES WITH GRADES GREATER THAN 10 PERCENT OR AS DIRECTED BY THE RESIDENT ENGINEER.

# DITCH CLEANING DETAIL SHEET

PROJECT NAME: WALLINGFORD - RUTLAND TOWN  
PROJECT NUMBER: NH 2408(I)S

FILE NAME: p04b050.dgn PLOT DATE: \$DATE\$  
PROJECT LEADER: D.E.G. DRAWN BY: C.A.K.  
DESIGNED BY: J.S.P. CHECKED BY: D.E.G.  
IPARM FILE: p04b050dc.I SHEET 12 OF 80



646.414 DURABLE 6" WHITE LINE (MOD.) (RETROREFLECTIVITY/INLAID)  
(ALL LINES WILL INCLUDE EDGE LINE BREAKS AND  
RADIUS FOR TOWN HIGHWAYS)

WALLINGFORD:  
STA. 344+88.96 - STA. 360+00.00 EDGE LINE LT  
STA. 358+15.00 - STA. 360+00.00 DASHED LINE C/L

646.415 DURABLE 6" YELLOW LINE (MOD.) (RETROREFLECTIVITY/INLAID)  
(ALL LINES WILL INCLUDE EDGE LINE BREAKS AND  
RADIUS FOR TOWN HIGHWAYS)

WALLINGFORD:  
STA. 344+88.96 - STA. 360+00.00 EDGE LINE RT

646.614 TEMPORARY 6" WHITE LINE (PAINT)  
(ALL LINES WILL INCLUDE EDGE LINE BREAKS AND  
RADIUS FOR TOWN HIGHWAYS)

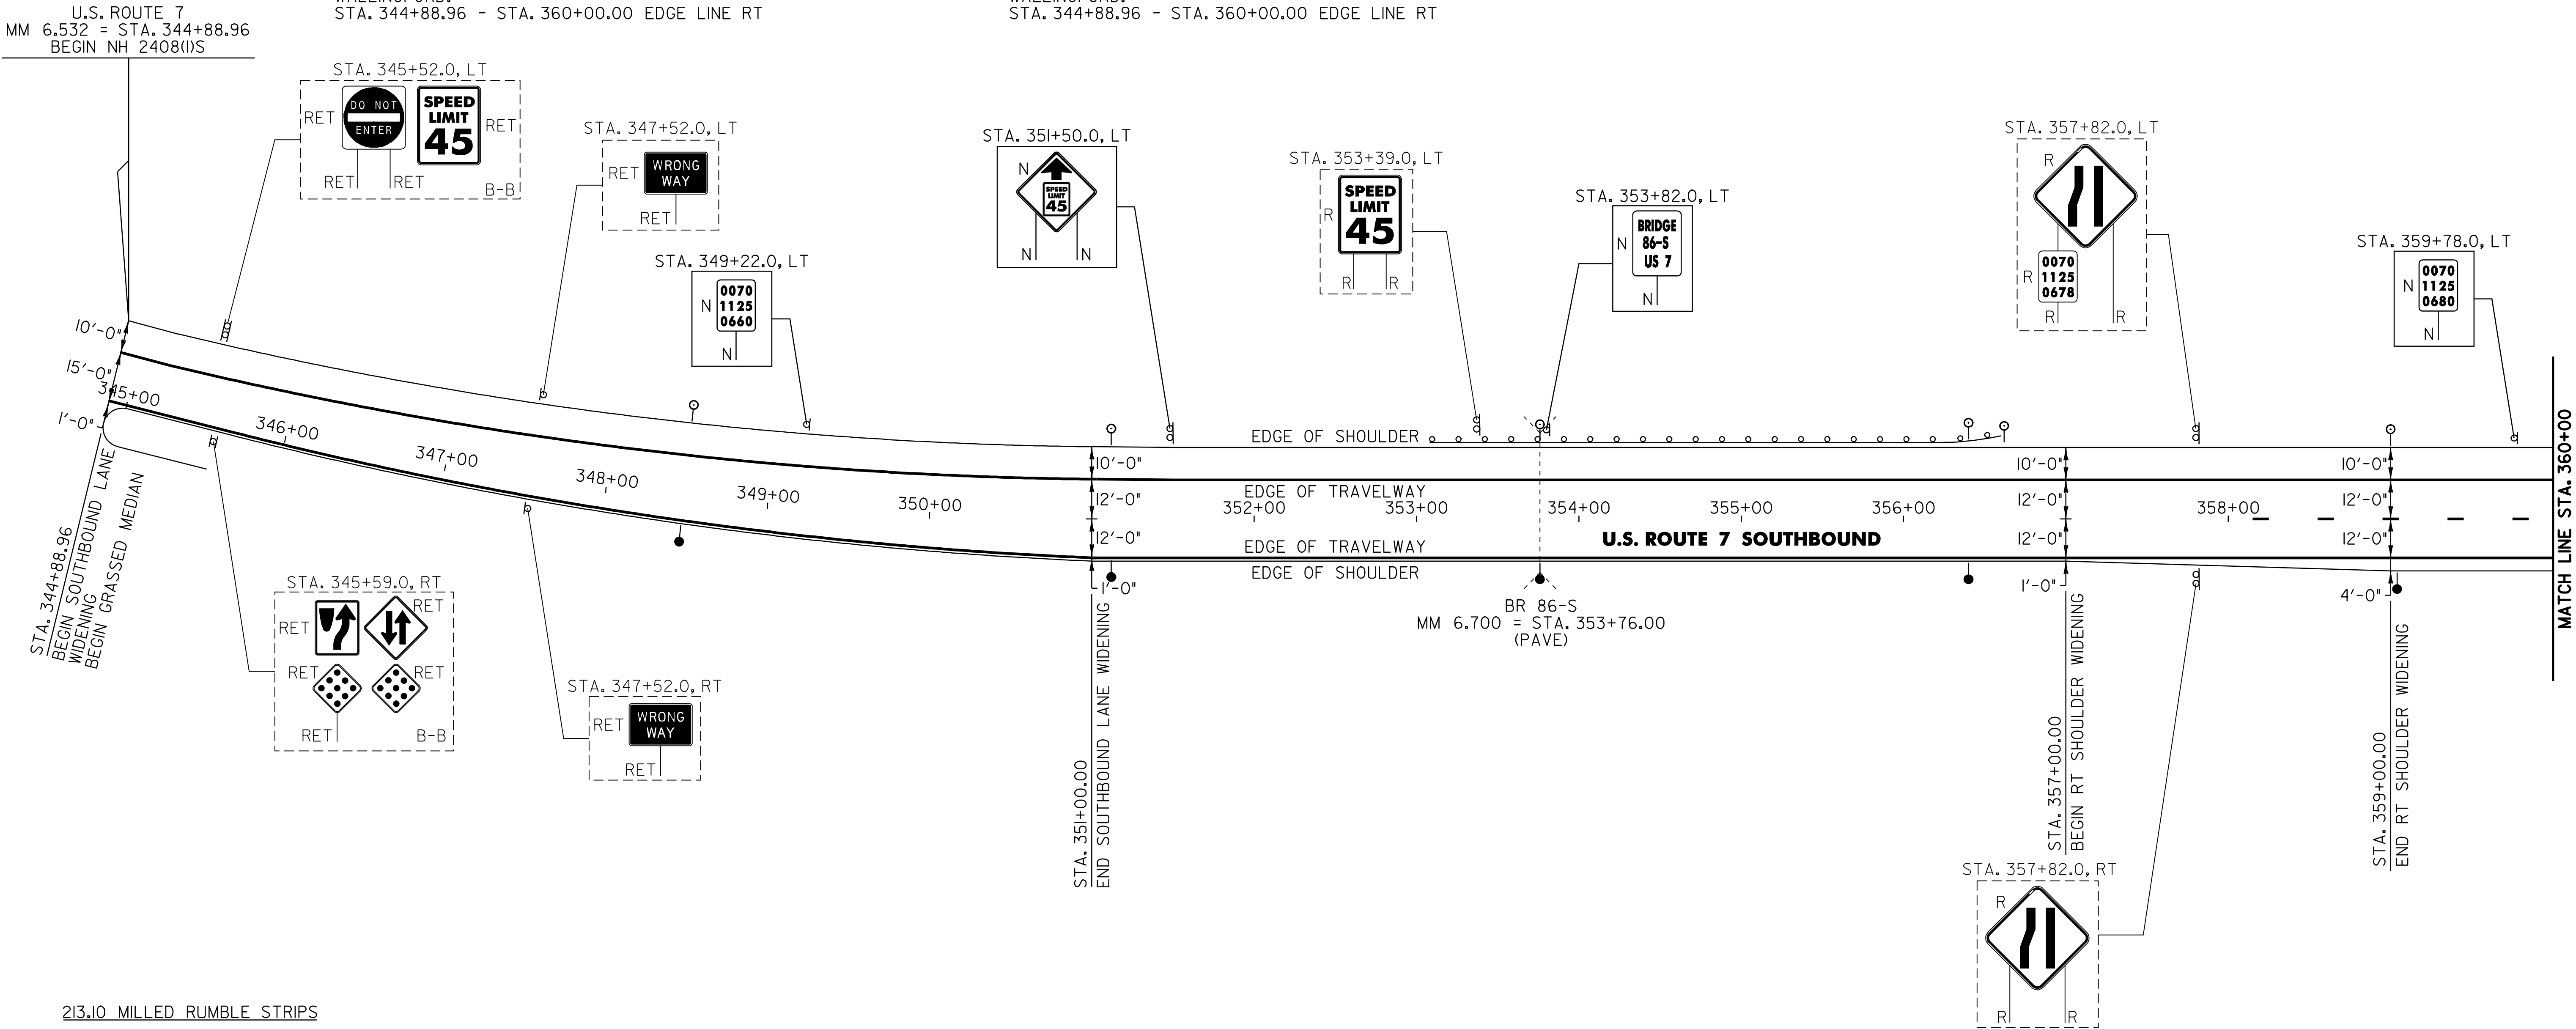
WALLINGFORD:  
STA. 344+88.96 - STA. 360+00.00 EDGE LINE LT  
STA. 358+15.00 - STA. 360+00.00 DASHED LINE C/L

646.615 TEMPORARY 6" YELLOW LINE (PAINT)  
(ALL LINES WILL INCLUDE EDGE LINE BREAKS AND  
RADIUS FOR TOWN HIGHWAYS)

WALLINGFORD:  
STA. 344+88.96 - STA. 360+00.00 EDGE LINE RT

675.50 REMOVING SIGNS

AS SHOWN - 4



213.10 MILLED RUMBLE STRIPS

WALLINGFORD:  
STA. 344+89.0 - STA. 360+00.0 LT (1511 LF)  
STA. 359+00.0 - STA. 360+00.0 RT (100 LF)

621.20 STEEL BEAM GUARDRAIL (GALVANIZED)

WALLINGFORD:  
STA. 353+22.0 - STA. 356+22.0 LT (300 LF)

621.505 MANUFACTURED TERMINAL SECTION (FLARED)

WALLINGFORD:  
STA. 356+22.0 - STA. 356+59.5 LT

621.52 TRAILING END TERMINAL

WALLINGFORD:  
STA. 353+08.0 - STA. 353+22.0 LT

621.80 REMOVAL AND DISPOSAL OF GUARDRAIL

WALLINGFORD:  
STA. 353+10.0 - STA. 355+12.0 LT (202 LF)

676.10 DELINEATORS WITH STEEL POSTS

○ TYPE I WHITE      ● TYPE I AMBER

WALLINGFORD:  
STA. 348+48.0 LT      STA. 348+48.0 RT  
STA. 351+12.0 LT      STA. 351+12.0 RT  
STA. 353+76.0 LT      STA. 353+76.0 RT  
STA. 356+40.0 LT      STA. 356+40.0 RT  
STA. 356+59.5 LT      STA. 359+04.0 RT  
STA. 359+04.0 LT

SIGN LEGEND  
R = REMOVE  
S = SALVAGE  
N = NEW  
RET = RETAIN  
B-B = BACK TO BACK  
EXISTING = -----  
NEW = -----

PROJECT  
LAYOUT  
SHEET #1

PROJECT NAME: WALLINGFORD - RUTLAND TOWN  
PROJECT NUMBER: NH 2408(1)S  
FILE NAME: p04b050.dgn  
PROJECT LEADER: D.E.G.  
DESIGNED BY: J.S.P.  
IPARM FILE: p04b050LO1.i  
PLOT DATE: \$DATE\$  
DRAWN BY: C.A.K.  
CHECKED BY: D.E.G.  
SHEET 13 OF 80



646.414 DURABLE 6" WHITE LINE (MOD.) (RETROREFLECTIVITY/INLAID)  
(ALL LINES WILL INCLUDE EDGE LINE BREAKS AND  
RADIUS FOR TOWN HIGHWAYS)

WALLINGFORD:  
STA. 360+00.00 - STA. 374+66.88 DASHED LINE C/L  
STA. 360+00.00 - STA. 374+66.88 EDGE LINE LT

CLARENDON:  
STA. 0+00.00 - STA. 1+00.00 DASHED LINE C/L  
STA. 0+00.00 - STA. 1+00.00 EDGE LINE LT

646.415 DURABLE 6" YELLOW LINE (MOD.) (RETROREFLECTIVITY/INLAID)  
(ALL LINES WILL INCLUDE EDGE LINE BREAKS AND  
RADIUS FOR TOWN HIGHWAYS)

WALLINGFORD:  
STA. 360+00.00 - STA. 374+66.88 EDGE LINE RT

CLARENDON:  
STA. 0+00.00 - STA. 1+00.00 EDGE LINE RT

646.614 TEMPORARY 6" WHITE LINE (PAINT)  
(ALL LINES WILL INCLUDE EDGE LINE BREAKS AND  
RADIUS FOR TOWN HIGHWAYS)

WALLINGFORD:  
STA. 360+00.00 - STA. 374+66.88 DASHED LINE C/L  
STA. 360+00.00 - STA. 374+66.88 EDGE LINE LT

CLARENDON:  
STA. 0+00.00 - STA. 1+00.00 DASHED LINE C/L  
STA. 0+00.00 - STA. 1+00.00 EDGE LINE LT

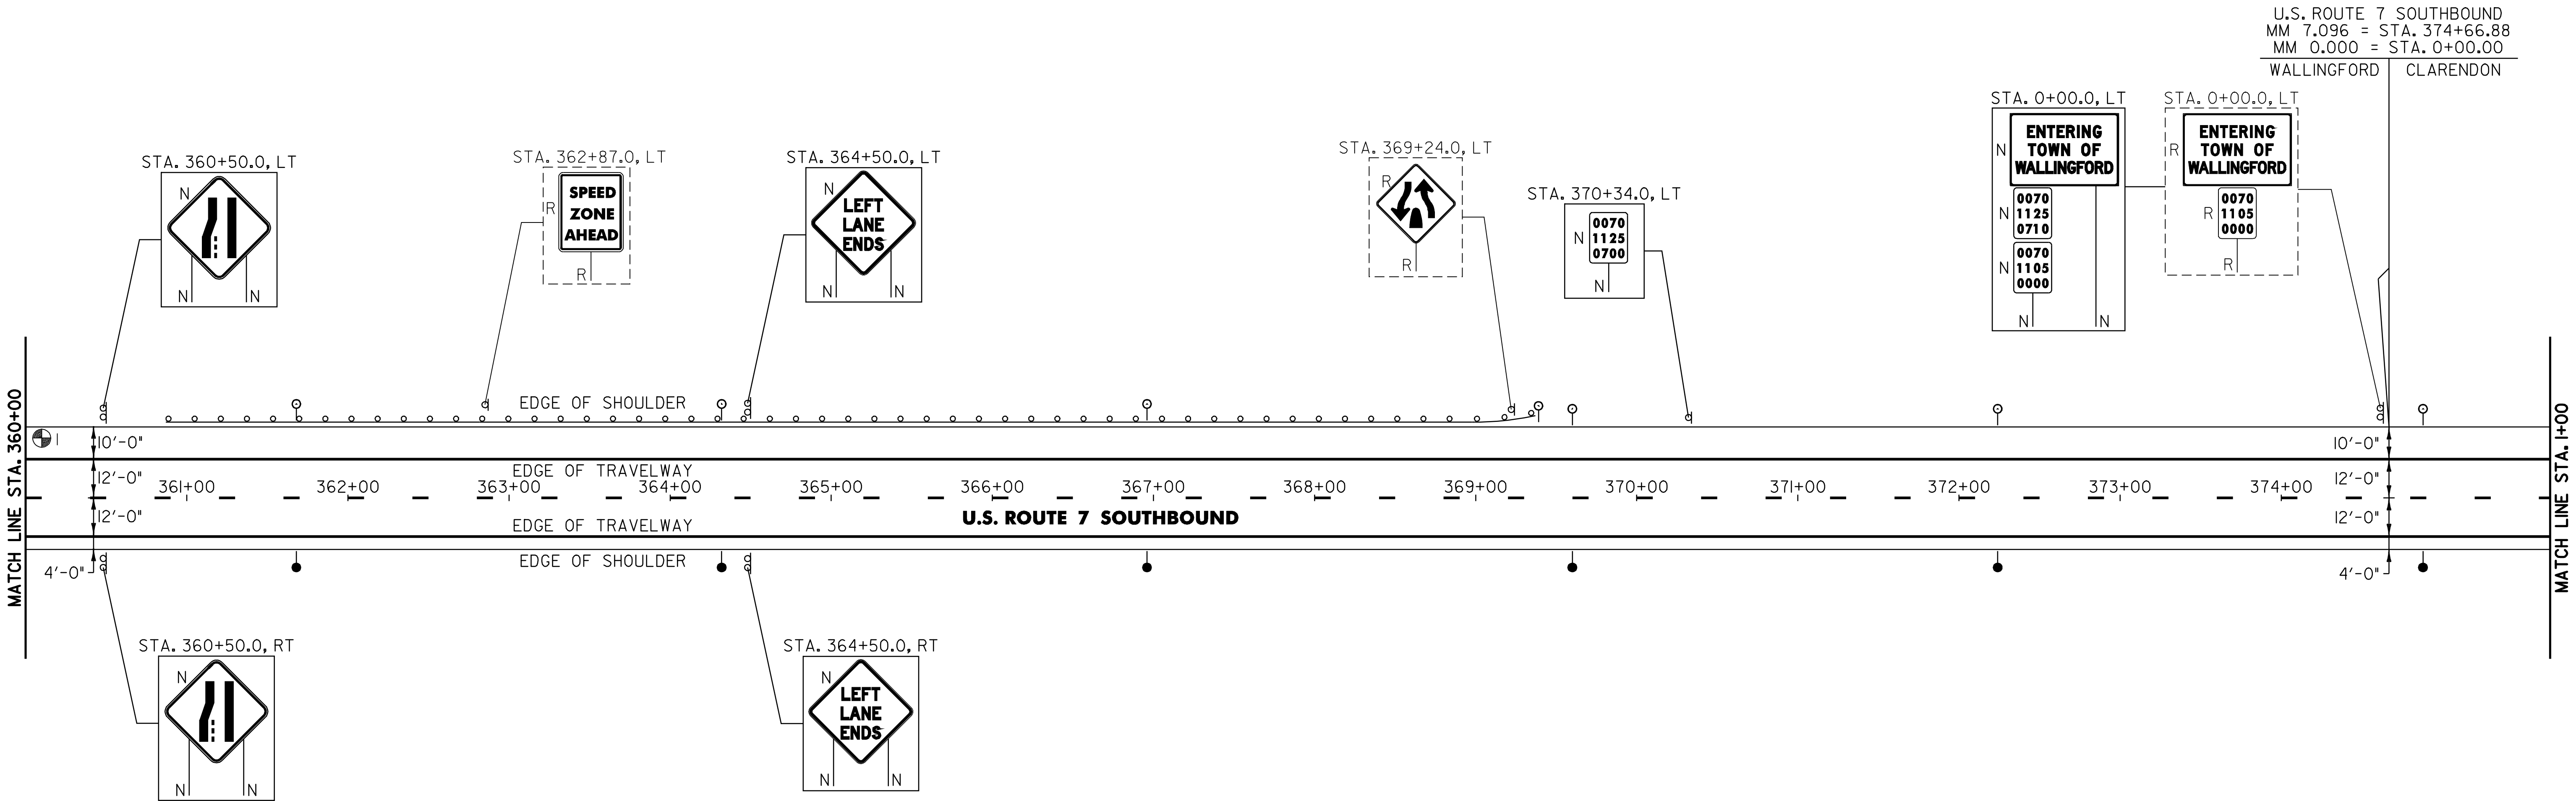
646.615 TEMPORARY 6" YELLOW LINE (PAINT)  
(ALL LINES WILL INCLUDE EDGE LINE BREAKS AND  
RADIUS FOR TOWN HIGHWAYS)

WALLINGFORD:  
STA. 360+00.00 - STA. 374+66.88 EDGE LINE RT

CLARENDON:  
STA. 0+00.00 - STA. 1+00.00 EDGE LINE RT

675.50 REMOVING SIGNS

AS SHOWN - 4



213.10 MILLED RUMBLE STRIPS

WALLINGFORD:  
STA. 360+00.0 - STA. 374+66.88 LT (1466.9 LF)  
STA. 360+00.0 - STA. 374+66.88 RT (1466.9 LF)

CLARENDON:  
STA. 0+00.0 - STA. 1+00.0 LT (100 LF)  
STA. 0+00.0 - STA. 1+00.0 RT (100 LF)

621.20 STEEL BEAM GUARDRAIL WITH 8' POSTS (MOD.) (GALVANIZED)

WALLINGFORD:  
STA. 361+01.0 - STA. 369+01.0 LT (800 LF) 787.5  
14

621.505 MANUFACTURED TERMINAL SECTION (FLARED)

WALLINGFORD:  
STA. 369+01.0 - STA. 369+38.5 LT

621.52 TRAILING END TERMINAL

WALLINGFORD:  
STA. 360+87.0 - STA. 361+01.0 LT

621.80 REMOVAL AND DISPOSAL OF GUARDRAIL

WALLINGFORD:  
STA. 360+89.0 - STA. 369+15.0 LT (826 LF)

676.10 DELINEATORS WITH STEEL POSTS

♀ TYPE 1 WHITE      ♂ TYPE 1 AMBER

WALLINGFORD:  
STA. 361+68.0 LT      STA. 361+68.0 RT  
STA. 364+32.0 LT      STA. 364+32.0 RT  
STA. 366+96.0 LT      STA. 366+96.0 RT  
STA. 369+38.5 LT      STA. 369+60.0 RT  
STA. 369+60.0 LT      STA. 372+24.0 RT  
STA. 372+24.0 LT

CLARENDON:  
STA. 0+10.0 LT      STA. 0+10.0 RT

SIGN LEGEND  
R = REMOVE  
S = SALVAGE  
N = NEW  
RET = RETAIN  
B-B = BACK TO BACK  
EXISTING = -----  
NEW = -----

PAVEMENT CORES = ☉

| No. | TOTAL<br>DEPTH<br>(Inches) | PCC | COMMENTS |
|-----|----------------------------|-----|----------|
| 1   | 1.00                       | N0  | -        |

PROJECT  
LAYOUT  
SHEET #2

PROJECT NAME: WALLINGFORD - RUTLAND TOWN  
PROJECT NUMBER: NH 2408(1)S

FILE NAME: p04b050.dgn  
PROJECT LEADER: D.E.G.  
DESIGNED BY: J.S.P.  
IPARM FILE: p04b050L02.1  
PLOT DATE: \$DATE\$  
DRAWN BY: C.A.K.  
CHECKED BY: D.E.G.  
SHEET 14 OF 80



646.414 DURABLE 6" WHITE LINE (MOD.) (RETROREFLECTIVITY/INLAID)  
(ALL LINES WILL INCLUDE EDGE LINE BREAKS AND  
RADIUS FOR TOWN HIGHWAYS)

CLARENDON:  
STA. 1+00.00 - STA. 16+00.00 DASHED LINE C/L  
STA. 1+00.00 - STA. 16+00.00 EDGE LINE LT

646.415 DURABLE 6" YELLOW LINE (MOD.) (RETROREFLECTIVITY/INLAID)  
(ALL LINES WILL INCLUDE EDGE LINE BREAKS AND  
RADIUS FOR TOWN HIGHWAYS)

CLARENDON:  
STA. 1+00.00 - STA. 16+00.00 EDGE LINE RT

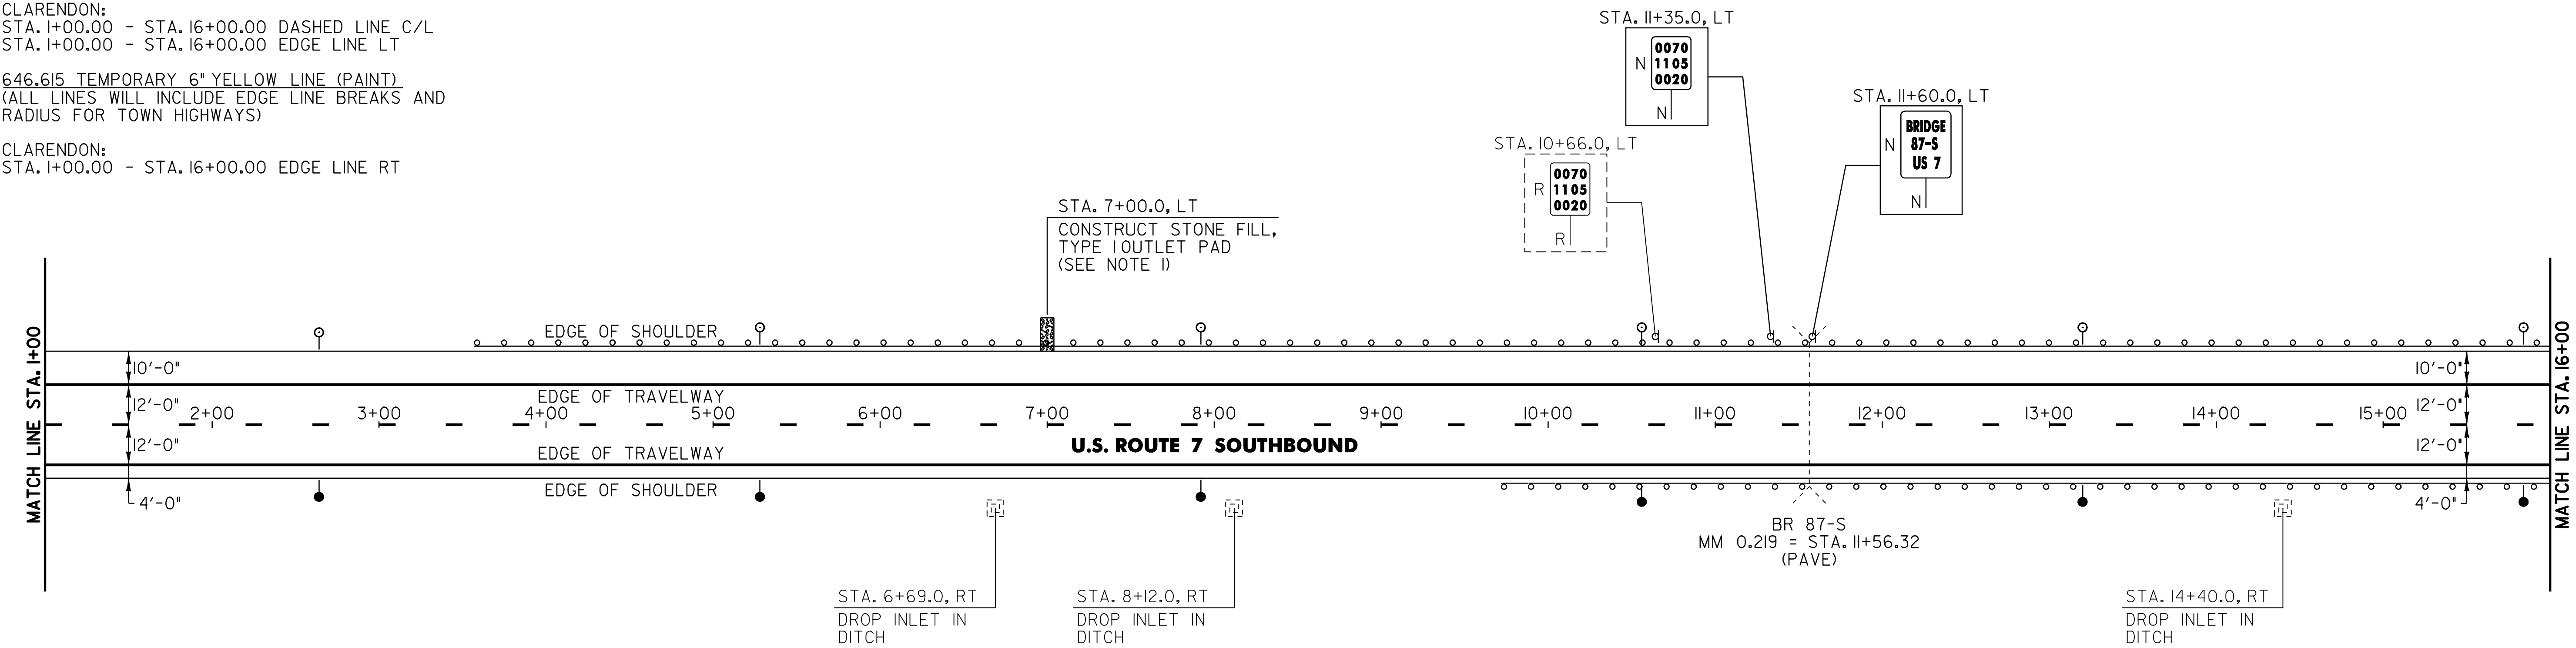
646.614 TEMPORARY 6" WHITE LINE (PAINT)  
(ALL LINES WILL INCLUDE EDGE LINE BREAKS AND  
RADIUS FOR TOWN HIGHWAYS)

CLARENDON:  
STA. 1+00.00 - STA. 16+00.00 DASHED LINE C/L  
STA. 1+00.00 - STA. 16+00.00 EDGE LINE LT

646.615 TEMPORARY 6" YELLOW LINE (PAINT)  
(ALL LINES WILL INCLUDE EDGE LINE BREAKS AND  
RADIUS FOR TOWN HIGHWAYS)

CLARENDON:  
STA. 1+00.00 - STA. 16+00.00 EDGE LINE RT

675.50 REMOVING SIGNS  
AS SHOWN - I



213.10 MILLED RUMBLE STRIPS

CLARENDON:  
STA. 1+00.0 - STA. 16+00.0 LT (1500 LF)  
STA. 1+00.0 - STA. 9+72.0 RT (872 LF)

604.412 REHABING DI, CB OR MH, CLASS I

CLARENDON:  
STA. 6+69.0 RT  
STA. 8+12.0 RT  
STA. 14+40.0 RT

621.20 STEEL BEAM GUARDRAIL (GALVANIZED)

CLARENDON: 3+58.5 1216.5  
STA. 3+71.0 - STA. 16+00.0 LT (1229 LF)  
STA. 9+86.0 - STA. 16+00.0 RT (614 LF)

621.52 TRAILING END TERMINAL

CLARENDON:  
STA. 3+57.0 - STA. 3+71.0 LT  
STA. 9+72.0 - STA. 9+86.0 RT

621.80 REMOVAL AND DISPOSAL OF GUARDRAIL

CLARENDON:  
STA. 3+59.0 - STA. 16+00.0 LT (1241 LF)  
STA. 9+74.0 - STA. 16+00.0 RT (626 LF)

676.10 DELINEATORS WITH STEEL POSTS

♀ TYPE I WHITE      ♂ TYPE I AMBER

CLARENDON:  
STA. 2+64.0 LT      STA. 2+64.0 RT  
STA. 5+28.0 LT      STA. 5+28.0 RT  
STA. 7+92.0 LT      STA. 7+92.0 RT  
STA. 10+56.0 LT      STA. 10+56.0 RT  
STA. 13+20.0 LT      STA. 13+20.0 RT  
STA. 15+84.0 LT      STA. 15+84.0 RT

SIGN LEGEND  
R = REMOVE  
S = SALVAGE  
N = NEW  
RET = RETAIN  
B-B = BACK TO BACK  
EXISTING = -----  
NEW = -----

NOTE:  
I. CONSTRUCT A 10' x 4' x 1' (L x W x D) STONE FILL, TYPE I OUTLET PAD ADJACENT TO THE SHOULDER AT STA. 7+00, OR AS DIRECTED BY THE RESIDENT ENGINEER. ALL REQUIRED EXCAVATION SHALL BE PAID FOR UNDER ITEM 608.25 ALL PURPOSE EXCAVATOR RENTAL, TYPE I.

PROJECT  
LAYOUT  
SHEET #3

PROJECT NAME: WALLINGFORD - RUTLAND TOWN  
PROJECT NUMBER: NH 2408(1)S

FILE NAME: p04b050.dgn      PLOT DATE: \$DATE\$  
PROJECT LEADER: D.E.G.      DRAWN BY: C.A.K.  
DESIGNED BY: J.S.P.      CHECKED BY: D.E.G.  
IPARM FILE: p04b050L03.1      SHEET 15 OF 80



646.414 DURABLE 6" WHITE LINE (MOD.) (RETROREFLECTIVITY/INLAID)  
(ALL LINES WILL INCLUDE EDGE LINE BREAKS AND  
RADIUS FOR TOWN HIGHWAYS)

CLARENDON:  
STA. 16+00.00 - STA. 32+00.00 DASHED LINE C/L  
STA. 16+00.00 - STA. 32+00.00 EDGE LINE LT

646.415 DURABLE 6" YELLOW LINE (MOD.) (RETROREFLECTIVITY/INLAID)  
(ALL LINES WILL INCLUDE EDGE LINE BREAKS AND  
RADIUS FOR TOWN HIGHWAYS)

CLARENDON:  
STA. 16+00.00 - STA. 32+00.00 EDGE LINE RT

646.614 TEMPORARY 6" WHITE LINE (PAINT)  
(ALL LINES WILL INCLUDE EDGE LINE BREAKS AND  
RADIUS FOR TOWN HIGHWAYS)

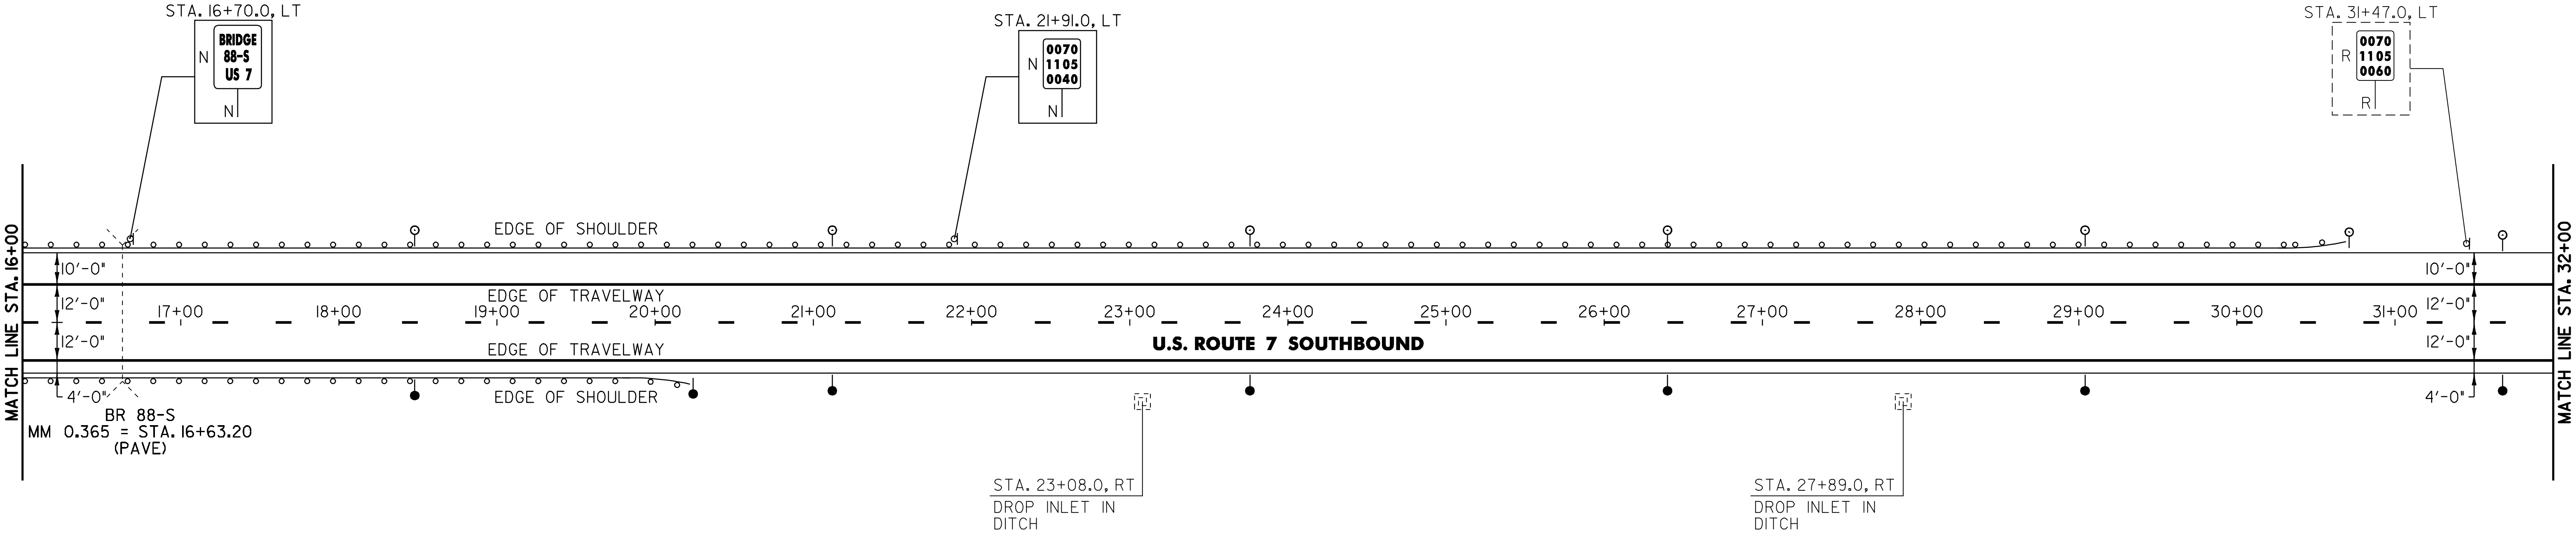
CLARENDON:  
STA. 16+00.00 - STA. 32+00.00 DASHED LINE C/L  
STA. 16+00.00 - STA. 32+00.00 EDGE LINE LT

646.615 TEMPORARY 6" YELLOW LINE (PAINT)  
(ALL LINES WILL INCLUDE EDGE LINE BREAKS AND  
RADIUS FOR TOWN HIGHWAYS)

CLARENDON:  
STA. 16+00.00 - STA. 32+00.00 EDGE LINE RT

675.50 REMOVING SIGNS

AS SHOWN - I



213.10 MILLED RUMBLE STRIPS

CLARENDON:  
STA. 16+00.0 - STA. 32+00.0 LT (1600 LF)  
STA. 20+24.0 - STA. 32+00.0 RT (1176 LF)

604.412 REHABING DI, CB OR MH, CLASS I

CLARENDON:  
STA. 23+08.0 RT  
STA. 27+89.0 RT

621.20 STEEL BEAM GUARDRAIL (GALVANIZED)

CLARENDON:  
STA. 16+00.0 - STA. 30+33.5 LT (1433.5 LF)  
STA. 16+00.0 - STA. 19+86.0 RT (386 LF)

621.505 MANUFACTURED TERMINAL SECTION (FLARED)

CLARENDON:  
STA. 19+86.0 - STA. 20+23.5 RT  
STA. 30+33.5 - STA. 30+71.0 LT

621.80 REMOVAL AND DISPOSAL OF GUARDRAIL

CLARENDON:  
STA. 16+00.0 - STA. 30+55.0 LT (1455 LF)  
STA. 16+00.0 - STA. 19+00.0 RT (300 LF)

676.10 DELINEATORS WITH STEEL POSTS

⌘ TYPE I WHITE      ● TYPE I AMBER

CLARENDON:  
STA. 18+48.0 LT      STA. 18+48.0 RT  
STA. 21+12.0 LT      STA. 20+23.5 RT  
STA. 23+76.0 LT      STA. 21+12.0 RT  
STA. 26+40.0 LT      STA. 23+76.0 RT  
STA. 29+04.0 LT      STA. 26+40.0 RT  
STA. 30+71.0 LT      STA. 29+04.0 RT  
STA. 31+68.0 LT      STA. 31+68.0 RT

SIGN LEGEND  
R = REMOVE  
S = SALVAGE  
N = NEW  
RET = RETAIN  
B-B = BACK TO BACK  
EXISTING = -----  
NEW = -----

PROJECT  
LAYOUT  
SHEET #4

PROJECT NAME: WALLINGFORD - RUTLAND TOWN  
PROJECT NUMBER: NH 2408(1)S

FILE NAME: p04b050.dgn  
PROJECT LEADER: D.E.G.  
DESIGNED BY: J.S.P.  
IPARM FILE: p04b050L04.1  
PLOT DATE: \$DATE\$  
DRAWN BY: C.A.K.  
CHECKED BY: D.E.G.  
SHEET 16 OF 80



646.414 DURABLE 6" WHITE LINE (MOD.) (RETROREFLECTIVITY/INLAID)  
(ALL LINES WILL INCLUDE EDGE LINE BREAKS AND RADIUS FOR TOWN HIGHWAYS)

CLARENDON:  
STA. 32+00.00 - STA. 48+00.00 DASHED LINE C/L  
STA. 32+00.00 - STA. 48+00.00 EDGE LINE LT  
STA. 40+00.00 - STA. 42+40.00 SOLID LANE LINE LT  
STA. 42+40.00 - STA. 45+00.00 DOTTED LANE LINE LT

646.415 DURABLE 6" YELLOW LINE (MOD.) (RETROREFLECTIVITY/INLAID)  
(ALL LINES WILL INCLUDE EDGE LINE BREAKS AND RADIUS FOR TOWN HIGHWAYS)

CLARENDON:  
STA. 32+00.00 - STA. 48+00.00 EDGE LINE RT

646.40 DURABLE 4" WHITE LINE (MOD.) (RETROREFLECTIVITY/INLAID)

CLARENDON:  
STA. 39+70.56 EDGE LINE LT, VT. ROUTE 7B

646.41DURABLE 4" YELLOW LINE (MOD.) (RETROREFLECTIVITY/INLAID)

CLARENDON:  
STA. 39+70.56 DOUBLE SOLID LT, VT. ROUTE 7B

646.614 TEMPORARY 6" WHITE LINE (PAINT)  
(ALL LINES WILL INCLUDE EDGE LINE BREAKS AND RADIUS FOR TOWN HIGHWAYS)

CLARENDON:  
STA. 32+00.00 - STA. 48+00.00 DASHED LINE C/L  
STA. 32+00.00 - STA. 48+00.00 EDGE LINE LT  
STA. 40+00.00 - STA. 42+40.00 SOLID LANE LINE LT  
STA. 42+40.00 - STA. 45+00.00 DOTTED LANE LINE LT

646.615 TEMPORARY 6" YELLOW LINE (PAINT)  
(ALL LINES WILL INCLUDE EDGE LINE BREAKS AND RADIUS FOR TOWN HIGHWAYS)

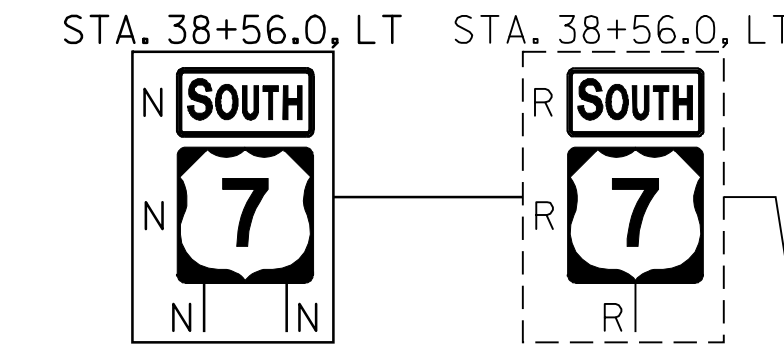
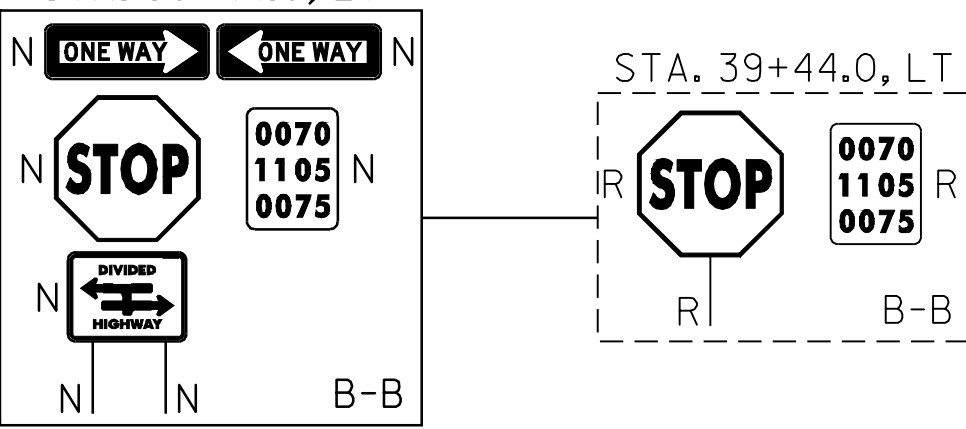
CLARENDON:  
STA. 32+00.00 - STA. 48+00.00 EDGE LINE RT

646.60 TEMPORARY 4" WHITE LINE (PAINT)

CLARENDON:  
STA. 39+70.56 EDGE LINE LT, VT. ROUTE 7B

646.61 TEMPORARY 4" YELLOW LINE (PAINT)

CLARENDON:  
STA. 39+70.56 DOUBLE SOLID LT, VT. ROUTE 7B  
STA. 39+44.0, LT



646.46 DURABLE 24" STOP BAR (THERMOPLASTIC)

CLARENDON:  
STA. 39+70.56 LT, VT. ROUTE 7B

646.66 TEMPORARY 24" STOP BAR (PAINT)

CLARENDON:  
STA. 39+70.56 LT, VT. ROUTE 7B

646.50 DURABLE LETTER OR SYMBOL (THERMOPLASTIC)

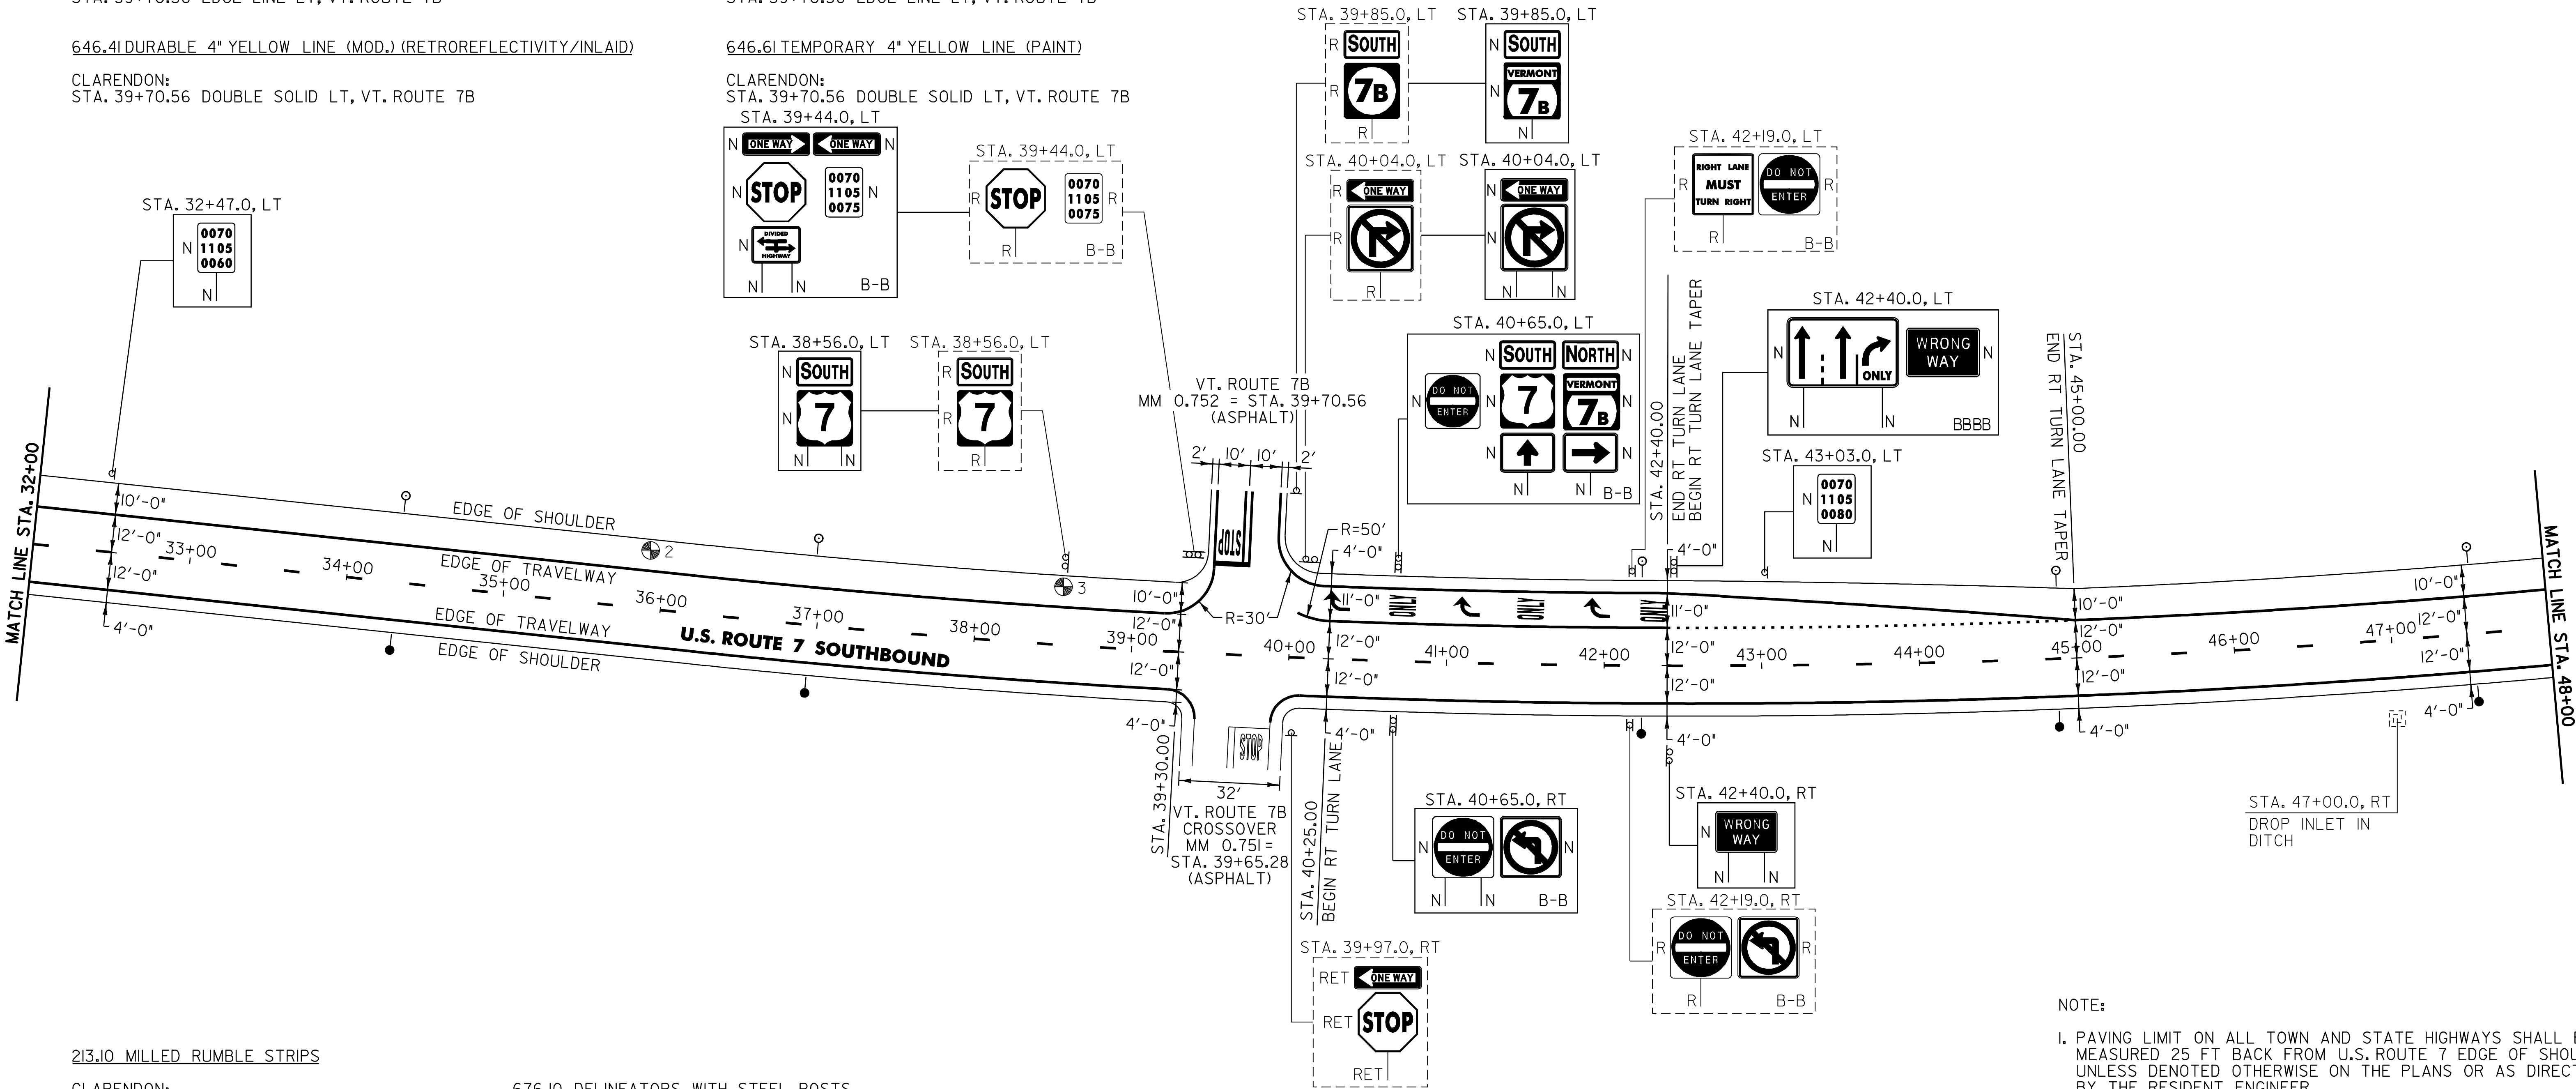
CLARENDON:  
STA. 39+70.56 LT, VT. ROUTE 7B, "S,T,O,P" (4 EA)  
STA. 40+29.3 LT, ARROW (1EA)  
STA. 40+70.6 LT, "O,N,L,Y" (4 EA) 40+98 LT  
STA. 41+11.9 LT, ARROW (1EA) 41+25 LT  
STA. 41+53.2 LT, "O,N,L,Y" (4 EA)  
STA. 41+94.5 LT, ARROW (1EA)  
STA. 42+35.8 LT, "O,N,L,Y" (4 EA) 42+48 LT

646.70 TEMPORARY LETTER OR SYMBOL (PAINT)

CLARENDON:  
STA. 39+70.56 LT, VT. ROUTE 7B, "S,T,O,P" (8 EA)  
STA. 40+29.3 LT, ARROW (2 EA)  
STA. 41+94.5 LT, ARROW (2 EA)

675.50 REMOVING SIGNS

AS SHOWN - 12



213.10 MILLED RUMBLE STRIPS

CLARENDON:  
STA. 32+00.0 - STA. 38+98.0 LT (698 LF)  
STA. 32+00.0 - STA. 38+89.0 RT (689 LF)  
STA. 40+41.0 - STA. 48+00.0 RT (759 LF)  
STA. 45+00.0 - STA. 48+00.0 LT (300 LF)

604.412 REHABING DI, CB OR MH, CLASS 1

CLARENDON:  
STA. 47+00.0 RT

676.10 DELINEATORS WITH STEEL POSTS

♀ TYPE I WHITE      ♂ TYPE I AMBER

CLARENDON:  
STA. 34+32.0 LT      STA. 34+32.0 RT  
STA. 36+96.0 LT      STA. 36+96.0 RT  
STA. 42+24.0 LT      STA. 42+24.0 RT  
STA. 44+88.0 LT      STA. 44+88.0 RT  
STA. 47+52.0 LT      STA. 47+52.0 RT

PAVEMENT CORES = ♂

| No. | TOTAL DEPTH (Inches) | PCC | COMMENTS |
|-----|----------------------|-----|----------|
| 2   | 1.50                 | NO  | -        |
| 3   | 3.00                 | NO  | -        |

SIGN LEGEND

R = REMOVE  
S = SALVAGE  
N = NEW  
RET = RETAIN  
B-B = BACK TO BACK  
EXISTING = -----  
NEW = -----

NOTE:

1. PAVING LIMIT ON ALL TOWN AND STATE HIGHWAYS SHALL BE MEASURED 25 FT BACK FROM U.S. ROUTE 7 EDGE OF SHOULDER UNLESS DENOTED OTHERWISE ON THE PLANS OR AS DIRECTED BY THE RESIDENT ENGINEER.

PROJECT  
LAYOUT  
SHEET #5

PROJECT NAME: WALLINGFORD - RUTLAND TOWN  
PROJECT NUMBER: NH 2408(1)S

FILE NAME: p04b050.dgn      PLOT DATE: \$DATE\$  
PROJECT LEADER: D.E.G.      DRAWN BY: C.A.K.  
DESIGNED BY: J.S.P.      CHECKED BY: D.E.G.  
IPARM FILE: p04b050L05.1      SHEET 17 OF 80



646.414 DURABLE 6" WHITE LINE (MOD.) (RETROREFLECTIVITY/INLAID)  
(ALL LINES WILL INCLUDE EDGE LINE BREAKS AND  
RADIUS FOR TOWN HIGHWAYS)

CLARENDON:  
STA. 48+00.00 - STA. 64+00.00 DASHED LINE C/L  
STA. 48+00.00 - STA. 64+00.00 EDGE LINE LT  
STA. 60+85.00 - STA. 63+40.00 SOLID LANE LINE RT  
STA. 63+40.00 - STA. 64+00.00 DOTTED LANE LINE RT

646.415 DURABLE 6" YELLOW LINE (MOD.) (RETROREFLECTIVITY/INLAID)  
(ALL LINES WILL INCLUDE EDGE LINE BREAKS AND  
RADIUS FOR TOWN HIGHWAYS)

CLARENDON:  
STA. 48+00.00 - STA. 64+00.00 EDGE LINE RT

646.614 TEMPORARY 6" WHITE LINE (PAINT)  
(ALL LINES WILL INCLUDE EDGE LINE BREAKS AND  
RADIUS FOR TOWN HIGHWAYS)

CLARENDON:  
STA. 48+00.00 - STA. 64+00.00 DASHED LINE C/L  
STA. 48+00.00 - STA. 64+00.00 EDGE LINE LT  
STA. 60+85.00 - STA. 63+40.00 SOLID LANE LINE RT  
STA. 63+40.00 - STA. 64+00.00 DOTTED LANE LINE RT

646.615 TEMPORARY 6" YELLOW LINE (PAINT)  
(ALL LINES WILL INCLUDE EDGE LINE BREAKS AND  
RADIUS FOR TOWN HIGHWAYS)

CLARENDON:  
STA. 48+00.00 - STA. 64+00.00 EDGE LINE RT

646.50 DURABLE LETTER OR SYMBOL (THERMOPLASTIC)

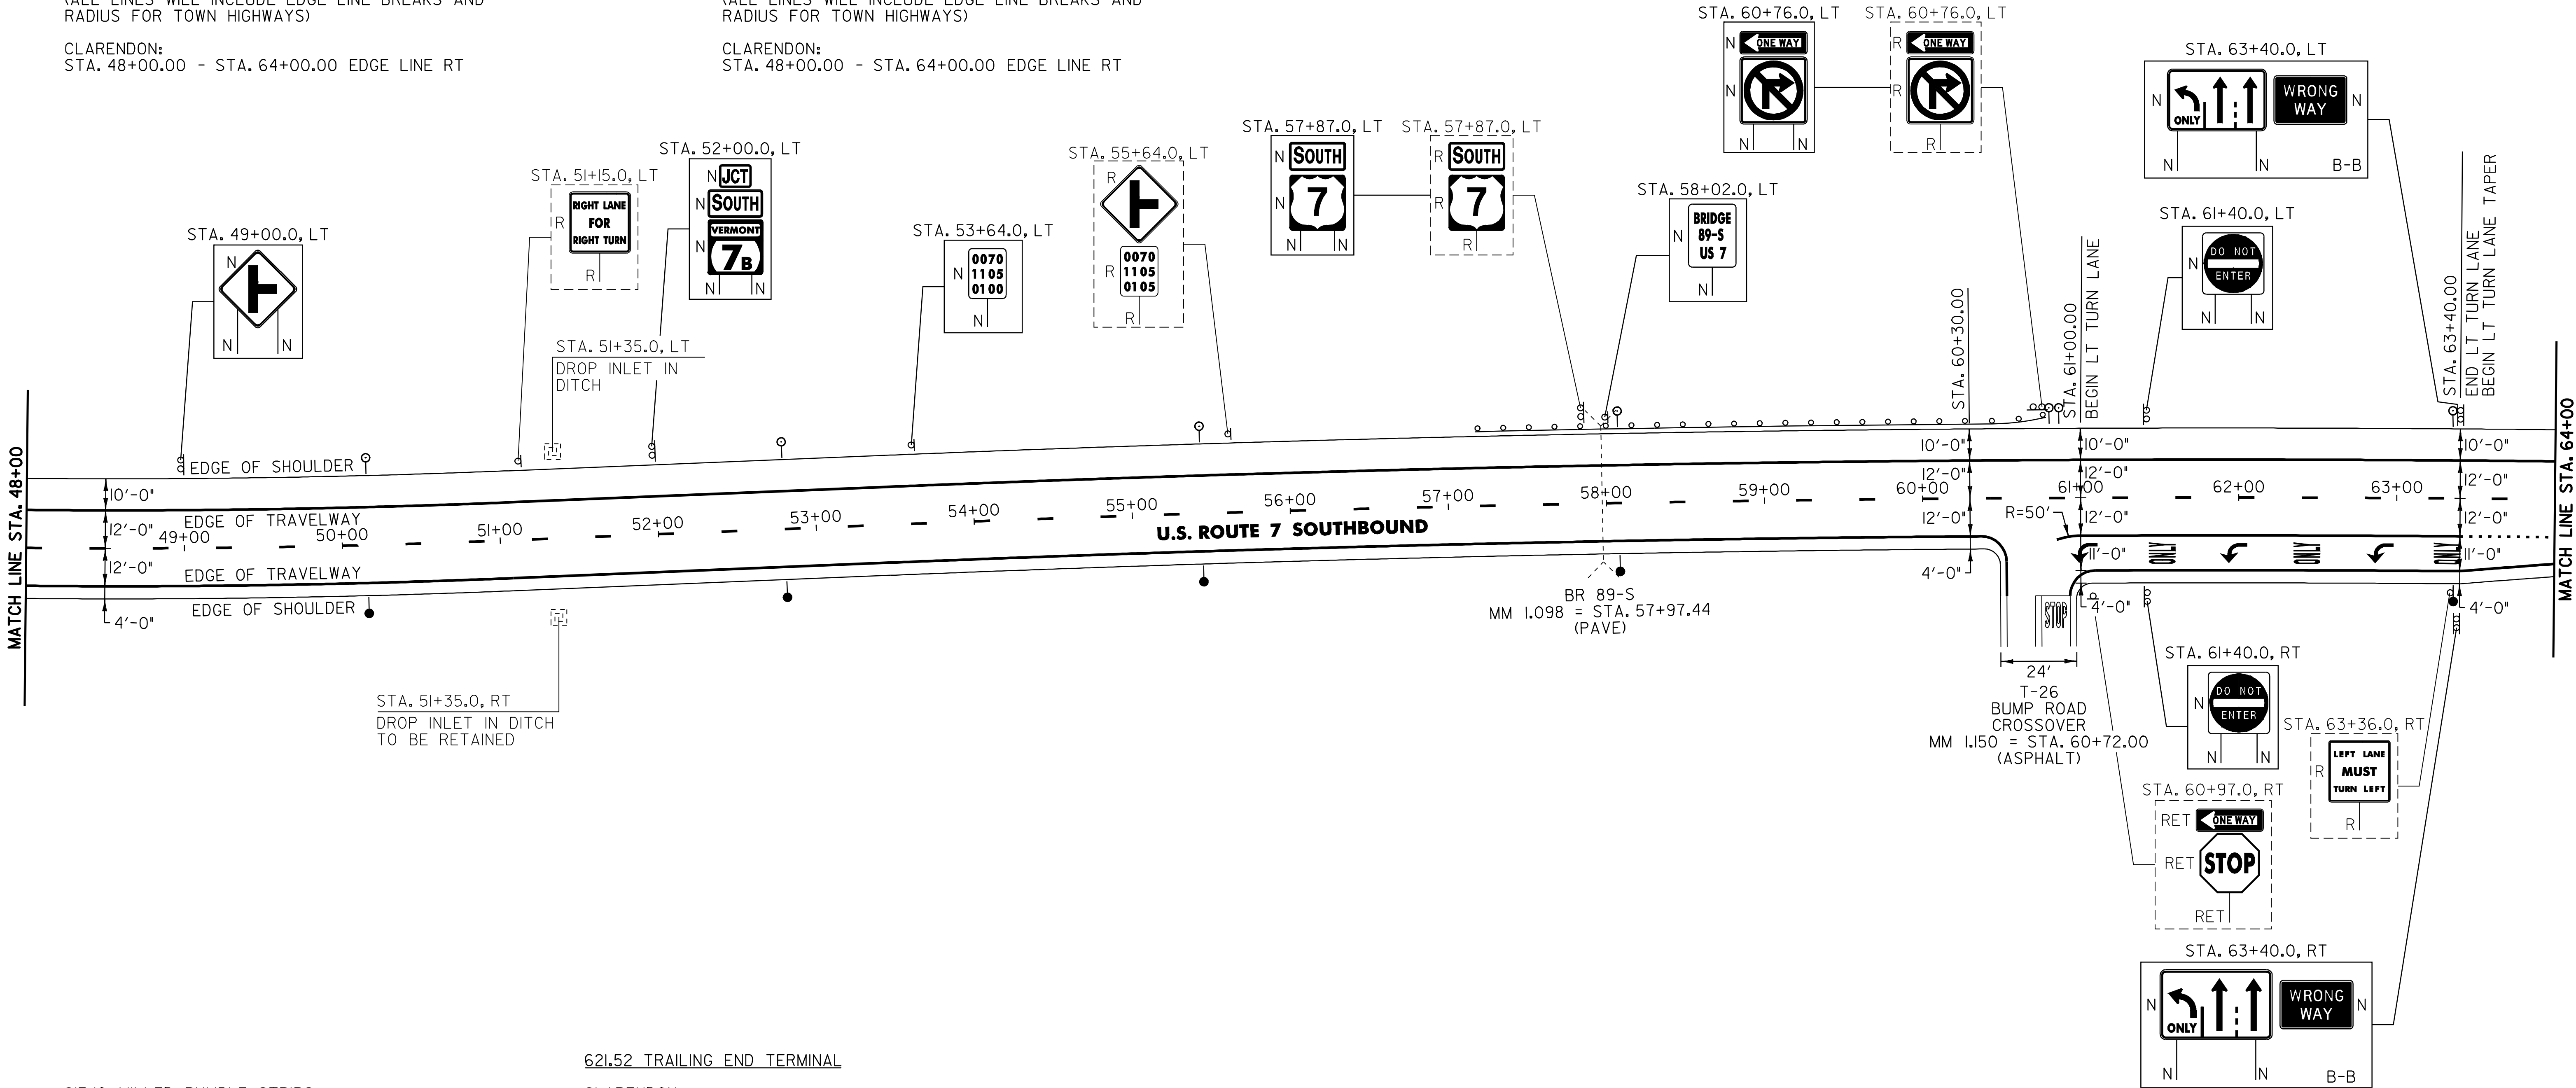
CLARENDON:  
STA. ~~61+04.3~~ RT, ARROW (1EA) **61+17 RT**  
STA. 61+50.6 RT, "O,N,L,Y" (4 EA)  
STA. 61+96.9 RT, ARROW (1EA)  
STA. 62+43.2 RT, "O,N,L,Y" (4 EA)  
STA. ~~62+89.5~~ RT, ARROW (1EA) **62+53 RT**  
STA. 63+35.8 RT, "O,N,L,Y" (4 EA)

646.70 TEMPORARY LETTER OR SYMBOL (PAINT)

CLARENDON:  
STA. 61+04.3 RT, ARROW (2 EA)  
STA. 62+89.5 RT, ARROW (2 EA)

675.50 REMOVING SIGNS

AS SHOWN - 8



213.10 MILLED RUMBLE STRIPS

CLARENDON:  
STA. 48+00.0 - STA. 64+00.0 LT (1600 LF)  
STA. 48+00.0 - STA. 60+00.0 RT (1200 LF)

604.412 REHABING DI, CB OR MH, CLASS I

CLARENDON:  
STA. 51+35.0 LT

621.20 STEEL BEAM GUARDRAIL (GALVANIZED)

CLARENDON: **57+42 - STA. 60+55 LT**  
~~STA. 57+32.0 - STA. 60+44.5 LT~~ (312.5 LF)

621.505 MANUFACTURED TERMINAL SECTION (FLARED)

CLARENDON: **60+55 - STA. 60+92 LT**  
~~STA. 60+44.5 - STA. 60+82.0 LT~~

621.52 TRAILING END TERMINAL

CLARENDON:  
~~STA. 57+18.0 - STA. 57+32.0 LT~~  
**57+30 - STA. 57+42 LT**

621.80 REMOVAL AND DISPOSAL OF GUARDRAIL

CLARENDON:  
STA. 57+20.0 - STA. 60+74.0 LT (354 LF)

676.10 DELINEATORS WITH STEEL POSTS

♀ TYPE I WHITE      ♂ TYPE I AMBER

CLARENDON:  
STA. 50+16.0 LT      STA. 50+16.0 RT  
STA. 52+80.0 LT      STA. 52+80.0 RT  
STA. 55+44.0 LT      STA. 55+44.0 RT  
STA. 58+08.0 LT      STA. 58+08.0 RT  
STA. 60+72.0 LT      STA. 63+36.0 RT  
STA. 60+82.0 LT  
STA. 63+36.0 LT

SIGN LEGEND  
R = REMOVE  
S = SALVAGE  
N = NEW  
RET = RETAIN  
B-B = BACK TO BACK  
EXISTING = -----  
NEW = \_\_\_\_\_

PROJECT  
LAYOUT  
SHEET #6

PROJECT NAME: WALLINGFORD - RUTLAND TOWN  
PROJECT NUMBER: NH 2408(1)S

FILE NAME: p04b050.dgn  
PROJECT LEADER: D.E.G.  
DESIGNED BY: J.S.P.  
IPARM FILE: p04b050L06.1

PLOT DATE: \$DATE\$  
DRAWN BY: C.A.K.  
CHECKED BY: D.E.G.  
SHEET 18 OF 80



646.614 TEMPORARY 6" WHITE LINE (PAINT)  
(ALL LINES WILL INCLUDE EDGE LINE BREAKS AND  
RADIUS FOR TOWN HIGHWAYS)

CLARENDON:

|               |                 |                     |
|---------------|-----------------|---------------------|
| STA. 64+00.00 | - STA. 80+00.00 | DASHED LINE C/L     |
| STA. 64+00.00 | - STA. 80+00.00 | EDGE LINE LT        |
| STA. 64+00.00 | - STA. 66+00.00 | DOTTED LANE LINE RT |
| STA. 77+60.00 | - STA. 80+00.00 | SOLID LANE LINE RT  |
| STA. 77+75.00 | - STA. 78+75.00 | SOLID LANE LINE LT  |
| STA. 78+75.00 | - STA. 80+00.00 | DOTTED LANE LINE LT |

646.615 TEMPORARY 6" YELLOW LINE (PAINT)  
(ALL LINES WILL INCLUDE EDGE LINE BREAKS AND  
RADIUS FOR TOWN HIGHWAYS)

CLARENDON:  
STA. 64+00.00 - STA. 80+00.00 EDGE LINE RT

646.60 TEMPORARY 4" WHITE LINE (PAINT)

CLARENDON:  
STA. 77+40.48 EDGE LINE LT, T-1

646.6| TEMPORARY 4" YELLOW LINE (PAINT)

CLARENDON:

CLARENDON:  
STA. 77+40.48 LT, T-1

621.505 MANUFACTURED TERMINAL SECTION (FLARED)

CLARENDON:  
STA. 74+89.3 - STA. 75+26.8 LT  
STA. 75+51.8 - STA. 75+89.3 RT

## 621.52 TRAILING END TERMINAL

CLARENDON:  
STA. 67+34.2 - STA. 67+48.2 LT  
STA. 68+09.2 - STA. 68+23.2 RT

621.72 ALUMINUM APPROACH RAIL

CLARENDON:  
STA. 68+60.7 - STA. 68+88.0 LT (27.3 LF)  
STA. 68+60.7 - STA. 68+88.0 RT (27.3 LF)  
STA. 72+37.0 - STA. 72+64.3 LT (27.3 LF)  
STA. 72+37.0 - STA. 72+64.3 RT (27.3 LF)

## 621.80 REMOVAL AND DISPOSAL OF GUARDRAIL

CLARENDON:  
STA. 67+37.0 - STA. 68+88.0 LT (151 LF)  
STA. 68+12.0 - STA. 68+88.0 RT (76 LF)  
STA. 68+87.0 RT (37.5 LF)  
STA. 72+37.0 - STA. 74+40.0 LT (203 LF)  
STA. 72+37.0 - STA. 74+40.0 RT (203 LF)  
STA. 72+38.0 RT (37.5 LF)

## 676.10 DELINEATORS WITH STEEL POSTS

○ TYPE I WHITE      ● TYPE I AMBER

|              |    |                 |
|--------------|----|-----------------|
| CLARENDON:   |    |                 |
| STA. 66+00.0 | LT | STA. 66+00.0 RT |
| STA. 68+64.0 | LT | STA. 68+64.0 RT |
| STA. 73+92.0 | LT | STA. 73+92.0 RT |
| STA. 75+26.8 | LT | STA. 75+89.3 RT |
| STA. 76+56.0 | LT | STA. 76+56.0 RT |
| STA. 79+20.0 | LT | STA. 79+20.0 RT |

NOTES:

I. PAVING LIMIT ON ALL TOWN AND STATE HIGHWAYS SHALL BE MEASURED 25 FT BACK FROM U.S. ROUTE 7 EDGE OF SHOULDER UNLESS DENOTED OTHERWISE ON THE PLANS OR AS DIRECTED BY THE RESIDENT ENGINEER.

2. SEE SHEETS 72 TO 74 FOR ALUMINUM APPROACH RAILING DETAILS.  
SEE SHEET 75 FOR BR 90-S DETAILS.

3. THERE ARE 24 EXISTING DRAINAGE STRUCTURES LOCATED IN THE LEFT AND RIGHT SHOULDERS ON BR 90-S. HEIGHT ADJUSTMENTS OR REHABILITATIONS WILL NOT BE REQUIRED.

CLARENDON:  
STA. 76+78.0 - STA. 77+28.0 LT (80 LF)  
STA. 77+52.0 - STA. 77+96.0 LT (65 LF)

CLARENDON:  
STA. 76+78.0 - STA. 77+28.0 LT (80 LF)  
STA. 77+52.0 - STA. 77+96.0 LT (65 LF)

Diagram illustrating a T-intersection scenario. The main road is a one-way street (STA. 77+27.0, LT) with a 'STOP' sign and a 'DIVIDED HIGHWAY' sign. The intersecting road is a two-lane road (STA. 77+27.0, LT) with a 'STOP' sign and a 'MIDDLE RD' sign. The intersection is marked with 'N' and 'B-B' labels.

STA. 77+20.0, LT

S MIDDLE RD MIDDLE RD S

N B-B

Diagram of a diamond interchange. A horizontal road (top) meets a vertical road (bottom) at a diamond-shaped interchange. The vertical road has a bridge crossing over the horizontal road. A diamond-shaped sign with a black border and white background is placed on the vertical road, just below the bridge. The sign contains the text "BRIDGES FREEZE BEFORE ROAD" in black capital letters. Above the sign, the text "STA. 76+22.0" is written. The vertical road is labeled "R" at the top and bottom. The horizontal road is labeled "R" on the left and right sides.

Diagram illustrating a two-lane road with a center turn lane. The road is labeled with stationing: STA. 74+87.0, LT on the left and STA. 76+05.0, LT on the right. The right side of the road features a 'SOUTH' directional sign and a '7' shield. The left side of the road features a sign with the numbers '0070', '1105', and '0140'.

|                 |  |
|-----------------|--|
| BEGIN SB ACCELE |  |
| STA. 76+00.00   |  |
| END SB ACCELE   |  |

### SIGN LEGEND

R = REMOVE  
 S = SALVAGE  
 N = NEW  
 RET = RETAIN  
 B-B = BACK TO BACK  
 EXISTING = -----  
 NEW = -----

S SHOWN - 17

75.60 ERECTING SALVAGED SIGNS

S SHOWN - 2

PROJECT NAME: WALLINGFORD - RUTLAND TOWN

PROJECT NUMBER: NH 2408(1)S

FILE NAME: p04b050.dgn PLOT DATE: \$DATE\$  
PROJECT LEADER: D.E.G. DRAWN BY: C.A.K.  
DESIGNED BY: J.S.P. CHECKED BY: D.E.G.  
IPARM FILE: p04b050LO71 SHEET 19 OF 80

PLOT DATE: \$DATE\$  
DRAWN BY: C.A.K.  
CHECKED BY: D.E.G.  
SHEET 19 OF 80



646.414 DURABLE 6" WHITE LINE (MOD.) (RETROREFLECTIVITY/INLAID)  
(ALL LINES WILL INCLUDE EDGE LINE BREAKS AND RADIUS FOR TOWN HIGHWAYS)

CLARENDON:  
STA. 80+00.00 - STA. 96+00.00 DASHED LINE C/L  
STA. 80+00.00 - STA. 96+00.00 EDGE LINE LT  
STA. 80+00.00 - STA. 80+75.00 DOTTED LANE LINE LT  
STA. 80+00.00 - STA. 80+75.00 SOLID LANE LINE RT  
STA. 80+75.00 - STA. 82+75.00 DOTTED LANE LINE RT

646.415 DURABLE 6" YELLOW LINE (MOD.) (RETROREFLECTIVITY/INLAID)  
(ALL LINES WILL INCLUDE EDGE LINE BREAKS AND RADIUS FOR TOWN HIGHWAYS)

CLARENDON:  
STA. 80+00.00 - STA. 96+00.00 EDGE LINE RT

646.614 TEMPORARY 6" WHITE LINE (PAINT)  
(ALL LINES WILL INCLUDE EDGE LINE BREAKS AND RADIUS FOR TOWN HIGHWAYS)

CLARENDON:  
STA. 80+00.00 - STA. 96+00.00 DASHED LINE C/L  
STA. 80+00.00 - STA. 96+00.00 EDGE LINE LT  
STA. 80+00.00 - STA. 80+75.00 DOTTED LANE LINE LT  
STA. 80+00.00 - STA. 80+75.00 SOLID LANE LINE RT  
STA. 80+75.00 - STA. 82+75.00 DOTTED LANE LINE RT

646.615 TEMPORARY 6" YELLOW LINE (PAINT)  
(ALL LINES WILL INCLUDE EDGE LINE BREAKS AND RADIUS FOR TOWN HIGHWAYS)

CLARENDON:  
STA. 80+00.00 - STA. 96+00.00 EDGE LINE RT

646.50 DURABLE LETTER OR SYMBOL (THERMOPLASTIC)

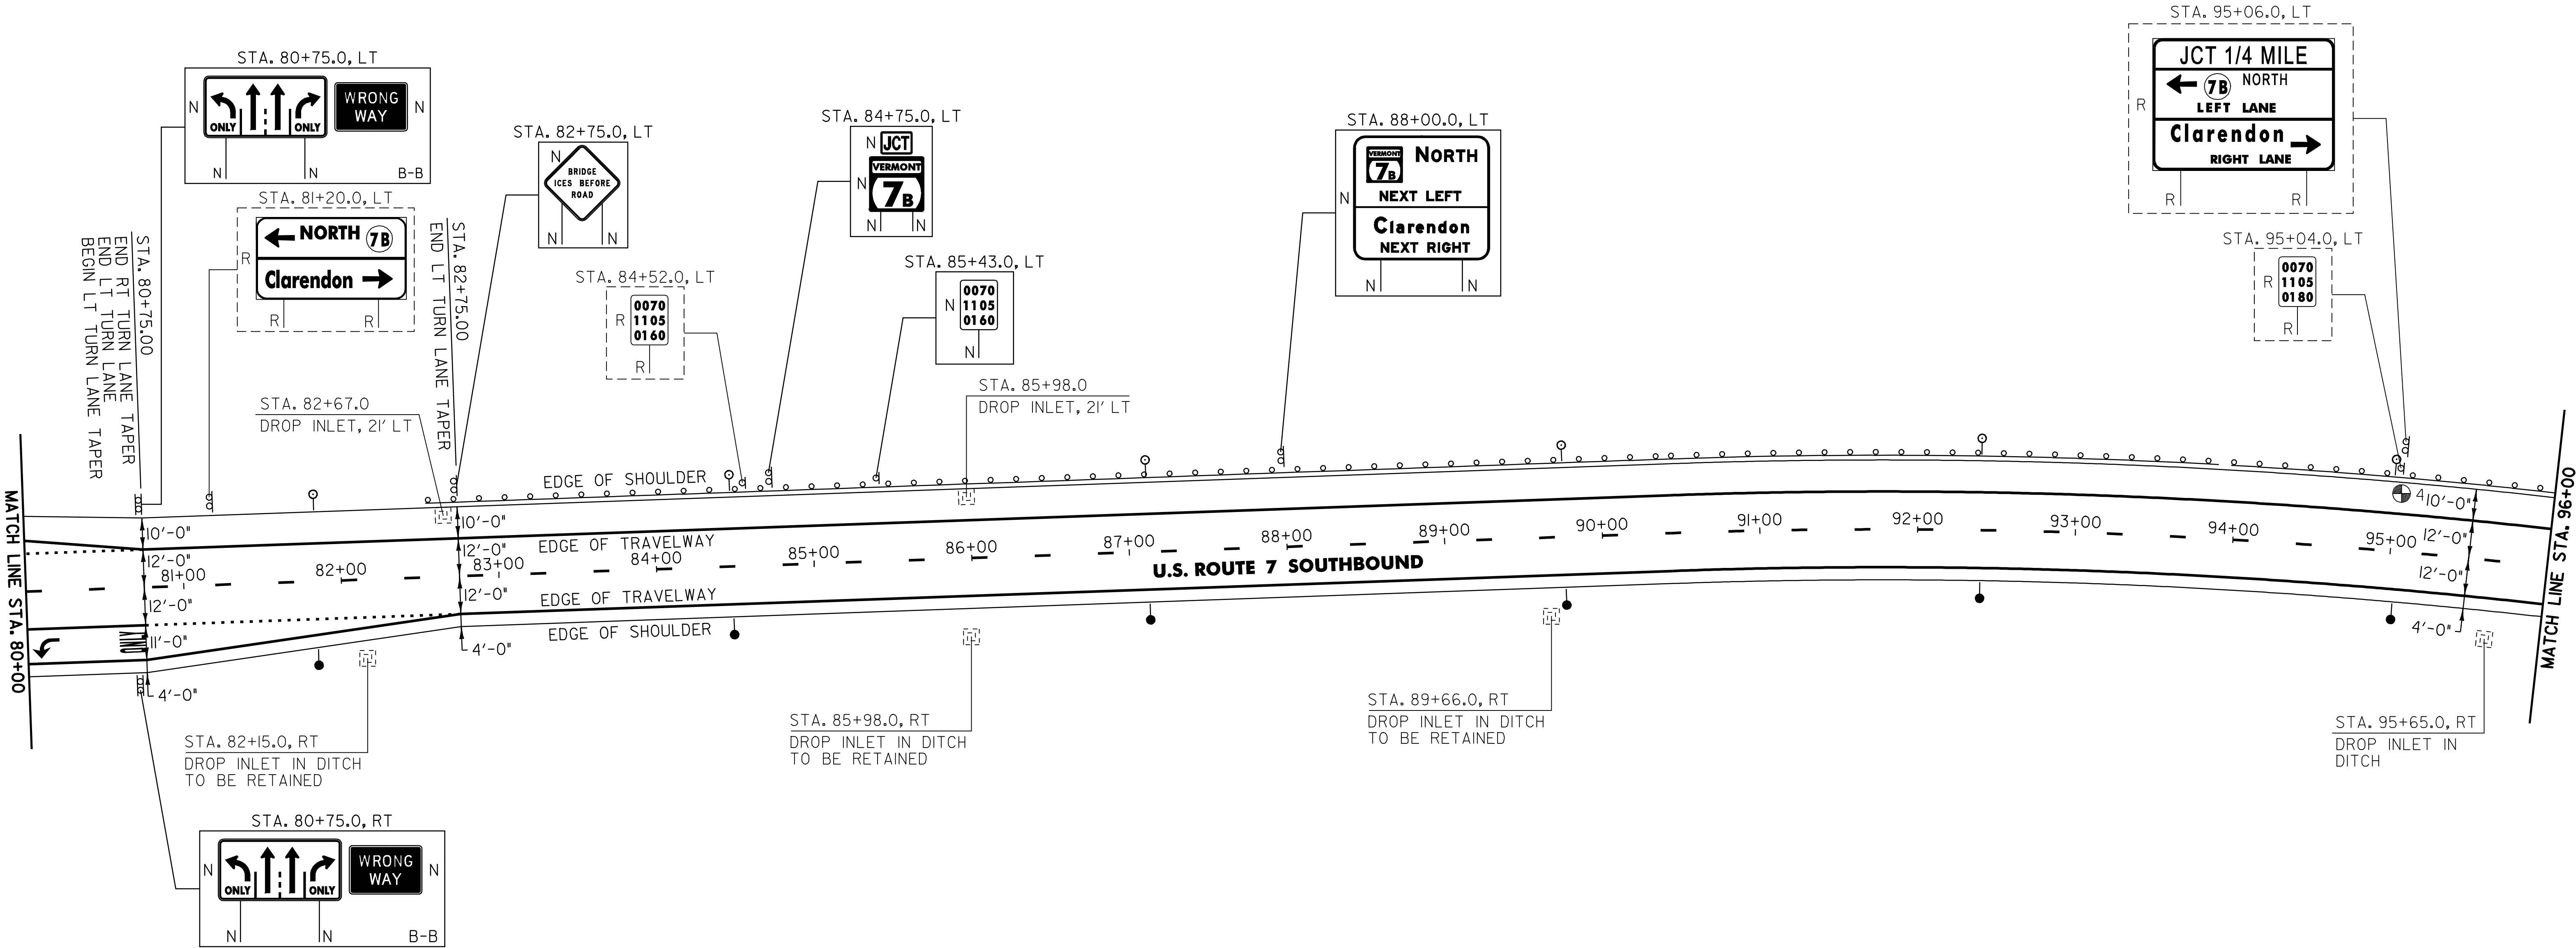
CLARENDON:  
STA. 80+11.5 RT, ARROW (1EA)  
STA. 80+70.8 RT, "O,N,L,Y" (4 EA)

646.70 TEMPORARY LETTER OR SYMBOL (PAINT)

CLARENDON:  
STA. 80+11.5 RT, ARROW (2 EA)

675.50 REMOVING SIGNS

AS SHOWN - 4



213.10 MILLED RUMBLE STRIPS

CLARENDON:  
STA. 80+75.0 - STA. 96+00.0 LT (1525 LF)  
STA. 82+75.0 - STA. 96+00.0 RT (1325 LF)

604.412 REHABING DI, CB OR MH, CLASS I

CLARENDON:  
STA. 82+67.0 LT  
STA. 85+98.0 LT  
STA. 95+65.0 RT

616.35 TREATED TIMBER CURB

CLARENDON:  
STA. 82+65.0 - STA. 88+73.0 LT (608 LF)

621.20 STEEL BEAM GUARDRAIL (GALVANIZED)

CLARENDON:  
STA. 82+69.0 - STA. 96+00.0 LT (1331 LF)

621.52 TRAILING END TERMINAL

CLARENDON:  
STA. 82+55.0 - STA. 82+69.0 LT

621.80 REMOVAL AND DISPOSAL OF GUARDRAIL

CLARENDON:  
STA. 82+57.0 - STA. 96+00.0 LT (1343 LF)

676.10 DELINEATORS WITH STEEL POSTS

TYPE I WHITE TYPE I AMBER

CLARENDON:  
STA. 81+84.0 LT STA. 81+84.0 RT  
STA. 84+48.0 LT STA. 84+48.0 RT  
STA. 87+12.0 LT STA. 87+12.0 RT  
STA. 89+76.0 LT STA. 89+76.0 RT  
STA. 92+40.0 LT STA. 92+40.0 RT  
STA. 95+04.0 LT STA. 95+04.0 RT

SIGN LEGEND  
R = REMOVE  
S = SALVAGE  
N = NEW  
RET = RETAIN  
B-B = BACK TO BACK  
EXISTING = -----  
NEW = -----

PAVEMENT CORES =

| No. | TOTAL DEPTH (Inches) | PCC | COMMENTS |
|-----|----------------------|-----|----------|
| 4   | 1,625                | N0  | -        |

PROJECT LAYOUT SHEET #8

|                                          |                             |
|------------------------------------------|-----------------------------|
| PROJECT NAME: WALLINGFORD - RUTLAND TOWN | PROJECT NUMBER: NH 2408(1)S |
| FILE NAME: p04b050.dgn                   | PLOT DATE: \$DATE\$         |
| PROJECT LEADER: D.E.G.                   | DRAWN BY: C.A.K.            |
| DESIGNED BY: J.S.P.                      | CHECKED BY: D.E.G.          |
| IPARM FILE: p04b050L08.1                 | SHEET 20 OF 80              |



646.414 DURABLE 6" WHITE LINE (MOD.) (RETROREFLECTIVITY/INLAID)  
(ALL LINES WILL INCLUDE EDGE LINE BREAKS AND  
RADIUS FOR TOWN HIGHWAYS)

CLARENDON:  
STA. 96+00.00 - STA. 112+00.00 DASHED LINE C/L  
STA. 96+00.00 - STA. 112+00.00 EDGE LINE LT

646.415 DURABLE 6" YELLOW LINE (MOD.) (RETROREFLECTIVITY/INLAID)  
(ALL LINES WILL INCLUDE EDGE LINE BREAKS AND  
RADIUS FOR TOWN HIGHWAYS)

CLARENDON:  
STA. 96+00.00 - STA. 112+00.00 EDGE LINE RT

646.614 TEMPORARY 6" WHITE LINE (PAINT)  
(ALL LINES WILL INCLUDE EDGE LINE BREAKS AND  
RADIUS FOR TOWN HIGHWAYS)

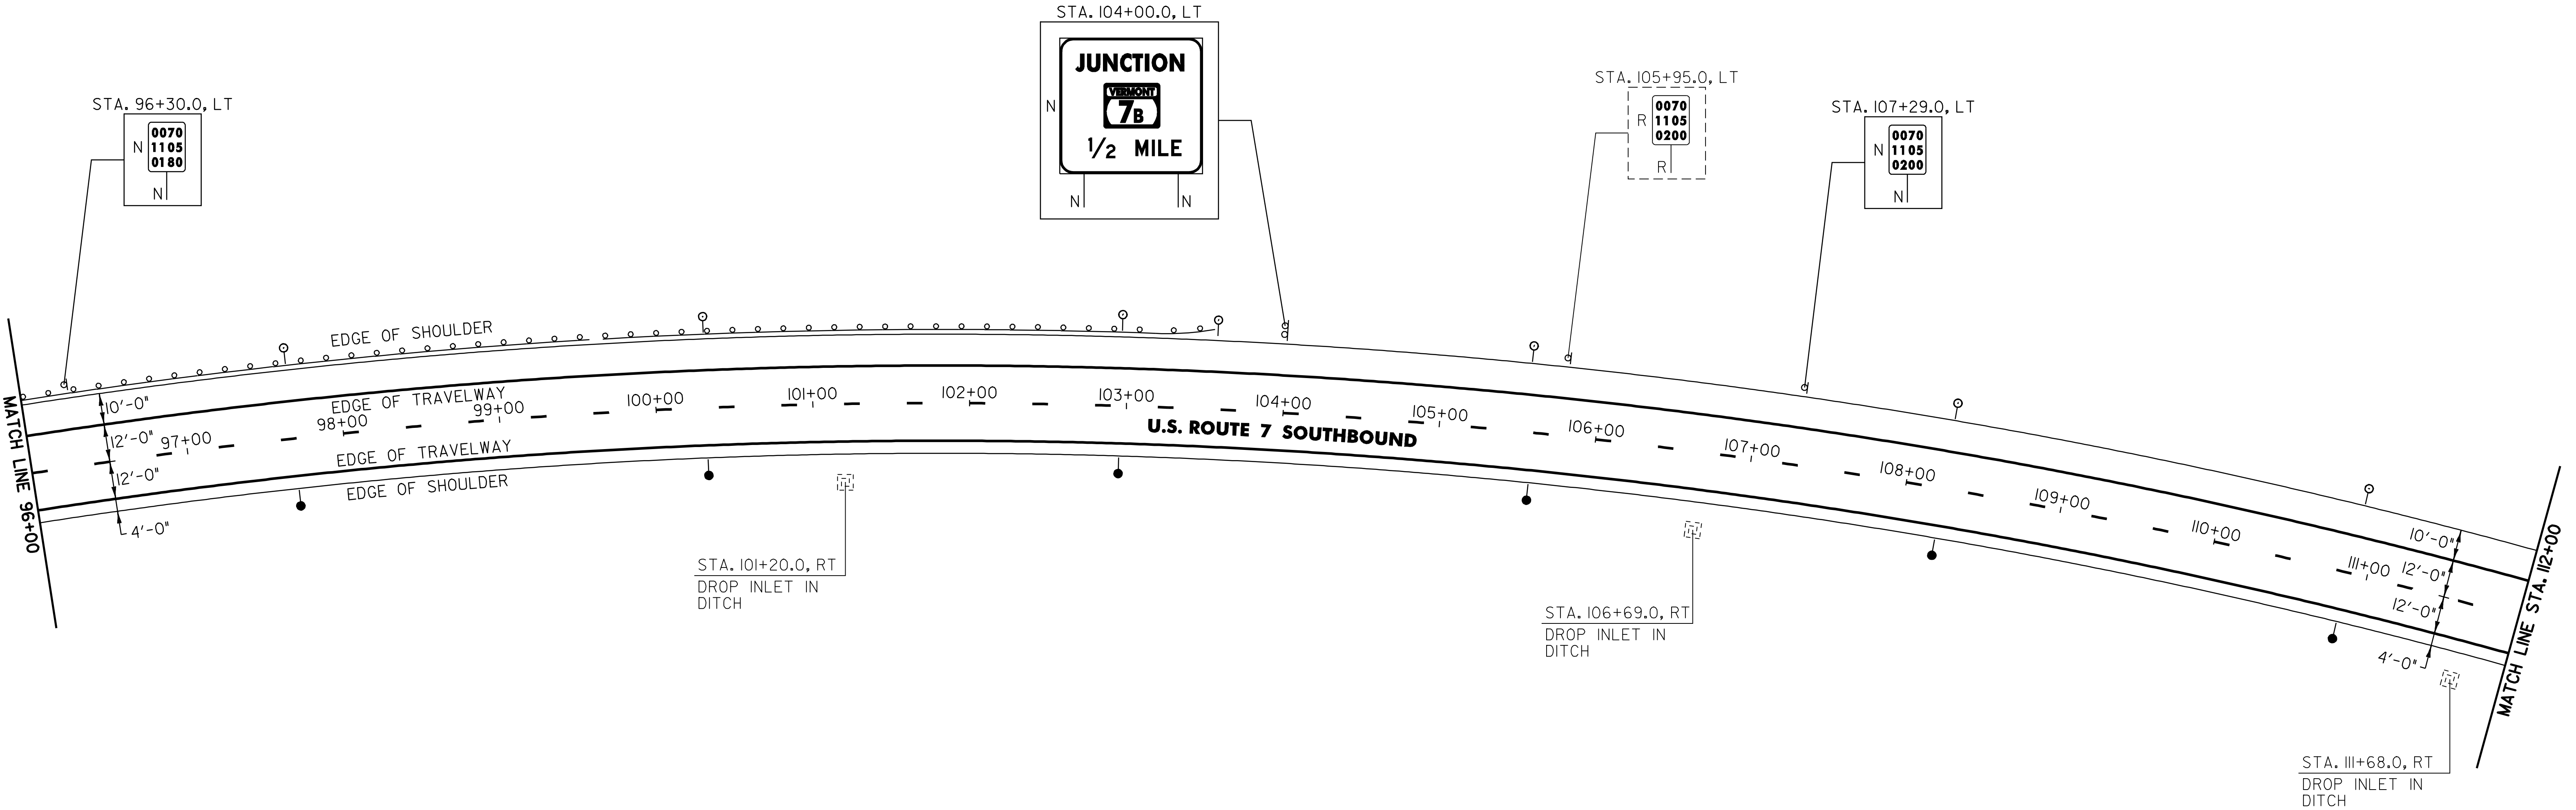
CLARENDON:  
STA. 96+00.00 - STA. 112+00.00 DASHED LINE C/L  
STA. 96+00.00 - STA. 112+00.00 EDGE LINE LT

646.615 TEMPORARY 6" YELLOW LINE (PAINT)  
(ALL LINES WILL INCLUDE EDGE LINE BREAKS AND  
RADIUS FOR TOWN HIGHWAYS)

CLARENDON:  
STA. 96+00.00 - STA. 112+00.00 EDGE LINE RT

675.50 REMOVING SIGNS

AS SHOWN - I



213.10 MILLED RUMBLE STRIPS

CLARENDON:  
STA. 96+00.0 - STA. 112+00.0 LT (1600 LF)  
STA. 96+00.0 - STA. 112+00.0 RT (1600 LF)

604.412 REHABING DI, CB OR MH, CLASS I

CLARENDON:  
STA. 101+20.0 RT  
STA. 106+69.0 RT  
STA. 111+68.0 RT

621.20 STEEL BEAM GUARDRAIL (GALVANIZED)

CLARENDON:  
STA. 96+00.0 - STA. 103+19.0 LT (719 LF)

621.505 MANUFACTURED TERMINAL SECTION (FLARED)

CLARENDON:  
STA. 103+19.0 - STA. 103+56.5 LT

621.80 REMOVAL AND DISPOSAL OF GUARDRAIL

CLARENDON:  
STA. 96+00.0 - STA. 103+42.0 LT (742 LF)

676.10 DELINEATORS WITH STEEL POSTS

○ TYPE I WHITE      ● TYPE I AMBER

CLARENDON:  
STA. 97+68.0 LT      STA. 97+68.0 RT  
STA. 100+32.0 LT      STA. 100+32.0 RT  
STA. 102+96.0 LT      STA. 102+96.0 RT  
STA. 103+56.5 LT      STA. 105+60.0 RT  
STA. 105+60.0 LT      STA. 108+24.0 RT  
STA. 108+24.0 LT      STA. 110+88.0 RT  
STA. 110+88.0 LT

SIGN LEGEND  
R = REMOVE  
S = SALVAGE  
N = NEW  
RET = RETAIN  
B-B = BACK TO BACK  
EXISTING = -----  
NEW = -----

PROJECT  
LAYOUT  
SHEET #9

PROJECT NAME: WALLINGFORD - RUTLAND TOWN  
PROJECT NUMBER: NH 2408(1)S

FILE NAME: p04b050.dgn      PLOT DATE: \$DATE\$  
PROJECT LEADER: D.E.G.      DRAWN BY: C.A.K.  
DESIGNED BY: J.S.P.      CHECKED BY: D.E.G.  
IPARM FILE: p04b050L09.1      SHEET 21 OF 80



646.414 DURABLE 6" WHITE LINE (MOD.) (RETROREFLECTIVITY/INLAID)  
(ALL LINES WILL INCLUDE EDGE LINE BREAKS AND  
RADIUS FOR TOWN HIGHWAYS)

CLARENDON:  
STA. 112+00.00 - STA. 128+00.00 DASHED LINE C/L  
STA. 112+00.00 - STA. 128+00.00 EDGE LINE LT  
STA. 125+05.00 - STA. 128+00.00 DASHED LANE LINE LT

646.415 DURABLE 6" YELLOW LINE (MOD.) (RETROREFLECTIVITY/INLAID)  
(ALL LINES WILL INCLUDE EDGE LINE BREAKS AND  
RADIUS FOR TOWN HIGHWAYS)

CLARENDON:  
STA. 112+00.00 - STA. 128+00.00 EDGE LINE RT

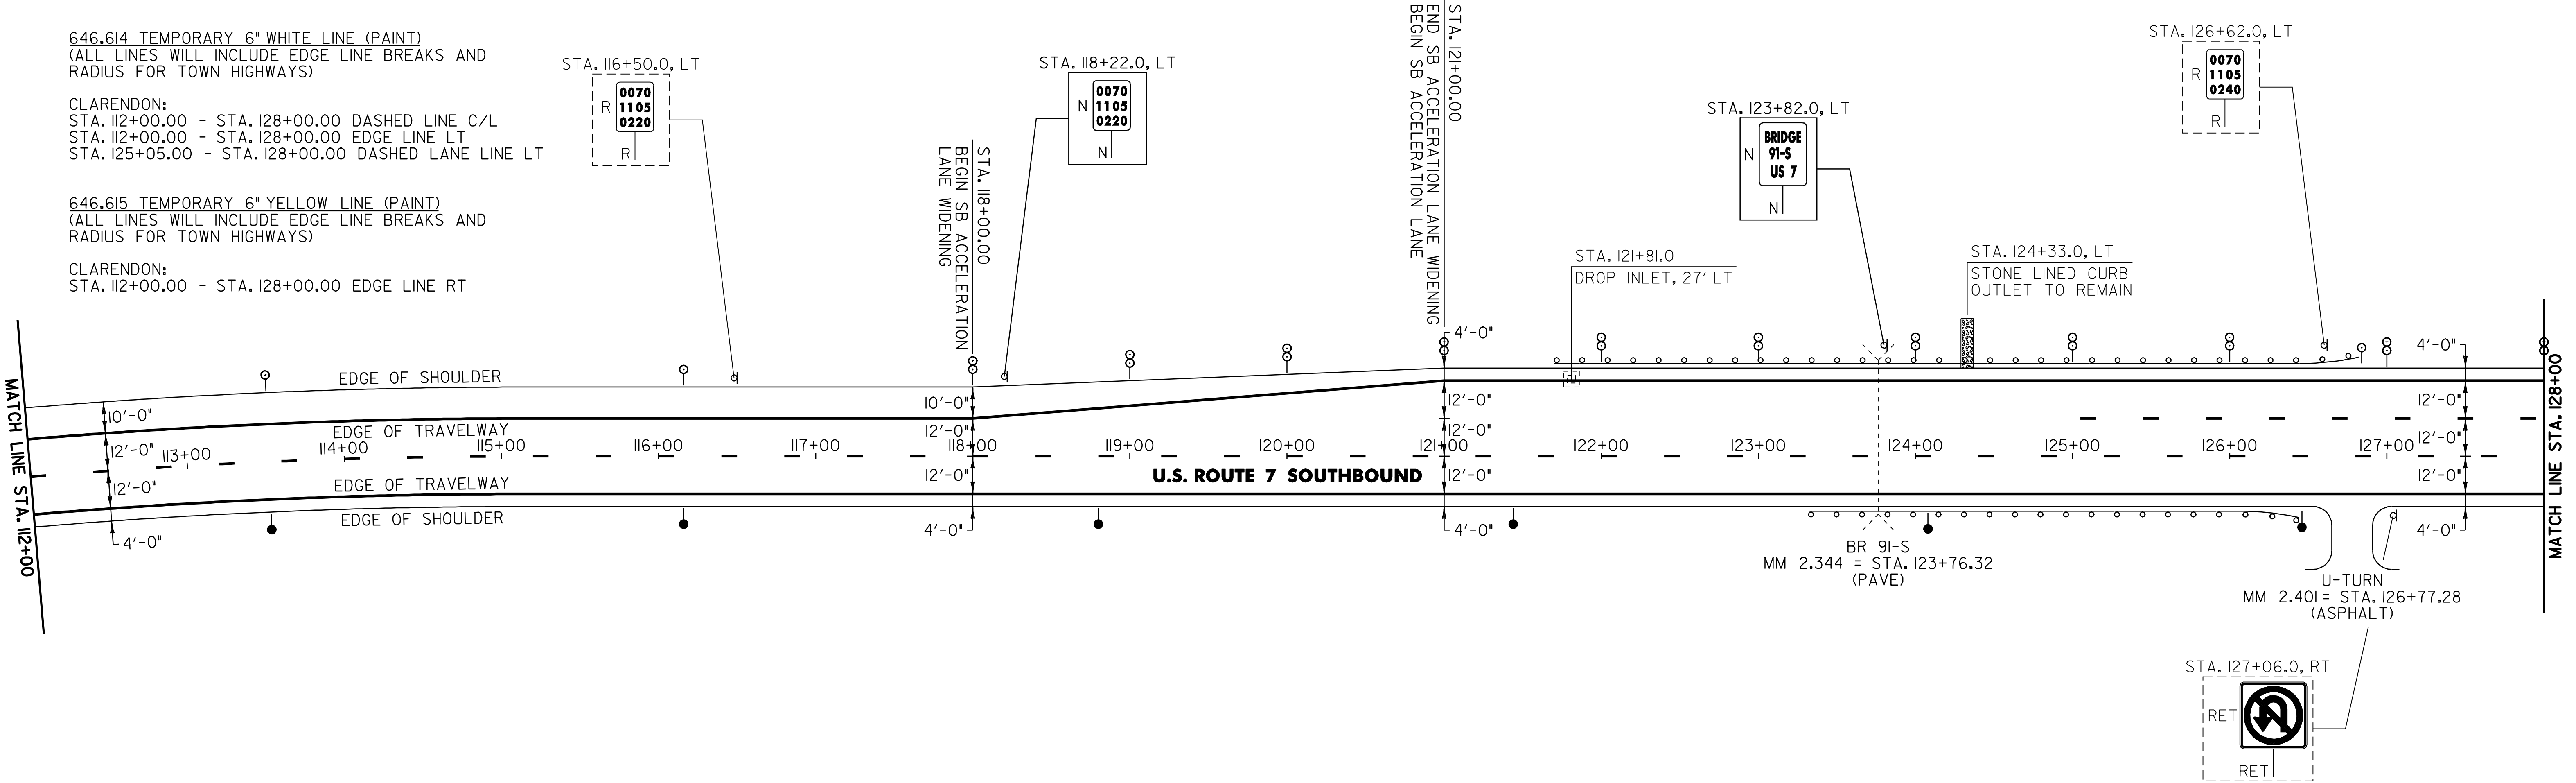
646.614 TEMPORARY 6" WHITE LINE (PAINT)  
(ALL LINES WILL INCLUDE EDGE LINE BREAKS AND  
RADIUS FOR TOWN HIGHWAYS)

CLARENDON:  
STA. 112+00.00 - STA. 128+00.00 DASHED LINE C/L  
STA. 112+00.00 - STA. 128+00.00 EDGE LINE LT  
STA. 125+05.00 - STA. 128+00.00 DASHED LANE LINE LT

646.615 TEMPORARY 6" YELLOW LINE (PAINT)  
(ALL LINES WILL INCLUDE EDGE LINE BREAKS AND  
RADIUS FOR TOWN HIGHWAYS)

CLARENDON:  
STA. 112+00.00 - STA. 128+00.00 EDGE LINE RT

675.50 REMOVING SIGNS  
AS SHOWN - 2



213.10 MILLED RUMBLE STRIPS

CLARENDON:  
STA. 112+00.0 - STA. 118+00.0 LT (600 LF)  
STA. 112+00.0 - STA. 123+32.0 RT (1132 LF)  
STA. 127+50.0 - STA. 128+00.0 RT (50 LF)

604.412 REHABING DI, CB OR MH, CLASS 1

CLARENDON:  
STA. 121+81.0 LT

616.35 TREATED TIMBER CURB

CLARENDON:  
STA. 121+75.0 - STA. 124+31.0 LT (256 LF)  
STA. 124+35.0 - STA. 126+43.0 LT (208 LF)

621.20 STEEL BEAM GUARDRAIL (GALVANIZED)

CLARENDON: STA. 123+26 - STA. 126+06 RT (275 LF)  
STA. 121+84.0 - STA. 126+46.5 LT (462.5 LF) 475 LF  
STA. 123+46.0 - STA. 126+08.5 RT (262.5 LF)

621.505 MANUFACTURED TERMINAL SECTION (FLARED)

CLARENDON:  
STA. 126+08.5 - STA. 126+46.0 RT  
STA. 126+46.5 - STA. 126+84.0 LT

621.52 TRAILING END TERMINAL

CLARENDON:  
STA. 121+70.0 - STA. 121+84.0 LT  
STA. 123+32.0 - STA. 123+46.0 RT  
123+18 - STA. 123+26 RT

621.80 REMOVAL AND DISPOSAL OF GUARDRAIL

CLARENDON:  
STA. 121+72.0 - STA. 126+62.0 LT (490 LF)  
STA. 123+34.0 - STA. 125+10.0 RT (176 LF)

676.10 DELINEATORS WITH STEEL POSTS

TYPE I WHITE TYPE I AMBER TYPE II WHITE

CLARENDON:  
STA. 113+52.0 LT STA. 116+16.0 RT STA. 118+00.0 LT  
STA. 116+16.0 LT STA. 118+80.0 RT STA. 119+00.0 LT  
STA. 126+84.0 LT STA. 121+44.0 RT STA. 120+00.0 LT  
STA. 124+08.0 RT STA. 122+00.0 LT  
STA. 126+46.0 RT STA. 123+00.0 LT  
STA. 124+00.0 LT  
STA. 125+00.0 LT  
STA. 126+00.0 LT  
STA. 127+00.0 LT  
STA. 128+00.0 LT

SIGN LEGEND  
R = REMOVE  
S = SALVAGE  
N = NEW  
RET = RETAIN  
B-B = BACK TO BACK  
EXISTING = -----  
NEW = -----

| PROJECT LAYOUT SHEET #10 | PROJECT NAME: WALLINGFORD - RUTLAND TOWN |  |
|--------------------------|------------------------------------------|--|
|                          | PROJECT NUMBER: NH 2408(1)S              |  |
| FILE NAME: p04b050.dgn   | PLOT DATE: \$DATE\$                      |  |
| PROJECT LEADER: D.E.G.   | DRAWN BY: C.A.K.                         |  |
| DESIGNED BY: J.S.P.      | CHECKED BY: D.E.G.                       |  |
| IPARM FILE: p04b050L10.1 | SHEET 22 OF 80                           |  |



646.414 DURABLE 6" WHITE LINE (MOD.) (RETROREFLECTIVITY/INLAID)  
(ALL LINES WILL INCLUDE EDGE LINE BREAKS AND  
RADIUS FOR TOWN HIGHWAYS)

CLARENDON:  
STA. 128+00.00 - STA. 144+00.00 DASHED LINE C/L  
STA. 128+00.00 - STA. 129+65.00 EDGE LINE LT  
STA. 128+00.00 - STA. 129+10.00 DASHED LANE LINE LT  
STA. 134+65.00 - STA. 144+00.00 EDGE LINE LT  
STA. 135+35.00 - STA. 136+75.00 DASHED LANE LINE LT  
STA. 136+75.00 - STA. 140+50.00 DOTTED LANE LINE LT

646.415 DURABLE 6" YELLOW LINE (MOD.) (RETROREFLECTIVITY/INLAID)  
(ALL LINES WILL INCLUDE EDGE LINE BREAKS AND  
RADIUS FOR TOWN HIGHWAYS)

CLARENDON:  
STA. 128+00.00 - STA. 144+00.00 EDGE LINE RT

646.44 DURABLE 12" WHITE LINE (MOD.) (RETROREFLECTIVITY/INLAID)

CLARENDON:  
STA. 129+10.00 - STA. 129+65.00 SOLID LANE LINE LT  
STA. 134+65.00 - STA. 135+35.00 SOLID LANE LINE LT

646.614 TEMPORARY 6" WHITE LINE (PAINT)  
(ALL LINES WILL INCLUDE EDGE LINE BREAKS AND  
RADIUS FOR TOWN HIGHWAYS)

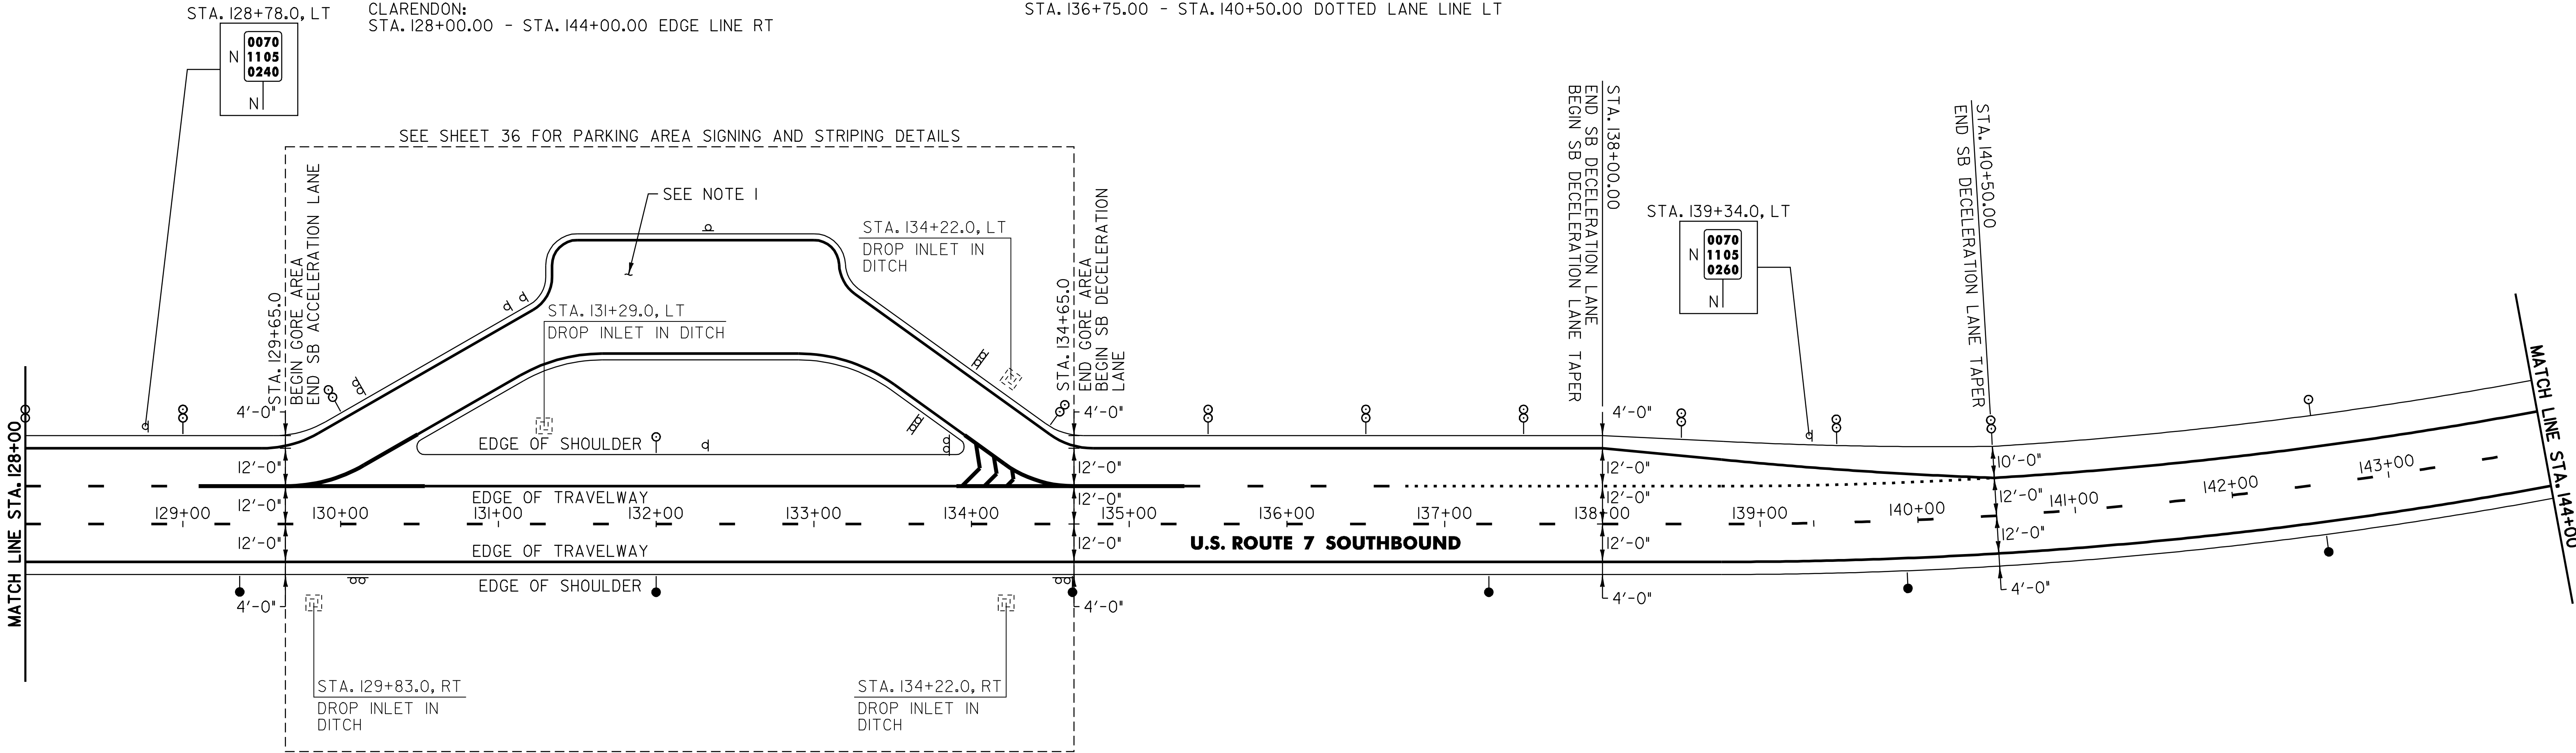
CLARENDON:  
STA. 128+00.00 - STA. 144+00.00 DASHED LINE C/L  
STA. 128+00.00 - STA. 129+65.00 EDGE LINE LT  
STA. 128+00.00 - STA. 129+10.00 DASHED LANE LINE LT  
STA. 134+65.00 - STA. 144+00.00 EDGE LINE LT  
STA. 135+35.00 - STA. 136+75.00 DASHED LANE LINE LT  
STA. 136+75.00 - STA. 140+50.00 DOTTED LANE LINE LT

646.615 TEMPORARY 6" YELLOW LINE (PAINT)  
(ALL LINES WILL INCLUDE EDGE LINE BREAKS AND  
RADIUS FOR TOWN HIGHWAYS)

CLARENDON:  
STA. 128+00.00 - STA. 144+00.00 EDGE LINE RT

646.64 TEMPORARY 12" WHITE LINE (PAINT)

CLARENDON:  
STA. 129+10.00 - STA. 129+65.00 SOLID LANE LINE LT  
STA. 134+65.00 - STA. 135+35.00 SOLID LANE LINE LT



213.10 MILLED RUMBLE STRIPS

CLARENDON:  
STA. 128+00.0 - STA. 144+00.0 RT (1600 LF)  
STA. 140+50.0 - STA. 144+00.0 LT (350 LF)

604.412 REHABING DI, CB OR MH, CLASS 1

CLARENDON:  
STA. 129+83.0 RT  
STA. 131+29.0 LT  
STA. 134+22.0 LT  
STA. 134+22.0 RT

676.10 DELINEATORS WITH STEEL POSTS

♀ TYPE I WHITE

● TYPE I AMBER

⊗ TYPE II WHITE

CLARENDON:  
STA. 132+00.0 LT  
STA. 142+56.0 LT

STA. 129+36.0 RT  
STA. 132+00.0 RT  
STA. 134+64.0 RT  
STA. 137+28.0 RT  
STA. 139+92.0 RT  
STA. 142+56.0 RT

STA. 129+00.0 LT  
STA. 130+00.0 LT  
STA. 134+50.0 LT  
STA. 135+50.0 LT  
STA. 136+50.0 LT  
STA. 137+50.0 LT  
STA. 138+50.0 LT  
STA. 139+50.0 LT  
STA. 140+50.0 LT

SIGN LEGEND

R = REMOVE  
S = SALVAGE  
N = NEW  
RET = RETAIN  
B-B = BACK TO BACK  
EXISTING = -----  
NEW = -----

NOTE:

1. PARKING AREA TO BE COLD PLANED 2 1/2", LEVEL  
WITH TYPE IVS AND PAVE WITH 2" OF TYPE IIIS  
OR AS DIRECTED BY THE RESIDENT ENGINEER.

PROJECT  
LAYOUT  
SHEET #11

PROJECT NAME: WALLINGFORD - RUTLAND TOWN  
PROJECT NUMBER: NH 2408(1)S

FILE NAME: p04b050.dgn  
PROJECT LEADER: D.E.G.  
DESIGNED BY: J.S.P.  
IPARM FILE: p04b050LI1

PLOT DATE: \$DATE\$  
DRAWN BY: C.A.K.  
CHECKED BY: D.E.G.  
SHEET 23 OF 80



646.414 DURABLE 6" WHITE LINE (MOD.) (RETROREFLECTIVITY/INLAID)  
(ALL LINES WILL INCLUDE EDGE LINE BREAKS AND  
RADIUS FOR TOWN HIGHWAYS)

CLARENDON:  
STA. 144+00.00 - STA. 160+25.00 DASHED LINE C/L  
STA. 144+00.00 - STA. 160+25.00 EDGE LINE LT

646.415 DURABLE 6" YELLOW LINE (MOD.) (RETROREFLECTIVITY/INLAID)  
(ALL LINES WILL INCLUDE EDGE LINE BREAKS AND  
RADIUS FOR TOWN HIGHWAYS)

CLARENDON:  
STA. 144+00.00 - STA. 160+25.00 EDGE LINE RT

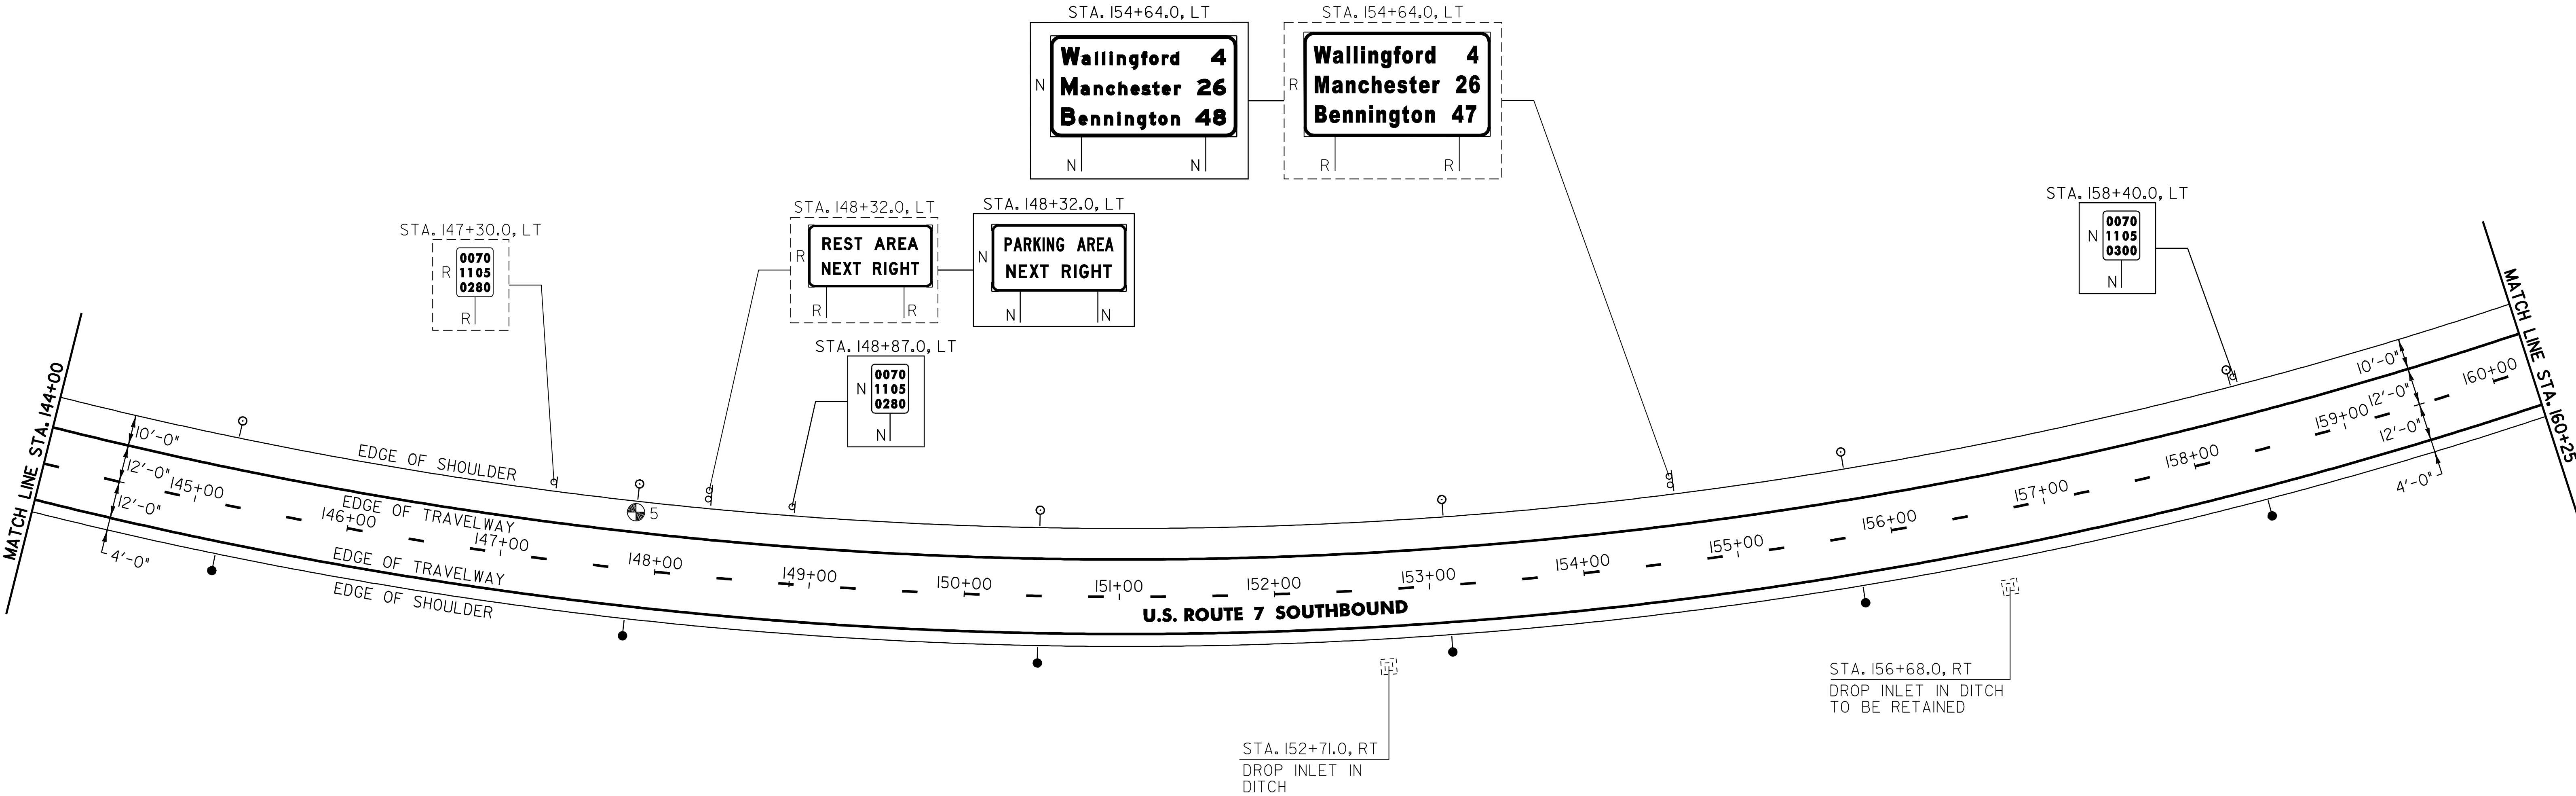
646.614 TEMPORARY 6" WHITE LINE (PAINT)  
(ALL LINES WILL INCLUDE EDGE LINE BREAKS AND  
RADIUS FOR TOWN HIGHWAYS)

CLARENDON:  
STA. 144+00.00 - STA. 160+25.00 DASHED LINE C/L  
STA. 144+00.00 - STA. 160+25.00 EDGE LINE LT

646.615 TEMPORARY 6" YELLOW LINE (PAINT)  
(ALL LINES WILL INCLUDE EDGE LINE BREAKS AND  
RADIUS FOR TOWN HIGHWAYS)

CLARENDON:  
STA. 144+00.00 - STA. 160+25.00 EDGE LINE RT

675.50 REMOVING SIGNS  
AS SHOWN - 3



213.10 MILLED RUMBLE STRIPS

CLARENDON:  
STA. 144+00.0 - STA. 160+25.0 LT (1625 LF)  
STA. 144+00.0 - STA. 160+25.0 RT (1625 LF)

604.412 REHABING DI, CB OR MH, CLASS I

CLARENDON:  
STA. 152+71.0 RT

676.10 DELINEATORS WITH STEEL POSTS

⦿ TYPE I WHITE

● TYPE I AMBER

CLARENDON:  
STA. 145+20.0 LT  
STA. 147+84.0 LT  
STA. 150+48.0 LT  
STA. 153+12.0 LT  
STA. 155+76.0 LT  
STA. 158+40.0 LT

CLARENDON:  
STA. 145+20.0 RT  
STA. 147+84.0 RT  
STA. 150+48.0 RT  
STA. 153+12.0 RT  
STA. 155+76.0 RT  
STA. 158+40.0 RT

SIGN LEGEND  
R = REMOVE  
S = SALVAGE  
N = NEW  
RET = RETAIN  
B-B = BACK TO BACK  
EXISTING = -----  
NEW = \_\_\_\_\_

| PAVEMENT CORES =  |                      |     |          |
|--------------------------------------------------------------------------------------------------------|----------------------|-----|----------|
| No.                                                                                                    | TOTAL DEPTH (Inches) | PCC | COMMENTS |
| 5                                                                                                      | 1,875                | N0  | -        |

PROJECT LAYOUT SHEET #12

|                                          |                     |
|------------------------------------------|---------------------|
| PROJECT NAME: WALLINGFORD - RUTLAND TOWN |                     |
| PROJECT NUMBER: NH 2408(1)S              |                     |
| FILE NAME: p04b050.dgn                   | PLOT DATE: \$DATE\$ |
| PROJECT LEADER: D.E.G.                   | DRAWN BY: C.A.K.    |
| DESIGNED BY: J.S.P.                      | CHECKED BY: D.E.G.  |
| IPARM FILE: p04b050LI2.1                 | SHEET 24 OF 80      |



646.414 DURABLE 6" WHITE LINE (MOD.) (RETROREFLECTIVITY/INLAID)  
(ALL LINES WILL INCLUDE EDGE LINE BREAKS AND  
RADIUS FOR TOWN HIGHWAYS)

CLARENDON:  
STA. 160+25.00 - STA. 175+00.00 DASHED LINE C/L  
STA. 160+25.00 - STA. 175+00.00 EDGE LINE LT

646.415 DURABLE 6" YELLOW LINE (MOD.) (RETROREFLECTIVITY/INLAID)  
(ALL LINES WILL INCLUDE EDGE LINE BREAKS AND  
RADIUS FOR TOWN HIGHWAYS)

CLARENDON:  
STA. 160+25.00 - STA. 175+00.00 EDGE LINE RT

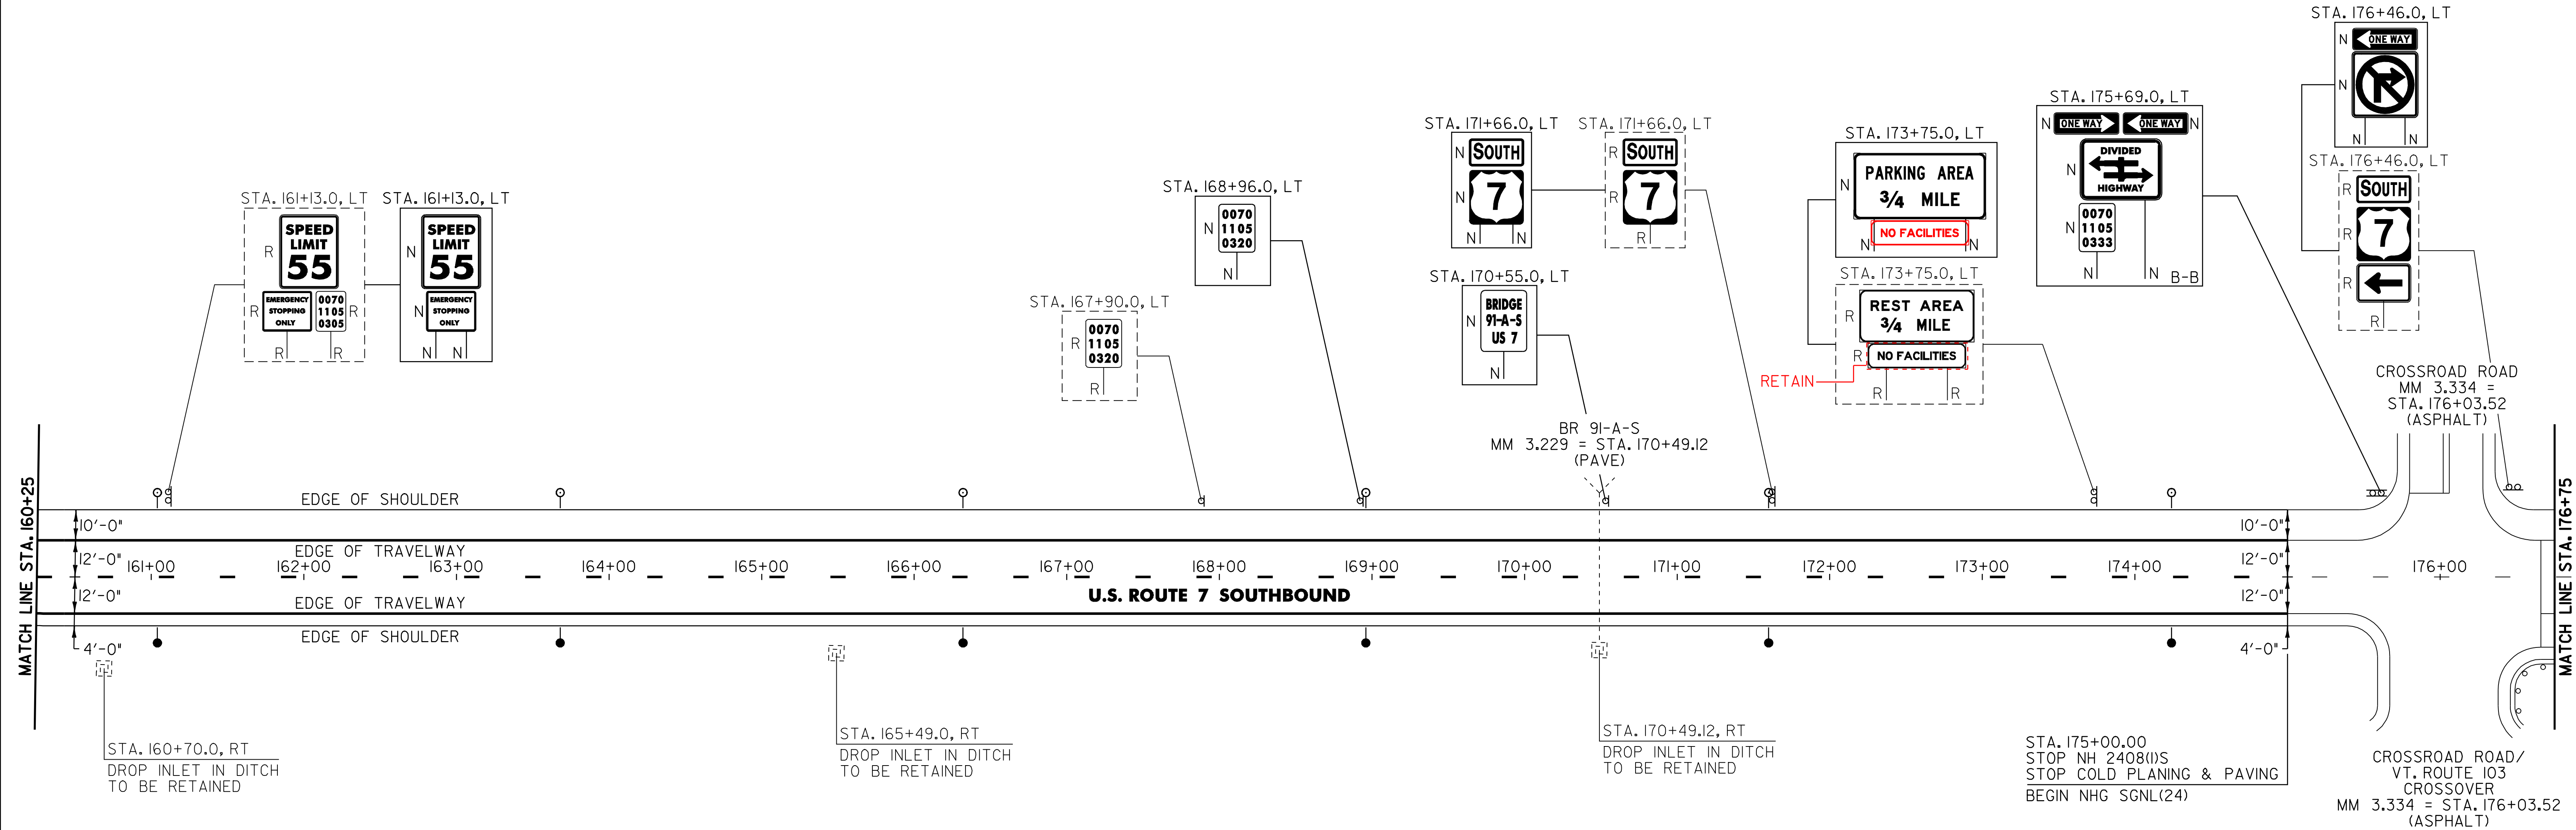
646.614 TEMPORARY 6" WHITE LINE (PAINT)  
(ALL LINES WILL INCLUDE EDGE LINE BREAKS AND  
RADIUS FOR TOWN HIGHWAYS)

CLARENDON:  
STA. 160+25.00 - STA. 175+00.00 DASHED LINE C/L  
STA. 160+25.00 - STA. 175+00.00 EDGE LINE LT

646.615 TEMPORARY 6" YELLOW LINE (PAINT)  
(ALL LINES WILL INCLUDE EDGE LINE BREAKS AND  
RADIUS FOR TOWN HIGHWAYS)

CLARENDON:  
STA. 160+25.00 - STA. 175+00.00 EDGE LINE RT

675.50 REMOVING SIGNS  
AS SHOWN - II



213.10 MILLED RUMBLE STRIPS

CLARENDON:  
STA. 160+25.0 - STA. 175+10.0 LT (1485 LF)  
STA. 160+25.0 - STA. 175+00.0 RT (1475 LF)

676.10 DELINEATORS WITH STEEL POSTS

⦿ TYPE I WHITE      ⦿ TYPE I AMBER

|                  |                  |
|------------------|------------------|
| CLARENDON:       |                  |
| STA. 161+04.0 LT | STA. 161+04.0 RT |
| STA. 163+68.0 LT | STA. 163+68.0 RT |
| STA. 166+32.0 LT | STA. 166+32.0 RT |
| STA. 168+96.0 LT | STA. 168+96.0 RT |
| STA. 171+60.0 LT | STA. 171+60.0 RT |
| STA. 174+24.0 LT | STA. 174+24.0 RT |

SIGN LEGEND  
R = REMOVE  
S = SALVAGE  
N = NEW  
RET = RETAIN  
B-B = BACK TO BACK  
EXISTING = -----  
NEW = \_\_\_\_\_

|                          |                                                                                                     |                                                                                 |
|--------------------------|-----------------------------------------------------------------------------------------------------|---------------------------------------------------------------------------------|
| PROJECT LAYOUT SHEET #13 | PROJECT NAME: WALLINGFORD - RUTLAND TOWN                                                            |                                                                                 |
|                          | PROJECT NUMBER: NH 2408(1)S                                                                         |                                                                                 |
|                          | FILE NAME: p04b050.dgn<br>PROJECT LEADER: D.E.G.<br>DESIGNED BY: J.S.P.<br>IPARM FILE: p04b050LI3.1 | PLOT DATE: \$DATE\$<br>DRAWN BY: C.A.K.<br>CHECKED BY: D.E.G.<br>SHEET 25 OF 80 |



646.414 DURABLE 6" WHITE LINE (MOD.) (RETROREFLECTIVITY/INLAID)  
(ALL LINES WILL INCLUDE EDGE LINE BREAKS AND  
RADIUS FOR TOWN HIGHWAYS)

CLARENDON:  
STA. 177+25.00 - STA. 192+00.00 DASHED LINE C/L  
STA. 177+25.00 - STA. 192+00.00 EDGE LINE LT  
STA. 177+25.00 - STA. 180+60.00 SOLID LANE LINE RT  
STA. 180+60.00 - STA. 182+70.00 DOTTED LANE LINE RT

646.415 DURABLE 6" YELLOW LINE (MOD.) (RETROREFLECTIVITY/INLAID)  
(ALL LINES WILL INCLUDE EDGE LINE BREAKS AND  
RADIUS FOR TOWN HIGHWAYS)

CLARENDON:  
STA. 177+25.00 - STA. 192+00.00 EDGE LINE RT

646.614 TEMPORARY 6" WHITE LINE (PAINT)  
(ALL LINES WILL INCLUDE EDGE LINE BREAKS AND  
RADIUS FOR TOWN HIGHWAYS)

CLARENDON:  
STA. 177+25.00 - STA. 192+00.00 DASHED LINE C/L  
STA. 177+25.00 - STA. 192+00.00 EDGE LINE LT  
STA. 177+25.00 - STA. 180+60.00 SOLID LANE LINE RT  
STA. 180+60.00 - STA. 182+70.00 DOTTED LANE LINE RT

646.615 TEMPORARY 6" YELLOW LINE (PAINT)  
(ALL LINES WILL INCLUDE EDGE LINE BREAKS AND  
RADIUS FOR TOWN HIGHWAYS)

CLARENDON:  
STA. 177+25.00 - STA. 192+00.00 EDGE LINE RT

646.50 DURABLE LETTER OR SYMBOL (THERMOPLASTIC)

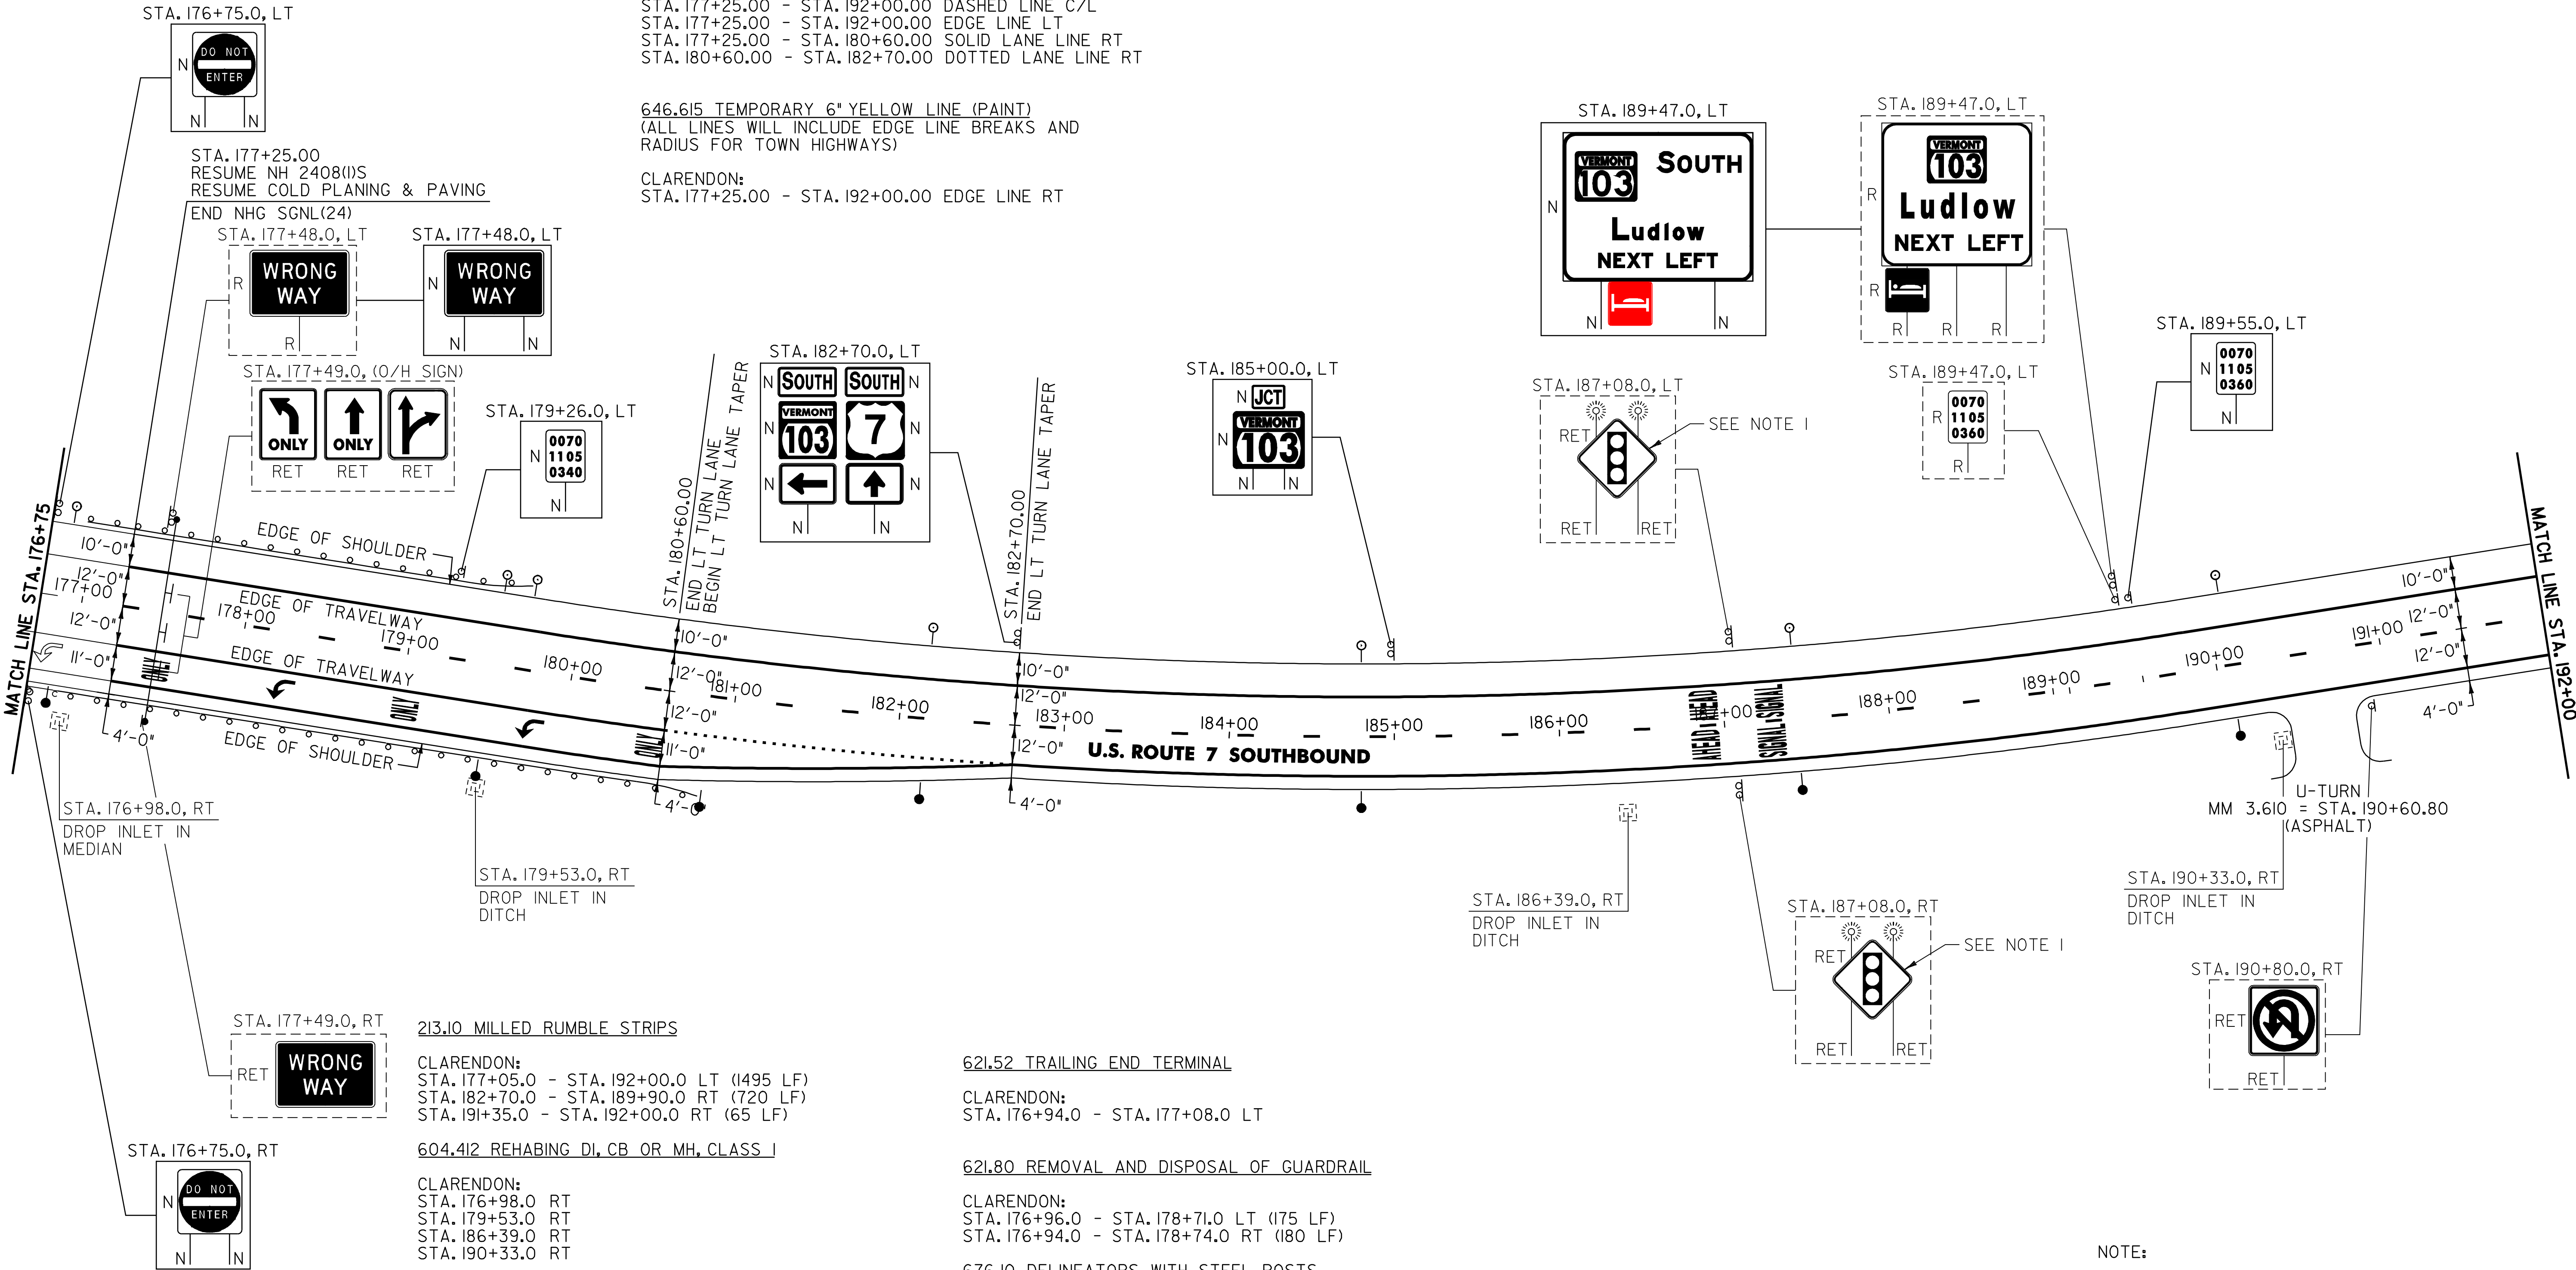
CLARENDON:  
STA. 177+50.6 RT, "O,N,L,Y" (4 EA)  
STA. 178+26.9 RT, ARROW (1EA)  
STA. 179+03.2 RT, "O,N,L,Y" (4 EA)  
STA. 179+79.5 RT, ARROW (1EA)  
STA. 180+55.8 RT, "O,N,L,Y" (4 EA)  
STA. 186+87.8 LT, "A,H,E,A,D" (5 EA)  
STA. 186+87.8 RT, "A,H,E,A,D" (5 EA)  
STA. 187+28.2 LT, "S,I,G,N,A,L" (6 EA)  
STA. 187+28.2 RT, "S,I,G,N,A,L" (6 EA)

646.70 TEMPORARY LETTER OR SYMBOL (PAINT)

CLARENDON:  
STA. 179+79.5 RT, ARROW (2 EA)  
STA. 186+87.8 LT, "A,H,E,A,D" (10 EA)  
STA. 186+87.8 RT, "A,H,E,A,D" (10 EA)  
STA. 187+28.2 LT, "S,I,G,N,A,L" (12 EA)  
STA. 187+28.2 RT, "S,I,G,N,A,L" (12 EA)

675.50 REMOVING SIGNS

AS SHOWN - 4



213.10 MILLED RUMBLE STRIPS

CLARENDON:  
STA. 177+05.0 - STA. 192+00.0 LT (1495 LF)  
STA. 182+70.0 - STA. 189+90.0 RT (720 LF)  
STA. 191+35.0 - STA. 192+00.0 RT (65 LF)

604.412 REHABING DI, CB OR MH, CLASS I

CLARENDON:  
STA. 176+98.0 RT  
STA. 179+53.0 RT  
STA. 186+39.0 RT  
STA. 190+33.0 RT

621.20 STEEL BEAM GUARDRAIL (GALVANIZED)

CLARENDON:  
STA. 176+94.0 - STA. 180+44.0 RT (350 LF)  
STA. 177+08.0 - STA. 179+33.0 LT (225 LF)

621.505 MANUFACTURED TERMINAL SECTION (FLARED)

CLARENDON:  
STA. 179+33.0 - STA. 179+70.5 LT  
STA. 180+44.0 - STA. 180+81.5 RT

621.52 TRAILING END TERMINAL

CLARENDON:  
STA. 176+94.0 - STA. 177+08.0 LT

621.80 REMOVAL AND DISPOSAL OF GUARDRAIL

CLARENDON:  
STA. 176+96.0 - STA. 178+71.0 LT (175 LF)  
STA. 176+94.0 - STA. 178+74.0 RT (180 LF)

676.10 DELINEATORS WITH STEEL POSTS

TYPE I WHITE TYPE I AMBER

CLARENDON:  
STA. 176+88.0 LT STA. 176+88.0 RT  
STA. 179+52.0 LT STA. 179+52.0 RT  
STA. 179+70.5 LT STA. 180+81.0 RT  
STA. 182+16.0 LT STA. 182+16.0 RT  
STA. 184+80.0 LT STA. 184+80.0 RT  
STA. 187+44.0 LT STA. 187+44.0 RT  
STA. 190+08.0 LT STA. 190+08.0 RT

SIGN LEGEND  
R = REMOVE  
S = SALVAGE  
N = NEW  
RET = RETAIN  
B-B = BACK TO BACK  
EXISTING = -----  
NEW = -----

NOTE:  
I. EXISTING SIGNAL AHEAD WARNING SIGNS INSTALLED  
UNDER THE NHG SGNL(24) PROJECT.

|                                |                                                                                                     |                                                                                 |
|--------------------------------|-----------------------------------------------------------------------------------------------------|---------------------------------------------------------------------------------|
| PROJECT<br>LAYOUT<br>SHEET #14 | PROJECT NAME: WALLINGFORD - RUTLAND TOWN                                                            |                                                                                 |
|                                | PROJECT NUMBER: NH 2408(I)S                                                                         |                                                                                 |
|                                | FILE NAME: p04b050.dgn<br>PROJECT LEADER: D.E.G.<br>DESIGNED BY: J.S.P.<br>IPARM FILE: p04b050L14.1 | PLOT DATE: \$DATE\$<br>DRAWN BY: C.A.K.<br>CHECKED BY: D.E.G.<br>SHEET 26 OF 80 |



646.414 DURABLE 6" WHITE LINE (MOD.) (RETROREFLECTIVITY/INLAID)  
(ALL LINES WILL INCLUDE EDGE LINE BREAKS AND  
RADIUS FOR TOWN HIGHWAYS)

CLARENDON:  
STA. 192+00.00 - STA. 208+00.00 DASHED LINE C/L  
STA. 192+00.00 - STA. 208+00.00 EDGE LINE LT

646.415 DURABLE 6" YELLOW LINE (MOD.) (RETROREFLECTIVITY/INLAID)  
(ALL LINES WILL INCLUDE EDGE LINE BREAKS AND  
RADIUS FOR TOWN HIGHWAYS)

CLARENDON:  
STA. 192+00.00 - STA. 208+00.00 EDGE LINE RT

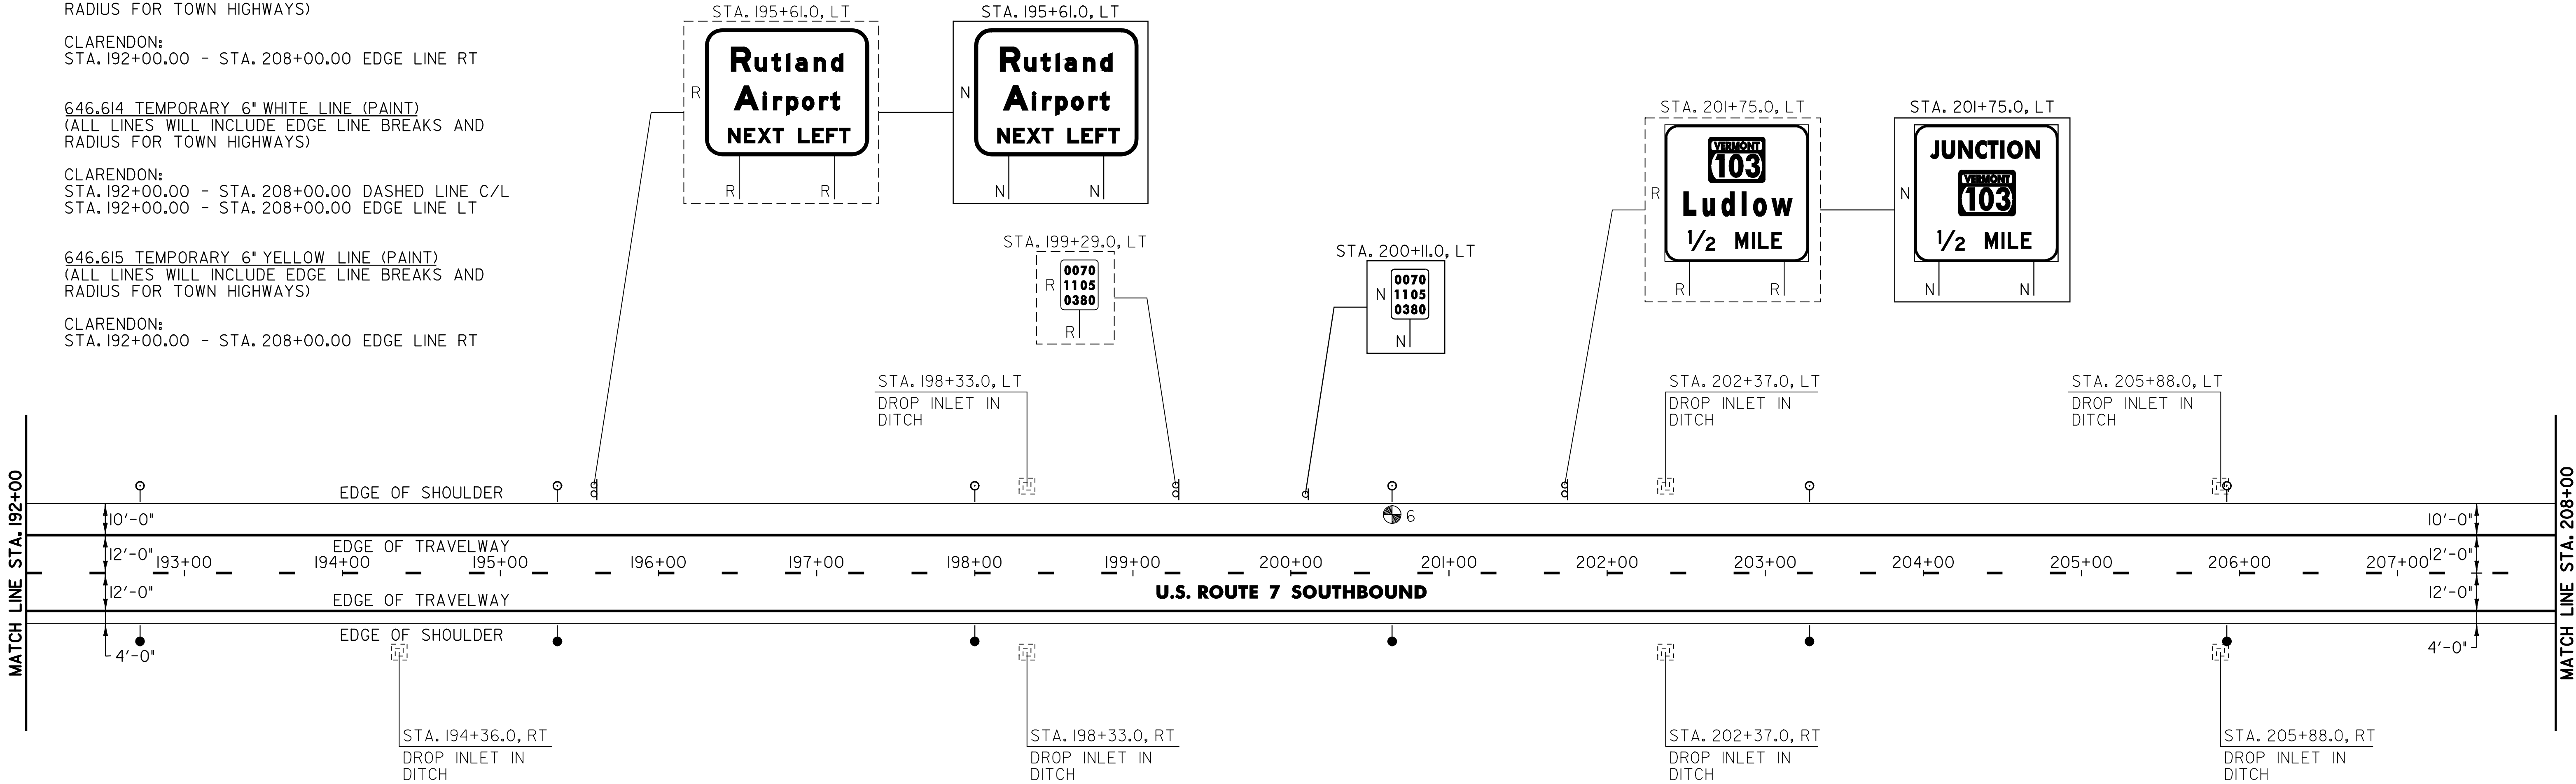
646.614 TEMPORARY 6" WHITE LINE (PAINT)  
(ALL LINES WILL INCLUDE EDGE LINE BREAKS AND  
RADIUS FOR TOWN HIGHWAYS)

CLARENDON:  
STA. 192+00.00 - STA. 208+00.00 DASHED LINE C/L  
STA. 192+00.00 - STA. 208+00.00 EDGE LINE LT

646.615 TEMPORARY 6" YELLOW LINE (PAINT)  
(ALL LINES WILL INCLUDE EDGE LINE BREAKS AND  
RADIUS FOR TOWN HIGHWAYS)

CLARENDON:  
STA. 192+00.00 - STA. 208+00.00 EDGE LINE RT

675.50 REMOVING SIGNS  
AS SHOWN - 3



213.10 MILLED RUMBLE STRIPS

CLARENDON:  
STA. 192+00.0 - STA. 208+00.0 LT (1600 LF)  
STA. 192+00.0 - STA. 208+00.0 RT (1600 LF)

604.412 REHABING DI, CB OR MH, CLASS 1

CLARENDON:  
STA. 194+36.0 RT  
STA. 198+33.0 LT  
STA. 198+33.0 RT  
STA. 202+37.0 LT  
STA. 202+37.0 RT  
STA. 205+88.0 LT  
STA. 205+88.0 RT

676.10 DELINEATORS WITH STEEL POSTS

⦿ TYPE 1 WHITE      ● TYPE 1 AMBER

CLARENDON:  
STA. 192+72.0 LT      STA. 192+72.0 RT  
STA. 195+36.0 LT      STA. 195+36.0 RT  
STA. 198+00.0 LT      STA. 198+00.0 RT  
STA. 200+64.0 LT      STA. 200+64.0 RT  
STA. 203+28.0 LT      STA. 203+28.0 RT  
STA. 205+92.0 LT      STA. 205+92.0 RT

SIGN LEGEND  
R = REMOVE  
S = SALVAGE  
N = NEW  
RET = RETAIN  
B-B = BACK TO BACK  
EXISTING = -----  
NEW = \_\_\_\_\_

PAVEMENT CORES = ●

| No. | TOTAL DEPTH (Inches) | PCC | COMMENTS |
|-----|----------------------|-----|----------|
| 6   | 2.00                 | N0  | -        |

PROJECT LAYOUT SHEET #15

PROJECT NAME: WALLINGFORD - RUTLAND TOWN  
PROJECT NUMBER: NH 2408(1)S

|                                                                                                     |                                                                                 |
|-----------------------------------------------------------------------------------------------------|---------------------------------------------------------------------------------|
| FILE NAME: p04b050.dgn<br>PROJECT LEADER: D.E.G.<br>DESIGNED BY: J.S.P.<br>IPARM FILE: p04b050LI5.1 | PLOT DATE: \$DATE\$<br>DRAWN BY: C.A.K.<br>CHECKED BY: D.E.G.<br>SHEET 27 OF 80 |
|-----------------------------------------------------------------------------------------------------|---------------------------------------------------------------------------------|



646.414 DURABLE 6" WHITE LINE (MOD.) (RETROREFLECTIVITY/INLAID)  
(ALL LINES WILL INCLUDE EDGE LINE BREAKS AND  
RADIUS FOR TOWN HIGHWAYS)

CLARENDON:  
STA. 208+00.00 - STA. 224+00.00 DASHED LINE C/L  
STA. 208+00.00 - STA. 224+00.00 EDGE LINE LT

646.415 DURABLE 6" YELLOW LINE (MOD.) (RETROREFLECTIVITY/INLAID)  
(ALL LINES WILL INCLUDE EDGE LINE BREAKS AND  
RADIUS FOR TOWN HIGHWAYS)

CLARENDON:  
STA. 208+00.00 - STA. 224+00.00 EDGE LINE RT

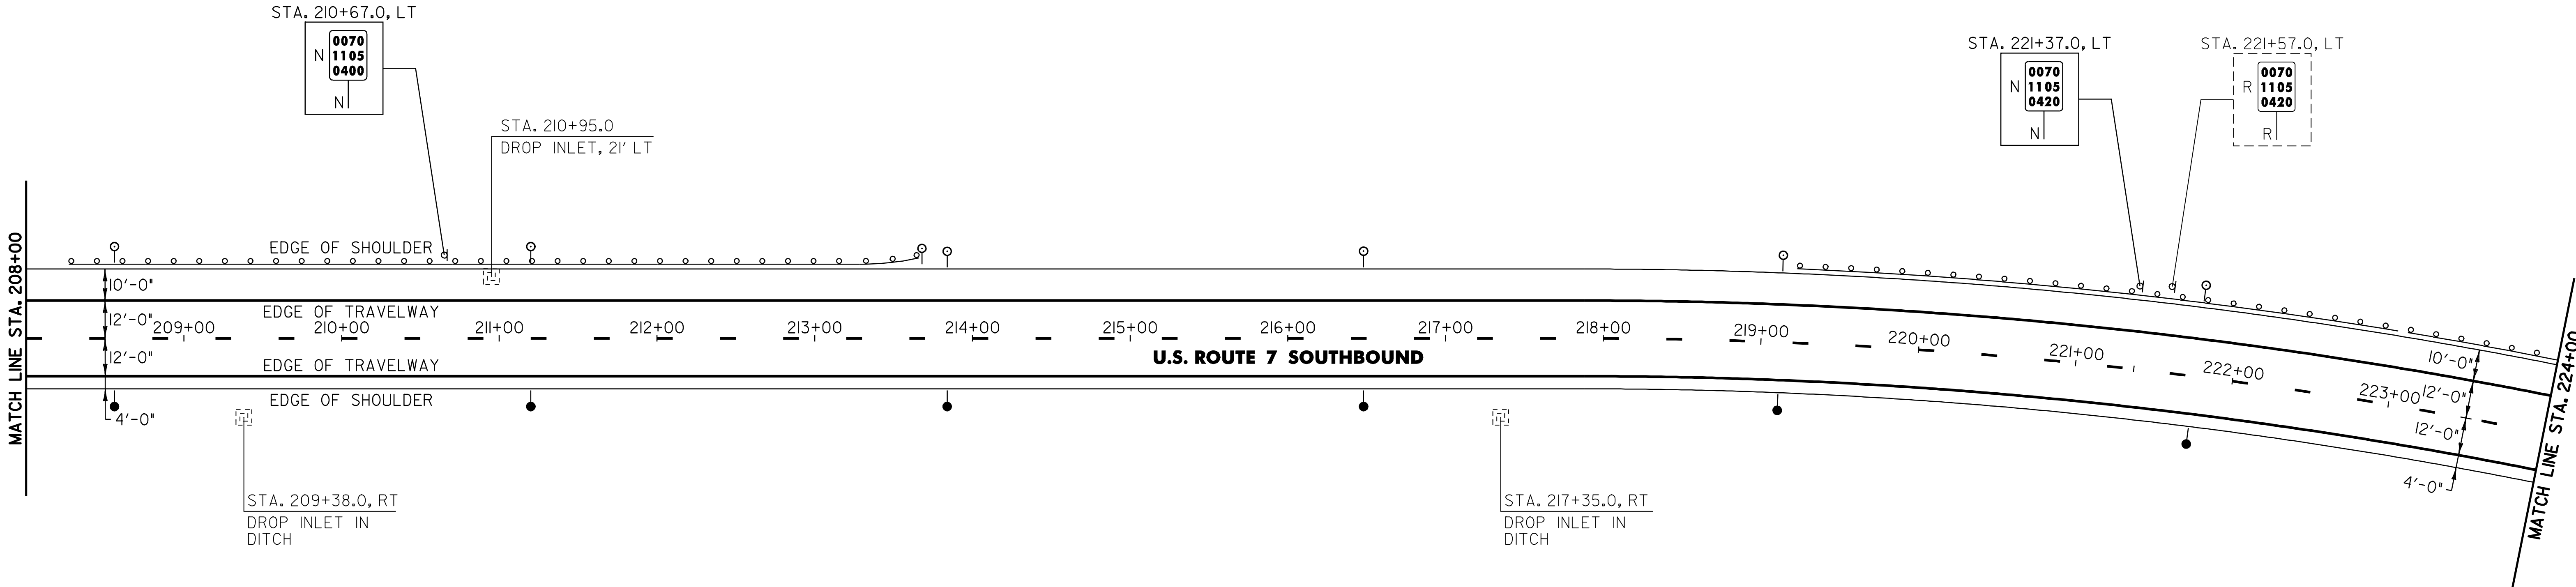
646.614 TEMPORARY 6" WHITE LINE (PAINT)  
(ALL LINES WILL INCLUDE EDGE LINE BREAKS AND  
RADIUS FOR TOWN HIGHWAYS)

CLARENDON:  
STA. 208+00.00 - STA. 224+00.00 DASHED LINE C/L  
STA. 208+00.00 - STA. 224+00.00 EDGE LINE LT

646.615 TEMPORARY 6" YELLOW LINE (PAINT)  
(ALL LINES WILL INCLUDE EDGE LINE BREAKS AND  
RADIUS FOR TOWN HIGHWAYS)

CLARENDON:  
STA. 208+00.00 - STA. 224+00.00 EDGE LINE RT

675.50 REMOVING SIGNS  
AS SHOWN - I



213.10 MILLED RUMBLE STRIPS

CLARENDON:  
STA. 208+00.0 - STA. 224+00.0 LT (1600 LF)  
STA. 208+00.0 - STA. 224+00.0 RT (1600 LF)

604.412 REHABING DI, CB OR MH, CLASS I

CLARENDON:  
STA. 209+38.0 RT  
STA. 210+95.0 LT  
STA. 217+35.0 RT

616.35 TREATED TIMBER CURB

CLARENDON:  
STA. 208+65.0 - STA. 212+65.0 LT (400 LF)

621.20 STEEL BEAM GUARDRAIL (GALVANIZED)

CLARENDON:  
STA. 208+41.0 - STA. 213+41.0 LT (500 LF)  
STA. 219+33.0 - STA. 224+00.0 LT (467 LF)

621.505 MANUFACTURED TERMINAL SECTION (FLARED)

CLARENDON:  
STA. 213+41.0 - STA. 213+78.5 LT

621.52 TRAILING END TERMINAL

CLARENDON:  
STA. 208+27.0 - STA. 208+41.0 LT  
STA. 219+19.0 - STA. 219+33.0 LT

621.80 REMOVAL AND DISPOSAL OF GUARDRAIL

CLARENDON:  
STA. 208+29.0 - STA. 213+68.0 LT (539 LF)  
STA. 219+21.0 - STA. 224+00.0 LT (479 LF)

676.10 DELINEATORS WITH STEEL POSTS

⌋ TYPE I WHITE ⌋ TYPE I AMBER

|                  |                  |  |
|------------------|------------------|--|
| CLARENDON:       |                  |  |
| STA. 208+56.0 LT | STA. 208+56.0 RT |  |
| STA. 211+20.0 LT | STA. 211+20.0 RT |  |
| STA. 213+78.5 LT | STA. 213+84.0 RT |  |
| STA. 213+84.0 LT | STA. 216+48.0 RT |  |
| STA. 216+48.0 LT | STA. 219+12.0 RT |  |
| STA. 219+12.0 LT | STA. 221+96.0 RT |  |
| STA. 221+96.0 LT |                  |  |

SIGN LEGEND  
R = REMOVE  
S = SALVAGE  
N = NEW  
RET = RETAIN  
B-B = BACK TO BACK  
EXISTING = -----  
NEW = -----

PROJECT  
LAYOUT  
SHEET #16

PROJECT NAME: WALLINGFORD - RUTLAND TOWN  
PROJECT NUMBER: NH 2408(1)S

|                          |                     |
|--------------------------|---------------------|
| FILE NAME: p04b050.dgn   | PLOT DATE: \$DATE\$ |
| PROJECT LEADER: D.E.G.   | DRAWN BY: C.A.K.    |
| DESIGNED BY: J.S.P.      | CHECKED BY: D.E.G.  |
| IPARM FILE: p04b050LI6.1 | SHEET 28 OF 80      |



646.414 DURABLE 6" WHITE LINE (MOD.) (RETROREFLECTIVITY/INLAID)  
(ALL LINES WILL INCLUDE EDGE LINE BREAKS AND  
RADIUS FOR TOWN HIGHWAYS)

CLARENDON:  
STA. 224+00.00 - STA. 240+00.00 DASHED LINE C/L  
STA. 224+00.00 - STA. 240+00.00 EDGE LINE LT

646.415 DURABLE 6" YELLOW LINE (MOD.) (RETROREFLECTIVITY/INLAID)  
(ALL LINES WILL INCLUDE EDGE LINE BREAKS AND  
RADIUS FOR TOWN HIGHWAYS)

CLARENDON:  
STA. 224+00.00 - STA. 240+00.00 EDGE LINE RT

646.614 TEMPORARY 6" WHITE LINE (PAINT)  
(ALL LINES WILL INCLUDE EDGE LINE BREAKS AND  
RADIUS FOR TOWN HIGHWAYS)

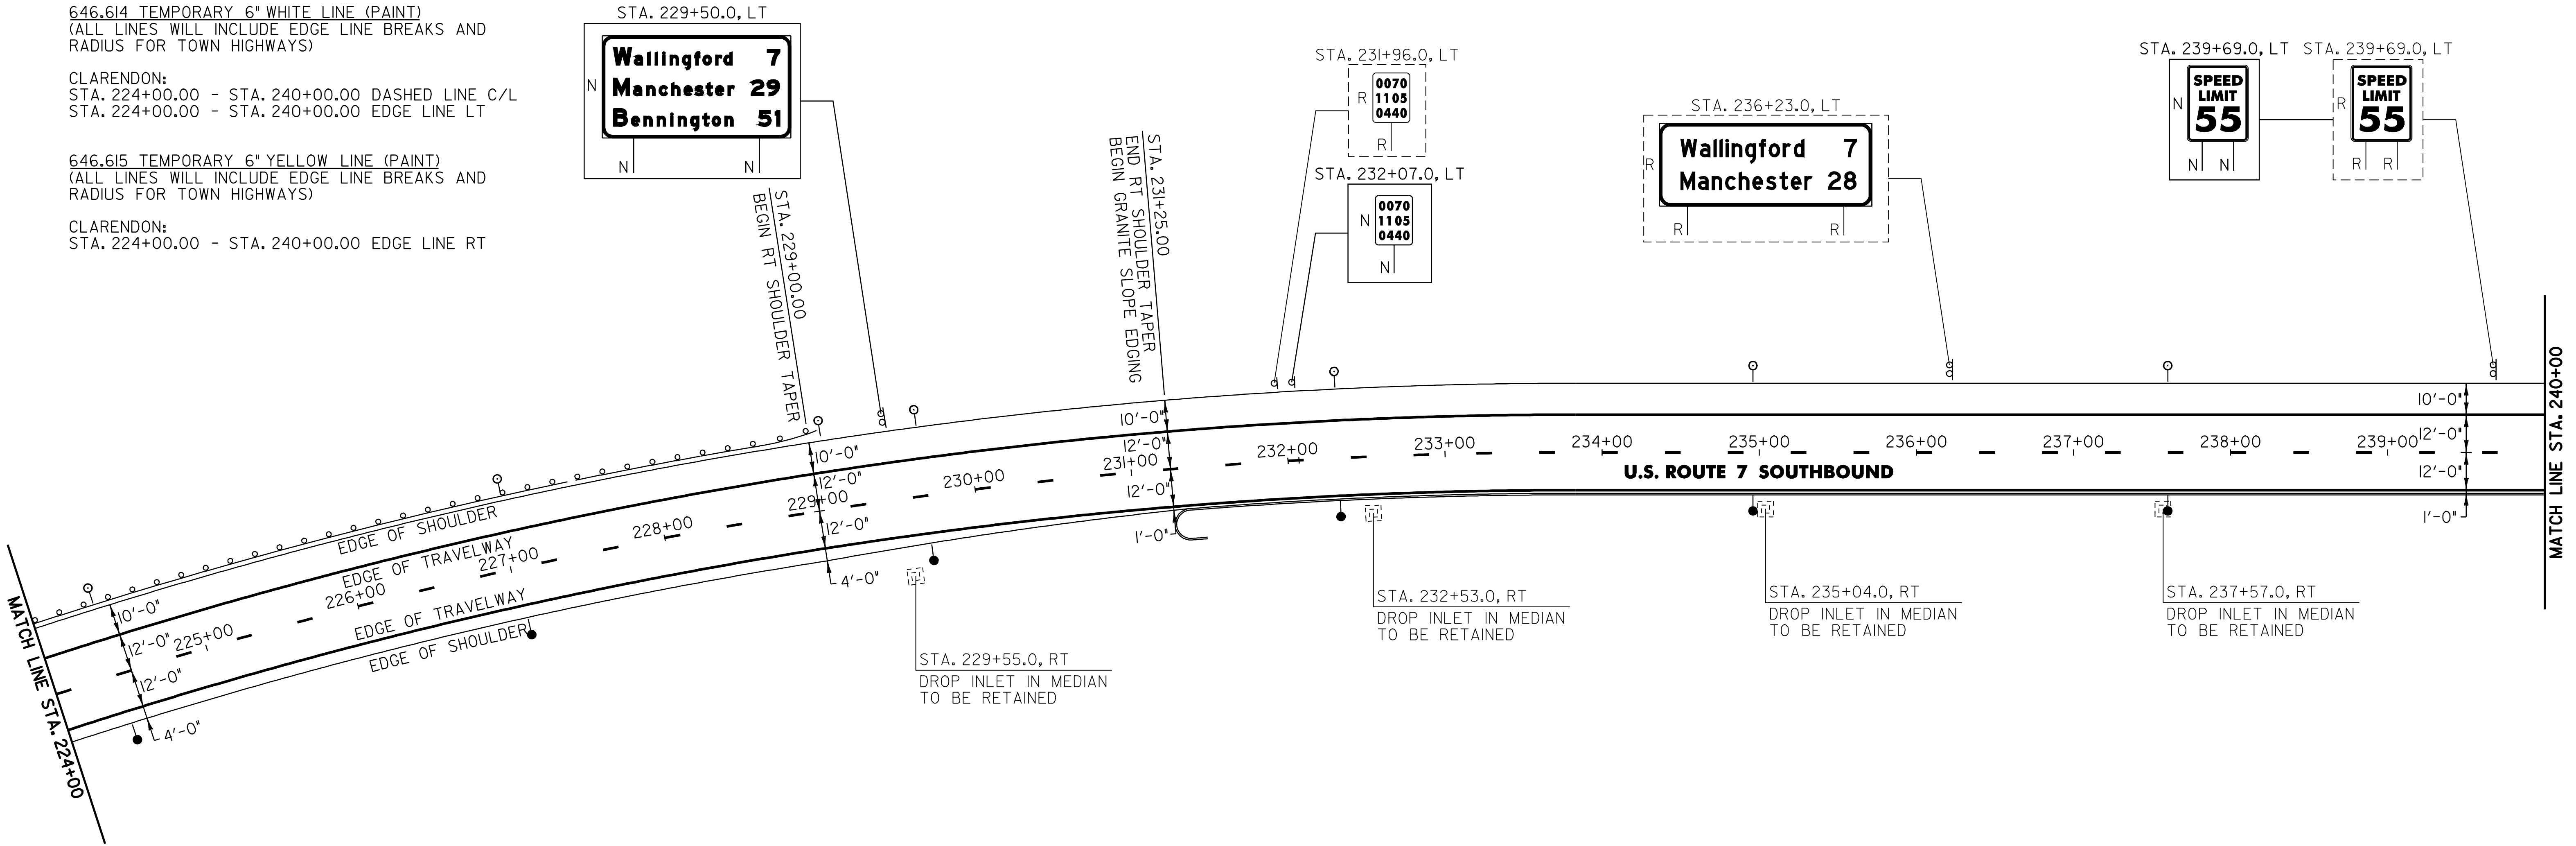
CLARENDON:  
STA. 224+00.00 - STA. 240+00.00 DASHED LINE C/L  
STA. 224+00.00 - STA. 240+00.00 EDGE LINE LT

646.615 TEMPORARY 6" YELLOW LINE (PAINT)  
(ALL LINES WILL INCLUDE EDGE LINE BREAKS AND  
RADIUS FOR TOWN HIGHWAYS)

CLARENDON:  
STA. 224+00.00 - STA. 240+00.00 EDGE LINE RT

646.81 PAINTED CURB  
CLARENDON:  
STA. 231+25.00 - STA. 240+00.00 RT (875 LF)

675.50 REMOVING SIGNS  
AS SHOWN - 3



213.10 MILLED RUMBLE STRIPS

CLARENDON:  
STA. 224+00.0 - STA. 240+00.0 LT (1600 LF)  
STA. 224+00.0 - STA. 229+00.0 RT (500 LF)

621.20 STEEL BEAM GUARDRAIL (GALVANIZED)

CLARENDON:  
STA. 224+00.0 - STA. 228+70.5 LT (470.5 LF)

621.505 MANUFACTURED TERMINAL SECTION (FLARED)

CLARENDON:  
STA. 228+70.5 - STA. 229+08.0 LT

621.80 REMOVAL AND DISPOSAL OF GUARDRAIL

CLARENDON:  
STA. 224+00.0 - STA. 228+96.0 LT (496 LF)

676.10 DELINEATORS WITH STEEL POSTS

⌚ TYPE 1 WHITE      ● TYPE 1 AMBER

|                  |                  |
|------------------|------------------|
| CLARENDON:       |                  |
| STA. 224+40.0 LT | STA. 224+40.0 RT |
| STA. 227+04.0 LT | STA. 227+04.0 RT |
| STA. 229+08.0 LT | STA. 229+68.0 RT |
| STA. 229+68.0 LT | STA. 232+32.0 RT |
| STA. 232+32.0 LT | STA. 234+96.0 RT |
| STA. 234+96.0 LT | STA. 237+60.0 RT |
| STA. 237+60.0 LT |                  |

SIGN LEGEND  
R = REMOVE  
S = SALVAGE  
N = NEW  
RET = RETAIN  
B-B = BACK TO BACK  
EXISTING = -----  
NEW = -----

PROJECT  
LAYOUT  
SHEET #17

PROJECT NAME: WALLINGFORD - RUTLAND TOWN  
PROJECT NUMBER: NH 2408(1)S

|                          |                     |
|--------------------------|---------------------|
| FILE NAME: p04b050.dgn   | PLOT DATE: \$DATE\$ |
| PROJECT LEADER: D.E.G.   | DRAWN BY: C.A.K.    |
| DESIGNED BY: J.S.P.      | CHECKED BY: D.E.G.  |
| IPARM FILE: p04b050LI7.1 | SHEET 29 OF 80      |



646.414 DURABLE 6" WHITE LINE (MOD.) (RETROREFLECTIVITY/INLAID)  
(ALL LINES WILL INCLUDE EDGE LINE BREAKS AND  
RADIUS FOR TOWN HIGHWAYS)

CLARENDON:  
STA. 240+00.00 - STA. 256+00.00 DASHED LINE C/L  
STA. 240+00.00 - STA. 256+00.00 EDGE LINE LT  
STA. 251+65.00 - STA. 254+25.00 SOLID LANE LINE RT  
STA. 254+25.00 - STA. 256+00.00 DOTTED LANE LINE RT

646.415 DURABLE 6" YELLOW LINE (MOD.) (RETROREFLECTIVITY/INLAID)  
(ALL LINES WILL INCLUDE EDGE LINE BREAKS AND  
RADIUS FOR TOWN HIGHWAYS)

CLARENDON:  
STA. 240+00.00 - STA. 256+00.00 EDGE LINE RT

646.40 DURABLE 4" WHITE LINE (MOD.) (RETROREFLECTIVITY/INLAID)

CLARENDON:  
STA. 251+27.52 EDGE LINE LT, VT. ROUTE 7B

646.41 DURABLE 4" YELLOW LINE (MOD.) (RETROREFLECTIVITY/INLAID)

CLARENDON:  
STA. 251+27.52 DOUBLE SOLID LT, VT. ROUTE 7B

646.614 TEMPORARY 6" WHITE LINE (PAINT)  
(ALL LINES WILL INCLUDE EDGE LINE BREAKS AND  
RADIUS FOR TOWN HIGHWAYS)

CLARENDON:  
STA. 240+00.00 - STA. 256+00.00 DASHED LINE C/L  
STA. 240+00.00 - STA. 256+00.00 EDGE LINE LT  
STA. 251+65.00 - STA. 254+25.00 SOLID LANE LINE RT  
STA. 254+25.00 - STA. 256+00.00 DOTTED LANE LINE RT

646.615 TEMPORARY 6" YELLOW LINE (PAINT)  
(ALL LINES WILL INCLUDE EDGE LINE BREAKS AND  
RADIUS FOR TOWN HIGHWAYS)

CLARENDON:  
STA. 240+00.00 - STA. 256+00.00 EDGE LINE RT

646.60 TEMPORARY 4" WHITE LINE (PAINT)

CLARENDON:  
STA. 251+27.52 EDGE LINE LT, VT. ROUTE 7B

646.61 TEMPORARY 4" YELLOW LINE (PAINT)

CLARENDON:  
STA. 251+27.52 DOUBLE SOLID LT, VT. ROUTE 7B

646.46 DURABLE 24" STOP BAR (THERMOPLASTIC)

CLARENDON:  
STA. 251+27.52 LT, VT. ROUTE 7B

646.66 TEMPORARY 24" STOP BAR (PAINT)

CLARENDON:  
STA. 251+27.52 LT, VT. ROUTE 7B

646.50 DURABLE LETTER OR SYMBOL (THERMOPLASTIC)

CLARENDON:  
STA. 251+27.52 LT, VT. ROUTE 7B, "S,T,O,P" (4 EA)  
STA. 251+79.3 RT, ARROW (1EA)  
STA. 252+27.6 RT, "O,N,L,Y" (4 EA)  
STA. 252+75.9 RT, ARROW (1EA)  
STA. 253+24.2 RT, "O,N,L,Y" (4 EA)  
STA. ~~253+72.5 RT~~, ARROW (1EA) **253+50 RT**  
STA. 254+20.8 RT, "O,N,L,Y" (4 EA)

646.70 TEMPORARY LETTER OR SYMBOL (PAINT)

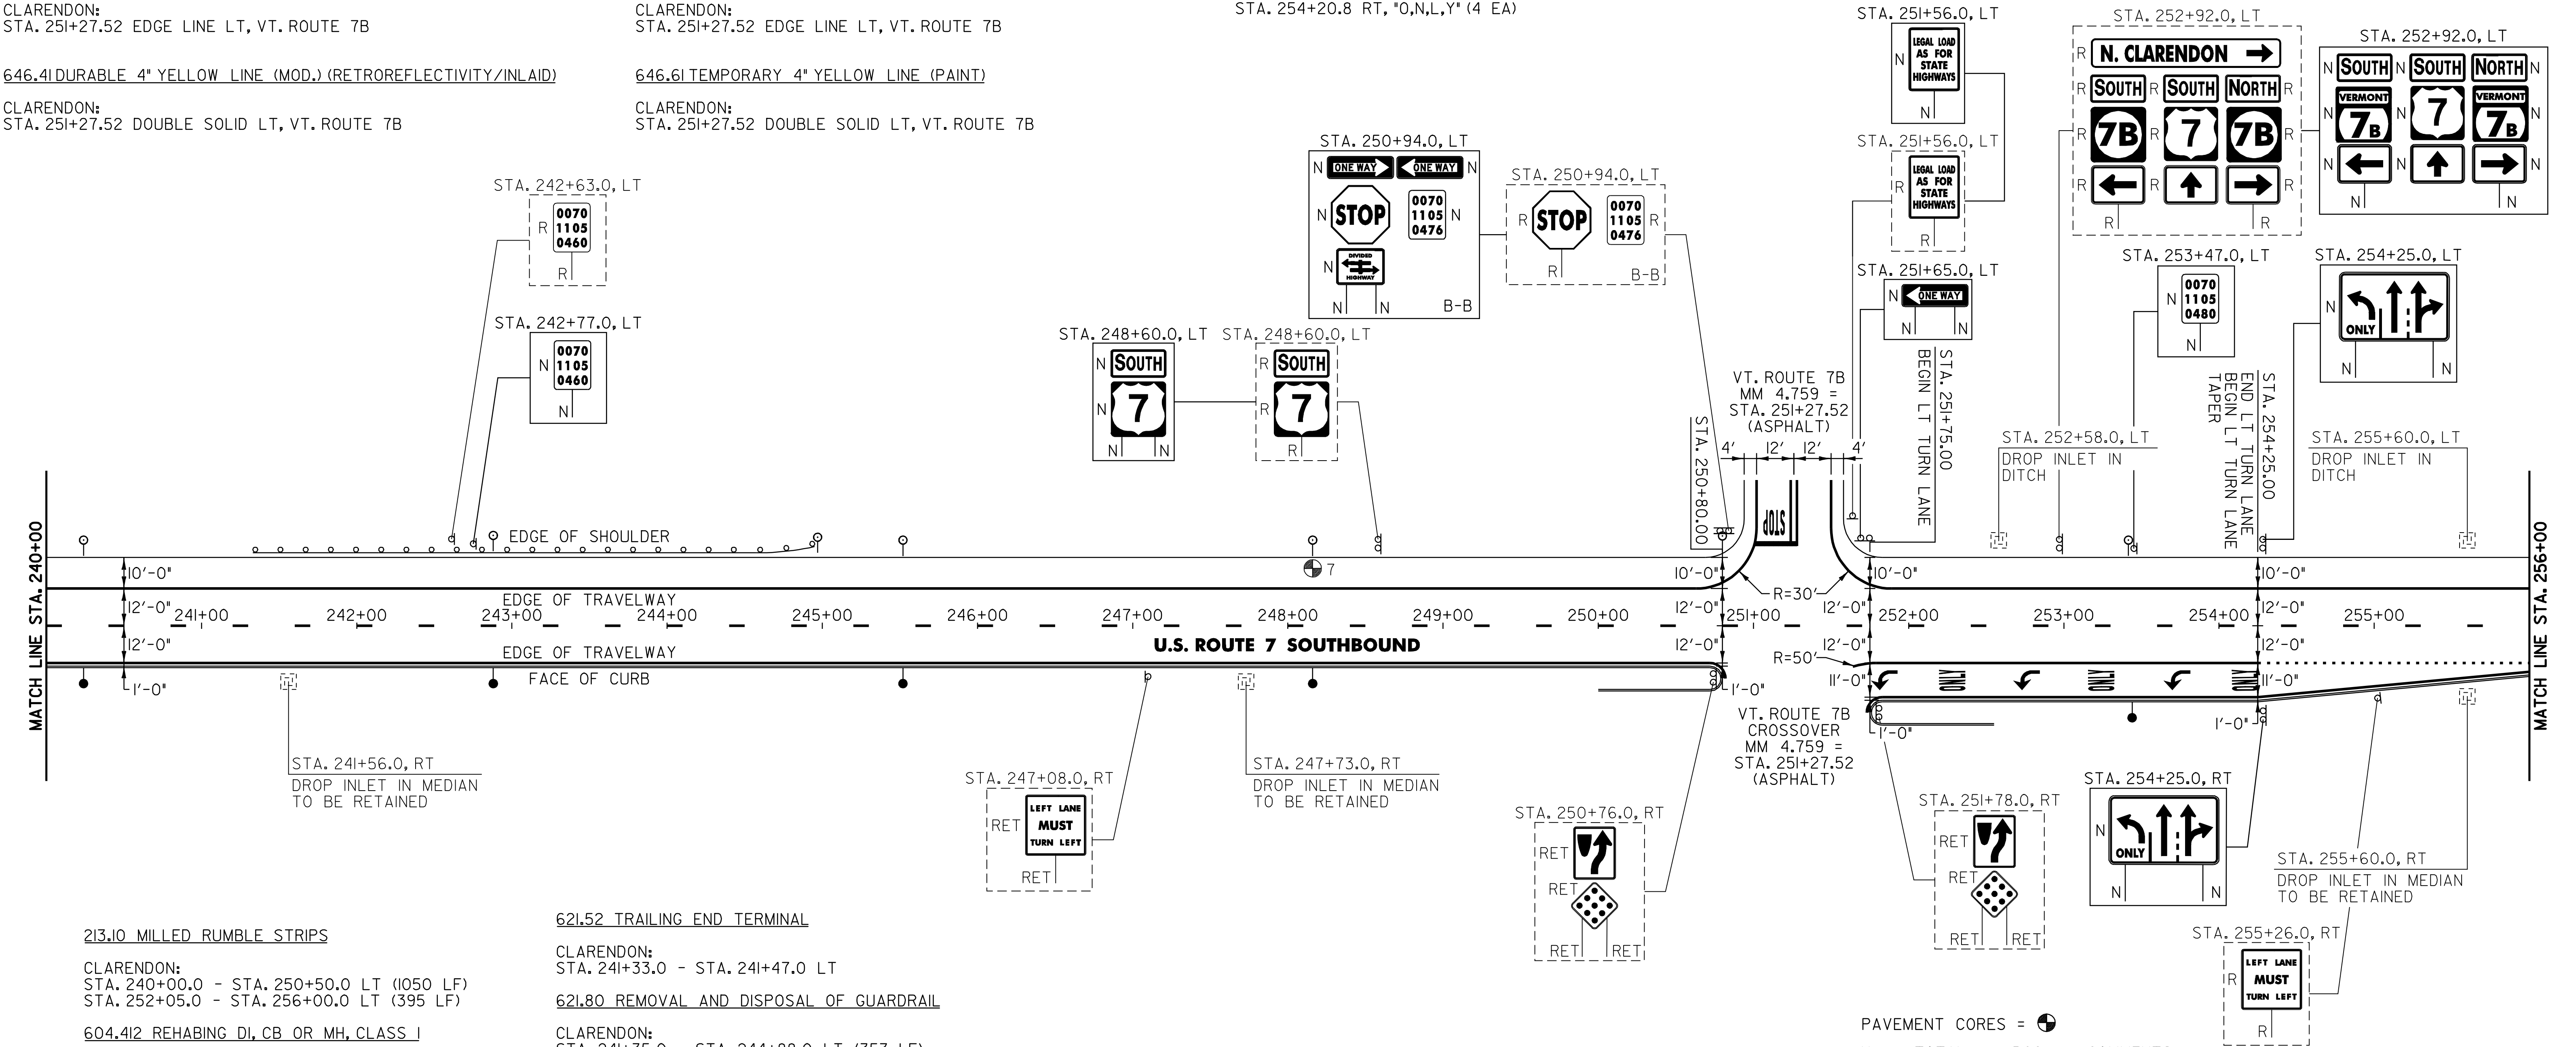
CLARENDON:  
STA. 251+27.52 LT, VT. ROUTE 7B, "S,T,O,P" (8 EA)  
STA. 251+79.3 RT, ARROW (2 EA)  
STA. 253+72.5 RT, ARROW (2 EA)

646.81 PAINTED CURB

CLARENDON:  
STA. 240+00.0 - STA. 250+80.0 RT (1080 LF)  
STA. 251+75.0 - STA. 256+00.0 RT (425 LF)

675.50 REMOVING SIGNS

AS SHOWN - 17



213.10 MILLED RUMBLE STRIPS

CLARENDON:  
STA. 240+00.0 - STA. 250+50.0 LT (1050 LF)  
STA. 252+05.0 - STA. 256+00.0 LT (395 LF)

604.412 REHABING DI, CB OR MH, CLASS I

CLARENDON:  
STA. 252+58.0 LT  
STA. 255+60.0 LT

621.20 STEEL BEAM GUARDRAIL (GALVANIZED)

CLARENDON:  
STA. 241+47.0 - STA. 244+59.5 LT (312.5 LF)

621.505 MANUFACTURED TERMINAL SECTION (FLARED)

CLARENDON:  
STA. 244+59.5 - STA. 244+97.0 LT

621.52 TRAILING END TERMINAL

CLARENDON:  
STA. 241+33.0 - STA. 241+47.0 LT

621.80 REMOVAL AND DISPOSAL OF GUARDRAIL

CLARENDON:  
STA. 241+35.0 - STA. 244+88.0 LT (353 LF)

676.10 DELINEATORS WITH STEEL POSTS

♀ TYPE I WHITE      ♂ TYPE I AMBER

CLARENDON:  
STA. 240+24.0 LT      STA. 240+24.0 RT  
STA. 242+88.0 LT      STA. 242+88.0 RT  
STA. 244+97.0 LT      STA. 245+52.0 RT  
STA. 245+52.0 LT      STA. 248+16.0 RT  
STA. 248+16.0 LT      STA. 253+44.0 RT  
STA. 250+80.0 LT  
STA. 253+44.0 LT

NOTE:

1. PAVING LIMIT ON ALL TOWN AND STATE HIGHWAYS SHALL BE MEASURED 25 FT BACK FROM U.S. ROUTE 7 EDGE OF SHOULDER UNLESS DENOTED OTHERWISE ON THE PLANS OR AS DIRECTED BY THE RESIDENT ENGINEER.

SIGN LEGEND

R = REMOVE  
S = SALVAGE  
N = NEW  
RET = RETAIN  
B-B = BACK TO BACK  
EXISTING = -----  
NEW = \_\_\_\_\_

|                  |                      |     |          |
|------------------|----------------------|-----|----------|
| PAVEMENT CORES = |                      |     |          |
| No.              | TOTAL DEPTH (inches) | PCC | COMMENTS |
| 7                | 1,875                | NO  | -        |

PROJECT  
LAYOUT  
SHEET #18

|                                          |                     |
|------------------------------------------|---------------------|
| PROJECT NAME: WALLINGFORD - RUTLAND TOWN |                     |
| PROJECT NUMBER: NH 2408(1)S              |                     |
| FILE NAME: p04b050.dgn                   | PLOT DATE: \$DATE\$ |
| PROJECT LEADER: D.E.G.                   | DRAWN BY: C.A.K.    |
| DESIGNED BY: J.S.P.                      | CHECKED BY: D.E.G.  |
| IPARM FILE: p04b050L18.1                 | SHEET 30 OF 80      |



646.414 DURABLE 6" WHITE LINE (MOD.) (RETROREFLECTIVITY/INLAID)  
(ALL LINES WILL INCLUDE EDGE LINE BREAKS AND  
RADIUS FOR TOWN HIGHWAYS)

CLARENDON:  
STA. 256+00.00 - STA. 272+00.00 DASHED LINE C/L  
STA. 256+00.00 - STA. 272+00.00 EDGE LINE LT  
STA. 256+00.00 - STA. 256+60.00 DOTTED LANE LINE RT

646.415 DURABLE 6" YELLOW LINE (MOD.) (RETROREFLECTIVITY/INLAID)  
(ALL LINES WILL INCLUDE EDGE LINE BREAKS AND  
RADIUS FOR TOWN HIGHWAYS)

CLARENDON:  
STA. 256+00.00 - STA. 272+00.00 EDGE LINE RT

646.614 TEMPORARY 6" WHITE LINE (PAINT)  
(ALL LINES WILL INCLUDE EDGE LINE BREAKS AND  
RADIUS FOR TOWN HIGHWAYS)

CLARENDON:  
STA. 256+00.00 - STA. 272+00.00 DASHED LINE C/L  
STA. 256+00.00 - STA. 272+00.00 EDGE LINE LT  
STA. 256+00.00 - STA. 256+60.00 DOTTED LANE LINE RT

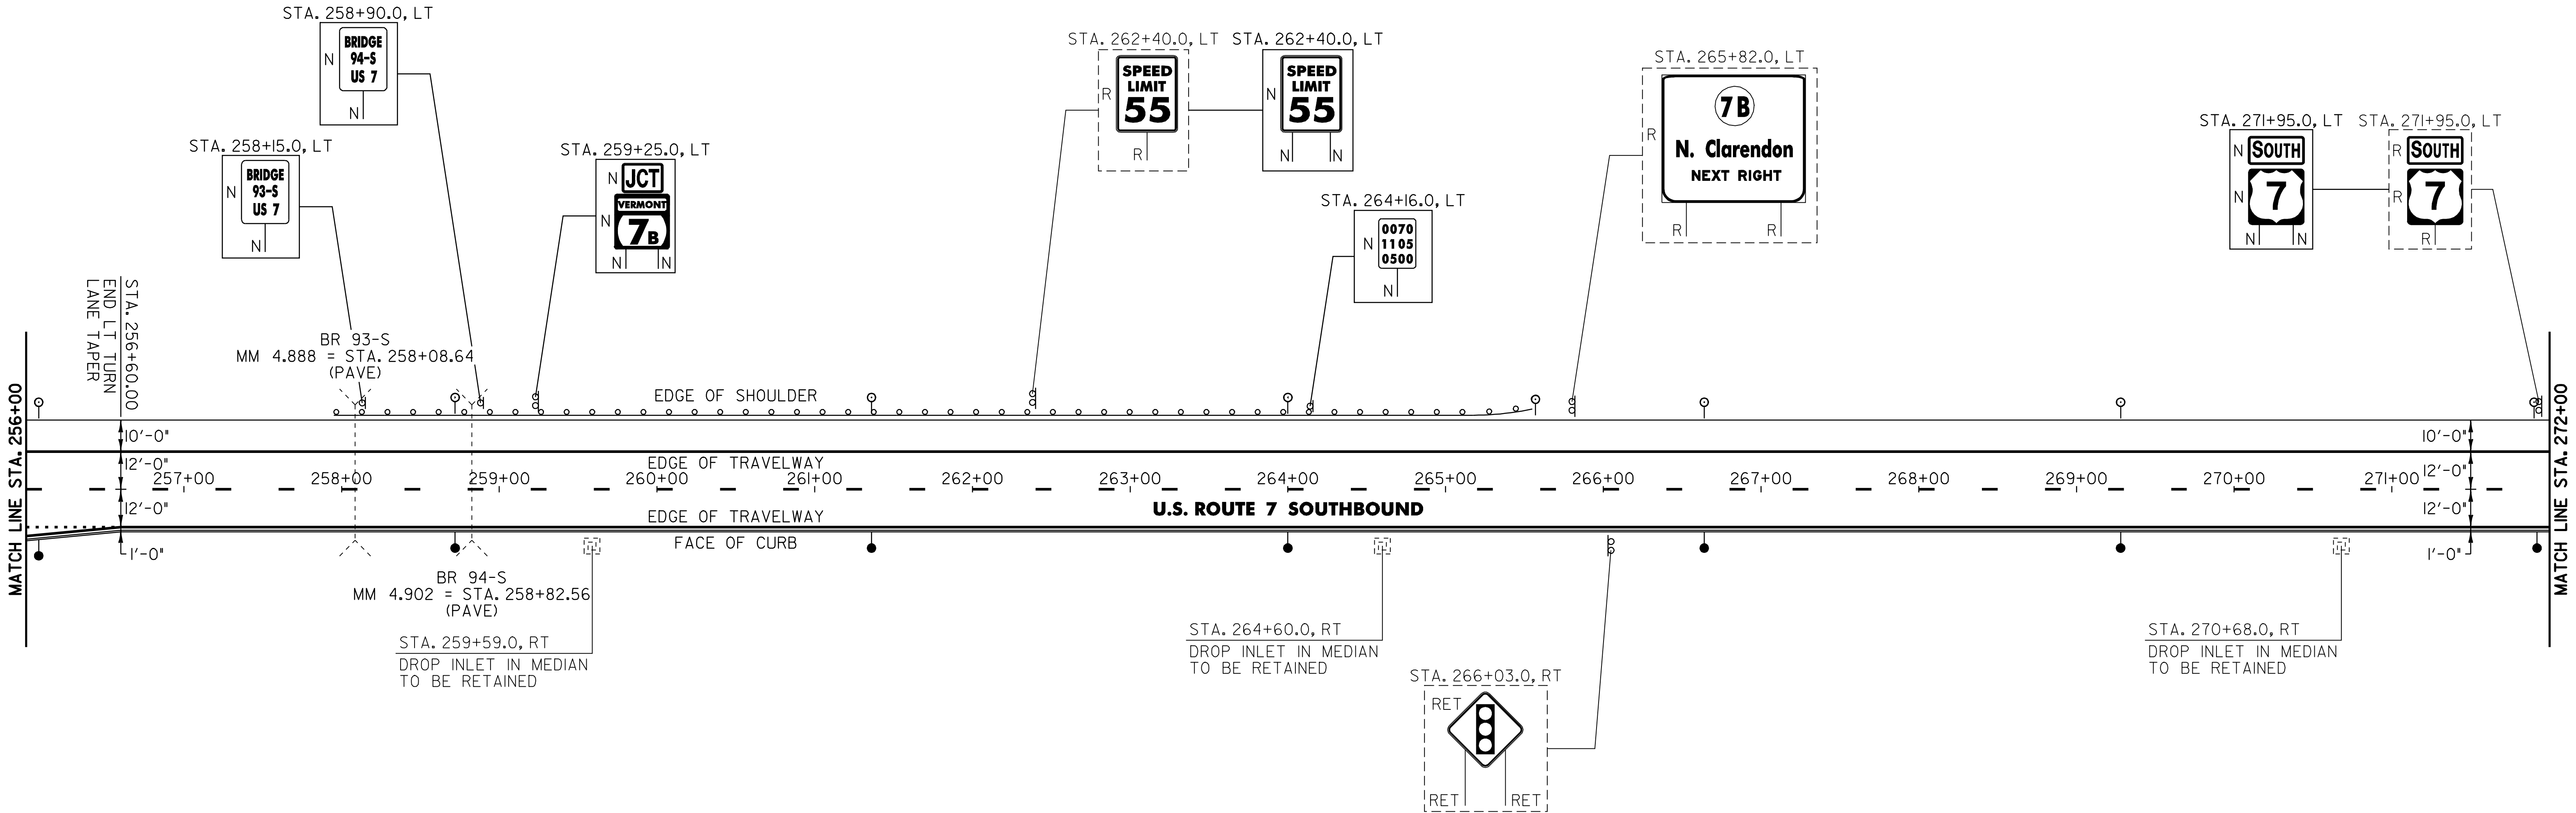
646.615 TEMPORARY 6" YELLOW LINE (PAINT)  
(ALL LINES WILL INCLUDE EDGE LINE BREAKS AND  
RADIUS FOR TOWN HIGHWAYS)

CLARENDON:  
STA. 256+00.00 - STA. 272+00.00 EDGE LINE RT

646.81 PAINTED CURB

CLARENDON:  
STA. 256+00.0 - STA. 272+00.0 RT (1600 LF)

675.50 REMOVING SIGNS  
AS SHOWN - 4



213.10 MILLED RUMBLE STRIPS

CLARENDON:  
STA. 256+00.0 - STA. 272+00.0 LT (1600 LF)

621.20 STEEL BEAM GUARDRAIL WITH 8' POSTS (MOD.) (GALVANIZED)

CLARENDON: 257+96  
STA. ~~258+09.0~~ - STA. 265+21.5 LT (712.5 LF) 725 LF

621.505 MANUFACTURED TERMINAL SECTION (FLARED)

CLARENDON:  
STA. 265+21.5 - STA. 265+59.0 LT

621.52 TRAILING END TERMINAL

CLARENDON:  
STA. ~~257+95.0~~ - STA. ~~258+09.0~~ LT 257+82 - STA. 257+96 LT

621.80 REMOVAL AND DISPOSAL OF GUARDRAIL

CLARENDON:  
STA. 257+97.0 - STA. 265+51.0 LT (754 LF)

676.10 DELINEATORS WITH STEEL POSTS

♀ TYPE 1 WHITE      ♀ TYPE 1 AMBER

CLARENDON:  
STA. 256+08.0 LT      STA. 256+08.0 RT  
STA. 258+72.0 LT      STA. 258+72.0 RT  
STA. 261+36.0 LT      STA. 261+36.0 RT  
STA. 264+00.0 LT      STA. 264+00.0 RT  
STA. 265+59.0 LT      STA. 266+64.0 RT  
STA. 266+64.0 LT      STA. 269+28.0 RT  
STA. 269+28.0 LT      STA. 271+92.0 RT  
STA. 271+92.0 LT

SIGN LEGEND  
R = REMOVE  
S = SALVAGE  
N = NEW  
RET = RETAIN  
B-B = BACK TO BACK  
EXISTING = -----  
NEW = -----

|                          |                                                                                                     |                                                                                 |
|--------------------------|-----------------------------------------------------------------------------------------------------|---------------------------------------------------------------------------------|
| PROJECT LAYOUT SHEET #19 | PROJECT NAME: WALLINGFORD - RUTLAND TOWN                                                            |                                                                                 |
|                          | PROJECT NUMBER: NH 2408(1)S                                                                         |                                                                                 |
|                          | FILE NAME: p04b050.dgn<br>PROJECT LEADER: D.E.G.<br>DESIGNED BY: J.S.P.<br>IPARM FILE: p04b050LI9.1 | PLOT DATE: \$DATE\$<br>DRAWN BY: C.A.K.<br>CHECKED BY: D.E.G.<br>SHEET 31 OF 80 |



646.414 DURABLE 6" WHITE LINE (MOD.) (RETROREFLECTIVITY/INLAID)  
(ALL LINES WILL INCLUDE EDGE LINE BREAKS AND  
RADIUS FOR TOWN HIGHWAYS)

CLARENDON:  
STA. 272+00.00 - STA. 288+25.00 DASHED LINE C/L  
STA. 272+00.00 - STA. 288+25.00 EDGE LINE LT  
STA. 274+65.00 - STA. 277+00.00 SOLID LANE LINE LT  
STA. 274+65.00 - STA. 276+65.00 SOLID LANE LINE RT  
STA. 276+65.00 - STA. 278+20.00 DOTTED LANE LINE RT  
STA. 277+00.00 - STA. 279+00.00 DOTTED LANE LINE LT

646.415 DURABLE 6" YELLOW LINE (MOD.) (RETROREFLECTIVITY/INLAID)  
(ALL LINES WILL INCLUDE EDGE LINE BREAKS AND  
RADIUS FOR TOWN HIGHWAYS)

CLARENDON:  
STA. 272+00.00 - STA. 288+25.00 EDGE LINE RT STA. 273+62.0, LT STA. 273+62.0, LT

646.40 DURABLE 4" WHITE LINE (MOD.) (RETROREFLECTIVITY/INLAID)

CLARENDON:  
STA. 273+97.92 EDGE LINE LT, T-4

646.41 DURABLE 4" YELLOW LINE (MOD.) (RETROREFLECTIVITY/INLAID)

CLARENDON:  
STA. 273+97.92 DOUBLE SOLID LT, T-4

646.614 TEMPORARY 6" WHITE LINE (PAINT)  
(ALL LINES WILL INCLUDE EDGE LINE BREAKS AND  
RADIUS FOR TOWN HIGHWAYS)

CLARENDON:  
STA. 272+00.00 - STA. 288+25.00 DASHED LINE C/L  
STA. 272+00.00 - STA. 288+25.00 EDGE LINE LT  
STA. 274+65.00 - STA. 277+00.00 SOLID LANE LINE LT  
STA. 274+65.00 - STA. 276+65.00 SOLID LANE LINE RT  
STA. 276+65.00 - STA. 278+20.00 DOTTED LANE LINE RT  
STA. 277+00.00 - STA. 279+00.00 DOTTED LANE LINE LT

646.615 TEMPORARY 6" YELLOW LINE (PAINT)  
(ALL LINES WILL INCLUDE EDGE LINE BREAKS AND  
RADIUS FOR TOWN HIGHWAYS)

CLARENDON:  
STA. 272+00.00 - STA. 288+25.00 EDGE LINE RT

646.60 TEMPORARY 4" WHITE LINE (PAINT)

CLARENDON:  
STA. 273+97.92 EDGE LINE LT, T-4

646.61 TEMPORARY 4" YELLOW LINE (PAINT)

CLARENDON:  
STA. 273+97.92 DOUBLE SOLID LT, T-4

646.616 DURABLE 24" STOP BAR (THERMOPLASTIC)

CLARENDON:  
STA. 273+97.92 LT, T-4  
STA. 274+65.00 LT/RT

646.66 TEMPORARY 24" STOP BAR (PAINT)

CLARENDON:  
STA. 273+97.92 LT, T-4  
STA. 274+65.00 LT/RT

646.50 DURABLE LETTER OR SYMBOL (THERMOPLASTIC)

CLARENDON:  
STA. 274+74.3 LT, ARROW (1 EA)  
STA. ~~274+74.3~~ RT, ARROW (1 EA) **274+64 RT**  
STA. ~~275+18.6~~ LT, "O,N,L,Y" (4 EA) **275+44 LT**  
STA. ~~275+36.5~~ RT, "O,N,L,Y" (4 EA) **274+08 RT**  
STA. 275+62.9 LT, ARROW (1 EA)  
STA. 275+98.7 RT, ARROW (1 EA)  
STA. ~~276+07.2~~ LT, "O,N,L,Y" (4 EA) **276+17 LT**  
STA. 276+51.5 LT, ARROW (1 EA)  
STA. 276+60.8 RT, "O,N,L,Y" (4 EA)  
STA. 276+95.8 LT, "O,N,L,Y" (4 EA)  
STA. ~~281+65.8~~ LT, "A,H,E,A,D" (5 EA) **281+77 LT**  
STA. ~~281+65.8~~ RT, "A,H,E,A,D" (5 EA) **281+77 RT**  
STA. ~~282+06.2~~ LT, "S,I,G,N,A,L" (6 EA) **282+17 LT**  
STA. ~~282+06.2~~ RT, "S,I,G,N,A,L" (6 EA) **282+17 RT**

646.70 TEMPORARY LETTER OR SYMBOL (PAINT)

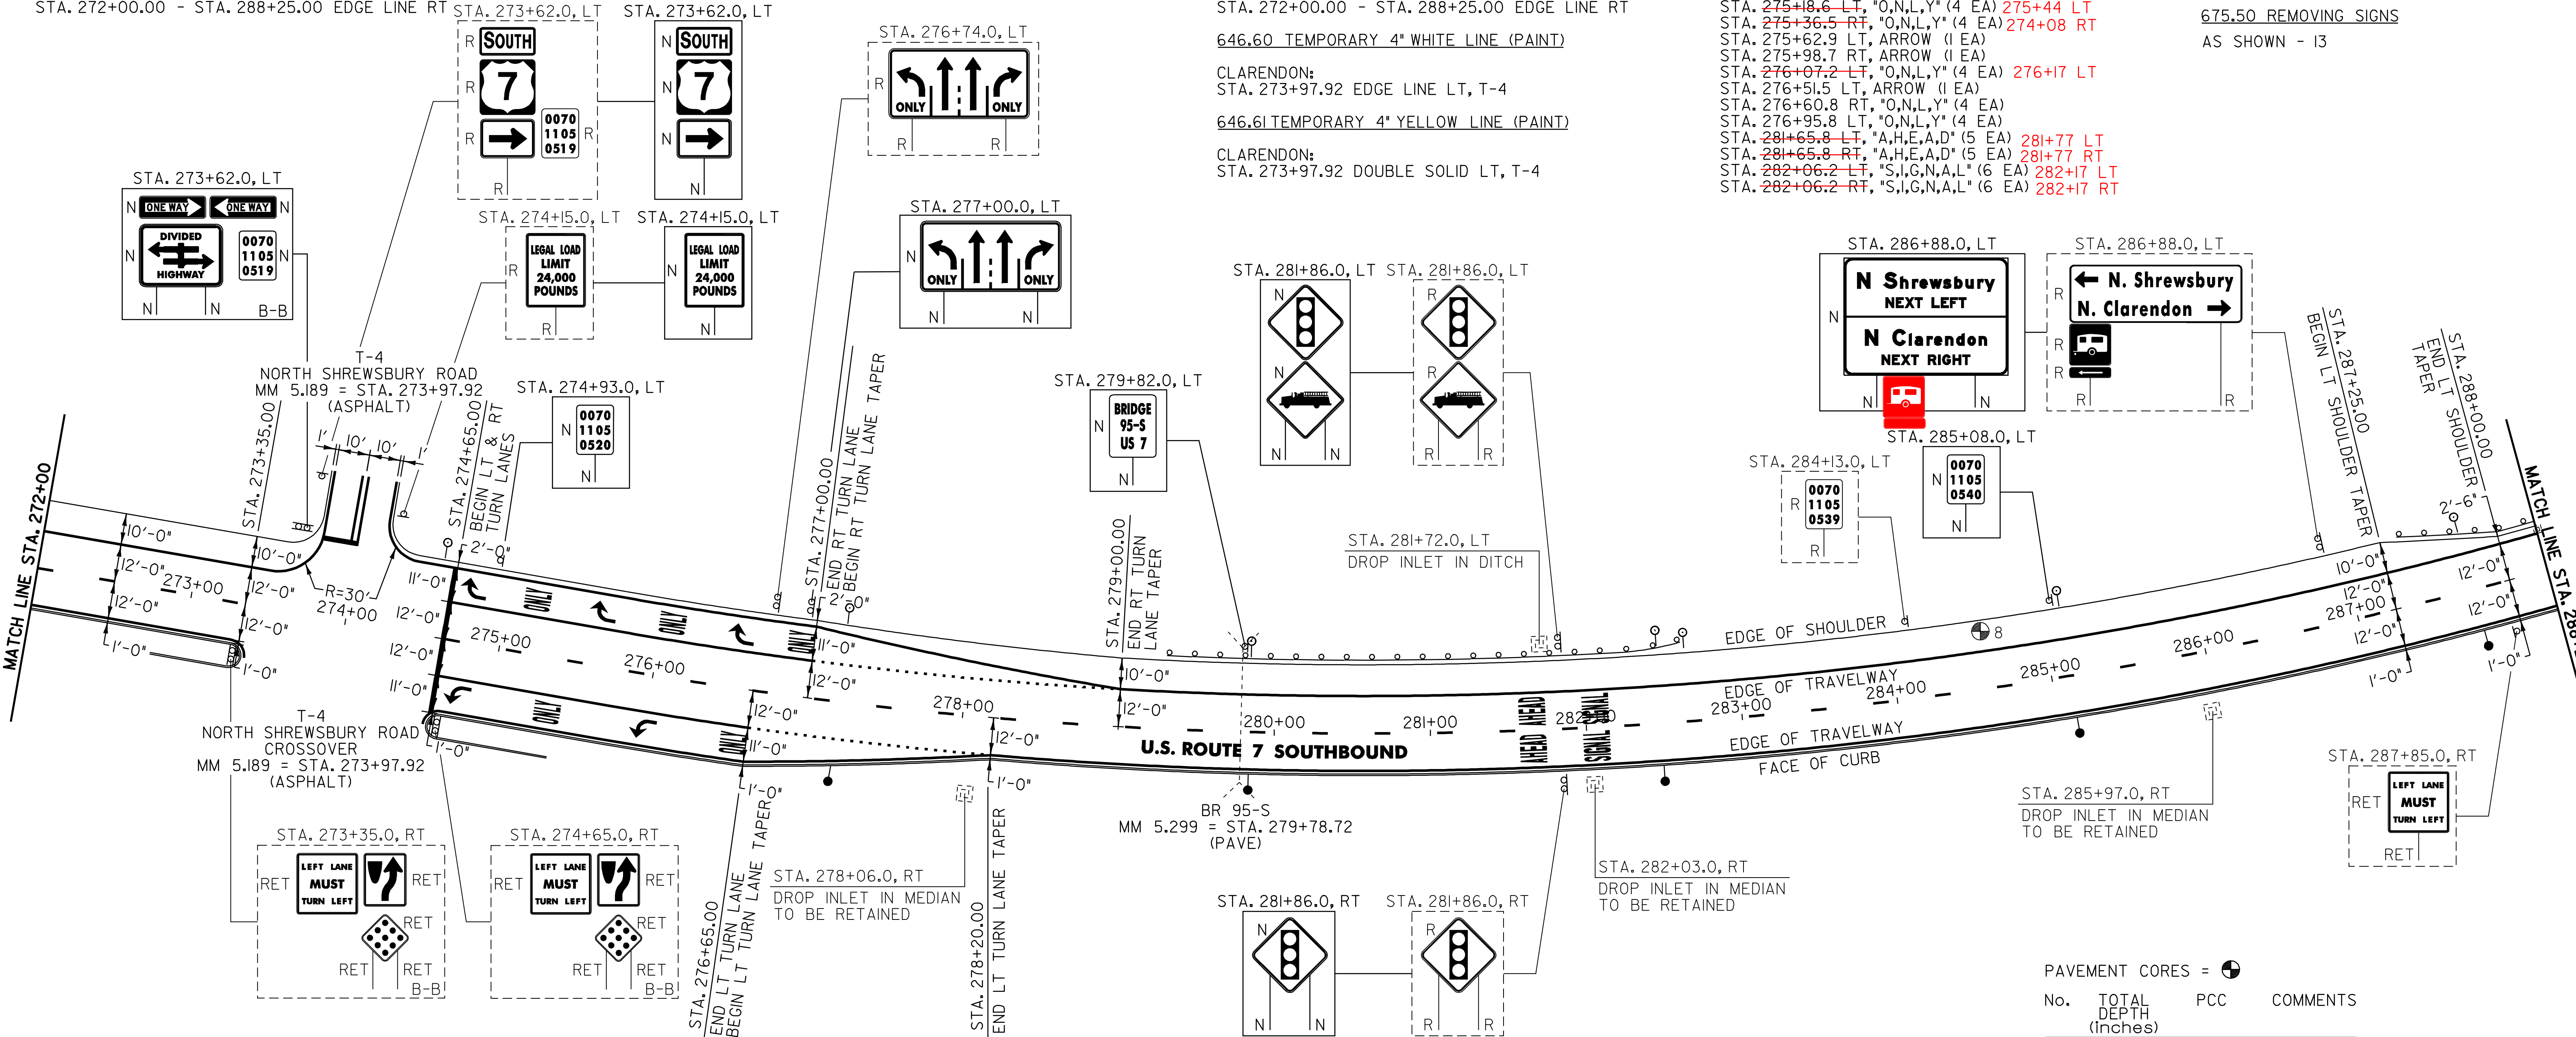
CLARENDON:  
STA. 274+74.3 LT, ARROW (2 EA)  
STA. 274+74.3 RT, ARROW (2 EA)  
STA. 275+98.7 RT, ARROW (2 EA)  
STA. 276+51.5 LT, ARROW (2 EA)  
STA. 281+65.8 LT, "A,H,E,A,D" (10 EA)  
STA. 281+65.8 RT, "A,H,E,A,D" (10 EA)  
STA. 282+06.2 LT, "S,I,G,N,A,L" (12 EA)  
STA. 282+06.2 RT, "S,I,G,N,A,L" (12 EA)

646.81 PAINTED CURB

CLARENDON:  
STA. 272+00.0 - STA. 273+35.0 RT (140 LF)  
STA. 274+65.0 - STA. 288+25.0 RT (1360 LF)

675.50 REMOVING SIGNS

AS SHOWN - 13



213.10 MILLED RUMBLE STRIPS

CLARENDON:  
STA. 272+00.0 - STA. 273+20.0 LT (120 LF)  
STA. 279+00.0 - STA. 287+75.0 LT (875 LF)

604.412 REHABING DI, CB OR MH, CLASS 1

CLARENDON:  
STA. 281+72.0 LT

621.20 STEEL BEAM GUARDRAIL (GALVANIZED)

CLARENDON: **279+14** - STA. 282+28.5 LT (300 LF)  
STA. ~~279+41.0~~ - STA. 282+28.5 LT (287.5 LF)  
STA. 287+47.7 - STA. 287+72.7 LT (25 LF)

621.505 MANUFACTURED TERMINAL SECTION (FLARED)

CLARENDON:  
STA. 282+28.5 - STA. 282+66.0 LT

621.52 TRAILING END TERMINAL

CLARENDON: **279+14** - STA. 279+28 LT  
STA. ~~279+27.0~~ - STA. 279+41.0 LT  
STA. 287+33.7 - STA. 287+47.7 LT

621.72 ALUMINUM APPROACH RAIL

CLARENDON:  
STA. 287+72.7 - STA. 288+00.0 LT (27.3 LF)

621.80 REMOVAL AND DISPOSAL OF GUARDRAIL

CLARENDON:  
STA. 279+29.0 - STA. 280+81.0 LT (152 LF)  
STA. 287+36.0 - STA. 288+00.0 LT (64 LF)

676.10 DELINEATORS WITH STEEL POSTS

TYPE I WHITE TYPE I AMBER

CLARENDON:  
STA. 274+56.0 LT STA. 277+20.0 RT  
STA. 277+20.0 LT STA. 279+84.0 RT  
STA. 279+84.0 LT STA. 282+48.0 RT  
STA. 282+48.0 LT STA. 285+12.0 RT  
STA. 282+66.0 LT STA. 287+76.0 RT  
STA. 285+12.0 LT  
STA. 287+76.0 LT

SIGN LEGEND  
R = REMOVE  
S = SALVAGE  
N = NEW  
RET = RETAIN  
B-B = BACK TO BACK  
EXISTING = -----  
NEW = \_\_\_\_\_

| PAVEMENT CORES = |                      |     |          |
|------------------|----------------------|-----|----------|
| No.              | TOTAL DEPTH (inches) | PCC | COMMENTS |
| 8                | 1.75                 | NO  | -        |

NOTE:

1. PAVING LIMIT ON ALL TOWN AND STATE HIGHWAYS SHALL BE MEASURED 25 FT BACK FROM U.S. ROUTE 7 EDGE OF SHOULDER UNLESS DENOTED OTHERWISE ON THE PLANS OR AS DIRECTED BY THE RESIDENT ENGINEER.

PROJECT  
LAYOUT  
SHEET #20

PROJECT NAME: WALLINGFORD - RUTLAND TOWN  
PROJECT NUMBER: NH 2408(1)S  
FILE NAME: p04b050.dgn  
PROJECT LEADER: D.E.G.  
DESIGNED BY: J.S.P.  
IPARM FILE: p04b050L20.1  
PLOT DATE: \$DATE\$  
DRAWN BY: C.A.K.  
CHECKED BY: D.E.G.  
SHEET 32 OF 80



646.414 DURABLE 6" WHITE LINE (MOD.) (RETROREFLECTIVITY/INLAID)  
(ALL LINES WILL INCLUDE EDGE LINE BREAKS AND RADIUS FOR TOWN HIGHWAYS)

CLARENDON:  
STA. 288+25.00 - STA. 298+47.84 DASHED LINE C/L  
STA. 288+25.00 - STA. 296+15.00 EDGE LINE LT  
STA. 296+15.00 - STA. 298+47.84 EDGE LINE LT  
STA. 297+40.00 - STA. 298+47.84 DOTTED LANE LINE LT

RUTLAND TOWN:  
STA. 0+00.00 - STA. 5+00.00 DASHED LINE C/L  
STA. 0+00.00 - STA. 5+00.00 EDGE LINE LT  
STA. 0+00.00 - STA. 1+00.00 DOTTED LANE LINE LT

646.415 DURABLE 6" YELLOW LINE (MOD.) (RETROREFLECTIVITY/INLAID)  
(ALL LINES WILL INCLUDE EDGE LINE BREAKS AND RADIUS FOR TOWN HIGHWAYS)

CLARENDON:  
STA. 288+25.00 - STA. 298+47.84 EDGE LINE RT

RUTLAND TOWN:  
STA. 0+00.00 - STA. 5+00.0 EDGE LINE RT

646.40 DURABLE 4" WHITE LINE (MOD.) (RETROREFLECTIVITY/INLAID)

CLARENDON:  
STA. 293+46.24 EDGE LINE LT, VT. ROUTE 7B

646.41DURABLE 4" YELLOW LINE (MOD.) (RETROREFLECTIVITY/INLAID)

CLARENDON:  
STA. 293+46.24 DOUBLE SOLID LT, VT. ROUTE 7B

646.44 DURABLE 12" WHITE LINE (MOD.) (RETROREFLECTIVITY/INLAID)

CLARENDON:  
STA. 296+15.00 - STA. 297+40.00 GORE AREA LT

646.614 TEMPORARY 6" WHITE LINE (PAINT)  
(ALL LINES WILL INCLUDE EDGE LINE BREAKS AND RADIUS FOR TOWN HIGHWAYS)

CLARENDON:  
STA. 288+25.00 - STA. 298+47.84 DASHED LINE C/L  
STA. 288+25.00 - STA. 296+15.00 EDGE LINE LT  
STA. 296+15.00 - STA. 298+47.84 EDGE LINE LT  
STA. 297+40.00 - STA. 298+47.84 DOTTED LANE LINE LT

RUTLAND TOWN:  
STA. 0+00.00 - STA. 5+00.00 DASHED LINE C/L  
STA. 0+00.00 - STA. 5+00.00 EDGE LINE LT  
STA. 0+00.00 - STA. 1+00.00 DOTTED LANE LINE LT

646.615 TEMPORARY 6" YELLOW LINE (PAINT)  
(ALL LINES WILL INCLUDE EDGE LINE BREAKS AND RADIUS FOR TOWN HIGHWAYS)

CLARENDON:  
STA. 288+25.00 - STA. 298+47.84 EDGE LINE RT

RUTLAND TOWN:  
STA. 0+00.00 - STA. 5+00.0 EDGE LINE RT

646.60 TEMPORARY 4" WHITE LINE (PAINT)

CLARENDON:  
STA. 293+46.24 EDGE LINE LT, VT. ROUTE 7B

646.61TEMPORARY 4" YELLOW LINE (PAINT)

CLARENDON:  
STA. 293+46.24 DOUBLE SOLID LT, VT. ROUTE 7B

646.64 TEMPORARY 12" WHITE LINE (PAINT)

CLARENDON:  
STA. 296+15.00 - STA. 297+40.00 GORE AREA LT

646.46 DURABLE 24" STOP BAR (THERMOPLASTIC)

CLARENDON:  
STA. 293+46.24 LT, VT. ROUTE 7B

646.66 TEMPORARY 24" STOP BAR (PAINT)

CLARENDON:  
STA. 293+46.24 LT, VT. ROUTE 7B

646.50 DURABLE LETTER OR SYMBOL (THERMOPLASTIC)

CLARENDON: **293+35 LT**  
STA. **293+46.24-LT**, VT. ROUTE 7B, "S,T,O,P" (4 EA)

646.70 TEMPORARY LETTER OR SYMBOL (PAINT)

CLARENDON:  
STA. 293+46.24 LT, VT. ROUTE 7B, "S,T,O,P" (8 EA)

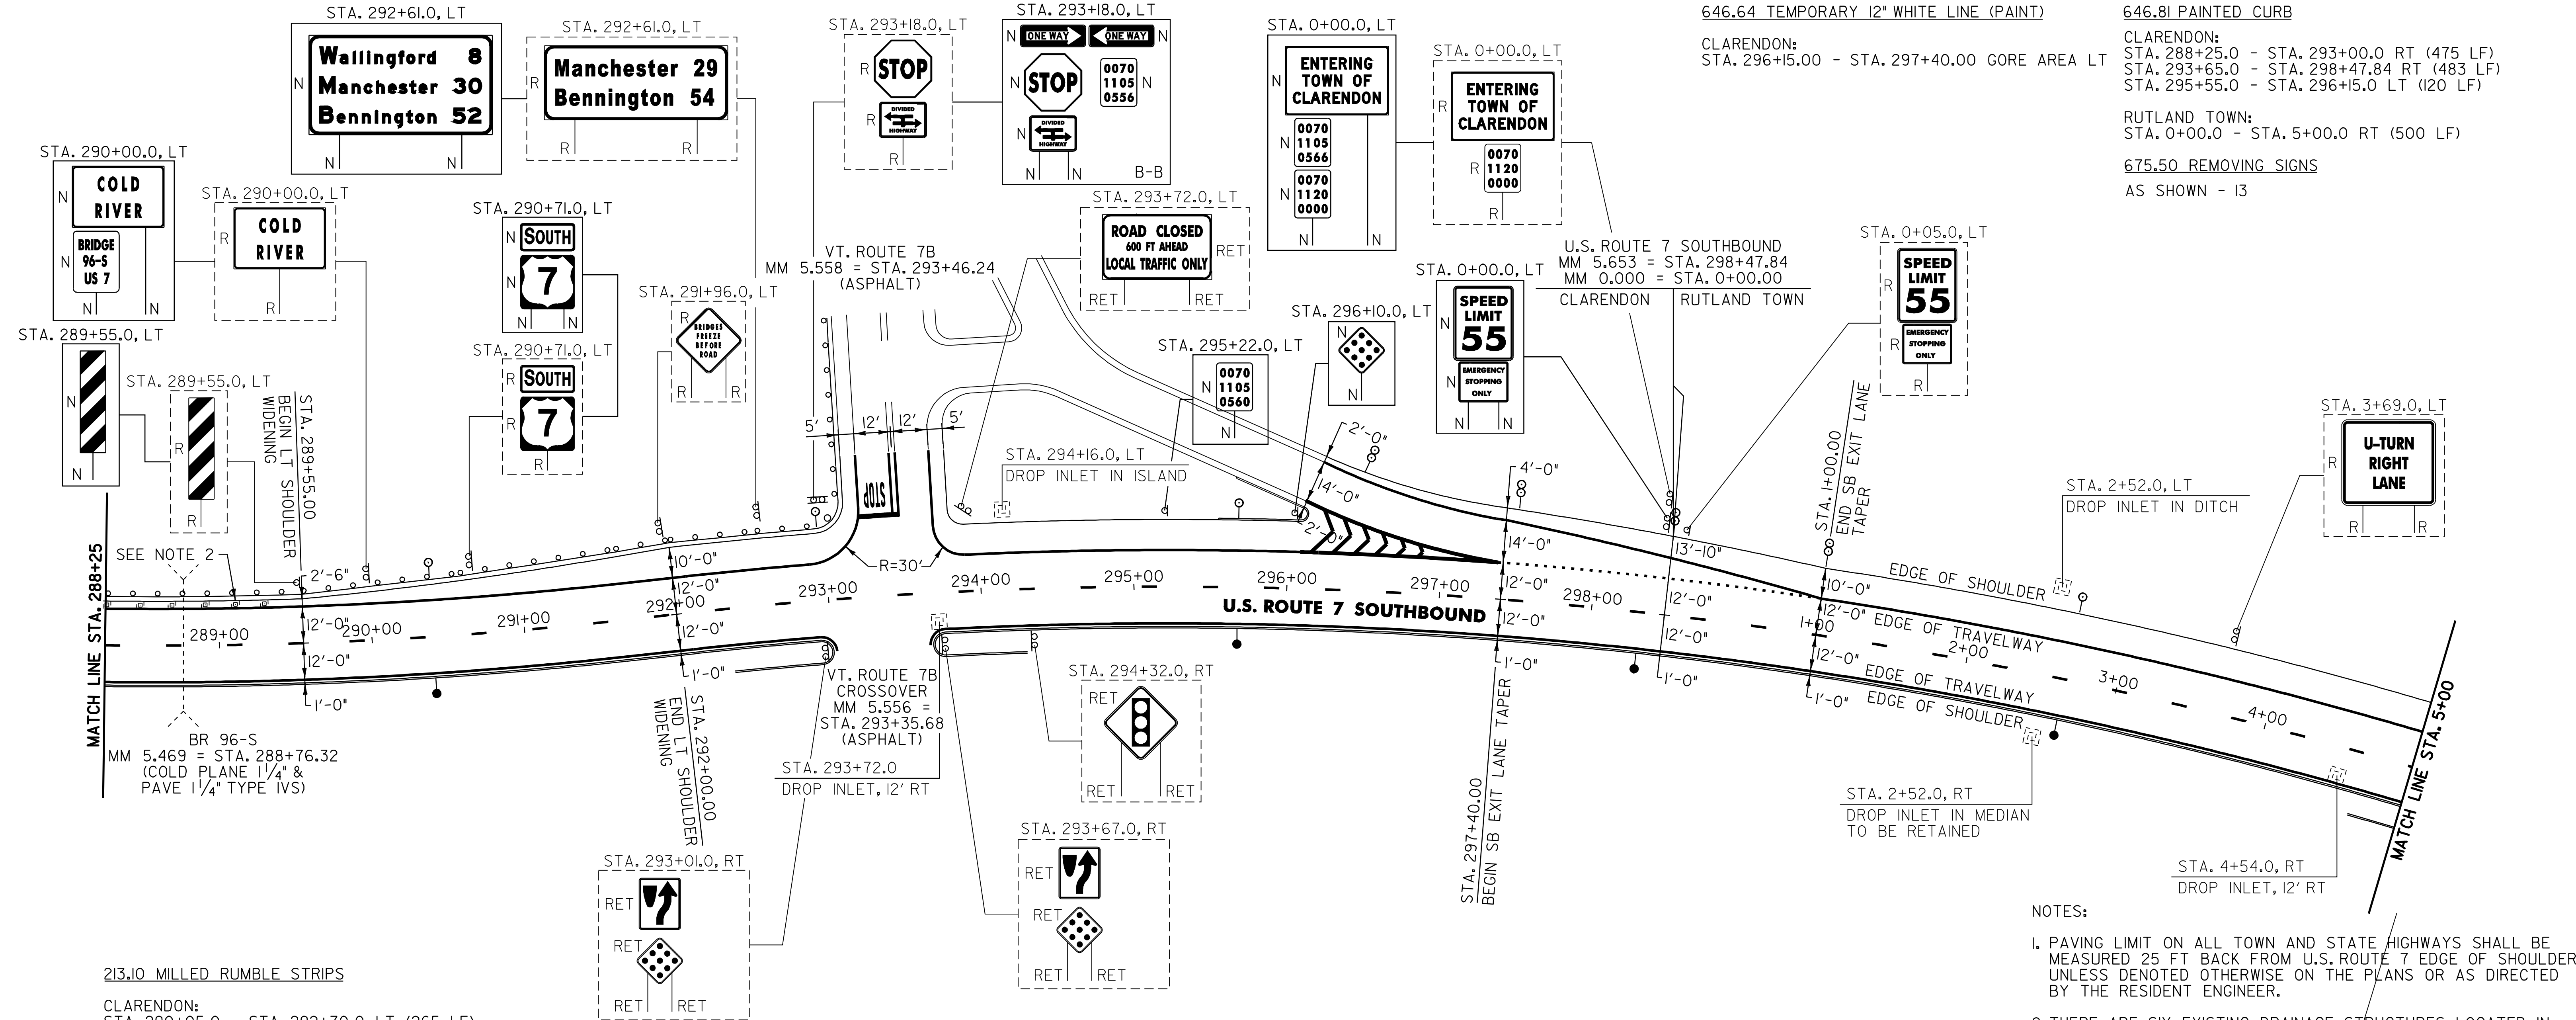
646.81 PAINTED CURB

CLARENDON:  
STA. 288+25.0 - STA. 293+00.0 RT (475 LF)  
STA. 293+65.0 - STA. 298+47.84 RT (483 LF)  
STA. 295+55.0 - STA. 296+15.0 LT (120 LF)

RUTLAND TOWN:  
STA. 0+00.0 - STA. 5+00.0 RT (500 LF)

675.50 REMOVING SIGNS

AS SHOWN - 13



213.10 MILLED RUMBLE STRIPS

CLARENDON:  
STA. 290+05.0 - STA. 292+70.0 LT (265 LF)  
STA. 294+25.0 - STA. 296+15.0 LT (190 LF)

RUTLAND TOWN:  
STA. 1+00.0 - STA. 4+95.0 LT (395 LF)

604.412 REHABING DI, CB OR MH, CLASS 1

CLARENDON:  
STA. 293+72.0 RT  
STA. 294+16.0 LT

RUTLAND TOWN:  
STA. 2+52.0 LT  
STA. 4+54.0 RT

621.20 STEEL BEAM GUARDRAIL (GALVANIZED)

CLARENDON: **293+40 LT 360.75 LF**  
STA. 289+80.3 - STA. **293+30.0-LT (350-LF)**

621.72 ALUMINUM APPROACH RAIL

CLARENDON:  
STA. 289+53.0 - STA. 289+80.3 LT (27.3 LF)

621.80 REMOVAL AND DISPOSAL OF GUARDRAIL

CLARENDON:  
STA. 289+53.0 - STA. 293+40.0 LT (387 LF)

676.10 DELINEATORS WITH STEEL POSTS

TYPE I WHITE TYPE I AMBER TYPE II WHITE

CLARENDON:  
STA. 290+40.0 LT  
STA. 293+04.0 LT  
STA. 295+68.0 LT

RUTLAND TOWN:  
STA. 2+64.0 LT

STA. 290+40.0 RT  
STA. 295+68.0 RT  
STA. 298+52.0 RT

RUTLAND TOWN:  
STA. 2+64.0 RT

STA. 296+48.0 LT  
STA. 297+48.0 LT

RUTLAND TOWN:  
STA. 0+00.0 LT  
STA. 1+00.0 LT

SIGN LEGEND

R = REMOVE

S = SALVAGE

N = NEW

RET = RETAIN

B-B = BACK TO BACK

EXISTING = -----

NEW = -----

NOTES:

- PAVING LIMIT ON ALL TOWN AND STATE HIGHWAYS SHALL BE MEASURED 25 FT BACK FROM U.S. ROUTE 7 EDGE OF SHOULDER UNLESS DENOTED OTHERWISE ON THE PLANS OR AS DIRECTED BY THE RESIDENT ENGINEER.
- THERE ARE SIX EXISTING DRAINAGE STRUCTURES LOCATED IN THE LEFT SHOULDER OF BR 96-S. HEIGHT ADJUSTMENTS OR REHABILITATIONS WILL NOT BE REQUIRED.
- SEE SHEETS 72 TO 74 FOR ALUMINUM APPROACH RAILING DETAILS. SEE SHEET 76 FOR BR 96-S DETAILS.

PROJECT  
LAYOUT  
SHEET #21

PROJECT NAME: WALLINGFORD - RUTLAND TOWN  
PROJECT NUMBER: NH 2408(1)S

FILE NAME: p04b050.dgn  
PROJECT LEADER: D.E.G.  
DESIGNED BY: J.S.P.  
IPARM FILE: p04b050L21.1

PLOT DATE: \$DATE\$  
DRAWN BY: C.A.K.  
CHECKED BY: D.E.G.  
SHEET 33 OF 80

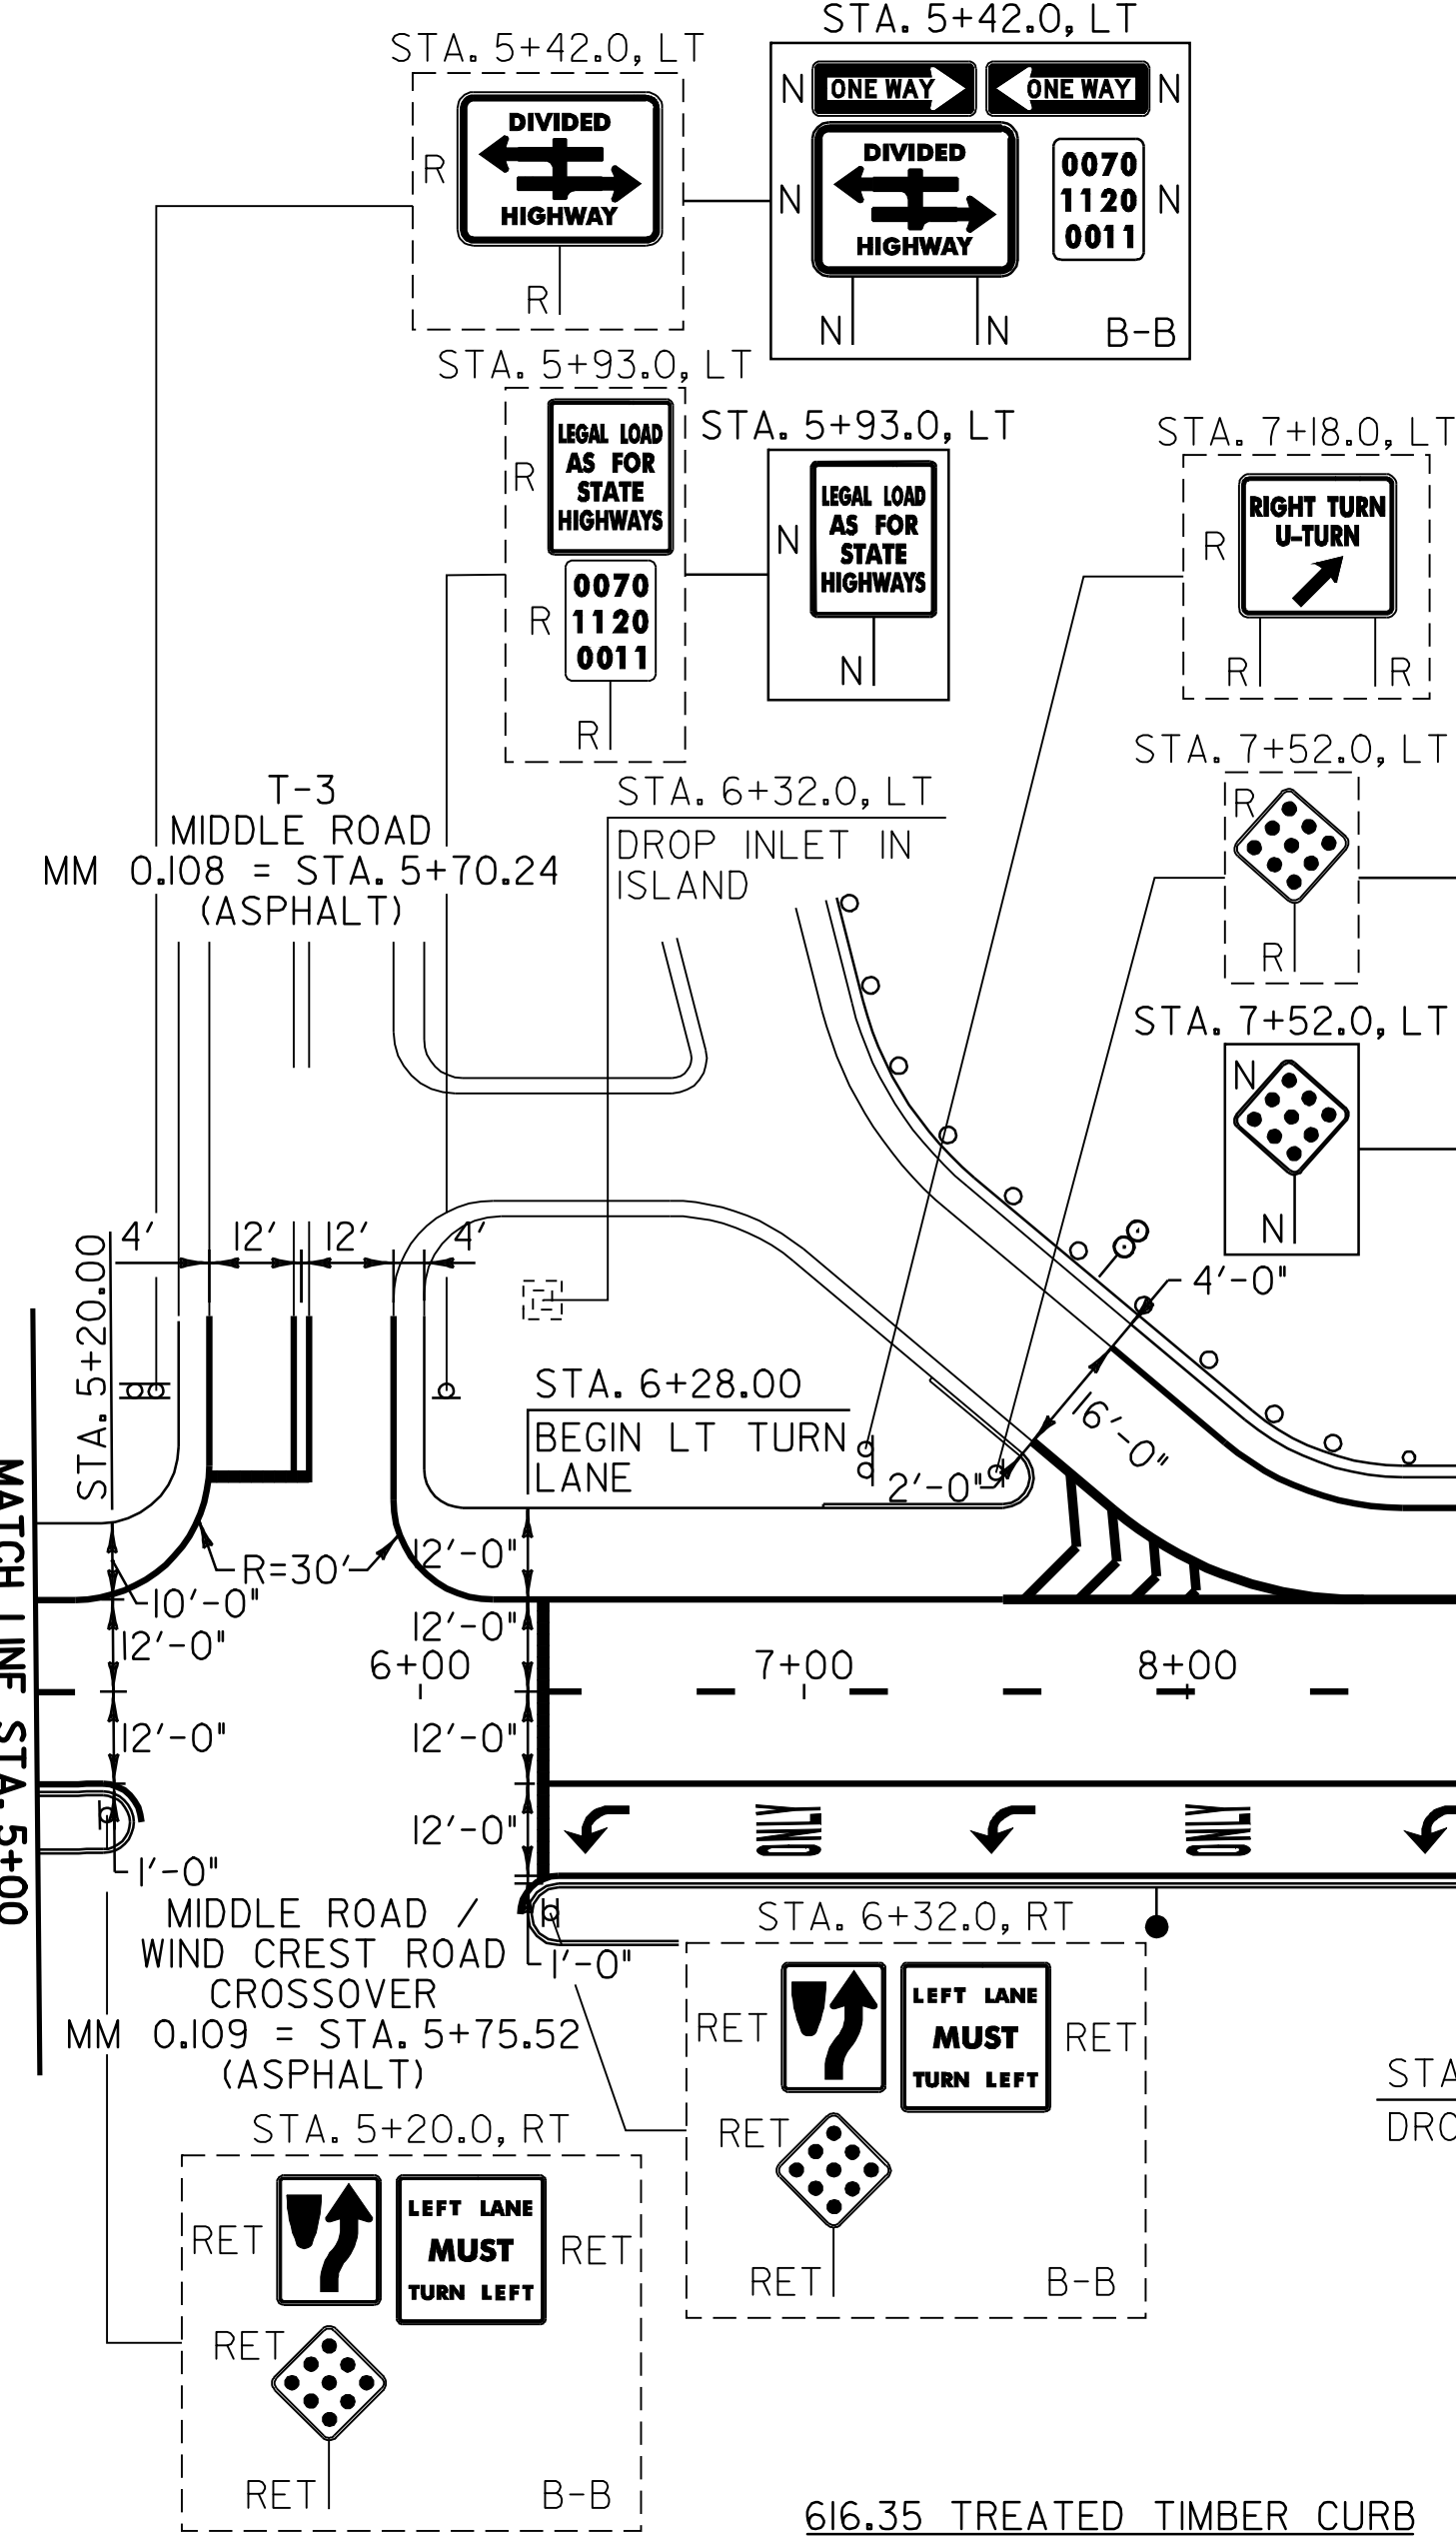


646.414 DURABLE 6" WHITE LINE (MOD.) (RETROREFLECTIVITY/INLAID)  
(ALL LINES WILL INCLUDE EDGE LINE BREAKS AND RADIUS FOR TOWN HIGHWAYS)

RUTLAND TOWN:  
STA. 5+00.00 - STA. 21+00.00 DASHED LINE C/L  
STA. 5+00.00 - STA. 7+60.00 EDGE LINE LT  
STA. 6+30.00 - STA. 9+25.00 SOLID LANE LINE RT  
STA. 7+60.00 - STA. 16+90.00 EDGE LINE LT  
STA. 8+85.00 - STA. 10+00.00 SOLID LANE LINE LT  
STA. 9+25.00 - STA. 11+30.00 DOTTED LANE LINE RT  
STA. 10+00.00 - STA. 15+30.00 DASHED LANE LINE LT  
STA. 16+90.00 - STA. 21+00.00 EDGE LINE LT  
STA. 19+75.00 - STA. 21+00.00 SOLID LANE LINE RT

646.415 DURABLE 6" YELLOW LINE (MOD.) (RETROREFLECTIVITY/INLAID)  
(ALL LINES WILL INCLUDE EDGE LINE BREAKS AND RADIUS FOR TOWN HIGHWAYS)

RUTLAND TOWN:  
STA. 5+00.00 - STA. 21+00.00 EDGE LINE RT



213.10 MILLED RUMBLE STRIPS

RUTLAND TOWN:  
STA. 6+45.0 - STA. 7+60.0 LT (115 LF)  
STA. 16+90.0 - STA. 18+20.0 LT (130 LF)  
STA. 20+25.0 - STA. 21+00.0 LT (75 LF)

604.412 REHABING DI, CB OR MH, CLASS I

RUTLAND TOWN:  
STA. 6+32.0 LT STA. 16+18.0 LT  
STA. 9+67.0 RT STA. 18+63.0 LT  
STA. 12+88.0 LT STA. 20+71.0 RT

646.40 DURABLE 4" WHITE LINE (MOD.) (RETROREFLECTIVITY/INLAID)

RUTLAND TOWN:  
STA. 5+70.24 EDGE LINE LT, T-3

646.41 DURABLE 4" YELLOW LINE (MOD.) (RETROREFLECTIVITY/INLAID)  
(ALL LINES WILL INCLUDE C/L BREAKS FOR TOWN HIGHWAYS) S=SOLID, D=DASHED

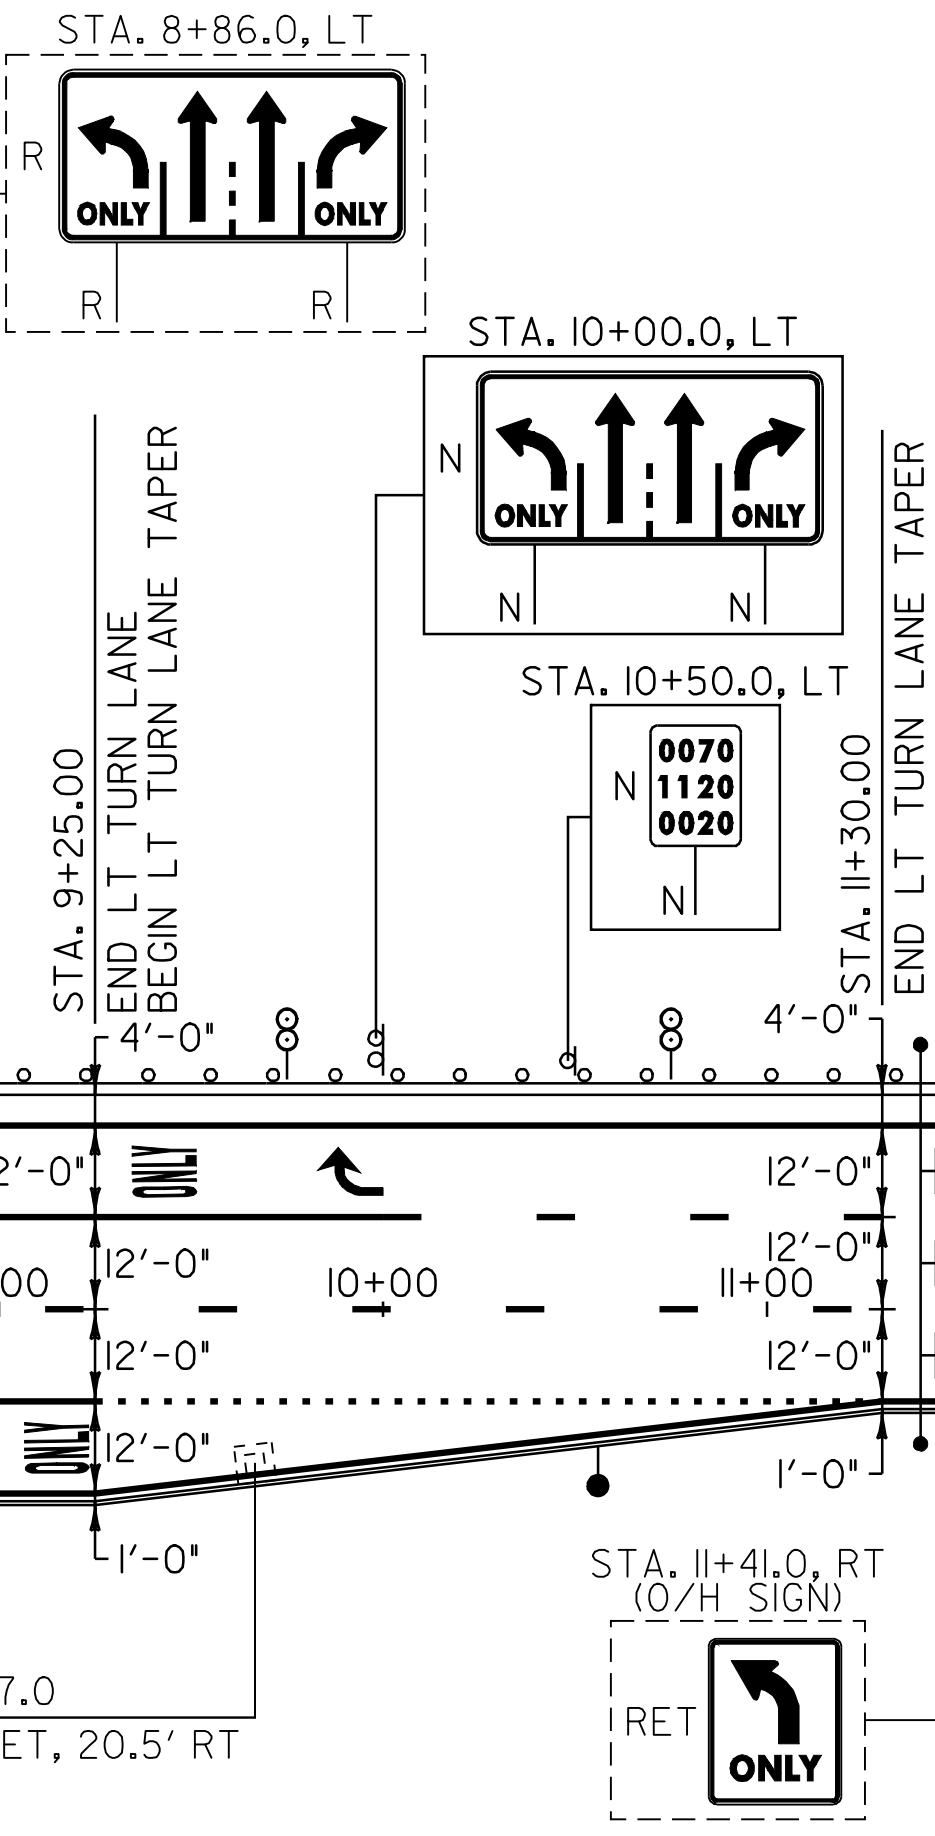
RUTLAND TOWN:  
STA. 5+70.24 DOUBLE SOLID LT, T-3

646.44 DURABLE 12" WHITE LINE (MOD.) (RETROREFLECTIVITY/INLAID)

RUTLAND TOWN:  
STA. 7+60.00 - STA. 8+85.00 GORE AREA LT  
STA. 15+30.00 - STA. 16+90.00 GORE AREA LT

646.614 TEMPORARY 6" WHITE LINE (PAINT)  
(ALL LINES WILL INCLUDE EDGE LINE BREAKS AND RADIUS FOR TOWN HIGHWAYS)

RUTLAND TOWN:  
STA. 5+00.00 - STA. 21+00.00 DASHED LINE C/L  
STA. 5+00.00 - STA. 7+60.00 EDGE LINE LT  
STA. 6+30.00 - STA. 9+25.00 SOLID LANE LINE RT  
STA. 7+60.00 - STA. 16+90.00 EDGE LINE LT  
STA. 8+85.00 - STA. 10+00.00 SOLID LANE LINE LT  
STA. 9+25.00 - STA. 11+30.00 DOTTED LANE LINE RT  
STA. 10+00.00 - STA. 15+30.00 DASHED LANE LINE LT  
STA. 16+90.00 - STA. 21+00.00 EDGE LINE LT  
STA. 19+75.00 - STA. 21+00.00 SOLID LANE LINE RT



621.52 TRAILING END TERMINAL

RUTLAND TOWN:  
STA. 5+96.0 - STA. 6+10.0 LT

621.80 REMOVAL AND DISPOSAL OF GUARDRAIL

RUTLAND TOWN:  
STA. 6+00.0 - STA. 16+55.0 LT (1055 LF)

676.10 DELINEATORS WITH STEEL POSTS

♀ TYPE I WHITE ♂ TYPE I AMBER ♂ TYPE II WHITE

RUTLAND TOWN:  
STA. 16+60.0 LT STA. 18+48.0 LT  
STA. 7+92.0 RT STA. 10+56.0 RT STA. 13+20.0 RT STA. 15+84.0 RT STA. 18+48.0 RT  
STA. 7+75.0 LT STA. 8+75.0 LT STA. 9+75.0 LT STA. 10+75.0 LT STA. 11+75.0 LT  
STA. 12+75.0 LT STA. 13+75.0 LT STA. 14+75.0 LT STA. 15+75.0 LT STA. 16+75.0 LT

646.615 TEMPORARY 6" YELLOW LINE (PAINT)  
(ALL LINES WILL INCLUDE EDGE LINE BREAKS AND RADIUS FOR TOWN HIGHWAYS)

RUTLAND TOWN:  
STA. 5+00.00 - STA. 21+00.00 EDGE LINE RT

646.60 TEMPORARY 4" WHITE LINE (PAINT)

RUTLAND TOWN:  
STA. 5+70.24 EDGE LINE LT, T-3

646.61 TEMPORARY 4" YELLOW LINE (PAINT)

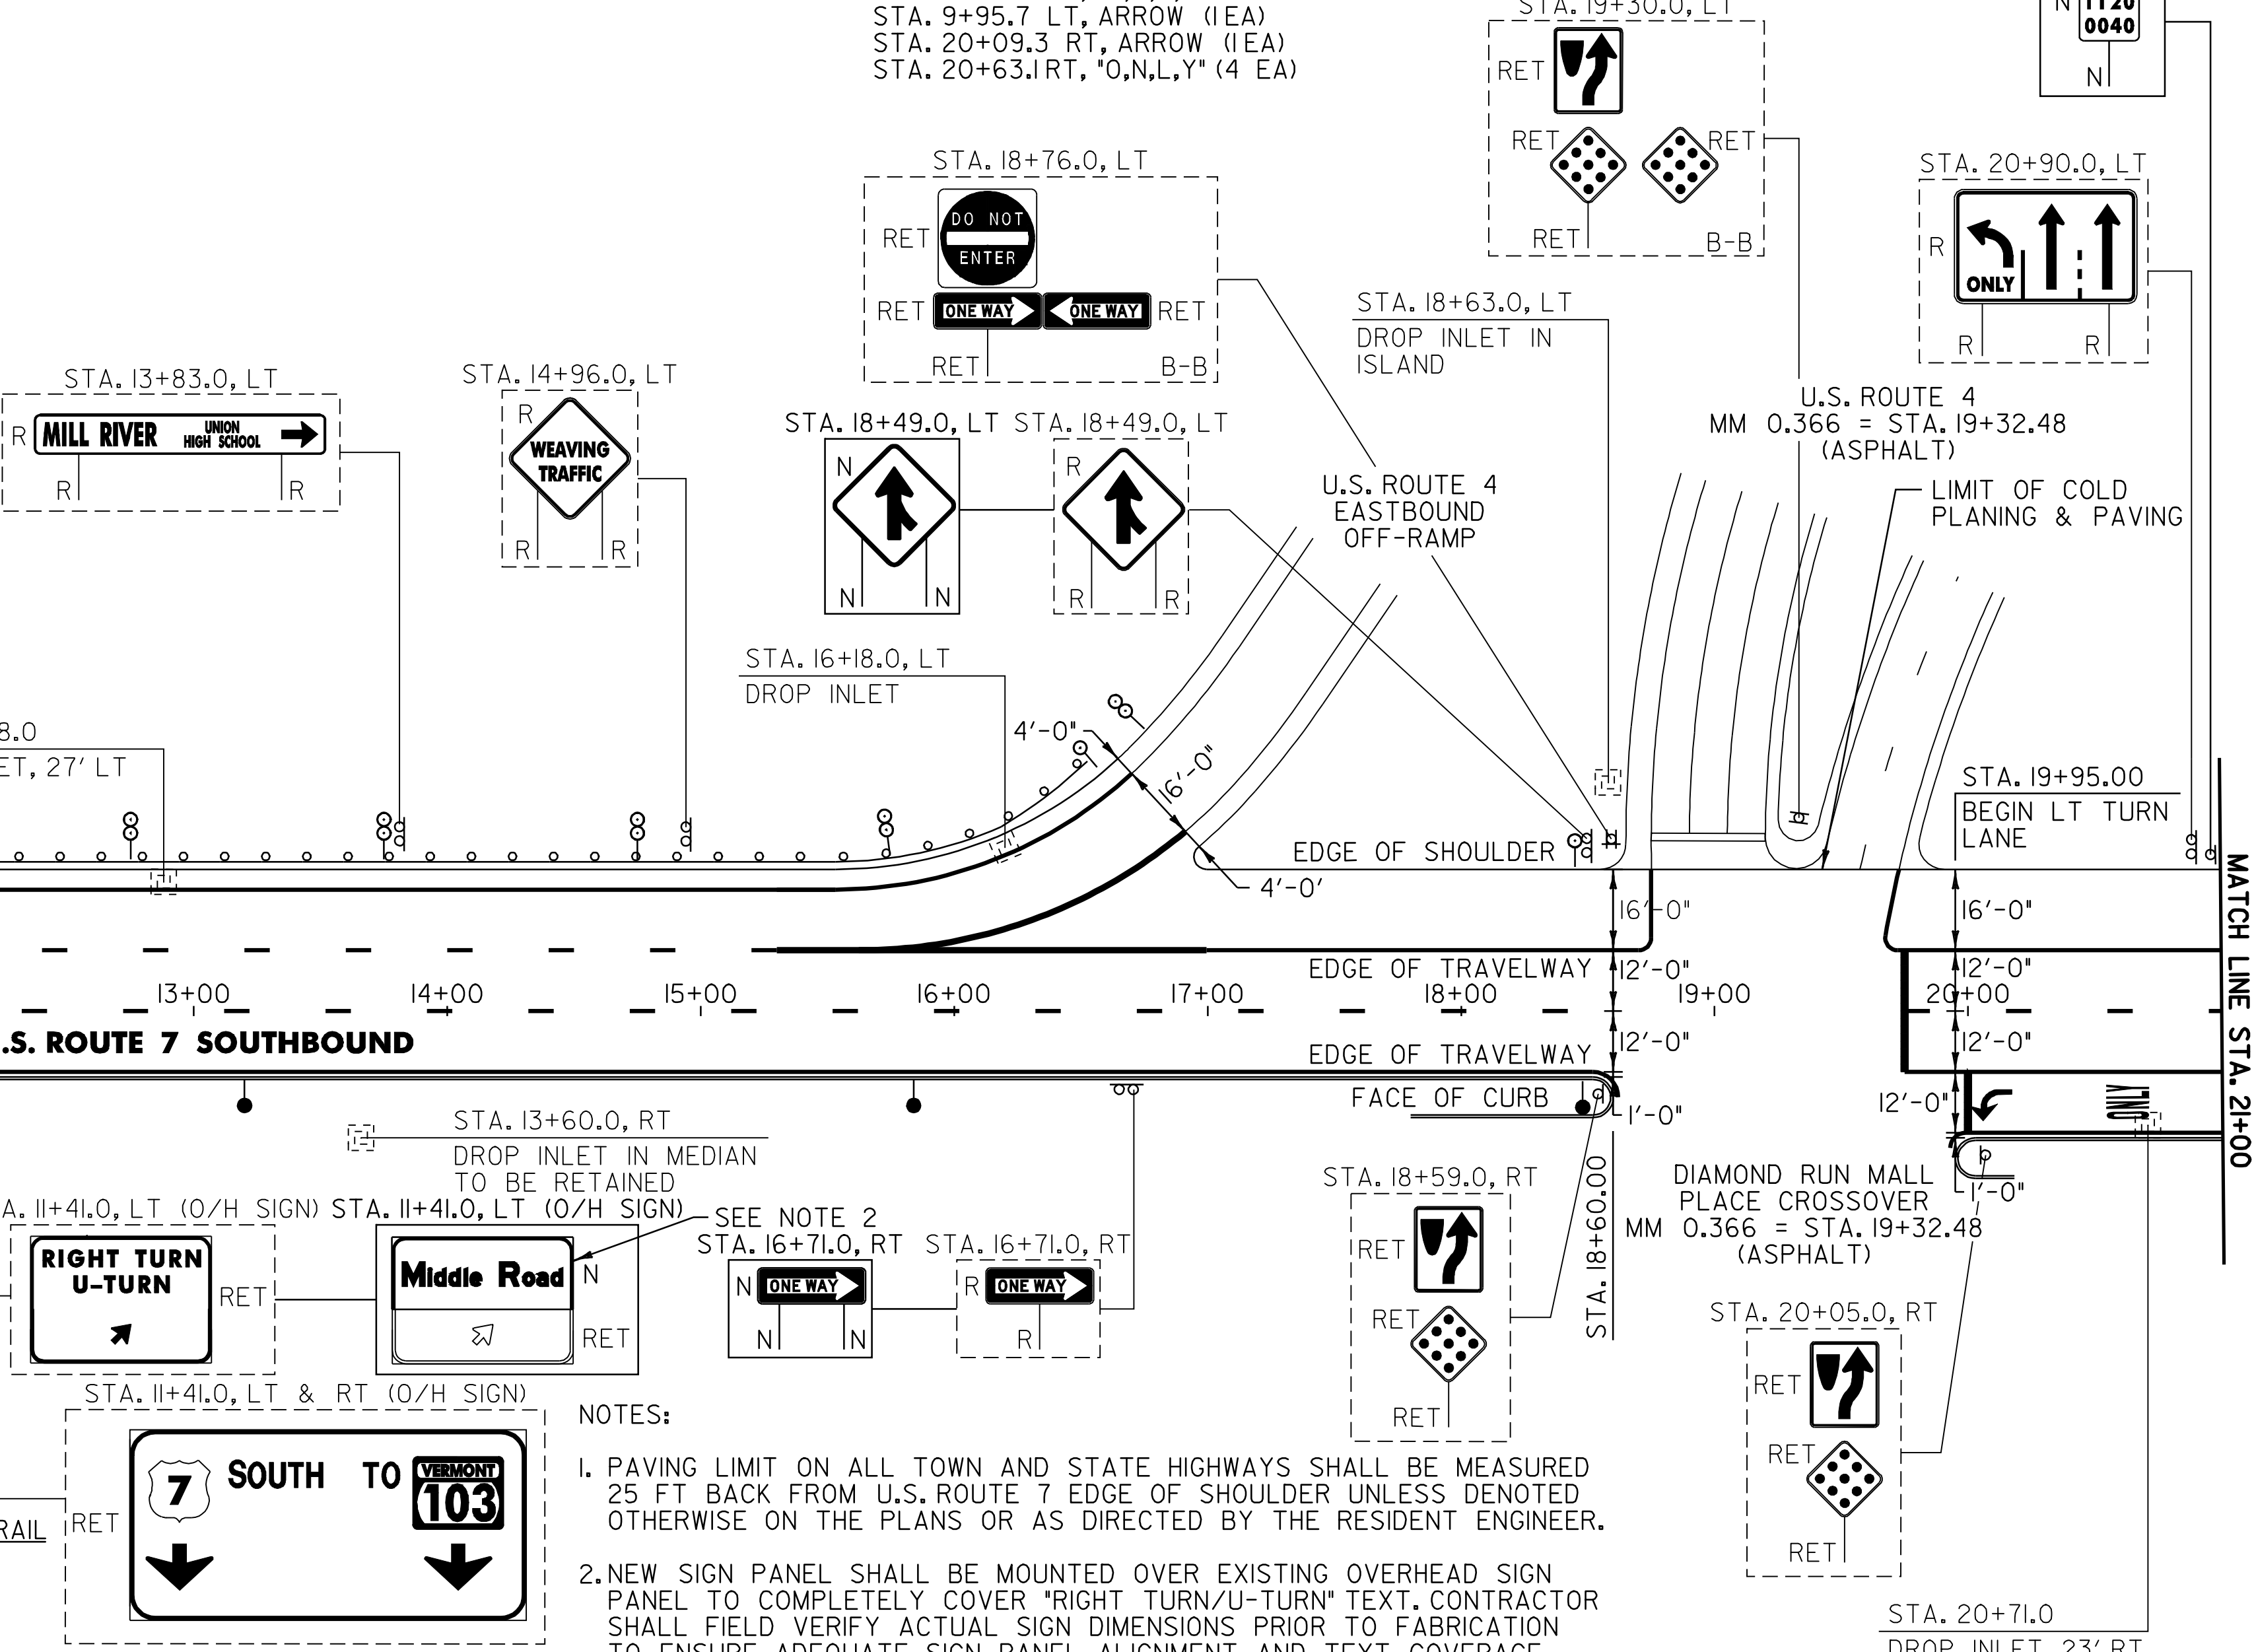
RUTLAND TOWN:  
STA. 5+70.24 DOUBLE SOLID LT, T-3

646.64 TEMPORARY 12" WHITE LINE (PAINT)

RUTLAND TOWN:  
STA. 7+60.00 - STA. 8+85.00 GORE AREA LT  
STA. 15+30.00 - STA. 16+90.00 GORE AREA LT

675.50 REMOVING SIGNS

AS SHOWN - II



NOTES:

1. PAVING LIMIT ON ALL TOWN AND STATE HIGHWAYS SHALL BE MEASURED 25 FT BACK FROM U.S. ROUTE 7 EDGE OF SHOULDER UNLESS DENOTED OTHERWISE ON THE PLANS OR AS DIRECTED BY THE RESIDENT ENGINEER.
2. NEW SIGN PANEL SHALL BE MOUNTED OVER EXISTING OVERHEAD SIGN PANEL TO COMPLETELY COVER "RIGHT TURN/U-TURN" TEXT. CONTRACTOR SHALL FIELD VERIFY ACTUAL SIGN DIMENSIONS PRIOR TO FABRICATION TO ENSURE ADEQUATE SIGN PANEL ALIGNMENT AND TEXT COVERAGE.

SIGN LEGEND

R = REMOVE  
S = SALVAGE  
N = NEW  
RET = RETAIN  
B-B = BACK TO BACK  
EXISTING = -----  
NEW = -----

PROJECT  
LAYOUT  
SHEET #22

PROJECT NAME: WALLINGFORD - RUTLAND TOWN  
PROJECT NUMBER: NH 2408(1)S

FILE NAME: p04b050.dgn  
PROJECT LEADER: D.E.G.  
DESIGNED BY: J.S.P.  
IPARM FILE: p04b050L22.i  
PLOT DATE: \$DATE\$  
DRAWN BY: C.A.K.  
CHECKED BY: D.E.G.  
SHEET 34 OF 80



646.414 DURABLE 6" WHITE LINE (MOD.) (RETROREFLECTIVITY/INLAID)  
(ALL LINES WILL INCLUDE EDGE LINE BREAKS AND  
RADIUS FOR TOWN HIGHWAYS)

RUTLAND TOWN:  
STA. 21+00.00 - STA. 35+58.72 DASHED LINE C/L  
STA. 21+00.00 - STA. 22+10.00 EDGE LINE LT  
STA. 21+00.00 - STA. 21+75.00 SOLID LANE LINE RT  
STA. 21+75.00 - STA. 23+80.00 DOTTED LANE LINE RT  
STA. 22+10.00 - STA. 35+58.72 EDGE LINE LT  
STA. 23+00.00 - STA. 23+60.00 DASHED LANE LINE LT  
STA. 23+60.00 - STA. 26+75.00 DOTTED LANE LINE LT

646.415 DURABLE 6" YELLOW LINE (MOD.) (RETROREFLECTIVITY/INLAID)  
(ALL LINES WILL INCLUDE EDGE LINE BREAKS AND  
RADIUS FOR TOWN HIGHWAYS)

RUTLAND TOWN:  
STA. 21+00.00 - STA. 35+58.72 EDGE LINE RT

646.44 DURABLE 12" WHITE LINE (MOD.) (RETROREFLECTIVITY/INLAID)

RUTLAND TOWN:  
STA. 22+10.00 - STA. 23+00.00 GORE AREA LT

646.614 TEMPORARY 6" WHITE LINE (PAINT)  
(ALL LINES WILL INCLUDE EDGE LINE BREAKS AND  
RADIUS FOR TOWN HIGHWAYS)

RUTLAND TOWN:  
STA. 21+00.00 - STA. 35+58.72 DASHED LINE C/L  
STA. 21+00.00 - STA. 22+10.00 EDGE LINE LT  
STA. 21+00.00 - STA. 21+75.00 SOLID LANE LINE RT  
STA. 21+75.00 - STA. 23+80.00 DOTTED LANE LINE RT  
STA. 22+10.00 - STA. 35+58.72 EDGE LINE LT  
STA. 23+00.00 - STA. 23+60.00 DASHED LANE LINE LT  
STA. 23+60.00 - STA. 26+75.00 DOTTED LANE LINE LT

646.615 TEMPORARY 6" YELLOW LINE (PAINT)  
(ALL LINES WILL INCLUDE EDGE LINE BREAKS AND  
RADIUS FOR TOWN HIGHWAYS)

RUTLAND TOWN:  
STA. 21+00.00 - STA. 35+58.72 EDGE LINE RT

646.64 TEMPORARY 12" WHITE LINE (PAINT)

RUTLAND TOWN:  
STA. 22+10.00 - STA. 23+00.00 GORE AREA LT

646.50 DURABLE LETTER OR SYMBOL (THERMOPLASTIC)

RUTLAND TOWN:  
STA. 21+16.9 RT, ARROW (1EA)  
STA. 21+70.7 RT, "O,N,L,Y" (4 EA)

646.70 TEMPORARY LETTER OR SYMBOL (PAINT)

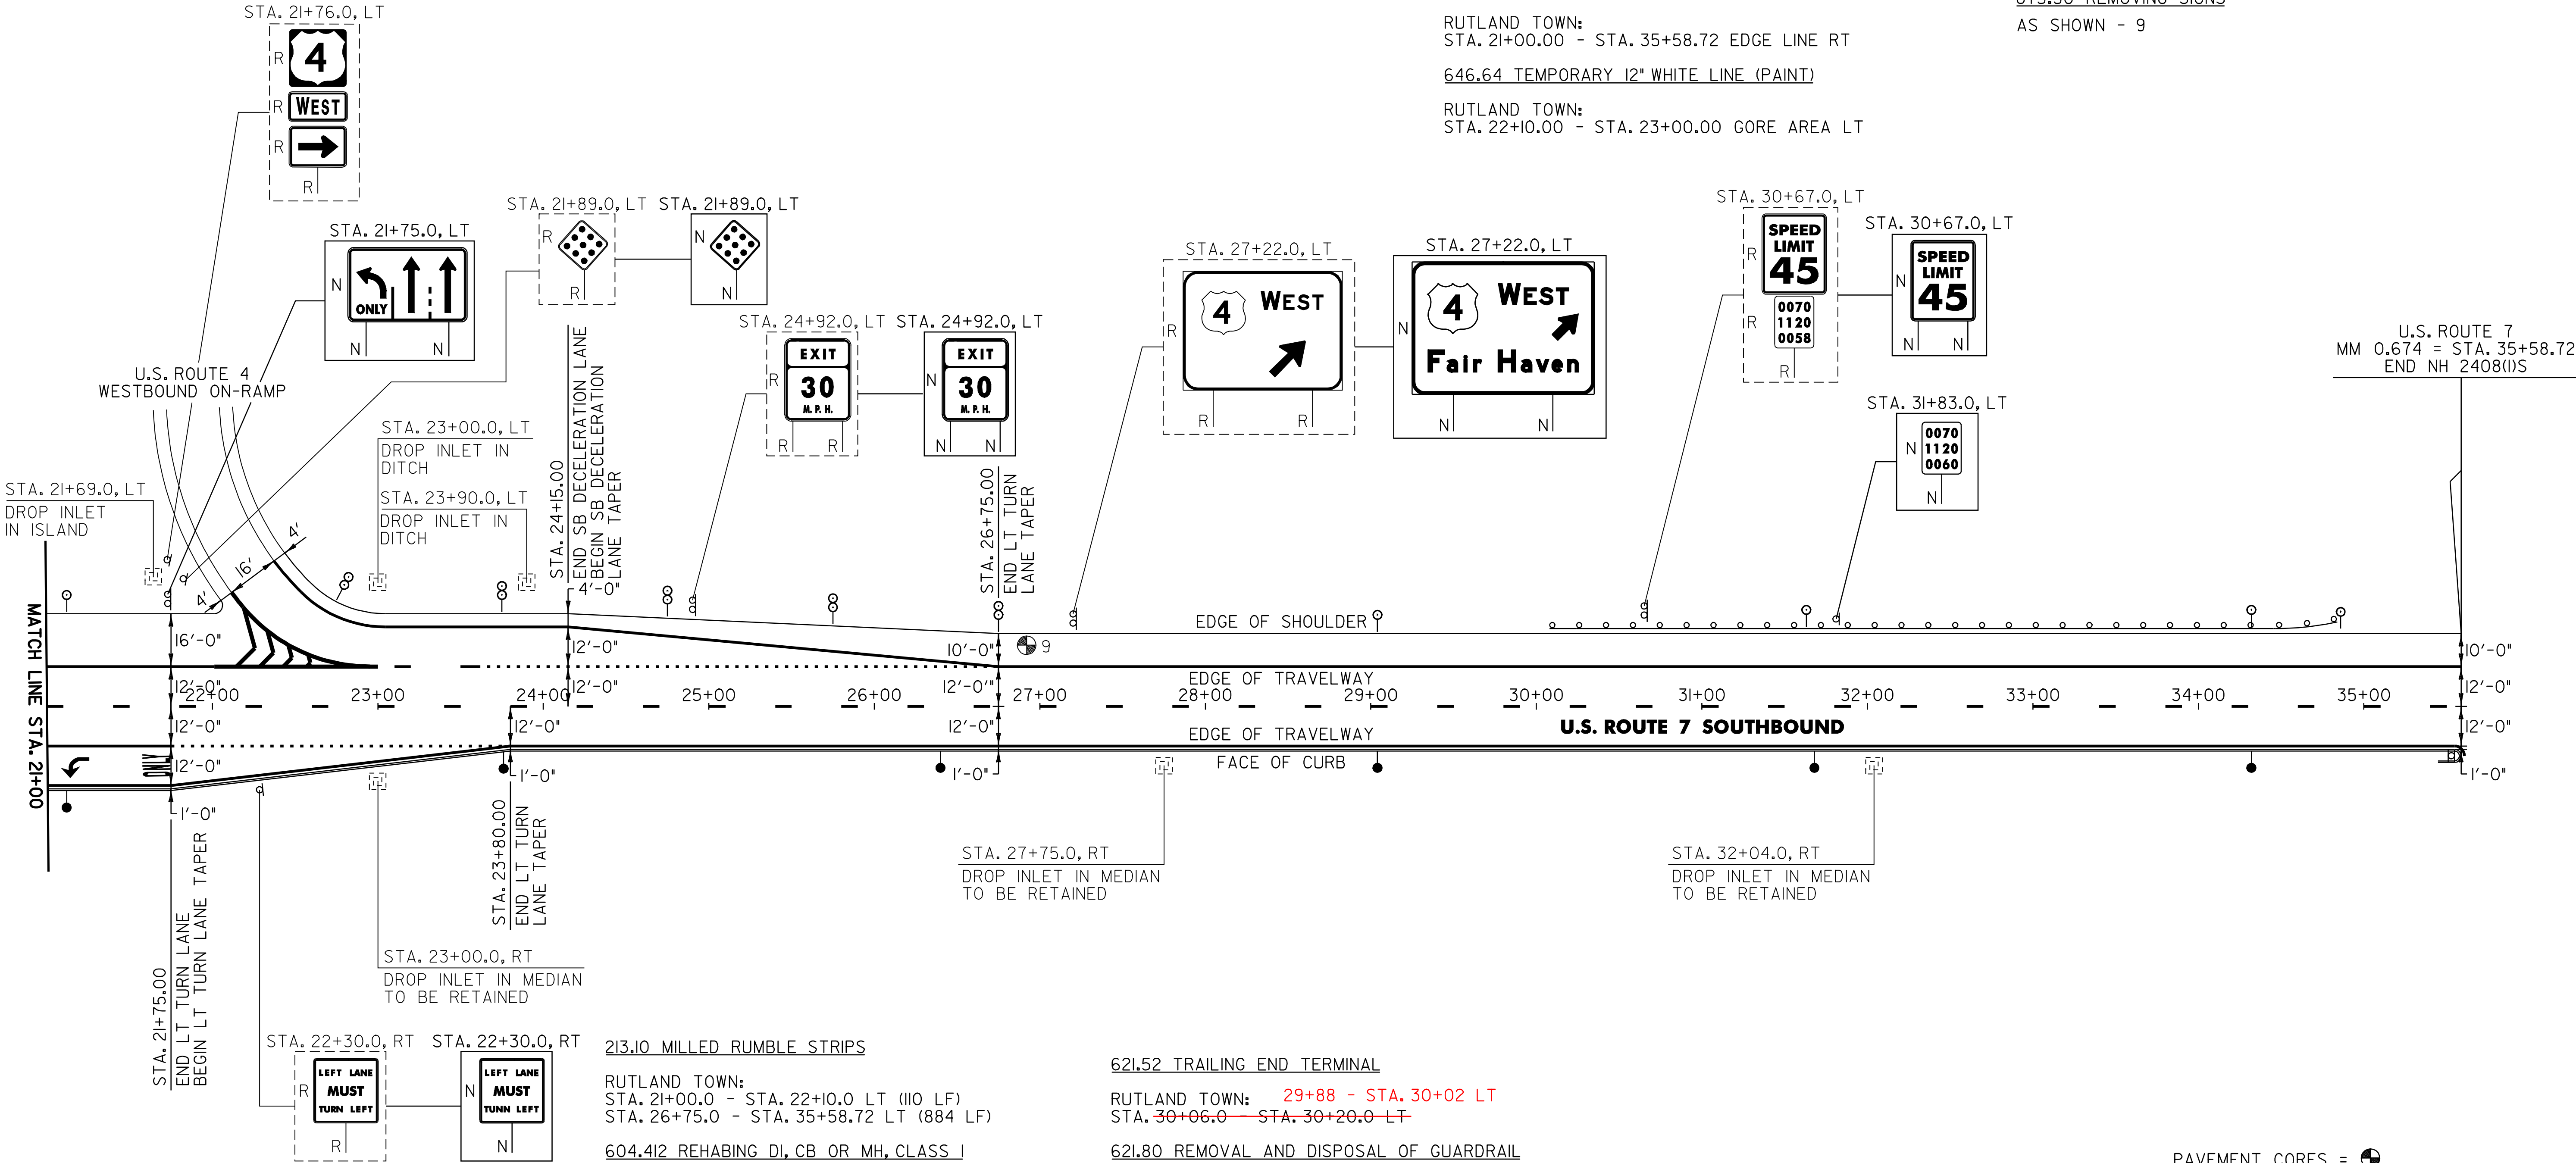
RUTLAND TOWN:  
STA. 21+16.9 RT, ARROW (2 EA)

646.81 PAINTED CURB

RUTLAND TOWN:  
STA. 21+00.0 - STA. 35+58.72 RT (1459 LF)

675.50 REMOVING SIGNS

AS SHOWN - 9



213.10 MILLED RUMBLE STRIPS

RUTLAND TOWN:  
STA. 21+00.0 - STA. 22+10.0 LT (110 LF)  
STA. 26+75.0 - STA. 35+58.72 LT (884 LF)

604.412 REHABING DI, CB OR MH, CLASS I

RUTLAND TOWN:  
STA. 21+69.0 LT  
STA. 23+00.0 LT  
STA. 23+90.0 LT

621.20 STEEL BEAM GUARDRAIL (GALVANIZED)

RUTLAND TOWN: 30+02 - STA. 34+52 LT  
STA. 30+20.0 - STA. 34+57.5 LT (437.5 LF) 450 LF

621.505 MANUFACTURED TERMINAL SECTION (FLARED)

RUTLAND TOWN:  
STA. 34+57.5 - STA. 34+95.0 LT

621.52 TRAILING END TERMINAL

RUTLAND TOWN: 29+88 - STA. 30+02 LT  
STA. 30+06.0 - STA. 30+20.0 LT

621.80 REMOVAL AND DISPOSAL OF GUARDRAIL

RUTLAND TOWN:  
STA. 30+08.0 - STA. 34+86.0 LT (478 LF)

676.10 DELINEATORS WITH STEEL POSTS

TYPE I WHITE      TYPE I AMBER      TYPE II WHITE

RUTLAND TOWN:  
STA. 21+12.0 LT      STA. 21+12.0 RT      STA. 22+75.0 LT  
STA. 23+04.0 LT      STA. 23+76.0 RT      STA. 23+75.0 LT  
STA. 31+68.0 LT      STA. 26+40.0 RT      STA. 24+75.0 LT  
STA. 34+32.0 LT      STA. 28+04.0 RT      STA. 25+75.0 LT  
STA. 34+95.0 LT      STA. 31+68.0 RT      STA. 26+75.0 LT  
STA. 34+32.0 RT

SIGN LEGEND  
R = REMOVE  
S = SALVAGE  
N = NEW  
RET = RETAIN  
B-B = BACK TO BACK  
EXISTING = -----  
NEW = \_\_\_\_\_

|                  |                      |     |          |
|------------------|----------------------|-----|----------|
| PAVEMENT CORES = |                      |     |          |
| No.              | TOTAL DEPTH (Inches) | PCC | COMMENTS |
| 9                | 1,625                | N0  | -        |

|                          |                                                                                                     |                                                                                 |
|--------------------------|-----------------------------------------------------------------------------------------------------|---------------------------------------------------------------------------------|
| PROJECT LAYOUT SHEET #23 | PROJECT NAME: WALLINGFORD - RUTLAND TOWN                                                            |                                                                                 |
|                          | PROJECT NUMBER: NH 2408(1)S                                                                         |                                                                                 |
|                          | FILE NAME: p04b050.dgn<br>PROJECT LEADER: D.E.G.<br>DESIGNED BY: J.S.P.<br>IPARM FILE: p04b050L23.1 | PLOT DATE: \$DATE\$<br>DRAWN BY: C.A.K.<br>CHECKED BY: D.E.G.<br>SHEET 35 OF 80 |



CLARENDON:  
STA. 129+65.00 - STA. 134+65.00 EDGE LINE LT (PARKING AREA)  
STA. 130+45.00 - STA. 134+10.00 EDGE LINE LT (MAINLINE)  
STA. 131+30.00 - STA. 133+20.00 EDGE LINE LT (PARKING AREA)

CLARENDON:  
STA. 130+45.00 - STA. 131+30.00 EDGE LINE LT  
STA. 133+20.00 - STA. 134+10.00 EDGE LINE LT

CLARENDON:  
STA. 129+65.00 - STA. 130+45.00 EDGE LINE LT  
STA. 134+10.00 - STA. 134+65.00 EDGE LINE LT

CLARENDON:  
STA. 129+65.00 - STA. 134+65.00 EDGE LINE LT (PARKING AREA)  
STA. 130+45.00 - STA. 134+10.00 EDGE LINE LT (MAINLINE)  
STA. 131+30.00 - STA. 133+20.00 EDGE LINE LT (PARKING AREA)

CLARENDON:  
STA. 130+45.00 - STA. 131+30.00 EDGE LINE LT  
STA. 133+20.00 - STA. 134+10.00 EDGE LINE LT

CLARENDON:  
STA. 129+65.00 - STA. 130+45.00 EDGE LINE LT  
STA. 134+10.00 - STA. 134+65.00 EDGE LINE LT

AS SHOWN - 16



SIGN LEGEND  
R = REMOVE  
S = SALVAGE  
N = NEW  
RET = RETAIN  
B-B = BACK TO BACK  
EXISTING = -----  
NEW = \_\_\_\_\_

|                                          |                                                                                                     |                                                                                 |
|------------------------------------------|-----------------------------------------------------------------------------------------------------|---------------------------------------------------------------------------------|
| <b>PARKING<br/>AREA<br/>DETAIL SHEET</b> | PROJECT NAME: WALLINGFORD - RUTLAND TOWN<br>PROJECT NUMBER: NH 2408(I)S                             |                                                                                 |
|                                          | FILE NAME: p04b050.dgn<br>PROJECT LEADER: D.E.G.<br>DESIGNED BY: J.S.P.<br>IPARM FILE: p04b050pad.I | PLOT DATE: \$DATE\$<br>DRAWN BY: C.A.K.<br>CHECKED BY: D.E.G.<br>SHEET 36 OF 80 |




678.22 VEHICLE LOOP DETECTOR

LOOP 2A - ~~54 FT~~ 52.5 FT  
LOOP 2B - ~~54 FT~~ 52.5 FT  
LOOP 2C - ~~38 FT~~ 40.5 FT  
LOOP 2D - ~~41 FT~~ 40.5 FT

|                        |          |          |      |          |       |           | TEST RESULTS AT JUNCTION BOX |          |                      |          |                   | TEST RESULTS AT CONTROLLER (FUTURE USE)** |          |                      |          |                   |
|------------------------|----------|----------|------|----------|-------|-----------|------------------------------|----------|----------------------|----------|-------------------|-------------------------------------------|----------|----------------------|----------|-------------------|
| VEHICLE LOOP DETECTORS |          |          |      |          |       |           | INDUCTANCE (uH)              |          | RESISTANCE Ω @ 25° C |          | (MΩ)              | INDUCTANCE (uH)                           |          | RESISTANCE Ω @ 25° C |          | (MΩ)              |
| LANE                   | LOOP NO. | SIZE     | TYPE | NO TURNS | MODE  | AMP       | CALCULATED                   | MEASURED | CALCULATED           | MEASURED | LEAKAGE TO GROUND | CALCULATED                                | MEASURED | CALCULATED           | MEASURED | LEAKAGE TO GROUND |
| NB LT                  | 1        | EXISTING | QUAD |          |       |           |                              |          |                      |          |                   |                                           |          |                      |          |                   |
| SB TH                  | 2A       | EXISTING | QUAD |          |       |           |                              |          |                      |          |                   |                                           |          |                      |          |                   |
| SB TH                  | 2A       | EXISTING | QUAD |          |       |           |                              |          |                      |          |                   |                                           |          |                      |          |                   |
| SB TH                  | 2A       | 6' x 6'  | RECT | 3        | PULSE | NON-DELAY | 91                           |          | 0.23                 |          |                   | 237                                       |          | 2.13                 |          |                   |
| SB TH                  | 2B       | 6' x 6'  | RECT | 3        | PULSE | NON-DELAY | 92                           |          | 0.24                 |          |                   | 194                                       |          | 1.56                 |          |                   |
| SB TH                  | 2C       | 6' x 6'  | RECT | 3        | PULSE | NON-DELAY | 87                           |          | 0.18                 |          |                   | 234                                       |          | 2.08                 |          |                   |
| SB TH                  | 2D       | 6' x 6'  | RECT | 3        | PULSE | NON-DELAY | 88                           |          | 0.19                 |          |                   | 190                                       |          | 1.52                 |          |                   |
| EB TH                  | 4        | EXISTING | QUAD |          |       |           |                              |          |                      |          |                   |                                           |          |                      |          |                   |
| EB TH                  | 4A       | EXISTING | RECT |          |       |           |                              |          |                      |          |                   |                                           |          |                      |          |                   |
| SB LT                  | 5        | EXISTING | QUAD |          |       |           |                              |          |                      |          |                   |                                           |          |                      |          |                   |
| NB TH                  | 6A       | EXISTING | QUAD |          |       |           |                              |          |                      |          |                   |                                           |          |                      |          |                   |
| NB TH                  | 6A       | EXISTING | QUAD |          |       |           |                              |          |                      |          |                   |                                           |          |                      |          |                   |
| NB TH                  | 6A       | EXISTING | RECT |          |       |           |                              |          |                      |          |                   |                                           |          |                      |          |                   |
| NB TH                  | 6B       | EXISTING | RECT |          |       |           |                              |          |                      |          |                   |                                           |          |                      |          |                   |
| NB TH                  | 6C       | EXISTING | RECT |          |       |           |                              |          |                      |          |                   |                                           |          |                      |          |                   |
| NB TH                  | 6D       | EXISTING | RECT |          |       |           |                              |          |                      |          |                   |                                           |          |                      |          |                   |

\*MEASURED VALUES MUST BE FILLED IN PRIOR TO TEST PERIOD.

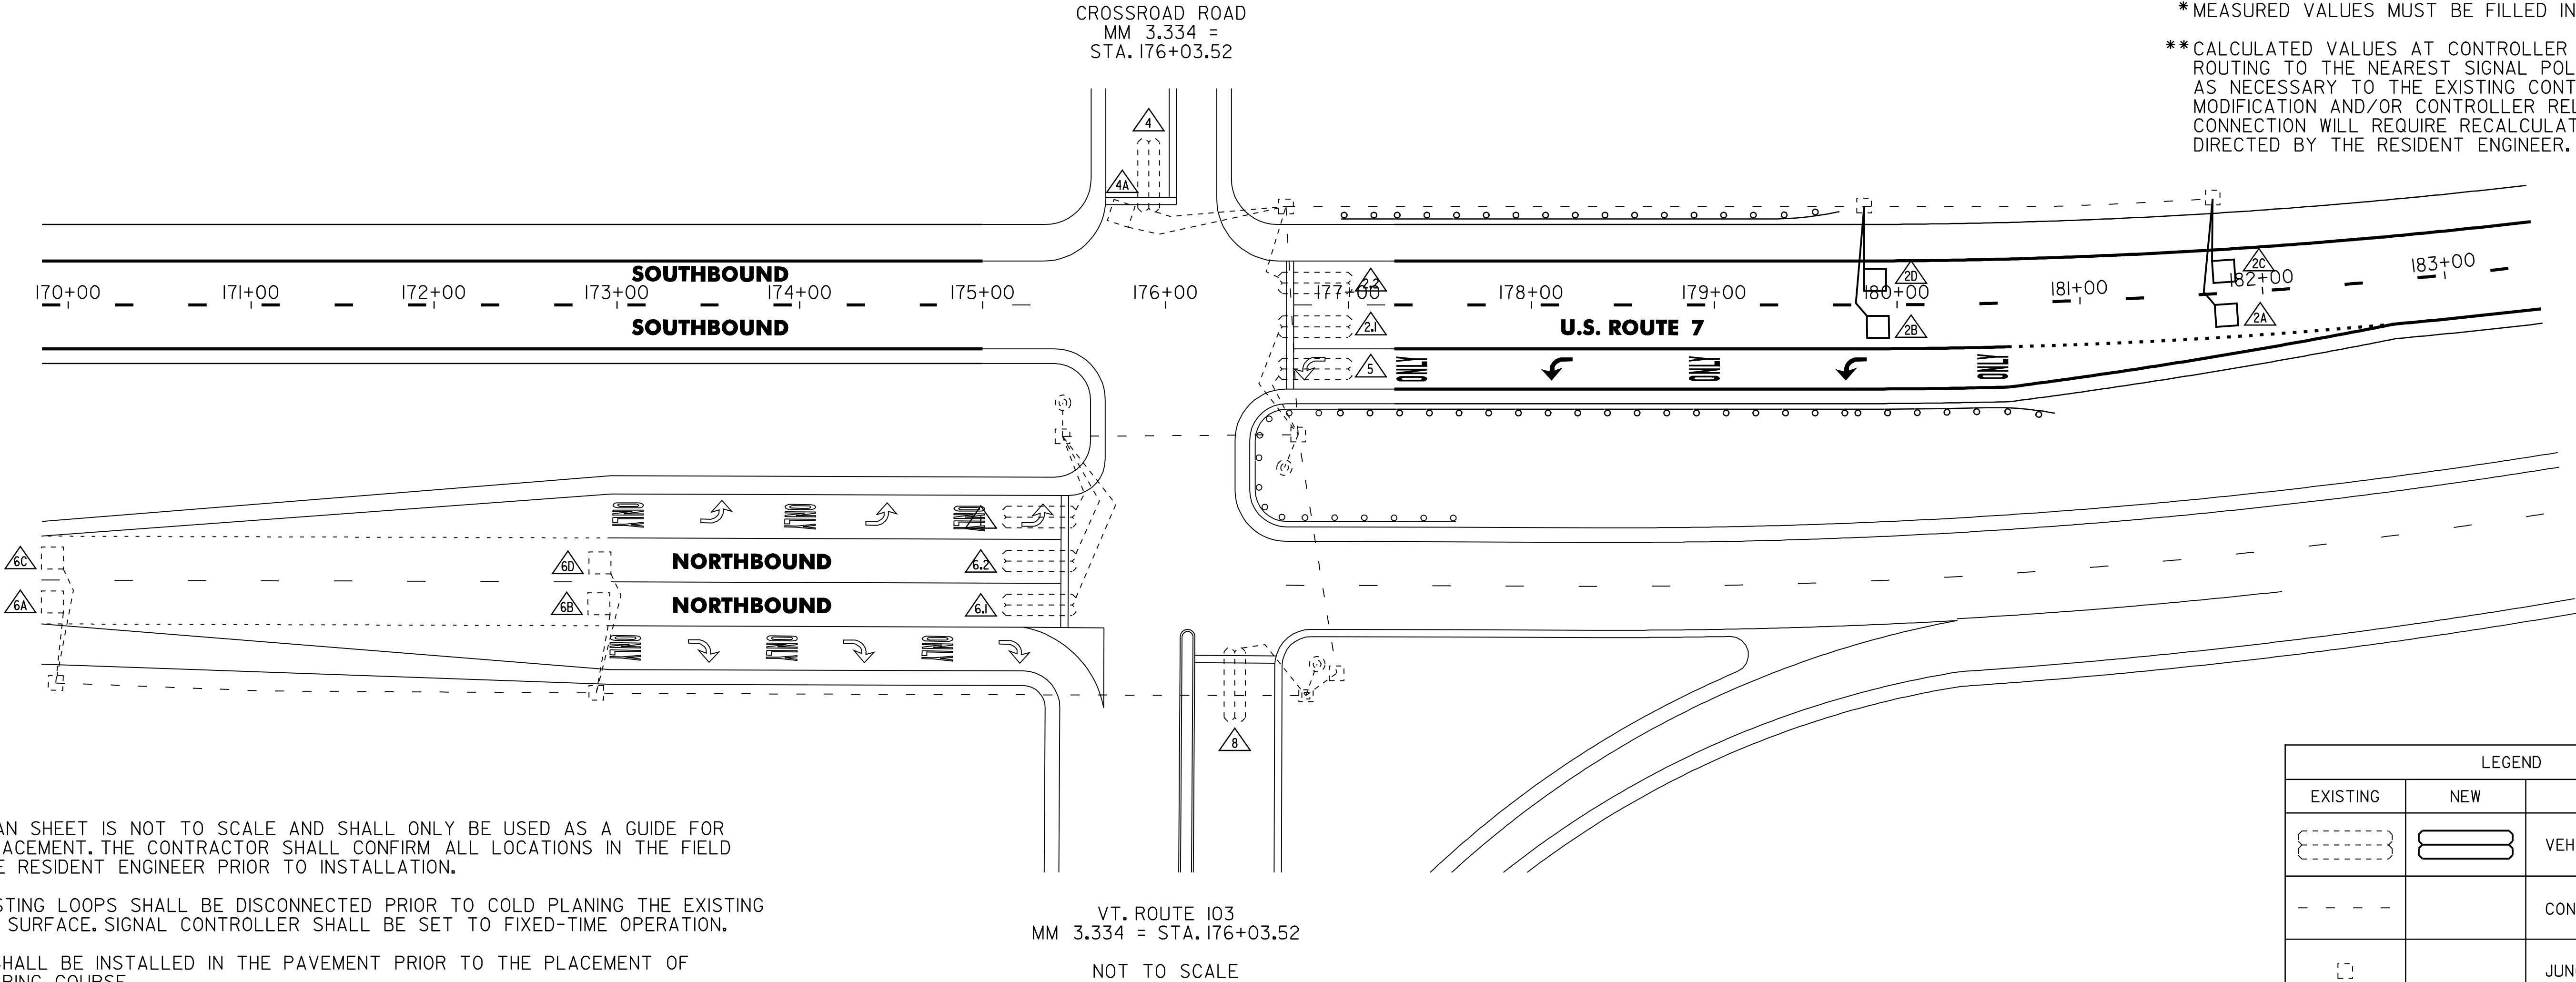\*\*CALCULATED VALUES AT CONTROLLER ARE BASED ON DIRECT CONDUIT ROUTING TO THE NEAREST SIGNAL POLE AND CROSSING THE SPAN WIRE AS NECESSARY TO THE EXISTING CONTROLLER LOCATION. ANY SIGNAL MODIFICATION AND/OR CONTROLLER RELOCATION PRIOR TO LOOP CONNECTION WILL REQUIRE RECALCULATION OF THESE VALUES AS DIRECTED BY THE RESIDENT ENGINEER.



NOTES:

- THIS PLAN SHEET IS NOT TO SCALE AND SHALL ONLY BE USED AS A GUIDE FOR LOOP PLACEMENT. THE CONTRACTOR SHALL CONFIRM ALL LOCATIONS IN THE FIELD WITH THE RESIDENT ENGINEER PRIOR TO INSTALLATION.
- ALL EXISTING LOOPS SHALL BE DISCONNECTED PRIOR TO COLD PLANING THE EXISTING HIGHWAY SURFACE. SIGNAL CONTROLLER SHALL BE SET TO FIXED-TIME OPERATION.
- LOOPS SHALL BE INSTALLED IN THE PAVEMENT PRIOR TO THE PLACEMENT OF THE WEARING COURSE.
- LOOP WIRE SHALL BE SPLICED TO THE EXISTING LEAD-IN CABLE AT THE NEAREST JUNCTION BOX/POLE.
- LOOPS 2B & 2D SHALL BE PLACED APPROXIMATELY 250 FT FROM STOP BAR AND LOOPS 2A & 2C SHALL BE PLACED APPROXIMATELY 420 FT FROM STOP BAR. EXACT LOCATION OF EXISTING LOOPS SHALL BE CONFIRMED IN THE FIELD.
- IF WATER VALVES, DROP INLETS OR OTHER OBSTRUCTIONS ARE ENCOUNTERED WITHIN THE AREA OF A PROPOSED LOOP, THE CONTRACTOR SHALL TAKE SPECIAL CARE TO AVOID THE OBSTRUCTION DURING LOOP INSTALLATION. IF LOOP SIZES OR SHAPES ARE TO BE MODIFIED DUE TO OBSTRUCTIONS THE RESIDENT ENGINEER MUST APPROVE THE NEW LAYOUT PRIOR TO INSTALLATION.
- SEE VAOT STANDARD E-I72 FOR VEHICLE DETECTOR LOOP DETAILS.

| LEGEND   |     |                    |
|----------|-----|--------------------|
| EXISTING | NEW | DESCRIPTION        |
|          |     | VEHICLE LOOP       |
|          |     | CONDUIT            |
|          |     | JUNCTION BOX       |
|          |     | CONTROLLER CABINET |
|          |     | SIGNAL POLE        |

TRAFFIC  
LOOP  
LAYOUT  
SHEET #1

PROJECT NAME: WALLINGFORD - RUTLAND TOWN

PROJECT NUMBER: NH 2408(1)S

FILE NAME: p04b050.dgn

PROJECT LEADER: D.E.G.

DESIGNED BY: J.S.P.

IPARM FILE: p04b050+lp01.i

PLOT DATE: \$DATE\$

DRAWN BY: C.A.K.

CHECKED BY: D.E.G.

SHEET 37 OF 80



678.22 VEHICLE LOOP DETECTOR


LOOP 1 - 172 FT 173.5 FT  
LOOP 4 - 148 FT  
~~LOOP 6 - 72 FT~~  
LOOP 6A - 40 FT  
LOOP 6B - 49 FT

| VEHICLE LOOP DETECTORS |          |          |      |          |          |           | TEST RESULTS AT JUNCTION BOX |          |                     |          |                   | TEST RESULTS AT CONTROLLER (FUTURE USE)** |          |                     |          |                   |
|------------------------|----------|----------|------|----------|----------|-----------|------------------------------|----------|---------------------|----------|-------------------|-------------------------------------------|----------|---------------------|----------|-------------------|
|                        |          |          |      |          |          |           | INDUCTANCE (uH)              |          | RESISTANCE Ω @ 25°C |          | (MΩ)              | INDUCTANCE (uH)                           |          | RESISTANCE Ω @ 25°C |          | (MΩ)              |
| LANE                   | LOOP NO. | SIZE     | TYPE | NO TURNS | MODE     | AMP       | CALCULATED                   | MEASURED | CALCULATED          | MEASURED | LEAKAGE TO GROUND | CALCULATED                                | MEASURED | CALCULATED          | MEASURED | LEAKAGE TO GROUND |
| SB LT                  | △1       | 6' x 40' | QUAD | 2        | PRESENCE | NON-DELAY | 350                          |          | 0.71                |          |                   | 361                                       |          | 0.86                |          |                   |
| NB TH                  | △2       | EXISTING | RECT |          |          |           |                              |          |                     |          |                   |                                           |          |                     |          |                   |
| EB TH                  | △4       | 6' x 40' | QUAD | 2        | PRESENCE | NON-DELAY | 344                          |          | 0.63                |          |                   | 349                                       |          | 0.70                |          |                   |
| NB LT                  | △5       | EXISTING | QUAD |          |          |           |                              |          |                     |          |                   |                                           |          |                     |          |                   |
| SB TH                  | △6       | 6' x 20' | RECT | 3        | PULSE    | NON-DELAY | 183                          |          | 0.11                |          |                   | 291                                       |          | 1.78                |          |                   |
| WB TH                  | △8       | EXISTING | QUAD |          |          |           |                              |          |                     |          |                   |                                           |          |                     |          |                   |

SB TL △6A 6' x 6'  
SB PL △6B 6' x 6'

\*MEASURED VALUES MUST BE FILLED IN PRIOR TO TEST PERIOD.

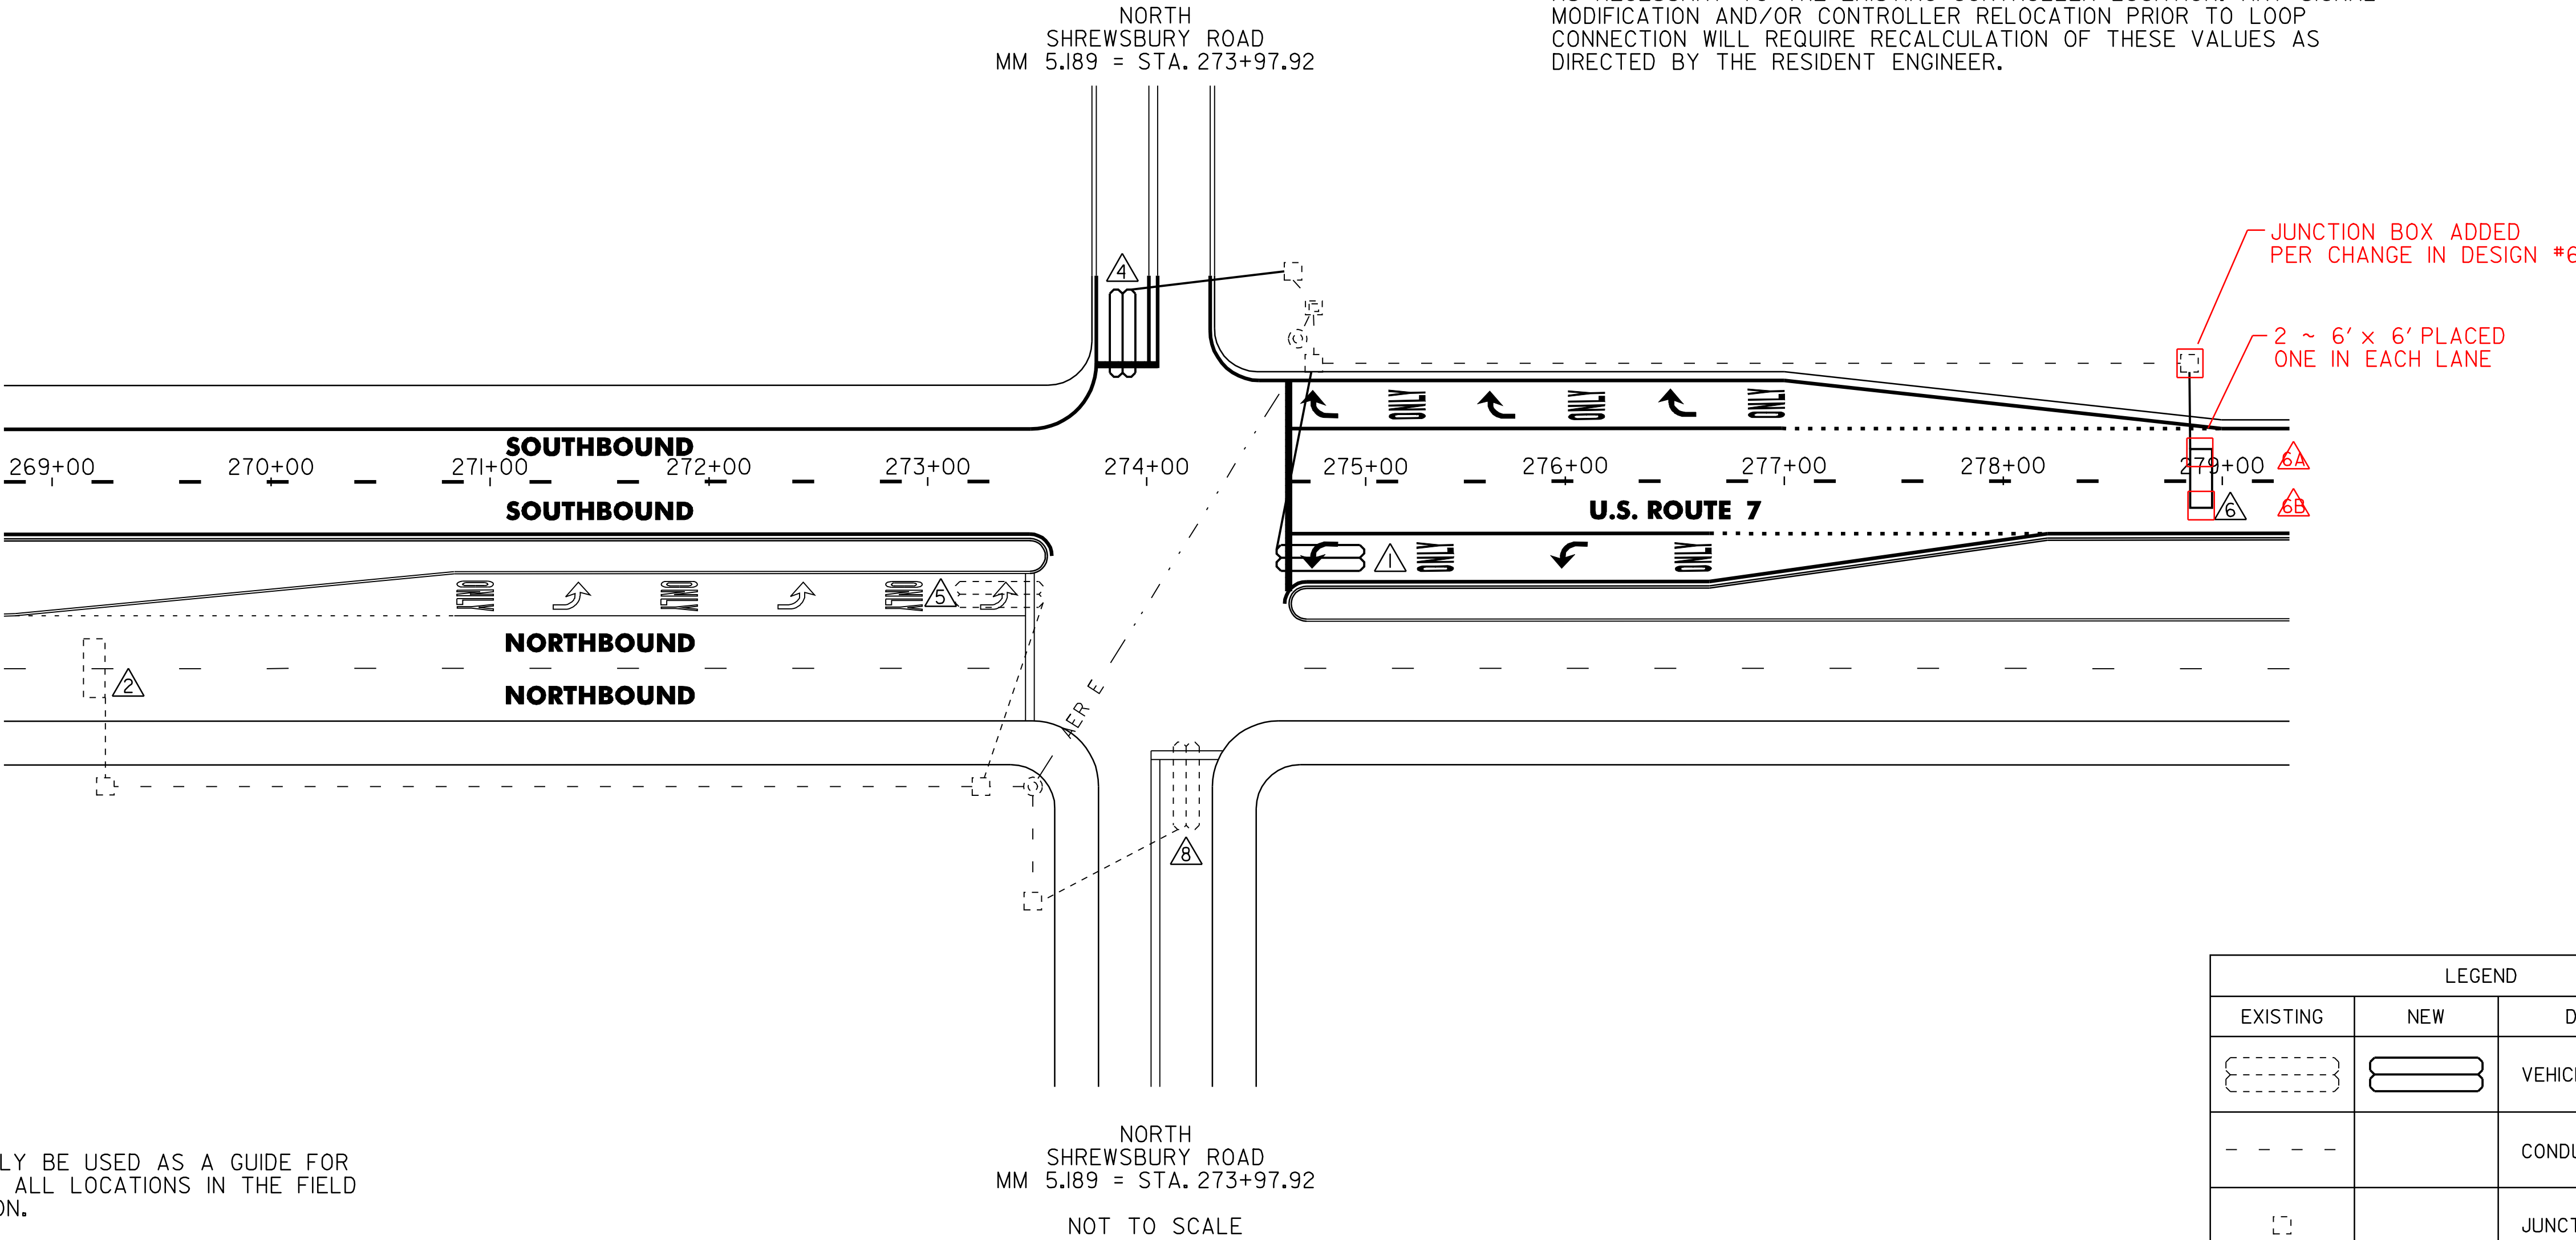\*\*CALCULATED VALUES AT CONTROLLER ARE BASED ON DIRECT CONDUIT ROUTING TO THE NEAREST SIGNAL POLE AND CROSSING THE SPAN WIRE AS NECESSARY TO THE EXISTING CONTROLLER LOCATION. ANY SIGNAL MODIFICATION AND/OR CONTROLLER RELOCATION PRIOR TO LOOP CONNECTION WILL REQUIRE RECALCULATION OF THESE VALUES AS DIRECTED BY THE RESIDENT ENGINEER.



NOTES:

- THIS PLAN SHEET IS NOT TO SCALE AND SHALL ONLY BE USED AS A GUIDE FOR LOOP PLACEMENT. THE CONTRACTOR SHALL CONFIRM ALL LOCATIONS IN THE FIELD WITH THE RESIDENT ENGINEER PRIOR TO INSTALLATION.
- ALL EXISTING LOOPS SHALL BE DISCONNECTED PRIOR TO COLD PLANING THE EXISTING HIGHWAY SURFACE. SIGNAL CONTROLLER SHALL BE SET TO FIXED-TIME OPERATION.
- LOOP 6 SHALL BE PLACED APPROXIMATELY 400 FT FROM STOP BAR. EXACT LOCATION OF EXISTING LOOP SHALL BE CONFIRMED IN THE FIELD. ALL REMAINING LOOPS SHALL EXTEND 5.0 FT PAST THE CENTER OF THE STOP BAR ON EACH APPROACH.
- LOOPS SHALL BE INSTALLED IN THE PAVEMENT PRIOR TO THE PLACEMENT OF THE WEARING COURSE.
- LOOP WIRE SHALL BE SPLICED TO THE EXISTING LEAD-IN CABLE AT THE NEAREST JUNCTION BOX/POLE.
- IF WATER VALVES, DROP INLETS OR OTHER OBSTRUCTIONS ARE ENCOUNTERED WITHIN THE AREA OF A PROPOSED LOOP, THE CONTRACTOR SHALL TAKE SPECIAL CARE TO AVOID THE OBSTRUCTION DURING LOOP INSTALLATION. IF LOOP SIZES OR SHAPES ARE TO BE MODIFIED DUE TO OBSTRUCTIONS THE RESIDENT ENGINEER MUST APPROVE THE NEW LAYOUT PRIOR TO INSTALLATION.
- SEE VAOT STANDARD E-172 FOR VEHICLE DETECTOR LOOP DETAILS. EACH APPROACH.

| LEGEND   |     |                    |
|----------|-----|--------------------|
| EXISTING | NEW | DESCRIPTION        |
| {-----}  | ==  | VEHICLE LOOP       |
| - - - -  |     | CONDUIT            |
| [ ]      |     | JUNCTION BOX       |
| [ ]      |     | CONTROLLER CABINET |
| ( )      |     | SIGNAL POLE        |

| TRAFFIC<br>LOOP<br>LAYOUT<br>SHEET #2 | PROJECT NAME: WALLINGFORD - RUTLAND TOWN                                                              |                                                                                 |
|---------------------------------------|-------------------------------------------------------------------------------------------------------|---------------------------------------------------------------------------------|
|                                       | PROJECT NUMBER: NH 2408(1)S                                                                           |                                                                                 |
|                                       | FILE NAME: p04b050.dgn<br>PROJECT LEADER: D.E.G.<br>DESIGNED BY: J.S.P.<br>IPARM FILE: p04b050+lp02.i | PLOT DATE: \$DATE\$<br>DRAWN BY: C.A.K.<br>CHECKED BY: D.E.G.<br>SHEET 38 OF 80 |




678.22 VEHICLE LOOP DETECTOR

LOOP 1 - ~~148 FT~~ 168 FT  
LOOP 4 - 142 FT  
LOOP 1A - 106 FT  
LOOP 4A - 39.5 FT

| VEHICLE LOOP DETECTORS |          |          |      |          |          |           | TEST RESULTS AT JUNCTION BOX |          |                      |          |                   | TEST RESULTS AT CONTROLLER (FUTURE USE)** |          |                      |          |                   |
|------------------------|----------|----------|------|----------|----------|-----------|------------------------------|----------|----------------------|----------|-------------------|-------------------------------------------|----------|----------------------|----------|-------------------|
|                        |          |          |      |          |          |           | INDUCTANCE (uH)              |          | RESISTANCE Ω @ 25° C |          | (MΩ)              | INDUCTANCE (uH)                           |          | RESISTANCE Ω @ 25° C |          | (MΩ)              |
| LANE                   | LOOP NO. | SIZE     | TYPE | NO TURNS | MODE     | AMP       | CALCULATED                   | MEASURED | CALCULATED           | MEASURED | LEAKAGE TO GROUND | CALCULATED                                | MEASURED | CALCULATED           | MEASURED | LEAKAGE TO GROUND |
| SB LT                  | 1        | 6' x 40' | QUAD | 2        | PRESENCE | NON-DELAY | 342                          |          | 0.61                 |          |                   | 418                                       |          | 1.59                 |          |                   |
| EB TH                  | 4        | 6' x 40' | QUAD | 2        | PRESENCE | NON-DELAY | 341                          |          | 0.59                 |          |                   | 347                                       |          | 0.67                 |          |                   |
| NB LT                  | 5        | EXISTING | QUAD |          |          |           |                              |          |                      |          |                   |                                           |          |                      |          |                   |
| WB LT/TH               | 8        | EXISTING | QUAD |          |          |           |                              |          |                      |          |                   |                                           |          |                      |          |                   |
| WB RT                  | 8A       | EXISTING | QUAD |          |          |           |                              |          |                      |          |                   |                                           |          |                      |          |                   |
| SB LT                  | 1A       | 6' x 30' |      |          |          |           |                              |          |                      |          |                   |                                           |          |                      |          |                   |
| EB RT                  | 4A       | 6' x 6'  |      |          |          |           |                              |          |                      |          |                   |                                           |          |                      |          |                   |

\* MEASURED VALUES MUST BE FILLED IN PRIOR TO TEST PERIOD.

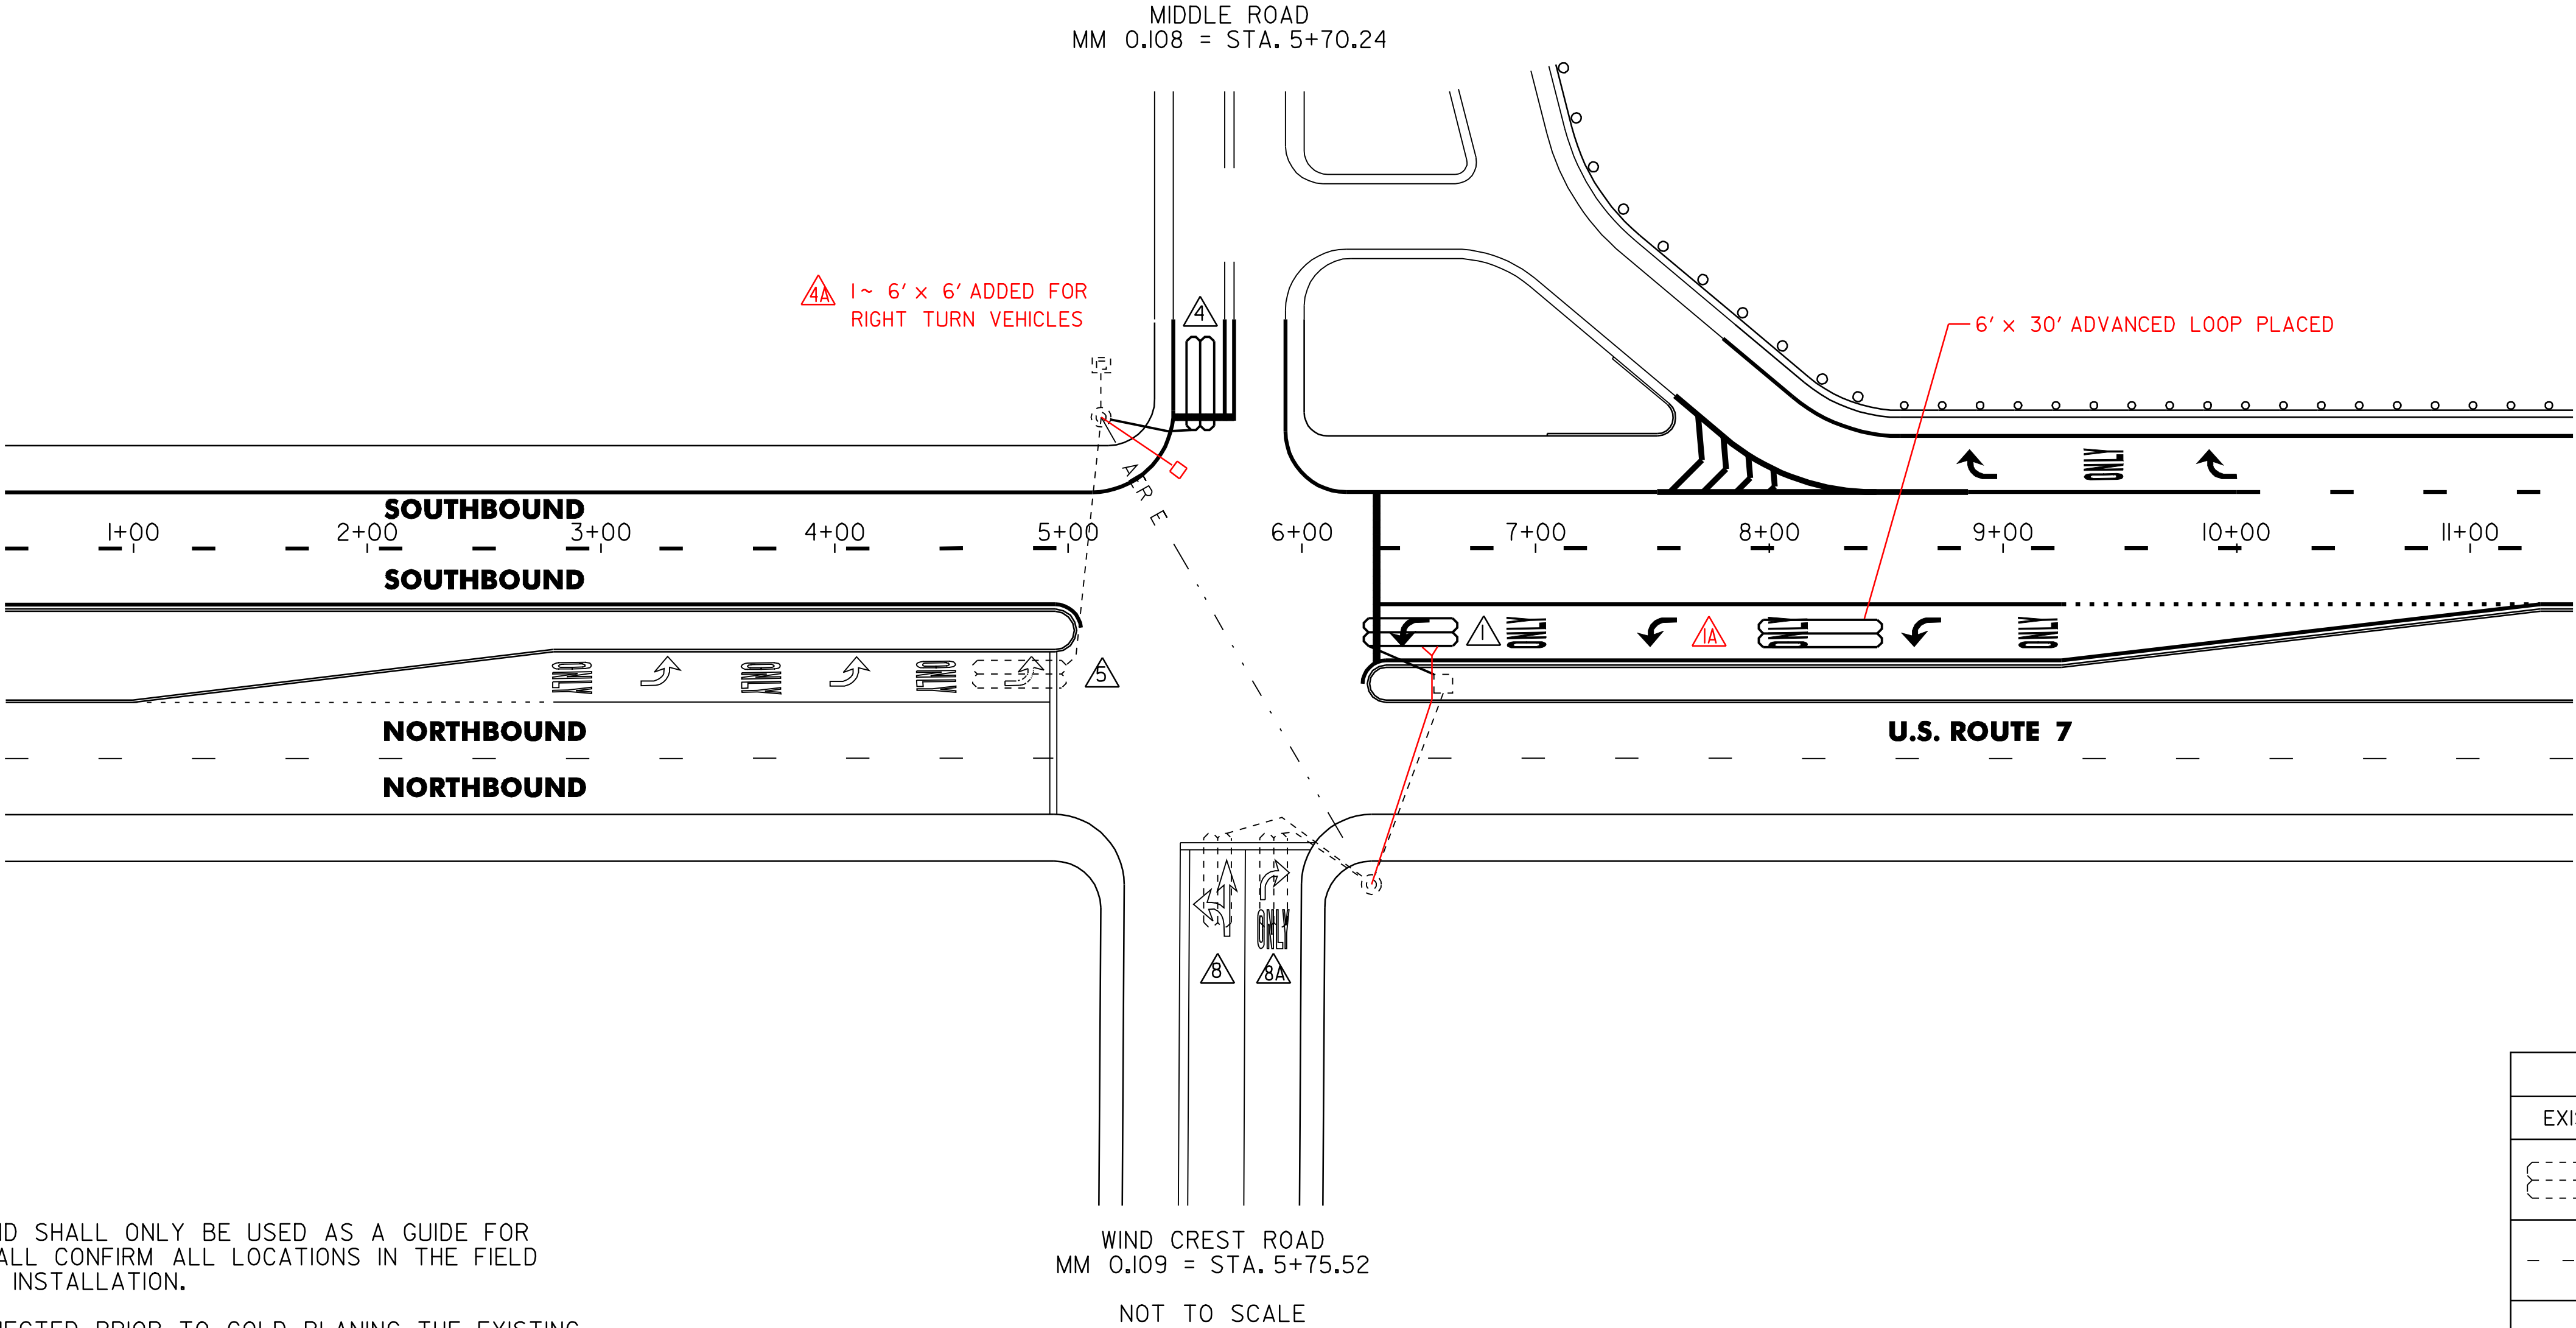\*\* CALCULATED VALUES AT CONTROLLER ARE BASED ON DIRECT CONDUIT ROUTING TO THE NEAREST SIGNAL POLE AND CROSSING THE SPAN WIRE AS NECESSARY TO THE EXISTING CONTROLLER LOCATION. ANY SIGNAL MODIFICATION AND/OR CONTROLLER RELOCATION PRIOR TO LOOP CONNECTION WILL REQUIRE RECALCULATION OF THESE VALUES AS DIRECTED BY THE RESIDENT ENGINEER.



TRAFFIC  
LOOP  
LAYOUT  
SHEET #3

PROJECT NAME: WALLINGFORD - RUTLAND TOWN  
PROJECT NUMBER: NH 2408(1)S

FILE NAME: p04b050.dgn  
PROJECT LEADER: D.E.G.  
DESIGNED BY: J.S.P.  
IPARM FILE: p04b050+lp03.i

PLOT DATE: \$DATE\$  
DRAWN BY: C.A.K.  
CHECKED BY: D.E.G.  
SHEET 39 OF 80




678.22 VEHICLE LOOP DETECTOR  
LOOP 1    - ~~177 FT~~ 178 FT

| VEHICLE LOOP DETECTORS |          |          |      |          |          |           | TEST RESULTS AT JUNCTION BOX |          |                      |          |                   | TEST RESULTS AT CONTROLLER (FUTURE USE)** |          |                      |          |                   |
|------------------------|----------|----------|------|----------|----------|-----------|------------------------------|----------|----------------------|----------|-------------------|-------------------------------------------|----------|----------------------|----------|-------------------|
|                        |          |          |      |          |          |           | INDUCTANCE (uH)              |          | RESISTANCE Ω @ 25° C |          | (MΩ)              | INDUCTANCE (uH)                           |          | RESISTANCE Ω @ 25° C |          | (MΩ)              |
| LANE                   | LOOP NO. | SIZE     | TYPE | NO TURNS | MODE     | AMP       | CALCULATED                   | MEASURED | CALCULATED           | MEASURED | LEAKAGE TO GROUND | CALCULATED                                | MEASURED | CALCULATED           | MEASURED | LEAKAGE TO GROUND |
| SB LT                  | △        | 6' x 40' | QUAD | 2        | PRESENCE | NON-DELAY | 349                          |          | 0.70                 |          |                   | 40l                                       |          | 1.38                 |          |                   |
| EB LT                  | △        | EXISTING | QUAD |          |          |           |                              |          |                      |          |                   |                                           |          |                      |          |                   |
| EB LT                  | △A       | EXISTING | QUAD |          |          |           |                              |          |                      |          |                   |                                           |          |                      |          |                   |
| EB TH                  | △B       | EXISTING | QUAD |          |          |           |                              |          |                      |          |                   |                                           |          |                      |          |                   |
| NB LT                  | △S       | EXISTING | QUAD |          |          |           |                              |          |                      |          |                   |                                           |          |                      |          |                   |
| WB LT                  | △8       | EXISTING | QUAD |          |          |           |                              |          |                      |          |                   |                                           |          |                      |          |                   |
| WB TH                  | △A       | EXISTING | QUAD |          |          |           |                              |          |                      |          |                   |                                           |          |                      |          |                   |

\*MEASURED VALUES MUST BE FILLED IN PRIOR TO TEST PERIOD.

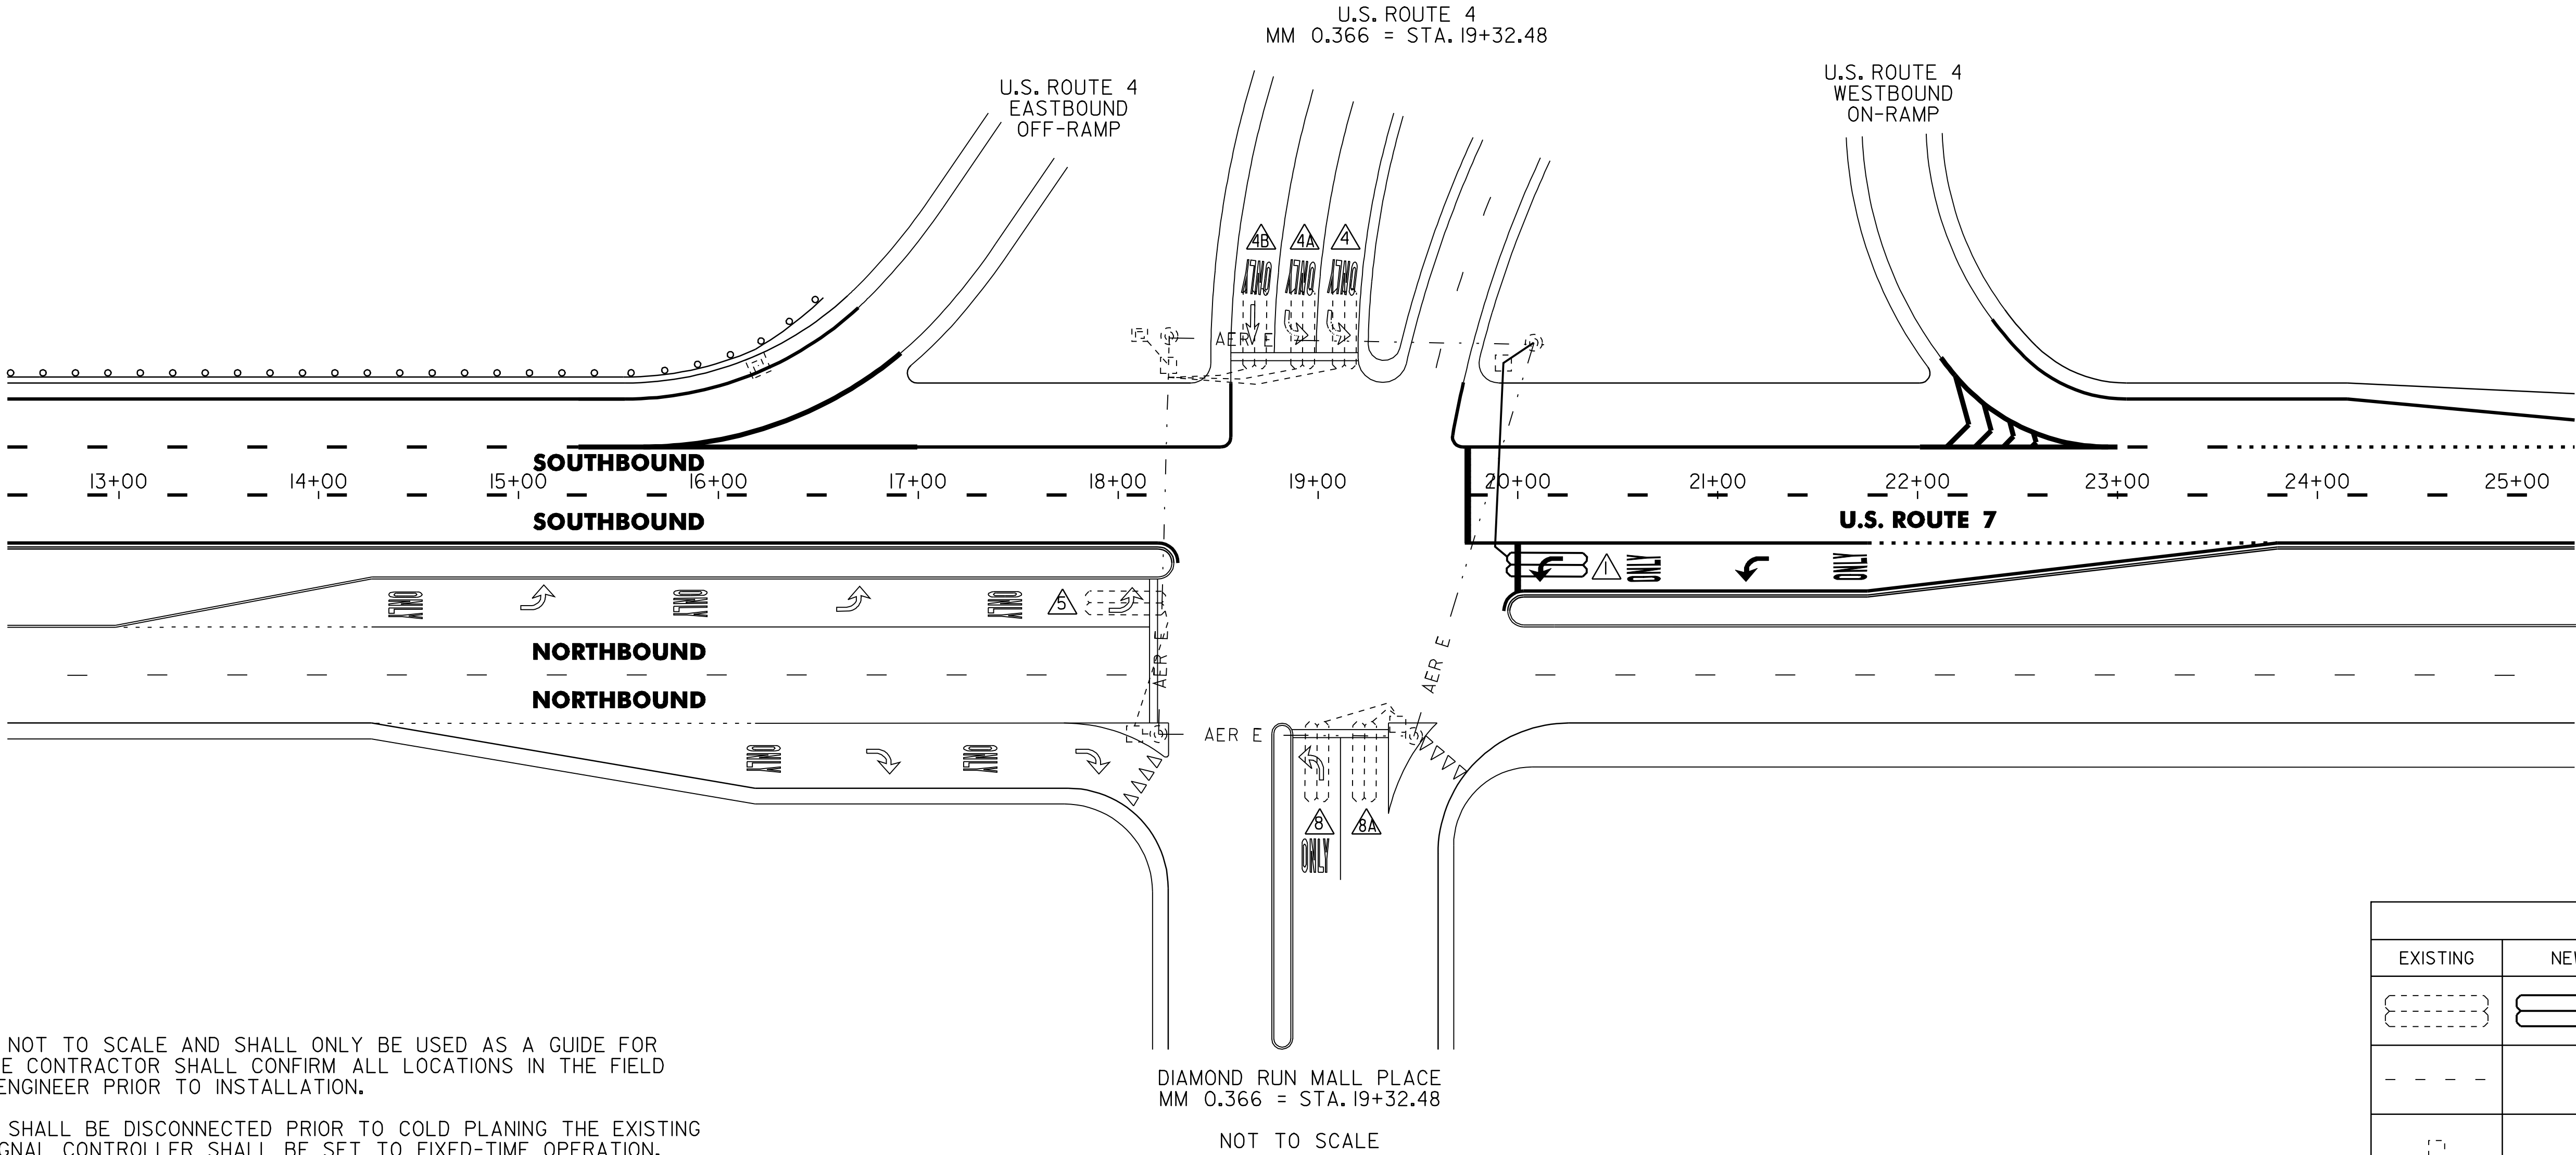\*\*CALCULATED VALUES AT CONTROLLER ARE BASED ON DIRECT CONDUIT ROUTING TO THE NEAREST SIGNAL POLE AND CROSSING THE SPAN WIRE AS NECESSARY TO THE EXISTING CONTROLLER LOCATION. ANY SIGNAL MODIFICATION AND/OR CONTROLLER RELOCATION PRIOR TO LOOP CONNECTION WILL REQUIRE RECALCULATION OF THESE VALUES AS DIRECTED BY THE RESIDENT ENGINEER.



NOTES:

1. THIS PLAN SHEET IS NOT TO SCALE AND SHALL ONLY BE USED AS A GUIDE FOR LOOP PLACEMENT. THE CONTRACTOR SHALL CONFIRM ALL LOCATIONS IN THE FIELD WITH THE RESIDENT ENGINEER PRIOR TO INSTALLATION.
2. ALL EXISTING LOOPS SHALL BE DISCONNECTED PRIOR TO COLD PLANING THE EXISTING HIGHWAY SURFACE. SIGNAL CONTROLLER SHALL BE SET TO FIXED-TIME OPERATION.
3. ALL LOOPS WILL EXTEND 5.0 FT PAST THE CENTER OF THE STOP BAR ON EACH APPROACH.
4. LOOPS SHALL BE INSTALLED IN THE PAVEMENT PRIOR TO THE PLACEMENT OF THE WEARING COURSE.
5. LOOP WIRE SHALL BE SPLICED TO THE EXISTING LEAD-IN CABLE AT THE NEAREST JUNCTION BOX/POLE.
6. IF WATER VALVES, DROP INLETS OR OTHER OBSTRUCTIONS ARE ENCOUNTERED WITHIN THE AREA OF A PROPOSED LOOP, THE CONTRACTOR SHALL TAKE SPECIAL CARE TO AVOID THE OBSTRUCTION DURING LOOP INSTALLATION. IF LOOP SIZES OR SHAPES ARE TO BE MODIFIED DUE TO OBSTRUCTIONS THE RESIDENT ENGINEER MUST APPROVE THE NEW LAYOUT PRIOR TO INSTALLATION.
7. SEE VAOT STANDARD E-172 FOR VEHICLE DETECTOR LOOP DETAILS.

| LEGEND   |     |                    |
|----------|-----|--------------------|
| EXISTING | NEW | DESCRIPTION        |
| { }      | ▬▬  | VEHICLE LOOP       |
| - - - -  |     | CONDUIT            |
| □        |     | JUNCTION BOX       |
| ▭        |     | CONTROLLER CABINET |
| ○        |     | SIGNAL POLE        |

TRAFFIC  
LOOP  
LAYOUT  
SHEET #4




PROJECT NAME: WALLINGFORD - RUTLAND TOWN  
PROJECT NUMBER: NH 2408(1)S

FILE NAME: p04b050.dgn  
PROJECT LEADER: D.E.G.  
DESIGNED BY: J.S.P.  
IPARM FILE: p04b050+lp04.i

PLOT DATE: \$DATE\$  
DRAWN BY: C.A.K.  
CHECKED BY: D.E.G.  
SHEET 40 OF 80



# TRAFFIC SIGN SUMMARY SHEET 1
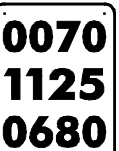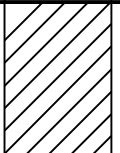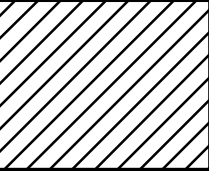
| MILEMARKER,<br>STATION,<br>OR<br>SIGN NUMBER                                                                                                                                                                        | SIGN<br>LEGEND                                                                      | SIGN<br>DIMENSIONS |               |                | NEW & SALVAGED SIGNS |             |              |             | EXIST<br>POST<br>RETAIN | SALVAGE                                                                              | NO.<br>OF<br>POSTS | NEW SIGN POSTS  |                  |                     |                      |     |     |                                                                                       |        |                         |            |                 |     |               |     | REQUIREMENTS |    |  |  |  |                     |                                                                         |       |  |  | SIGN DETAIL |           |       |        |              |
|---|
|                                                                                                                                                                                                                     |                                                                                     |                    |               |                |                      |             |              |             |                         |                                                                                      |                    | FLANGED CHANNEL |                  |                     | SQUARE STEEL<br>(In) |     |     | TUBULAR ALUMINUM<br>Ø (In)                                                            |        | TUBULAR STEEL<br>Ø (In) |            |                 |     | W-SHAPE STEEL |     |              |    |  |  |  |                     |                                                                         |       |  |  |             |           |       |        |              |
|                                                                                                                                                                                                                     |                                                                                     | E<br>A             | WIDTH<br>(In) | HEIGHT<br>(In) | "A"                  | "B"         | SALV<br>SIGN | SALV<br>TIS |                         |                                                                                      |                    | I.12            | 2.0              | 3.0                 | 1.75                 | 2.0 | 2.5 | ANCHOR                                                                                | SLEEVE | 3.0                     | 4.0<br>MOD | FOUND-<br>ATION | 3.0 | 3.5           | 4.0 |              |    |  |  |  |                     |                                                                         |       |  |  | 5.0         | FTG. SIZE |       | WEIGHT | POST<br>SIZE |
|                                                                                                                                                                                                                     |                                                                                     lb/ft     | lb/ft |        |              |
| OPTION ITEMS ( )                                                                                                                                                                                                    | |
| WALLINGFORD:<br>349+22.0, LT                                                                                                                                                                                        |    | I                  | 6             | 10             | 0.42                 |             |              |             |                         |                                                                                      | I                  | X<br>9'         |                  |                     | X                    |     |     | X                                                                                     |        |                         |            |                 |     |               |     |              |    |  |  |  | SIGN ID CODE VD-700 |                                                                         | E-I38 |  |  |             |           |       |        |              |
| |
| 351+50.0, LT                                                                                                                                                                                                        |    | I                  | 48            | 48             | 16.00                |             |              |             |                         |                                                                                      | 2                  |                 |                  | 16'<br>X<br>16'-10" |                      |     |     |                                                                                       |        |                         |            |                 |     |               |     |              |    |  |  |  | SIGN ID CODE W3-5   | 63                                                                      |       |  |  |             |           |       |        |              |
| |
| 353+82.0, LT                                                                                                                                                                                                        |    | I                  | 6             | 8              | 0.33                 |             |              |             |                         |                                                                                      | I                  | X<br>9'         |                  |                     | X                    |     |     | X                                                                                     |        |                         |            |                 |     |               |     |              |    |  |  |  | SIGN ID CODE VD-701 |                                                                         | E-I34 |  |  |             |           |       |        |              |
| 359+78.0, LT                                                                                                                                                                                                        |    | I                  | 6             | 10             | 0.42                 |             |              |             |                         |                                                                                      | I                  | X<br>9'         |                  |                     | X                    |     |     | X                                                                                     |        |                         |            |                 |     |               |     |              |    |  |  |  | SIGN ID CODE VD-700 |                                                                         | E-I38 |  |  |             |           |       |        |              |
| |
| 360+50.0, LT                                                                                                                                                                                                        |   | I                  | 48            | 48             | 16.00                |             |              |             |                         |                                                                                      | 2                  |                 |                  | 16'<br>X<br>16'-10" |                      |     |     |                                                                                       |        |                         |            |                 |     |               |     |              |    |  |  |  | SIGN ID CODE W4-2   |                                                                         | E-I51 |  |  |             |           |       |        |              |
| |
| 360+50.0, RT                                                                                                                                                                                                        |  | I                  | 48            | 48             | 16.00                |             |              |             |                         |                                                                                      | 2                  |                 |                  | 16'<br>X<br>16'-7"  |                      |     |     |                                                                                       |        |                         |            |                 |     |               |     |              |    |  |  |  | SIGN ID CODE W4-2   |                                                                         | E-I51 |  |  |             |           |       |        |              |
| |
| 364+50.0, LT                                                                                                                                                                                                        |  | I                  | 48            | 48             | 16.00                |             |              |             |                         |                                                                                      | 2                  |                 |                  | 16'<br>X<br>16'-10" |                      |     |     |                                                                                       |        |                         |            |                 |     |               |     |              |    |  |  |  | SIGN ID CODE W9-1   | 67                                                                      |       |  |  |             |           |       |        |              |
| |
| 364+50.0, RT                                                                                                                                                                                                        |  | I                  | 48            | 48             | 16.00                |             |              |             |                         |                                                                                      | 2                  |                 |                  | 16'<br>X<br>16'-7"  |                      |     |     |                                                                                       |        |                         |            |                 |     |               |     |              |    |  |  |  | SIGN ID CODE W9-1   | 67                                                                      |       |  |  |             |           |       |        |              |
| |
| 370+34.0, LT                                                                                                                                                                                                        |  | I                  | 6             | 10             | 0.42                 |             |              |             |                         |                                                                                      | I                  | X<br>9'         |                  |                     | X                    |     |     | X                                                                                     |        |                         |            |                 |     |               |     |              |    |  |  |  | SIGN ID CODE VD-700 |                                                                         | E-I38 |  |  |             |           |       |        |              |
| FINAL POST LENGTHS ARE TO BE DETERMINED<br>IN THE FIELD. POST SIZES ARE COMPUTED<br>BASED ON INFORMATION FURNISHED ON THE<br>STANDARD SHEETS AND THE TRAFFIC<br>OPERATIONS SECTION *SIGN POST DESIGN<br>GUIDELINE." |                                                                                     |                    |               |                |                      |             |              |             |                         |                                                                                      | LF<br>-<br>(56)    | LF              | LF<br>140<br>(-) | LF<br>-<br>(56)     | LF                   | LF  | LF  |  | EA     | LB                      | LB         | LB              |     | LB            | LB  | LB           | LB |  |  |  |                     | PROJECT NAME: WALLINGFORD - RUTLAND TOWN<br>PROJECT NUMBER: NH 2408(I)S |       |  |  |             |           |       |        |              |
|                                                                                                                                                                                                                     |                                                                                     |                    |               |                | 199.65               |             |              |                                                                                                                                                                                                                     |                                                                                     |                    |               |                | TOTALS               | SF<br>81.59 | SF           | EA.         | SF                      |  | LF<br>140<br>(56)  | LF<br>-<br>(56) |                  |                     | LB                   |     |     | EA.                                                                                   | LB     |                         |            | EA.             | EA. | LB            |     |              |    |  |  |  |                     |                                                                         |       |  |  |             |           |       |        |              |

FILE NAME: p04b050.dgn  
PROJECT LEADER: D.E.G.  
DESIGNED BY: J.S.P.  
IPARM FILE: p04b050+ss01.i

PLOT DATE: \$DATE\$  
DRAWN BY: C.A.K.  
CHECKED BY: D.E.G.  
SHEET 41 OF 80






**STATE OF VERMONT  
AGENCY OF TRANSPORTATION**

# TRAFFIC SIGN SUMMARY SHEET 2
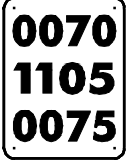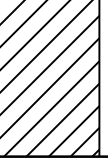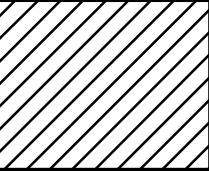
| MILEMARKER,<br>STATION,<br>OR<br>SIGN NUMBER                                                                                                                                                         | SIGN<br>LEGEND | SIGN<br>DIMENSIONS |     |              | NEW & SALVAGED SIGNS |       |      |     | EXIST<br>POST<br>RETAIN | S<br>SALV<br>AGE | NO.<br>OF<br>POSTS | NEW SIGN POSTS  |           |           |           |              |                 |            |     |                  |     |           |               |        |              |      |      | RE<br>Q<br>U<br>I<br>R<br>E<br>D<br>S<br>I<br>G<br>N<br>M<br>E<br>E<br>D        | REMARKS | SIGN DETAIL         |                     |                                                                                                       |                                                                         |                             |
|------------------------------------------------------------------------------------------------------------------------------------------------------------------------------------------------------|----------------|--------------------|-----|--------------|----------------------|-------|------|-----|-------------------------|------------------|--------------------|-----------------|-----------|-----------|-----------|--------------|-----------------|------------|-----|------------------|-----|-----------|---------------|--------|--------------|------|------|---------------------------------------------------------------------------------|---------|---------------------|---------------------|-------------------------------------------------------------------------------------------------------|-------------------------------------------------------------------------|-----------------------------|
|                                                                                                                                                                                                      |                |                    |     |              |                      |       |      |     |                         |                  |                    | FLANGED CHANNEL |           |           |           | SQUARE STEEL |                 |            |     | TUBULAR ALUMINUM |     |           | TUBULAR STEEL |        |              |      |      |                                                                                 |         | W-SHAPE STEEL       |                     |                                                                                                       |                                                                         | DETAIL<br>ON DWG.<br>NUMBER |
|                                                                                                                                                                                                      |                | "A"                | "B" | SALV<br>SIGN | SALV<br>TIS          | lb/ft | (in) |     |                         |                  |                    | ANCHOR          | SLEEVE    | Ø (in)    |           |              | FOUND-<br>ATION | Ø (in)     |     |                  |     | FTG. SIZE |               | WEIGHT | POST<br>SIZE |      |      |                                                                                 |         |                     |                     |                                                                                                       |                                                                         |                             |
|                                                                                                                                                                                                      |                |                    |     |              |                      |       | 1.75 | 2.0 |                         |                  |                    |                 |           | 2.5       | 3.0       | 4.0          |                 | 4.0<br>MOD | 3.0 | 3.5              | 4.0 | 5.0       | 24"           |        |              | 30"  |      |                                                                                 |         |                     |                     |                                                                                                       |                                                                         |                             |
|                                                                                                                                                                                                      |                |                    |     |              |                      |       | 1.12 | 2.0 |                         |                  |                    |                 |           | 3.0       | 1.88      | 2.16         |                 | 3.35       | 1.3 | 1.7              | 1.7 | 7.6       | 9.0           |        |              | 10.8 | 14.6 |                                                                                 |         |                     |                     |                                                                                                       |                                                                         |                             |
| OPTION ITEMS ( )                                                                                                                                                                                     |                |                    | CLARENDON:<br>0+00.0, LT                                                                                                                                                                             |                | I                  | 36  | 24           | 6.00                 |       |      |     |                         |                  | -2'<br>1'          |                 |           | X<br>14'  |           |              |                 |            |     |                  |     |           |               |        |              |      |      |                                                                                 |         |                     | 65                  |                                                                                                       |                                                                         |                             |
|                                                                                                                                                                                                      |                | I                  | 6   | 10           | 0.42                 |       |      SIGN ID CODE VD-700 |                     | E-I38                                                                                                 |                                                                         |                             |
|                                                                                                                                                                                                      |                | I                  | 6   | 10           | 0.42                 |       |      SIGN ID CODE VD-700 |                     | E-I38                                                                                                 |                                                                         |                             |
|                                                                                                                                                                                                      |                | 11+35.0, LT                                                                                                                                                                                          |                | I                  | 6   | 10           | 0.42                 |       |      |     |                         |                  | I                  | X<br>9'         |           | X         |           |              | X               |            |     |                  |     |           |               |        |              |      |      |                                                                                 |         |                     | SIGN ID CODE VD-700 |                                                                                                       | E-I38                                                                   |                             |
|                                                                                                                                                                                                      |                | 11+60.0, LT                                                                                                                                                                                          |                | I                  | 6   | 8            | 0.33                 |       |      |     |                         |                  | I                  | X<br>9'         |           | X         |           |              | X               |            |     |                  |     |           |               |        |              |      |      |                                                                                 |         |                     | SIGN ID CODE VD-701 |                                                                                                       | E-I34                                                                   |                             |
|                                                                                                                                                                                                      |                | 16+70.0, LT                                                                                                                                                                                          |                | I                  | 6   | 8            | 0.33                 |       |      |     |                         |                  | I                  | X<br>9'         |           | X         |           |              | X               |            |     |                  |     |           |               |        |              |      |      |                                                                                 |         |                     | SIGN ID CODE VD-701 |                                                                                                       | E-I34                                                                   |                             |
|                                                                                                                                                                                                      |                | 21+91.0, LT                                                                                                                                                                                          |                | I                  | 6   | 10           | 0.42                 |       |      |     |                         |                  | I                  | X<br>9'         |           | X         |           |              | X               |            |     |                  |     |           |               |        |              |      |      |                                                                                 |         |                     | SIGN ID CODE VD-700 |                                                                                                       | E-I38                                                                   |                             |
|                                                                                                                                                                                                      |                | 32+47.0, LT                                                                                                                                                                                          |                | I                  | 6   | 10           | 0.42                 |       |      |     |                         |                  | I                  | X<br>9'         |           | X         |           |              | X               |            |     |                  |     |           |               |        |              |      |      |                                                                                 |         |                     | SIGN ID CODE VD-700 |                                                                                                       | E-I38                                                                   |                             |
|                                                                                                                                                                                                      |                | 38+56.0, LT                                                                                                                                                                                          |                | I                  | 30  | 15           | 3.13                 |       |      |     |                         |                  | 2                  |                 |           |           |           |              |                 |            |     |                  |     |           |               |        |              |      |      |                                                                                 |         | SIGN ID CODE M3-3   |                     | E-I36A                                                                                                |                                                                         |                             |
|                                                                                                                                                                                                      |                | I                  | 36  | 36           | 9.00                 |       |      SIGN ID CODE MI-4   |                     | E-I36A                                                                                                |                                                                         |                             |
| FINAL POST LENGTHS ARE TO BE DETERMINED IN THE FIELD. POST SIZES ARE COMPUTED BASED ON INFORMATION FURNISHED ON THE STANDARD SHEETS AND THE TRAFFIC OPERATIONS SECTION "SIGN POST DESIGN GUIDELINE." |                |                    |     |              |                      |       |      |     |                         |                  |                    | LF - (70)       | LF        | LF 56 (-) | LF - (70) | LF           | LF              | LF         |     | EA               | LB  | LB        | LB            |        | LB           | LB   | LB   | LB                                                                              |         |                     |                     |                                                                                                       | PROJECT NAME: WALLINGFORD - RUTLAND TOWN<br>PROJECT NUMBER: NH 2408(I)S |                             |
|                                                                                                                                                                                                      |                |                    |     |              |                      |       |      |     |                         |                  |                    | 89.67           |           |           |           |              |                 |            |     |                  |     |           |               |        |              |      |      |                                                                                 |         |                     |                     | FILE NAME: p04b050.dgn<br>PROJECT LEADER: D.E.G.<br>DESIGNED BY: J.S.P.<br>IPARM FILE: p04b050+ss02.i |                                                                         |                             |
|                                                                                                                                                                                                      |                |                    |     |              |                      |       |      |     |                         |                  |                    | LF 56 (70)      | LF - (70) |           |           |              |                 | LB         |     | EA.              | LB  |           |               |        | EA.          | EA.  | LB   | PLOT DATE: \$DATE\$<br>DRAWN BY: C.A.K.<br>CHECKED BY: D.E.G.<br>SHEET 42 OF 80 |         |                     |                     |                                                                                                       |                                                                         |                             |








| STATE OF VERMONT<br>AGENCY OF TRANSPORTATION                                                                                                                                                                        |                                                                                                                                                                                                                                                             |                    |       |       | TRAFFIC SIGN SUMMARY SHEET 3 |             |              |---------------------------------------------------------------------------------------------------------------------------------------------------------------------------------------------------------------------|-------------------------------------------------------------------------------------------------------------------------------------------------------------------------------------------------------------------------------------------------------------|--------------------|-------|-------|------------------------------|-------------|--------------|-------------|---------------|--------------------------------------------------------------------------------------|--------------------|------------------|-----------------|------------------|----------------------|-----------------|-----------------|---------------------------------------------------------------------------------------|----------------------------|-----|----------|-------------------------|-------|-----------|--------------|---------------|------|------|-------------------------------------------------------------------------------------------------------|-------------------|---------------------------------------------------------------------------------|-------------------------|----------------------------------------|--------------------------------------------------------------------------|------------------|---------------------------|
| MILEMARKER,<br>STATION,<br>OR<br>SIGN NUMBER                                                                                                                                                                        | SIGN<br>LEGEND                                                                                                                                                                                                                                              | SIGN<br>DIMENSIONS |       |       | NEW & SALVAGED SIGNS         |             |              |             | EXIST<br>POST |                                                                                      | NEW SIGN POSTS     |                  |                 |                  |                      |                 |                 |                                                                                       |                            |     |          |                         |       |           |              |               |      |      | REMARKS                                                                                               | SIGN DETAIL       |                                                                                 |                         |                                        |                                                                          |                  |                           |
|                                                                                                                                                                                                                     |                                                                                                                                                                                                                                                             |                    |       |       | "A"                          | "B"         | SALV<br>SIGN | SALV<br>TIS | RETAIN        | SALVAGE                                                                              | NO.<br>OF<br>POSTS | FLANGED CHANNEL  |                 |                  | SQUARE STEEL<br>(In) |                 |                 |                                                                                       | TUBULAR ALUMINUM<br>Ø (In) |     |          | TUBULAR STEEL<br>Ø (In) |       |           |              | W-SHAPE STEEL |      |      |                                                                                                       | REQUIRE<br>SIGNED | DETAIL<br>ON DWG.<br>NUMBER                                                     | STD.<br>SHEET<br>NUMBER |                                        |                                                                          |                  |                           |
|                                                                                                                                                                                                                     |                                                                                                                                                                                                                                                             | lb/ft              | lb/ft | lb/ft |                              |             |              |             |               |                                                                                      |                    | ANCHOR           | SLEEVE          | 3.0              | 4.0                  | 4.0<br>MOD      | FOUND-<br>ATION | 3.0                                                                                   | 3.5                        | 4.0 | 5.0      | FTG. SIZE               |       | WEIGHT    | POST<br>SIZE |               |      |      |                                                                                                       |                   |                                                                                 |                         |                                        |                                                                          |                  |                           |
|                                                                                                                                                                                                                     |                                                                                                                                                                                                                                                             1.12                    | 2.0   |           |              | 3.0           | 1.88 | 2.16 |                                                                                                       |                   |                                                                                 |                         | 3.35                                   | 1.3                                                                      | 1.7              | 1.7                       |
|                                                                                                                                                                                                                     |                                                                                                                                                                                                                                                             |                    |       |       |                              |             |              |             |               |                                                                                      |                    | OPTION ITEMS ( ) |                 |                  | CLARENDON:<br>39+44.0, LT                                                                                                                                                                                           |                                                                                           | I                  | 36    | 12    | 3.00                         |             |              |             |               |                                                                                      | 2                  |                  |                 | 14'              |                      |                 |                 |                                                                                       |                            |     |          |                         |       |           |              |               |      |      |                                                                                                       |                   |                                                                                 |                         |                                        | SIGN ID CODE R6-IR<br>SIGN ID CODE R6-IL<br>BACK-TO-BACK                 |                  | E-I42<br>E-I42            |
|                                                                                                                                                                                                                     |                                                                                           | I                  | 30    | 30    | 6.25                         |             |              SIGN ID CODE RI-I<br>SIGN ID CODE VD-700                                 |                  | E-I43<br>E-I38            |
|                                                                                                                                                                                                                     |                                                                                                                                                                            | I                  | 24    | 18    | 3.00                         |             |              SIGN ID CODE R6-3                                                        | 65               |                           |
|                                                                                                                                                                                                                     |                                                                                                                                                                                                                                                             | 39+85.0, LT                                                                                                                                                                                                         |                                                                                                                                                                            | I                  | 24    | 12    | 2.00                         |             |              |             |               |                                                                                      | 1                  |                  |                 | 14'              |                      | X               |                 |                                                                                       | X                          |     |          |                         |       |           |              |               |      |      |                                                                                                       |                   |                                                                                 |                         |                                        | SIGN ID CODE M3-3                                                        |                  | E-I36B                    |
|                                                                                                                                                                                                                     |                                                                                                                                                                            | I                  | 24    | 24    | 4.00                         |             |              SIGN ID CODE MI-5                                                        |                  | E-I36B                    |
|                                                                                                                                                                                                                     |                                                                                                                                                                                                                                                             | 40+04.0, LT                                                                                                                                                                                                         |                                                                                                                                                                            | I                  | 36    | 12    | 3.00                         |             |              |             |               |                                                                                      | 2                  |                  |                 | 14'              |                      | X               |                 |                                                                                       |                            |     |          |                         |       |           |              |               |      |      |                                                                                                       |                   |                                                                                 |                         |                                        | SIGN ID CODE R6-IL                                                       |                  | E-I42                     |
|                                                                                                                                                                                                                     |                                                                                                                                                                          | I                  | 36    | 36    | 9.00                         |             |              SIGN ID CODE R3-I                                                        |                  | E-I43                     |
|                                                                                                                                                                                                                     |                                                                                                                                                                                                                                                             | 40+65.0, LT                                                                                                                                                                                                         |                                                                                       | I                  | 30    | 15    | 3.13                         |             |              |             |               |                                                                                      | 2                  |                  |                 |                  |                      |                 |                 |                                                                                       |                            |     |          | 2                       | 214.7 | 13'-8"    |              |               |      |      |                                                                                                       |                   |                                                                                 | X                       | SIGN ID CODE M3-3<br>SIGN ID CODE M3-3 |                                                                          | E-I36A<br>E-I36B |                           |
|                                                                                                                                                                                                                     |    | I                  | 36    | 36    | 9.00                         |             |              SIGN ID CODE R5-I BACK-TO-BACK<br>SIGN ID CODE MI-5<br>SIGN ID CODE MI-4 |                  | E-I43<br>E-I36A<br>E-I36B |
|                                                                                                                                                                                                                     |                                                                                       | I                  | 21    | 15    | 2.19                         |             |              SIGN ID CODE M6-I<br>SIGN ID CODE M6-3                                   |                  | E-I36A<br>E-I36B          |
|                                                                                                                                                                                                                     |                                                                                                                                                                                                                                                             | 40+65.0, RT                                                                                                                                                                                                         |                                                                                       | I                  | 36    | 36    | 9.00                         |             |              |             |               |                                                                                      | 2                  |                  |                 | 14.67'           |                      |                 |                 |                                                                                       |                            |     |          |                         |       |           |              |               |      |      |                                                                                                       |                   |                                                                                 |                         |                                        | BACK-TO-BACK<br>SIGN ID CODE R5-I<br>SIGN ID CODE R3-I                   |                  | E-I43<br>E-I43            |
|                                                                                                                                                                                                                     |                                                                                                                                                                                                                                                             | FINAL POST LENGTHS ARE TO BE DETERMINED<br>IN THE FIELD. POST SIZES ARE COMPUTED<br>BASED ON INFORMATION FURNISHED ON THE<br>STANDARD SHEETS AND THE TRAFFIC<br>OPERATIONS SECTION "SIGN POST DESIGN<br>GUIDELINE." |                                                                                                                                                                                                                                                             |                    |       |       |                              |             |              |             |               |                                                                                      |                    | LF               | LF              | LF<br>84<br>(14) | LF                   | LF<br>-<br>(14) | LF              |  | EA                         | LB  | LB       | LB                      |       | LB<br>250 | LB           | LB            | LB   | LB   |                                                                                                       |                   |                                                                                 |                         |                                        | PROJECT NAME: WALLINGFORD - RUTLAND TOWN<br>PROJECT NUMBER: NH 2408(I)S  |                  |                           |
|                                                                                                                                                                                                                     |                                                                                                                                                                                                                                                             |                    |       |       |                              |             |              |             |               |                                                                                      |                    | 99.84            |                 |                  |                      |                 |                 |                                                                                       |                            |     |          |                         |       | 214.7     |              |               |      |      |                                                                                                       |                   |                                                                                 |                         |                                        |                                                                          |                  |                           |
|                                                                                                                                                                                                                     |                                                                                                                                                                                                                                                             |                    |       |       | TOTALS                       | SF<br>89.31 | SF           | EA.         | SF            |  |                    | LF<br>84<br>(14) | LF<br>-<br>(14) |                  |                      |                 | LB              |                                                                                       |                            |     | EA.<br>2 | LB<br>250               |       |           |              | EA.           | EA.  | LB   | FILE NAME: p04b050.dgn<br>PROJECT LEADER: D.E.G.<br>DESIGNED BY: J.S.P.<br>IPARM FILE: p04b050+ss03.i |                   | PLOT DATE: \$DATE\$<br>DRAWN BY: C.A.K.<br>CHECKED BY: D.E.G.<br>SHEET 43 OF 80 |                         |                                        |                                                                          |                  |                           |



| STATE OF VERMONT<br>AGENCY OF TRANSPORTATION                                                                                                                                                                        |                |                    |     |      | TRAFFIC SIGN SUMMARY SHEET 4 |             |              |---------------------------------------------------------------------------------------------------------------------------------------------------------------------------------------------------------------------|----------------|--------------------|-----|------|------------------------------|-------------|--------------|-------------|---------------|-------------|------------------------|-----------------|------|------------------------|-----------------|------|------|----------------------------|-----------------|-----|-------------------------|-----|-----|-----------|---------------|--------|--------------|-----|------------------|-----------------------------|---------|-------------------------|--------------------------------------------------------------------------------------------------------------------------------------------------------------------------------------|-----------------------------------------------------------|---------------------------------------------------------------------------------|-----------------|
| MILEMARKER,<br>STATION,<br>OR<br>SIGN NUMBER                                                                                                                                                                        | SIGN<br>LEGEND | SIGN<br>DIMENSIONS |     |      | NEW & SALVAGED SIGNS         |             |              |             | EXIST<br>POST |             | NEW SIGN POSTS         |                 |      |                        |                 |      |      |                            |                 |     |                         |     |     |           |               |        |              |     |                  |                             | REMARKS | SIGN DETAIL             |                                                                                                                                                                                      |                                                           |                                                                                 |                 |
|                                                                                                                                                                                                                     |                |                    |     |      | "A"                          | "B"         | SALV<br>SIGN | SALV<br>TIS | RE<br>TAIN    | SAL<br>VAGE | NO.<br>OF<br>POST<br>S | FLANGED CHANNEL |      | SQUARE STEEL<br>(In)   |                 |      |      | TUBULAR ALUMINUM<br>Ø (In) |                 |     | TUBULAR STEEL<br>Ø (In) |     |     |           | W-SHAPE STEEL |        |              |     | RE<br>QUIRE<br>D | DETAIL<br>ON DWG.<br>NUMBER |         | STD.<br>SHEET<br>NUMBER |                                                                                                                                                                                      |                                                           |                                                                                 |                 |
|                                                                                                                                                                                                                     |                | lb/ft              | 3.0 | 1.75 |                              |             |              |             |               |             |                        | 2.0             | 2.5  | ANCHOR                 | SLEEVE          | 3.0  | 4.0  | 4.0<br>MOD                 | FOUND-<br>ATION | 3.0 | 3.5                     | 4.0 | 5.0 | FTG. SIZE |               | WEIGHT | POST<br>SIZE |     |                  |                             |         |                         |                                                                                                                                                                                      |                                                           |                                                                                 |                 |
|                                                                                                                                                                                                                     |                |                    |     | 1.12 |                              |             |              |             |               |             |                        | 2.0             | 1.88 |                        |                 | 2.16 | 3.35 | 1.3                        |                 | 1.7 | 1.7                     | 7.6 | 9.0 | 10.8      | 14.6          |        |              | 24" |                  |                             |         |                         | 30"                                                                                                                                                                                  |                                                           |                                                                                 |                 |
|                                                                                                                                                                                                                     |                |                    |     |      |                              |             |              |             |               |             | OPTION ITEMS ( )       |                 |      | CLARENDON:<br>42+40.0, LT                                                                                                                                                                                           |                | I                  | 48  | 30   | 10.00                        |             |              |             |               |             | 2                      |                 |      | 14'<br>X<br>14.67'     |                 |      |      |                            |                 |     |                         |     |     |           |               |        |              |     |                  |                             |         |                         |                                                                                                                                                                                      | BACK-TO-BACK<br>SIGN ID CODE VR-935<br>SIGN ID CODE R5-1A |                                                                                 | E-145B<br>E-143 |
| 42+40.0, RT                                                                                                                                                                                                         |                | I                  | 36  | 24   | 6.00                         |             |              |             |               |             | 2                      |                 |      | 13'-6"<br>X<br>14'     |                 |      |      |                            |                 |     |                         |     |     |           |               |        |              |     |                  |                             |         |                         | SIGN ID CODE R5-1A                                                                                                                                                                   |                                                           | E-143                                                                           |                 |
| 43+03.0, LT                                                                                                                                                                                                         |                | I                  | 6   | 10   | 0.42                         |             |              |             |               |             | 1                      | 9'<br>X         |      |                        | X               |      |      | X                          |                 |     |                         |     |     |           |               |        |              |     |                  |                             |         |                         | SIGN ID CODE VD-700                                                                                                                                                                  |                                                           | E-138                                                                           |                 |
| 49+00.0, LT                                                                                                                                                                                                         |                | I                  | 36  | 36   | 9.00                         |             |              |             |               |             | 2                      |                 |      | 14'<br>X<br>14'-6"     |                 |      |      |                            |                 |     |                         |     |     |           |               |        |              |     |                  |                             |         |                         | SIGN ID CODE W2-2                                                                                                                                                                    |                                                           | E-155                                                                           |                 |
|                                                                                                                                                                                                                     |                | 52+00.0, LT                                                                                                                                                                                                         |                | I                  | 21  | 15   | 2.19<br>3.13                 |             |              |             |               |             | 2                      |                 |      | 15'-10"<br>X<br>16'-6" |                 |      |      |                            |                 |     |                         |     |     |           |               |        |              |     |                  |                             |         |                         | SIGN ID CODE M2-1<br>SIGN ID CODE M3-3                                                                                                                                               |                                                           | E-136B<br>E-136B                                                                |                 |
|                                                                                                                                                                                                                     |                | I                  | 36  | 36   | 9.00                         |             |              SIGN ID CODE MI-5                                                                                                                                                                    |                                                           | E-136B                                                                          |                 |
|                                                                                                                                                                                                                     |                | 53+64.0, LT                                                                                                                                                                                                         |                | I                  | 6   | 10   | 0.42                         |             |              |             |               |             | 1                      | 8'<br>X         |      |                        | X               |      |      | X                          |                 |     |                         |     |     |           |               |        |              |     |                  |                             |         |                         |                                                                                                                                                                                      | SIGN ID CODE VD-700                                       |                                                                                 | E-138           |
| 57+87.0, LT                                                                                                                                                                                                         |                | I                  | 30  | 15   | 3.13                         |             |              |             |               |             | 2                      |                 |      | 14'<br>X<br>14'-10"    |                 |      |      |                            |                 |     |                         |     |     |           |               |        |              |     |                  |                             |         |                         | SIGN ID CODE M3-3                                                                                                                                                                    |                                                           | E-136A                                                                          |                 |
|                                                                                                                                                                                                                     |                | I                  | 36  | 36   | 9.00                         |             |              SIGN ID CODE MI-4                                                                                                                                                                    |                                                           | E-136A                                                                          |                 |
|                                                                                                                                                                                                                     |                | 58+02.0, LT                                                                                                                                                                                                         |                | I                  | 6   | 8    | 0.33                         |             |              |             |               |             | 1                      | 8'<br>X         |      |                        | X               |      |      | X                          |                 |     |                         |     |     |           |               |        |              |     |                  |                             |         |                         | SIGN ID CODE VD-701                                                                                                                                                                  |                                                           | E-134                                                                           |                 |
|                                                                                                                                                                                                                     |                | 60+76.0, LT                                                                                                                                                                                                         |                | I                  | 36  | 12   | 3.00                         |             |              |             |               |             | 2                      |                 |      | 14'<br>X<br>14'        |                 |      |      |                            |                 |     |                         |     |     |           |               |        |              |     |                  |                             |         |                         | SIGN ID CODE R6-1L                                                                                                                                                                   |                                                           | E-142                                                                           |                 |
|                                                                                                                                                                                                                     |                | I                  | 36  | 36   | 9.00                         |             |              SIGN ID CODE R3-1                                                                                                                                                                    |                                                           | E-143                                                                           |                 |
| FINAL POST LENGTHS ARE TO BE DETERMINED<br>IN THE FIELD. POST SIZES ARE COMPUTED<br>BASED ON INFORMATION FURNISHED ON THE<br>STANDARD SHEETS AND THE TRAFFIC<br>OPERATIONS SECTION "SIGN POST DESIGN<br>GUIDELINE." |                |                    |     |      |                              |             |              |             |               |             |                        | LF<br>-<br>(42) | LF   | LF<br>168<br>(-)       | LF<br>-<br>(42) | LF   | LF   | LF                         |                 | EA  | LB                      | LB  | LB  |           | LB            | LB     | LB           | LB  |                  |                             |         |                         | PROJECT NAME: WALLINGFORD - RUTLAND TOWN<br>PROJECT NUMBER: NH 2408(I)S<br><br>FILE NAME: p04b050.dgn<br>PROJECT LEADER: D.E.G.<br>DESIGNED BY: J.S.P.<br>IPARM FILE: p04b050+ss04.i |                                                           | PLOT DATE: \$DATE\$<br>DRAWN BY: C.A.K.<br>CHECKED BY: D.E.G.<br>SHEET 44 OF 80 |                 |
|                                                                                                                                                                                                                     |                |                    |     |      | TOTALS                       | SF<br>70.62 | SF           | EA.         | SF            |             | LF<br>168<br>(42)      | LF<br>-<br>(42) |      |                        |                 | LB   | EA.  | LB                         |                 | EA. | EA.                     | LB  |     |           |               |        |              |     |                  |                             |         |                         |                                                                                                                                                                                      |                                                           |                                                                                 |                 |

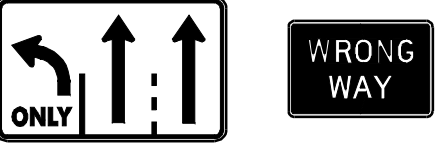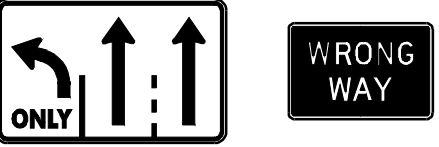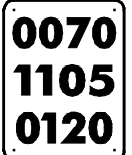
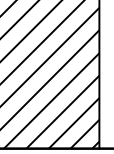
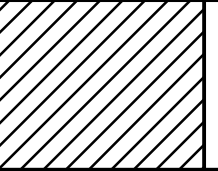


| STATE OF VERMONT<br>AGENCY OF TRANSPORTATION                                                                                                                                                                        |                                                                                     |                    |          |          |                      | TRAFFIC SIGN SUMMARY SHEET 5 |              |             |---------------------------------------------------------------------------------------------------------------------------------------------------------------------------------------------------------------------|-------------------------------------------------------------------------------------|--------------------|----------|----------|----------------------|------------------------------|--------------|-------------|---------------|--------------------------------------------------------------------------------------|--------------------|-----------------|------|------------------------|-----------------|-----------------|------|---------------------------------------------------------------------------------------|-----------------|-----|-------------------------|-----|-----|-----------|---------------------------------------------------------------------------------|--------|--------------|----------------------------------------------------------------|-----------------------------|-------------------------|-----------------------------------------------------------|-------------------------------------------------------------------------|-----------------|-------|--|
| MILEMARKER,<br>STATION,<br>OR<br>SIGN NUMBER                                                                                                                                                                        | SIGN<br>LEGEND                                                                      | SIGN<br>DIMENSIONS |          |          | NEW & SALVAGED SIGNS |                              |              |             | EXIST<br>POST |                                                                                      | NEW SIGN POSTS     |                 |      |                        |                 |                 |      |                                                                                       |                 |     |                         |     |     |           |                                                                                 |        |              |                                                                |                             |                         | REMARKS                                                   | SIGN DETAIL                                                             |                 |       |  |
|                                                                                                                                                                                                                     |                                                                                     |                    |          |          | "A"                  | "B"                          | SALV<br>SIGN | SALV<br>TIS | RE<br>TAIN    | S<br>ALV<br>AGE                                                                      | NO.<br>OF<br>POSTS | FLANGED CHANNEL |      | SQUARE STEEL<br>(In)   |                 |                 |      | TUBULAR ALUMINUM<br>Ø (In)                                                            |                 |     | TUBULAR STEEL<br>Ø (In) |     |     |           | W-SHAPE STEEL                                                                   |        |              | RE<br>QUI<br>RE<br>D<br>S<br>IG<br>N<br>M<br>E<br>T<br>R<br>IC | DETAIL<br>ON DWG.<br>NUMBER | STD.<br>SHEET<br>NUMBER |                                                           |                                                                         |                 |       |  |
|                                                                                                                                                                                                                     |                                                                                     | lb/ft              | 3.0      | 1.75     |                      |                              |              |             |               |                                                                                      |                    | 2.0             | 2.5  | ANCHOR                 | SLEEVE          | 3.0             | 4.0  | 4.0<br>MOD                                                                            | FOUND-<br>ATION | 3.0 | 3.5                     | 4.0 | 5.0 | FTG. SIZE |                                                                                 | WEIGHT | POST<br>SIZE |                                                                |                             |                         |                                                           |                                                                         |                 |       |  |
|                                                                                                                                                                                                                     |                                                                                     |                    |          | 1.12     |                      |                              |              |             |               |                                                                                      |                    | 2.0             | 1.88 |                        |                 | 2.16            | 3.35 | 1.3                                                                                   |                 | 1.7 | 1.7                     | 7.6 | 9.0 | 10.8      | 14.6                                                                            |        |              |                                                                |                             |                         |                                                           | 24"                                                                     | 30"             |       |  |
| OPTION ITEMS ( )                                                                                                                                                                                                    |                                                                                     |                    | CLARENDON:<br>61+40.0, LT                                                                                                                                                                                           |    | I                  | 36       | 36       | 9.00                 |                              |              |             |               |                                                                                      | 2                  |                 |      | 15'<br>X<br>15'-4"     |                 |                 |      |                                                                                       |                 |     |                         |     |     |           |                                                                                 |        |              |                                                                |                             |                         |                                                           | SIGN ID CODE R5-1                                                       |                 | E-I43 |  |
|                                                                                                                                                                                                                     |                                                                                     | 61+40.0, RT                                                                                                                                                                                                         |    | I                  | 36       | 36       | 9.00                 |                              |              |             |               |                                                                                      | 2                  |                 |      | 13.83'<br>X<br>14'     |                 |                 |      |                                                                                       |                 |     |                         |     |     |           |                                                                                 |        |              |                                                                |                             |                         |                                                           | SIGN ID CODE R5-1                                                       |                 | E-I43 |  |
|                                                                                                                                                                                                                     |                                                                                     | 63+40.0, LT                                                                                                                                                                                                         |    | I<br>I             | 48<br>36 | 30<br>24 | 10.00<br>6.00        |                              |              |             |               |                                                                                      | 2                  |                 |      | 14'<br>X<br>14'-6"     |                 |                 |      |                                                                                       |                 |     |                         |     |     |           |                                                                                 |        |              |                                                                |                             |                         | BACK-TO-BACK<br>SIGN ID CODE VR-935<br>SIGN ID CODE R5-1A |                                                                         | E-I45B<br>E-I43 |       |  |
|                                                                                                                                                                                                                     |                                                                                     | 63+40.0, RT                                                                                                                                                                                                         |    | I<br>I             | 48<br>36 | 30<br>24 | 10.00<br>6.00        |                              |              |             |               |                                                                                      | 2                  |                 |      | 14'-6"<br>X<br>14'-10" |                 |                 |      |                                                                                       |                 |     |                         |     |     |           |                                                                                 |        |              |                                                                |                             |                         | BACK-TO-BACK<br>SIGN ID CODE VR-935<br>SIGN ID CODE R5-1A |                                                                         | E-I45B<br>E-I43 |       |  |
|                                                                                                                                                                                                                     |                                                                                     | 64+25.0, LT                                                                                                                                                                                                         |  | I                  | 6        | 10       | 0.42                 |                              |              |             |               |                                                                                      | I                  | 8'<br>X         |      |                        | X               |                 |      | X                                                                                     |                 |     |                         |     |     |           |                                                                                 |        |              |                                                                |                             |                         | SIGN ID CODE VD-700                                       |                                                                         | E-I38           |       |  |
|                                                                                                                                                                                                                     |                                                                                     | 68+00.0, LT                                                                                                                                                                                                         |  | I                  | 36       | 36       | 9.00                 |                              |              |             |               |                                                                                      | 2                  |                 |      | 13'-6"<br>X<br>14'-8"  |                 |                 |      |                                                                                       |                 |     |                         |     |     |           |                                                                                 |        |              |                                                                |                             |                         | SIGN ID CODE W2-2                                         |                                                                         | E-I55           |       |  |
|                                                                                                                                                                                                                     |                                                                                     | 72+39.0, LT                                                                                                                                                                                                         |  | I                  | 12       | 36       | 3.00                 |                              |              |             |               |                                                                                      | I                  |                 |      | 10'-6"<br>X            |                 | X               |      | X                                                                                     |                 |     |                         |     |     |           |                                                                                 |        |              |                                                                |                             |                         | SIGN ID CODE OM-3R                                        |                                                                         | E-I20           |       |  |
|                                                                                                                                                                                                                     |                                                                                     | 72+39.0, RT                                                                                                                                                                                                         |  | I                  | 12       | 36       | 3.00                 |                              |              |             |               |                                                                                      | I                  |                 |      | 10'-6"<br>X            |                 | X               |      | X                                                                                     |                 |     |                         |     |     |           |                                                                                 |        |              |                                                                |                             |                         | SIGN ID CODE OM-3L                                        |                                                                         | E-I20           |       |  |
|                                                                                                                                                                                                                     |                                                                                     | FINAL POST LENGTHS ARE TO BE DETERMINED<br>IN THE FIELD. POST SIZES ARE COMPUTED<br>BASED ON INFORMATION FURNISHED ON THE<br>STANDARD SHEETS AND THE TRAFFIC<br>OPERATIONS SECTION *SIGN POST DESIGN<br>GUIDELINE." |                                                                                     |                    |          |          |                      |                              |              |             |               |                                                                                      |                    | LF<br>-<br>(14) | LF   | LF<br>140<br>(28)      | LF<br>-<br>(14) | LF<br>-<br>(28) | LF   |  | EA              | LB  | LB                      | LB  |     | LB        | LB                                                                              | LB     | LB           |                                                                |                             |                         |                                                           | PROJECT NAME: WALLINGFORD - RUTLAND TOWN<br>PROJECT NUMBER: NH 2408(I)S |                 |       |  |
|                                                                                                                                                                                                                     |                                                                                     |                                                                                                                                                                                                                     |                                                                                     |                    |          |          | TOTALS               | SF<br>65.42                  | SF           | EA.         | SF            |  | LF<br>140<br>(42)  | LF<br>-<br>(42) |      |                        | LB              |                 |      | EA.                                                                                   | LB              |     |                         | EA. | EA. | LB        | PLOT DATE: \$DATE\$<br>DRAWN BY: C.A.K.<br>CHECKED BY: D.E.G.<br>SHEET 45 OF 80 |        |              |                                                                |                             |                         |                                                           |                                                                         |                 |       |  |





**STATE OF VERMONT**  
**AGENCY OF TRANSPORTATION**

# TRAFFIC SIGN SUMMARY SHEET 6
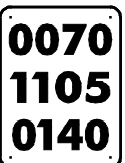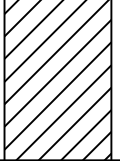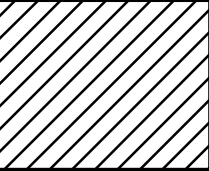
| MILEMARKER,<br>STATION,<br>OR<br>SIGN NUMBER                                                                                                                                                                        | SIGN<br>LEGEND                                                                                                                                                          | SIGN<br>DIMENSIONS |               |                | NEW & SALVAGED SIGNS |             |              |             | EXIST<br>POST |                                                                                      | NO.<br>OF<br>POSTS | FLANGED CHANNEL  |                   |                    | SQUARE STEEL<br>(In) |     |                                                                                       |        | TUBULAR ALUMINUM<br>Ø (In) |     |     | TUBULAR STEEL<br>Ø (In) |                 |     |     | W-SHAPE STEEL |                                                                                                       |           | RE-<br>FOUR-<br>SQUARE<br>REQUIRED                                              | REMARKS                                                   |                                                                         | SIGN DETAIL    |              |                             |                         |     |     |
|---------------------------------------------------------------------------------------------------------------------------------------------------------------------------------------------------------------------|-------------------------------------------------------------------------------------------------------------------------------------------------------------------------|--------------------|---------------|----------------|----------------------|-------------|--------------|-------------|---------------|--------------------------------------------------------------------------------------|--------------------|------------------|-------------------|--------------------|----------------------|-----|---------------------------------------------------------------------------------------|--------|----------------------------|-----|-----|-------------------------|-----------------|-----|-----|---------------|-------------------------------------------------------------------------------------------------------|-----------|---------------------------------------------------------------------------------|-----------------------------------------------------------|-------------------------------------------------------------------------|----------------|--------------|-----------------------------|-------------------------|-----|-----|
|                                                                                                                                                                                                                     |                                                                                                                                                                         |                    |               |                | “A”                  | “B”         | SALV<br>SIGN | SALV<br>TIS | RETAIN        | SALVAGE                                                                              |                    | 1.12             | 2.0               | 3.0                | 1.75                 | 2.0 | 2.5                                                                                   | ANCHOR | SLEEVE                     | 3.0 | 4.0 | 4.0<br>MOD              | FOUND-<br>ATION | 3.0 | 3.5 | 4.0           | 5.0                                                                                                   | FTG. SIZE |                                                                                 |                                                           |                                                                         | WEIGHT         | POST<br>SIZE | DETAIL<br>ON DWG.<br>NUMBER | STD.<br>SHEET<br>NUMBER |     |     |
|                                                                                                                                                                                                                     |                                                                                                                                                                         | lb/ft              |               | lb/ft          |                      |             lb/ft     |                                                                                 |                                                           |                                                                         |                |              |                             |                         |     |     |
|                                                                                                                                                                                                                     |                                                                                                                                                                         | EA                 | WIDTH<br>(In) | HEIGHT<br>(In) |                      |             24"       |                                                                                 | 30"                                                       | 1.3                                                                     |                |              |                             |                         | 1.7 | 1.7 |
|                                                                                                                                                                                                                     |                                                                                                                                                                         |                    |               |                |                      |             |              |             |               |                                                                                      |                    | OPTION ITEMS ( ) |                   |                    | CLARENDON:<br>72+87.0, LT                                                                                                                                                                                           |                                                                                        | I                  | 36            | 24             | 6.00                 |             |              |             |               |                                                                                      | -2-<br>1           |                  |                   | 13'<br>X           |                      |     |                                                                                                                                                                                                                     |                                                                                        | I                  | 6             | 8              | 0.33                 |             |              SIGN ID CODE VD-70I                                                     |                | E-I34        |                             |                         |     |     |
|                                                                                                                                                                                                                     |                                                                                                                                                                         | 74+05.0, LT                                                                                                                                                                                                         |                                                                                        | I                  | 36            | 48             | 12.00                |             |              |             |               |                                                                                      | 2                  |                  |                   | 16'-6"<br>X<br>17' |                      |     |                                                                                       |        |                            |     |     |                         |                 |     |     |               |                                                                                                       |           |                                                                                 |                                                           | SIGN ID CODE R2-I                                                       |                | E-I42        |                             |                         |     |     |
|                                                                                                                                                                                                                     |                                                                                        | I                  | 30            | 24             | 5.00                 |             |              SIGN ID CODE R8-7                                                       |                | E-I42        |                             |                         |     |     |
|                                                                                                                                                                                                                     |                                                                                                                                                                         | 74+87.0, LT                                                                                                                                                                                                         |                                                                                        | I                  | 6             | 10             | 0.42                 |             |              |             |               |                                                                                      | 1                  | 9'<br>X          |                   |                    | X                    |     |                                                                                       | X      |                            |     |     |                         |                 |     |     |               |                                                                                                       |           |                                                                                 |                                                           | SIGN ID CODE VD-700                                                     |                | E-I38        |                             |                         |     |     |
|                                                                                                                                                                                                                     |                                                                                                                                                                         | 76+05.0, LT                                                                                                                                                                                                         |                                                                                      | I                  | 30            | 15             | 3.13                 |             |              |             |               |                                                                                      | 2                  |                  |                   | 15'<br>X<br>16'    |                      |     |                                                                                       |        |                            |     |     |                         |                 |     |     |               |                                                                                                       |           |                                                                                 |                                                           | SIGN ID CODE M3-3                                                       |                | E-I36A       |                             |                         |     |     |
|                                                                                                                                                                                                                     |                                                                                      | I                  | 36            | 36             | 9.00                 |             |              SIGN ID CODE MI-4                                                       |                | E-I36A       |                             |                         |     |     |
|                                                                                                                                                                                                                     |                                                                                                                                                                         | 77+20.0, LT                                                                                                                                                                                                         |   |                    |               |                |                      |             | I<br>I       |             |               |                                                                                      | 1                  |                  |                   | 12'-6"<br>X        |                      | X   |                                                                                       | X      |                            |     |     |                         |                 |     |     |               |                                                                                                       |           |                                                                                 | SALVAGED SIGNS TO BE MOUNTED ON NEW POST.<br>BACK-TO-BACK | -<br>-                                                                  | -<br>-         |              |                             |                         |     |     |
|                                                                                                                                                                                                                     |                                                                                                                                                                         | 77+27.0, LT                                                                                                                                                                                                         |   | I<br>I             | 36<br>36      | 12<br>12       | 3.00<br>3.00         |             |              |             |               |                                                                                      | 2                  |                  |                   | 14'<br>X<br>14'    |                      |     |                                                                                       |        |                            |     |     |                         |                 |     |     |               |                                                                                                       |           |                                                                                 | BACK-TO-BACK<br>SIGN ID CODE R6-IR<br>SIGN ID CODE R6-IL  |                                                                         | E-I42<br>E-I42 |              |                             |                         |     |     |
|                                                                                                                                                                                                                     |   | I<br>I             | 30<br>6       | 30<br>10       | 6.25<br>0.42         |             |              SIGN ID CODE RI-I<br>SIGN ID CODE VD-700                                        |                                                           | E-I43<br>E-I38                                                          |                |              |                             |                         |     |     |
|                                                                                                                                                                                                                     |                                                                                      | I                  | 24            | 18             | 3.00                 |             |              SIGN ID CODE R6-3                                                               | 65                                                        |                                                                         |                |              |                             |                         |     |     |
| FINAL POST LENGTHS ARE TO BE DETERMINED<br>IN THE FIELD. POST SIZES ARE COMPUTED<br>BASED ON INFORMATION FURNISHED ON THE<br>STANDARD SHEETS AND THE TRAFFIC<br>OPERATIONS SECTION *SIGN POST DESIGN<br>GUIDELINE." |                                                                                                                                                                         |                    |               |                |                      |             |              |             |               |                                                                                      | LF<br>-<br>(14)    | LF               | LF<br>112<br>(14) | LF<br>-<br>(14)    | LF<br>-<br>(14)      | LF  |  | EA     | LB                         | LB  | LB  |                         | LB              | LB  | LB  | LB            |                                                                                                       |           |                                                                                 |                                                           | PROJECT NAME: WALLINGFORD - RUTLAND TOWN<br>PROJECT NUMBER: NH 2408(I)S |                |              |                             |                         |     |     |
|                                                                                                                                                                                                                     |                                                                                                                                                                         |                                                                                                                                                                                                                     |                                                                                                                                                                         |                    |               |                | TOTALS               | SF<br>51.55 | SF           | EA.<br>2    | SF            |  | LF<br>112<br>(28)  | LF<br>-<br>(28)  |                   |                    |                      | LB  |                                                                                       |        | EA.                        | LB  |     |                         |                 | EA. | EA. | LB            | FILE NAME: p04b050.dgn<br>PROJECT LEADER: D.E.G.<br>DESIGNED BY: J.S.P.<br>IPARM FILE: p04b050+ss06.I |           | PLOT DATE: \$DATE\$<br>DRAWN BY: C.A.K.<br>CHECKED BY: D.E.G.<br>SHEET 46 OF 80 |                                                           |                                                                         |                |              |                             |                         |     |     |


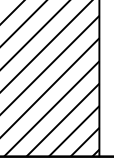
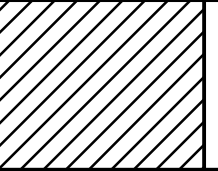


| STATE OF VERMONT<br>AGENCY OF TRANSPORTATION                                                                                                                                                                        |                                                                                                                                                                                                                                                             |                    |                | TRAFFIC SIGN SUMMARY SHEET 7 |                      |     |---------------------------------------------------------------------------------------------------------------------------------------------------------------------------------------------------------------------|-------------------------------------------------------------------------------------------------------------------------------------------------------------------------------------------------------------------------------------------------------------|--------------------|----------------|------------------------------|----------------------|-----|--------------|-------------|--------------------------------------------------------------------------------------|------------------|--------------------|------------------|-----------------|-----------------------|----------------------|--------|-----------------|---------------------------------------------------------------------------------------|----------------------------|----------------------|-----|-------------------------|----------------------|---------------------|-----------|---------------|--------|--------------|-------------------------------------------------------------------------------------------------------|--------------------------------------------------------------------------|---------------------------------------------------------------------------------|-------------------------------------------------------------------------|-------------------------|
| MILEMARKER,<br>STATION,<br>OR<br>SIGN NUMBER                                                                                                                                                                        | SIGN<br>LEGEND                                                                                                                                                                                                                                              | SIGN<br>DIMENSIONS |                |                              | NEW & SALVAGED SIGNS |     |              |             | EXIST<br>POST                                                                        |                  | NEW SIGN POSTS     |                  |                 |                       |                      |        |                 |                                                                                       |                            |                      |     |                         |                      |                     |           |               |        |              |                                                                                                       |                                                                          | REMARKS                                                                         | SIGN DETAIL                                                             |                         |
|                                                                                                                                                                                                                     |                                                                                                                                                                                                                                                             |                    |                |                              | "A"                  | "B" | SALV<br>SIGN | SALV<br>TIS | RETAIN                                                                               | SALVAGE          | NO.<br>OF<br>POSTS | FLANGED CHANNEL  |                 |                       | SQUARE STEEL<br>(In) |        |                 |                                                                                       | TUBULAR ALUMINUM<br>Ø (In) |                      |     | TUBULAR STEEL<br>Ø (In) |                      |                     |           | W-SHAPE STEEL |        |              |                                                                                                       | FREQUENTLY<br>SIGHTED                                                    |                                                                                 | DETAIL<br>ON DWG.<br>NUMBER                                             | STD.<br>SHEET<br>NUMBER |
|                                                                                                                                                                                                                     |                                                                                                                                                                                                                                                             | lb/ft              | lb/ft          | lb/ft                        |                      |     |              |             |                                                                                      |                  |                    | 1.75             | 2.0             | 2.5                   | ANCHOR               | SLEEVE | 3.0             | 4.0                                                                                   | 4.0<br>MOD                 | FOUND-<br>ATION      | 3.0 | 3.5                     | 4.0                  | 5.0                 | FTG. SIZE |               | WEIGHT | POST<br>SIZE |                                                                                                       |                                                                          |                                                                                 |                                                                         |                         |
|                                                                                                                                                                                                                     |                                                                                                                                                                                                                                                             1.2       | 2.0           |        |              | 3.0                                                                                                   |                                                                          |                                                                                 |                                                                         |                         |
| OPTION ITEMS ( )                                                                                                                                                                                                    |                                                                                                                                                                                                                                                             |                    | CLARENDON:<br>77+61.0, LT                                                                                                                                                                                           |                                                                                                                                                                            | I                  | 24             | 30                           | 5.00                 |     |              |             |                                                                                      |                  | I                  |                  |                 | 15'-6"<br>X           |                      |        | X               | X                                                                                     |                            |                      |     |                         |                      |                     |           |               |        |              |                                                                                                       |                                                                          | SIGN ID CODE VR-079                                                             |                                                                         | E-I41                   |
|                                                                                                                                                                                                                     |                                                                                                                                                                            | I                  | 24             | 30                           | 5.00                 |     |              SIGN ID CODE R2-I                                                               |                                                                         | E-I42                   |
|                                                                                                                                                                                                                     |                                                                                                                                                                                                                                                             |                                                                                                                                                                                                                     |                                                                                                                                                                                                                                                             | 78+00.0, LT                                                                                                                                                                                                         |                                                                                                                                                                            | I                  | 36             | 12                           | 3.00                 |     |              |             |                                                                                      |                  | 2                  |                  |                 | 14'<br>X<br>14'       |                      |        |                 |                                                                                       |                            |                      |     |                         |                      |                     |           |               |        |              |                                                                                                       |                                                                          | SIGN ID CODE R6-IL                                                              |                                                                         | E-I42                   |
|                                                                                                                                                                                                                     |                                                                                                                                                                            | I                  | 36             | 36                           | 9.00                 |     |              SIGN ID CODE R3-I                                                               |                                                                         | E-I43                   |
|                                                                                                                                                                                                                     |                                                                                                                                                                                                                                                             | 78+25.0, RT                                                                                                                                                                                                         |                                                                                                                                                                           | I                  | 36             | 36                           | 9.00                 |     |              |             |                                                                                      |                  | 2                  |                  |                 | 15'-4"<br>X<br>15'-6" |                      |        |                 |                                                                                       |                            |                      |     |                         |                      |                     |           |               |        |              |                                                                                                       |                                                                          | SIGN ID CODE R5-I                                                               |                                                                         | E-I43                   |
|                                                                                                                                                                                                                     |                                                                                                                                                                                                                                                             | 78+25.0, LT                                                                                                                                                                                                         |                                                                                       | I<br>I             | 30<br>30       | 15<br>15                     | 3.13<br>3.13         |     |              |             |                                                                                      |                  | 2                  |                  |                 |                       |                      |        |                 |                                                                                       | 14'-3"<br>2<br>13'-4"      | 209.61<br>250        |     |                         |                      |                     |           |               |        |              | X                                                                                                     | SIGN ID CODE M3-3<br>SIGN ID CODE M3-3                                   |                                                                                 | E-I36B<br>E-I36A                                                        |                         |
|                                                                                                                                                                                                                     |    | I<br>I<br>I        | 36<br>36<br>36 | 36<br>36<br>36               | 9.00<br>9.00<br>9.00 |     |              SIGN ID CODE R5-I BACK-TO-BACK<br>SIGN ID CODE MI-5<br>SIGN ID CODE MI-4 |                                                                                 | E-I43<br>E-I36B<br>E-I36A                                               |                         |
|                                                                                                                                                                                                                     |                                                                                       | I<br>I             | 21<br>21       | 15<br>15                     | 2.19<br>2.19         |     |              SIGN ID CODE M6-I<br>SIGN ID CODE M6-3                                   |                                                                                 | E-I36B<br>E-I36A                                                        |                         |
|                                                                                                                                                                                                                     |                                                                                                                                                                                                                                                             |                                                                                                                                                                                                                     |                                                                                                                                                                                                                                                             |                                                                                                                                                                                                                     |                                                                                                                                                                                                                                                             |                                                                                                                                                                                                                     |                                                                                                                                                                                                                                                             | FINAL POST LENGTHS ARE TO BE DETERMINED<br>IN THE FIELD. POST SIZES ARE COMPUTED<br>BASED ON INFORMATION FURNISHED ON THE<br>STANDARD SHEETS AND THE TRAFFIC<br>OPERATIONS SECTION "SIGN POST DESIGN<br>GUIDELINE." |                                                                                                                                                                                                                                                             |                    |                |                              |                      |     |              |             |                                                                                      |                  |                    | LF               | LF              | LF<br>56<br>(14)      | LF                   | LF     | LF<br>-<br>(14) |  | EA                         | LB                   | LB  | LB                      |                      | LB<br>209.61<br>250 | LB        | LB            | LB     |              |                                                                                                       |                                                                          |                                                                                 | PROJECT NAME: WALLINGFORD - RUTLAND TOWN<br>PROJECT NUMBER: NH 2408(I)S |                         |
|                                                                                                                                                                                                                     |                                                                                                                                                                                                                                                             |                    |                |                              |                      |     |              |             |                                                                                      |                  |                    | LF<br>56<br>(14) |                 |                       | LF<br>-<br>(14)      |        |                 |                                                                                       | LB                         |                      |     | EA.<br>2                | LB<br>-250<br>209.61 |                     |           | EA.           | EA.    | LB           | FILE NAME: p04b050.dgn<br>PROJECT LEADER: D.E.G.<br>DESIGNED BY: J.S.P.<br>IPARM FILE: p04b050+ss07.i |                                                                          | PLOT DATE: \$DATE\$<br>DRAWN BY: C.A.K.<br>CHECKED BY: D.E.G.<br>SHEET 47 OF 80 |                                                                         |                         |
| TOTALS                                                                                                                                                                                                              |                                                                                                                                                                                                                                                             |                    |                |                              | SF<br>68.64          | SF  | EA.          | SF          |  | LF<br>56<br>(14) |                    |                  | LF<br>-<br>(14) |                       |                      | LB     |                 |                                                                                       | EA.<br>2                   | LB<br>-250<br>209.61 |     |                         | EA.                  | EA.                 | LB        |               |        |              |                                                                                                       |                                                                          |                                                                                 |                                                                         |                         |








**STATE OF VERMONT  
AGENCY OF TRANSPORTATION**

# TRAFFIC SIGN SUMMARY SHEET 8
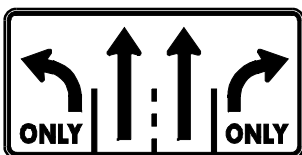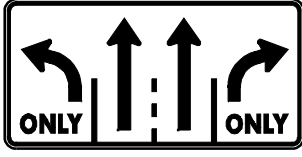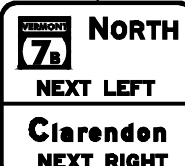
| MILEMARKER,<br>STATION,<br>OR<br>SIGN NUMBER                                                                                                                                                                        | SIGN<br>LEGEND                                                                                                                                                      | SIGN<br>DIMENSIONS |               |                | NEW & SALVAGED SIGNS |        |              |             | EXIST<br>POST<br>RETAIN<br>SALVAGE | NO.<br>OF<br>POSTS | FLANGED CHANNEL |                    |                 | SQUARE STEEL<br>(In)   |                 |      |        | TUBULAR ALUMINUM<br>Ø (In) |     |     | TUBULAR STEEL<br>Ø (In) |                 |                       |               |       | W-SHAPE STEEL |                                                 |                                                                                                       | RE<br>QUI<br>RE<br>D<br>S<br>I<br>G<br>N<br>E<br>E<br>D   | REMARKS                                                                         | SIGN DETAIL     |              |
|---------------------------------------------------------------------------------------------------------------------------------------------------------------------------------------------------------------------|---------------------------------------------------------------------------------------------------------------------------------------------------------------------|--------------------|---------------|----------------|----------------------|--------|--------------|-------------|------------------------------------|--------------------|-----------------|--------------------|-----------------|------------------------|-----------------|------|--------|----------------------------|-----|-----|-------------------------|-----------------|-----------------------|---------------|-------|---------------|-------------------------------------------------|-------------------------------------------------------------------------------------------------------|-----------------------------------------------------------|---------------------------------------------------------------------------------|-----------------|--------------|
|                                                                                                                                                                                                                     |                                                                                                                                                                     |                    |               |                |                      |        |              |             |                                    |                    | lb/ft           |                    |                 | 1.75                   | 2.0             | 2.5  | ANCHOR | SLEEVE                     | 3.0 | 4.0 | 4.0<br>MOD              | FOUND-<br>ATION | 3.0                   | 3.5           | 4.0   | 5.0           | FTG. SIZE                                       |                                                                                                       |                                                           |                                                                                 | WEIGHT          | POST<br>SIZE |
|                                                                                                                                                                                                                     |                                                                                                                                                                     | lb/ft              |               |                | lb/ft                |        |              | lb/ft       |                                    |                    | 24"             | 30"                |                 |                        |                                                                                                                                                                                                                     |                                                                                                                                                                     | EA                 | WIDTH<br>(In) | HEIGHT<br>(In) | "A"                  | "B"    | SALV<br>SIGN | SALV<br>TIS |                                    |                    | 1.12            | 2.0                | 3.0             | 1.88                   | 2.16            | 3.35 |        |                            | 3.0 | 4.0 | 4.0<br>MOD              |                 | 3.0                   | 3.5           | 4.0   | 5.0           | 24"                                             | 30"                                                                                                   |                                                           |                                                                                 |                 |              |
| OPTION ITEMS ( )                                                                                                                                                                                                    |                                                                                                                                                                     |                    | CLARENDON:<br>80+75.0, LT                                                                                                                                                                                           |   | I                  | 60<br>36      | 30<br>24       | 12.50<br>6.00        |        |              |             |                                    |                    | 2               |                    |                 | 15'<br>X<br>15'-8"     |                 |      |        |                            |     |     |                         |                 |                       |               |       |               |                                                 |                                                                                                       | BACK-TO-BACK<br>SIGN ID CODE VR-94I<br>SIGN ID CODE R5-1A |                                                                                 | E-145B<br>E-143 |              |
|                                                                                                                                                                                                                     |                                                                                                                                                                     |                                                                                                                                                                                                                     |                                                                                                                                                                     | 80+75.0, RT                                                                                                                                                                                                         |   | I                  | 60<br>36      | 30<br>24       | 12.50<br>6.00        |        |              |             |                                    |                    | 2               |                    |                 | 15'-1"<br>X<br>15'-8"  |                 |      |        |                            |     |     |                         |                 |                       |               |       |               |                                                 |                                                                                                       | BACK-TO-BACK<br>SIGN ID CODE VR-94I<br>SIGN ID CODE R5-1A |                                                                                 | E-145B<br>E-143 |              |
|                                                                                                                                                                                                                     |                                                                                                                                                                     | 82+75.0, LT                                                                                                                                                                                                         |                                                                                    | I                  | 48            | 48             | 16.00                |        |              |             |                                    |                    | 2               |                    |                 | 16'-4"<br>X<br>16'-11" |                 |      |        |                            |     |     |                         |                 |                       |               |       |               |                                                 |                                                                                                       | SIGN ID CODE W8-13                                        |                                                                                 | E-150           |              |
|                                                                                                                                                                                                                     |                                                                                                                                                                     | 84+75.0, LT                                                                                                                                                                                                         |                                                                                    | I                  | 21            | 15             | 2.19                 |        |              |             |                                    |                    | 2               |                    |                 | 15'<br>X<br>16'        |                 |      |        |                            |     |     |                         |                 |                       |               |       |               |                                                 |                                                                                                       | SIGN ID CODE M2-1                                         |                                                                                 | E-136B          |              |
|                                                                                                                                                                                                                     |                                                                                  | I                  | 36            | 36             | 9.00                 |        |              SIGN ID CODE MI-5                                                                                     |                                                           | E-136B                                                                          |                 |              |
|                                                                                                                                                                                                                     |                                                                                                                                                                     | 85+43.0, LT                                                                                                                                                                                                         |                                                                                  | I                  | 6             | 10             | 0.42                 |        |              |             |                                    |                    | I               | 9'<br>X            |                 |                        | X               |      | X      |                            |     |     |                         |                 |                       |               |       |               |                                                 |                                                                                                       | SIGN ID CODE VD-700                                       |                                                                                 | E-138           |              |
|                                                                                                                                                                                                                     |                                                                                                                                                                     | 88+00.0, LT                                                                                                                                                                                                         |                                                                                  | I                  | 138           | 126            |                      | 120.75 |              |             |                                    |                    | 2               |                    |                 |                        |                 |      |        |                            |     |     |                         |                 | 20'-6"<br>2<br>24'-3" | 805.5<br>-812 | W8x18 |               | CALCULATED INDIVIDUAL BOLT TENSION IS 18.4 KIPS | 65                                                                                                    |                                                           |                                                                                 |                 |              |
|                                                                                                                                                                                                                     |                                                                                                                                                                     |                                                                                                                                                                                                                     |                                                                                                                                                                     |                                                                                                                                                                                                                     |                                                                                                                                                                     | FINAL POST LENGTHS ARE TO BE DETERMINED<br>IN THE FIELD. POST SIZES ARE COMPUTED<br>BASED ON INFORMATION FURNISHED ON THE<br>STANDARD SHEETS AND THE TRAFFIC<br>OPERATIONS SECTION *SIGN POST DESIGN<br>GUIDELINE." |                                                                                                                                                                     |                    |               |                |                      |        |              |             |                                    |                    |                 | LF<br>-<br>(14)    | LF              | LF<br>11/2<br>(-)      | LF<br>-<br>(14) | LF   | LF     | EA                         | LB  | LB  | LB                      |                 | LB                    | LB            | LB    | LB            |                                                 |                                                                                                       |                                                           | PROJECT NAME: WALLINGFORD - RUTLAND TOWN<br>PROJECT NUMBER: NH 2408(I)S         |                 |              |
|                                                                                                                                                                                                                     |                                                                                                                                                                     |                    |               |                |                      |        |              |             |                                    |                    |                 | LF<br>11/2<br>(14) | LF<br>-<br>(14) |                        |                 |      | LB     |                            |     | EA. | LB                      |                 |                       |               | EA.   | EA.           | LB<br>-812<br>805.5                             | FILE NAME: p04b050.dgn<br>PROJECT LEADER: D.E.G.<br>DESIGNED BY: J.S.P.<br>IPARM FILE: p04b050+ss08.i |                                                           | PLOT DATE: \$DATE\$<br>DRAWN BY: C.A.K.<br>CHECKED BY: D.E.G.<br>SHEET 48 OF 80 |                 |              |

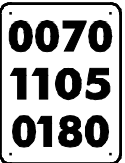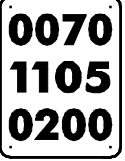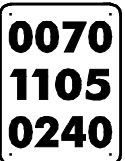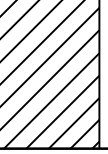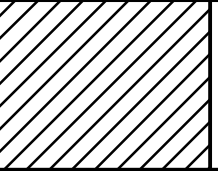

| STATE OF VERMONT<br>AGENCY OF TRANSPORTATION                                                                                                                                                                        |                                                                                     |                    |       |       |                      |             |              |             |               | TRAFFIC SIGN SUMMARY SHEET 9                                                         |                    |                 |---|
| MILEMARKER,<br>STATION,<br>OR<br>SIGN NUMBER                                                                                                                                                                        | SIGN<br>LEGEND                                                                      | SIGN<br>DIMENSIONS |       |       | NEW & SALVAGED SIGNS |             |              |             | EXIST<br>POST |                                                                                      | NEW SIGN POSTS     |                 |                  |                       |                      |                 |                                                                                       |     |                            |                     |     |                         |     |        |                     |               |      |      | REMARKS | SIGN DETAIL                      |                             |                                                                                                       |                                                                                 |       |     |     |     |     |      |
|                                                                                                                                                                                                                     |                                                                                     |                    |       |       | “A”                  | “B”         | SALV<br>SIGN | SALV<br>TIS | RETAIN        | SALVAGE                                                                              | NO.<br>OF<br>POSTS | FLANGED CHANNEL |                  |                       | SQUARE STEEL<br>(In) |                 |                                                                                       |     | TUBULAR ALUMINUM<br>Ø (In) |                     |     | TUBULAR STEEL<br>Ø (In) |     |        |                     | W-SHAPE STEEL |      |      |         | REQUIRE<br>D<br>SIGN<br>MATERIAL | DETAIL<br>ON DWG.<br>NUMBER | STD.<br>SHEET<br>NUMBER                                                                               |                                                                                 |       |     |     |     |     |      |
|                                                                                                                                                                                                                     |                                                                                     | lb/ft              | lb/ft | lb/ft |                      |             |              |             |               |                                                                                      |                    | ANCHOR          | SLEEVE           | 3.0                   | 4.0                  | 4.0<br>MOD      | FOUND-<br>ATION                                                                       | 3.0 | 3.5                        | 4.0                 | 5.0 | FTG. SIZE               |     | WEIGHT | POST<br>SIZE        |               |      |      |         |                                  |                             |                                                                                                       |                                                                                 |       |     |     |     |     |      |
|                                                                                                                                                                                                                     |                                                                                     1.12                    | 2.0 |        |                     | 3.0           | 1.88 | 2.16 |         |                                  |                             |                                                                                                       | 3.35                                                                            | 1.3   | 1.7 | 1.7 | 7.6 | 9.0 | 10.8 |
| OPTION ITEMS ( )                                                                                                                                                                                                    | |
| CLARENDON:<br>96+30.0, LT                                                                                                                                                                                           |    | I                  | 6     | 10    | 0.42                 |             |              |             |               |                                                                                      | I                  | 9'<br>X         |                  |                       | X                    |                 |                                                                                       | X   |                            |                     |     |                         |     |        |                     |               |      |      |         |                                  |                             | SIGN ID CODE VD-700                                                                                   |                                                                                 | E-I38 |     |     |     |     |      |
| |
| 104+00.0, LT                                                                                                                                                                                                        |    | I                  | 96    | 96    |                      | 64.00       |              |             |               |                                                                                      | 2                  |                 |                  |                       |                      |                 |                                                                                       |     | 18'-8"<br>2<br>19'         |                     |     | 406.84<br>-402          |     |        |                     |               |      |      |         |                                  |                             | 63                                                                                                    |                                                                                 |       |     |     |     |     |      |
| |
| 107+29.0, LT                                                                                                                                                                                                        |    | I                  | 6     | 10    | 0.42                 |             |              |             |               |                                                                                      | I                  | 9'<br>X         |                  |                       | X                    |                 |                                                                                       | X   |                            |                     |     |                         |     |        |                     |               |      |      |         |                                  |                             | SIGN ID CODE VD-700                                                                                   |                                                                                 | E-I38 |     |     |     |     |      |
| |
| 118+22.0, LT                                                                                                                                                                                                        |    | I                  | 6     | 10    | 0.42                 |             |              |             |               |                                                                                      | I                  | 9'<br>X         |                  |                       | X                    |                 |                                                                                       | X   |                            |                     |     |                         |     |        |                     |               |      |      |         |                                  |                             | SIGN ID CODE VD-700                                                                                   |                                                                                 | E-I38 |     |     |     |     |      |
| |
| 123+82.0, LT                                                                                                                                                                                                        |  | I                  | 6     | 8     | 0.33                 |             |              |             |               |                                                                                      | I                  | 9'<br>X         |                  |                       | X                    |                 |                                                                                       | X   |                            |                     |     |                         |     |        |                     |               |      |      |         |                                  |                             | SIGN ID CODE VD-701                                                                                   |                                                                                 | E-I34 |     |     |     |     |      |
| |
| 128+78.0, LT                                                                                                                                                                                                        |  | I                  | 6     | 10    | 0.42                 |             |              |             |               |                                                                                      | I                  | 8'<br>X         |                  |                       | X                    |                 |                                                                                       | X   |                            |                     |     |                         |     |        |                     |               |      |      |         |                                  |                             | SIGN ID CODE VD-700                                                                                   |                                                                                 | E-I38 |     |     |     |     |      |
| |
| 130+08.0, RT                                                                                                                                                                                                        |  | I                  | 36    | 12    | 3.00                 |             |              |             |               |                                                                                      | 2                  |                 |                  | 13'-2"<br>X<br>13'-3" |                      |                 |                                                                                       |     |                            |                     |     |                         |     |        |                     |               |      |      |         |                                  |                             | SIGN ID CODE R6-1R                                                                                    |                                                                                 | E-I42 |     |     |     |     |      |
| |
| 130+16.0, LT                                                                                                                                                                                                        |  | I                  | 36    | 36    | 9.00                 |             |              |             |               |                                                                                      | 2                  |                 |                  | 14'-8"<br>X<br>15'-4" |                      |                 |                                                                                       |     |                            |                     |     |                         |     |        |                     |               |      |      |         |                                  |                             | SIGN ID CODE R3-2                                                                                     |                                                                                 | E-I43 |     |     |     |     |      |
| 131+09.0, LT                                                                                                                                                                                                        |  | I                  | 30    | 36    | 7.50                 |             |              |             |               |                                                                                      | I                  |                 |                  | 14'-7"<br>X           |                      |                 | X                                                                                     | X   |                            |                     |     |                         |     |        |                     |               |      |      |         |                                  |                             | 64                                                                                                    |                                                                                 |       |     |     |     |     |      |
| FINAL POST LENGTHS ARE TO BE DETERMINED<br>IN THE FIELD. POST SIZES ARE COMPUTED<br>BASED ON INFORMATION FURNISHED ON THE<br>STANDARD SHEETS AND THE TRAFFIC<br>OPERATIONS SECTION "SIGN POST DESIGN<br>GUIDELINE." |                                                                                     |                    |       |       |                      |             |              |             |               |                                                                                      | LF<br>-<br>(70)    | LF              | LF<br>56<br>(14) | LF<br>-<br>(70)       | LF                   | LF<br>-<br>(14) |  | EA  | LB                         | LB                  | LB  |                         | LB  | LB     | LB<br>402<br>406.84 | LB            |      |      |         |                                  |                             | PROJECT NAME: WALLINGFORD - RUTLAND TOWN<br>PROJECT NUMBER: NH 2408(I)S                               |                                                                                 |       |     |     |     |     |      |
|                                                                                                                                                                                                                     |                                                                                     |                    |       |       | 115                  |             |              |                                                                                                                                                                                                                     |                                                                                     |                    |       |       | TOTALS               | SF<br>21.51 | SF<br>64.00  | EA.         | SF            |  | LF<br>56<br>(84)   | LF<br>-<br>(84) |                  |                       |                      | LB              |                                                                                       |     | EA.<br>2                   | LB<br>402<br>406.84 |     |                         |     | EA.    | EA.                 | LB            |      |      |         |                                  |                             | FILE NAME: p04b050.dgn<br>PROJECT LEADER: D.E.G.<br>DESIGNED BY: J.S.P.<br>IPARM FILE: p04b050+ss09.i | PLOT DATE: \$DATE\$<br>DRAWN BY: C.A.K.<br>CHECKED BY: D.E.G.<br>SHEET 49 OF 80 |       |     |     |     |     |      |



STATE OF VERMONT  
AGENCY OF TRANSPORTATION

# TRAFFIC SIGN SUMMARY SHEET 10

| MILEMARKER,<br>STATION,<br>OR<br>SIGN NUMBER | SIGN<br>LEGEND                                                                    | SIGN<br>DIMENSIONS |     |     | NEW & SALVAGED SIGNS |     |              |             | EXIST<br>POST<br><br>RETAI<br>N<br>SALV<br>AGE | NO.<br>OF<br>POS<br>TS | FLANGED CHANNEL |      |      | SQUARE STEEL |     |        |        | TUBULAR ALUMINUM |     |                 | TUBULAR STEEL |      |           |     | W-SHAPE STEEL |              |     | R<br>E<br>Q<br>U<br>I<br>R<br>E<br>D<br><br>F<br>O<br>R<br>I<br>N<br>S<br>T<br>A<br>L<br>L<br>A<br>T<br>I<br>O<br>N | REMARKS | SIGN DETAIL | |
|---|
|                                              |                                                                                   |                    |     |     | "A"                  | "B" | SALV<br>SIGN | SALV<br>TIS |                                                |                        | lb/ft           |      |      | (In)         |     | ANCHOR | SLEEVE | Ø (In)           |     | FOUND-<br>ATION | Ø (In)        |      | FTG. SIZE |     | WEIGHT        | POST<br>SIZE | |
|                                              |                                                                                   | 1.12               | 2.0 | 3.0 |                      |     |              |             |                                                |                        | 1.75            | 2.0  | 2.5  | 3.0          | 4.0 |        |        | 4.0<br>MOD       | 3.0 |                 | 3.5           | 4.0  | 5.0       | 24" |               |              | 30" | |
|                                              |                                                                                   |                    |     |     |                      |     |              |             |                                                |                        | 1.88            | 2.16 | 3.35 | 1.3          | 1.7 |        |        | 1.7              | 7.6 |                 | 9.0           | 10.8 | 14.6      | |
| OPTION ITEMS ( )                             | |
| CLARENDON:<br>I31+19.0, LT                   |  | I                  | 30  | 30  | 6.25                 |     |              |             |                                                |                        | I               |      |      | 13'-8"<br>X  |     | X      |        | X                | |</ |



**STATE OF VERMONT  
AGENCY OF TRANSPORTATION**

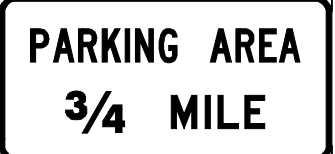
# TRAFFIC SIGN SUMMARY SHEET 11

| MILEMARKER,<br>STATION,<br>OR<br>SIGN NUMBER                                                                                                                                                         | SIGN<br>LEGEND | SIGN<br>DIMENSIONS |               |                | NEW & SALVAGED SIGNS |          |              |             | EXIST<br>POST<br>RETAIN | S<br>SALVAGE | NO.<br>OF<br>POSTS | NEW SIGN POSTS   |     |                    |                      |     |       |        |                            |     |     |                         |                 |     |                   |                   | RE<br>QUIR<br>ED<br>S<br>IG<br>N<br>M<br>E<br>N<br>T | REMARKS | SIGN DETAIL                 |                                                                                                                                                                                                                                                                             |       |           |       |        |              |       |     |     |  |  |  |
|---|
|                                                                                                                                                                                                      |                |                    |               |                |                      |          |              |             |                         |              |                    | FLANGED CHANNEL  |     |                    | SQUARE STEEL<br>(In) |     |       |        | TUBULAR ALUMINUM<br>Ø (In) |     |     | TUBULAR STEEL<br>Ø (In) |                 |     |                   | W-SHAPE STEEL     |                                                      |         | DETAIL<br>ON DWG.<br>NUMBER | STD.<br>SHEET<br>NUMBER                                                                                                                                                                                                                                                     |       |           |       |        |              |       |     |     |  |  |  |
|                                                                                                                                                                                                      |                | E<br>A             | WIDTH<br>(In) | HEIGHT<br>(In) | “A”                  | “B”      | SALV<br>SIGN | SALV<br>TIS |                         |              |                    | I.12             | 2.0 | 3.0                | 1.75                 | 2.0 | 2.5   | ANCHOR | SLEEVE                     | 3.0 | 4.0 | 4.0<br>MOD              | FOUND-<br>ATION | 3.0 | 3.5               | 4.0               |                                                      |         |                             |                                                                                                                                                                                                                                                                             | 5.0   | FTG. SIZE |       | WEIGHT | POST<br>SIZE |       |     |     |  |  |  |
|                                                                                                                                                                                                      |                lb/ft     | lb/ft |        |              | lb/ft | 24" | 30" |  |  |  |
|                                                                                                                                                                                                      |                |                    |               |                |                      |          |              |             |                         |              |                    | OPTION ITEMS ( ) |     |                    | CLARENDON:<br>139+34.0, LT                                                                                                                                                                           |                | I                  | 6             | 10             | 0.42                 |          |              |             |                         |              | I                  | 8'<br>X          |     |                    | X                    |     |       | X      |                            |     |     |                         |                 |     |                   |                   |                                                      |         |                             | SIGN ID CODE VD-700                                                                                                                                                                                                                                                         |       | E-I38     |       |        |              |       |     |     |  |  |  |
| |
| 148+32.0, LT                                                                                                                                                                                         |                | I                  | 138           | 60             |                      | 57.50    |              |             |                         |              | 2                  |                  |     |                    |                      |     |       | 2      |                            |     |     | 360.94<br>-397          |                 |     |                   |                   |                                                      |         |                             | 64                                                                                                                                                                                                                                                                          |       |           |       |        |              |       |     |     |  |  |  |
| |
| 148+87.0, LT                                                                                                                                                                                         |                | I                  | 6             | 10             | 0.42                 |          |              |             |                         |              | I                  | 8'<br>X          |     |                    | X                    |     |       | X      |                            |     |     |                         |                 |     |                   |                   |                                                      |         | SIGN ID CODE VD-700         |                                                                                                                                                                                                                                                                             | E-I38 |           |       |        |              |       |     |     |  |  |  |
| |
| 154+64.0, LT                                                                                                                                                                                         |                | I                  | 144           | 78             |                      | 78.00    |              |             |                         |              | 2                  |                  |     |                    |                      |     |       | 2      |                            |     |     | 570.61<br>-636          |                 |     |                   |                   |                                                      |         |                             | 66                                                                                                                                                                                                                                                                          |       |           |       |        |              |       |     |     |  |  |  |
| |
| 158+40.0, LT                                                                                                                                                                                         |                | I                  | 6             | 10             | 0.42                 |          |              |             |                         |              | I                  | 8'<br>X          |     |                    | X                    |     |       | X      |                            |     |     |                         |                 |     |                   |                   |                                                      |         | SIGN ID CODE VD-700         |                                                                                                                                                                                                                                                                             | E-I38 |           |       |        |              |       |     |     |  |  |  |
| |
| 161+13.0, LT                                                                                                                                                                                         |                | I                  | 36            | 48             | 12.00                |          |              |             |                         |              | 2                  |                  |     | 17'<br>X<br>17'-8" |                      |     |       |        |                            |     |     |                         |                 |     |                   |                   |                                                      |         | SIGN ID CODE R2-1           |                                                                                                                                                                                                                                                                             | E-I42 |           |       |        |              |       |     |     |  |  |  |
|                                                                                                                                                                                                      |                | I                  | 30            | 24             | 5.00                 |          |              SIGN ID CODE R8-7           |                                                                                                                                                                                                                                                                             | E-I42 |           |       |        |              |       |     |     |  |  |  |
| |
| 168+96.0, LT                                                                                                                                                                                         |                | I                  | 6             | 10             | 0.42                 |          |              |             |                         |              | I                  | 8'<br>X          |     |                    | X                    |     |       | X      |                            |     |     |                         |                 |     |                   |                   |                                                      |         | SIGN ID CODE VD-700         |                                                                                                                                                                                                                                                                             | E-I38 |           |       |        |              |       |     |     |  |  |  |
| |
| 170+55.0, LT                                                                                                                                                                                         |                | I                  | 6             | 8              | 0.33                 |          |              |             |                         |              | I                  | 8'<br>X          |     |                    | X                    |     |       | X      |                            |     |     |                         |                 |     |                   |                   |                                                      |         | SIGN ID CODE VD-701         |                                                                                                                                                                                                                                                                             | E-I34 |           |       |        |              |       |     |     |  |  |  |
| FINAL POST LENGTHS ARE TO BE DETERMINED IN THE FIELD. POST SIZES ARE COMPUTED BASED ON INFORMATION FURNISHED ON THE STANDARD SHEETS AND THE TRAFFIC OPERATIONS SECTION "SIGN POST DESIGN GUIDELINE." |                |                    |               |                |                      |          |              |             |                         |              |                    | LF - (70)        | LF  | LF 28 (-)          | LF - (70)            | LF  | LF    | EA     | LB                         | LB  | LB  |                         | LB              | LB  | LB 360.94<br>-397 | LB 570.61<br>-636 |                                                      |         |                             | PROJECT NAME: WALLINGFORD - RUTLAND TOWN<br>PROJECT NUMBER: NH 2408(I)S<br><br>FILE NAME: p04b050.dgn<br>PROJECT LEADER: D.E.G.<br>DESIGNED BY: J.S.P.<br>IPARM FILE: p04b050+ssll.i<br><br>PLOT DATE: \$DATE\$<br>DRAWN BY: C.A.K.<br>CHECKED BY: D.E.G.<br>SHEET 51 OF 80 |       |           |       |        |              |       |     |     |  |  |  |
| |
|                                                                                                                                                                                                      |                |                    |               |                | TOTALS               | SF 19.01 | SF 135.50    | EA.         | SF                      |              |                    | LF 28 (70)       |     | LF - (70)          |                      | LB  | EA. 4 |        | LB 931.55<br>-1033-        |     | EA. | EA.                     | LB              |     |                   |                   |                                                      |         |                             |                                                                                                                                                                                                                                                                             |       |           |       |        |              |       |     |     |  |  |  |



STATE OF VERMONT  
AGENCY OF TRANSPORTATION






# TRAFFIC SIGN SUMMARY SHEET 12

| MILEMARKER,<br>STATION,<br>OR<br>SIGN NUMBER                                                                                                                                                                        | SIGN<br>LEGEND                                                                                                                                                      | SIGN<br>DIMENSIONS |          |          | NEW & SALVAGED SIGNS |       |              |             | EXIST<br>POST<br>RETAIN<br>SALVAGE | NO.<br>OF<br>POSTS | FLANGED CHANNEL |                   |                 | SQUARE STEEL            |                 |        |        | TUBULAR ALUMINUM |     |                 | TUBULAR STEEL      |              |                    |                    | W-SHAPE STEEL |              |                                                                                 | RE<br>FO<br>R<br>I<br>N<br>G<br>M<br>E<br>R<br>E<br>D | REMARKS                                                  | SIGN DETAIL                                                                                           |                                                                         |        |       |
|---------------------------------------------------------------------------------------------------------------------------------------------------------------------------------------------------------------------|---------------------------------------------------------------------------------------------------------------------------------------------------------------------|--------------------|----------|----------|----------------------|-------|--------------|-------------|------------------------------------|--------------------|-----------------|-------------------|-----------------|-------------------------|-----------------|--------|--------|------------------|-----|-----------------|--------------------|--------------|--------------------|--------------------|---------------|--------------|---------------------------------------------------------------------------------|-------------------------------------------------------|----------------------------------------------------------|-------------------------------------------------------------------------------------------------------|-------------------------------------------------------------------------|--------|-------|
|                                                                                                                                                                                                                     |                                                                                                                                                                     |                    |          |          | "A"                  | "B"   | SALV<br>SIGN | SALV<br>TIS |                                    |                    | lb/ft           |                   |                 | (in)                    |                 | ANCHOR | SLEEVE | Ø (in)           |     | FOUND-<br>ATION | Ø (in)             |              | FTG. SIZE          |                    | WEIGHT        | POST<br>SIZE |                                                                                 |                                                       |                                                          |                                                                                                       |                                                                         |        |       |
|                                                                                                                                                                                                                     |                                                                                                                                                                     | 1.12               | 2.0      | 3.0      |                      |       |              |             |                                    |                    | 1.75            | 2.0               | 2.5             | 3.0                     | 4.0             |        |        | 4.0<br>MOD       | 3.0 |                 | 3.5                | 4.0          | 5.0                | 24"                |               |              | 30"                                                                             |                                                       |                                                          |                                                                                                       |                                                                         |        |       |
|                                                                                                                                                                                                                     |                                                                                                                                                                     | 1.12               | 2.0      | 3.0      |                      |       |              |             |                                    |                    | 1.88            | 2.16              | 3.35            | 1.3                     | 1.7             |        |        | 1.7              | 7.6 |                 | 9.0                | 10.8         | 14.6               |                    |               |              |                                                                                 |                                                       |                                                          |                                                                                                       |                                                                         |        |       |
| OPTION ITEMS ( )                                                                                                                                                                                                    |                                                                                                                                                                     |                    | CLARENDON:<br>171+66.0, LT                                                                                                                                                                                          |                                                                                    | I                  | 30       | 15       | 3.13                 |       |              |             |                                    |                    | 2               |                   |                 | 15'-4"<br>X<br>15'-8"   |                 |        |        |                  |     |                 |                    |              |                    |                    |               |              |                                                                                 |                                                       |                                                          | SIGN ID CODE M3-3                                                                                     |                                                                         | E-I36A |       |
|                                                                                                                                                                                                                     |                                                                                    | I                  | 36       | 36       | 9.00                 |       |              SIGN ID CODE MI-4                                                                                     |                                                                         | E-I36A |       |
| 173+75. LT                                                                                                                                                                                                          |                                                                                    |                    |          |          |                      |       |              | X           |                                    |                    | 173+75.0, LT                                                                                                                                                                                                        |                                                                                    | I                  | 138      | 60       |                      | 57.50 |              |             |                                    |                    | 2               |                   |                 |                         |                 |        |        |                  |     | 2               |                    | 275.2<br>271 |                    |                    |               |              |                                                                                 |                                                       |                                                          | 64                                                                                                    |                                                                         |        |       |
| 175+69.0, LT                                                                                                                                                                                                        |   | I<br>I             | 36<br>36 | 12<br>12 | 3.00<br>3.00         |       |              |             |                                    |                    | 1<br>-2         |                   |                 | 13'<br>X                |                 |        |        |                  |     |                 |                    |              |                    |                    |               |              |                                                                                 |                                                       | BACK-TO-BACK<br>SIGN ID CODE R6-IR<br>SIGN ID CODE R6-IL |                                                                                                       | E-I42<br>E-I42                                                          |        |       |
|                                                                                                                                                                                                                     |                                                                                    | I                  | 24       | 18       | 3.00                 |       |              SIGN ID CODE R6-3                                                                                     | 65                                                                      |        |       |
|                                                                                                                                                                                                                     |                                                                                    | I                  | 6        | 10       | 0.42                 |       |              SIGN ID CODE VD-700                                                                                   |                                                                         | E-I38  |       |
| 176+46.0, LT                                                                                                                                                                                                        |                                                                                    | I                  | 36       | 12       | 3.00                 |       |              |             |                                    |                    | 2               |                   |                 | 15'-10"<br>X<br>15'-10" |                 |        |        |                  |     |                 |                    |              |                    |                    |               |              |                                                                                 |                                                       |                                                          | SIGN ID CODE R6-IL                                                                                    |                                                                         | E-I42  |       |
|                                                                                                                                                                                                                     |                                                                                  | I                  | 36       | 36       | 9.00                 |       |              SIGN ID CODE R3-I                                                                                     |                                                                         | E-I43  |       |
|                                                                                                                                                                                                                     |                                                                                                                                                                     | 176+75.0, LT                                                                                                                                                                                                        |                                                                                  | I                  | 36       | 36       | 9.00                 |       |              |             |                                    |                    | 2               |                   |                 | 14'-10"<br>X<br>15'     |                 |        |        |                  |     |                 |                    |              |                    |                    |               |              |                                                                                 |                                                       |                                                          |                                                                                                       | SIGN ID CODE R5-I                                                       |        | E-I43 |
|                                                                                                                                                                                                                     |                                                                                                                                                                     | 176+75.0, RT                                                                                                                                                                                                        |                                                                                  | I                  | 36       | 36       | 9.00                 |       |              |             |                                    |                    | 2               |                   |                 | 14'<br>X<br>14'         |                 |        |        |                  |     |                 |                    |              |                    |                    |               |              |                                                                                 |                                                       |                                                          |                                                                                                       | SIGN ID CODE R5-I                                                       |        | E-I43 |
|                                                                                                                                                                                                                     |                                                                                                                                                                     | 177+48.0, LT                                                                                                                                                                                                        |                                                                                  | I                  | 36       | 24       | 6.00                 |       |              |             |                                    |                    | 2               |                   |                 | 13'-4"<br>X<br>13'-10"  |                 |        |        |                  |     |                 |                    |              |                    |                    |               |              |                                                                                 |                                                       |                                                          |                                                                                                       | SIGN ID CODE R5-IA                                                      |        | E-I43 |
| 179+26.0, LT                                                                                                                                                                                                        |                                                                                  | I                  | 6        | 10       | 0.42                 |       |              |             |                                    |                    | I               | 9'<br>X           |                 |                         | X               |        | X      |                  |     |                 |                    |              |                    |                    |               |              |                                                                                 |                                                       |                                                          |                                                                                                       | SIGN ID CODE VD-700                                                     |        | E-I38 |
| FINAL POST LENGTHS ARE TO BE DETERMINED<br>IN THE FIELD. POST SIZES ARE COMPUTED<br>BASED ON INFORMATION FURNISHED ON THE<br>STANDARD SHEETS AND THE TRAFFIC<br>OPERATIONS SECTION "SIGN POST DESIGN<br>GUIDELINE." |                                                                                                                                                                     |                    |          |          |                      |       |              | I           |                                    |                    |                 | LF<br>-<br>(14)   | LF              | LF<br>168<br>(-)        | LF<br>-<br>(14) | LF     | LF     | EA               | LB  | LB              | LB                 |              | LB                 | LB<br>275.2<br>271 | LB            | LB           |                                                                                 |                                                       |                                                          |                                                                                                       | PROJECT NAME: WALLINGFORD - RUTLAND TOWN<br>PROJECT NUMBER: NH 2408(I)S |        |       |
|                                                                                                                                                                                                                     |                                                                                                                                                                     |                    |          |          |                      |       |              |             |                                    |                    |                 | 169.65            |                 |                         |                 |        |        |                  |     |                 |                    |              | LB<br>275.2<br>271 |                    |               |              |                                                                                 |                                                       |                                                          | FILE NAME: p04b050.dgn<br>PROJECT LEADER: D.E.G.<br>DESIGNED BY: J.S.P.<br>IPARM FILE: p04b050+ssl2.i |                                                                         |        |       |
|                                                                                                                                                                                                                     |                                                                                                                                                                     |                    |          |          |                      |       |              |             |                                    |                    |                 | LF<br>168<br>(14) | LF<br>-<br>(14) |                         |                 |        | LB     |                  |     | EA.<br>2        | LB<br>275.2<br>271 |              |                    | EA.                | EA.           | LB           | PLOT DATE: \$DATE\$<br>DRAWN BY: C.A.K.<br>CHECKED BY: D.E.G.<br>SHEET 52 OF 80 |                                                       |                                                          |                                                                                                       |                                                                         |        |       |



STATE OF VERMONT  
AGENCY OF TRANSPORTATION

# TRAFFIC SIGN SUMMARY SHEET 13
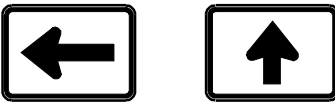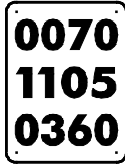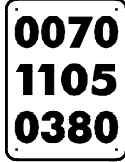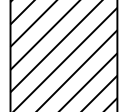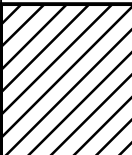
| MILEMARKER,<br>STATION,<br>OR<br>SIGN NUMBER                                                                                                                                                         | SIGN<br>LEGEND                                                                      | SIGN<br>DIMENSIONS |      |     | NEW & SALVAGED SIGNS |          |              |             |                                        |                                                                                      |                 |           | NEW SIGN POSTS |                       |           |      |     |                                                                                       |                 |     |                         |                    |                   |           | REMARKS       |               |  |                                                                                                       |                                        |                                                                                 |                  |                  |  |  | SIGN DETAIL   |              |     |     |
|------------------------------------------------------------------------------------------------------------------------------------------------------------------------------------------------------|-------------------------------------------------------------------------------------|--------------------|------|-----|----------------------|----------|--------------|-------------|----------------------------------------|--------------------------------------------------------------------------------------|-----------------|-----------|----------------|-----------------------|-----------|------|-----|---------------------------------------------------------------------------------------|-----------------|-----|-------------------------|--------------------|-------------------|-----------|---------------|---------------|--|-------------------------------------------------------------------------------------------------------|----------------------------------------|---------------------------------------------------------------------------------|------------------|------------------|--|--|---------------|--------------|-----|-----|
|                                                                                                                                                                                                      |                                                                                     |                    |      |     | “A”                  | “B”      | SALV<br>SIGN | SALV<br>TIS | EXIST<br>POST<br><br>RETAIN<br>SALVAGE | NO.<br>OF<br>POSTS                                                                   | FLANGED CHANNEL |           |                | SQUARE STEEL<br>(In)  |           |      |     | TUBULAR ALUMINUM<br>Ø (In)                                                            |                 |     | TUBULAR STEEL<br>Ø (In) |                    |                   |           |               |               |  |                                                                                                       |                                        |                                                                                 |                  |                  |  |  | W-SHAPE STEEL |              |     |     |
|                                                                                                                                                                                                      |                                                                                     | 1.75               | 2.0  | 2.5 |                      |          |              |             |                                        |                                                                                      |                 |           |                | ANCHOR                | SLEEVE    | 3.0  | 4.0 | 4.0<br>MOD                                                                            | FOUND-<br>ATION | 3.0 | 3.5                     | 4.0                | 5.0               | FTG. SIZE |               |               |  |                                                                                                       |                                        |                                                                                 |                  |                  |  |  | WEIGHT        | POST<br>SIZE |     |     |
|                                                                                                                                                                                                      |                                                                                     | lb/ft              | 1.12 | 2.0 |                      |          |              |             |                                        |                                                                                      | 3.0             | 1.88      | 2.16           |                       |           | 3.35 | 1.3 | 1.7                                                                                   |                 | 1.7 | 7.6                     | 9.0                | 10.8              | 14.6      |               |               |  |                                                                                                       |                                        |                                                                                 |                  |                  |  |  |               |              | 24" | 30" |
| OPTION ITEMS ( )                                                                                                                                                                                     |                                                                                     |                    | CLARENDON:<br>182+70.0, LT                                                                                                                                                                           |    | I                  | 30   | 15  | 3.13                 |          |              |             |                                        |                                                                                      | 2               |           |                |                       |           |      |     |                                                                                       |                 | 2   | 218.5<br>262            | 14'-11"<br>13'-10" |                   |           |               |               |  |                                                                                                       | X                                      | SIGN ID CODE M3-3<br>SIGN ID CODE M3-3                                          |                  | E-I36B<br>E-I36A |  |  |               |              |     |     |
|                                                                                                                                                                                                      |    | I                  | 45   | 36  | 11.25                |          |              SIGN ID CODE MI-5<br>SIGN ID CODE MI-4 |                                                                                 | E-I36B<br>E-I36A |                  |  |  |               |              |     |     |
|                                                                                                                                                                                                      |    | I                  | 21   | 15  | 2.19                 |          |              SIGN ID CODE M6-1<br>SIGN ID CODE M6-3 |                                                                                 | E-I36B<br>E-I36A |                  |  |  |               |              |     |     |
| 185+00.0, LT                                                                                                                                                                                         |    | I                  | 21   | 15  | 2.19                 |          |              |             |                                        |                                                                                      | 2               |           |                | 15'-2"<br>X<br>15'-9" |           |      |     |                                                                                       |                 |     |                         |                    |                   |           |               |               |  |                                                                                                       |                                        | SIGN ID CODE M2-1                                                               |                  | E-I36B           |  |  |               |              |     |     |
|                                                                                                                                                                                                      |    | I                  | 45   | 36  | 11.25                |          |              SIGN ID CODE MI-5                      |                                                                                 | E-I36B           |                  |  |  |               |              |     |     |
| 189+47 LT                                                                                                                                                                                            |    | I                  | 24   | 24  | 4.00                 |          |              | 189+47.0, LT                                                                                                                                                                                         |    | I                  | 138  | 108 |                      | 103.50   |              |             |                                        |                                                                                      | 2               |           |                |                       |           |      |     |                                                                                       | 2               |     |                         | 655.69<br>657      | 23'-1"<br>21'-10" |           |               |               |  |                                                                                                       |                                        | 65                                                                              |                  |                  |  |  |               |              |     |     |
| 189+55.0, LT                                                                                                                                                                                         |   | I                  | 6    | 10  | 0.42                 |          |              |             |                                        |                                                                                      | I               | 9'<br>X   |                | X                     |           | X    |     |                                                                                       |                 |     |                         |                    |                   |           |               |               |  |                                                                                                       | SIGN ID CODE VD-700                    |                                                                                 | E-I38            |                  |  |  |               |              |     |     |
| |
| 195+61.0, LT                                                                                                                                                                                         |  | I                  | 108  | 84  |                      | 63.00    |              |             |                                        |                                                                                      | 2               |           |                |                       |           |      |     | 2                                                                                     |                 |     | 374.44<br>402           | 17'-6"<br>17'-2"   |                   |           |               |               |  |                                                                                                       |                                        | 63                                                                              |                  |                  |  |  |               |              |     |     |
| |
| 200+11.0, LT                                                                                                                                                                                         |  | I                  | 6    | 10  | 0.42                 |          |              |             |                                        |                                                                                      | I               | 8'<br>X   |                | X                     |           | X    |     |                                                                                       |                 |     |                         |                    |                   |           |               |               |  |                                                                                                       | SIGN ID CODE VD-700                    |                                                                                 | E-I38            |                  |  |  |               |              |     |     |
| |
| 201+75.0, LT                                                                                                                                                                                         |  | I                  | 102  | 102 |                      | 72.25    |              |             |                                        |                                                                                      | 2               |           |                |                       |           |      |     | 2                                                                                     |                 |     | 385.13<br>412           | 18'-4"<br>17'-4"   |                   |           |               |               |  |                                                                                                       |                                        | 63                                                                              |                  |                  |  |  |               |              |     |     |
| |
| 210+67.0, LT                                                                                                                                                                                         |  | I                  | 6    | 10  | 0.42                 |          |              |             |                                        |                                                                                      | I               | 8'<br>X   |                | X                     |           | X    |     |                                                                                       |                 |     |                         |                    |                   |           |               |               |  |                                                                                                       | SIGN ID CODE VD-700                    |                                                                                 | E-I38            |                  |  |  |               |              |     |     |
| FINAL POST LENGTHS ARE TO BE DETERMINED IN THE FIELD. POST SIZES ARE COMPUTED BASED ON INFORMATION FURNISHED ON THE STANDARD SHEETS AND THE TRAFFIC OPERATIONS SECTION "SIGN POST DESIGN GUIDELINE." |                                                                                     |                    |      |     |                      |          |              |             |                                        |                                                                                      |                 | LF - (42) | LF             | LF 28 (-)             | LF - (42) | LF   | LF  |  | EA              | LB  | LB                      | LB                 | LB 218.5 262      | LB        | LB 759.57 814 | LB 655.69 657 |  |                                                                                                       |                                        | PROJECT NAME: WALLINGFORD - RUTLAND TOWN<br>PROJECT NUMBER: NH 2408(I)S         |                  |                  |  |  |               |              |     |     |
|                                                                                                                                                                                                      |                                                                                     |                    |      |     | TOTALS               | SF 45.59 | SF 238.75    | EA.         | SF                                     |  | LF 28 (42)      | LF - (42) |                |                       | LB        |      |     | EA. 8                                                                                 | LB 1633.76 1733 |     |                         | EA.                | EA.               | LB        |               |               |  | FILE NAME: p04b050.dgn<br>PROJECT LEADER: D.E.G.<br>DESIGNED BY: J.S.P.<br>IPARM FILE: p04b050+ssl3.i |                                        | PLOT DATE: \$DATE\$<br>DRAWN BY: C.A.K.<br>CHECKED BY: D.E.G.<br>SHEET 53 OF 80 |                  |                  |  |  |               |              |     |     |



STATE OF VERMONT  
AGENCY OF TRANSPORTATION




# TRAFFIC SIGN SUMMARY SHEET 14
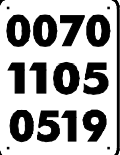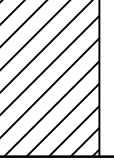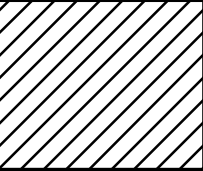
| MILEMARKER,<br>STATION,<br>OR<br>SIGN NUMBER                                                                                                                                                         | SIGN<br>LEGEND | SIGN<br>DIMENSIONS |               |                | NEW & SALVAGED SIGNS |             |              |             | EXIST<br>POST<br>RETAIN | SALVAGE | NO.<br>OF<br>POSTS | NEW SIGN POSTS   |                 |                       |                      |        |        |     |                            |            |                     |                         |     |     |     |                                                                         |                                                                                                                                                                                          | REQUIRE<br>SIGNMENT | REMARKS             |              |       |      | SIGN DETAIL                 |                         |     |     |     |     |     |  |  |  |  |
|---|
|                                                                                                                                                                                                      |                |                    |               |                |                      |             |              |             |                         |         |                    | FLANGED CHANNEL  |                 |                       | SQUARE STEEL<br>(In) |        |        |     | TUBULAR ALUMINUM<br>Ø (In) |            |                     | TUBULAR STEEL<br>Ø (In) |     |     |     | W-SHAPE STEEL                                                           |                                                                                                                                                                                          |                     |                     |              |       |      | DETAIL<br>ON DWG.<br>NUMBER | STD.<br>SHEET<br>NUMBER |     |     |     |     |     |  |  |  |  |
|                                                                                                                                                                                                      |                | E<br>A             | WIDTH<br>(In) | HEIGHT<br>(In) | “A”                  | “B”         | SALV<br>SIGN | SALV<br>TIS |                         |         |                    | Ib/f+            | 1.75            | 2.0                   | 2.5                  | ANCHOR | SLEEVE | 3.0 | 4.0                        | 4.0<br>MOD | FOUND-<br>ATION     | 3.0                     | 3.5 | 4.0 | 5.0 | FTG. SIZE                                                               |                                                                                                                                                                                          |                     | WEIGHT              | POST<br>SIZE |       |      |                             |                         |     |     |     |     |     |  |  |  |  |
|                                                                                                                                                                                                      |                1.12                                                                    | 2.0                                                                                                                                                                                      |                     |                     |              | 3.0   | 1.88 | 2.16                        | 3.35                    | 1.3 | 1.7 | 1.7 | 24" | 30" |  |  |  |  |
|                                                                                                                                                                                                      |                |                    |               |                |                      |             |              |             |                         |         |                    | OPTION ITEMS ( ) |                 |                       | CLARENDON:<br>221+37.0, LT                                                                                                                                                                           |                | I                  | 6             | 10             | 0.42                 |             |              |             |                         |         | I                  | 8'<br>X          |                 | X                     |                      | X      |        |     |                            |            |                     |                         |     |     |     |                                                                         |                                                                                                                                                                                          |                     | SIGN ID CODE VD-700 |              | E-I38 |      |                             |                         |     |     |     |     |     |  |  |  |  |
| |
| 229+50.0, LT                                                                                                                                                                                         |                | I                  | 144           | 78             |                      | 78.00       |              |             |                         |         | 2                  |                  |                 |                       |                      |        |        | 2   |                            |            |                     | 508.66<br>555           |     |     |     |                                                                         |                                                                                                                                                                                          |                     | 66                  |              |       |      |                             |                         |     |     |     |     |     |  |  |  |  |
| |
| 232+07.0, LT                                                                                                                                                                                         |                | I                  | 6             | 10             | 0.42                 |             |              |             |                         |         | I                  | 8'<br>X          |                 | X                     |                      | X      |        |     |                            |            |                     |                         |     |     |     |                                                                         |                                                                                                                                                                                          | SIGN ID CODE VD-700 |                     | E-I38        |       |      |                             |                         |     |     |     |     |     |  |  |  |  |
| |
| 239+69.0, LT                                                                                                                                                                                         |                | I                  | 36            | 48             | 12.00                |             |              |             |                         |         | 2                  |                  |                 | 16'<br>X<br>16'-6"    |                      |        |        |     |                            |            |                     |                         |     |     |     |                                                                         |                                                                                                                                                                                          | SIGN ID CODE R2-1   |                     | E-I42        |       |      |                             |                         |     |     |     |     |     |  |  |  |  |
| |
| 242+77.0, LT                                                                                                                                                                                         |                | I                  | 6             | 10             | 0.42                 |             |              |             |                         |         | I                  | 8'-6"<br>X       |                 | X                     |                      | X      |        |     |                            |            |                     |                         |     |     |     |                                                                         | SIGN ID CODE VD-700                                                                                                                                                                      |                     | E-I38               |              |       |      |                             |                         |     |     |     |     |     |  |  |  |  |
| |
| 248+60.0, LT                                                                                                                                                                                         |                | I                  | 30            | 15             | 3.13                 |             |              |             |                         |         | 2                  |                  |                 | 14'-6"<br>X<br>15'-6" |                      |        |        |     |                            |            |                     |                         |     |     |     |                                                                         | SIGN ID CODE M3-3                                                                                                                                                                        |                     | E-I36A              |              |       |      |                             |                         |     |     |     |     |     |  |  |  |  |
|                                                                                                                                                                                                      |                | I                  | 36            | 36             | 9.00                 |             |              SIGN ID CODE MI-4                                                                                                                                                                        |                     | E-I36A              |              |       |      |                             |                         |     |     |     |     |     |  |  |  |  |
| |
| 250+94.0, LT                                                                                                                                                                                         |                | I                  | 36            | 12             | 3.00                 |             |              |             |                         |         | 2                  |                  |                 | 15'-6"<br>X<br>15'-6" |                      |        |        |     |                            |            |                     |                         |     |     |     |                                                                         | BACK-TO-BACK<br>SIGN ID CODE R6-IR<br>SIGN ID CODE R6-IL                                                                                                                                 |                     | E-I42<br>E-I42      |              |       |      |                             |                         |     |     |     |     |     |  |  |  |  |
|                                                                                                                                                                                                      |                | I                  | 30            | 30             | 6.25                 |             |              BACK-TO-BACK<br>SIGN ID CODE RI-1<br>SIGN ID CODE VD-700                |                                                                                                                                                                                          | E-I43<br>E-I38      |                     |              |       |      |                             |                         |     |     |     |     |     |  |  |  |  |
|                                                                                                                                                                                                      |                | I                  | 24            | 18             | 3.00                 |             |              SIGN ID CODE R6-3                                                       | 65                                                                                                                                                                                       |                     |                     |              |       |      |                             |                         |     |     |     |     |     |  |  |  |  |
| FINAL POST LENGTHS ARE TO BE DETERMINED IN THE FIELD. POST SIZES ARE COMPUTED BASED ON INFORMATION FURNISHED ON THE STANDARD SHEETS AND THE TRAFFIC OPERATIONS SECTION "SIGN POST DESIGN GUIDELINE." |                |                    |               |                |                      |             |              |             |                         |         |                    | LF<br>-<br>(42)  | LF              | LF<br>84<br>(-)       | LF<br>-<br>(42)      | LF     | LF     | EA  | LB                         | LB         | LB                  | LB<br>508.66<br>555     |     |     |     | PROJECT NAME: WALLINGFORD - RUTLAND TOWN<br>PROJECT NUMBER: NH 2408(I)S |                                                                                                                                                                                          |                     |                     |              |       |      |                             |                         |     |     |     |     |     |  |  |  |  |
|                                                                                                                                                                                                      |                |                    |               |                | TOTALS               | SF<br>41.06 | SF<br>78.00  | EA.         | SF                      |         |                    | LF<br>84<br>(42) | LF<br>-<br>(42) |                       |                      |        | LB     |     |                            | EA.<br>2   | LB<br>508.66<br>555 |                         |     | EA. | EA. | LB                                                                      | FILE NAME: p04b050.dgn<br>PROJECT LEADER: D.E.G.<br>DESIGNED BY: J.S.P.<br>IPARM FILE: p04b050+ssl4.i<br>PLOT DATE: \$DATE\$<br>DRAWN BY: C.A.K.<br>CHECKED BY: D.E.G.<br>SHEET 54 OF 80 |                     |                     |              |       |      |                             |                         |     |     |     |     |     |  |  |  |  |













| STATE OF VERMONT<br>AGENCY OF TRANSPORTATION                                                                                                                                                                        |                                                                                                                                                                         |                    |          |          |                      |             |              |             |               | TRAFFIC SIGN SUMMARY SHEET 16                                                        |                    |                 |---|
| MILEMARKER,<br>STATION,<br>OR<br>SIGN NUMBER                                                                                                                                                                        | SIGN<br>LEGEND                                                                                                                                                          | SIGN<br>DIMENSIONS |          |          | NEW & SALVAGED SIGNS |             |              |             | EXIST<br>POST |                                                                                      | NEW SIGN POSTS     |                 |                  |                       |                      |        |     |                                                                                       |                            |                 |     |                         |     |     |           |               |                                                                                                       |              | REMARKS | SIGN DETAIL                    |                             |                                                          |                                                                         |                |       |      |                                                                                 |     |     |
|                                                                                                                                                                                                                     |                                                                                                                                                                         |                    |          |          | "A"                  | "B"         | SALV<br>SIGN | SALV<br>TIS | RETAIN        | SALVAGE                                                                              | NO.<br>OF<br>POSTS | FLANGED CHANNEL |                  |                       | SQUARE STEEL<br>(In) |        |     |                                                                                       | TUBULAR ALUMINUM<br>Ø (In) |                 |     | TUBULAR STEEL<br>Ø (In) |     |     |           | W-SHAPE STEEL |                                                                                                       |              |         | RE-<br>QUIRED<br>SIGN-<br>MENT | DETAIL<br>ON DWG.<br>NUMBER | STD.<br>SHEET<br>NUMBER                                  |                                                                         |                |       |      |                                                                                 |     |     |
|                                                                                                                                                                                                                     |                                                                                                                                                                         | lb/ft              | 2.0      | 3.0      |                      |             |              |             |               |                                                                                      |                    | 1.75            | 2.0              | 2.5                   | ANCHOR               | SLEEVE | 3.0 | 4.0                                                                                   | 4.0<br>MOD                 | FOUND-<br>ATION | 3.0 | 3.5                     | 4.0 | 5.0 | FTG. SIZE |               | WEIGHT                                                                                                | POST<br>SIZE |         |                                |                             |                                                          |                                                                         |                |       |      |                                                                                 |     |     |
|                                                                                                                                                                                                                     |                                                                                                                                                                         1.2       | 2.0           |                                                                                                       |              |         |                                |                             |                                                          | 3.0                                                                     | 1.88           | 2.16  | 3.35 | 1.3                                                                             | 1.7 | 1.7 |
|                                                                                                                                                                                                                     |                                                                                                                                                                         |                    |          |          |                      |             |              |             |               |                                                                                      | OPTION ITEMS ( )   |                 |                  | CLARENDON:<br>258+15.0, LT                                                                                                                                                                                          |                                                                                        | I                  | 6        | 8        | 0.33                 |             |              |             |               |                                                                                      | I                  | 8'<br>X         |                  |                       | X                    |        |     | X                                                                                     |                            |                 |     |                         |     |     |           |               |                                                                                                       |              |         |                                |                             |                                                          | SIGN ID CODE VD-70I                                                     |                | E-I34 |      |                                                                                 |     |     |
| |
| 258+90.0, LT                                                                                                                                                                                                        |                                                                                        | I                  | 6        | 8        | 0.33                 |             |              |             |               |                                                                                      | I                  | 8'<br>X         |                  |                       | X                    |        |     | X                                                                                     |                            |                 |     |                         |     |     |           |               |                                                                                                       |              |         |                                |                             |                                                          | SIGN ID CODE VD-70I                                                     |                | E-I34 |      |                                                                                 |     |     |
| |
| 259+25.0, LT                                                                                                                                                                                                        |                                                                                        | I                  | 21       | 15       | 2.19                 |             |              |             |               |                                                                                      | 2                  |                 |                  | 15'-8"<br>X<br>16'-6" |                      |        |     |                                                                                       |                            |                 |     |                         |     |     |           |               |                                                                                                       |              |         |                                |                             | SIGN ID CODE M2-I                                        |                                                                         | E-I36B         |       |      |                                                                                 |     |     |
|                                                                                                                                                                                                                     |                                                                                        | I                  | 36       | 36       | 9.00                 |             |              E-I36B         |       |      |                                                                                 |     |     |
| |
| 262+40.0, LT                                                                                                                                                                                                        |                                                                                       | I                  | 36       | 48       | 12.00                |             |              |             |               |                                                                                      | 2                  |                 |                  | 16'<br>X<br>17'-2"    |                      |        |     |                                                                                       |                            |                 |     |                         |     |     |           |               |                                                                                                       |              |         |                                |                             | SIGN ID CODE R2-I                                        |                                                                         | E-I42          |       |      |                                                                                 |     |     |
| |
| 264+16.0, LT                                                                                                                                                                                                        |                                                                                      | I                  | 6        | 10       | 0.42                 |             |              |             |               |                                                                                      | I                  | 8'-6"<br>X      |                  |                       | X                    |        |     | X                                                                                     |                            |                 |     |                         |     |     |           |               |                                                                                                       |              |         |                                |                             | SIGN ID CODE VD-700                                      |                                                                         | E-I38          |       |      |                                                                                 |     |     |
| |
| 271+95.0, LT                                                                                                                                                                                                        |                                                                                      | I                  | 30       | 15       | 3.13                 |             |              |             |               |                                                                                      | 2                  |                 |                  | 15'<br>X<br>15'-8"    |                      |        |     |                                                                                       |                            |                 |     |                         |     |     |           |               |                                                                                                       |              |         |                                |                             | SIGN ID CODE M3-3                                        |                                                                         | E-I36A         |       |      |                                                                                 |     |     |
|                                                                                                                                                                                                                     |                                                                                      | I                  | 36       | 36       | 9.00                 |             |              SIGN ID CODE MI-4                                        |                                                                         | E-I36A         |       |      |                                                                                 |     |     |
| |
| 273+62.0, LT                                                                                                                                                                                                        |   | I<br>I             | 36<br>36 | 12<br>12 | 3.00<br>3.00         |             |              |             |               |                                                                                      | I<br>↪             |                 |                  | 14'<br>X              |                      |        |     |                                                                                       |                            |                 |     |                         |     |     |           |               |                                                                                                       |              |         |                                |                             | BACK-TO-BACK<br>SIGN ID CODE R6-IR<br>SIGN ID CODE R6-IL |                                                                         | E-I42<br>E-I42 |       |      |                                                                                 |     |     |
|                                                                                                                                                                                                                     |   | I<br>I             | 24<br>6  | 18<br>10 | 3.00<br>0.42         |             |              BACK-TO-BACK<br>SIGN ID CODE R6-3<br>SIGN ID CODE VD-700 | 65                                                                      | E-I38          |       |      |                                                                                 |     |     |
| FINAL POST LENGTHS ARE TO BE DETERMINED<br>IN THE FIELD. POST SIZES ARE COMPUTED<br>BASED ON INFORMATION FURNISHED ON THE<br>STANDARD SHEETS AND THE TRAFFIC<br>OPERATIONS SECTION "SIGN POST DESIGN<br>GUIDELINE." |                                                                                                                                                                         |                    |          |          |                      |             |              |             |               |                                                                                      | LF<br>-<br>(42)    | LF              | LF<br>112<br>(-) | LF<br>-<br>(42)       | LF                   | LF     | LF  |  | EA                         | LB              | LB  | LB                      |     | LB  | LB        | LB            | LB                                                                                                    |              |         |                                |                             |                                                          | PROJECT NAME: WALLINGFORD - RUTLAND TOWN<br>PROJECT NUMBER: NH 2408(I)S |                |       |      |                                                                                 |     |     |
|                                                                                                                                                                                                                     |                                                                                                                                                                         |                    |          |          |                      |             |              |             |               |                                                                                      | 134.34             |                 |                  |                                                                                                                                                                                                                     |                                                                                                                                                                         |                    |          |          | TOTALS               | SF<br>45.82 | SF           | EA.         | SF            |  | LF<br>112<br>(42)  | LF<br>-<br>(42) |                  |                       |                      | LB     |     |                                                                                       | EA.                        | LB              |     |                         |     | EA. | EA.       | LB            | FILE NAME: p04b050.dgn<br>PROJECT LEADER: D.E.G.<br>DESIGNED BY: J.S.P.<br>IPARM FILE: p04b050+ssl6.i |              |         |                                |                             |                                                          |                                                                         |                |       |      | PLOT DATE: \$DATE\$<br>DRAWN BY: C.A.K.<br>CHECKED BY: D.E.G.<br>SHEET 56 OF 80 |     |     |

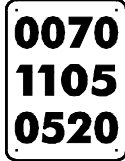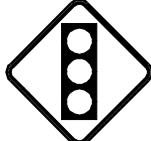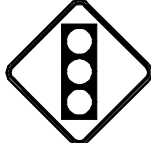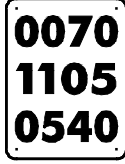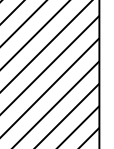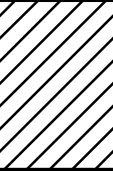

| STATE OF VERMONT<br>AGENCY OF TRANSPORTATION                                                                                                                                                                        |                                                                                     |                    |               |                |                      |             |              |             |               | TRAFFIC SIGN SUMMARY SHEET 17                                                        |                        |                  |---|
| MILEMARKER,<br>STATION,<br>OR<br>SIGN NUMBER                                                                                                                                                                        | SIGN<br>LEGEND                                                                      | SIGN<br>DIMENSIONS |               |                | NEW & SALVAGED SIGNS |             |              |             | EXIST<br>POST |                                                                                      | NO.<br>OF<br>POST<br>S | NEW SIGN POSTS   |                 |                       |                 |                 |                 |                                                                                       |          |                      |                         |            |                 |                      |               |     |     |                                                                                       |           |                                                                                                       |        | REMARKS                                                                         | SIGN DETAIL  |                                                                         |                     |      |        |     |     |     |     |
|                                                                                                                                                                                                                     |                                                                                     |                    |               |                |                      |             |              |             |               |                                                                                      |                        | FLANGED CHANNEL  |                 | SQUARE STEEL<br>(In)  |                 |                 |                 | TUBULAR ALUMINUM<br>Ø (In)                                                            |          |                      | TUBULAR STEEL<br>Ø (In) |            |                 |                      | W-SHAPE STEEL |     |     | RE<br>QUI<br>RE<br>D<br>S<br>I<br>G<br>N<br>M<br>A<br>T<br>E<br>R<br>I<br>A<br>L<br>S |           |                                                                                                       |        |                                                                                 |              |                                                                         |                     |      |        |     |     |     |     |
|                                                                                                                                                                                                                     |                                                                                     | E<br>A             | WIDTH<br>(In) | HEIGHT<br>(In) | "A"                  | "B"         | SALV<br>SIGN | SALV<br>TIS | RE<br>TAIN    | S<br>A<br>L<br>V<br>A<br>G<br>E                                                      |                        | lb/ft            | lb/ft           | lb/ft                 | 1.75            | 2.0             | 2.5             | ANCHOR                                                                                | SLEEVE   | 3.0                  | 4.0                     | 4.0<br>MOD | FOUND-<br>ATION | 3.0                  | 3.5           | 4.0 | 5.0 |                                                                                       | FTG. SIZE |                                                                                                       | WEIGHT |                                                                                 | POST<br>SIZE |                                                                         |                     |      |        |     |     |     |     |
|                                                                                                                                                                                                                     |                                                                                     1.2       | 2.0                                                                                                   |        |                                                                                 |              | 3.0                                                                     | 1.88                | 2.16 | 3.35   | 1.3 | 1.7 | 1.7 | 7.6 |
|                                                                                                                                                                                                                     |                                                                                     |                    |               |                |                      |             |              |             |               |                                                                                      |                        | OPTION ITEMS ( ) |                 |                       | CLARENDON:<br>273+62.0, LT                                                                                                                                                                                          |    | I                  | 24            | 12             | 2.00                 |             |              |             |               |                                                                                      | I                      |                  |                 | 14'<br>X              |                 |                 | X               | X                                                                                     |          |                      |                         |            |                 |                      |               |     |     |                                                                                       |           |                                                                                                       |        |                                                                                 |              |                                                                         | SIGN ID CODE M3-3   |      | E-I36A |     |     |     |     |
|                                                                                                                                                                                                                     |    | I                  | 24            | 24             | 4.00                 |             |              SIGN ID CODE MI-4   |      | E-I36A |     |     |     |     |
|                                                                                                                                                                                                                     |    | I                  | 21            | 15             | 2.19                 |             |              SIGN ID CODE M6-1   |      | E-I36A |     |     |     |     |
| |
| 274+15.0, LT                                                                                                                                                                                                        |    | I                  | 24            | 30             | 5.00                 |             |              |             |               |                                                                                      | I                      |                  |                 | 13'<br>X              |                 | X               |                 | X                                                                                     |          |                      |                         |            |                 |                      |               |     |     |                                                                                       |           |                                                                                                       |        |                                                                                 |              |                                                                         | SIGN ID CODE VR-017 |      | E-I41  |     |     |     |     |
| 274+93.0, LT                                                                                                                                                                                                        |    | I                  | 6             | 10             | 0.42                 |             |              |             |               |                                                                                      | I                      | 8'<br>X          |                 |                       | X               |                 |                 | X                                                                                     |          |                      |                         |            |                 |                      |               |     |     |                                                                                       |           |                                                                                                       |        |                                                                                 |              |                                                                         | SIGN ID CODE VD-700 |      | E-I38  |     |     |     |     |
| 277+00.0, LT                                                                                                                                                                                                        |    | I                  | 60            | 30             | 12.50                |             |              |             |               |                                                                                      | 2                      |                  |                 | 13'-8"<br>X<br>14'-8" |                 |                 SIGN ID CODE VR-941 |      | E-I45A |     |     |     |     |
| |
| 279+82.0, LT                                                                                                                                                                                                        |  | I                  | 6             | 8              | 0.33                 |             |              |             |               |                                                                                      | I                      | 8'<br>X          |                 |                       | X               |                 |                 | X                                                                                     |          |                      |                         |            |                 |                      |               |     |     |                                                                                       |           |                                                                                                       |        |                                                                                 |              |                                                                         | SIGN ID CODE VD-701 |      | E-I34  |     |     |     |     |
| |
| 281+86.0, LT                                                                                                                                                                                                        |  | I                  | 36            | 36             | 9.00                 |             |              |             |               |                                                                                      | 2                      |                  |                 |                       |                 |                 |                 |                                                                                       |          |                      |                         | 2          | 241.91<br>-241  |                      |               |     |     |                                                                                       |           |                                                                                                       |        |                                                                                 |              |                                                                         | SIGN ID CODE W3-3   |      | E-I52  |     |     |     |     |
|                                                                                                                                                                                                                     |  | I                  | 36            | 36             | 9.00                 |             |              SIGN ID CODE W11-8  | 63   |        |     |     |     |     |
| |
| 281+86.0, RT                                                                                                                                                                                                        |  | I                  | 36            | 36             | 9.00                 |             |              |             |               |                                                                                      | 2                      |                  |                 | 12'-6"<br>X<br>12'-6" |                 |                 SIGN ID CODE W3-3   |      | E-I52  |     |     |     |     |
| |
| 285+08.0, LT                                                                                                                                                                                                        |  | I                  | 6             | 10             | 0.42                 |             |              |             |               |                                                                                      | I                      | 9'-6"<br>X       |                 |                       | X               |                 |                 | X                                                                                     |          |                      |                         |            |                 |                      |               |     |     |                                                                                       |           |                                                                                                       |        |                                                                                 |              |                                                                         | SIGN ID CODE VD-700 |      | E-I38  |     |     |     |     |
| FINAL POST LENGTHS ARE TO BE DETERMINED<br>IN THE FIELD. POST SIZES ARE COMPUTED<br>BASED ON INFORMATION FURNISHED ON THE<br>STANDARD SHEETS AND THE TRAFFIC<br>OPERATIONS SECTION "SIGN POST DESIGN<br>GUIDELINE." |                                                                                     |                    |               |                |                      |             |              |             |               |                                                                                      |                        | LF<br>-<br>(42)  | LF<br>-<br>(42) | LF<br>56<br>(28)      | LF<br>-<br>(42) | LF<br>-<br>(14) | LF<br>-<br>(14) |  | EA       | LB                   | LB                      | LB         |                 | LB<br>241.91<br>-241 | LB            | LB  | LB  |                                                                                       |           |                                                                                                       |        |                                                                                 |              | PROJECT NAME: WALLINGFORD - RUTLAND TOWN<br>PROJECT NUMBER: NH 2408(I)S |                     |      |        |     |     |     |     |
|                                                                                                                                                                                                                     |                                                                                     |                    |               |                |                      |             |              |             |               |                                                                                      |                        | 105.84           |                 |                       |                                                                                                                                                                                                                     |                                                                                     |                    |               |                | TOTALS               | SF<br>53.86 | SF           | EA.         | SF            |  |                        | LF<br>56<br>(70) | LF<br>-<br>(70) |                       |                 | LB              |                 |                                                                                       | EA.<br>2 | LB<br>241.91<br>-241 |                         |            | EA.             | EA.                  | LB            |     |     |                                                                                       |           | FILE NAME: p04b050.dgn<br>PROJECT LEADER: D.E.G.<br>DESIGNED BY: J.S.P.<br>IPARM FILE: p04b050+ss17.1 |        | PLOT DATE: \$DATE\$<br>DRAWN BY: C.A.K.<br>CHECKED BY: D.E.G.<br>SHEET 57 OF 80 |              |                                                                         |                     |      |        |     |     |     |     |









**STATE OF VERMONT  
AGENCY OF TRANSPORTATION**

# TRAFFIC SIGN SUMMARY SHEET 18

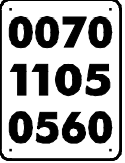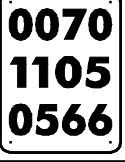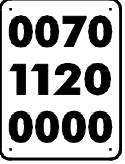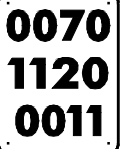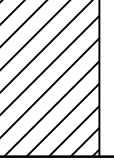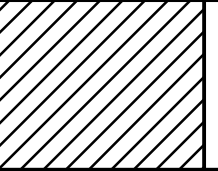[illegible]



| STATE OF VERMONT<br>AGENCY OF TRANSPORTATION                                                                                                                                                                        |                                                                                                                                                                         |                    |               |                |                      |             |              |             |               |                                                                                      |                    | TRAFFIC SIGN SUMMARY SHEET 19 |     |                      |---|
| MILEMARKER,<br>STATION,<br>OR<br>SIGN NUMBER                                                                                                                                                                        | SIGN<br>LEGEND                                                                                                                                                          | SIGN<br>DIMENSIONS |               |                | NEW & SALVAGED SIGNS |             |              |             | EXIST<br>POST |                                                                                      | NO.<br>OF<br>POSTS | NEW SIGN POSTS                |     |                      |                 |                 |     |                                                                                       |        |     |                         |            |                 |     |               |     |     |                                                                                                       |                                                          |                                                          |                     | REMARKS        | SIGN DETAIL  |  |  |  |  |                                                                                 |  |  |  |  |  |  |  |  |  |
|                                                                                                                                                                                                                     |                                                                                                                                                                         |                    |               |                |                      |             |              |             |               |                                                                                      |                    | FLANGED CHANNEL               |     | SQUARE STEEL<br>(In) |                 |                 |     | TUBULAR ALUMINUM<br>Ø (In)                                                            |        |     | TUBULAR STEEL<br>Ø (In) |            |                 |     | W-SHAPE STEEL |     |     | REQUIRE<br>SIGNED                                                                                     |                                                          |                                                          |                     |                |              |  |  |  |  |                                                                                 |  |  |  |  |  |  |  |  |  |
|                                                                                                                                                                                                                     |                                                                                                                                                                         | E<br>A             | WIDTH<br>(In) | HEIGHT<br>(In) | "A"                  | "B"         | SALV<br>SIGN | SALV<br>TIS | RETAIN        | SALVAGE                                                                              |                    | 1.12                          | 2.0 | 3.0                  | 1.75            | 2.0             | 2.5 | ANCHOR                                                                                | SLEEVE | 3.0 | 4.0                     | 4.0<br>MOD | FOUND-<br>ATION | 3.0 | 3.5           | 4.0 | 5.0 |                                                                                                       | FTG. SIZE                                                |                                                          | WEIGHT              |                | POST<br>SIZE |  |  |  |  |                                                                                 |  |  |  |  |  |  |  |  |  |
|                                                                                                                                                                                                                     |                                                                                                                                                                         24"                                                      | 30"                                                      |                     |                |              |  |  |  |  |                                                                                 |  |  |  |  |  |  |  |  |  |
|                                                                                                                                                                                                                     |                                                                                                                                                                         |                    |               |                |                      |             |              |             |               |                                                                                      |                    | OPTION ITEMS ( )              |     |                      | CLARENDON:<br>295+22.0, LT                                                                                                                                                                                          |                                                                                        | I                  | 6             | 10             | 0.42                 |             |              |             |               |                                                                                      | I                  | 8'-6"<br>X                    |     |                      | X               |                 |     | X                                                                                     |        |     |                         |            |                 |     |               |     |     |                                                                                                       |                                                          |                                                          | SIGN ID CODE VD-700 |                | E-I38        |  |  |  |  |                                                                                 |  |  |  |  |  |  |  |  |  |
| |
| 296+10.0, LT                                                                                                                                                                                                        |                                                                                        | I                  | 18            | 18             | 2.25                 |             |              |             |               |                                                                                      | I                  | 9'<br>X                       |     |                      | X               |                 |     | X                                                                                     |        |     |                         |            |                 |     |               |     |     |                                                                                                       |                                                          |                                                          | SIGN ID CODE OMI-I  |                | E-I50        |  |  |  |  |                                                                                 |  |  |  |  |  |  |  |  |  |
| |
| RUTLAND TOWN:<br>0+00.0, LT                                                                                                                                                                                         |                                                                                        | I                  | 36            | 24             | 6.00                 |             |              |             |               |                                                                                      | 1<br>-2-           |                               |     | 18'-8"<br>X          |                 |                 |     |                                                                                       |        |     |                         |            |                 |     |               |     |     |                                                                                                       |                                                          |                                                          | 65                  |                |              |  |  |  |  |                                                                                 |  |  |  |  |  |  |  |  |  |
|                                                                                                                                                                                                                     |                                                                                        | I                  | 6             | 10             | 0.42                 |             |              SIGN ID CODE VD-700 |                | E-I38        |  |  |  |  |                                                                                 |  |  |  |  |  |  |  |  |  |
|                                                                                                                                                                                                                     |                                                                                        | I                  | 6             | 10             | 0.42                 |             |              SIGN ID CODE VD-700 |                | E-I38        |  |  |  |  |                                                                                 |  |  |  |  |  |  |  |  |  |
| |
| 0+00.0, LT                                                                                                                                                                                                          |                                                                                      | I                  | 36            | 48             | 12.00                |             |              |             |               |                                                                                      | 2                  |                               |     | 17'<br>X             |                 |                 |     |                                                                                       |        |     |                         |            |                 |     |               |     |     |                                                                                                       |                                                          |                                                          | SIGN ID CODE R2-I   |                | E-I42        |  |  |  |  |                                                                                 |  |  |  |  |  |  |  |  |  |
|                                                                                                                                                                                                                     |                                                                                      | I                  | 30            | 24             | 5.00                 |             |              SIGN ID CODE R8-7   |                | E-I42        |  |  |  |  |                                                                                 |  |  |  |  |  |  |  |  |  |
| |
| 5+42.0, LT                                                                                                                                                                                                          |   | I<br>I             | 36<br>36      | 12<br>12       | 3.00<br>3.00         |             |              |             |               |                                                                                      | 2                  |                               |     | 14'<br>X             |                 |                 |     |                                                                                       |        |     |                         |            |                 |     |               |     |     |                                                                                                       |                                                          | BACK-TO-BACK<br>SIGN ID CODE R6-IR<br>SIGN ID CODE R6-IL |                     | E-I42<br>E-I42 |              |  |  |  |  |                                                                                 |  |  |  |  |  |  |  |  |  |
|                                                                                                                                                                                                                     |   | I<br>I             | 24<br>6       | 18<br>10       | 3.00<br>0.42         |             |              BACK-TO-BACK<br>SIGN ID CODE R6-3<br>SIGN ID CODE VD-700 | 65                                                       | E-I38               |                |              |  |  |  |  |                                                                                 |  |  |  |  |  |  |  |  |  |
| |
| 5+93.0, LT                                                                                                                                                                                                          |                                                                                      | I                  | 24            | 30             | 5.00                 |             |              |             |               |                                                                                      | I                  |                               |     | 13'<br>X             |                 | X               |     | X                                                                                     |        |     |                         |            |                 |     |               |     |     |                                                                                                       |                                                          | SIGN ID CODE VR-079                                      |                     | E-I41          |              |  |  |  |  |                                                                                 |  |  |  |  |  |  |  |  |  |
| |
| FINAL POST LENGTHS ARE TO BE DETERMINED<br>IN THE FIELD. POST SIZES ARE COMPUTED<br>BASED ON INFORMATION FURNISHED ON THE<br>STANDARD SHEETS AND THE TRAFFIC<br>OPERATIONS SECTION "SIGN POST DESIGN<br>GUIDELINE." |                                                                                                                                                                         |                    |               |                |                      |             |              |             |               |                                                                                      |                    | LF<br>-<br>(28)               | LF  | LF<br>84<br>(14)     | LF<br>-<br>(28) | LF<br>-<br>(14) | LF  |  | EA     | LB  | LB                      | LB         |                 | LB  | LB            | LB  | LB  |                                                                                                       |                                                          |                                                                                                                                                                                                                     |                                                                                                                                                                         |                    |               |                | 96.67                | |
|                                                                                                                                                                                                                     |                                                                                                                                                                         |                    |               |                | TOTALS               | SF<br>40.93 | SF           | EA.         | SF            |  | LF<br>84<br>(42)   | LF<br>-<br>(42)               |     |                      |                 | LB              |     |                                                                                       | EA.    | LB  |                         |            |                 | EA. | EA.           | LB  |     |                                                                                                       | PROJECT NAME: WALLINGFORD - RUTLAND TOWN<br>PROJECT NUMBER: NH 2408(I)S                                                                                                                                             |                                                                                                                                                                         |                    FILE NAME: p04b050.dgn<br>PROJECT LEADER: D.E.G.<br>DESIGNED BY: J.S.P.<br>IPARM FILE: p04b050+ssl9.i |                                                          |                                                          |                     |                |              |  |  |  |  | PLOT DATE: \$DATE\$<br>DRAWN BY: C.A.K.<br>CHECKED BY: D.E.G.<br>SHEET 59 OF 80 |  |  |  |  |  |  |  |  |  |






STATE OF VERMONT  
AGENCY OF TRANSPORTATION

# TRAFFIC SIGN SUMMARY SHEET 20
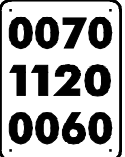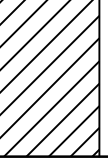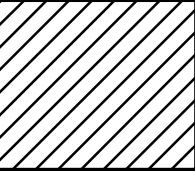
| MILEMARKER, STATION, OR SIGN NUMBER                                                                                                                                                                  | SIGN LEGEND | SIGN DIMENSIONS |     |           | NEW & SALVAGED SIGNS |          |                      |     | EXIST POST RETAIN | SALVAGE | NO. OF POSTS | NEW SIGN POSTS   |           |                 |                   |        |     |     |                         |             |     | REQUIRE SIGNMENT | REMARKS | SIGN DETAIL          |     |     |           |               |                                                                                                                                                                                   |                     |                                                                                                       |                                                                                 |       |
|------------------------------------------------------------------------------------------------------------------------------------------------------------------------------------------------------|-------------|-----------------|-----|-----------|----------------------|----------|----------------------|-----|-------------------|---------|--------------|------------------|-----------|-----------------|-------------------|--------|-----|-----|-------------------------|-------------|-----|------------------|---------|----------------------|-----|-----|-----------|---------------|-----------------------------------------------------------------------------------------------------------------------------------------------------------------------------------|---------------------|-------------------------------------------------------------------------------------------------------|---------------------------------------------------------------------------------|-------|
|                                                                                                                                                                                                      |             |                 |     |           |                      |          |                      |     |                   |         |              | FLANGED CHANNEL  |           |                 | SQUARE STEEL (In) |        |     |     | TUBULAR ALUMINUM Ø (In) |             |     |                  |         | TUBULAR STEEL Ø (In) |     |     |           | W-SHAPE STEEL |                                                                                                                                                                                   |                     | DETAIL ON DWG. NUMBER                                                                                 | STD. SHEET NUMBER                                                               |       |
|                                                                                                                                                                                                      |             | "A"             | "B" | SALV SIGN | SALV TIS             | 1.12     | 2.0                  | 3.0 |                   |         |              | 1.75             | 2.0       | 2.5             | ANCHOR            | SLEEVE | 3.0 | 4.0 | 4.0 MOD                 | FOUND-ATION | 3.0 |                  |         | 3.5                  | 4.0 | 5.0 | FTG. SIZE |               | WEIGHT                                                                                                                                                                            | POST SIZE           |                                                                                                       |                                                                                 |       |
|                                                                                                                                                                                                      |             lb/ft     | lb/ft         |                                                                                                                                                                                   |                     |                                                                                                       |                                                                                 | lb/ft |
|                                                                                                                                                                                                      |             |                 |     |           |                      |          |                      |     |                   |         |              | OPTION ITEMS ( ) |           |                 | RUTLAND TOWN: 7+52.0, LT                                                                                                                                                                             |             | I               | 18  | 18        | 2.25                 |          |                      |     |                   |         | I            | 9' X             |           |                 | X                 |        |     | X   |                         |             |     |                  |         |                      |     |     |           |               |                                                                                                                                                                                   | SIGN ID CODE OMI-I  |                                                                                                       | E-150                                                                           |       |
|                                                                                                                                                                                                      |             | 10+00.0, LT                                                                                                                                                                                          |             | I               | 60  | 30        | 12.50                |          |                      |     |                   |         | 2            |                  |           | 14' X 15'-8     |                   |        |     |     |                         |             |     |                  |         |                      |     |     |           |               |                                                                                                                                                                                   | SIGN ID CODE VR-94I |                                                                                                       | E-145A                                                                          |       |
|                                                                                                                                                                                                      |             | 10+50.0, LT                                                                                                                                                                                          |             | I               | 6   | 10        | 0.42                 |          |                      |     |                   |         | I            | 9' X             |           |                 | X                 |        |     | X   |                         |             |     |                  |         |                      |     |     |           |               |                                                                                                                                                                                   | SIGN ID CODE VD-700 |                                                                                                       | E-138                                                                           |       |
|                                                                                                                                                                                                      |             | 11+41.0, LT                                                                                                                                                                                          |             | I               | 120 | 48        |                      | 40.00    |                      |     SIGN SHALL BE MOUNTED OVER EXISTING OVERHEAD SIGN PANEL TO COMPLETELY COVER "RIGHT TURN/ U-TURN" TEXT. CONTRACTOR SHALL FIELD VERIFY ACTUAL SIGN DIMENSIONS PRIOR TO FABRICATION. | 66                  |                                                                                                       |                                                                                 |       |
|                                                                                                                                                                                                      |             | I               | 120 | 36        |                      | 30.00    | ADDED PER R.E., T.P. |     |                   DID NOT RETAIN EXISTING OVERHEAD SIGN PANEL.                                                                                                                                      |                     |                                                                                                       |                                                                                 |       |
| 16+71.0, RT                                                                                                                                                                                          |             | I               | 36  | 12        | 3.00                 |          |                      |     |                   |         | 2            |                  |           | 11'-6" X 11'-6" |                   |        |     |     |                         |             |     |                  |         |                      |     |     |           |               |                                                                                                                                                                                   | SIGN ID CODE R6-IL  |                                                                                                       | E-142                                                                           |       |
|                                                                                                                                                                                                      |             | 18+49.0, LT                                                                                                                                                                                          |             | I               | 36  | 36        | 9.00                 |          |                      |     |                   |         | 2            |                  |           | 13' X 13'-8"    |                   |        |     |     |                         |             |     |                  |         |                      |     |     |           |               |                                                                                                                                                                                   | SIGN ID CODE W4-I   |                                                                                                       | E-150                                                                           |       |
|                                                                                                                                                                                                      |             | 21+00.0, LT                                                                                                                                                                                          |             | I               | 6   | 10        | 0.42                 |          |                      |     |                   |         | I            | 8' X             |           |                 | X                 |        |     | X   |                         |             |     |                  |         |                      |     |     |           |               |                                                                                                                                                                                   | SIGN ID CODE VD-700 |                                                                                                       | E-138                                                                           |       |
|                                                                                                                                                                                                      |             | 21+75.0, LT                                                                                                                                                                                          |             | I               | 48  | 30        | 10.00                |          |                      |     |                   |         | 2            |                  |           | 14' X 14'-6"    |                   |        |     |     |                         |             |     |                  |         |                      |     |     |           |               |                                                                                                                                                                                   | SIGN ID CODE VR-935 |                                                                                                       | E-145B                                                                          |       |
|                                                                                                                                                                                                      |             | FINAL POST LENGTHS ARE TO BE DETERMINED IN THE FIELD. POST SIZES ARE COMPUTED BASED ON INFORMATION FURNISHED ON THE STANDARD SHEETS AND THE TRAFFIC OPERATIONS SECTION "SIGN POST DESIGN GUIDELINE." |             |                 |     |           |                      |          |                      |     |                   |         |              | LF - (42)        | LF        | LF 112 (-)      | LF - (42)         | LF     | LF  | EA  | LB                      | LB          | LB  |                  | LB      | LB                   | LB  | LB  |           |               |                                                                                                                                                                                   |                     | PROJECT NAME: WALLINGFORD - RUTLAND TOWN<br>PROJECT NUMBER: NH 2408(I)S                               |                                                                                 |       |
|                                                                                                                                                                                                      |             |                 |     |           |                      | 70.00    |                      |     |                   |         |              | 133.84           |           |                 |                   |        |     |     |                         |             |     |                  |         |                      |     |     |           |               |                                                                                                                                                                                   |                     | FILE NAME: p04b050.dgn<br>PROJECT LEADER: D.E.G.<br>DESIGNED BY: J.S.P.<br>IPARM FILE: p04b050+ss20.i | PLOT DATE: \$DATE\$<br>DRAWN BY: C.A.K.<br>CHECKED BY: D.E.G.<br>SHEET 60 OF 80 |       |
| TOTALS                                                                                                                                                                                               |             |                 |     |           | SF 37.59             | SF 40.00 | EA.                  | SF  |                   |         |              | LF 112 (42)      | LF - (42) |                 |                   |        | LB  |     |                         | EA.         | LB  |                  |         |                      | EA. | EA. | LB        |               |                                                                                                                                                                                   |                     |                                                                                                       |                                                                                 |       |



| STATE OF VERMONT<br>AGENCY OF TRANSPORTATION                                                                                                                                                                        |                                                                                     |                    |               |                |                      |             |              |             |               | TRAFFIC SIGN SUMMARY SHEET 21                                                        | |
|---|
| MILEMARKER,<br>STATION,<br>OR<br>SIGN NUMBER                                                                                                                                                                        | SIGN<br>LEGEND                                                                      | SIGN<br>DIMENSIONS |               |                | NEW & SALVAGED SIGNS |             |              |             | EXIST<br>POST |                                                                                      | NO.<br>OF<br>POSTS | NEW SIGN POSTS   |                     |                  |             |                      |        |                                                                                       |     |                            |            |                     |                         |      |     |                 |                     |                                          |        |                          |              | REMARKS                     | SIGN DETAIL         |                    |       |                                                                                                                                                                                                                     |                                                                                     |                    |               |                |                      |             |              |             |               |                                                                                      |                    | FLANGED CHANNEL  |                     |                  |             | SQUARE STEEL<br>(In) |        |                                                                                       |     | TUBULAR ALUMINUM<br>Ø (In) |            |                     | TUBULAR STEEL<br>Ø (In) |      |     |                 | W-SHAPE STEEL       |                                          |        | REQUIRE<br>SIGN<br>FRAME |              |                             |                                                                                                                                                                                                                     |                                                                                     | E<br>A             | WIDTH<br>(In) | HEIGHT<br>(In) | “A”                  | “B”         | SALV<br>SIGN | SALV<br>TIS | RETAIN        | SALVAGE                                                                              |                    | lb/ft            | 3.0                 | 1.75             | 2.0         | 2.5                  | ANCHOR | SLEEVE                                                                                | 3.0 | 4.0                        | 4.0<br>MOD | FOUND-<br>ATION     | 3.0                     | 3.5  | 4.0 | 5.0             | FTG. SIZE           |                                          | WEIGHT |                          | POST<br>SIZE |                             |                     |                                                                                                                                                                                                                     |                                                                                     24"                 | 30"                                      |        |                          | OPTION ITEMS ( )                                                                                                                                                                                                    |                                                                                     |                    |               |                |                      |             |              |             |               |                                                                                      |                    | 1.2              | 2.0                 | 3.0              | 1.88        | 2.16                 | 3.35   | 1.3                                                                                   | 1.7 | 1.7                        | 7.6        | 9.0                 | 10.8                    | 14.6 | |
| RUTLAND TOWN:<br>21+89.0, LT                                                                                                                                                                                        |    | I                  | 18            | 18             | 2.25                 |             |              |             |               |                                                                                      | I                  | 9'<br>X          |                     |                  | X           |                      |        | X                                                                                     |     |                            |            |                     |                         |      |     |                 |                     |                                          |        |                          |              |                             |                     | SIGN ID CODE OMI-I |       | E-I50                  |  |  | |
| 22+30.0, RT                                                                                                                                                                                                         |    | I                  | 30            | 30             | 6.25                 |             |              |             |               |                                                                                      | I                  |                  | 13'<br>X            |                  | X           |                      | X      |                                                                                       |     |                            |            |                     |                         |      |     |                 |                     |                                          |        |                          |              |                             |                     | SIGN ID CODE R3-7L |       | E-I40                  |  |  | |
| 24+92.0, LT                                                                                                                                                                                                         |    | I                  | 36            | 48             | 12.00                |             |              |             |               |                                                                                      | 2                  |                  | 16'<br>X<br>16'-6"  |                  |             SIGN ID CODE W13-2 |       | E-I50                  |  |  | |
| 27+22.0, LT                                                                                                                                                                                                         |    | I                  | 132           | 96             |                      | 88.00       |              |             |               |                                                                                      | 2                  |                  |                     |                  |             |                      |        |                                                                                       |     |                            | 2          |                     |                         |      |     | 530.56<br>-555- |                     |                                          |        |                          |              |                             |                     |                    | 67    |                        |  | |
| 30+67.0, LT                                                                                                                                                                                                         |  | I                  | 36            | 48             | 12.00                |             |              |             |               |                                                                                      | 2                  |                  | 15'<br>X<br>15'-10" |                  |             SIGN ID CODE R2-1  |       | E-I42                  |  |  | |
| 31+83.0, LT                                                                                                                                                                                                         |  | I                  | 6             | 10             | 0.42                 |             |              |             |               |                                                                                      | I                  | 9'<br>X          |                     | X                |             | X                    |        |                                                                                       |     |                            |            |                     |                         |      |     |                 |                     |                                          |        |                          |              |                             | SIGN ID CODE VD-700 |                    | E-I38 |                        |  | |
| |
| |
| |
| |
| FINAL POST LENGTHS ARE TO BE DETERMINED<br>IN THE FIELD. POST SIZES ARE COMPUTED<br>BASED ON INFORMATION FURNISHED ON THE<br>STANDARD SHEETS AND THE TRAFFIC<br>OPERATIONS SECTION "SIGN POST DESIGN<br>GUIDELINE." |                                                                                     |                    |               |                |                      |             |              |             |               |                                                                                      |                    | LF<br>-(28)      | LF                  | LF<br>56<br>(14) | LF<br>-(28) | LF<br>-(14)          | LF     |  | EA  | LB                         | LB         | LB                  |                         | LB   | LB  | LB              | LB<br>530.56<br>555 |                                          |        |                                                                                                                                                                                                                     |                                                                                     |                    |               |                | 94.33                | |
|                                                                                                                                                                                                                     |                                                                                     |                    |               |                | TOTALS               | SF<br>32.92 | SF<br>88.00  | EA.         | SF            |  |                    | LF<br>56<br>(42) |                     | LF<br>-(42)      |             |                      |        | LB                                                                                    |     | EA.<br>2                   |            | LB<br>530.56<br>555 |                         | EA.  | EA. | LB              |                     |                                          |                                                                                                                                                                                                                     |                                                                                     PROJECT NAME: WALLINGFORD - RUTLAND TOWN |        |                          |              | PROJECT NUMBER: NH 2408(I)S |                     |                    |       | FILE NAME: p04b050.dgn |  |  |  | PLOT DATE: \$DATE\$ |  |  |  | PROJECT LEADER: D.E.G. |  |  |  | DRAWN BY: C.A.K. |  |  |  | DESIGNED BY: J.S.P. |  |  |  | CHECKED BY: D.E.G. |  |  |  | SHEET 61 OF 80 |  |  |  |




STATE OF VERMONT  
AGENCY OF TRANSPORTATION

# TRAFFIC SIGN SUMMARY SHEET 22
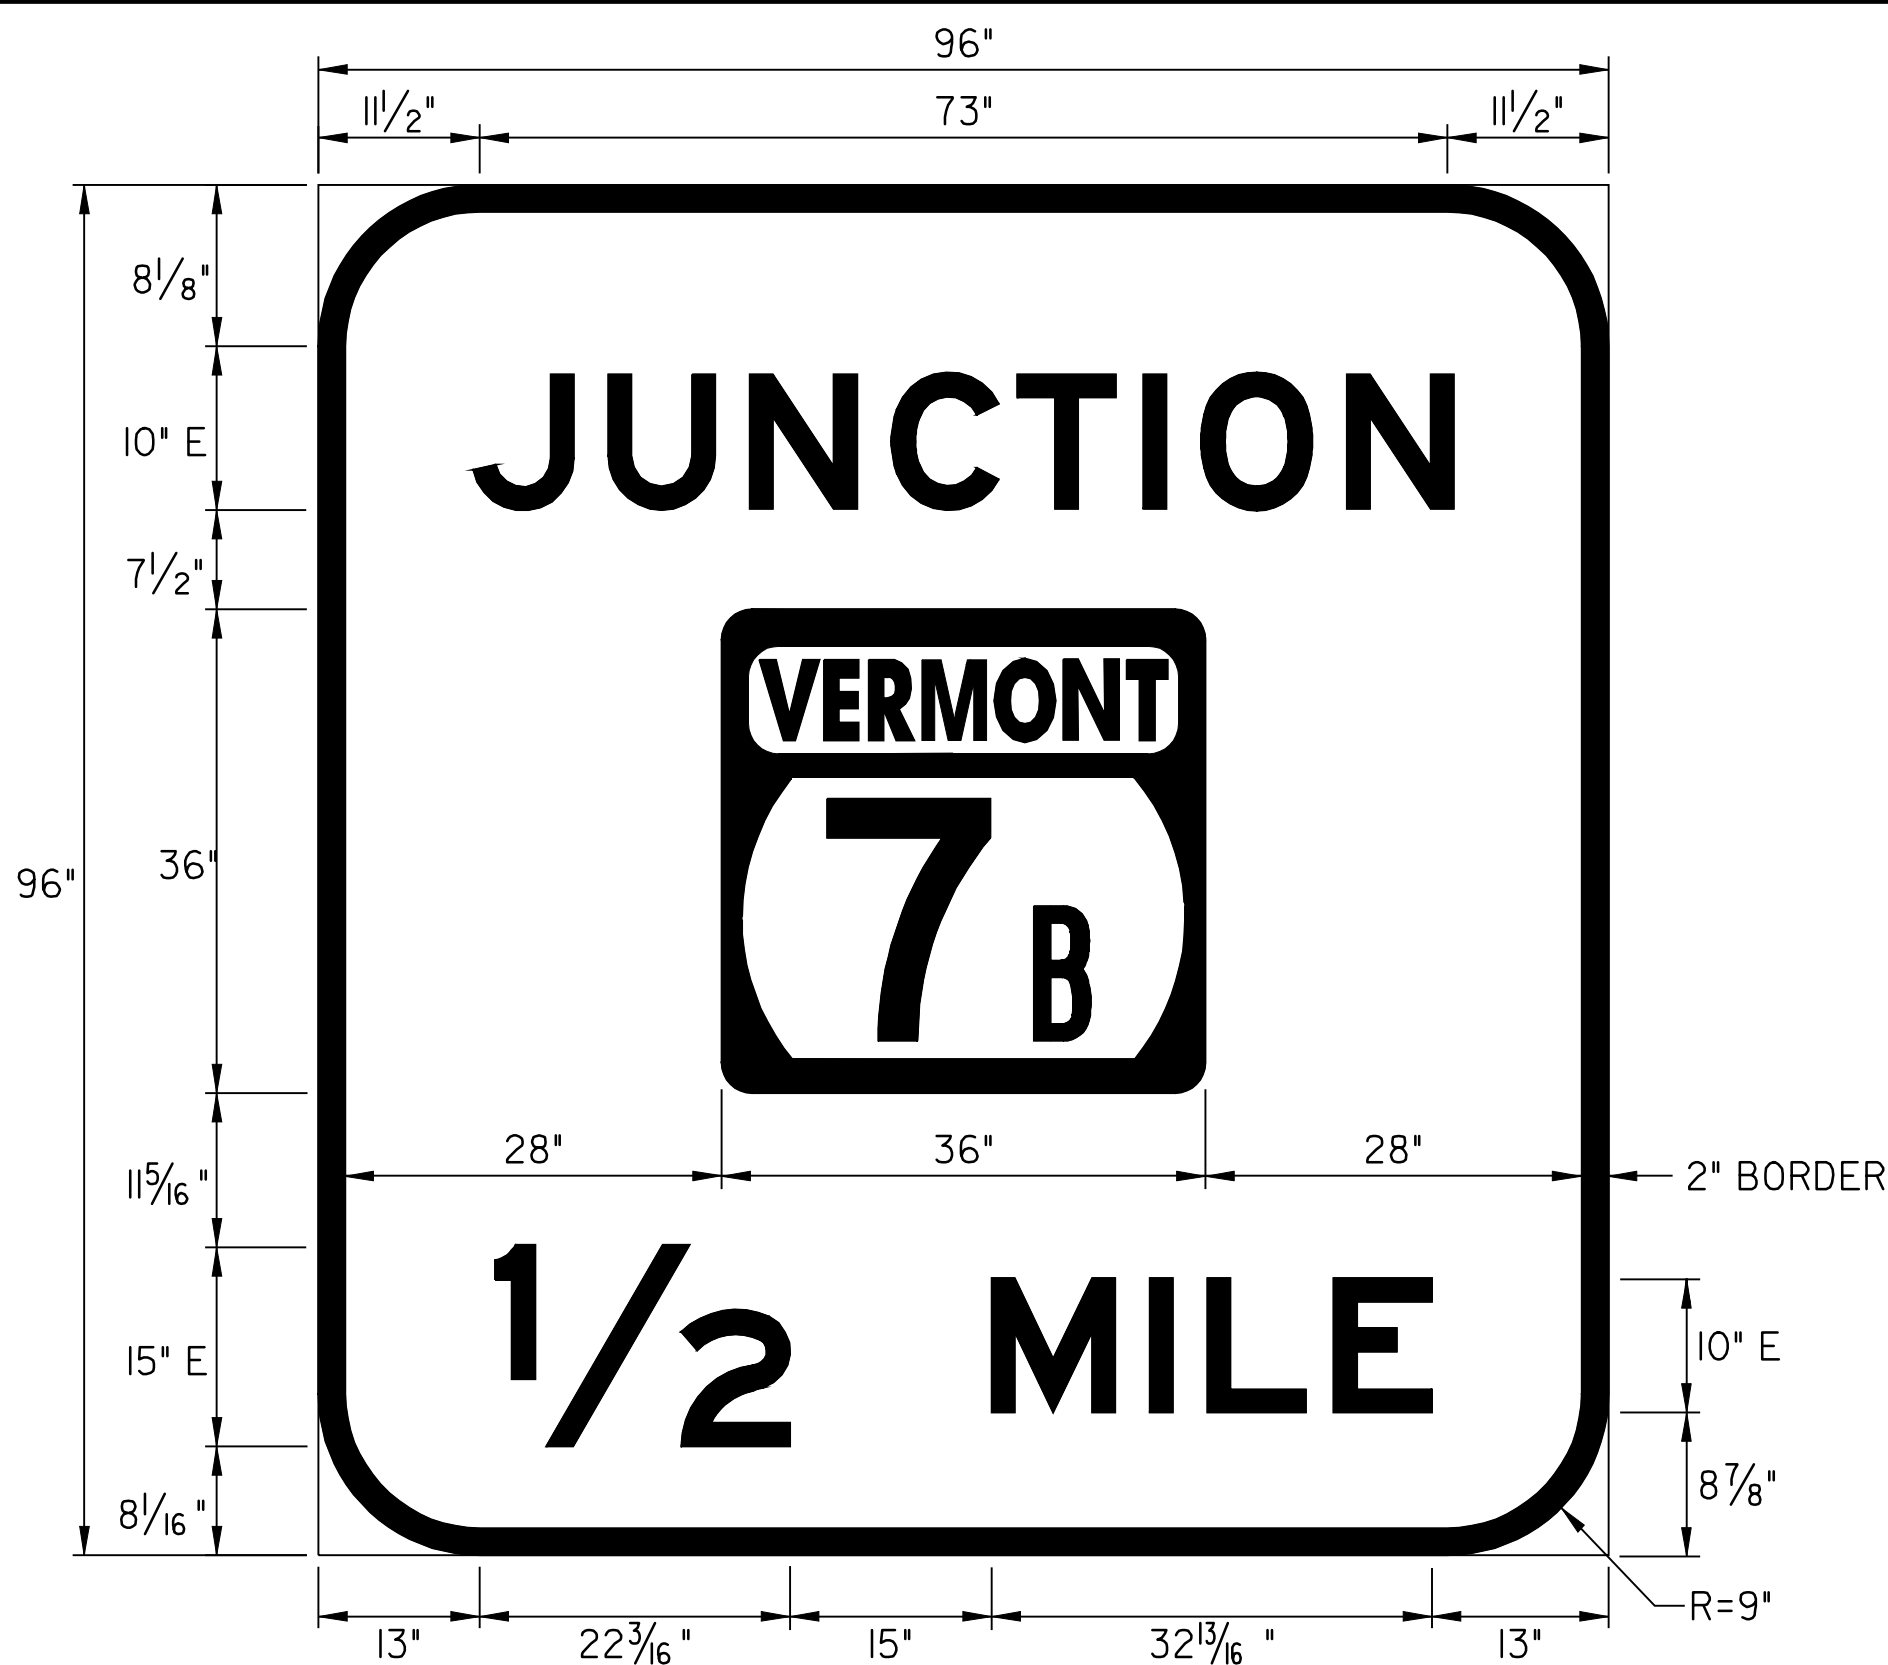
| MILEMARKER,<br>STATION,<br>OR<br>SIGN NUMBER                                                                                                                                                         | SIGN<br>LEGEND     | SIGN<br>DIMENSIONS |               |                | NEW & SALVAGED SIGNS |                         |                          |             | EXIST<br>POST | NO.<br>OF<br>POSTS | NEW SIGN POSTS  |                     |                       |                     |                      |             |            |      |                            |    | RE<br>QUIR<br>ED | REMARKS               |         |                     |                      | SIGN DETAIL           |                       |                         |                                                                                                       |                |   |               |                                                                                 |   |     |     |        |        |     |
|---|
|                                                                                                                                                                                                      |                    |                    |               |                |                      |                         |                          |             |               |                    | FLANGED CHANNEL |                     |                       |                     | SQUARE STEEL<br>(In) |             |            |      | TUBULAR ALUMINUM<br>Ø (In) |    |                  |                       |         |                     |                      |                       |                       | TUBULAR STEEL<br>Ø (In) |                                                                                                       |                |   | W-SHAPE STEEL |                                                                                 |   |     |     |        |        |     |
|                                                                                                                                                                                                      |                    | E<br>A             | WIDTH<br>(In) | HEIGHT<br>(In) | “A”                  | “B”                     | SALV<br>SIGN             | SALV<br>TIS |               |                    |                 |                     |                       |                     |                      |             |            |      |                            |    |                  | RETAIN                | SALVAGE | 1.12                | 2.0                  | 3.0                   | 1.75                  |                         |                                                                                                       |                |   |               |                                                                                 |   | 2.0 | 2.5 | ANCHOR | SLEEVE | 3.0 |
|                                                                                                                                                                                                      |                    |                    |               |                |                      |                         |                          |             |               |                    | 24"             | 30"                 |                       |                     |                                                                                                                                                                                                      |                    |                    |               |                |                      |                         |                          |             |               |                    |                 | OPTION ITEMS ( )    |                       |                     |                                                                                                                                                                                                      | SHEET 41 SUBTOTALS |                    |               |                | 81.59                | -                       | -                        |             |               |                    |                 | -                   | 199.65<br>(-)         | 140<br>(-)          | -                    | (56)        | (-)        | (-)  |                            | -  |                  |                       |         | -                   | -                    | -                     | -                     | -                       | -                                                                                                     | -              | - |               |                                                                                 |   |     |     |        |        |     |
|                                                                                                                                                                                                      | SHEET 42 SUBTOTALS |                    |               |                | 20.89                | -                       | -                        |             |               |                    |                 | -                   | 89.67<br>(-)          | 56<br>(-)           | -                    | (70)        | (-)        | (-)  |                            | -  |                  |                       |         | -                   | -                    | -                     | -                     | -                       | -                                                                                                     | -              | - | -             |                                                                                 |   |     |     |        |        |     |
|                                                                                                                                                                                                      | SHEET 43 SUBTOTALS |                    |               |                | 89.31                | -                       | -                        |             |               |                    |                 | -                   | 99.84<br>(-)          | 84<br>(14)          | -                    | (-)         | (14)       | (-)  |                            | -  |                  |                       | 2       | -                   | -250<br>214.7        | -                     | -                     | -                       | -                                                                                                     | -              | - | -             |                                                                                 |   |     |     |        |        |     |
|                                                                                                                                                                                                      | SHEET 44 SUBTOTALS |                    |               |                | 70.62                | -                       | -                        |             |               |                    |                 | -                   | 198.83<br>(-)         | 168<br>(-)          | -                    | (42)        | (-)        | (-)  |                            | -  |                  |                       | -       | -                   | -                    | -                     | -                     | -                       | -                                                                                                     | -              | - | -             |                                                                                 |   |     |     |        |        |     |
|                                                                                                                                                                                                      | SHEET 45 SUBTOTALS |                    |               |                | 65.42                | -                       | -                        |             |               |                    |                 | -                   | 173.16<br>(-)         | 140<br>(28)         | -                    | (14)        | (28)       | (-)  |                            | -  |                  |                       | -       | -                   | -                    | -                     | -                     | -                       | -                                                                                                     | -              | - | -             |                                                                                 |   |     |     |        |        |     |
|                                                                                                                                                                                                      | SHEET 46 SUBTOTALS |                    |               |                | 51.55                | -                       | -2.1                     |             |               |                    |                 | -                   | 127.0<br>(-)          | 112<br>(14)         | -                    | (14)        | (14)       | (-)  |                            | -  |                  |                       | -       | -                   | -                    | -                     | -                     | -                       | -                                                                                                     | -              | - | -             |                                                                                 |   |     |     |        |        |     |
|                                                                                                                                                                                                      | SHEET 47 SUBTOTALS |                    |               |                | 68.64                | -                       | -                        |             |               |                    |                 | -                   | 74.33<br>(-)          | 56<br>(14)          | -                    | (-)         | (-)        | (14) |                            | -  |                  |                       | 2       | -                   | -250<br>209.61       | -                     | -                     | -                       | -                                                                                                     | -              | - | -             |                                                                                 |   |     |     |        |        |     |
|                                                                                                                                                                                                      | SHEET 48 SUBTOTALS |                    |               |                | 64.61                | 120.75                  | -                        |             |               |                    |                 | -                   | 134.67<br>(-)         | 112<br>(-)          | -                    | (14)        | (-)        | (-)  |                            | -  |                  |                       | -       | -                   | -                    | -                     | -                     | 2                       | -                                                                                                     | 805.5<br>-812  |   |               |                                                                                 |   |     |     |        |        |     |
|                                                                                                                                                                                                      | SHEET 49 SUBTOTALS |                    |               |                | 21.51                | 64.00                   | -                        |             |               |                    |                 | -                   | 115<br>(-)            | 56<br>(14)          | -                    | (70)        | (-)        | (14) |                            | -  |                  |                       | 2       | -                   | -282.78<br>301       | 402<br>406.84         | -                     | -                       | -                                                                                                     | -              | - | -             | -                                                                               |   |     |     |        |        |     |
|                                                                                                                                                                                                      | SHEET 50 SUBTOTALS |                    |               |                | 94.92                | 42.25                   | -                        |             |               |                    |                 | -                   | 154.59<br>(-)         | 112<br>(28)         | -                    | (14)        | (28)       | (-)  |                            | -  |                  |                       | 2       | -                   | -301                 | -                     | -                     | -                       | -                                                                                                     | -              | - | -             |                                                                                 |   |     |     |        |        |     |
|                                                                                                                                                                                                      | SHEET 51 SUBTOTALS |                    |               |                | 19.01                | 135.50                  | -                        |             |               |                    |                 | -                   | 74.67<br>(-)          | 28<br>(-)           | -                    | (70)        | (-)        | (-)  |                            | -  |                  |                       | 4       | -                   | -275.2<br>271        | 397<br>360.94         | -636<br>570.61        | -                       | -                                                                                                     | -              | - | -             | -                                                                               |   |     |     |        |        |     |
|                                                                                                                                                                                                      | SHEET 52 SUBTOTALS |                    |               |                | 57.97                | 57.50                   | -1                       |             |               |                    |                 | -                   | 169.65<br>(-)         | 168<br>(-)          | -                    | (14)        | (-)        | (-)  |                            | -  |                  |                       | 2       | -                   | -271                 | -                     | -                     | -                       | -                                                                                                     | -              | - | -             |                                                                                 |   |     |     |        |        |     |
|                                                                                                                                                                                                      | SHEET 53 SUBTOTALS |                    |               |                | -45.59<br>49.59      | 238.75                  | -                        |             |               |                    |                 | -                   | 55.92<br>(-)          | 28<br>(-)           | -                    | (42)        | (-)        | (-)  |                            | -  |                  |                       | 8       | 262<br>218.5        | -                    | -814<br>759.57        | -657<br>555           | 655.69<br>508.66        | -                                                                                                     | -              | - | -             | -                                                                               |   |     |     |        |        |     |
|                                                                                                                                                                                                      | SHEET 54 SUBTOTALS |                    |               |                | 41.06                | 78.00                   | -                        |             |               |                    |                 | -                   | 118.0<br>(-)          | 84<br>(-)           | -                    | (42)        | (-)        | (-)  |                            | -  |                  |                       | 2       | -                   | -                    | -                     | -                     | -                       | -                                                                                                     | -              | - | -             | -                                                                               |   |     |     |        |        |     |
|                                                                                                                                                                                                      | SHEET 55 SUBTOTALS |                    |               |                | 71.38                | -                       | -                        |             |               |                    |                 | -                   | 100.5<br>(-)          | 84<br>(14)          | -                    | (14)        | (14)       | (-)  |                            | -  |                  |                       | 2       | 230<br>212.8        | -                    | -                     | -                     | -                       | -                                                                                                     | -              | - | -             | -                                                                               | - |     |     |        |        |     |
|                                                                                                                                                                                                      | SHEET 56 SUBTOTALS |                    |               |                | 45.82                | -                       | -                        |             |               |                    |                 | -                   | 134.34<br>(-)         | 112<br>(-)          | -                    | (42)        | (-)        | (-)  |                            | -  |                  |                       | -       | -                   | -                    | -                     | -                     | -                       | -                                                                                                     | -              | - | -             | -                                                                               | - |     |     |        |        |     |
|                                                                                                                                                                                                      | SHEET 57 SUBTOTALS |                    |               |                | 53.86                | -                       | -                        |             |               |                    |                 | -                   | 105.84<br>(-)         | 56<br>(28)          | -                    | (42)        | (14)       | (14) |                            | -  |                  |                       | 2       | 241<br>241.91       | -                    | -                     | -                     | -                       | -                                                                                                     | -              | - | -             | -                                                                               | - |     |     |        |        |     |
|                                                                                                                                                                                                      | SHEET 58 SUBTOTALS |                    |               |                | 42.13<br>37.13       | 218.00                  | -                        |             |               |                    |                 | -                   | 83.5<br>(-)           | 84<br>(14)          | -                    | (-)         | (14)       | (-)  |                            | -  |                  |                       | 2       | -                   | -                    | -                     | 498.88<br>501         | 2                       | -                                                                                                     | 960.75<br>1057 |   |               |                                                                                 |   |     |     |        |        |     |
|                                                                                                                                                                                                      | SHEET 59 SUBTOTALS |                    |               |                | 40.93                | -                       | -                        |             |               |                    |                 | -                   | 96.67<br>(-)          | 84<br>(14)          | -                    | (28)        | (14)       | (-)  |                            | -  |                  |                       | -       | -                   | -                    | -                     | -                     | -                       | -                                                                                                     | -              | - | -             | -                                                                               |   |     |     |        |        |     |
|                                                                                                                                                                                                      | SHEET 60 SUBTOTALS |                    |               |                | 37.59                | 70.00<br>40.00          | -                        |             |               |                    |                 | -                   | 133.84<br>(-)         | 112<br>(-)          | -                    | (42)        | (-)        | (-)  |                            | -  |                  |                       | -       | -                   | -                    | -                     | -                     | -                       | -                                                                                                     | -              | - | -             | -                                                                               | - |     |     |        |        |     |
|                                                                                                                                                                                                      | SHEET 61 SUBTOTALS |                    |               |                | 32.92                | 88.00                   | -                        |             |               |                    |                 | -                   | 94.33<br>(-)          | 56<br>(14)          | -                    | (28)        | (14)       | (-)  |                            | -  |                  |                       | 2       | -                   | -                    | -                     | -                     | 555<br>530.56           | -                                                                                                     | -              | - | -             | -                                                                               | - |     |     |        |        |     |
| |
| |
| FINAL POST LENGTHS ARE TO BE DETERMINED IN THE FIELD. POST SIZES ARE COMPUTED BASED ON INFORMATION FURNISHED ON THE STANDARD SHEETS AND THE TRAFFIC OPERATIONS SECTION "SIGN POST DESIGN GUIDELINE." |                    |                    |               |                |                      |                         |                          |             |               |                    |                 | LF<br>(658)         | LF<br>(-)             | LF<br>1932<br>(196) | LF<br>(658)          | LF<br>(154) | LF<br>(42) |      | EA                         | LB | LB               | LB                    |         | LB<br>673.21<br>733 | LB<br>982.29<br>1072 | LB<br>1613<br>1527.35 | LB<br>2764.40<br>2909 |                         |                                                                                                       |                |   |               |                                                                                 |   |     |     |        |        |     |
|                                                                                                                                                                                                      |                    |                    |               |                | TOTALS               | SF<br>112.32<br>1121.32 | SF<br>1082.75<br>1112.75 | EA.<br>2    | SF            |                    |                 | LF<br>1932<br>(854) | LF<br>2534.0<br>(854) |                     |                      |             | LB         |      |                            |    | EA.<br>32        | LB<br>5947.25<br>6327 |         |                     |                      | EA.<br>4              | EA.<br>-              | LB<br>1766.25<br>1869   |                                                                                                       |                |   |               | PROJECT NAME: WALLINGFORD - RUTLAND TOWN<br>PROJECT NUMBER: NH 2408(1)S         |   |     |     |        |        |     |
|                                                                                                                                                                                                      |                    FILE NAME: p04b050.dgn<br>PROJECT LEADER: D.E.G.<br>DESIGNED BY: J.S.P.<br>IPARM FILE: p04b050+ss22.1 |                |   |               | PLOT DATE: \$DATE\$<br>DRAWN BY: C.A.K.<br>CHECKED BY: D.E.G.<br>SHEET 62 OF 80 |   |     |     |        |        |     |






COLOR: WHITE BORDER & TEXT (REFLECTORIZED)  
GREEN BACKGROUND (REFLECTORIZED)

MATERIAL: PER VAOT STANDARD E-131

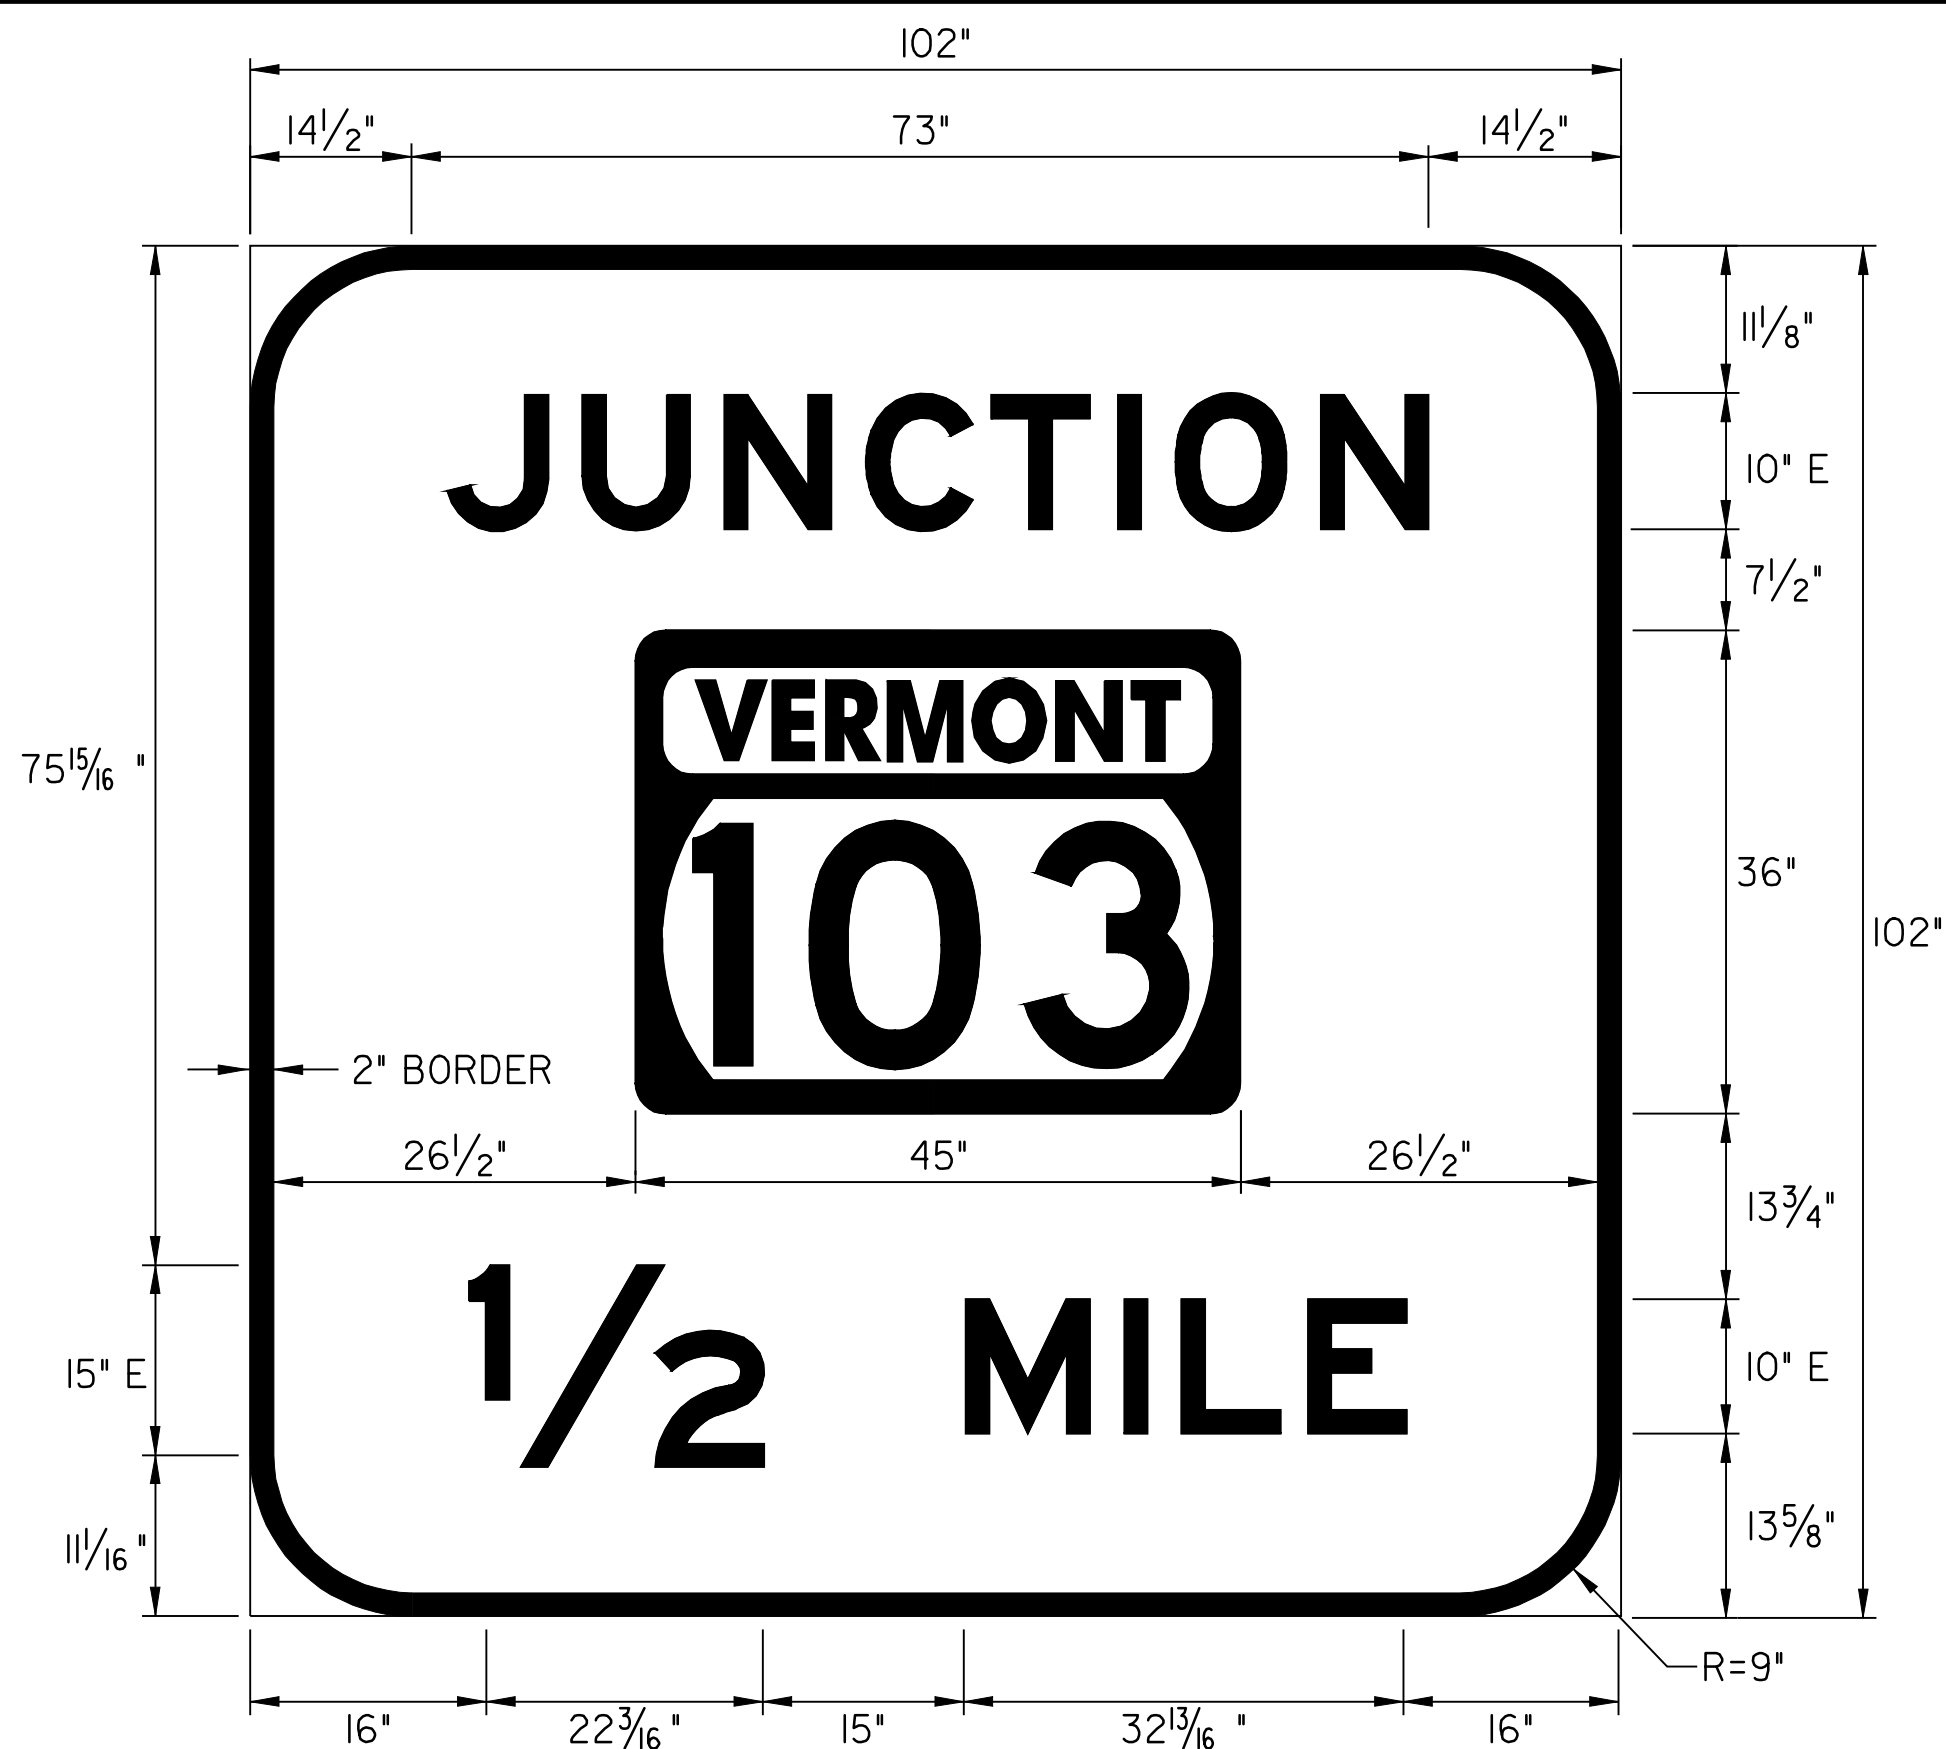
LOCATION: U.S. ROUTE 7  
CLARENDON:  
STA. 104+00.0, LT



COLOR: WHITE BORDER & TEXT (REFLECTORIZED)  
GREEN BACKGROUND (REFLECTORIZED)

MATERIAL: PER VAOT STANDARD E-131

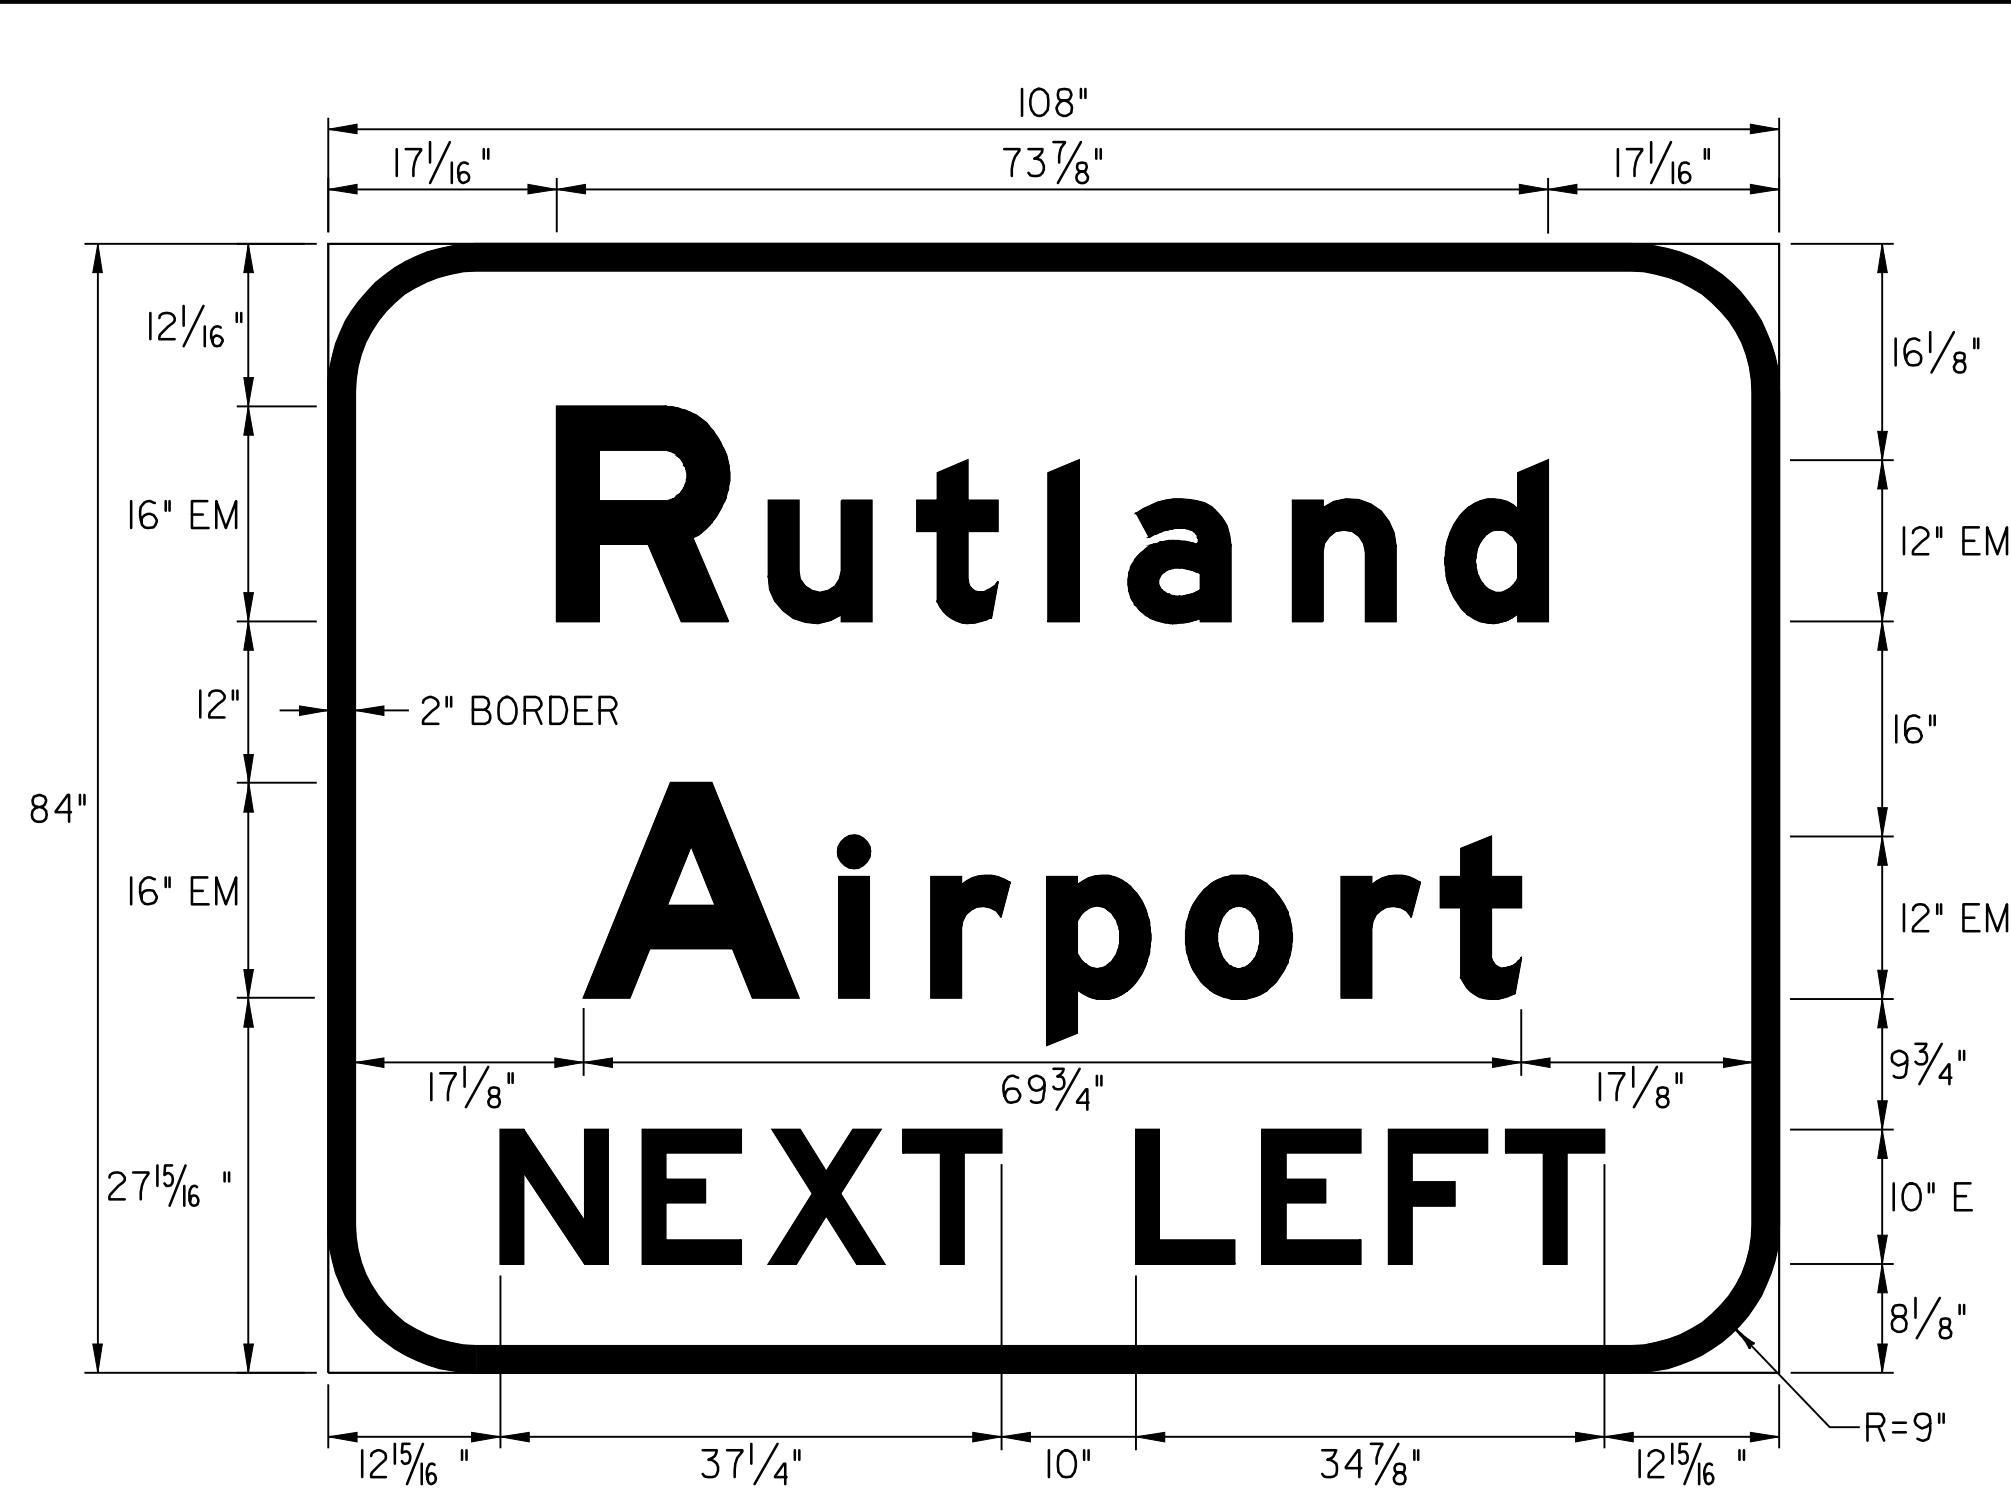
LOCATION: U.S. ROUTE 7  
CLARENDON:  
STA. 201+75.0, LT



COLOR: WHITE BORDER & TEXT (REFLECTORIZED)  
GREEN BACKGROUND (REFLECTORIZED)

MATERIAL: PER VAOT STANDARD E-131

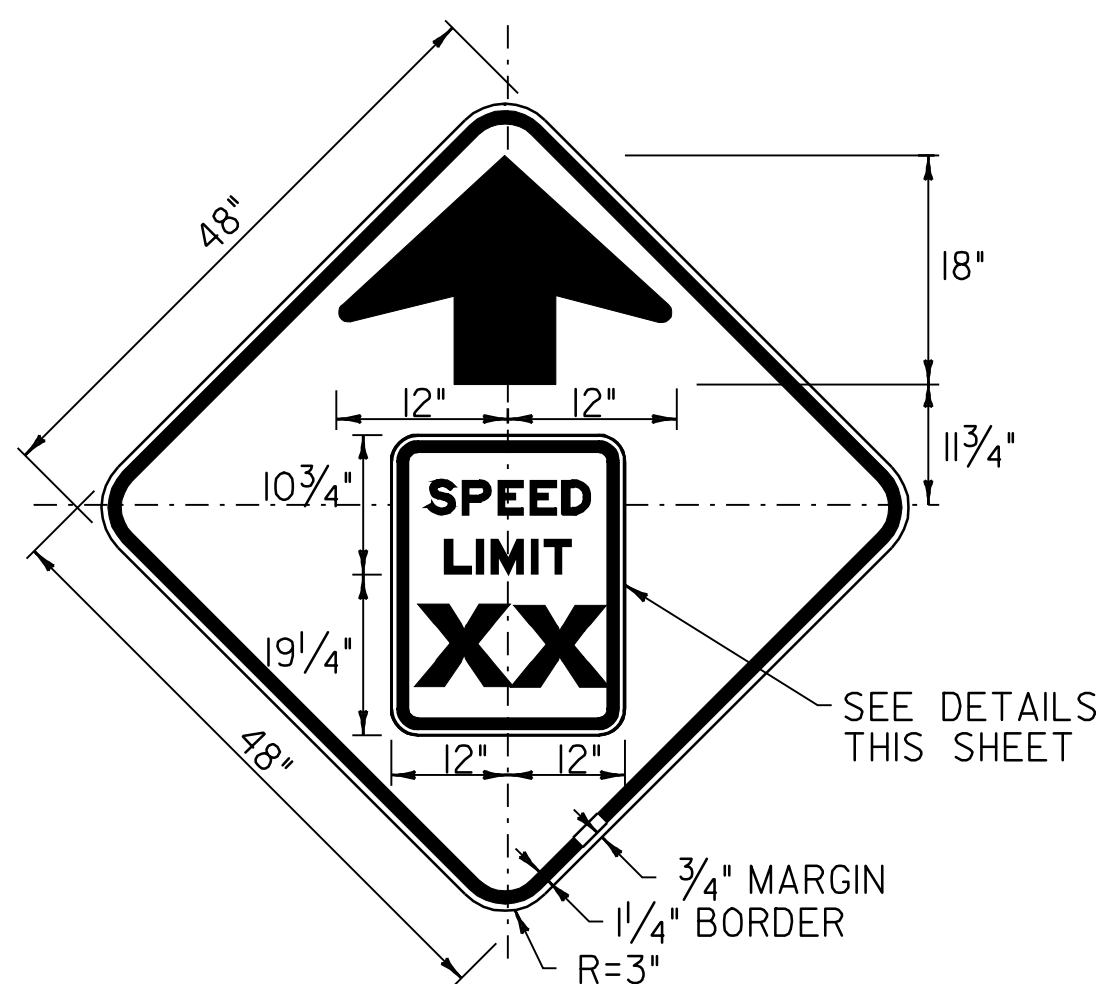
LOCATION: U.S. ROUTE 7  
CLARENDON:  
STA. 195+61.0, LT




COLOR: BLACK BORDER & ARROW  
YELLOW BACKGROUND (RETROREFLECTIVE)

MATERIAL: PER VAOT STANDARD E-151

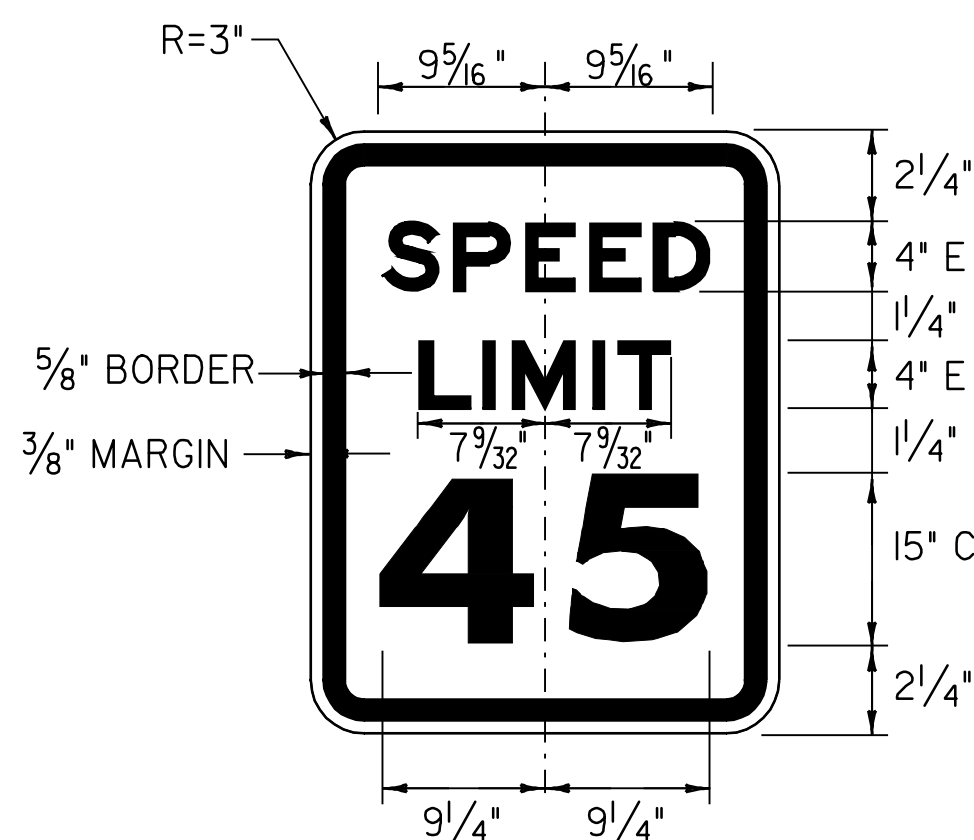LOCATION: U.S. ROUTE 7  
WALLINGFORD:  
STA. 351+50.0, LT



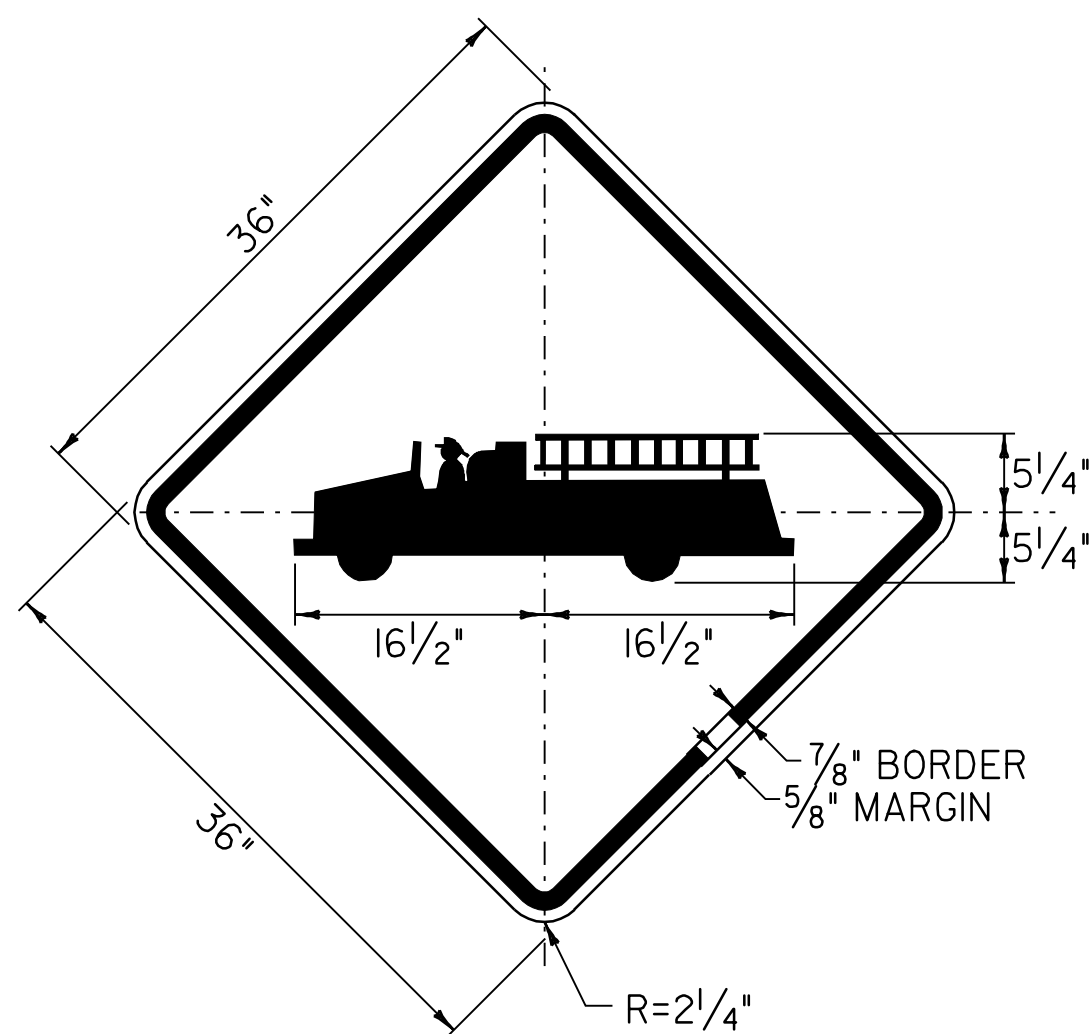
COLOR: BLACK BORDER & TEXT (REFLECTORIZED)  
WHITE BACKGROUND (REFLECTORIZED)



COLOR: BLACK BORDER & TEXT (REFLECTORIZED)  
YELLOW BACKGROUND (REFLECTORIZED)

MATERIAL: PER VAOT STANDARD E-151

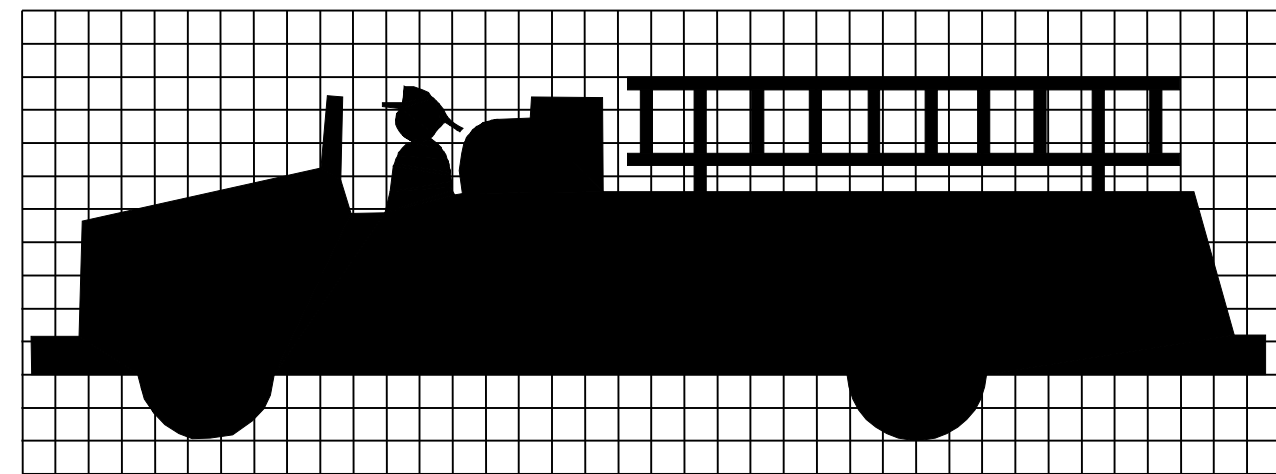
LOCATION: U.S. ROUTE 7  
CLARENDON:  
STA. 281+86.0, LT



NOTE:  
TEXT LAYOUT DIMENSIONS ARE BASED ON THE STANDARD ALPHABETS SPACING CHARTS  
FOUND IN THE "STANDARD HIGHWAY SIGNS" BOOK PUBLISHED BY FHWA. MINOR VARIATIONS  
IN TEXT DIMENSIONS ARE ACCEPTABLE BASED ON INDIVIDUAL MANUFACTURER'S LETTER  
FABRICATION. SIGNIFICANT CHANGES THAT AFFECT SIGN APPEARANCE SHALL BE BROUGHT  
TO THE ATTENTION OF VAOT'S TRAFFIC OPERATIONS SECTION BEFORE FABRICATION.

|                                    |                                                                                                      |                                                                                 |
|------------------------------------|------------------------------------------------------------------------------------------------------|---------------------------------------------------------------------------------|
| TRAFFIC SIGN<br>DETAIL<br>SHEET #1 | PROJECT NAME: WALLINGFORD - RUTLAND TOWN                                                             |                                                                                 |
|                                    | PROJECT NUMBER: NH 2408(1)S                                                                          |                                                                                 |
|                                    | FILE NAME: p04b050.dgn<br>PROJECT LEADER: D.E.G.<br>DESIGNED BY: J.S.P.<br>IPARM FILE: p04b050+sd1.1 | PLOT DATE: \$DATE\$<br>DRAWN BY: C.A.K.<br>CHECKED BY: D.E.G.<br>SHEET 63 OF 80 |




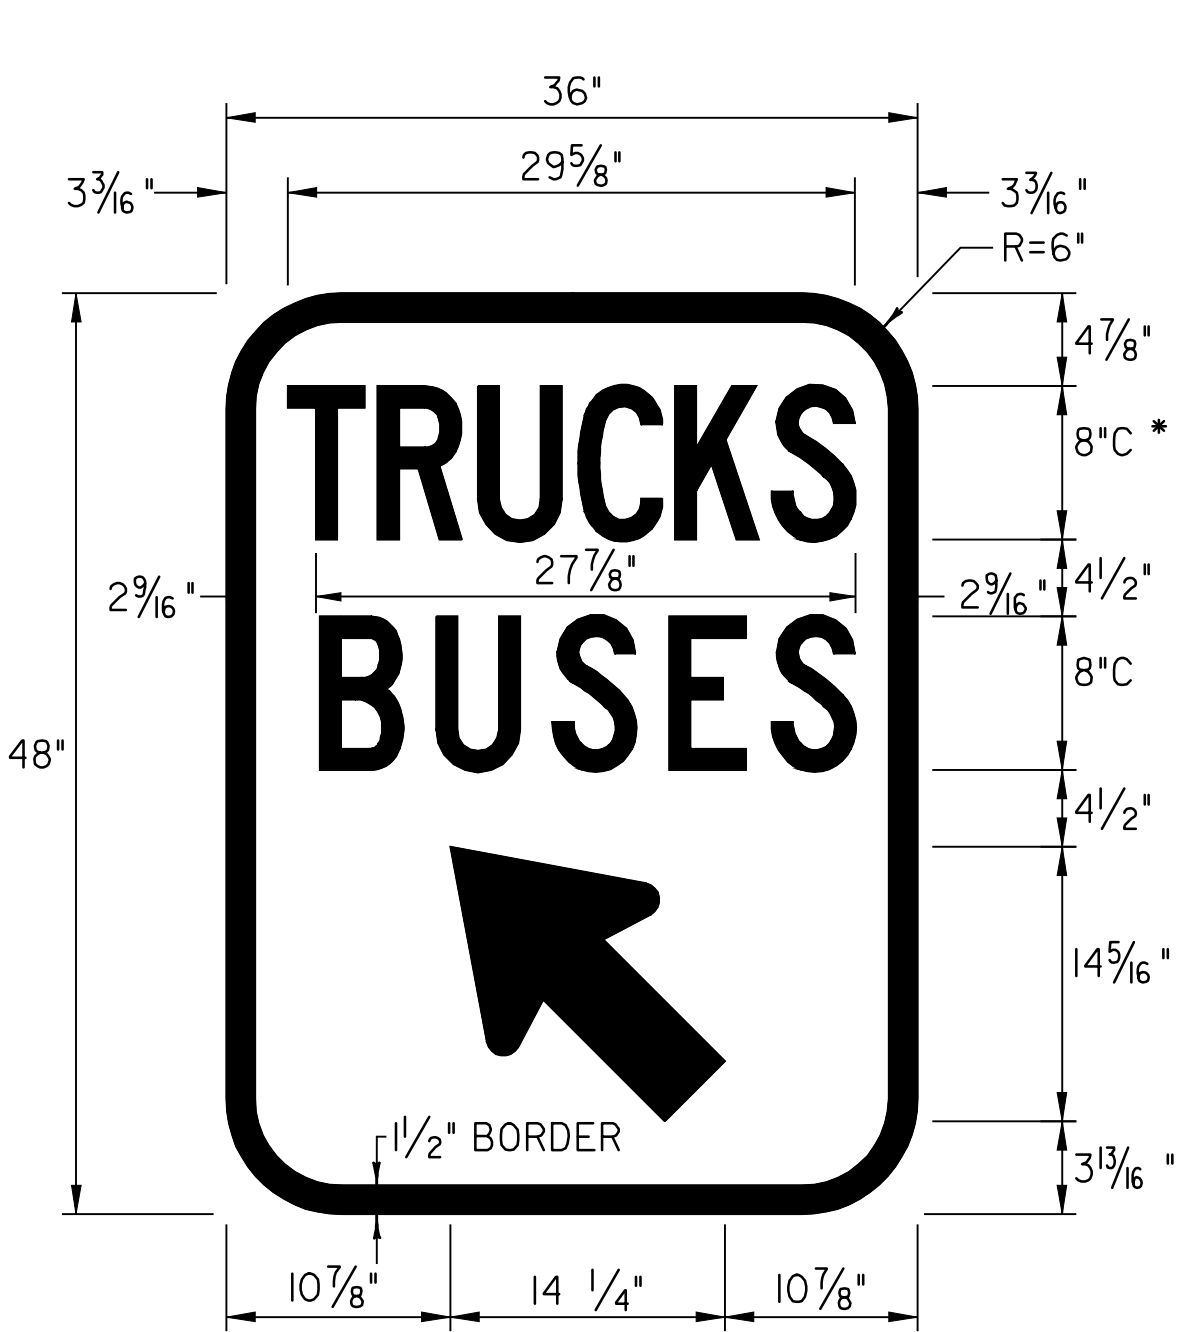

COLOR: WHITE BORDER & TEXT (REFLECTORIZED)  
BLUE BACKGROUND (REFLECTORIZED)

MATERIAL: PER VAOT STANDARD E-131  
\*50% REDUCTION IN SPACING

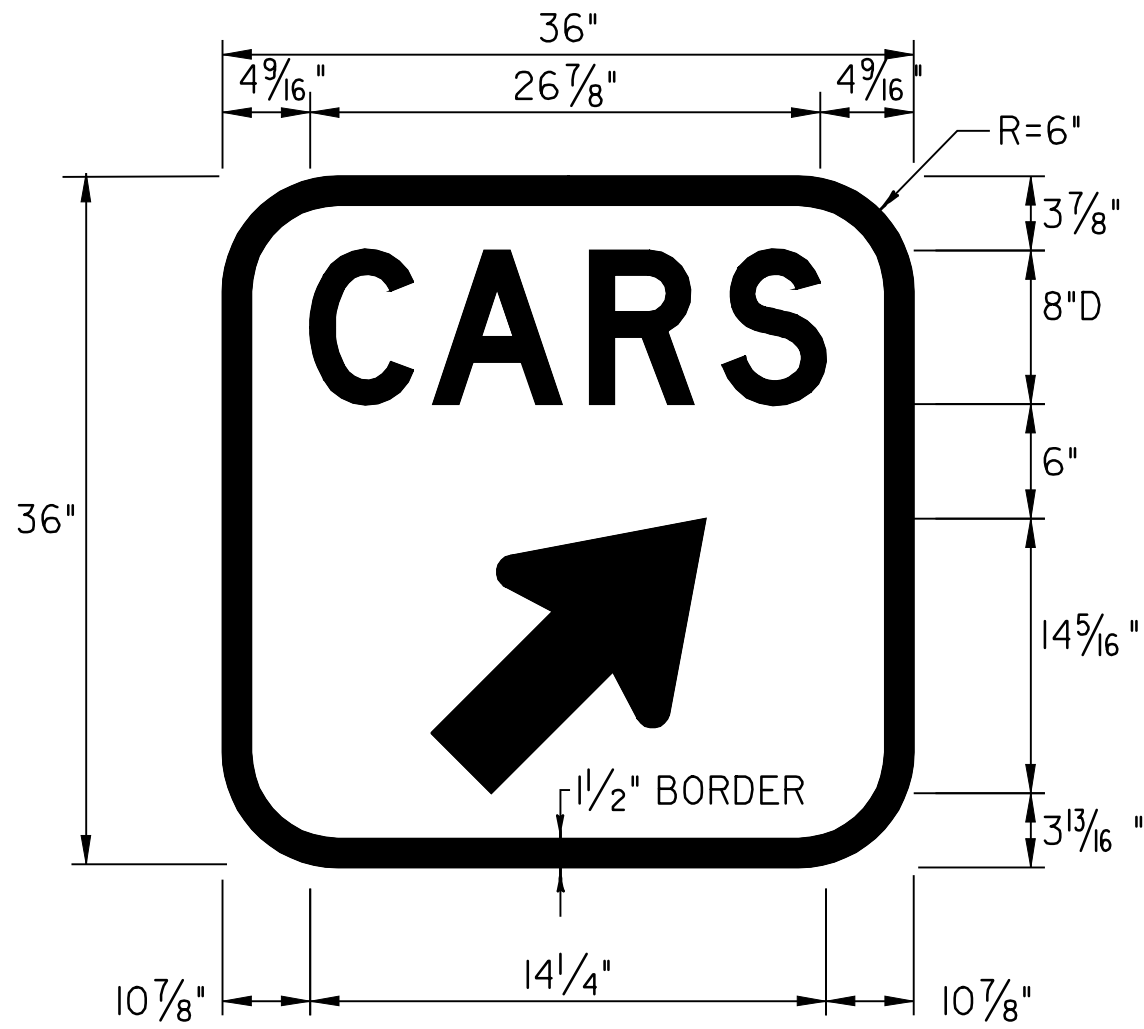
LOCATION: U.S. ROUTE 7  
CLARENDON:  
STA. I33+86.0, LT



COLOR: WHITE BORDER & TEXT (REFLECTORIZED)  
BLUE BACKGROUND (REFLECTORIZED)

MATERIAL: PER VAOT STANDARD E-131

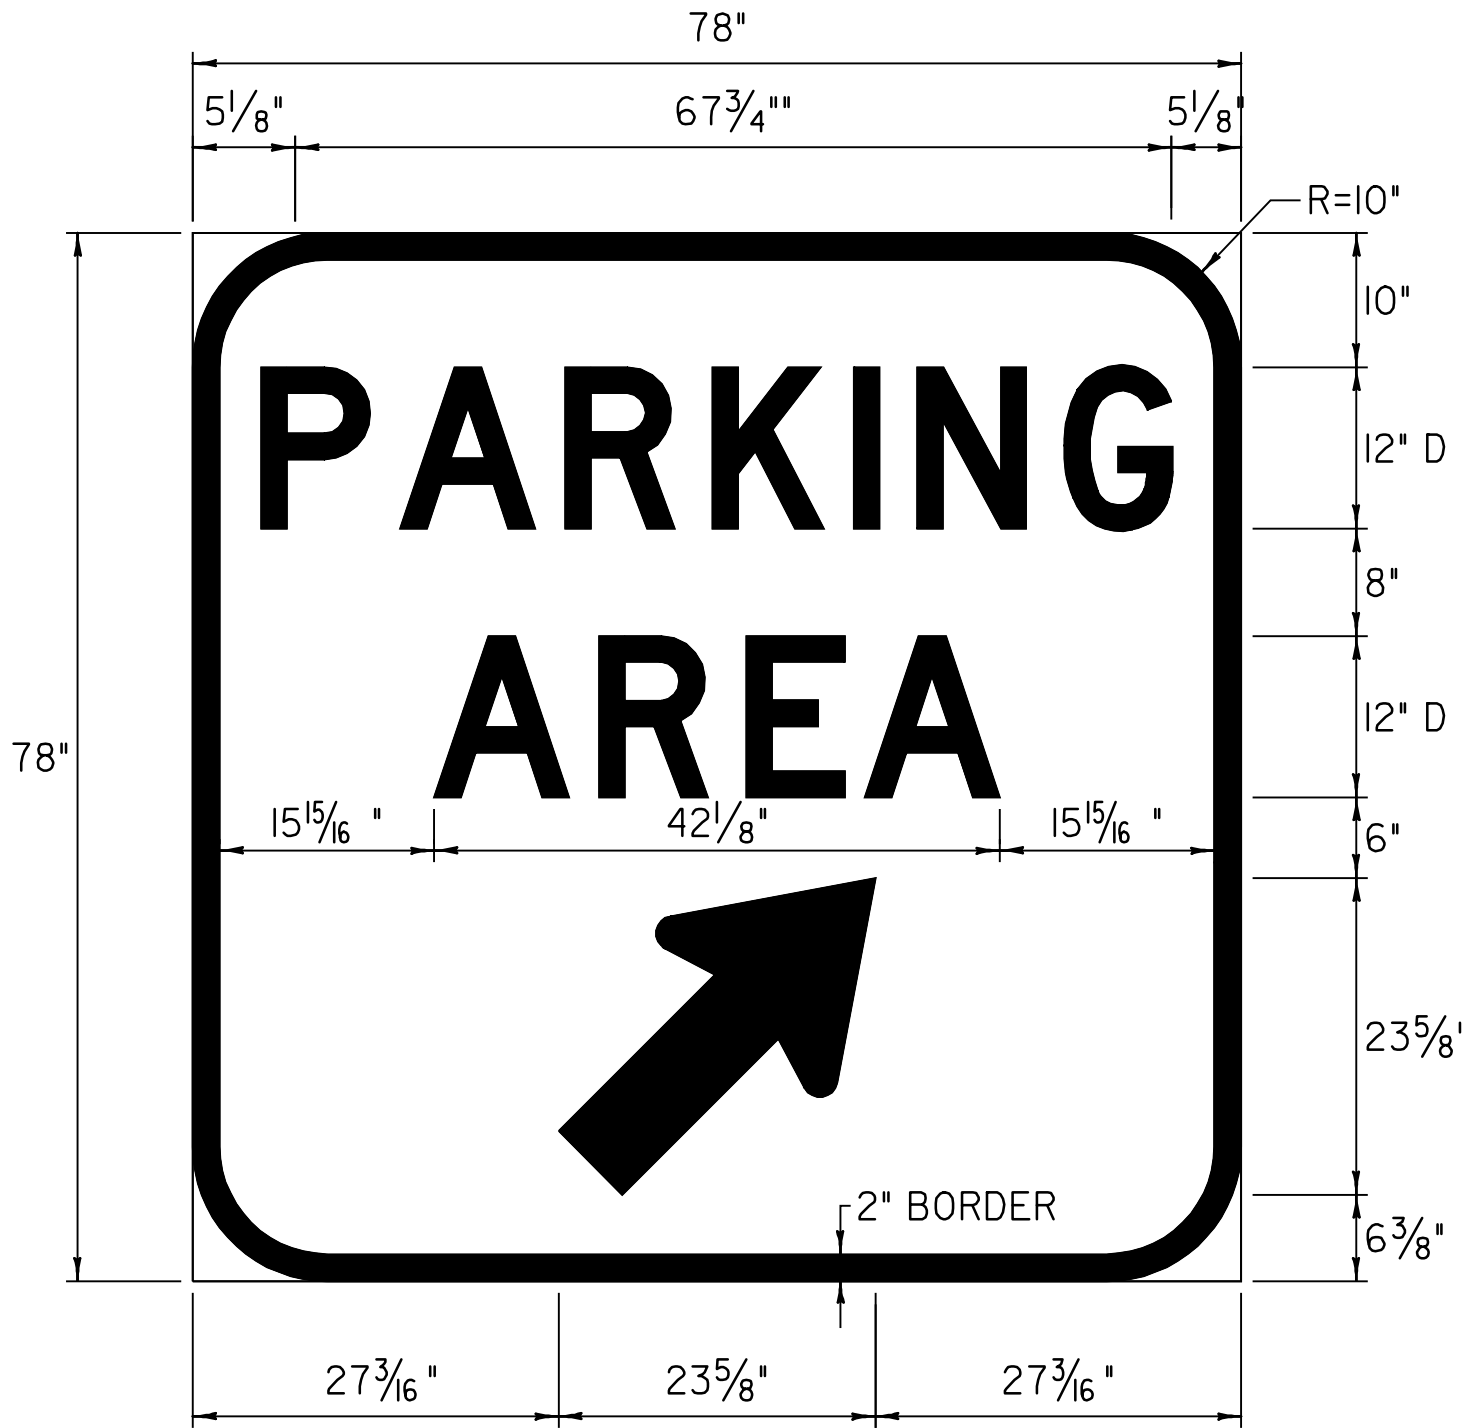
LOCATION: U.S. ROUTE 7  
CLARENDON:  
STA. I34+03.0, LT



COLOR: WHITE BORDER & TEXT (REFLECTORIZED)  
BLUE BACKGROUND (REFLECTORIZED)

MATERIAL: PER VAOT STANDARD E-131

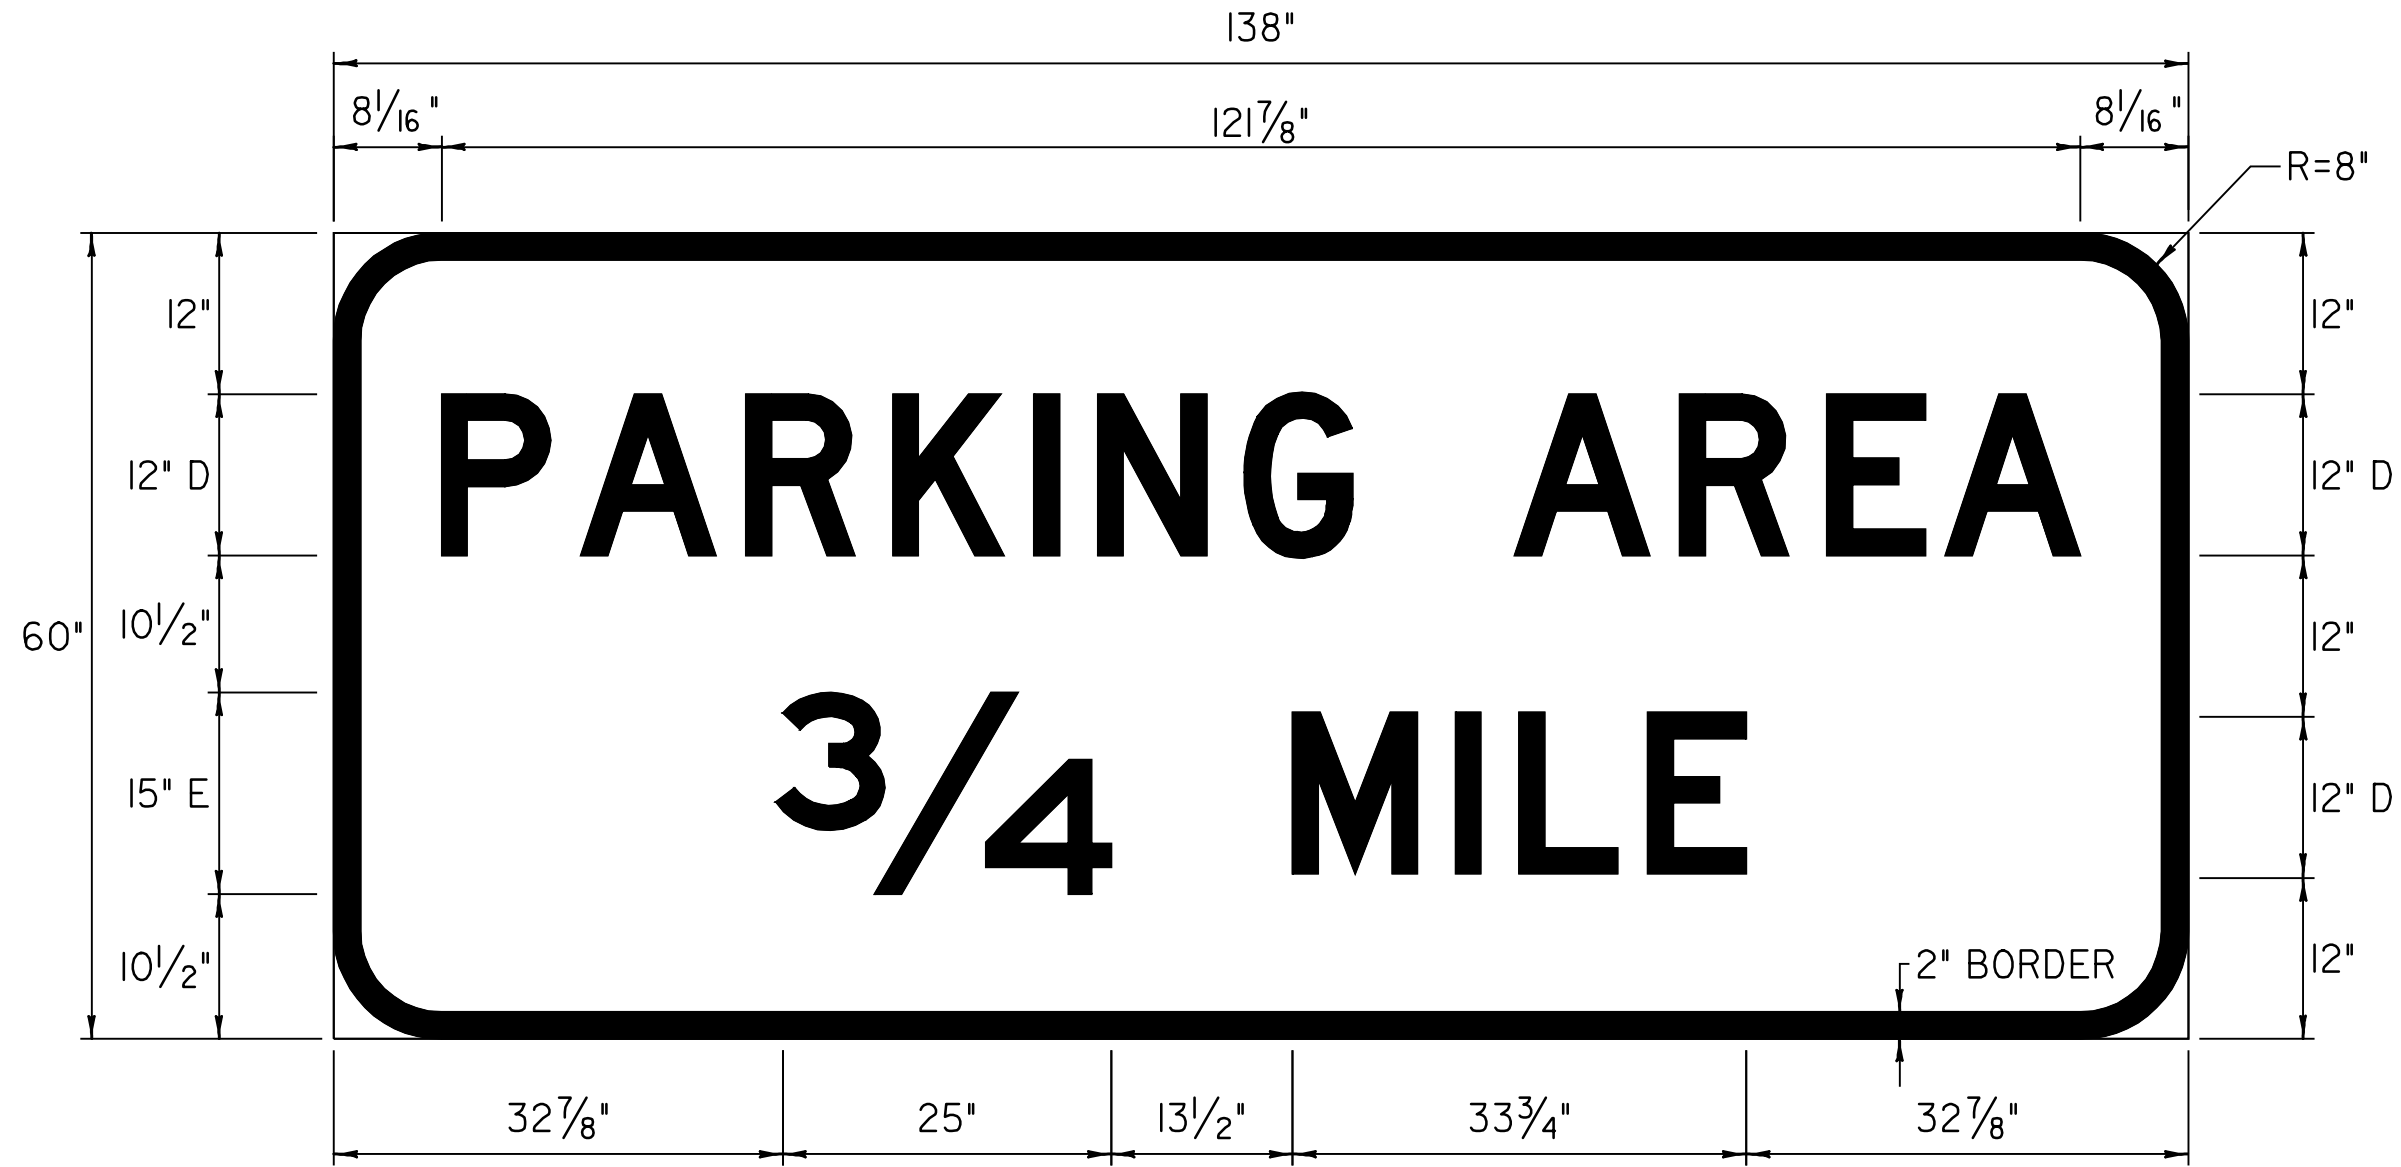
LOCATION: U.S. ROUTE 7  
CLARENDON:  
STA. I34+03.0, LT



COLOR: WHITE BORDER & TEXT (REFLECTORIZED)  
BLUE BACKGROUND (REFLECTORIZED)

MATERIAL: PER VAOT STANDARD E-131

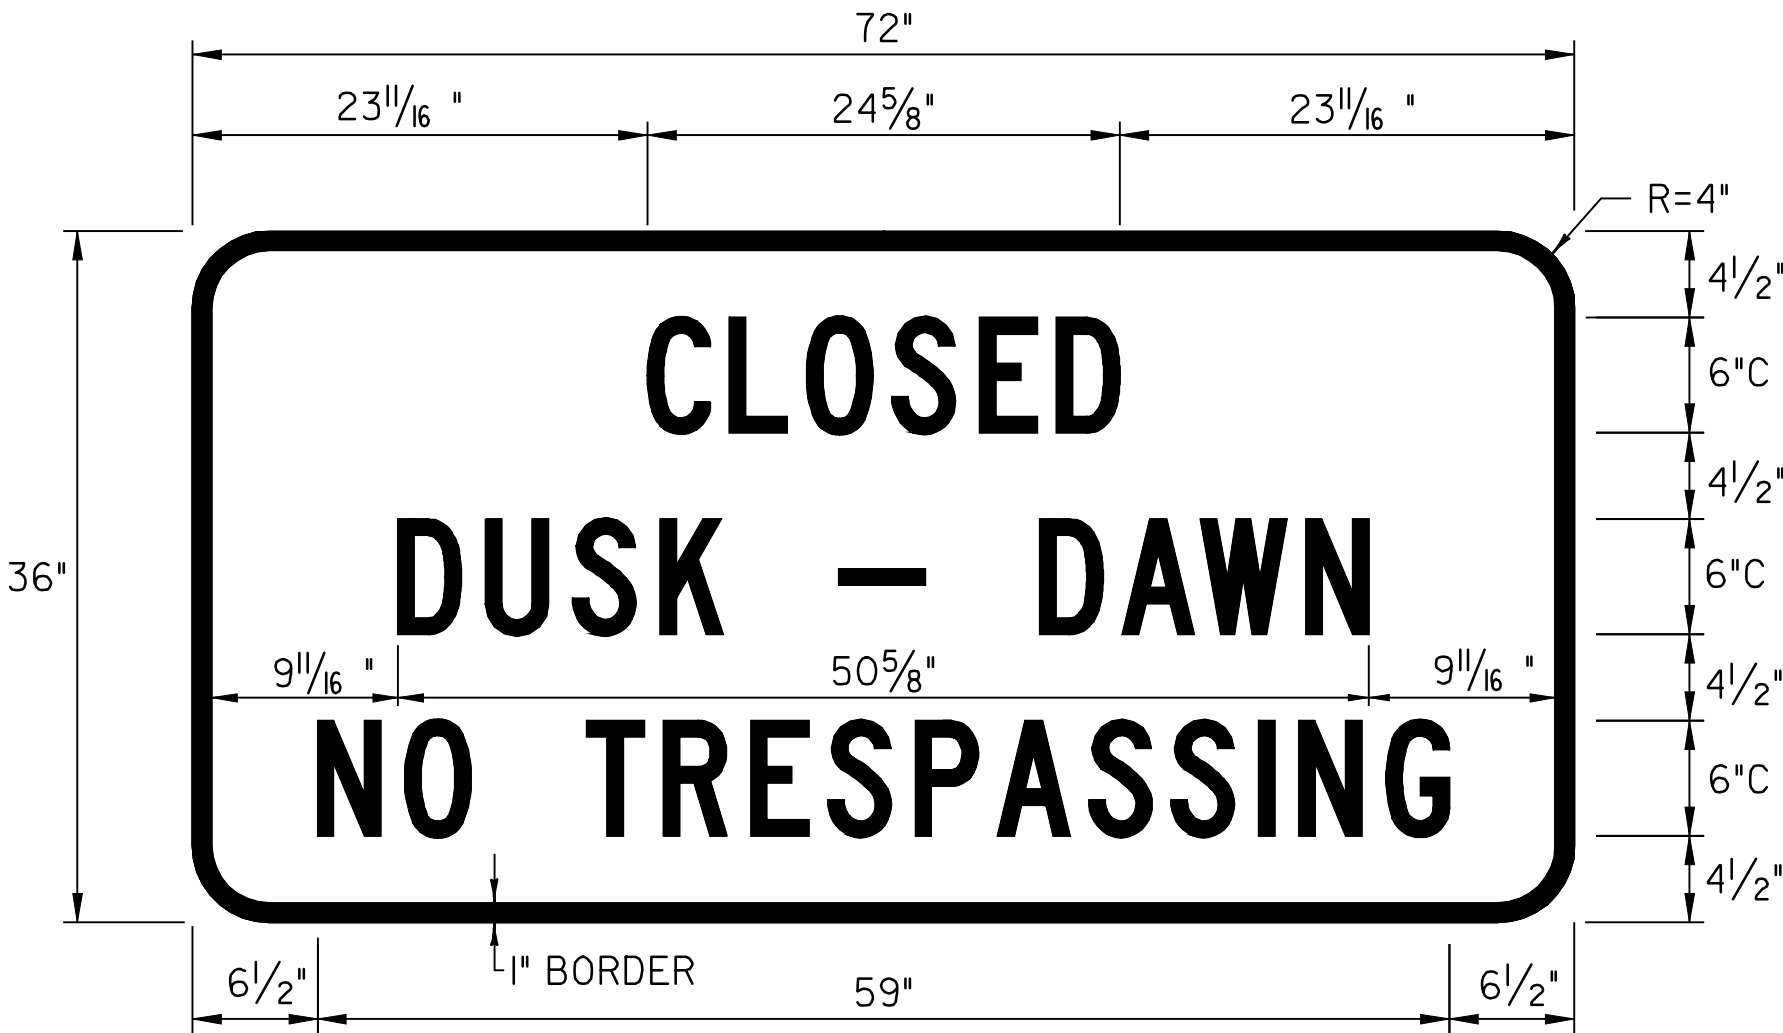
LOCATION: U.S. ROUTE 7  
CLARENDON:  
STA. I73+75.0, LT



COLOR: BLACK BORDER & TEXT (REFLECTORIZED)  
WHITE BACKGROUND (REFLECTORIZED)

MATERIAL: PER VAOT STANDARD E-131

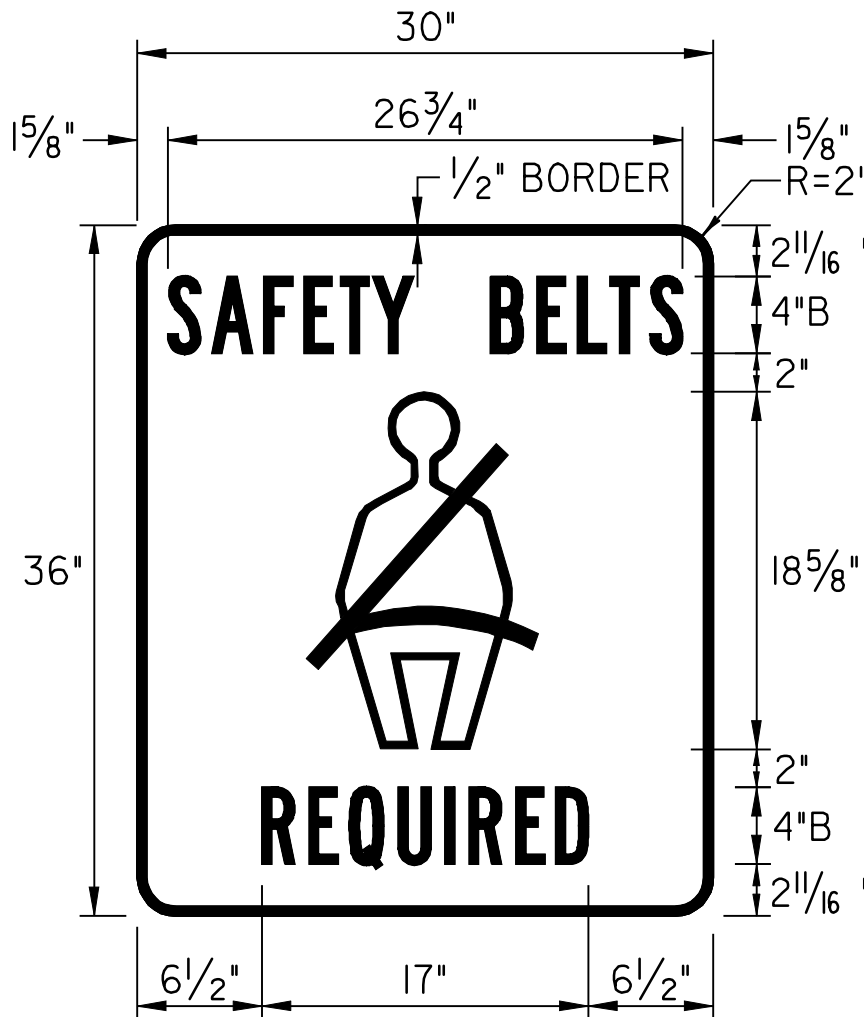
LOCATION: U.S. ROUTE 7  
CLARENDON:  
STA. I34+03.0, LT



COLOR: BLACK BORDER & TEXT (REFLECTORIZED)  
WHITE BACKGROUND (REFLECTORIZED)

MATERIAL: PER VAOT STANDARD E-131

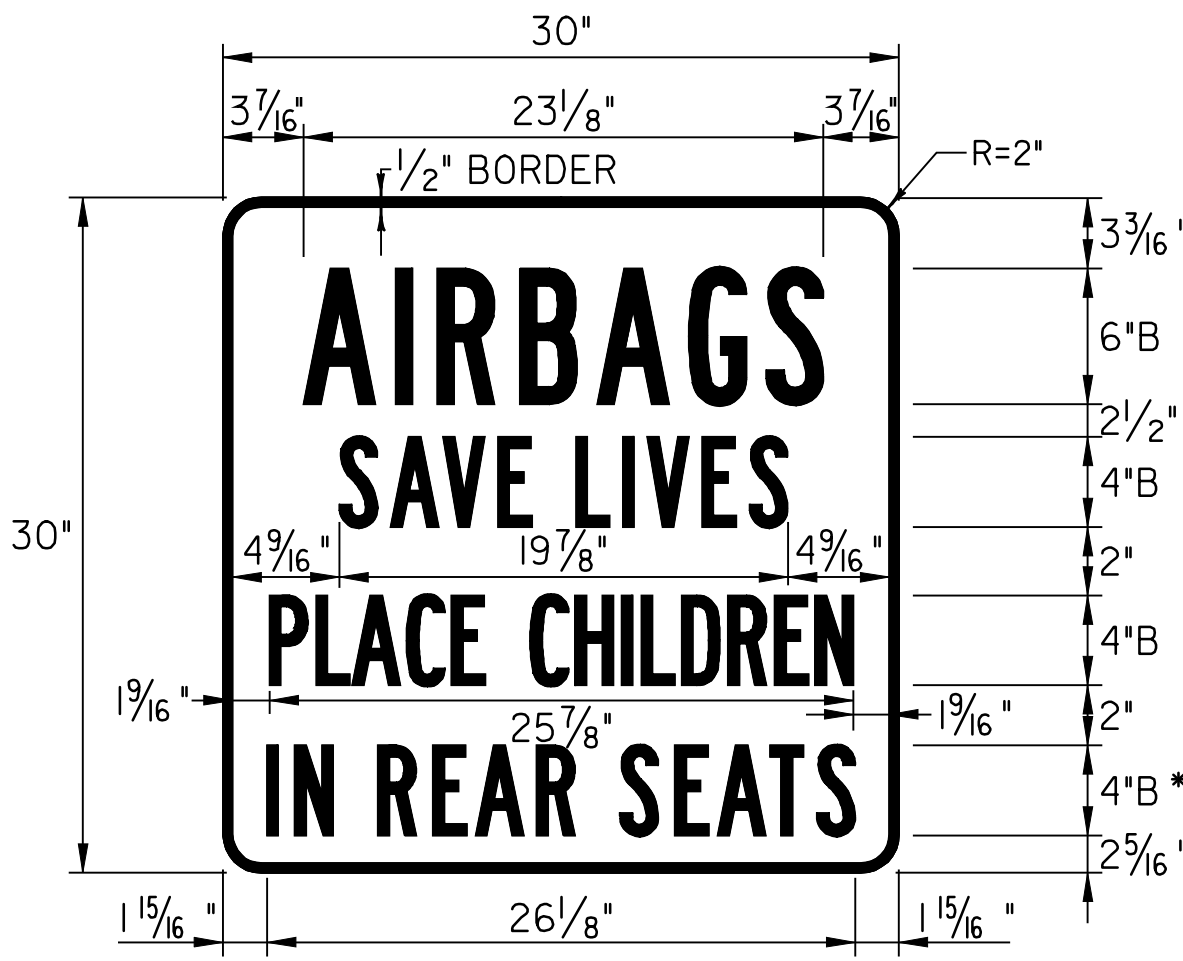
LOCATION: U.S. ROUTE 7  
CLARENDON:  
STA. I31+09.0, LT



COLOR: BLACK BORDER & TEXT (REFLECTORIZED)  
WHITE BACKGROUND (REFLECTORIZED)

MATERIAL: PER VAOT STANDARD E-131  
\*50% REDUCTION IN SPACING

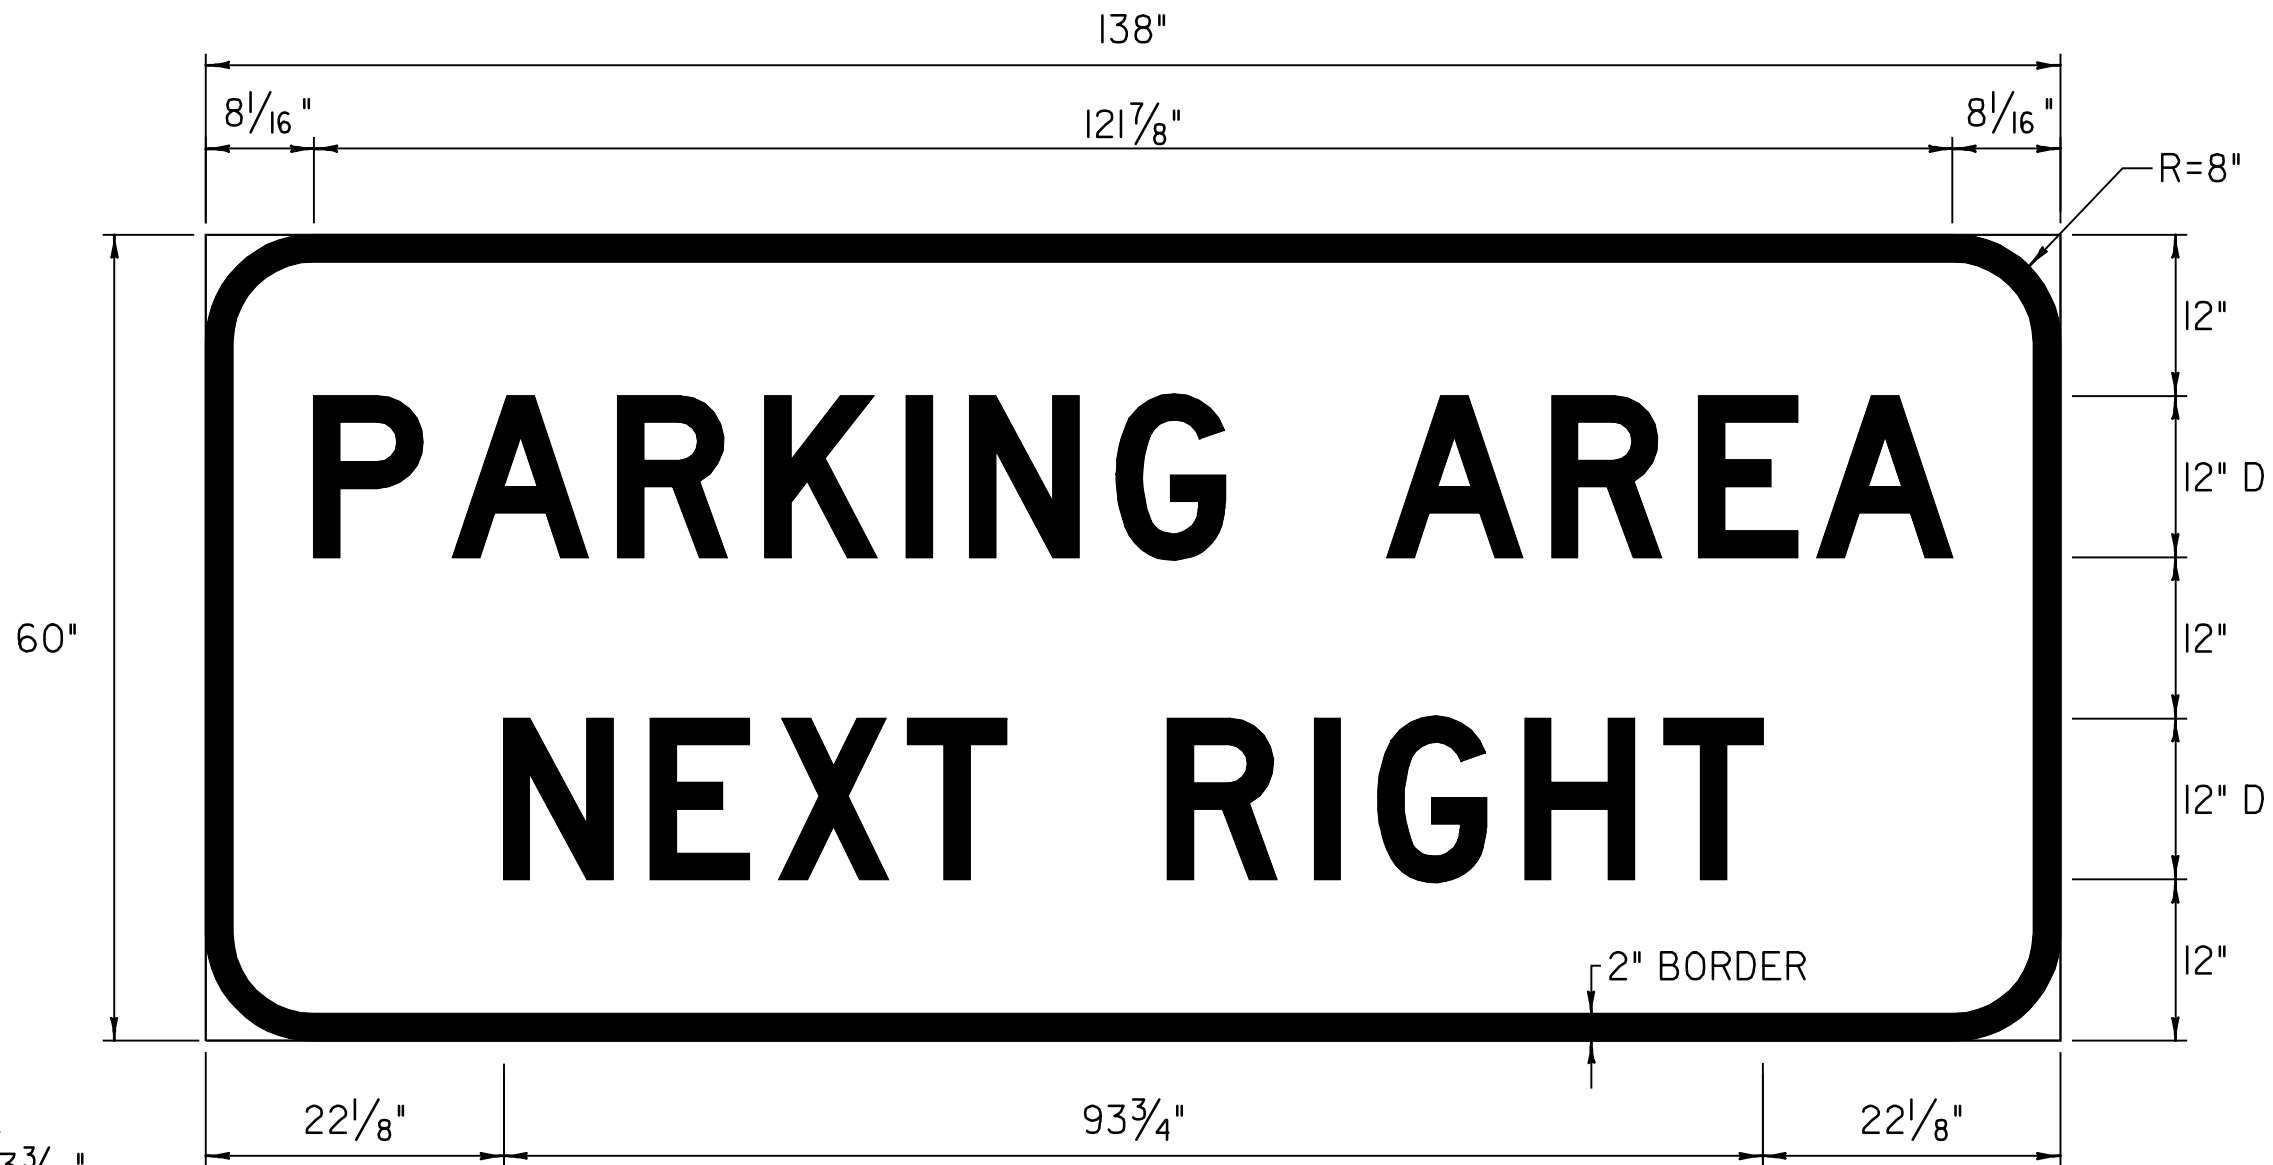LOCATION: U.S. ROUTE 7  
CLARENDON:  
STA. I31+19.0, LT



COLOR: WHITE BORDER & TEXT (REFLECTORIZED)  
BLUE BACKGROUND (REFLECTORIZED)

MATERIAL: PER VAOT STANDARD E-131

LOCATION: U.S. ROUTE 7  
CLARENDON:  
STA. I48+32.0, LT

**TRAFFIC SIGN  
DETAIL  
SHEET #2**

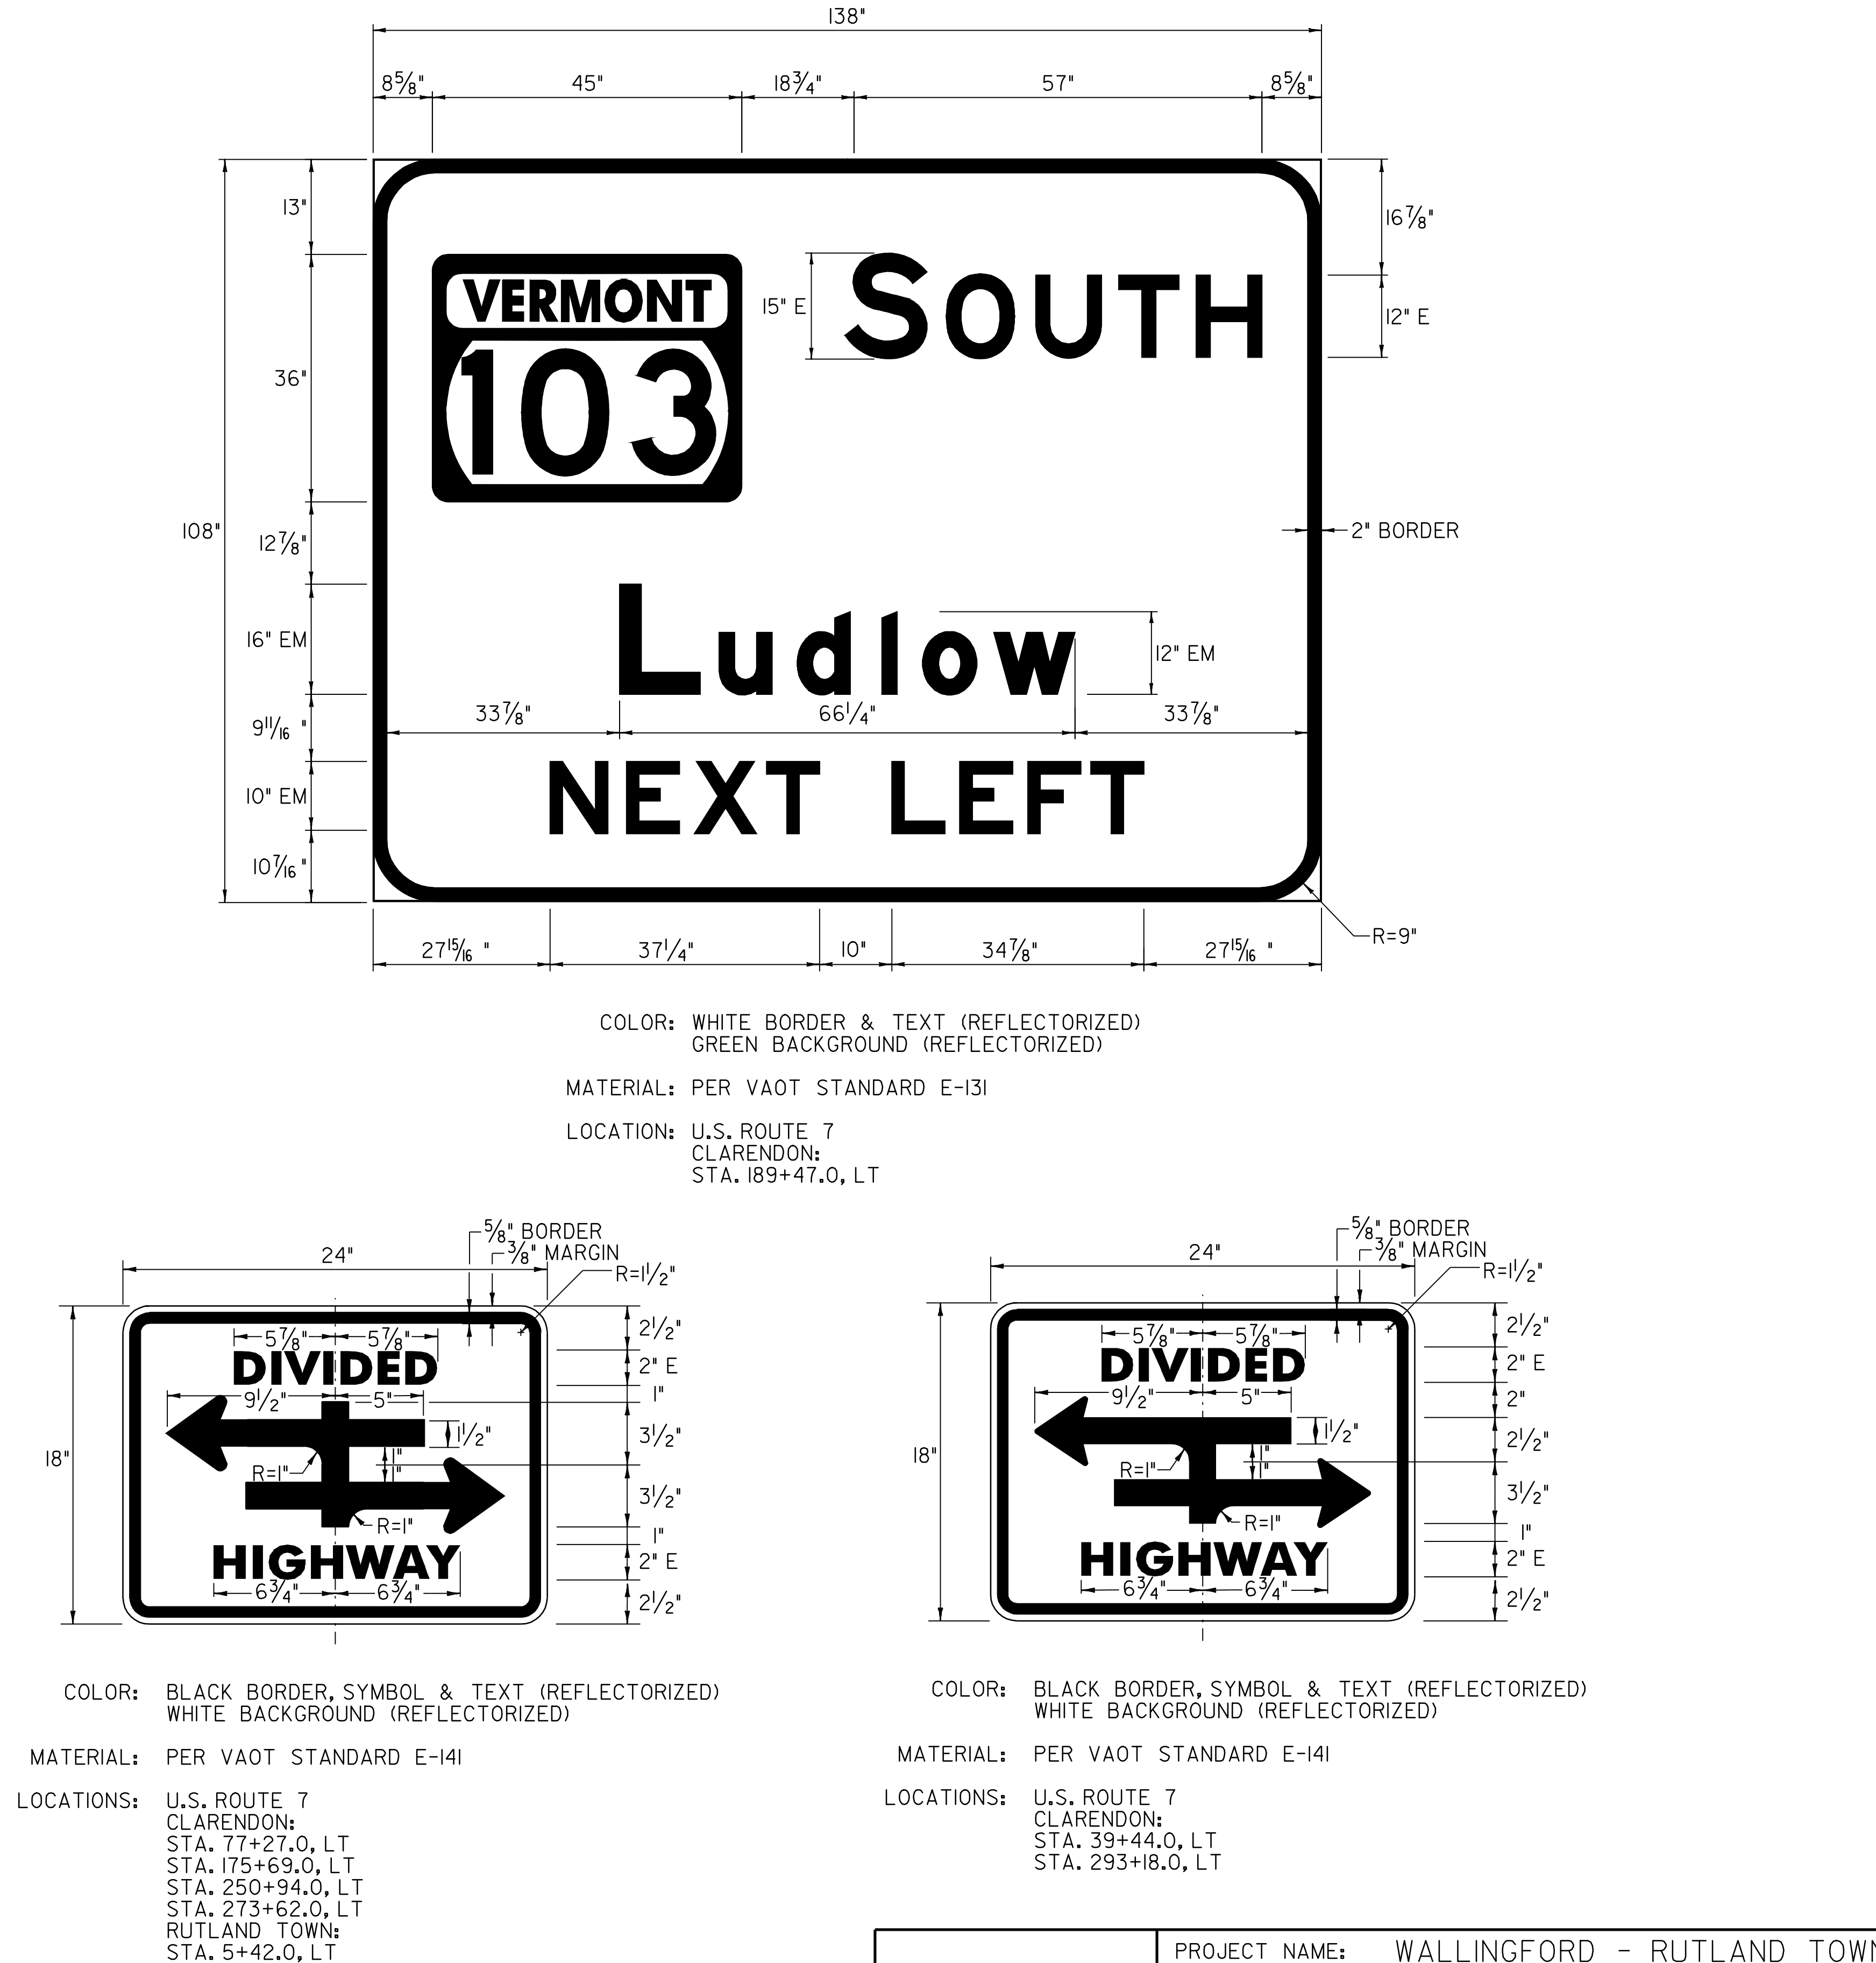
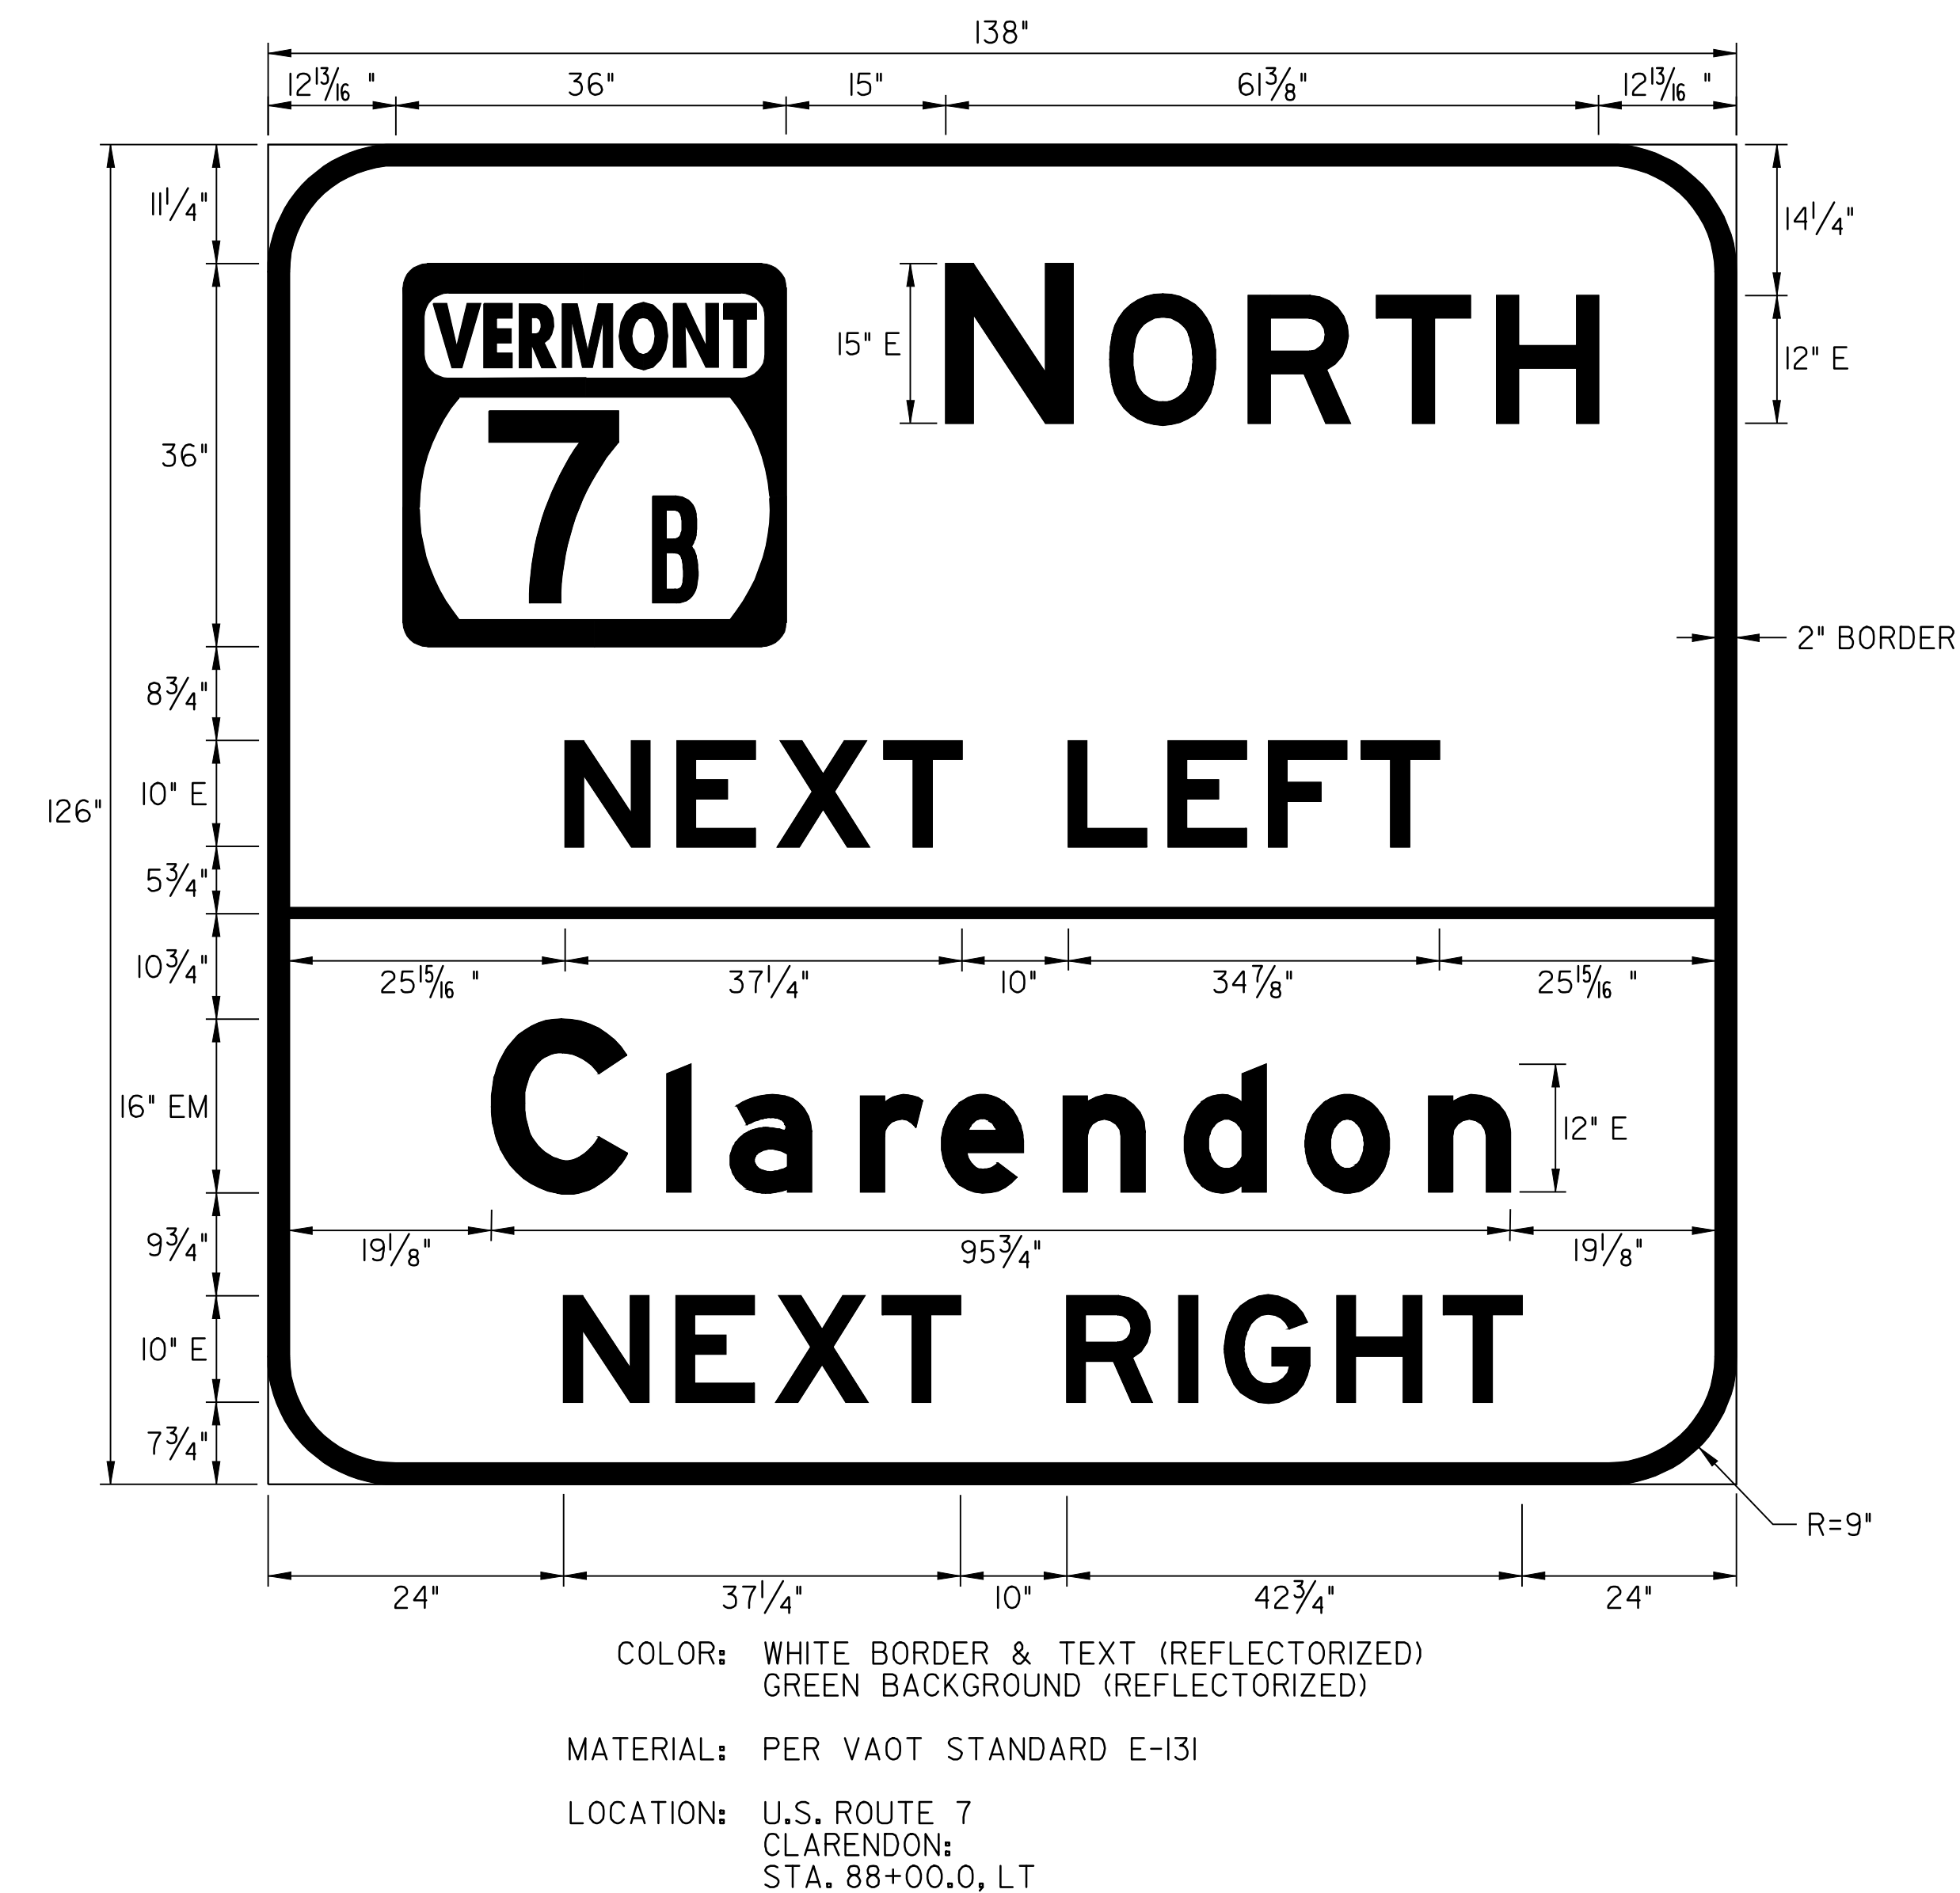
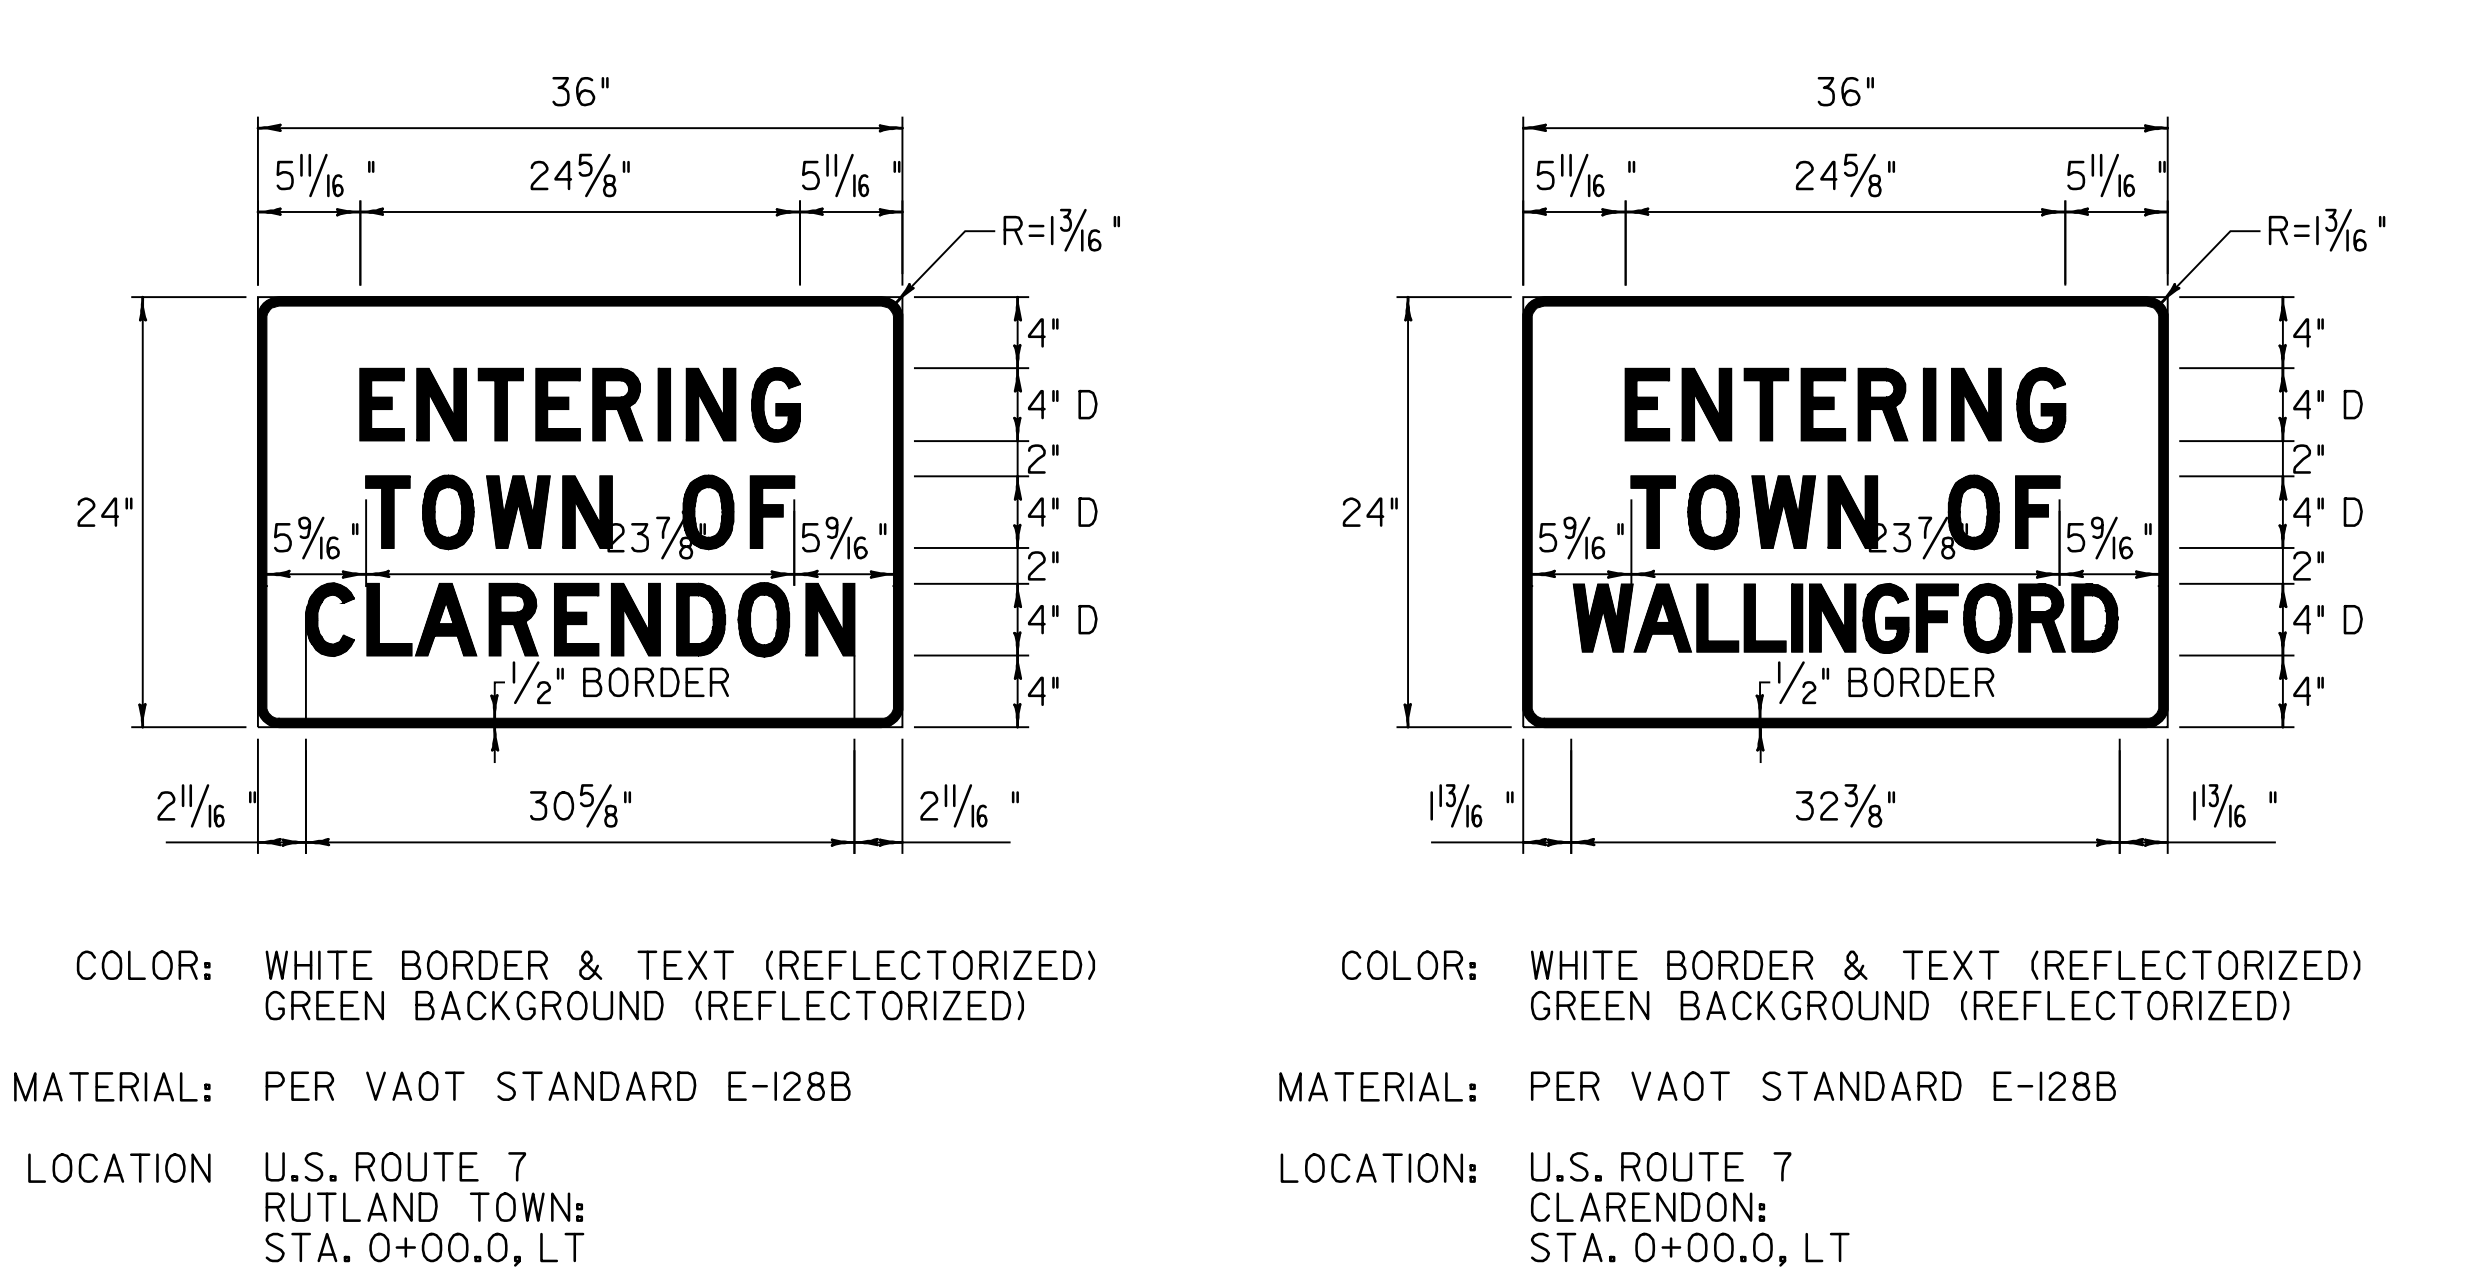
PROJECT NAME: WALLINGFORD - RUTLAND TOWN  
PROJECT NUMBER: NH 2408(I)S

FILE NAME: p04b050.dgn  
PROJECT LEADER: D.E.G.  
DESIGNED BY: J.S.P.  
IPARM FILE: p04b050+sd2.1

PLOT DATE: \$DATE\$  
DRAWN BY: C.A.K.  
CHECKED BY: D.E.G.  
SHEET 64 OF 80

NOTE:  
TEXT LAYOUT DIMENSIONS ARE BASED ON THE STANDARD ALPHABETS SPACING CHARTS  
FOUND IN THE "STANDARD HIGHWAY SIGNS" BOOK PUBLISHED BY FHWA. MINOR VARIATIONS  
IN TEXT DIMENSIONS ARE ACCEPTABLE BASED ON INDIVIDUAL MANUFACTURER'S LETTER  
FABRICATION. SIGNIFICANT CHANGES THAT AFFECT SIGN APPEARANCE SHALL BE BROUGHT  
TO THE ATTENTION OF VAOT'S TRAFFIC OPERATIONS SECTION BEFORE FABRICATION.





NOTE:  
TEXT LAYOUT DIMENSIONS ARE BASED ON THE STANDARD ALPHABETS SPACING CHARTS  
FOUND IN THE "STANDARD HIGHWAY SIGNS" BOOK PUBLISHED BY FHWA. MINOR VARIATIONS  
IN TEXT DIMENSIONS ARE ACCEPTABLE BASED ON INDIVIDUAL MANUFACTURER'S LETTER  
FABRICATION. SIGNIFICANT CHANGES THAT AFFECT SIGN APPEARANCE SHALL BE BROUGHT  
TO THE ATTENTION OF VAOT'S TRAFFIC OPERATIONS SECTION BEFORE FABRICATION.

|                                    |                                          |                     |
|------------------------------------|------------------------------------------|---------------------|
| TRAFFIC SIGN<br>DETAIL<br>SHEET #3 | PROJECT NAME: WALLINGFORD - RUTLAND TOWN |                     |
|                                    | PROJECT NUMBER: NH 2408(1)S              |                     |
|                                    | FILE NAME: p04b050.dgn                   | PLOT DATE: \$DATE\$ |
|                                    | PROJECT LEADER: D.E.G.                   | DRAWN BY: C.A.K.    |
|                                    | DESIGNED BY: J.S.P.                      | CHECKED BY: D.E.G.  |
|                                    | IPARM FILE: p04b050+sd3.1                | SHEET 65 OF 80      |





COLOR: WHITE BORDER & TEXT (REFLECTORIZED)  
GREEN BACKGROUND (REFLECTORIZED)

MATERIAL: PER VAOT STANDARD E-131

LOCATION: U.S. ROUTE 7  
CLARENDON:  
STA. 292+61.0, LT



COLOR: WHITE BORDER & TEXT (REFLECTORIZED)  
GREEN BACKGROUND (REFLECTORIZED)

MATERIAL: PER VAOT STANDARD E-131

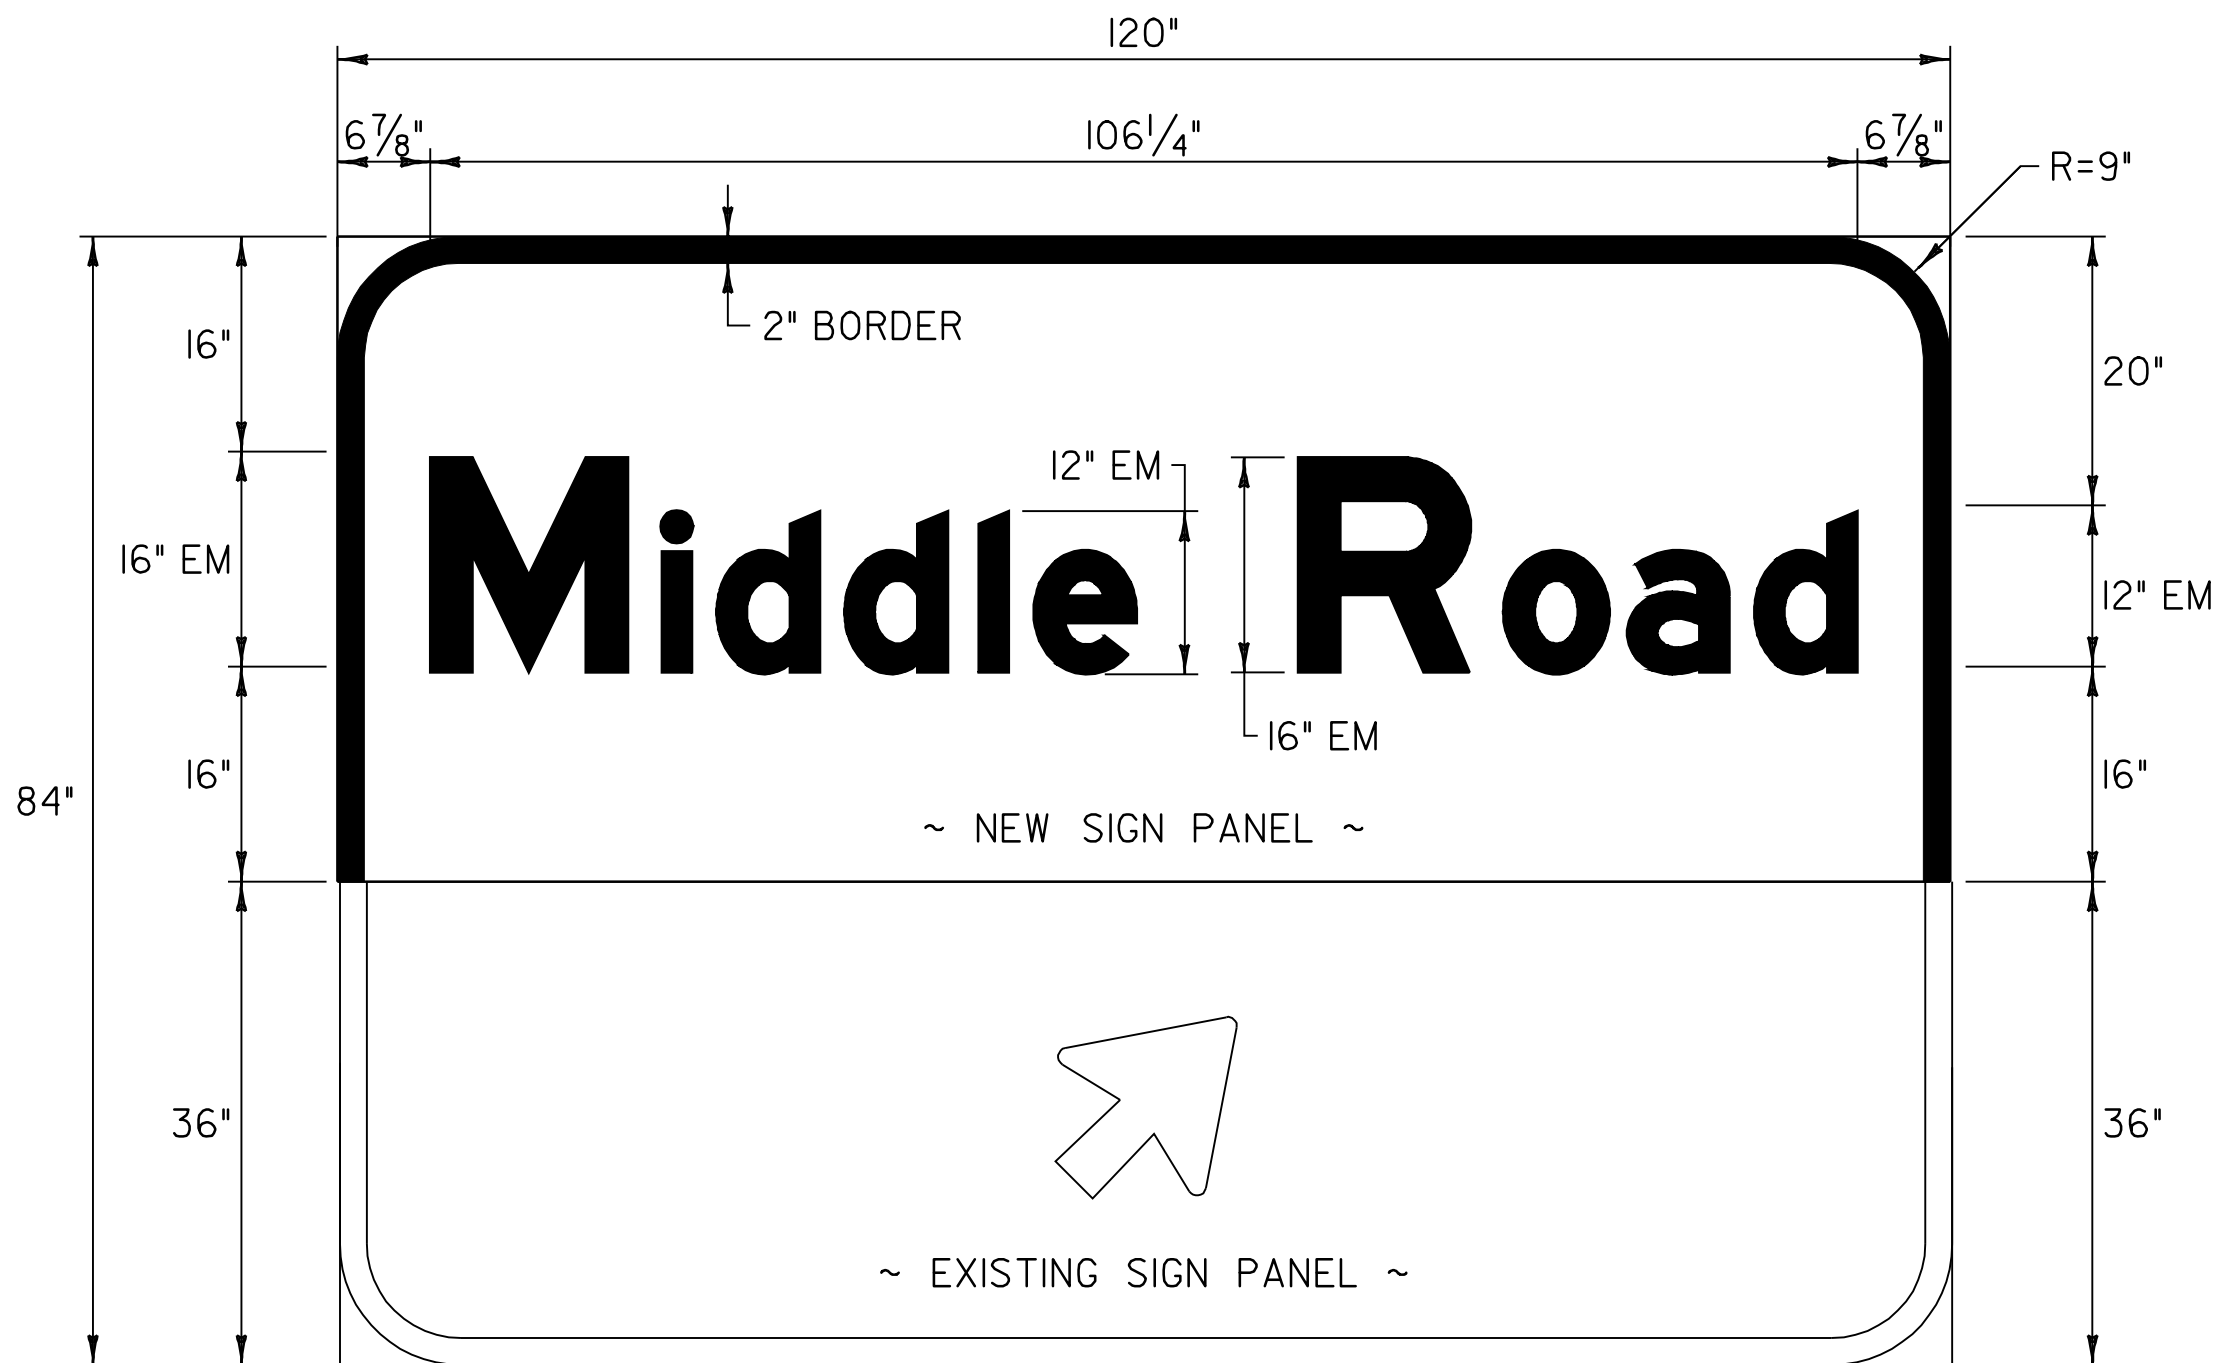
LOCATION: U.S. ROUTE 7  
CLARENDON:  
STA. 154+64.0, LT



COLOR: WHITE BORDER & TEXT (REFLECTORIZED)  
GREEN BACKGROUND (REFLECTORIZED)

MATERIAL: PER VAOT STANDARD E-131

LOCATION: U.S. ROUTE 7  
CLARENDON:  
STA. 229+50.0, LT



COLOR: WHITE BORDER & TEXT (REFLECTORIZED)  
GREEN BACKGROUND (REFLECTORIZED)

MATERIAL: PER VAOT STANDARD E-131

LOCATION: U.S. ROUTE 7  
RUTLAND TOWN:  
STA. 11+41.0, LT (OVERHEAD)

NOTE:  
NEW SIGN PANEL SHALL BE MOUNTED OVER EXISTING OVERHEAD  
SIGN PANEL TO COMPLETELY COVER "RIGHT TURN/U-TURN" TEXT.  
CONTRACTOR SHALL FIELD VERIFY ACTUAL SIGN DIMENSIONS  
PRIOR TO FABRICATION TO ENSURE ADEQUATE SIGN PANEL  
ALIGNMENT AND TEXT COVERAGE OR AS DIRECTED BY THE  
RESIDENT ENGINEER.


NOTE:  
TEXT LAYOUT DIMENSIONS ARE BASED ON THE STANDARD ALPHABETS  
SPACING CHARTS FOUND IN THE "STANDARD HIGHWAY SIGNS" BOOK  
PUBLISHED BY FHWA. MINOR VARIATIONS IN TEXT DIMENSIONS ARE  
ACCEPTABLE BASED ON INDIVIDUAL MANUFACTURER'S LETTER  
FABRICATION. SIGNIFICANT CHANGES THAT AFFECT SIGN APPEARANCE  
SHALL BE BROUGHT TO THE ATTENTION OF VAOT'S TRAFFIC OPERATIONS  
SECTION BEFORE FABRICATION.

**TRAFFIC SIGN  
DETAIL  
SHEET #4**

PROJECT NAME: WALLINGFORD - RUTLAND TOWN  
PROJECT NUMBER: NH 2408(1)S

|                           |                     |
|---------------------------|---------------------|
| FILE NAME: p04b050.dgn    | PLOT DATE: \$DATE\$ |
| PROJECT LEADER: D.E.G.    | DRAWN BY: C.A.K.    |
| DESIGNED BY: J.S.P.       | CHECKED BY: D.E.G.  |
| IPARM FILE: p04b050+sd4.1 | SHEET 66 OF 80      |




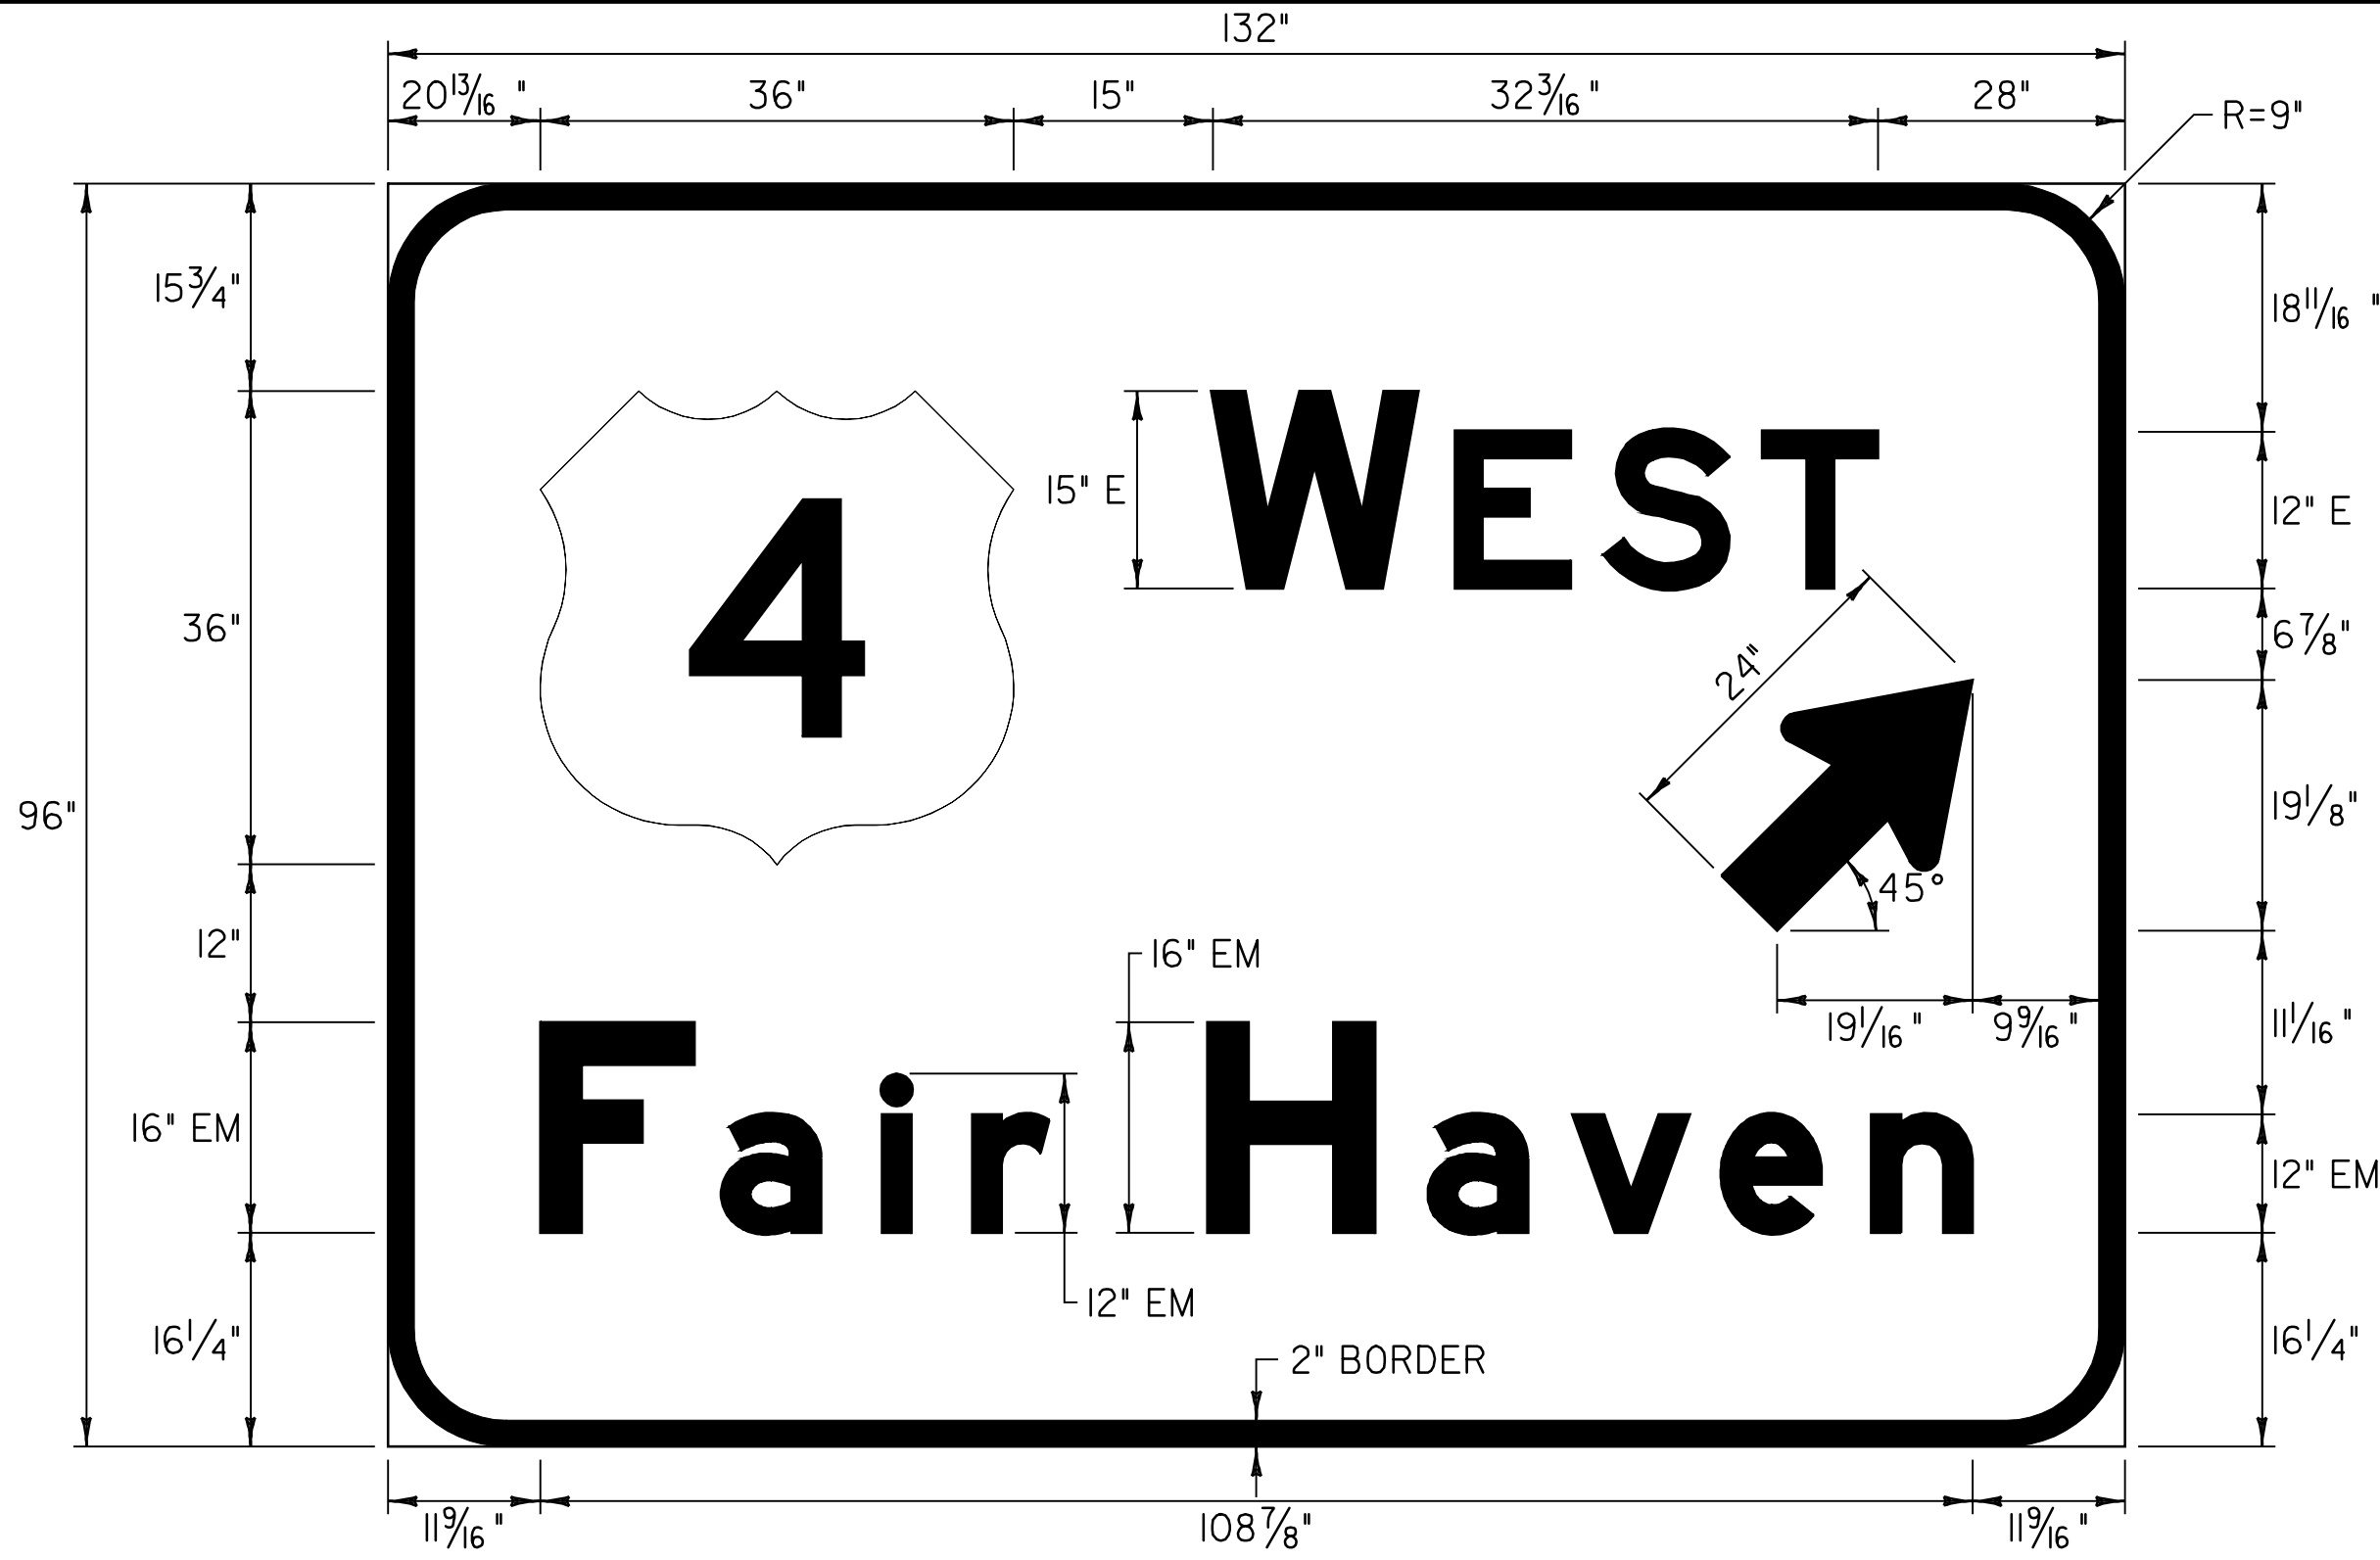

COLOR: WHITE BORDER & TEXT (REFLECTORIZED)  
GREEN BACKGROUND (REFLECTORIZED)

MATERIAL: PER VAOT STANDARD E-131

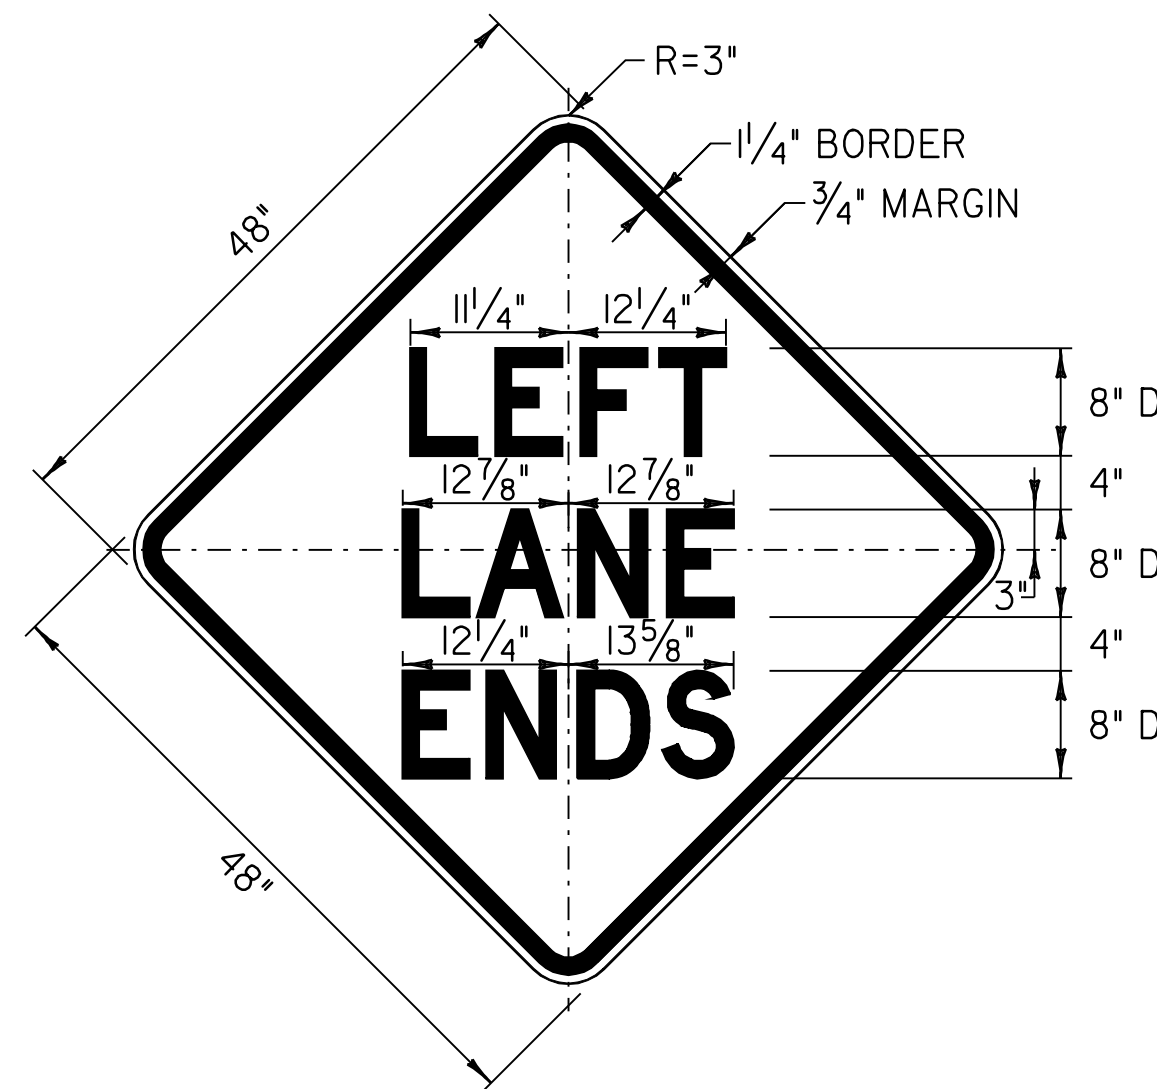
LOCATION: U.S. ROUTE 7  
RUTLAND TOWN:  
STA. 27+22.0, LT



COLOR: BLACK BORDER & TEXT (REFLECTORIZED)  
YELLOW BACKGROUND (REFLECTORIZED)

MATERIAL: PER VAOT STANDARD E-150

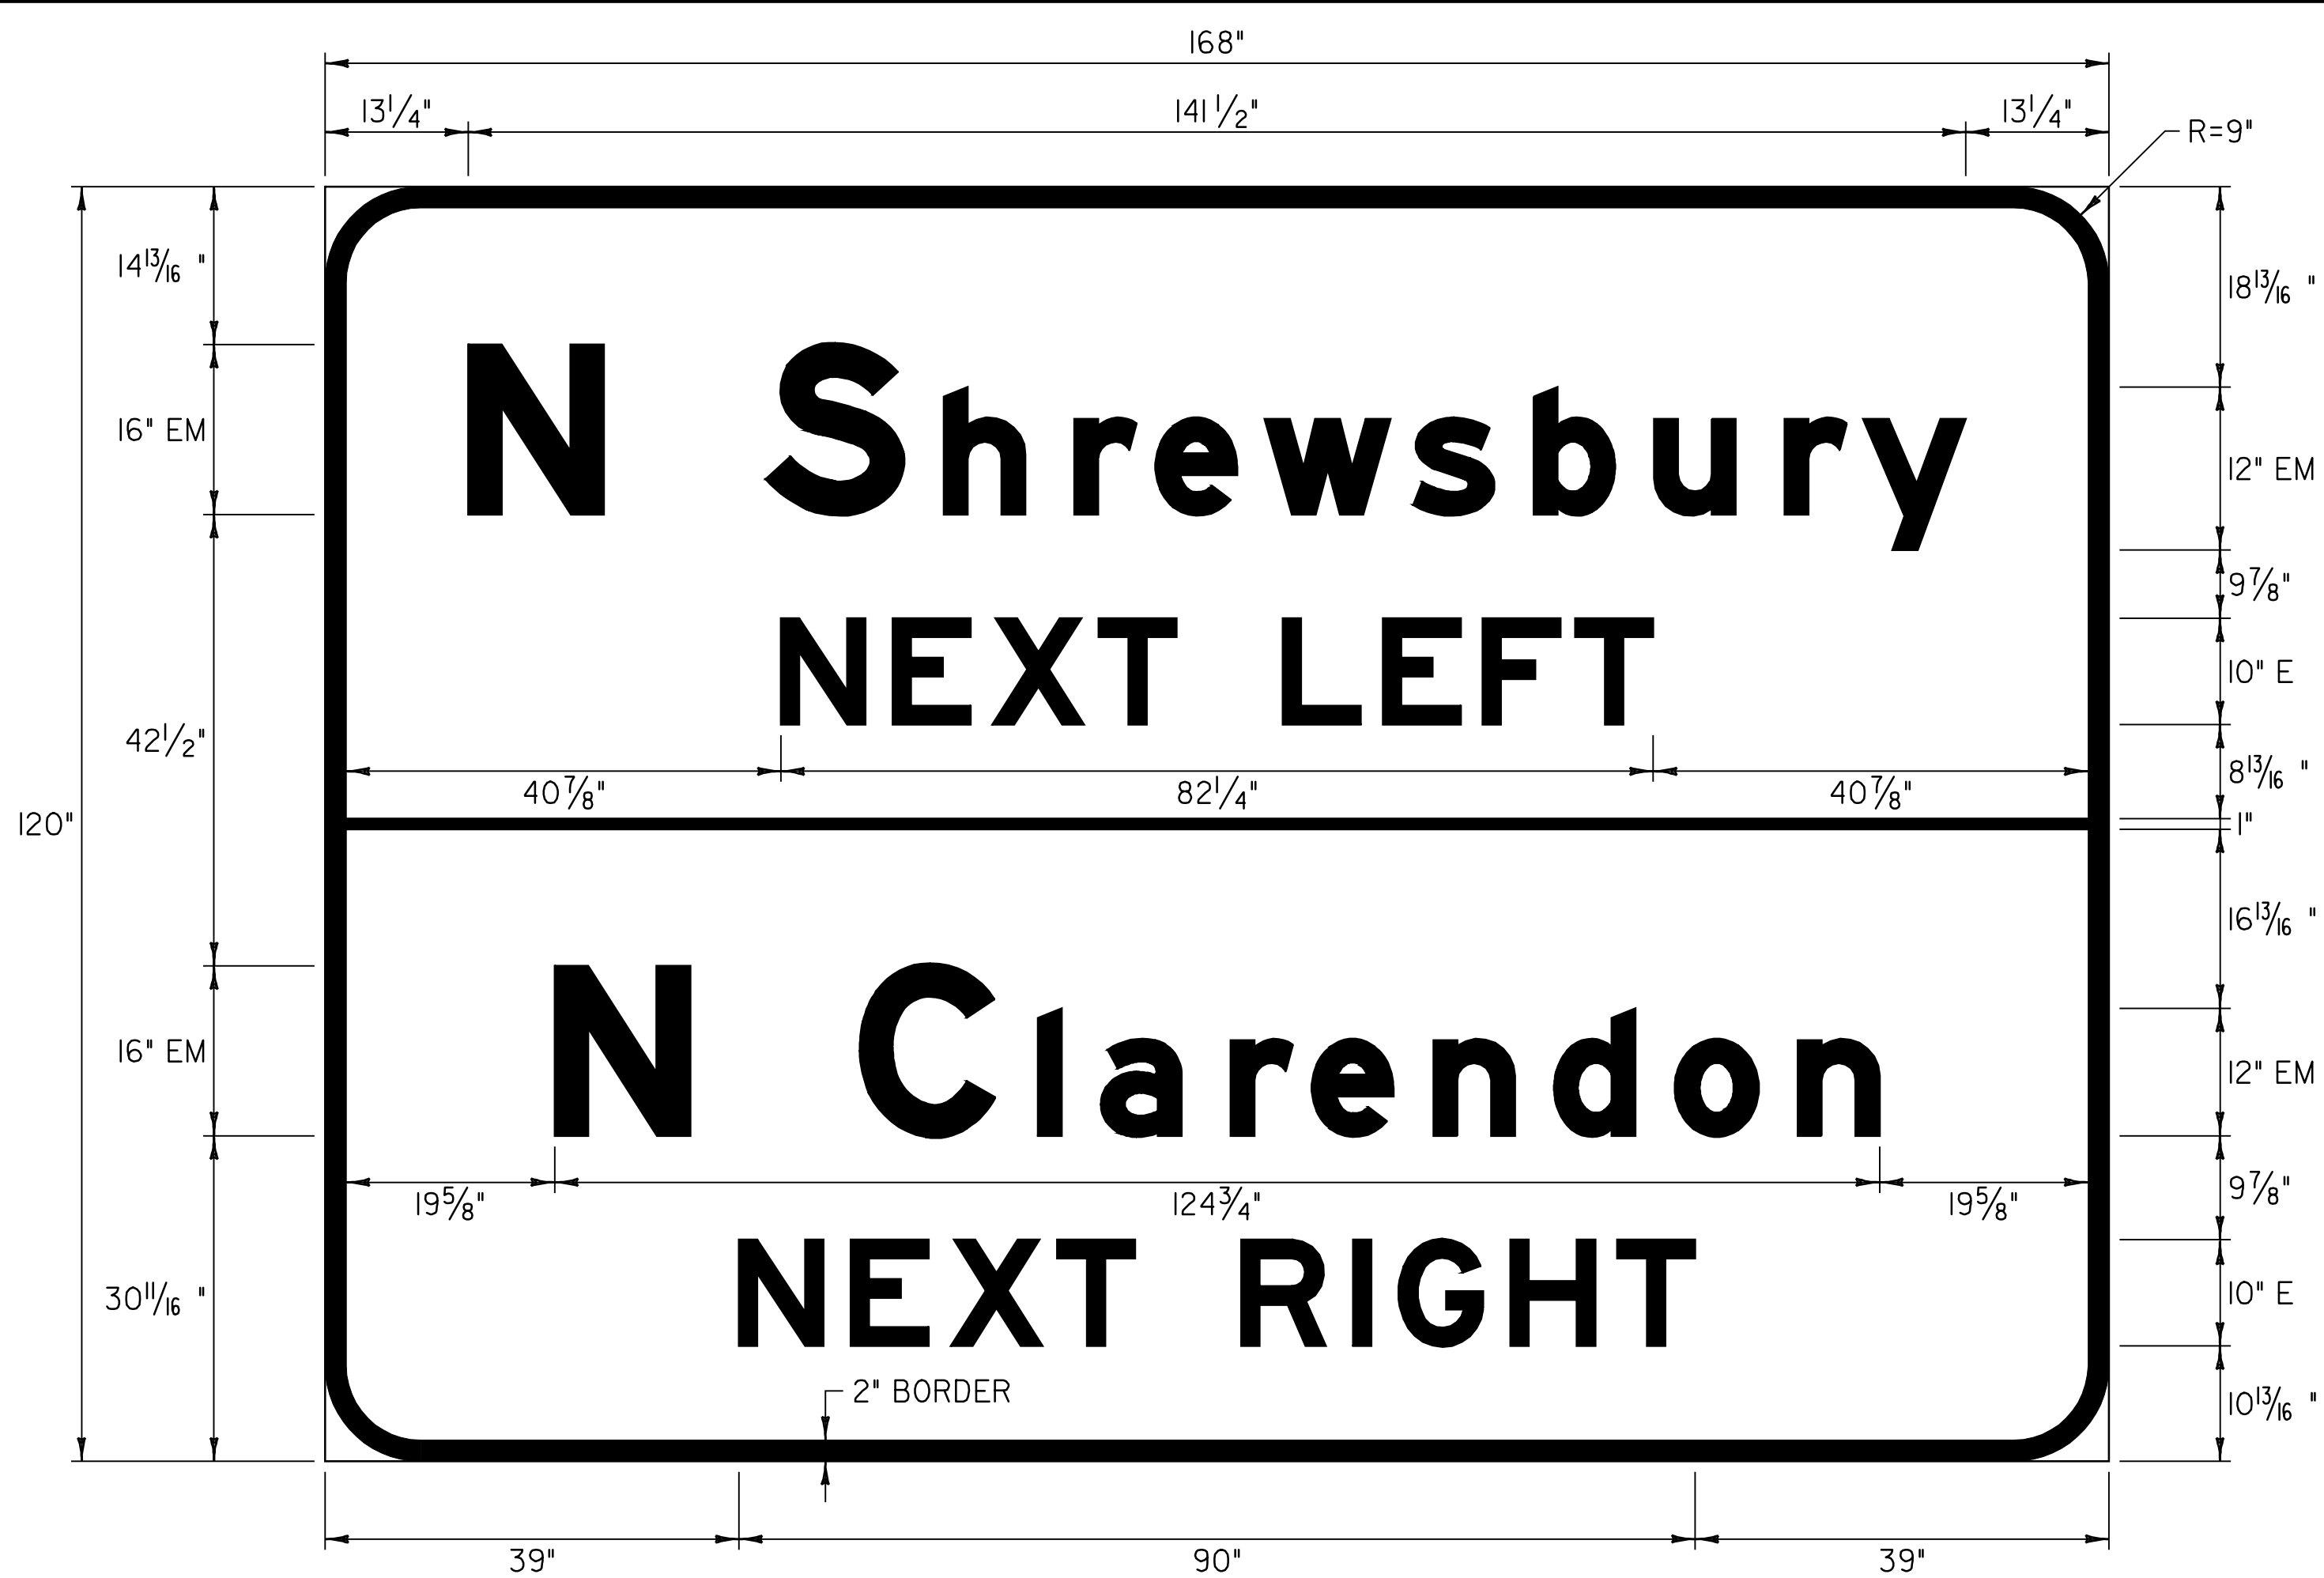LOCATIONS: U.S. ROUTE 7  
WALLINGFORD:  
STA. 364+50.0, LT  
STA. 364+50.0, RT



COLOR: WHITE BORDER & TEXT (REFLECTORIZED)  
GREEN BACKGROUND (REFLECTORIZED)

MATERIAL: PER VAOT STANDARD E-131

LOCATION: U.S. ROUTE 7  
CLARENDON:  
STA. 286+88.0, LT

**TRAFFIC SIGN  
DETAIL  
SHEET #5**

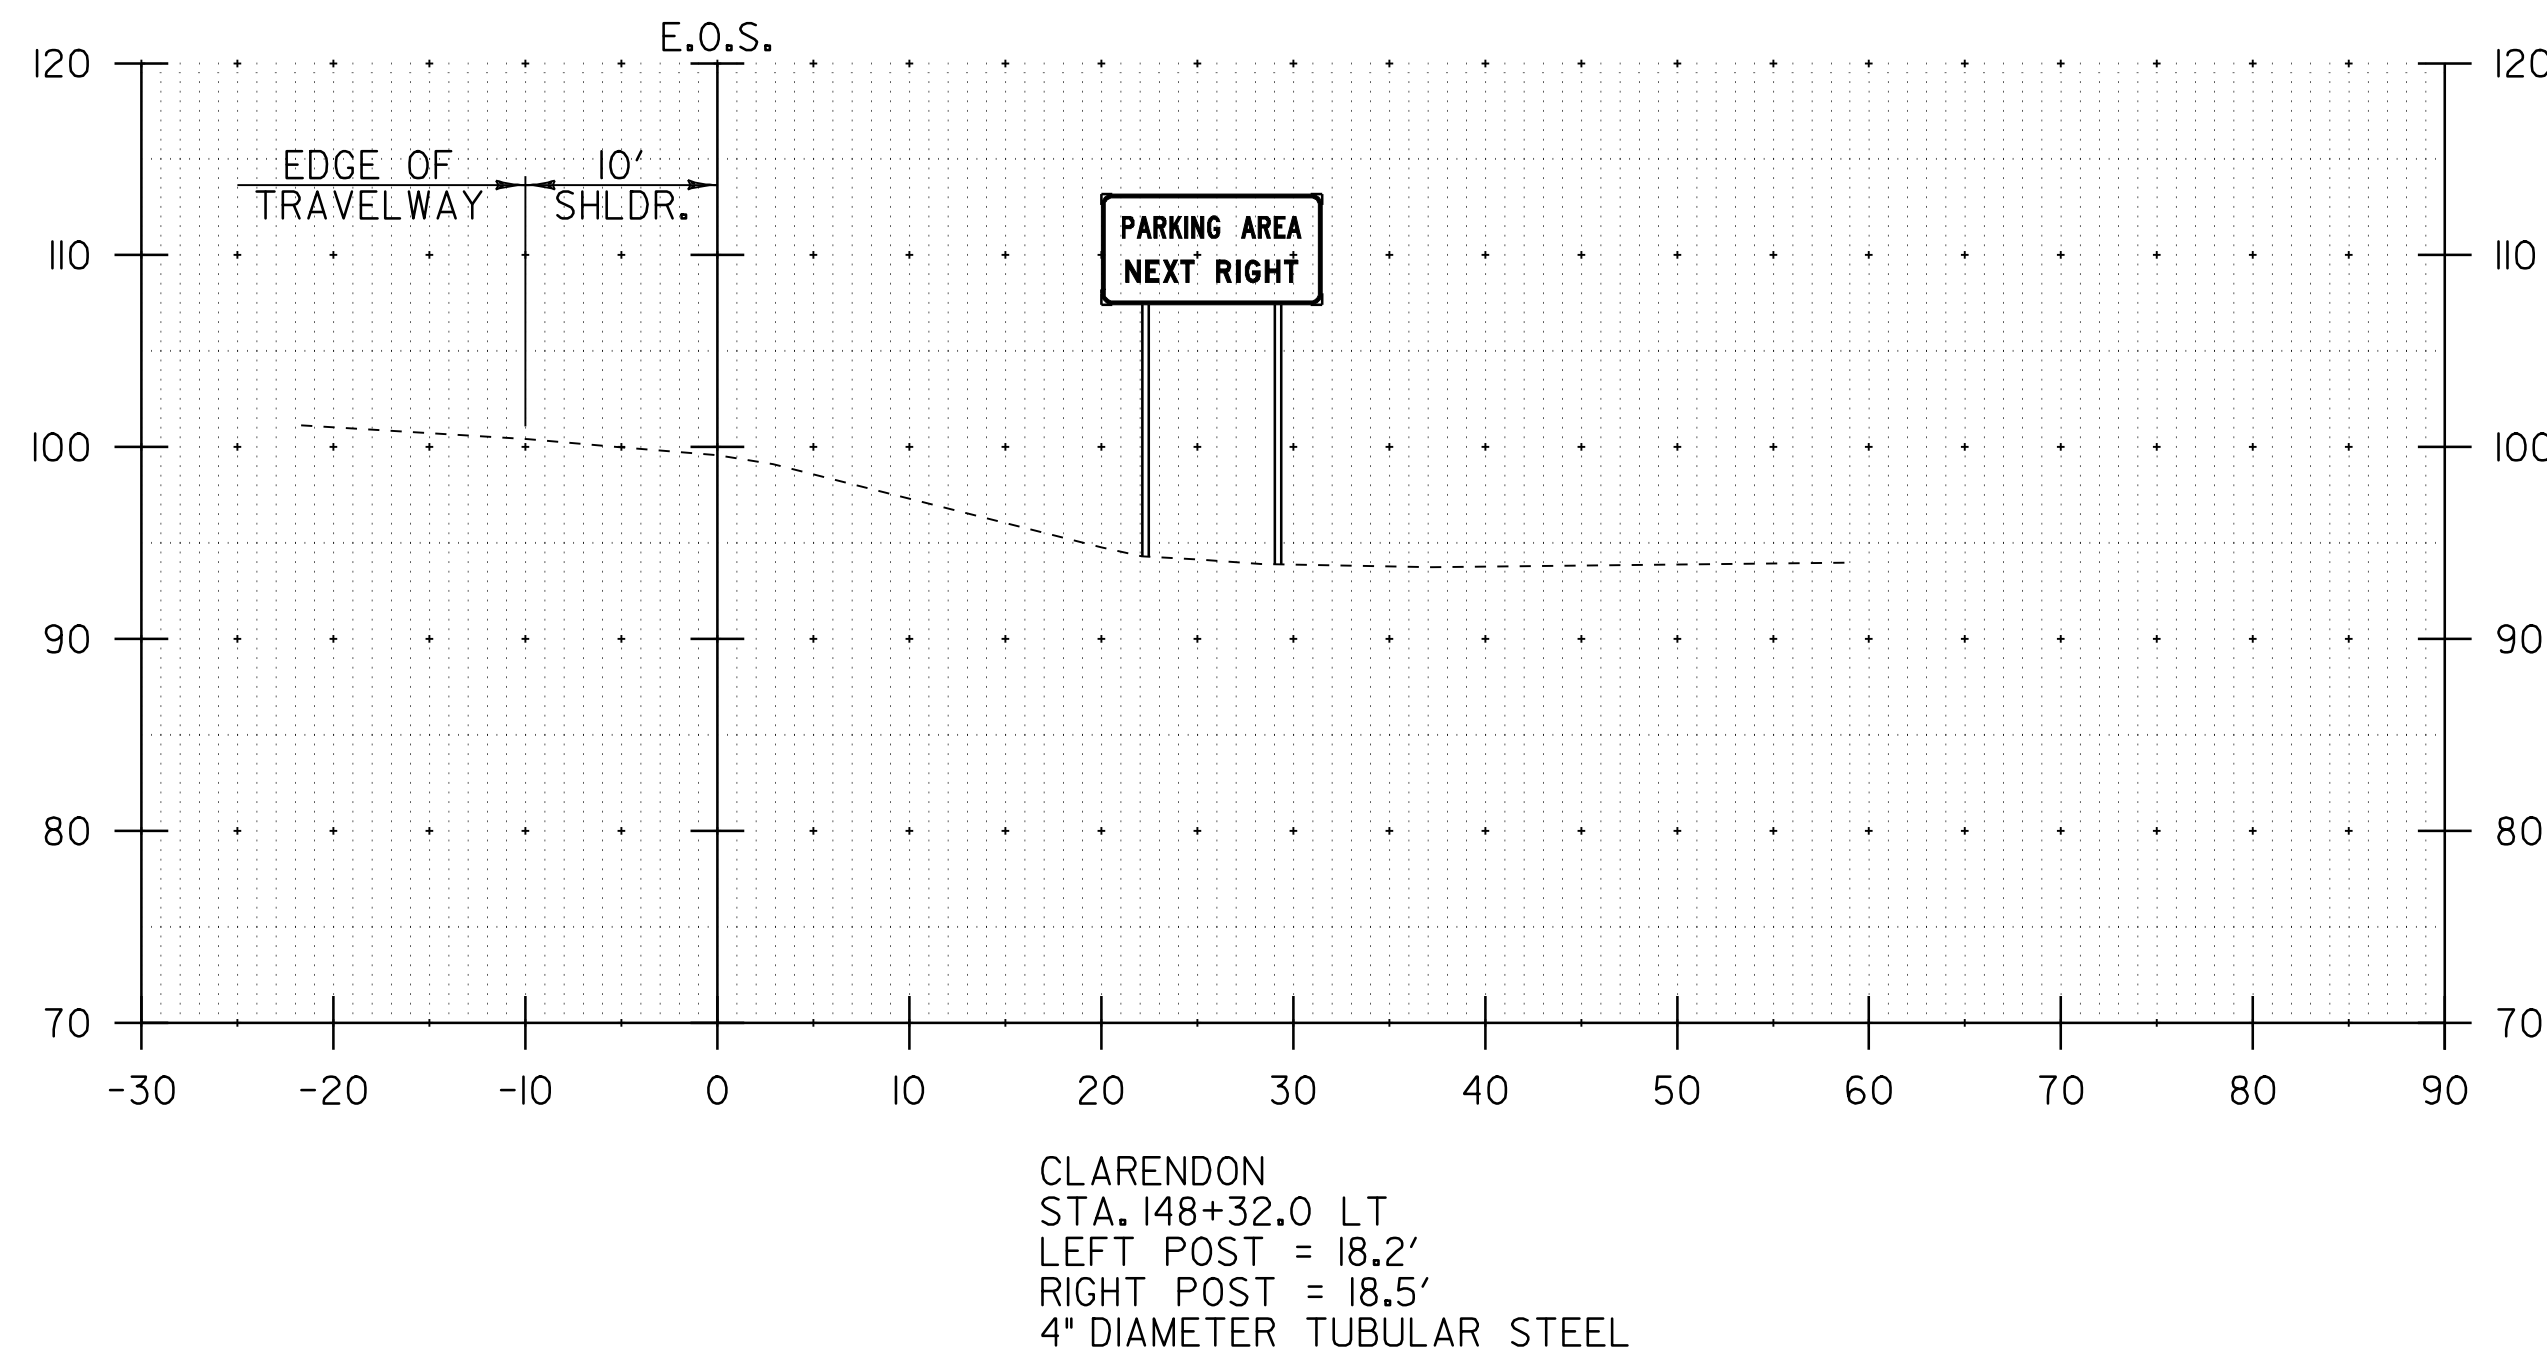
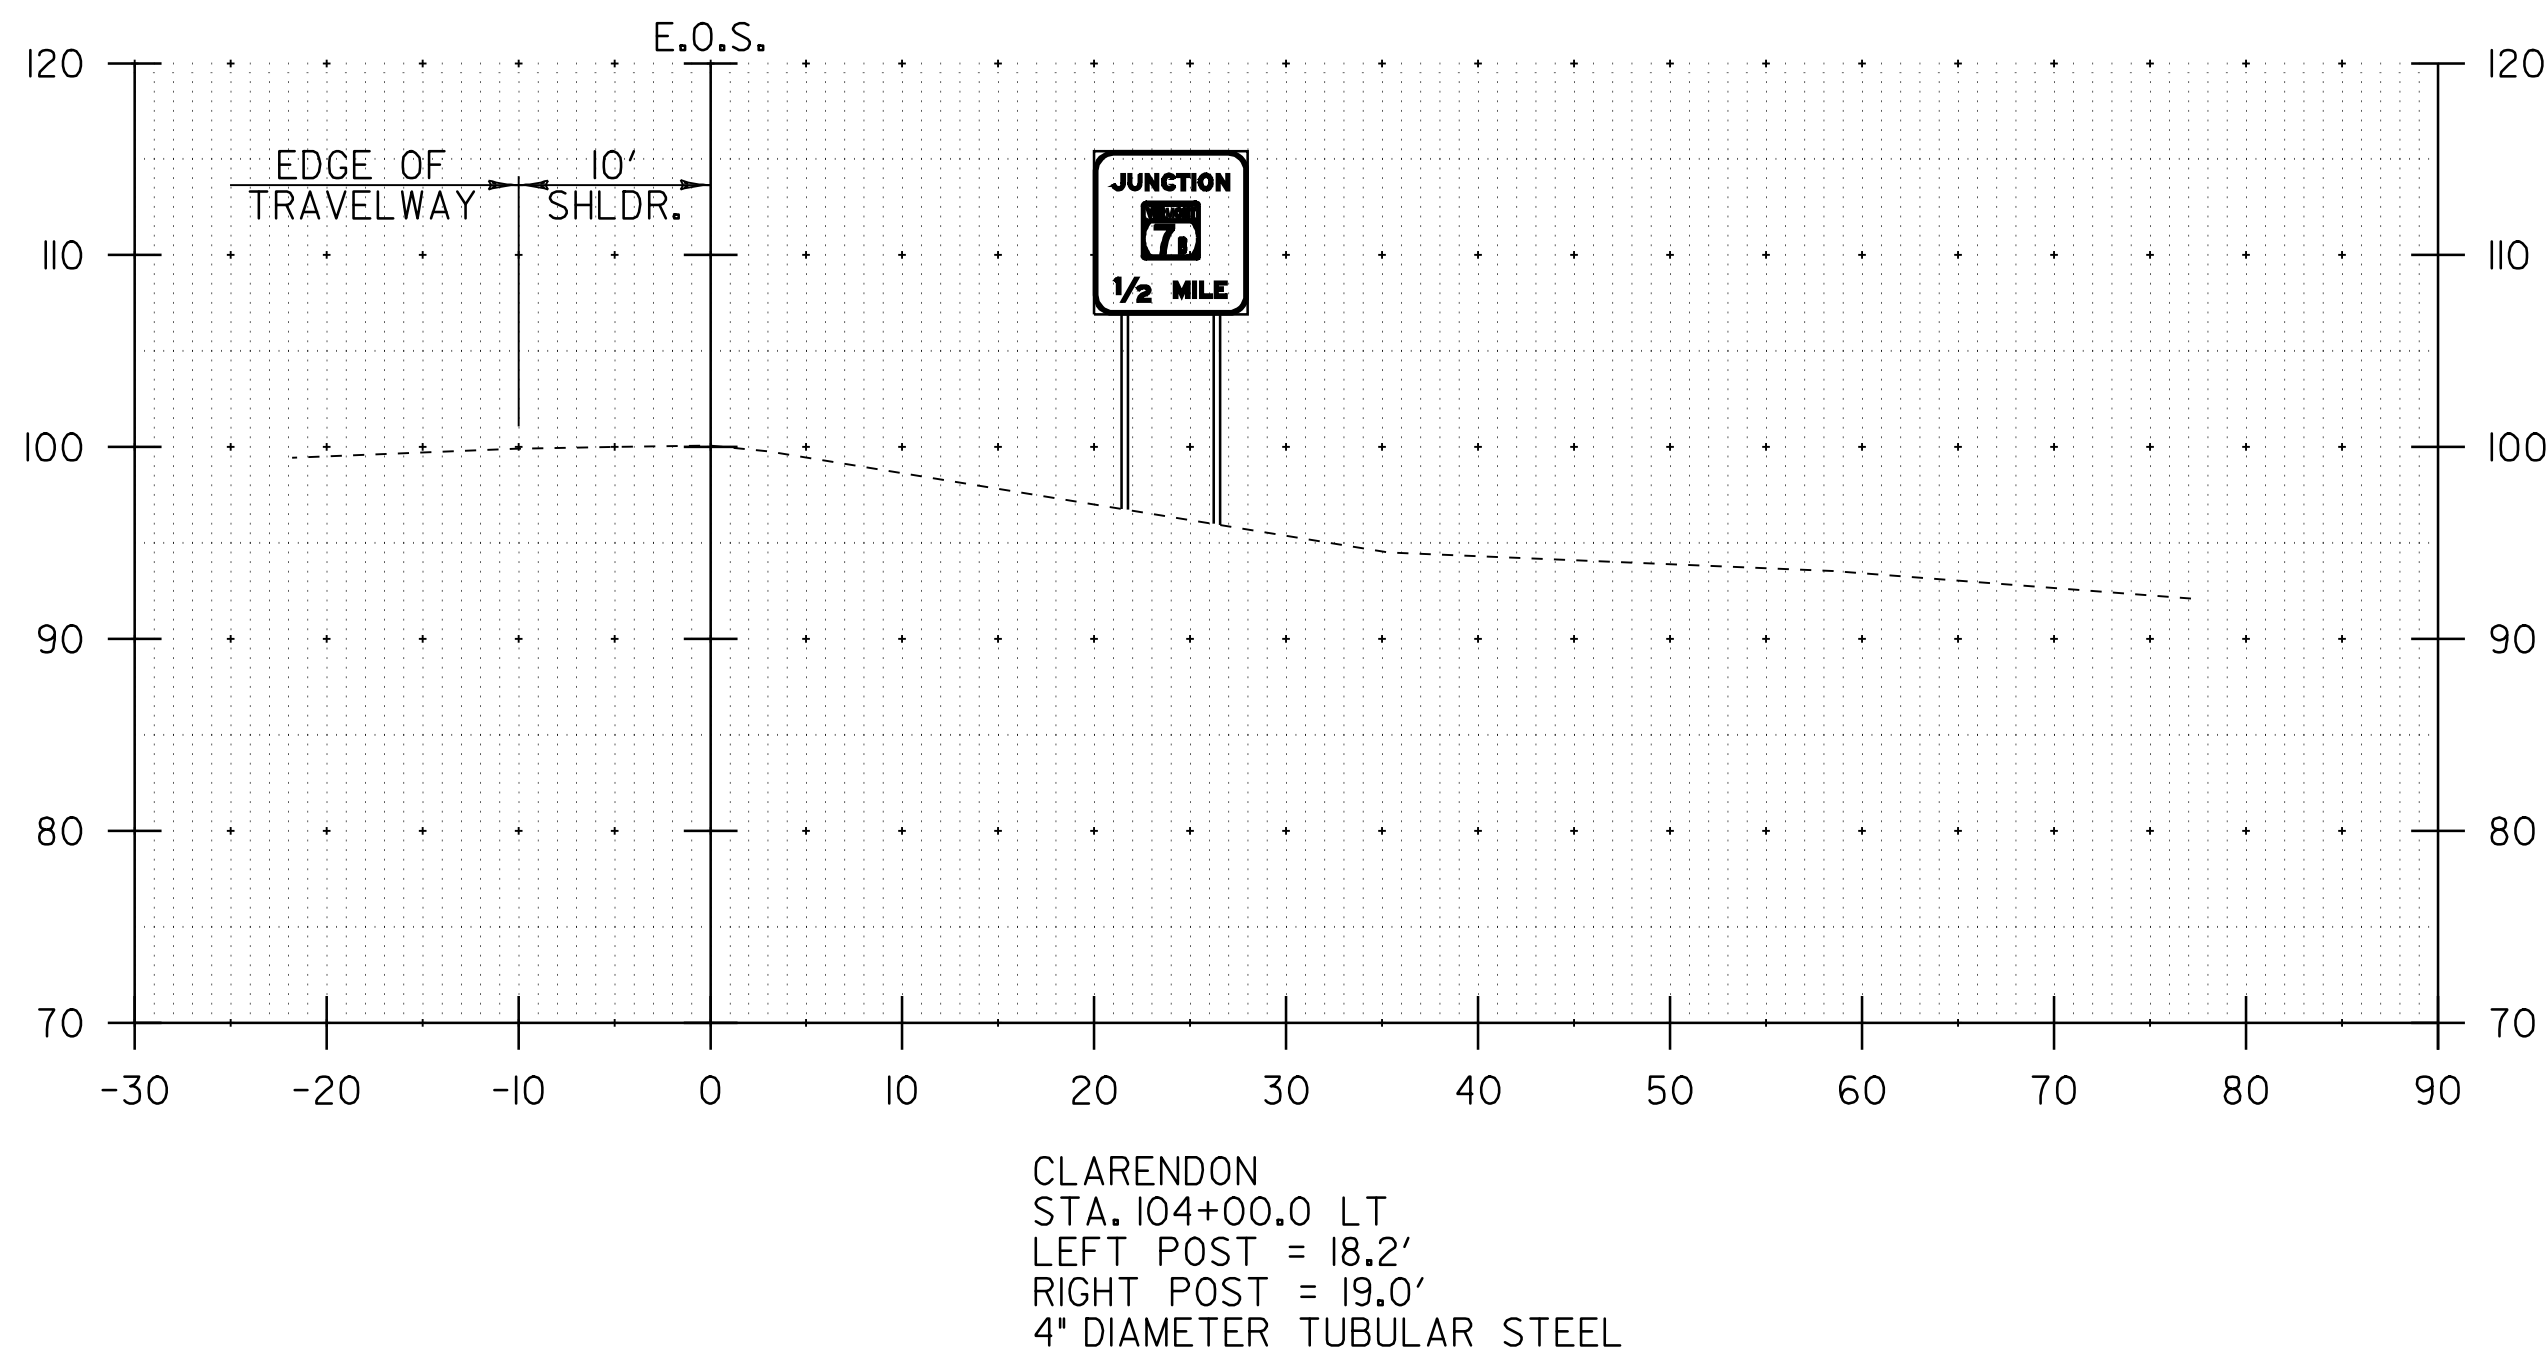
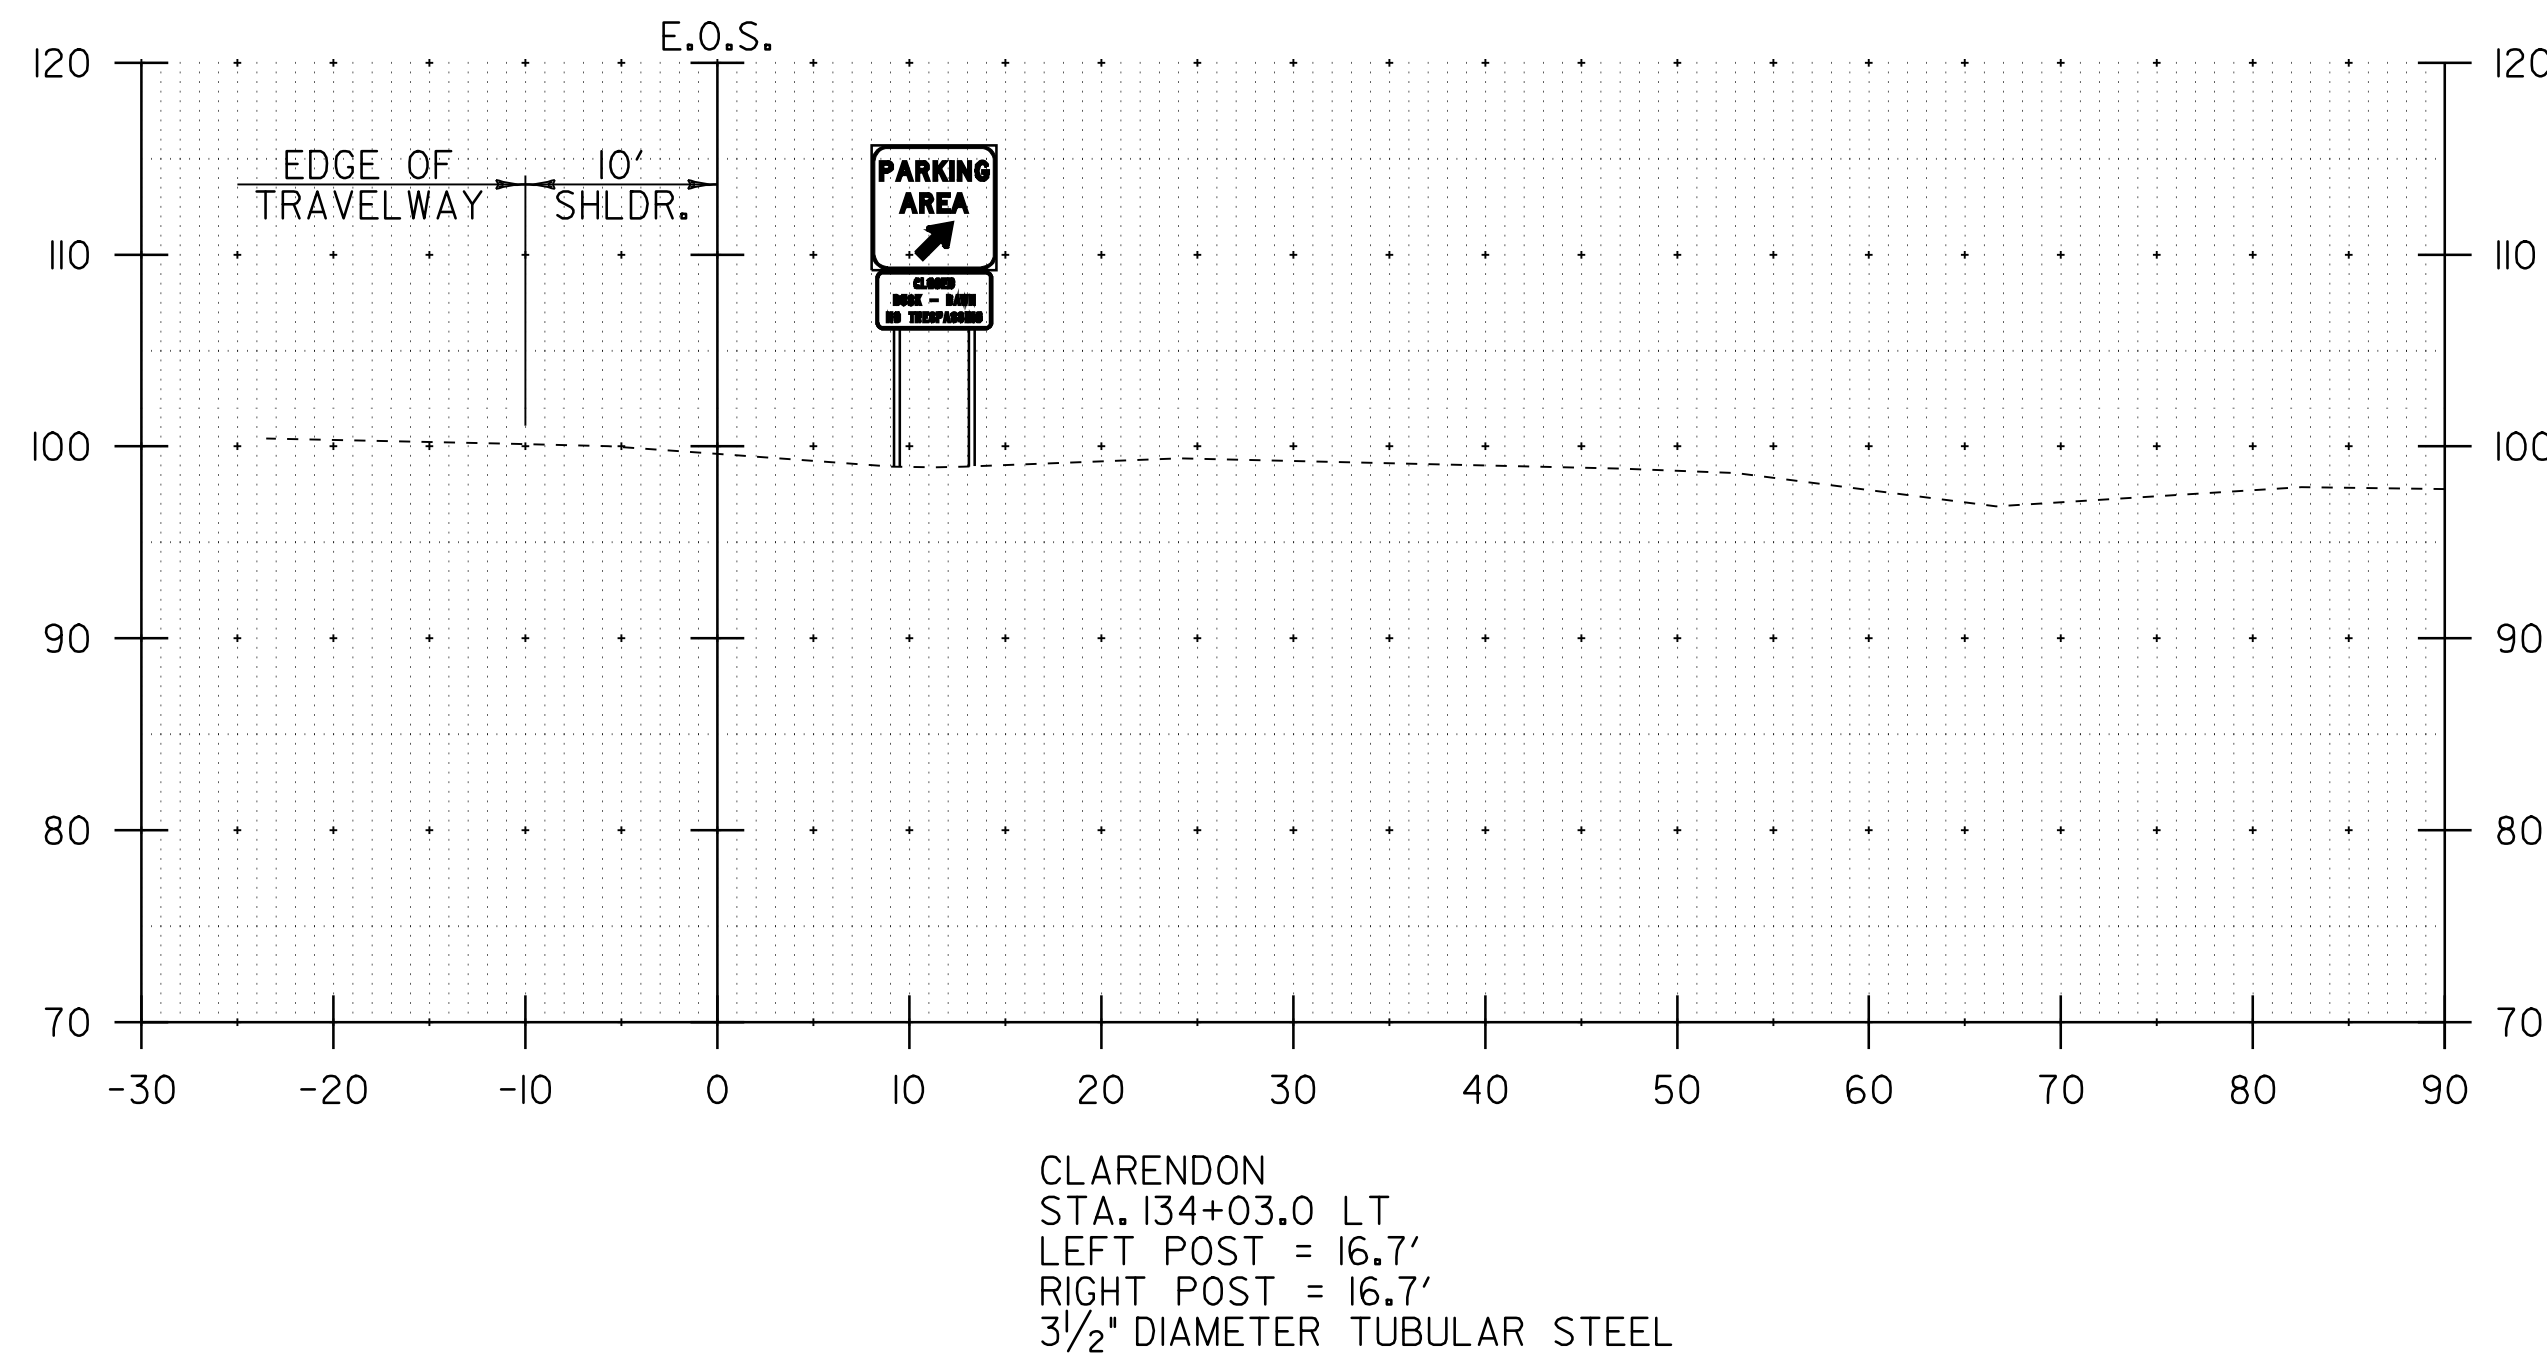
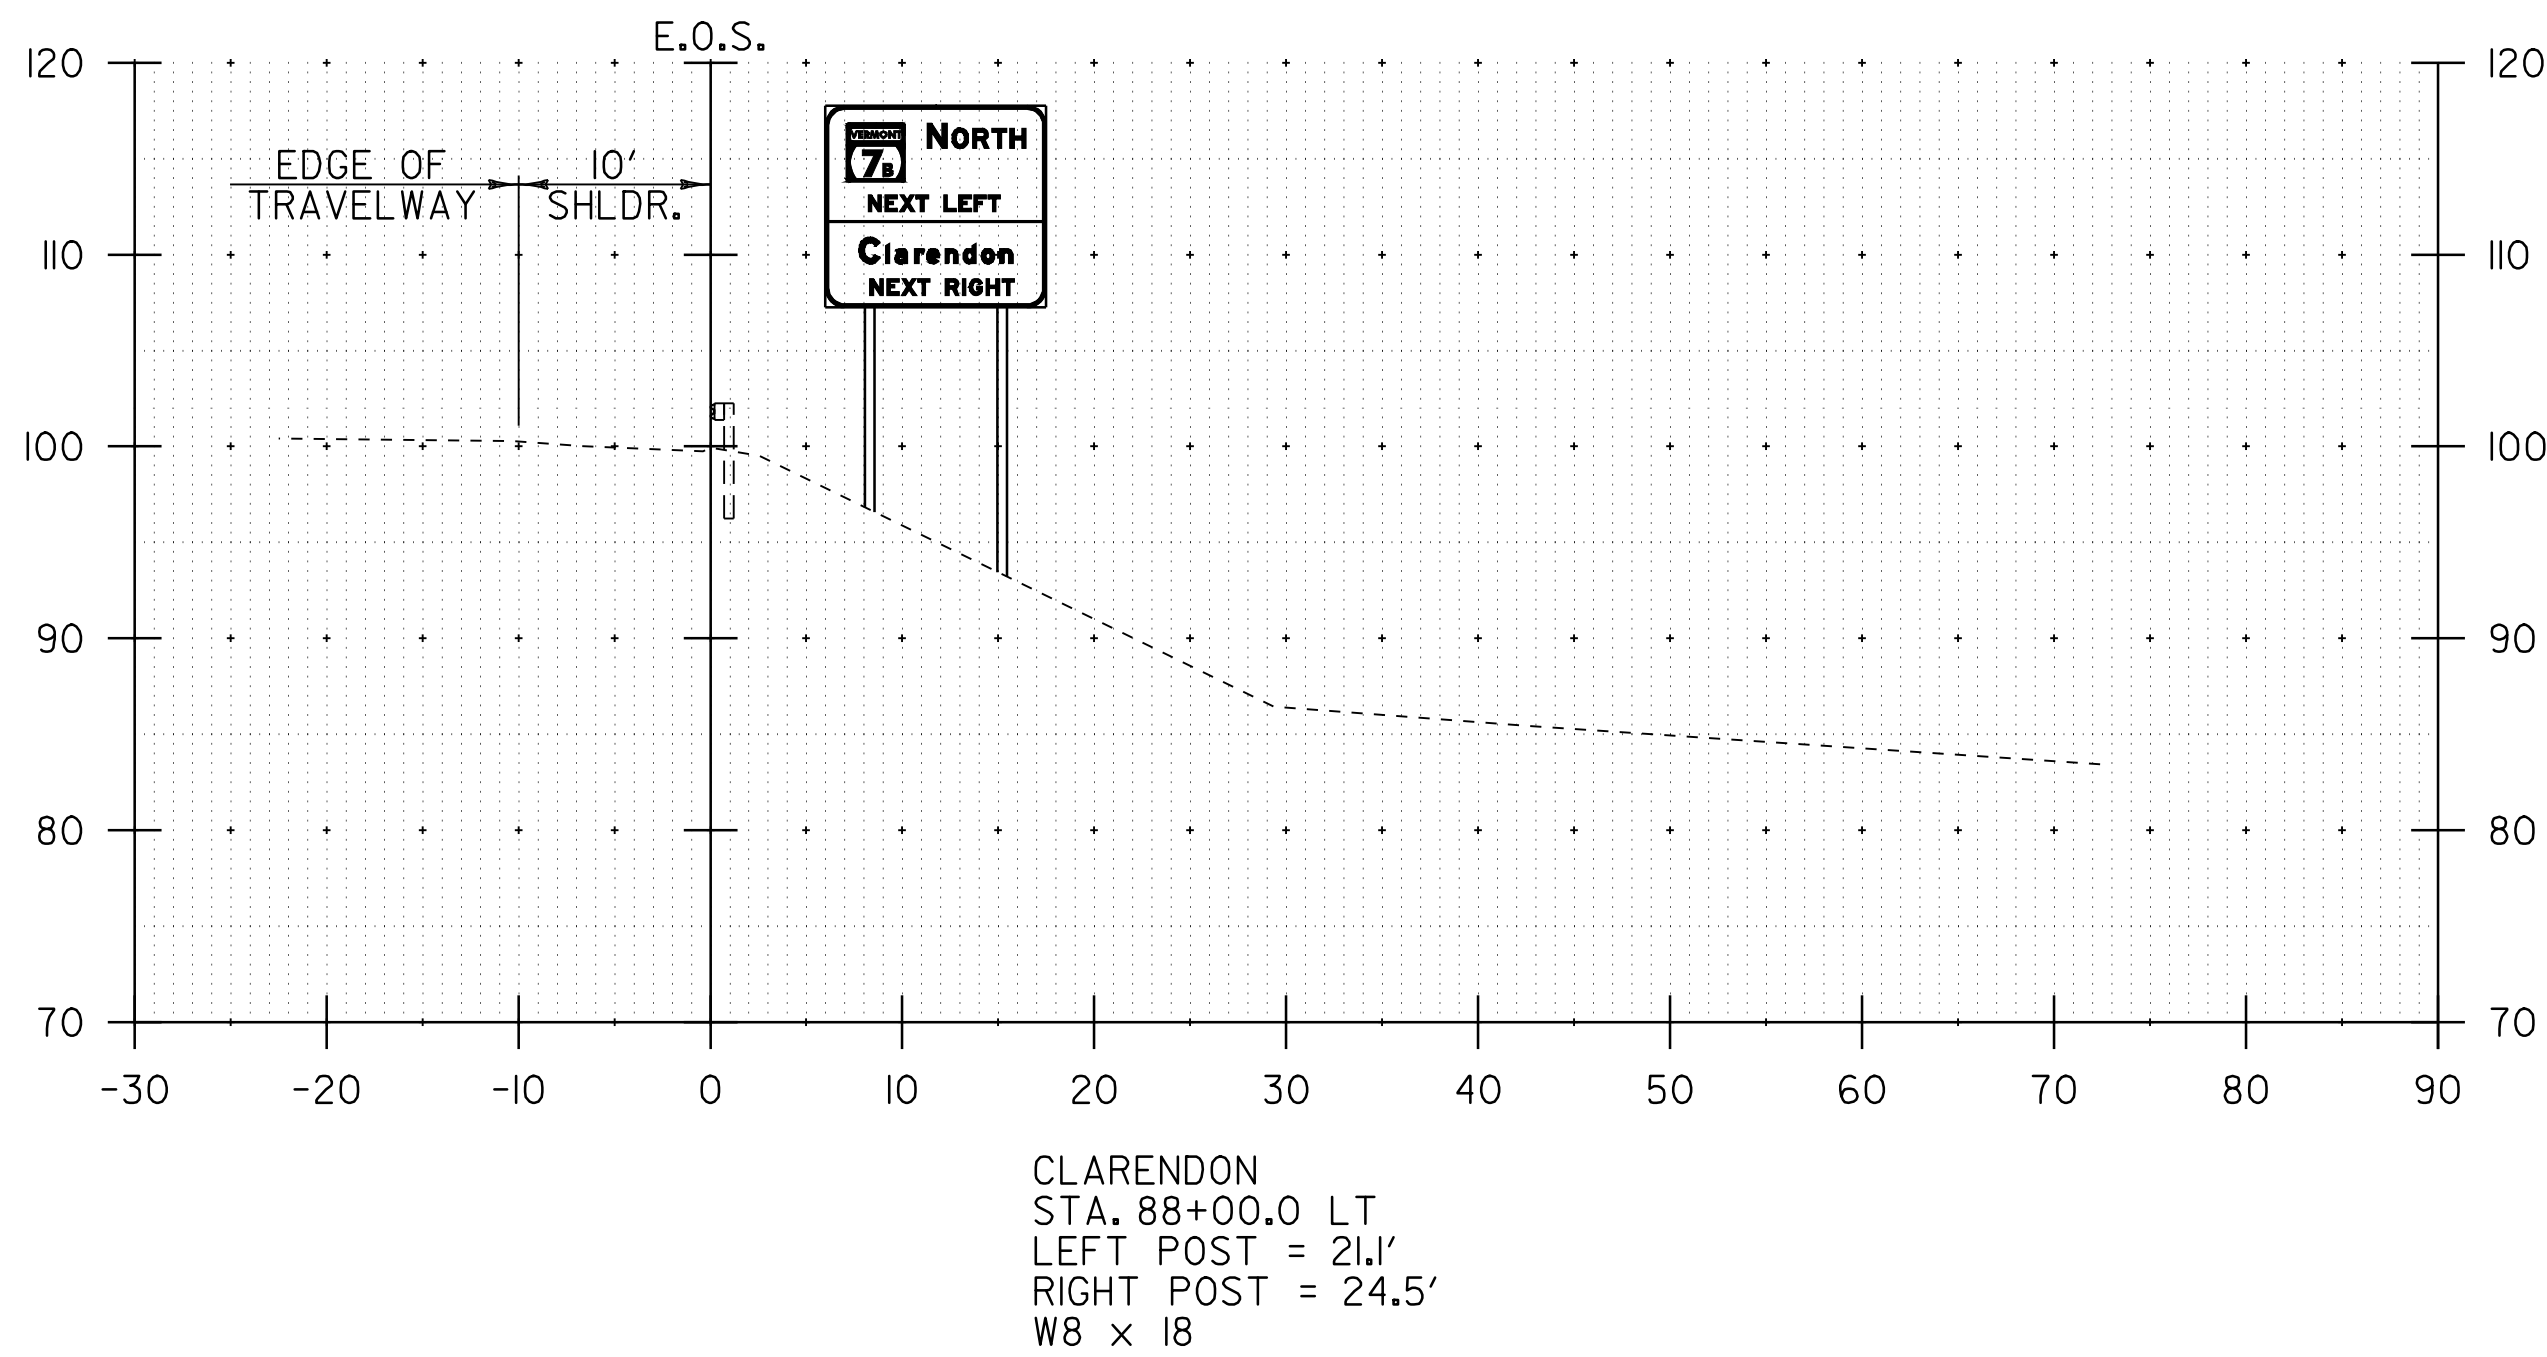
PROJECT NAME: WALLINGFORD - RUTLAND TOWN  
PROJECT NUMBER: NH 2408(I)S

FILE NAME: p04b050.dgn  
PROJECT LEADER: D.E.G.  
DESIGNED BY: J.S.P.  
IPARM FILE: p04b050+sd5.i

PLOT DATE: \$DATE\$  
DRAWN BY: C.A.K.  
CHECKED BY: D.E.G.  
SHEET 67 OF 80

NOTE:  
TEXT LAYOUT DIMENSIONS ARE BASED ON THE STANDARD ALPHABETS SPACING CHARTS  
FOUND IN THE "STANDARD HIGHWAY SIGNS" BOOK PUBLISHED BY FHWA. MINOR VARIATIONS  
IN TEXT DIMENSIONS ARE ACCEPTABLE BASED ON INDIVIDUAL MANUFACTURER'S LETTER  
FABRICATION. SIGNIFICANT CHANGES THAT AFFECT SIGN APPEARANCE SHALL BE BROUGHT  
TO THE ATTENTION OF VAOT'S TRAFFIC OPERATIONS SECTION BEFORE FABRICATION.





10 0 10  
SCALE: 1" = 20'  
@ FULL SIZE

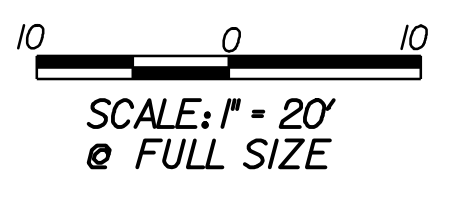
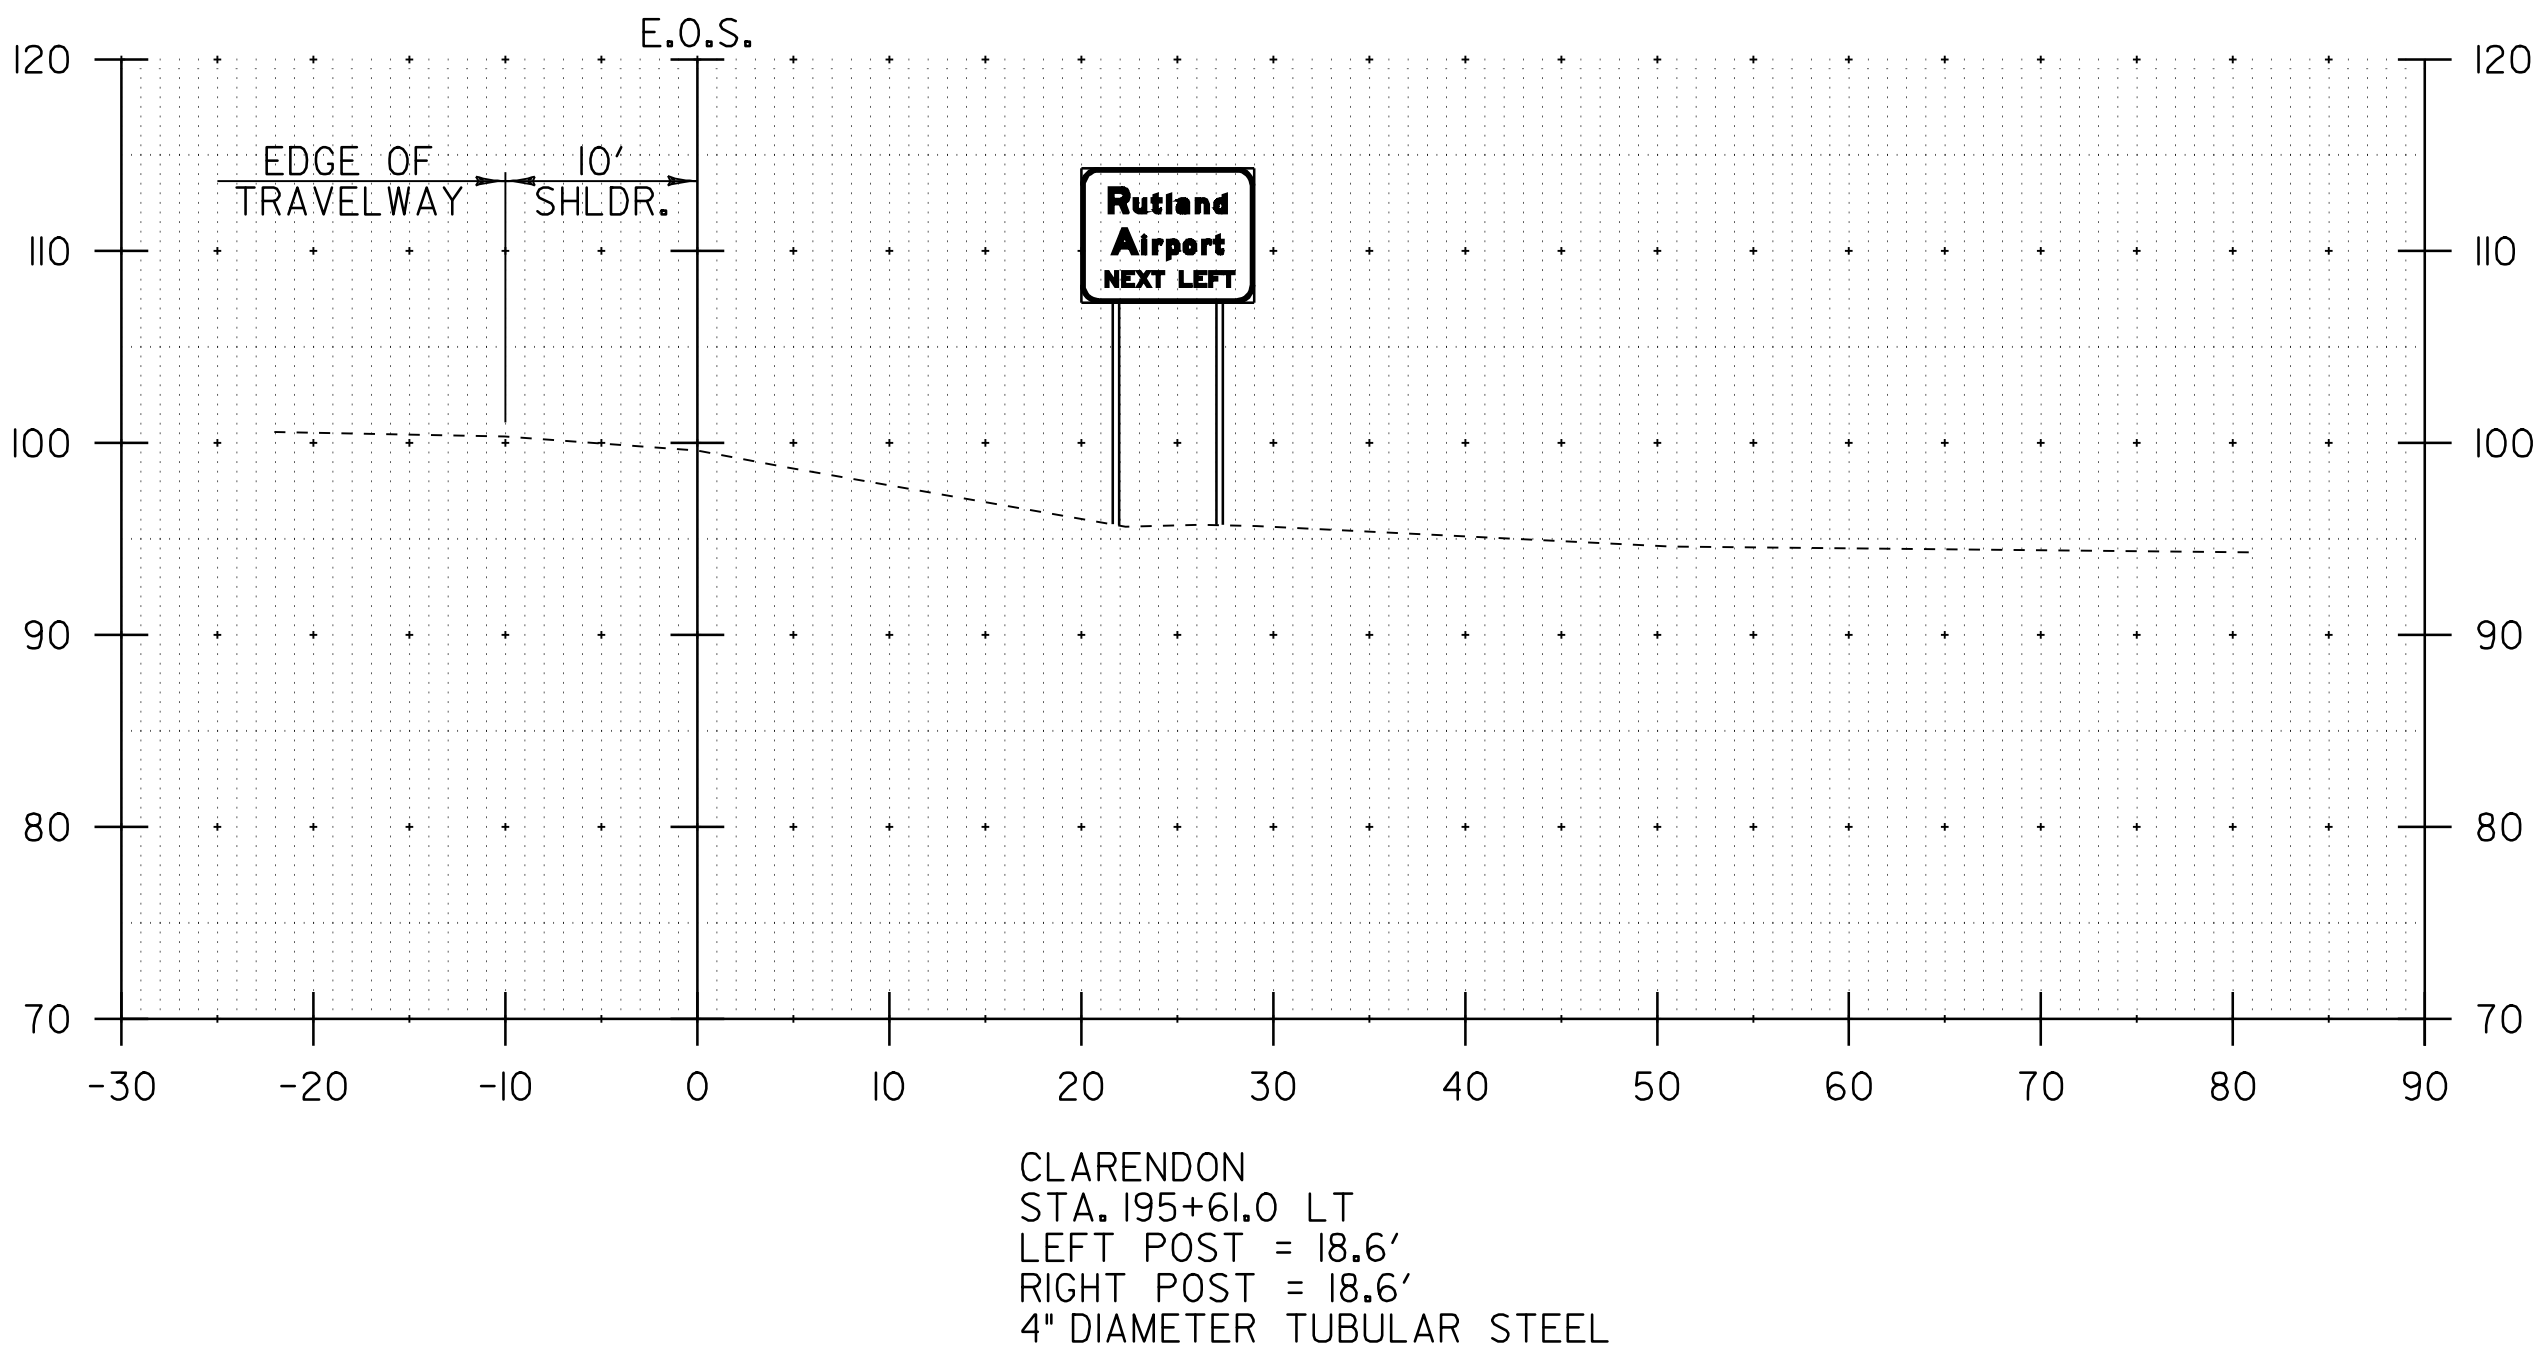
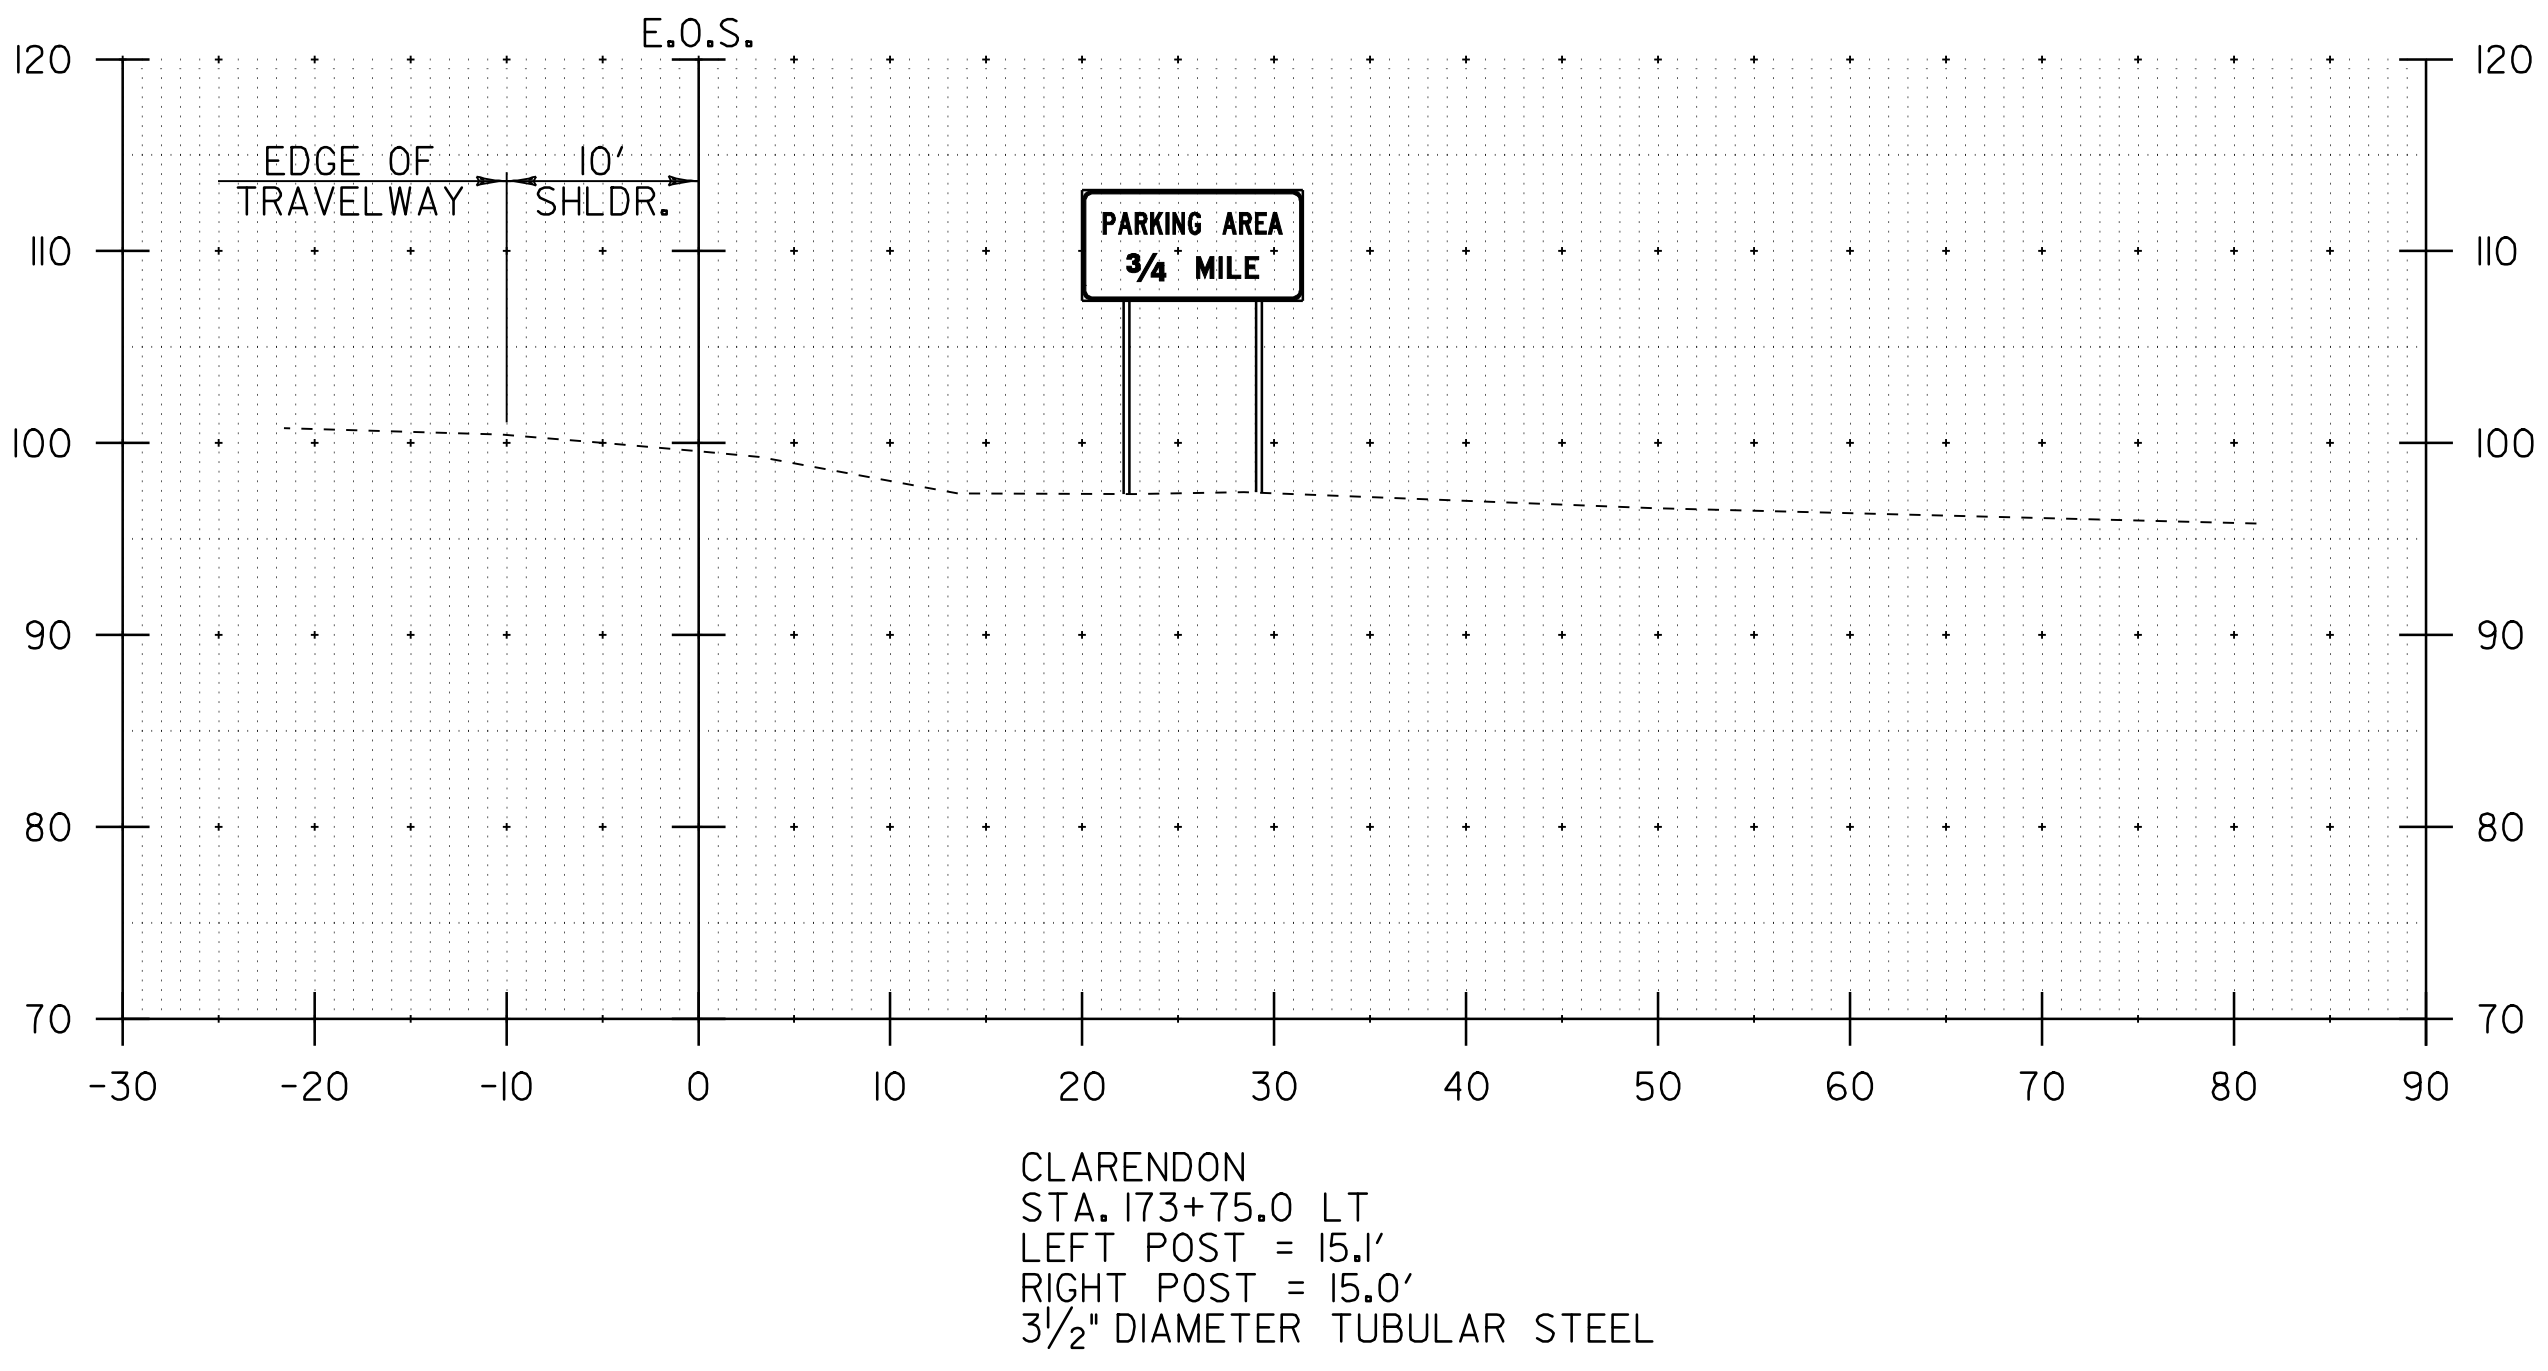
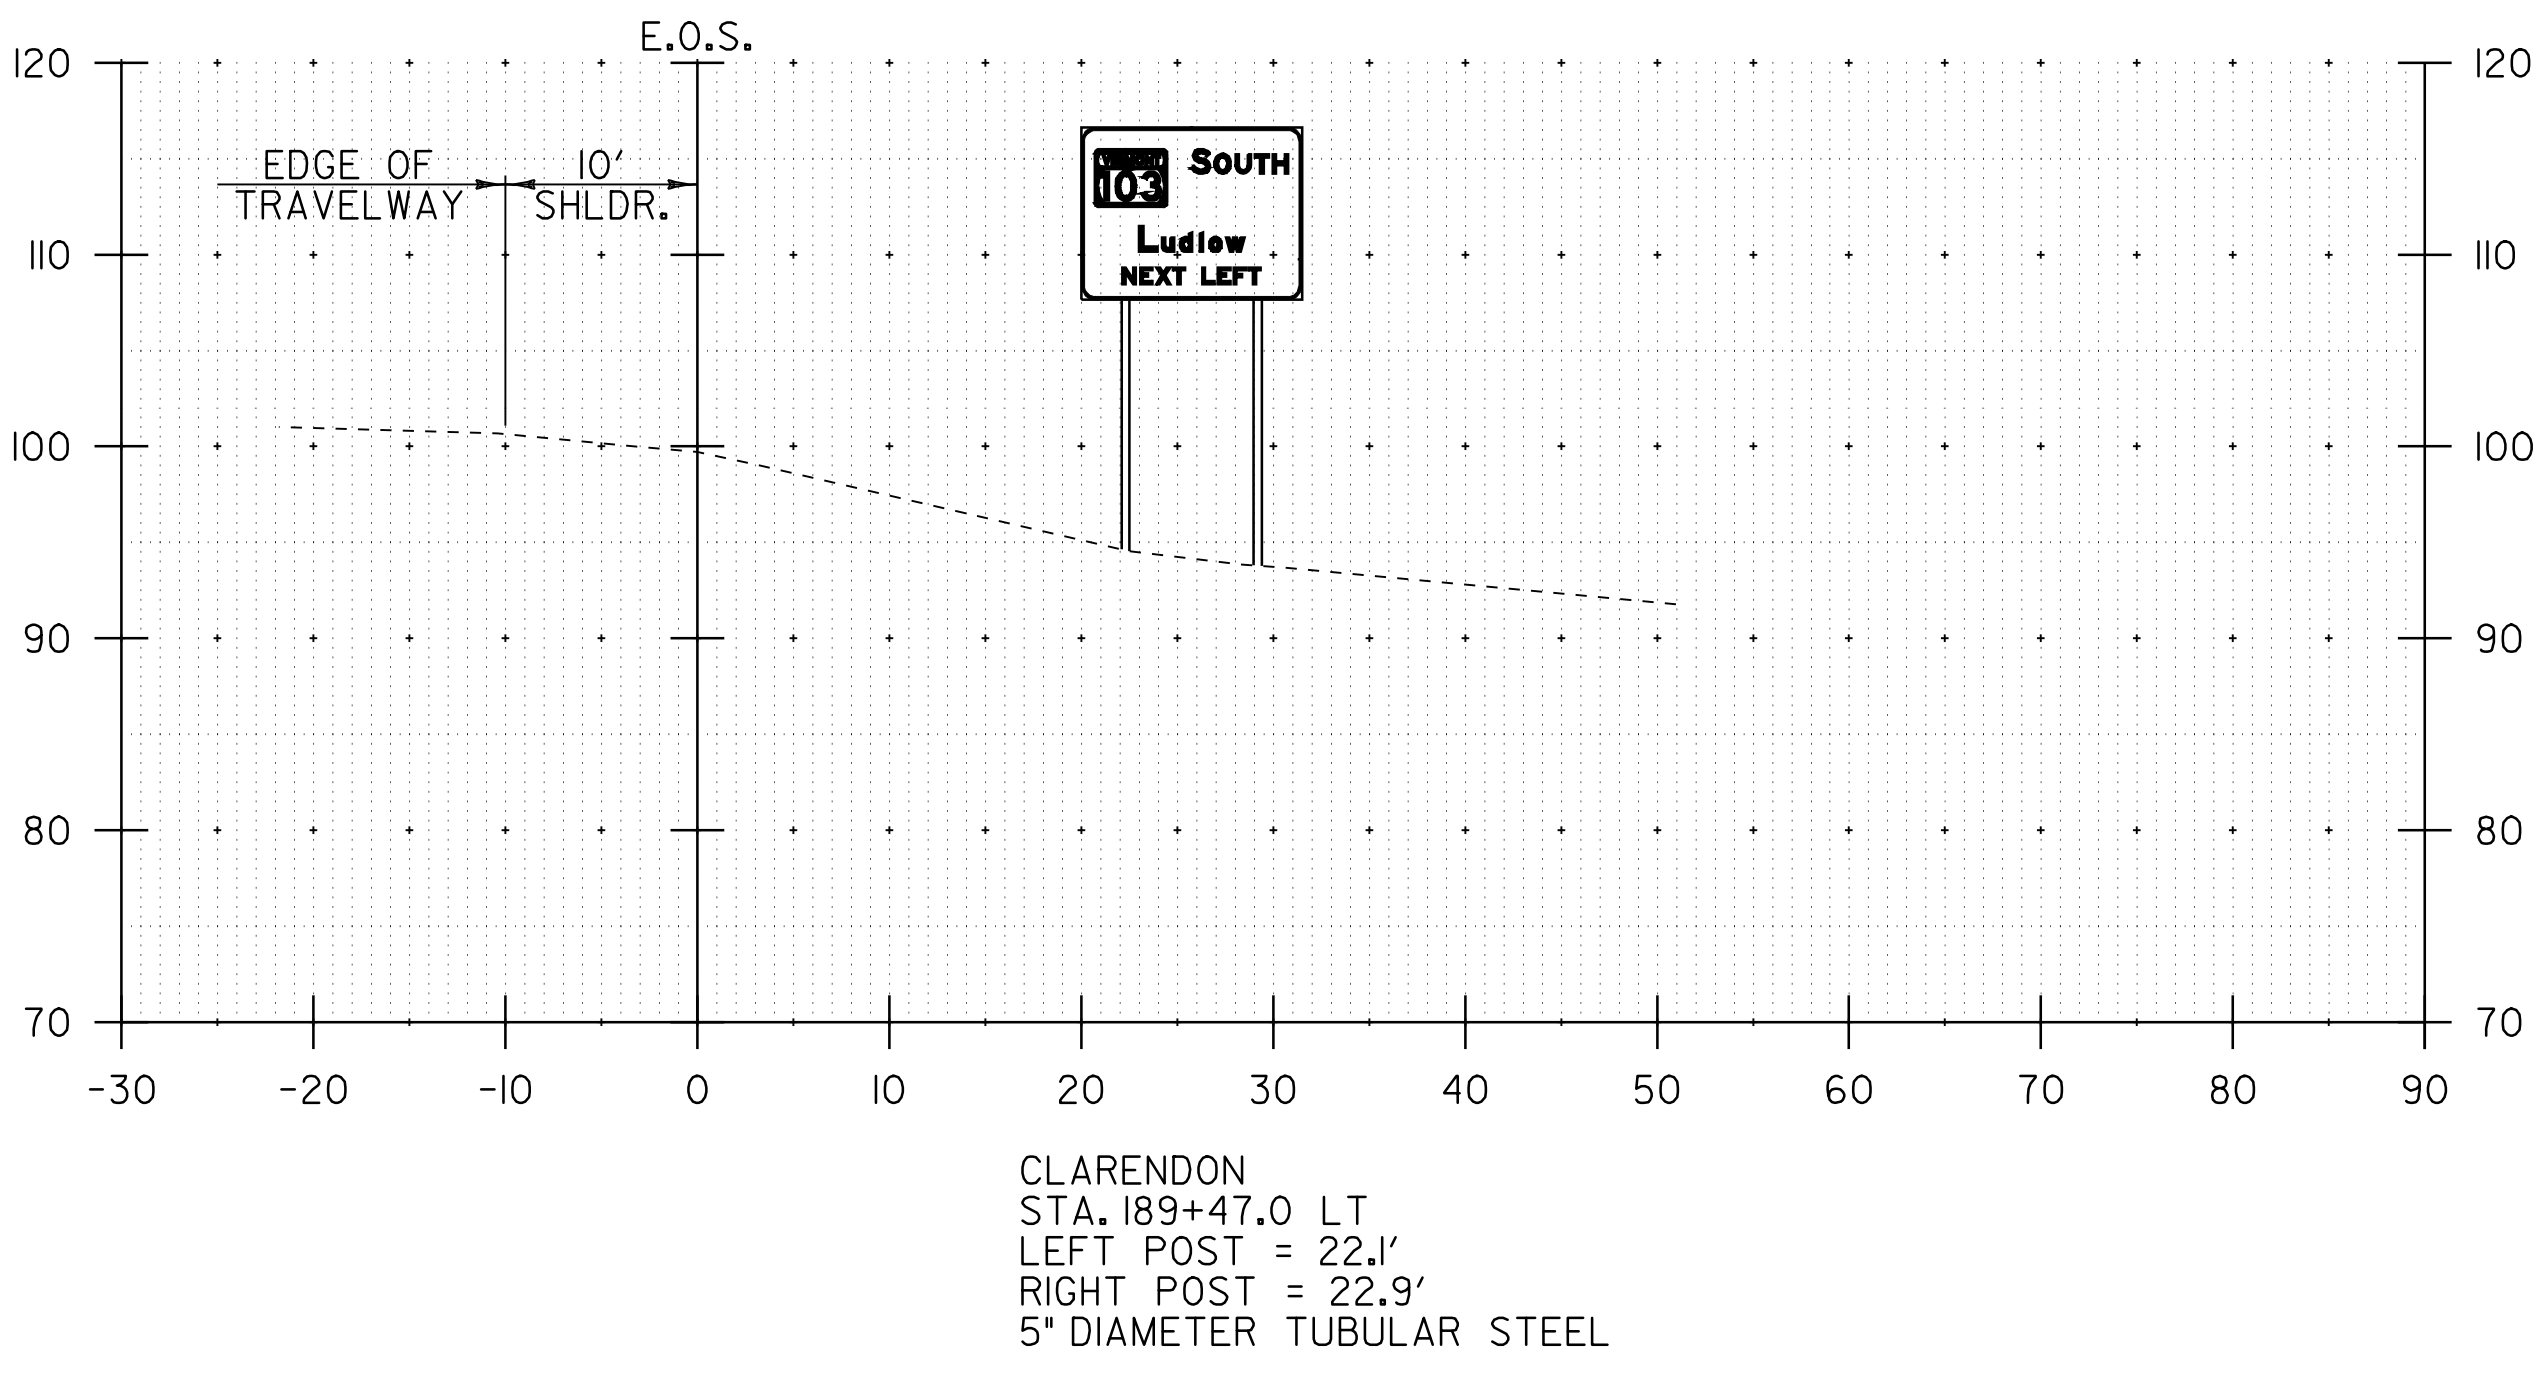
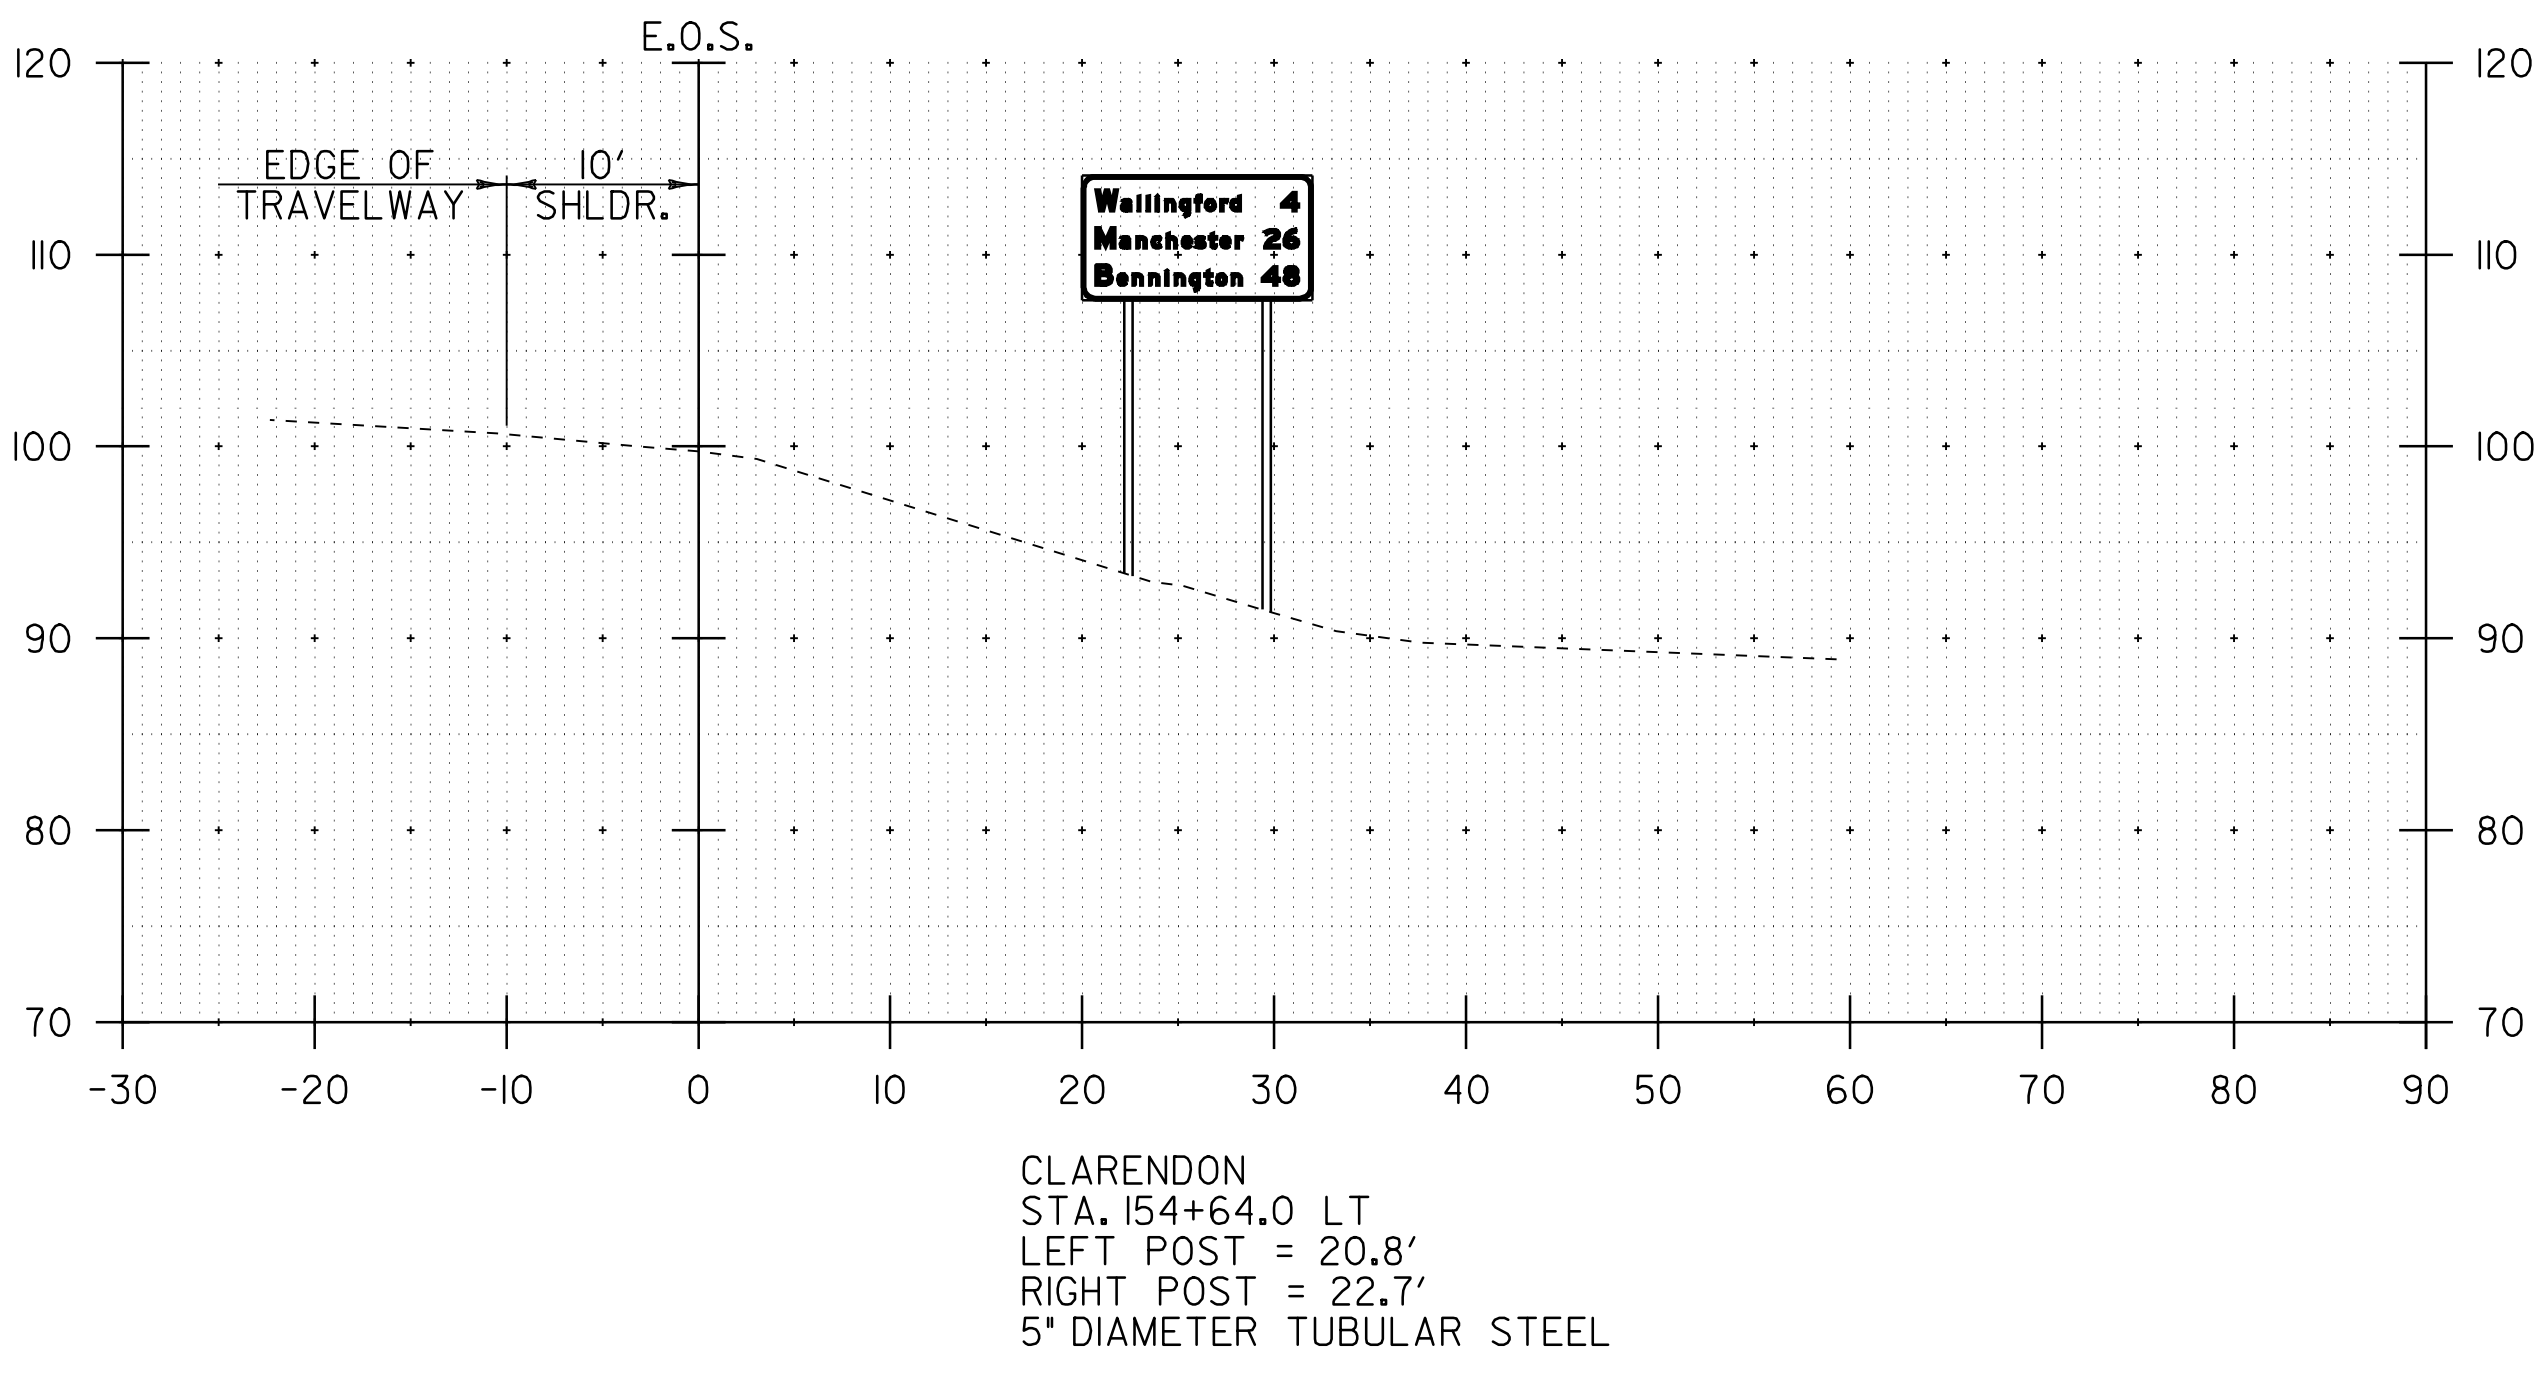
**TRAFFIC SIGN  
CROSS SECTION  
SHEET #1**

PROJECT NAME: WALLINGFORD - RUTLAND TOWN  
PROJECT NUMBER: NH 2408(I)S

FILE NAME: p04b050.dgn  
PROJECT LEADER: D.E.G.  
DESIGNED BY: J.S.P.  
FILE NAME: p04b050xsc01.dgn

PLOT DATE: \$DATE\$  
DRAWN BY: C.A.K.  
CHECKED BY: D.E.G.  
SHEET 68 OF 80










PROJECT NAME: WALLINGFORD - RUTLAND TOWN  
PROJECT NUMBER: NH 2408(I)S

FILE NAME: p04b050.dgn  
PROJECT LEADER: D.E.G.  
DESIGNED BY: J.S.P.  
FILE NAME: p04b050xsc02.dgn

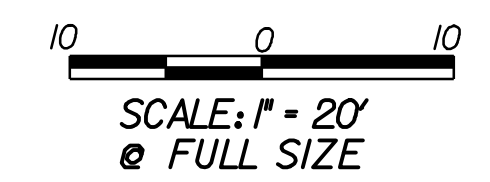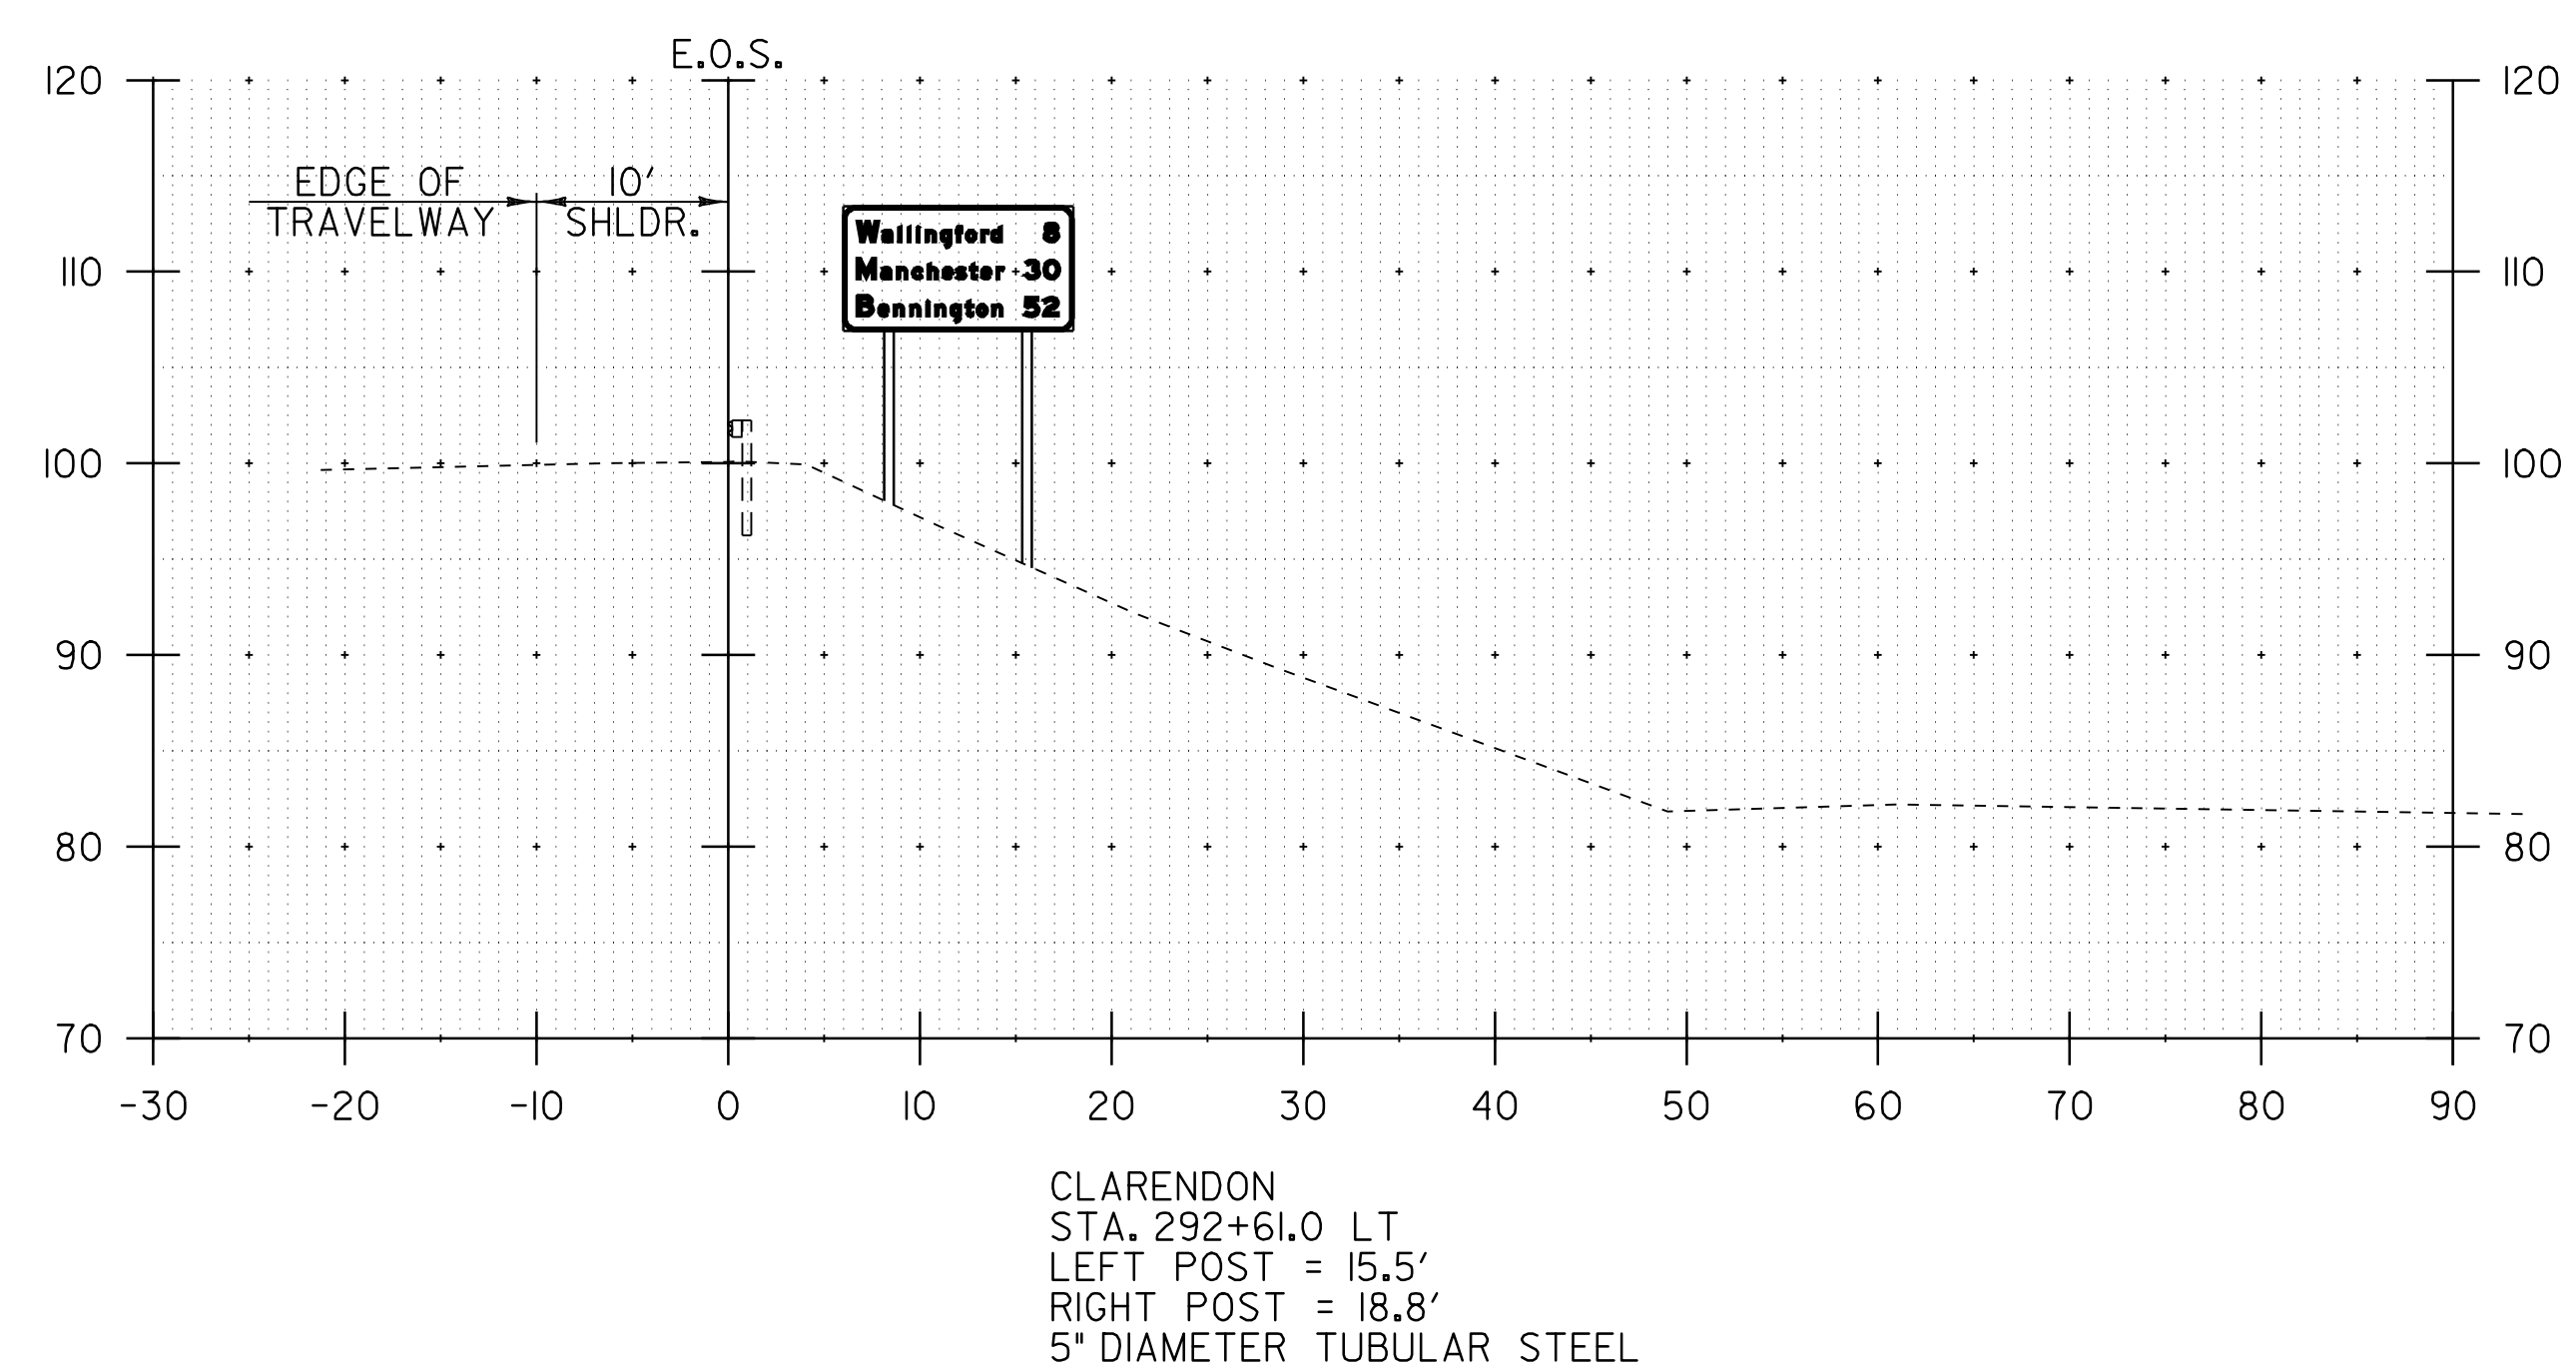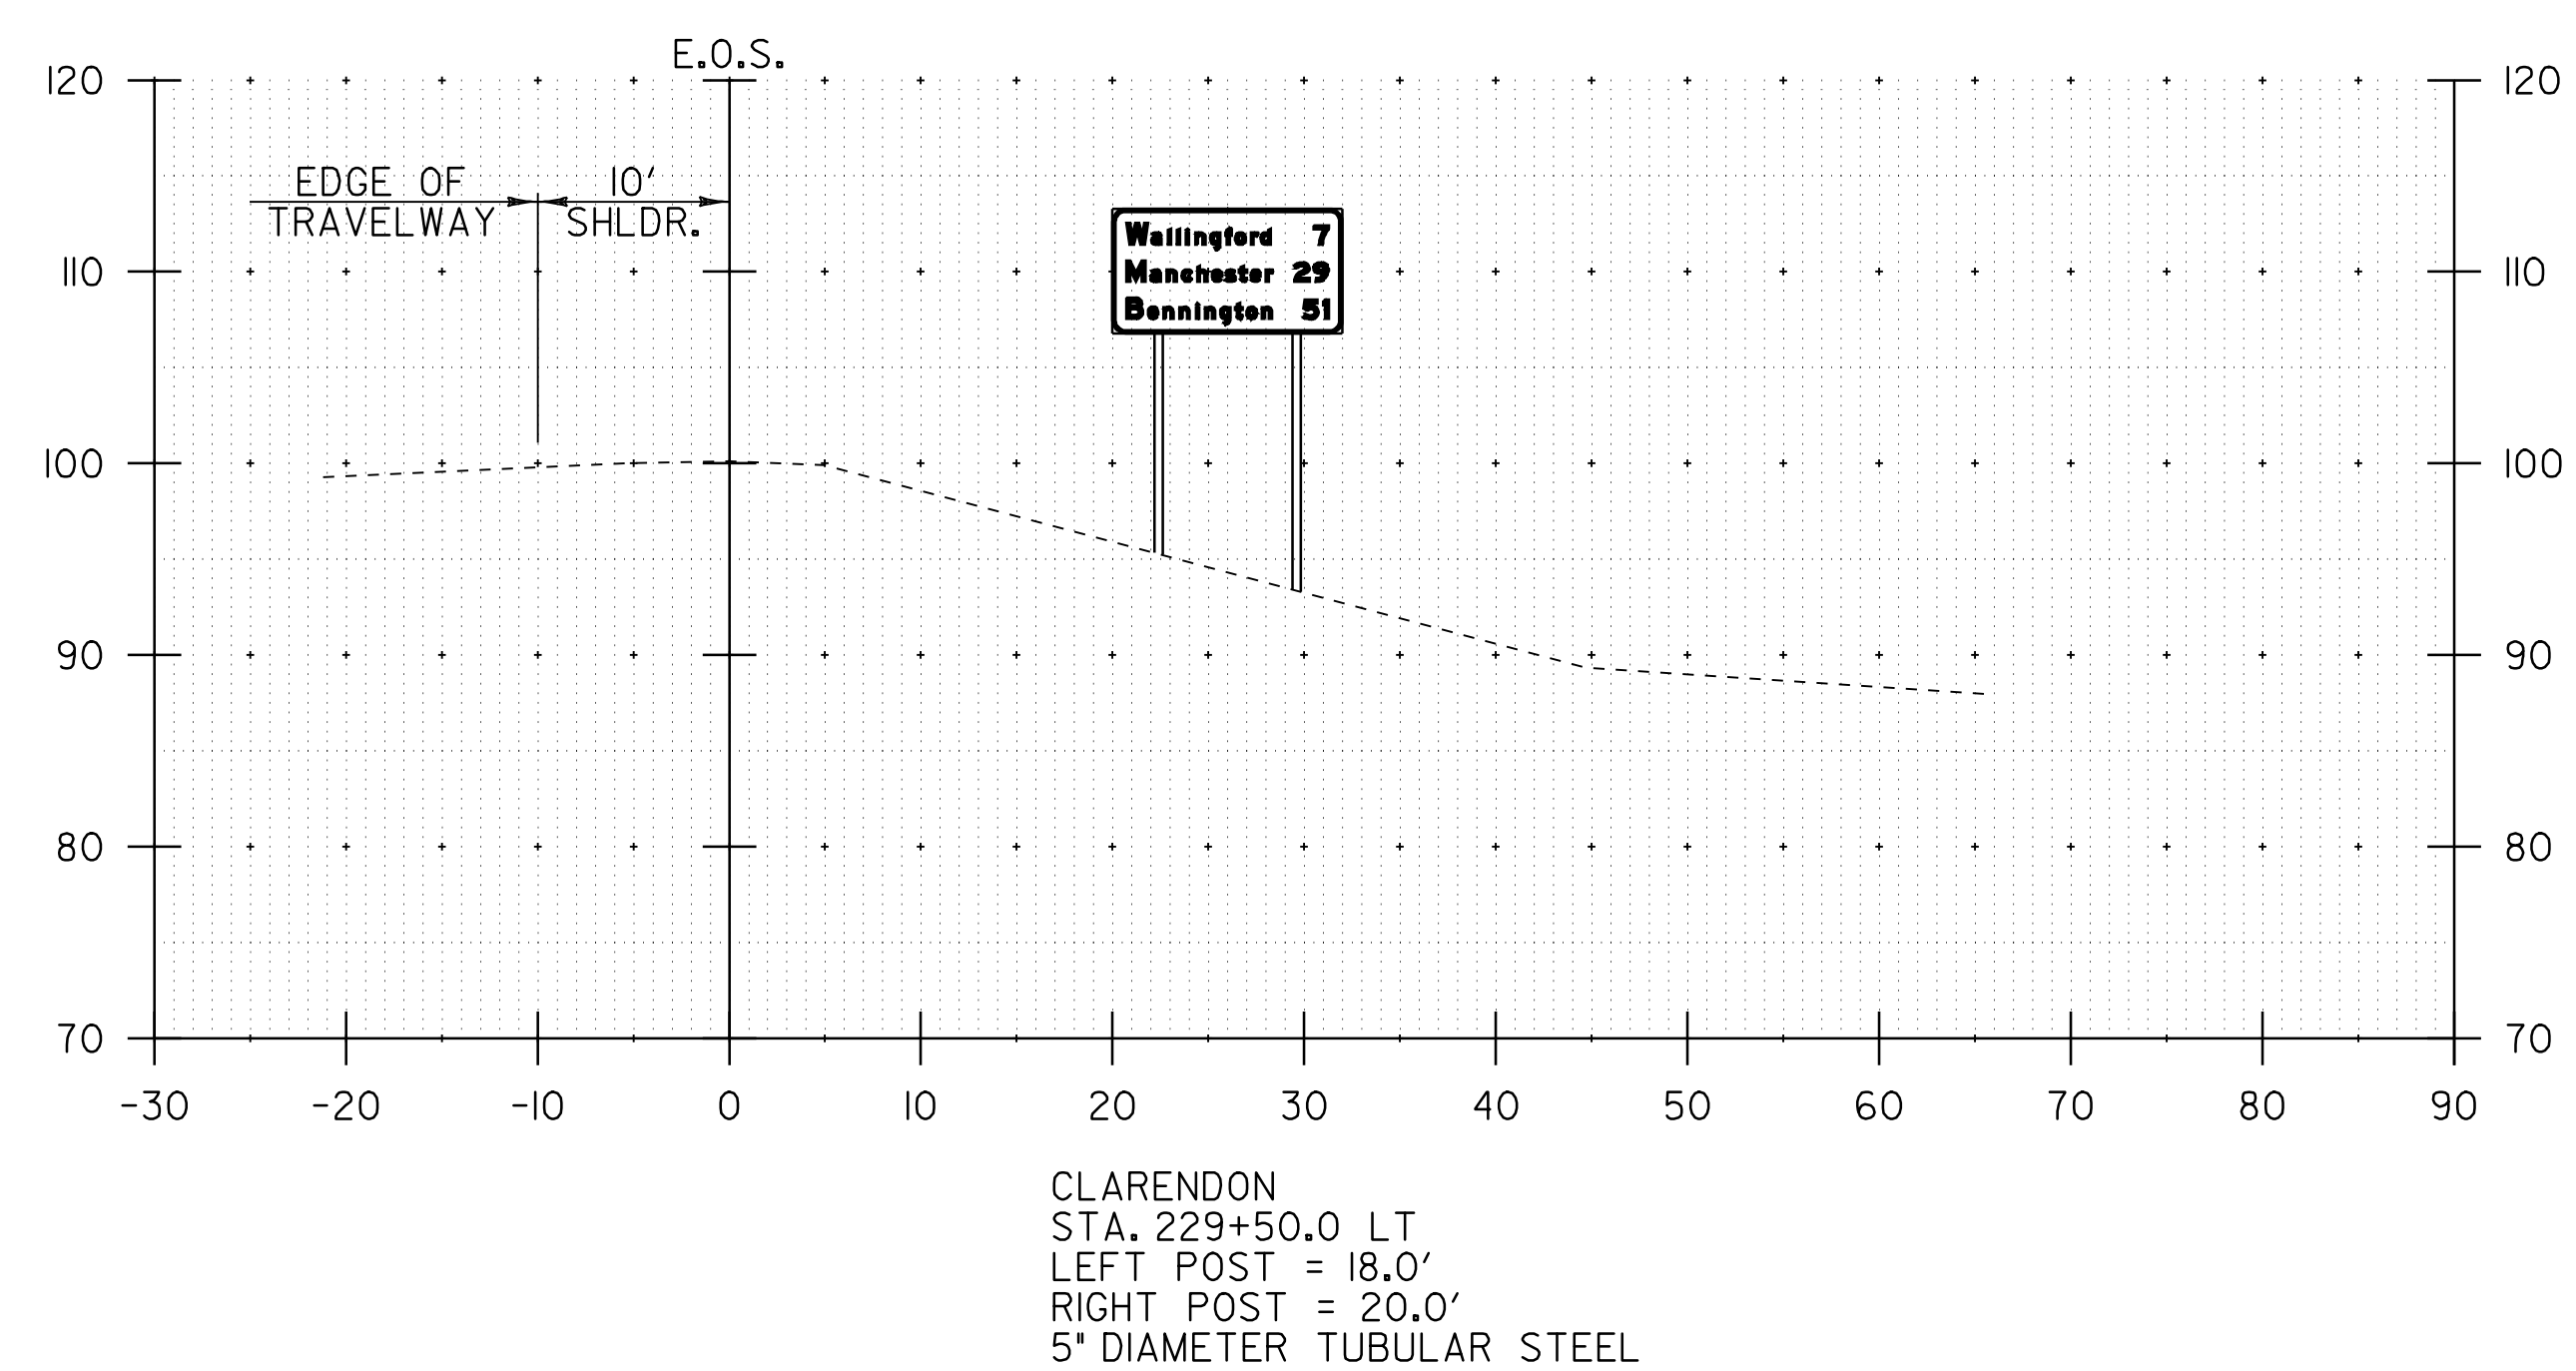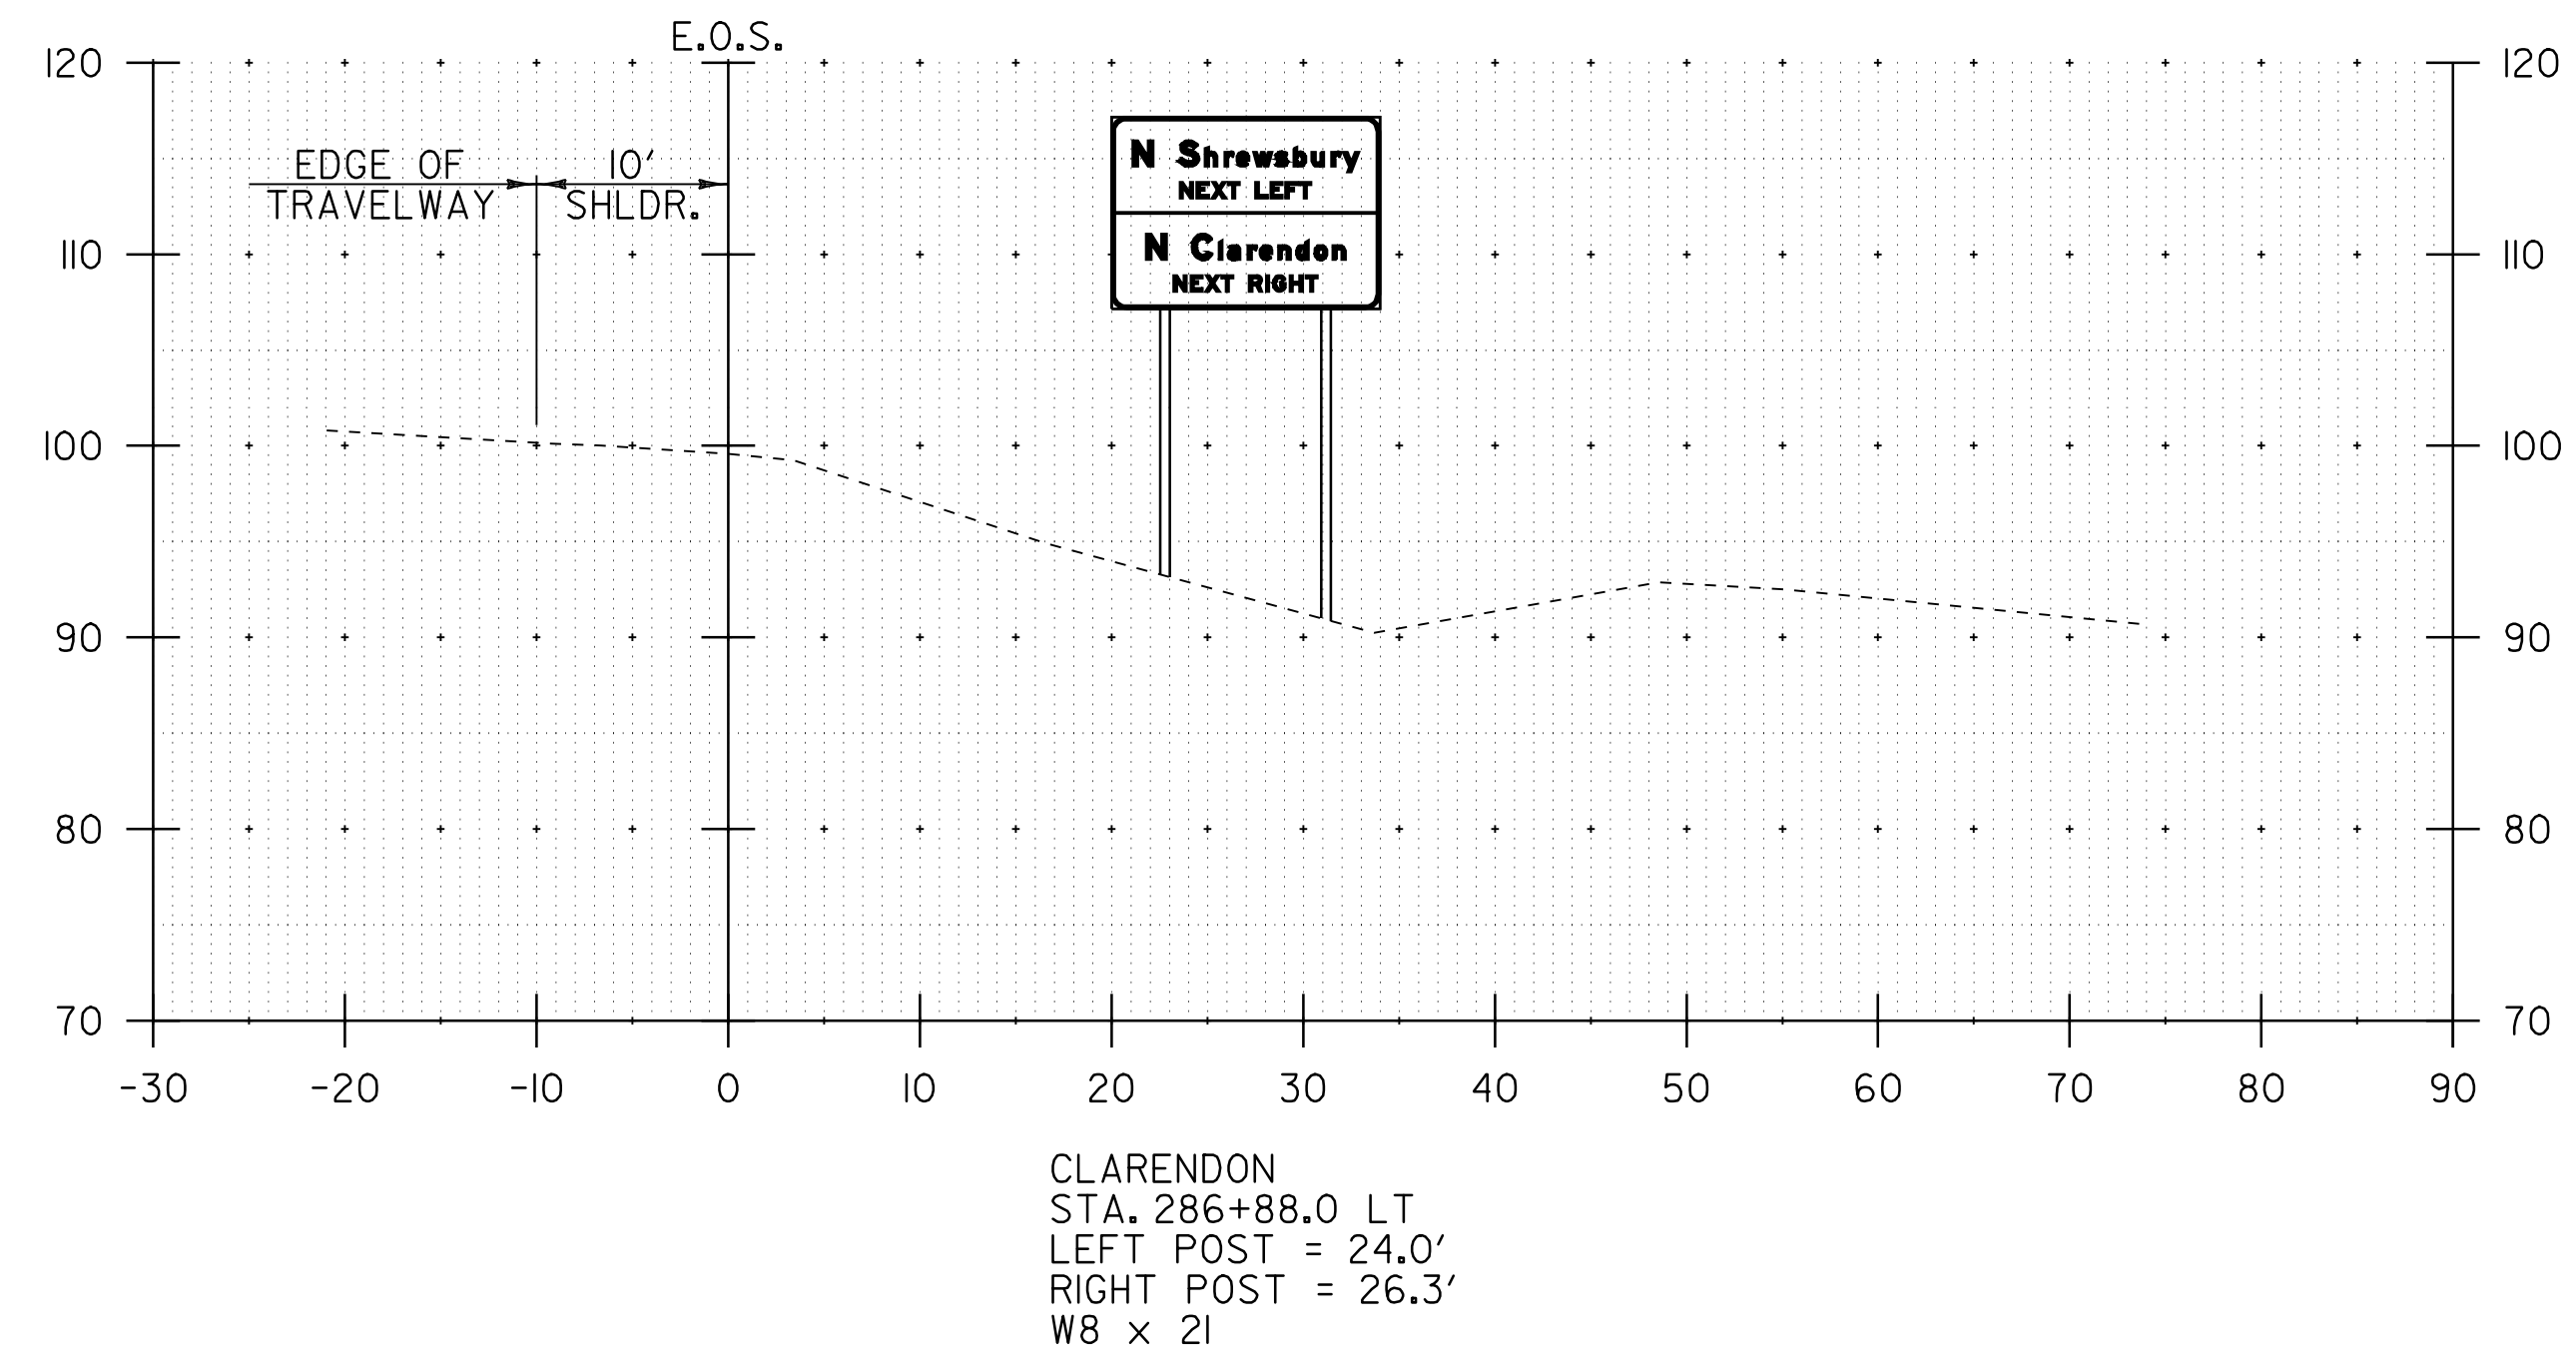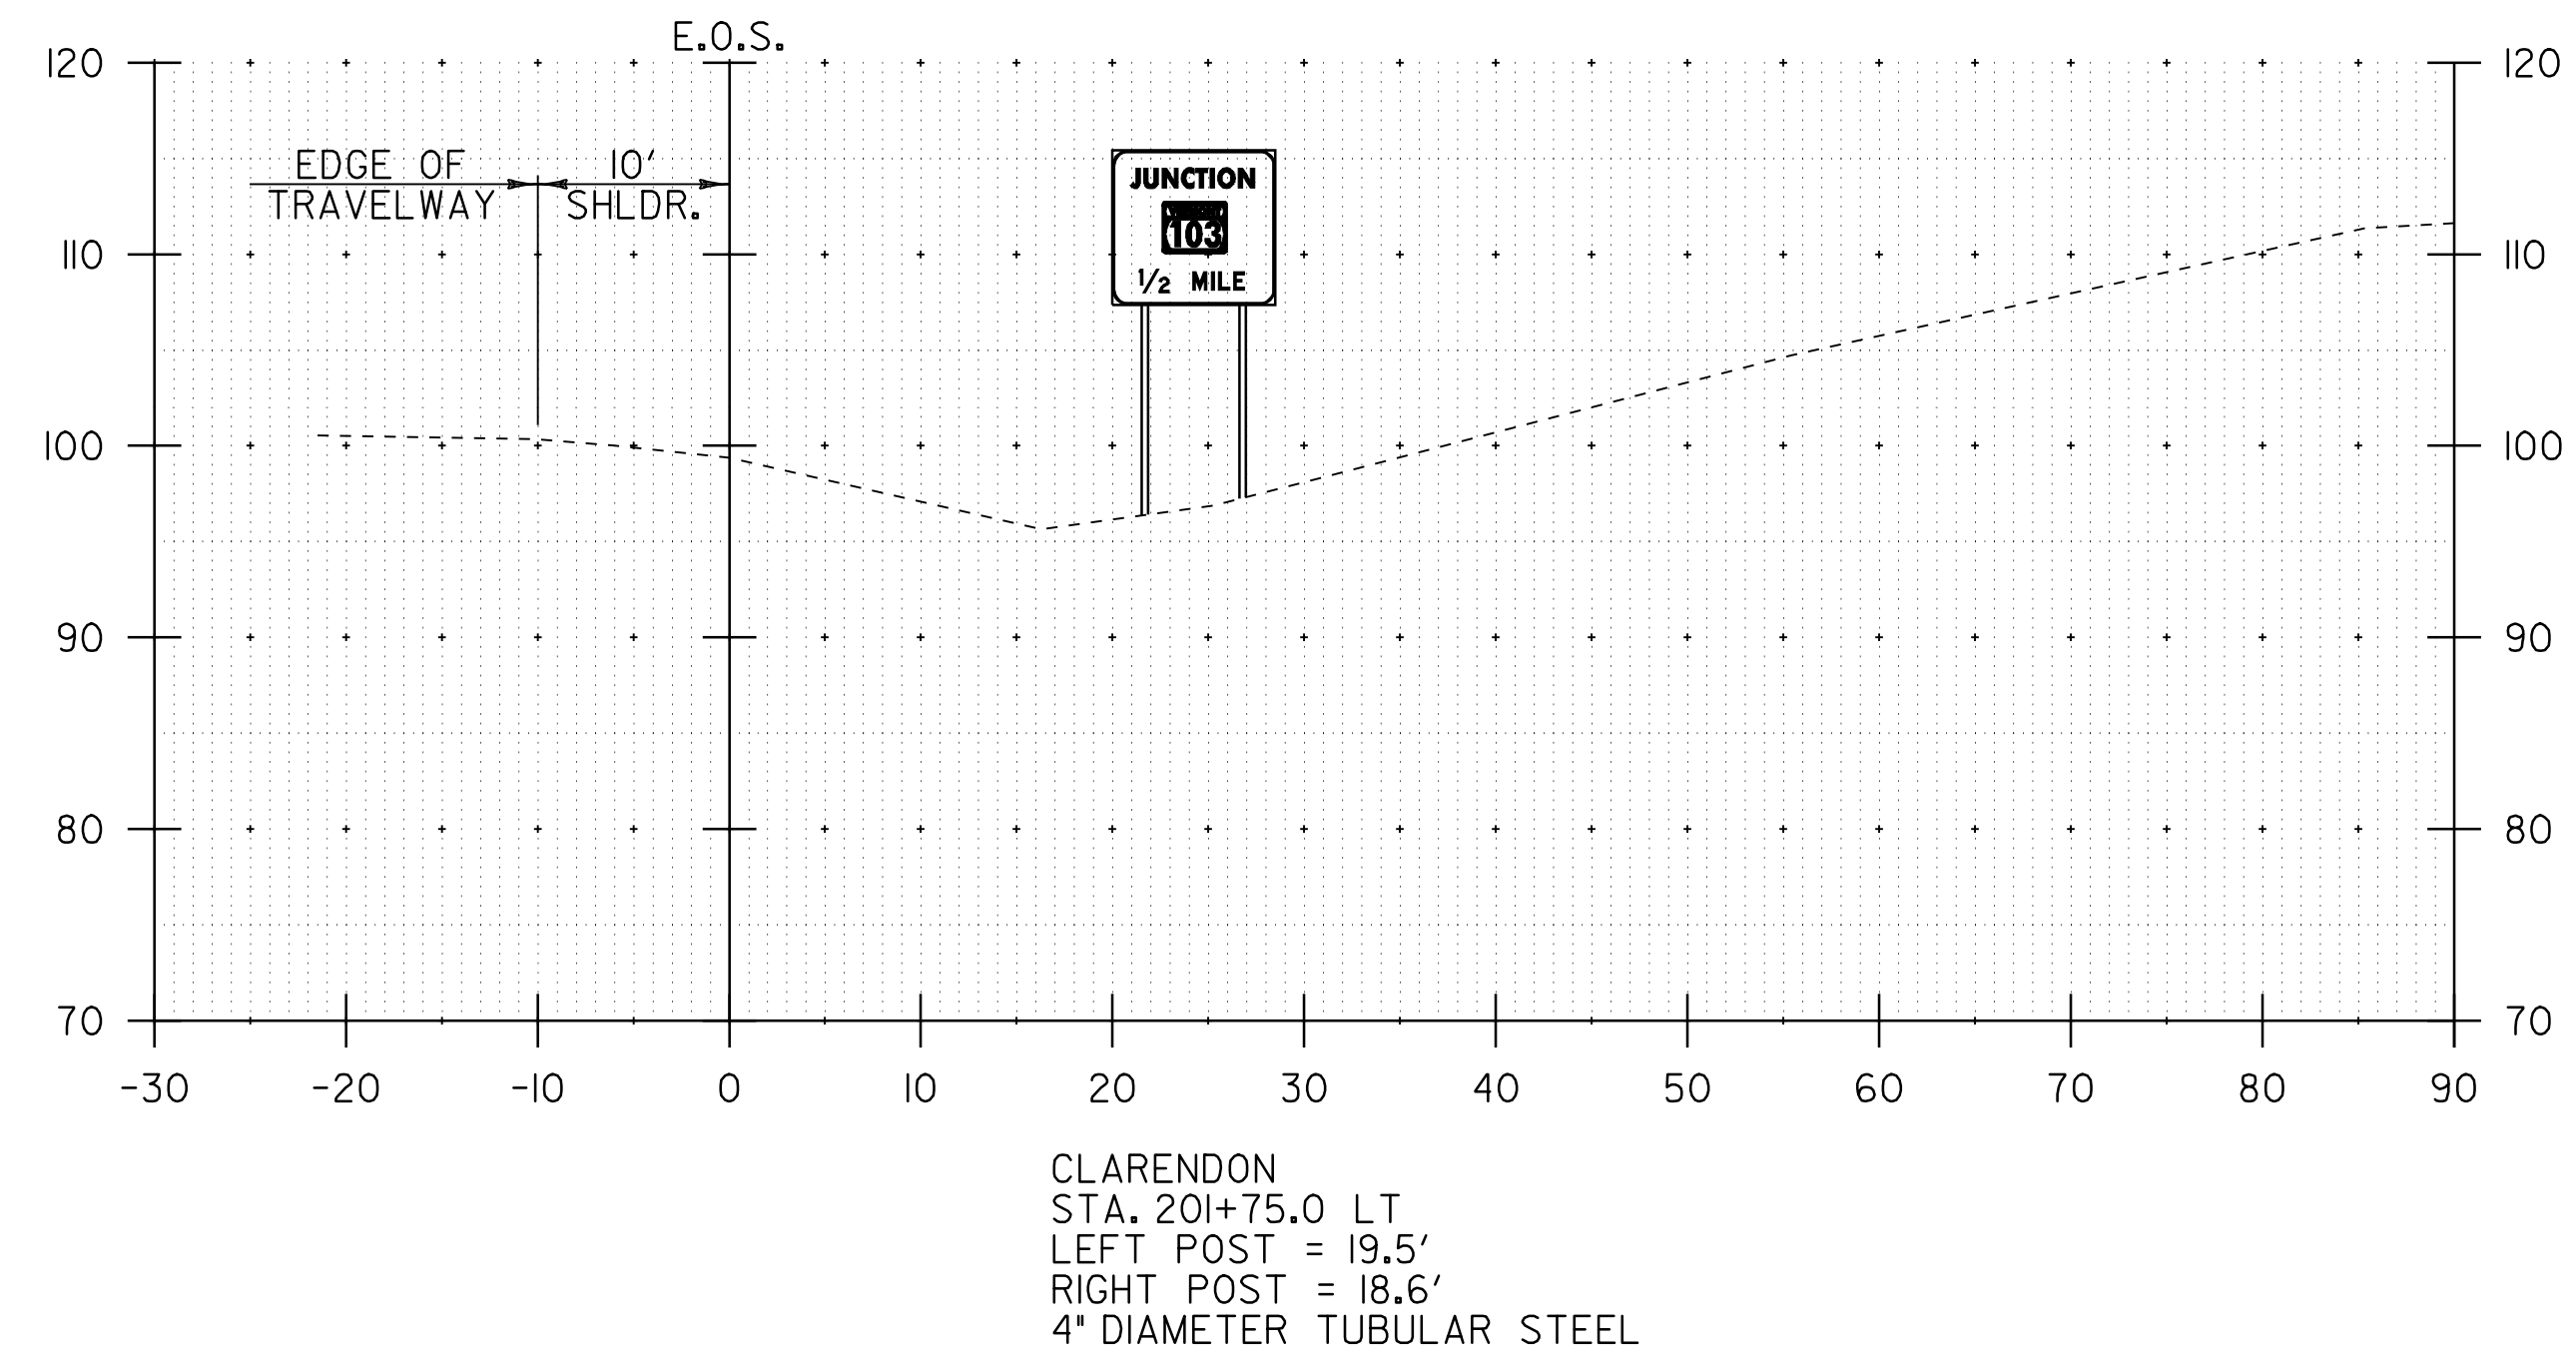
PLOT DATE: \$DATE\$  
DRAWN BY: C.A.K.  
CHECKED BY: D.E.G.  
SHEET 69 OF 80






|                                           |                                          |                     |
|-------------------------------------------|------------------------------------------|---------------------|
| TRAFFIC SIGN<br>CROSS SECTION<br>SHEET #3 | PROJECT NAME: WALLINGFORD - RUTLAND TOWN |                     |
|                                           | PROJECT NUMBER: NH 2408(I)S              |                     |
|                                           | FILE NAME: p04b050.dgn                   | PLOT DATE: \$DATE\$ |
|                                           | PROJECT LEADER: D.E.G.                   | DRAWN BY: C.A.K.    |
|                                           | DESIGNED BY: J.S.P.                      | CHECKED BY: D.E.G.  |
|                                           | FILE NAME: p04b050xsc03.dgn              | SHEET 70 OF 80      |



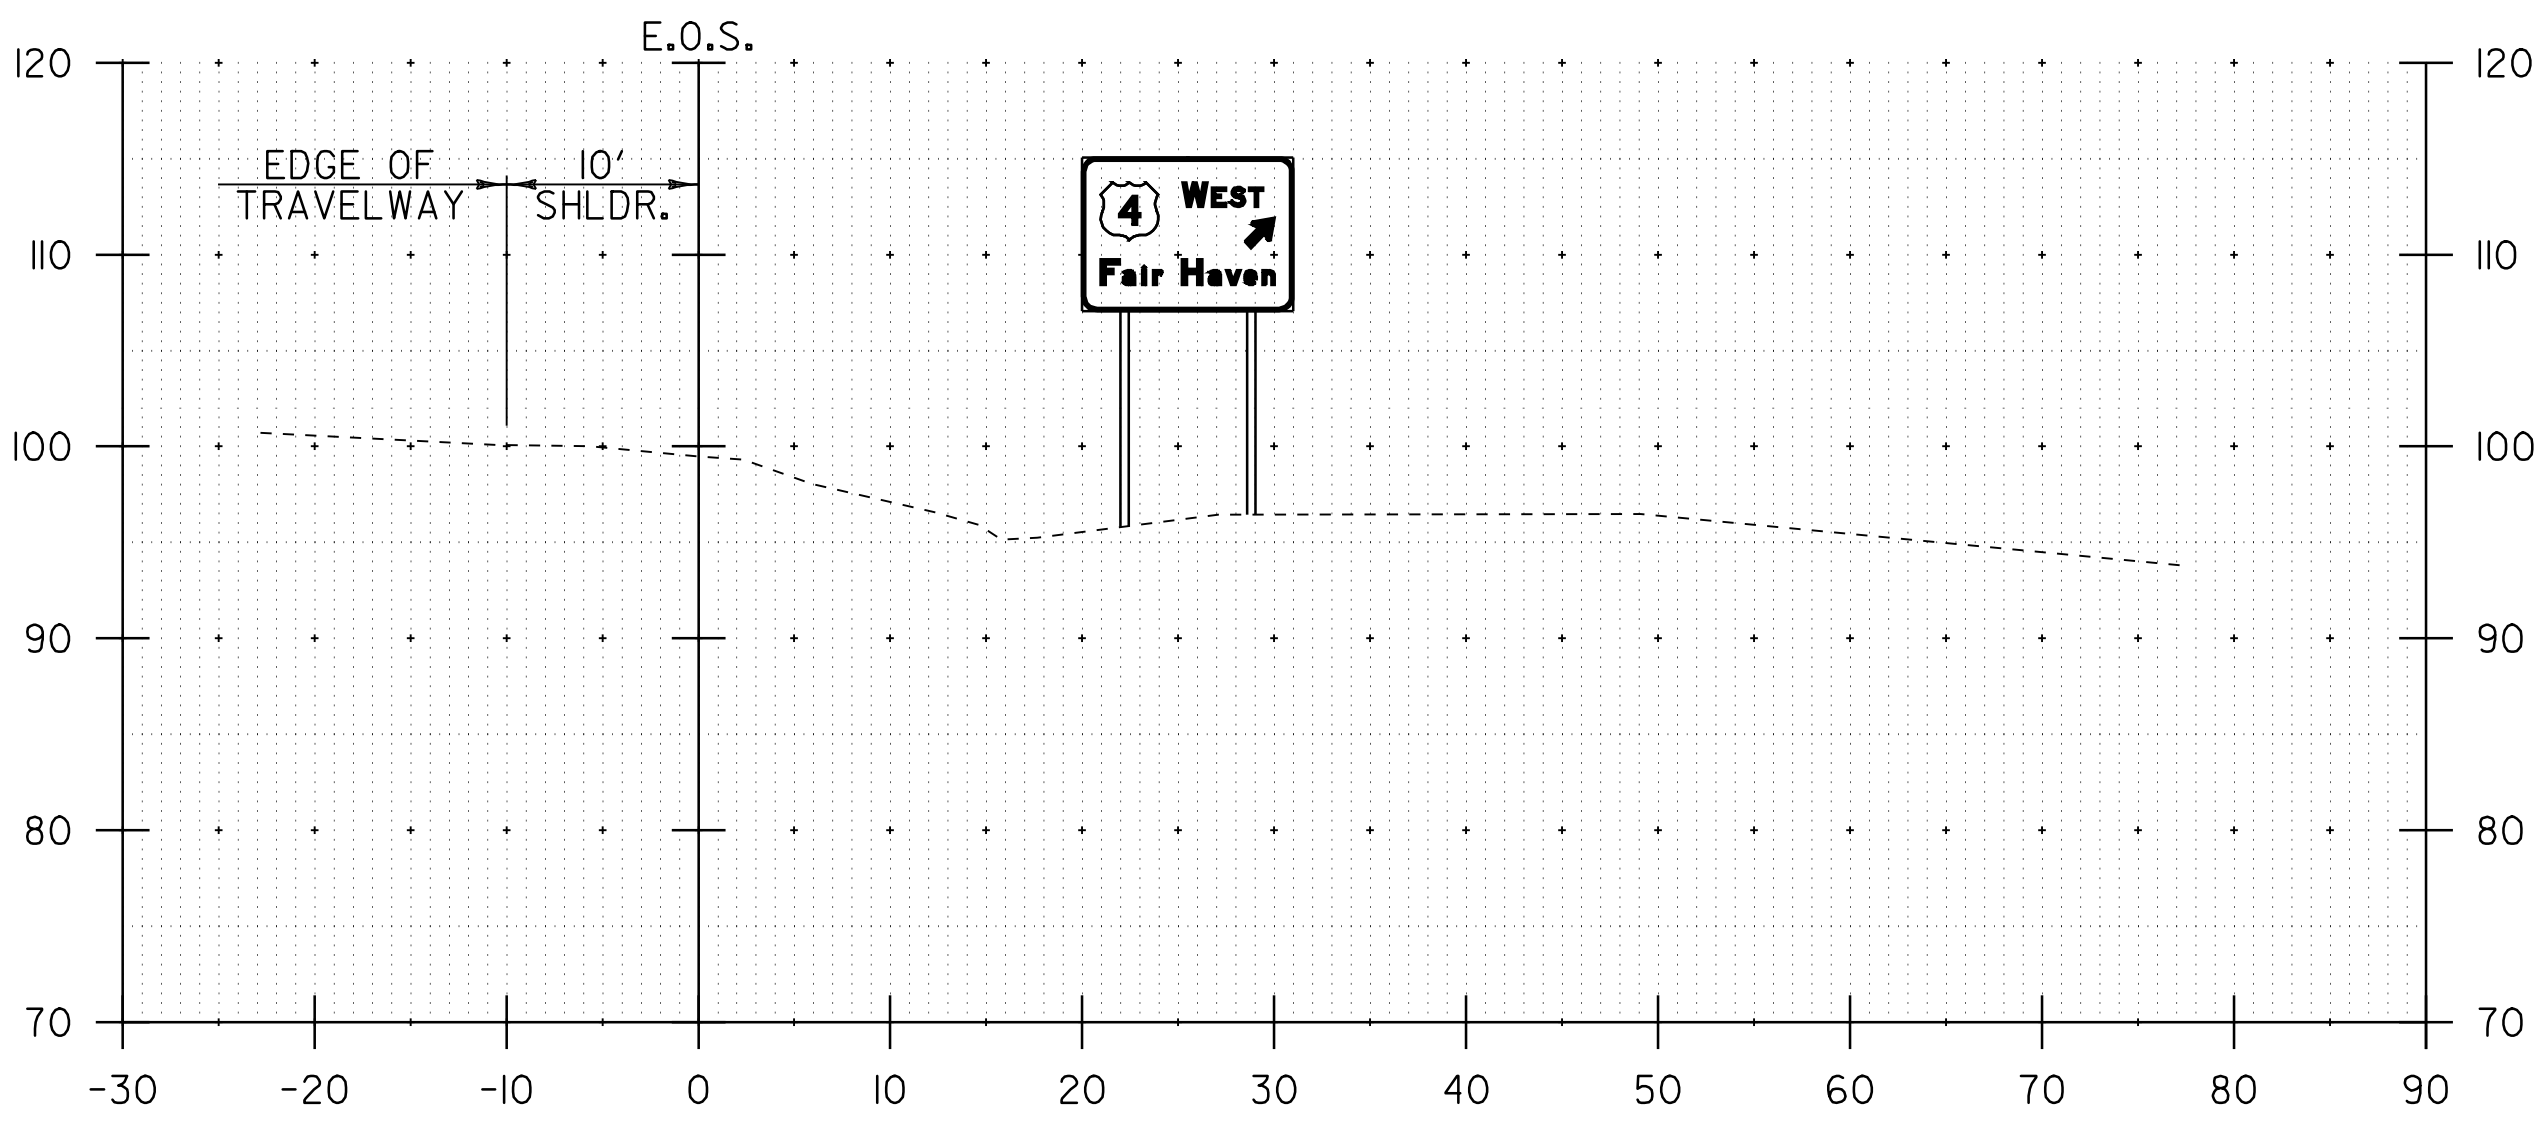

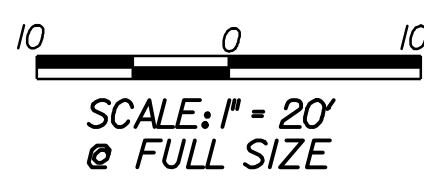RUTLAND TOWN  
STA. 27+22.0 LT  
LEFT POST = 19.3'  
RIGHT POST = 18.7'  
5" DIAMETER TUBULAR STEEL







**TRAFFIC SIGN  
CROSS SECTION  
SHEET #4**


PROJECT NAME: WALLINGFORD - RUTLAND TOWN  
PROJECT NUMBER: NH 2408(I)S

|                             |                     |
|-----------------------------|---------------------|
| FILE NAME: p04b050.dgn      | PLOT DATE: \$DATE\$ |
| PROJECT LEADER: D.E.G.      | DRAWN BY: C.A.K.    |
| DESIGNED BY: J.S.P.         | CHECKED BY: D.E.G.  |
| FILE NAME: p04b050xsc04.dgn | SHEET 71 OF 80      |




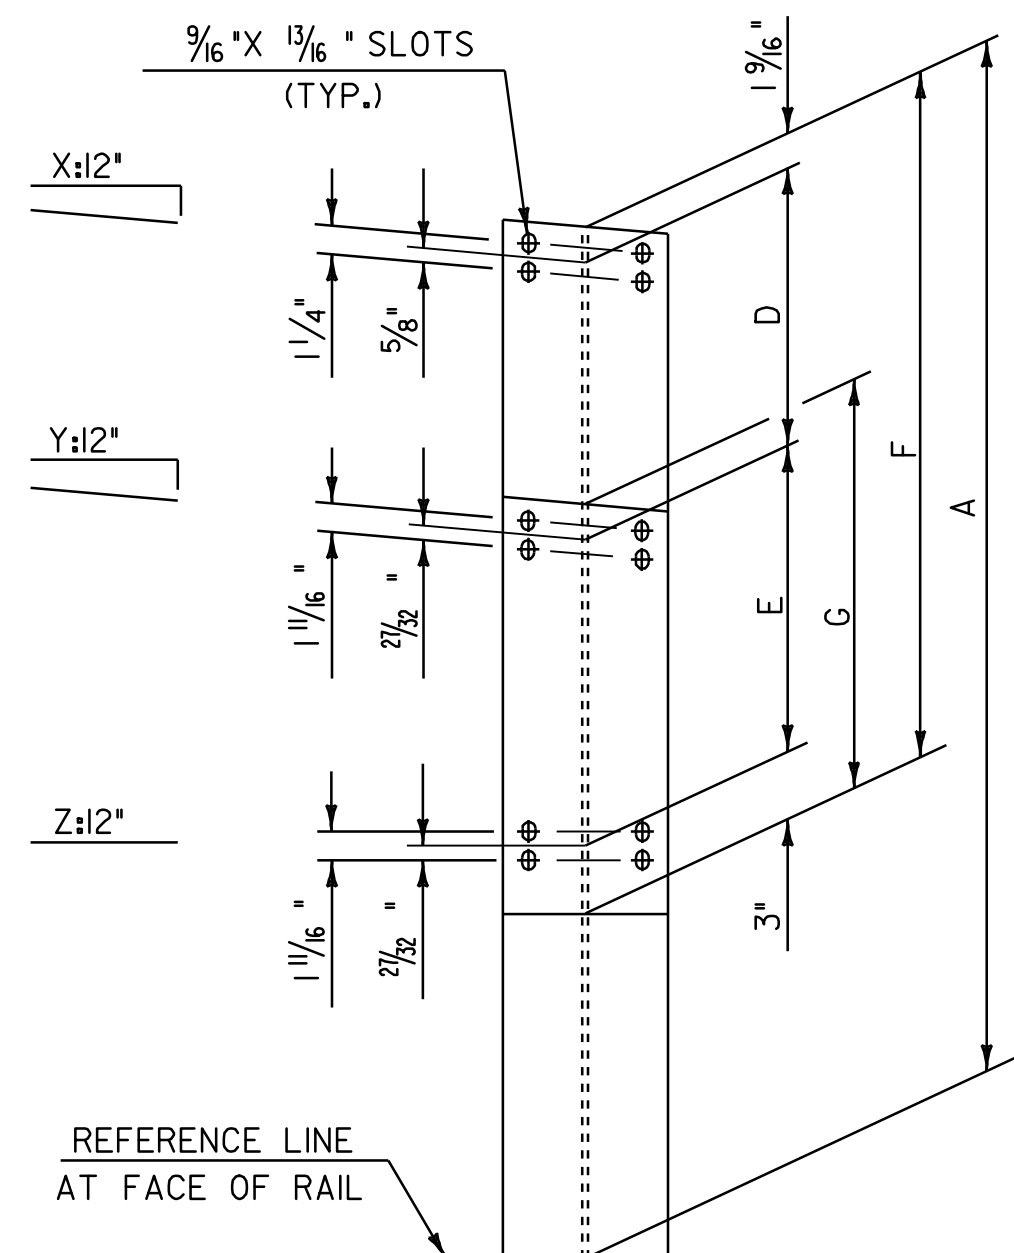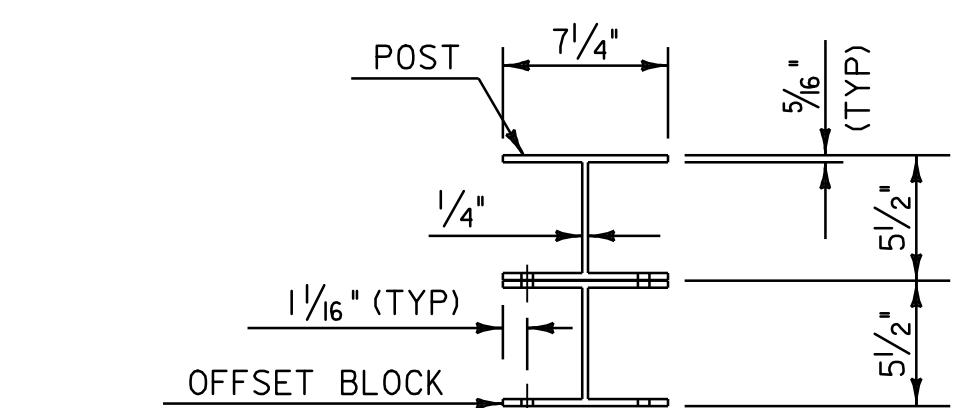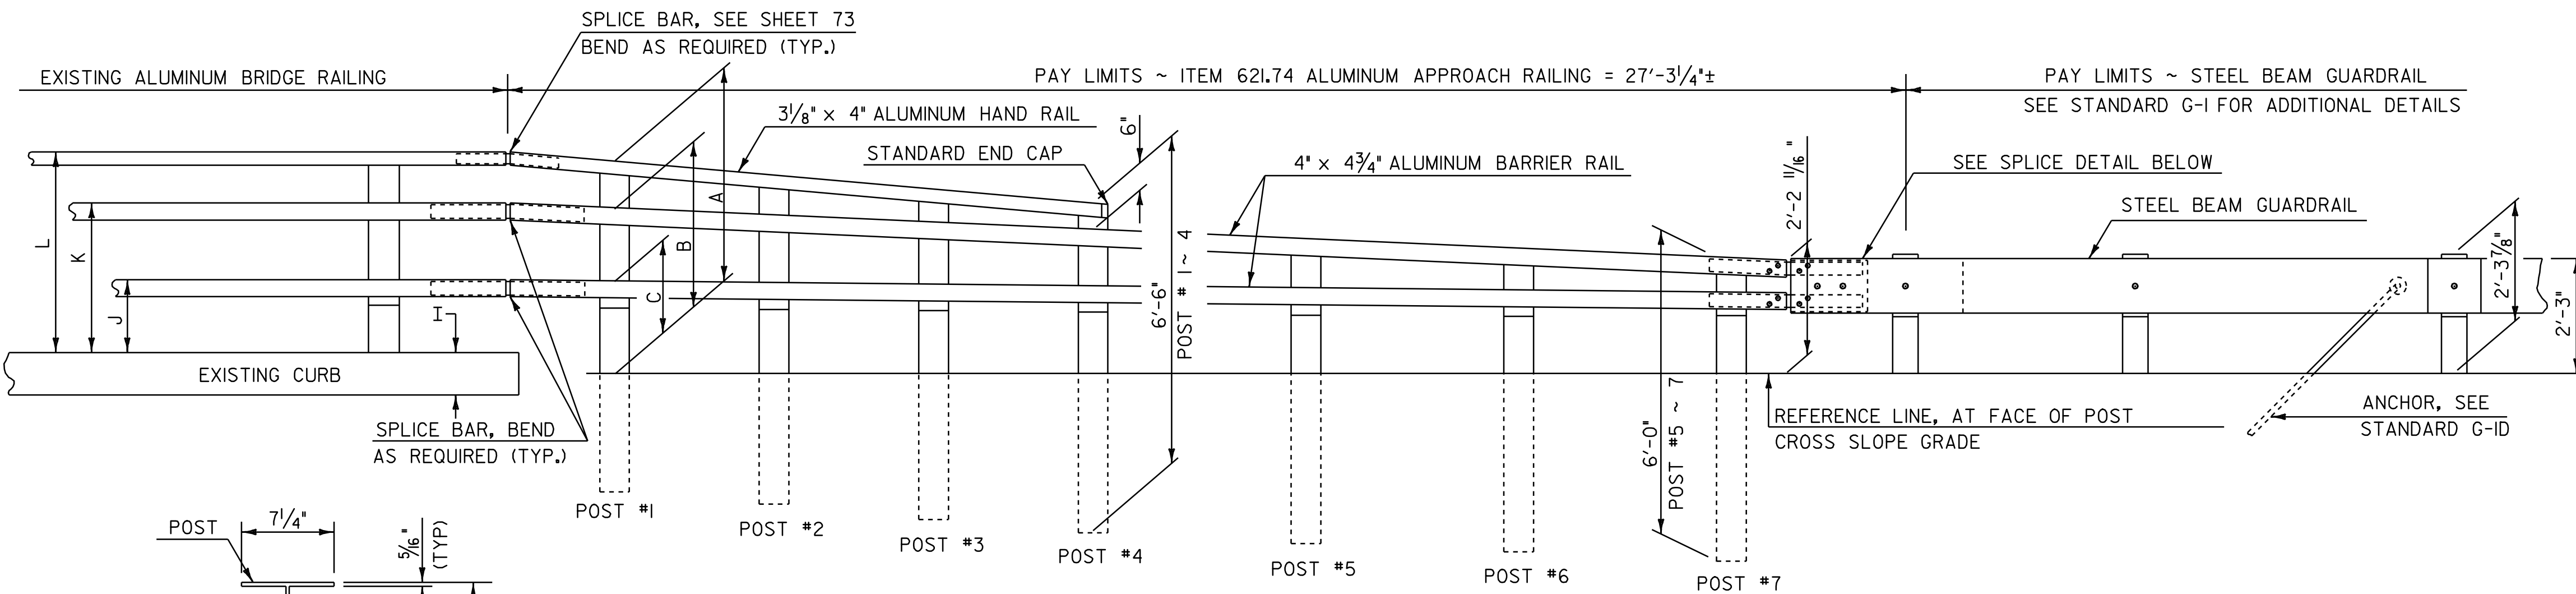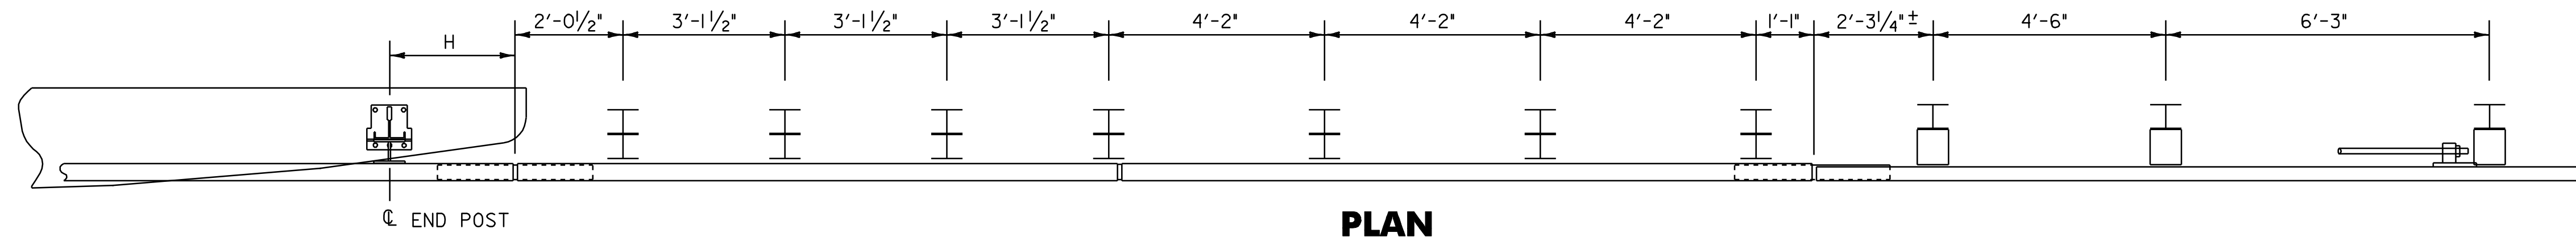

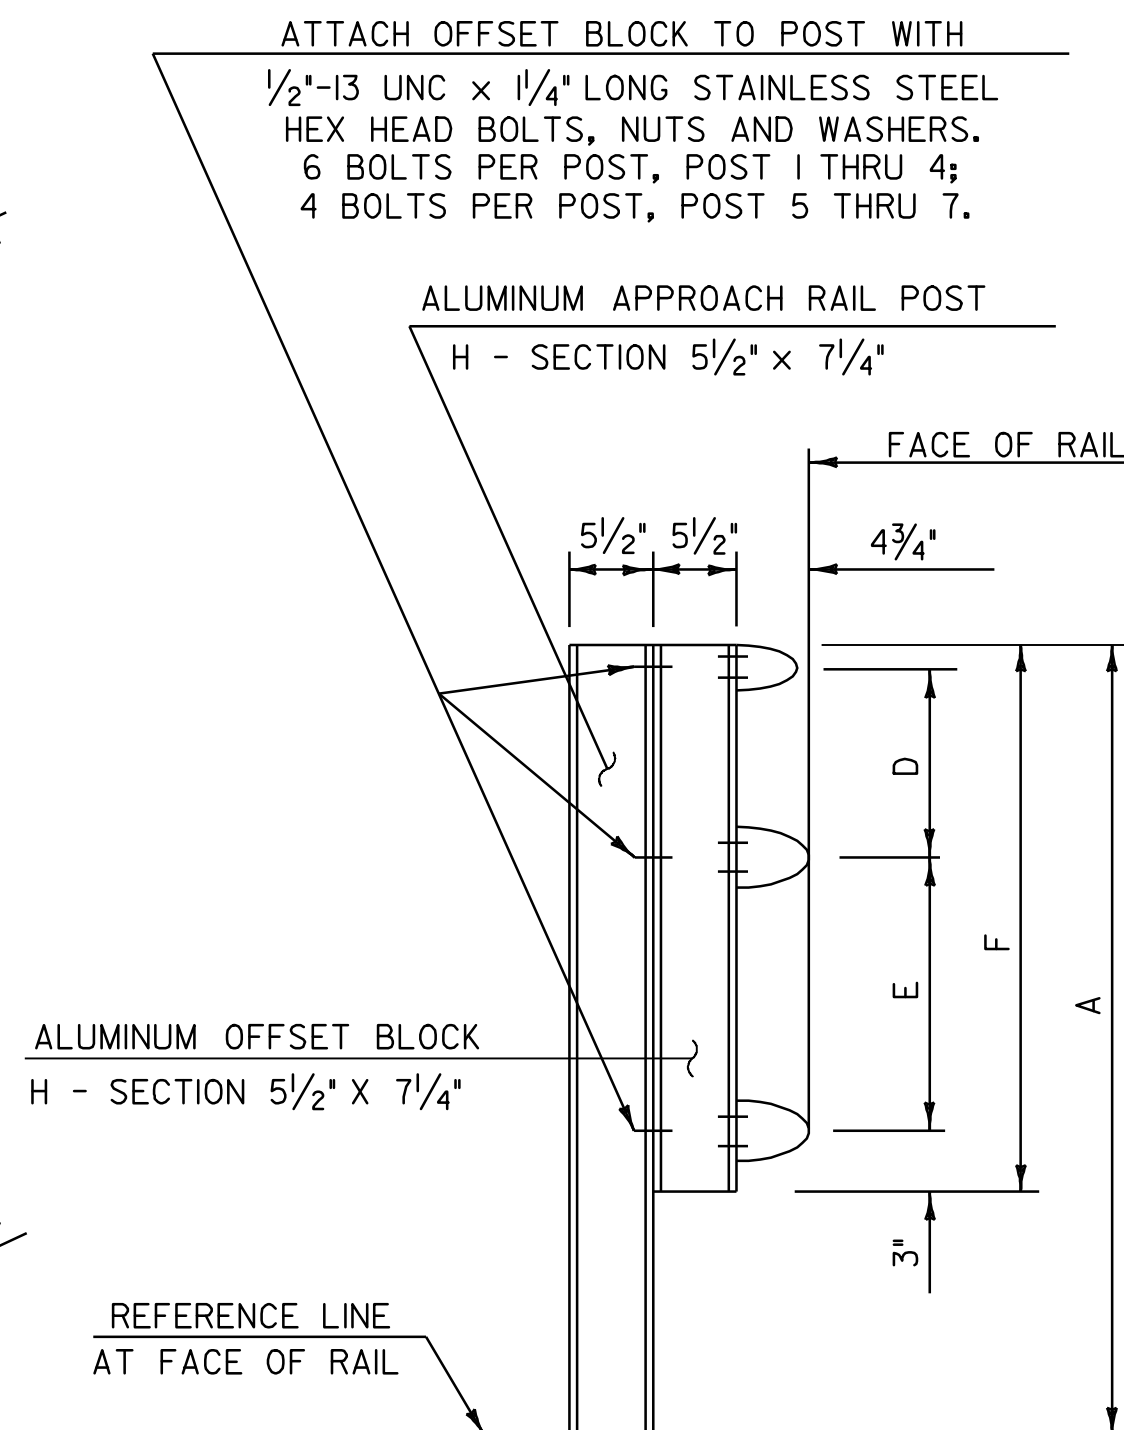
**POST ELEVATION & SECTION**  
(SEE NOTE 7)




**RAIL DETAIL**  
(SEE NOTE 7)

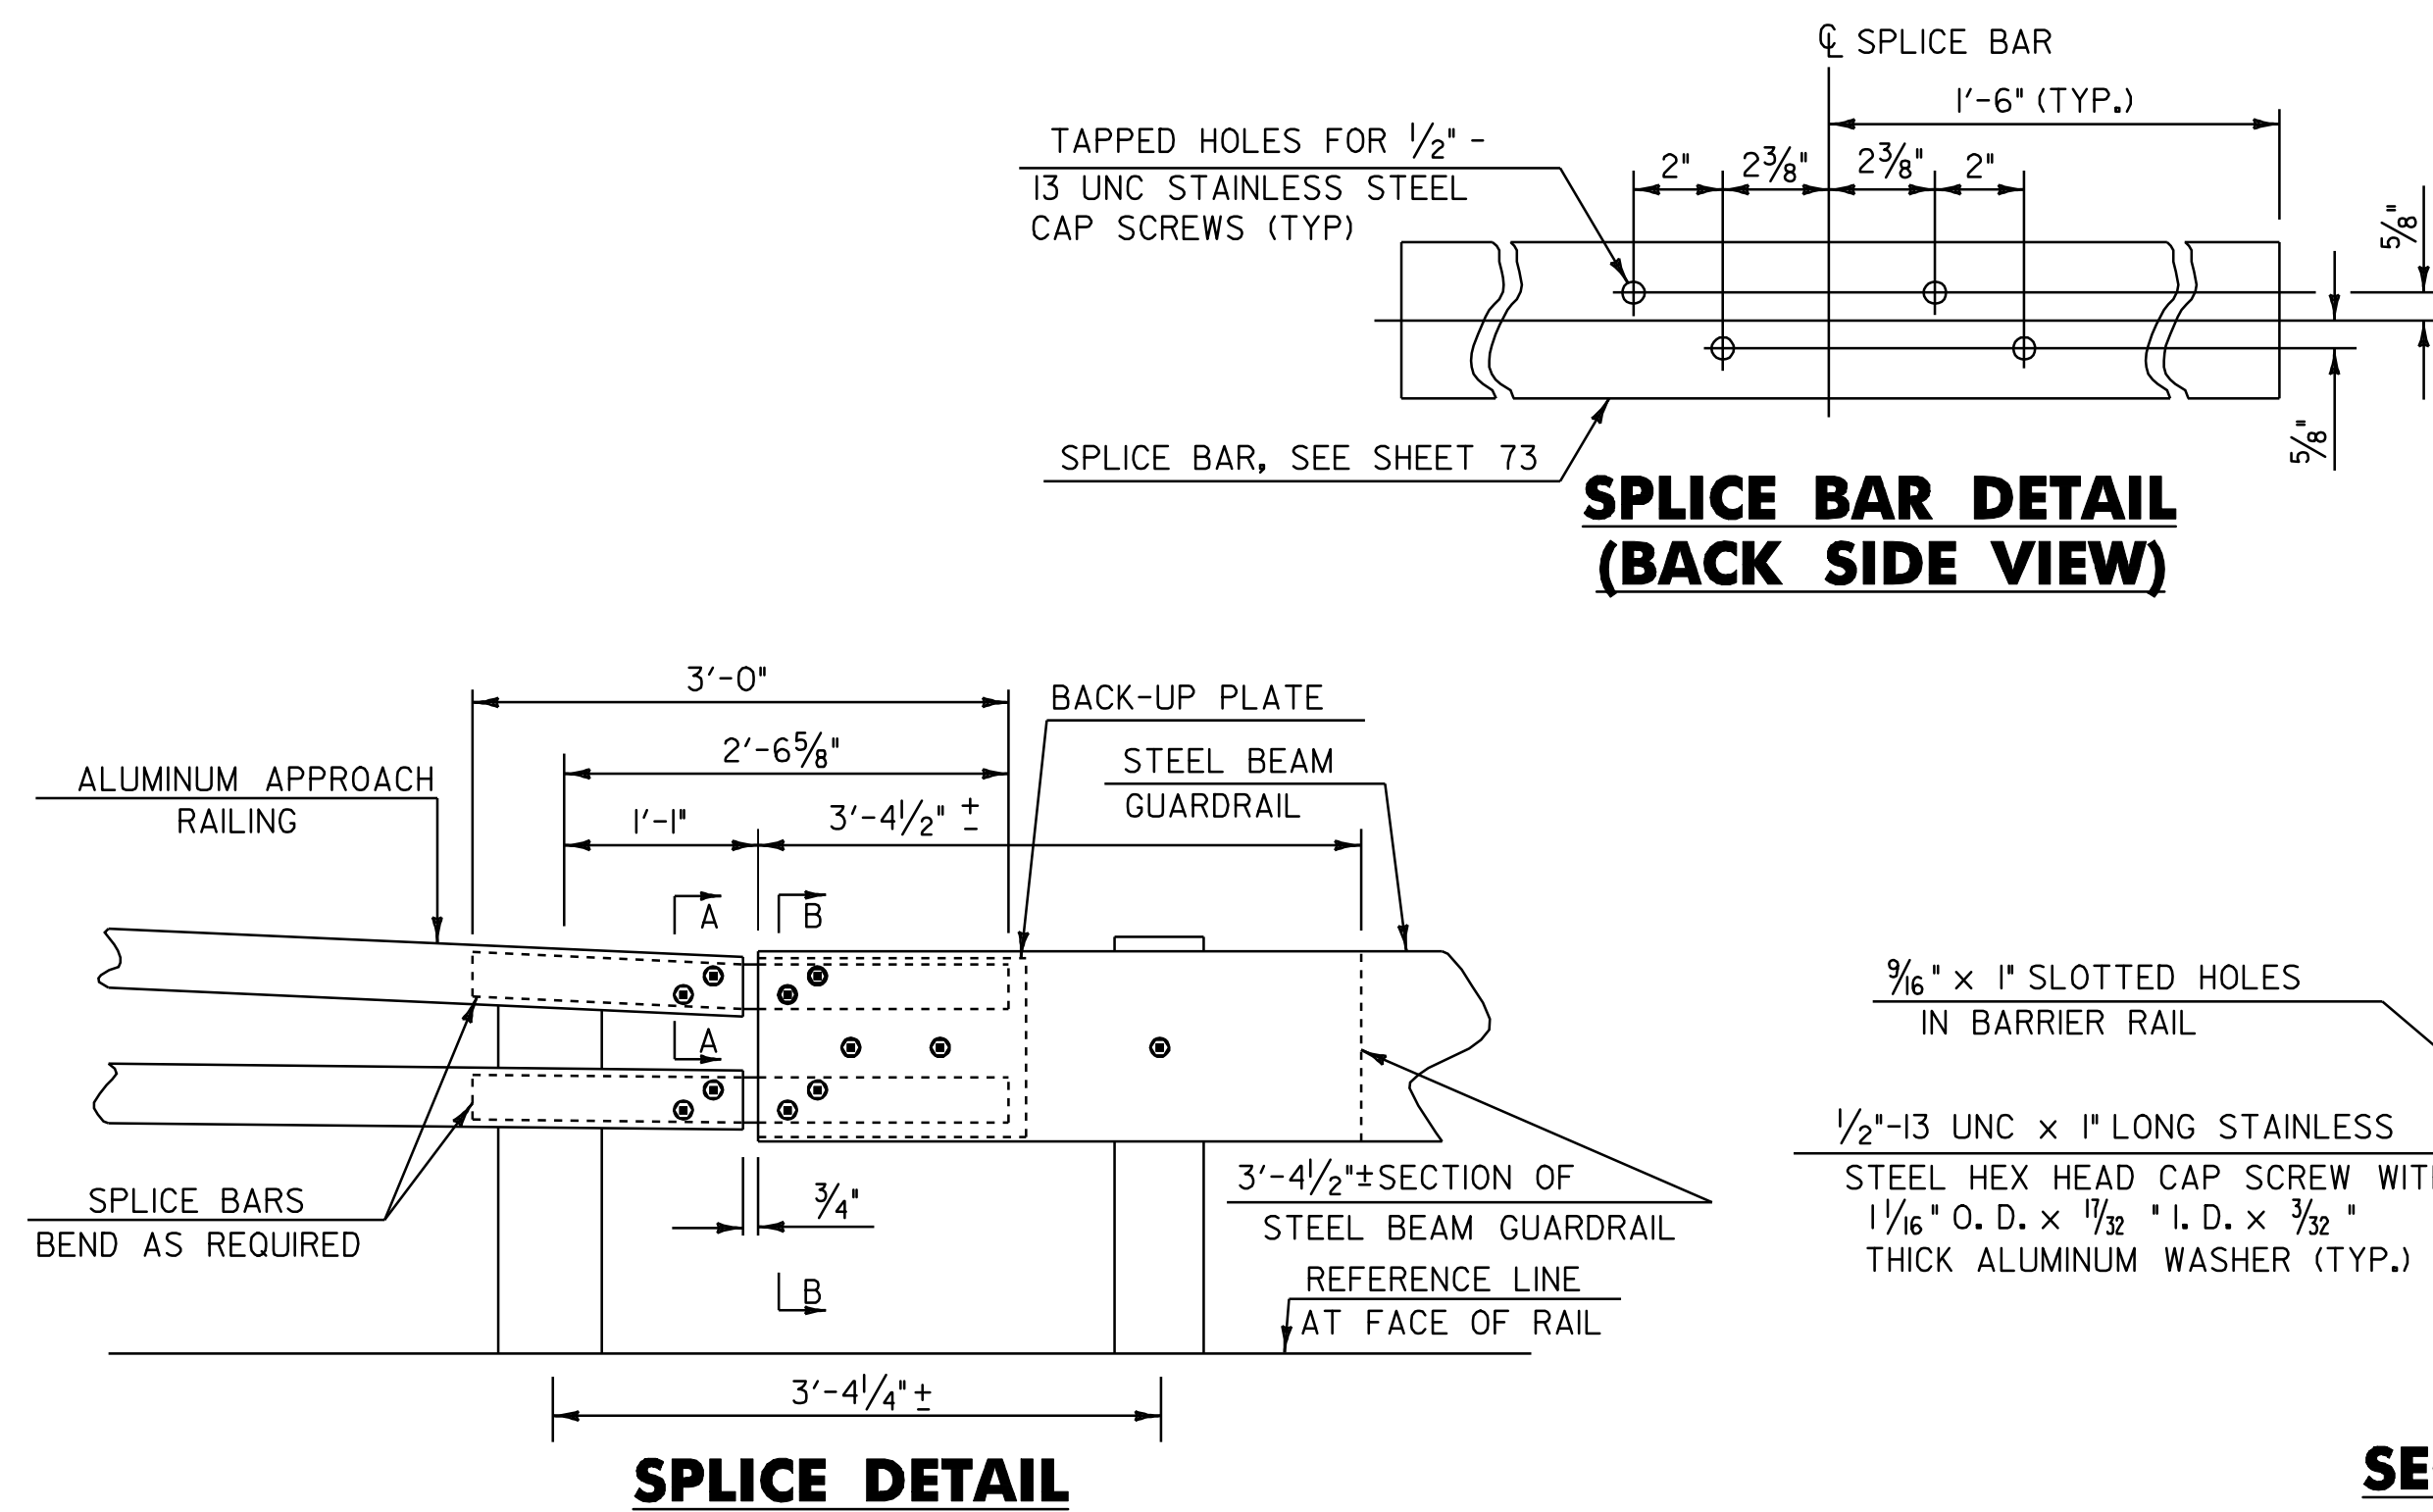


## SPLICE DETAIL

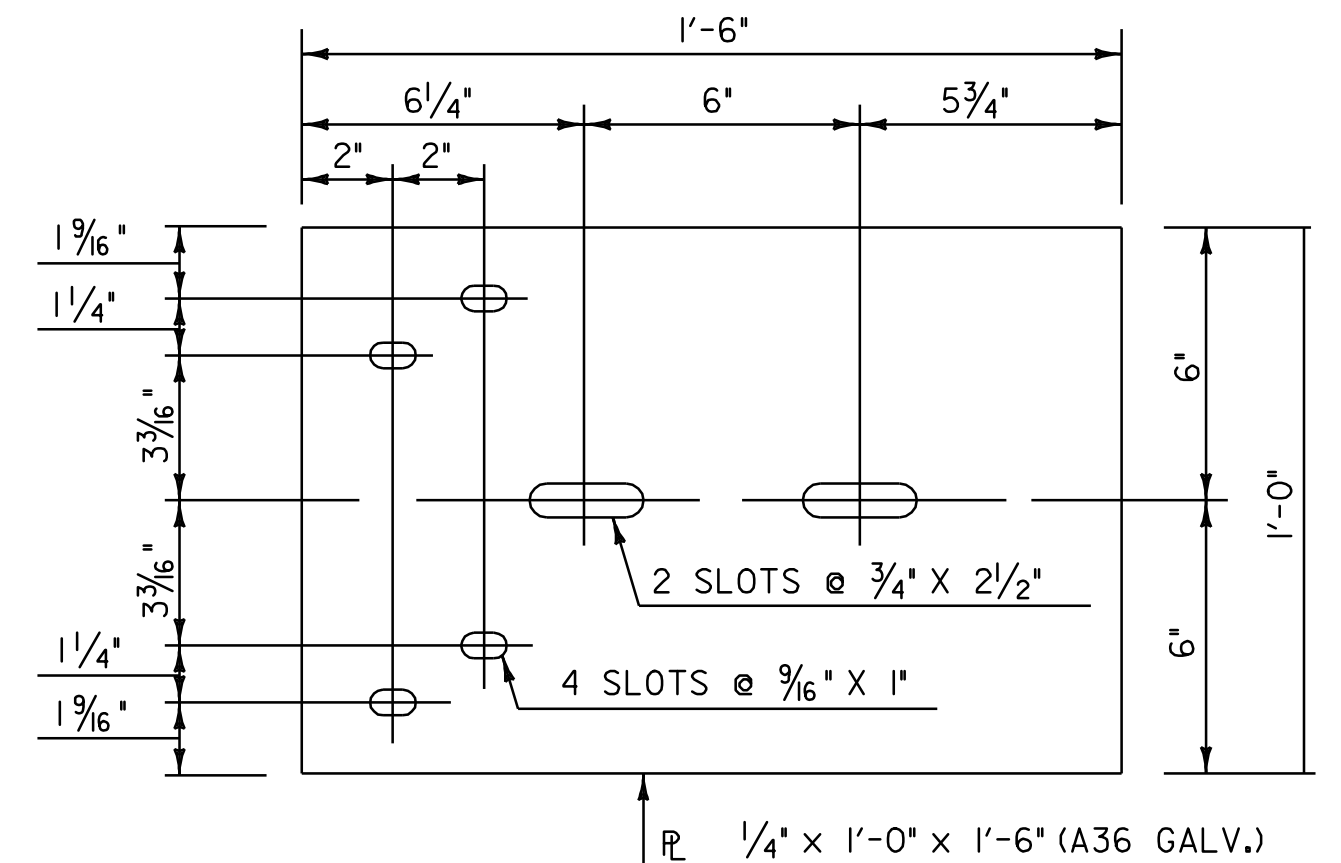


### BACK-UP PLATE DETAIL

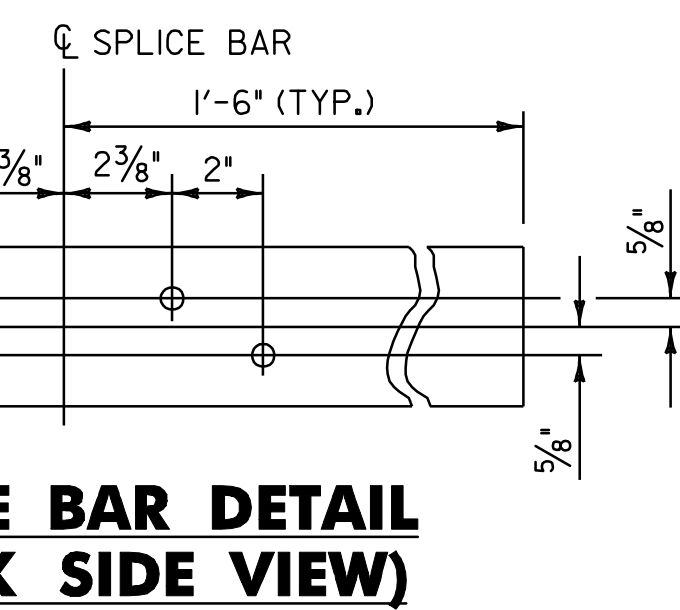

### SPLICE BAR DETAIL (BACK SIDE VIEW)

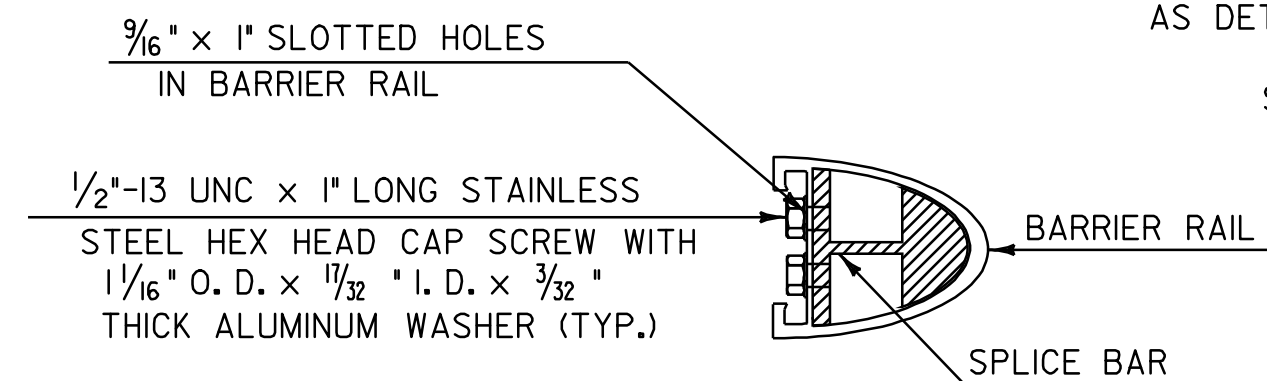

**SECTION A - A**

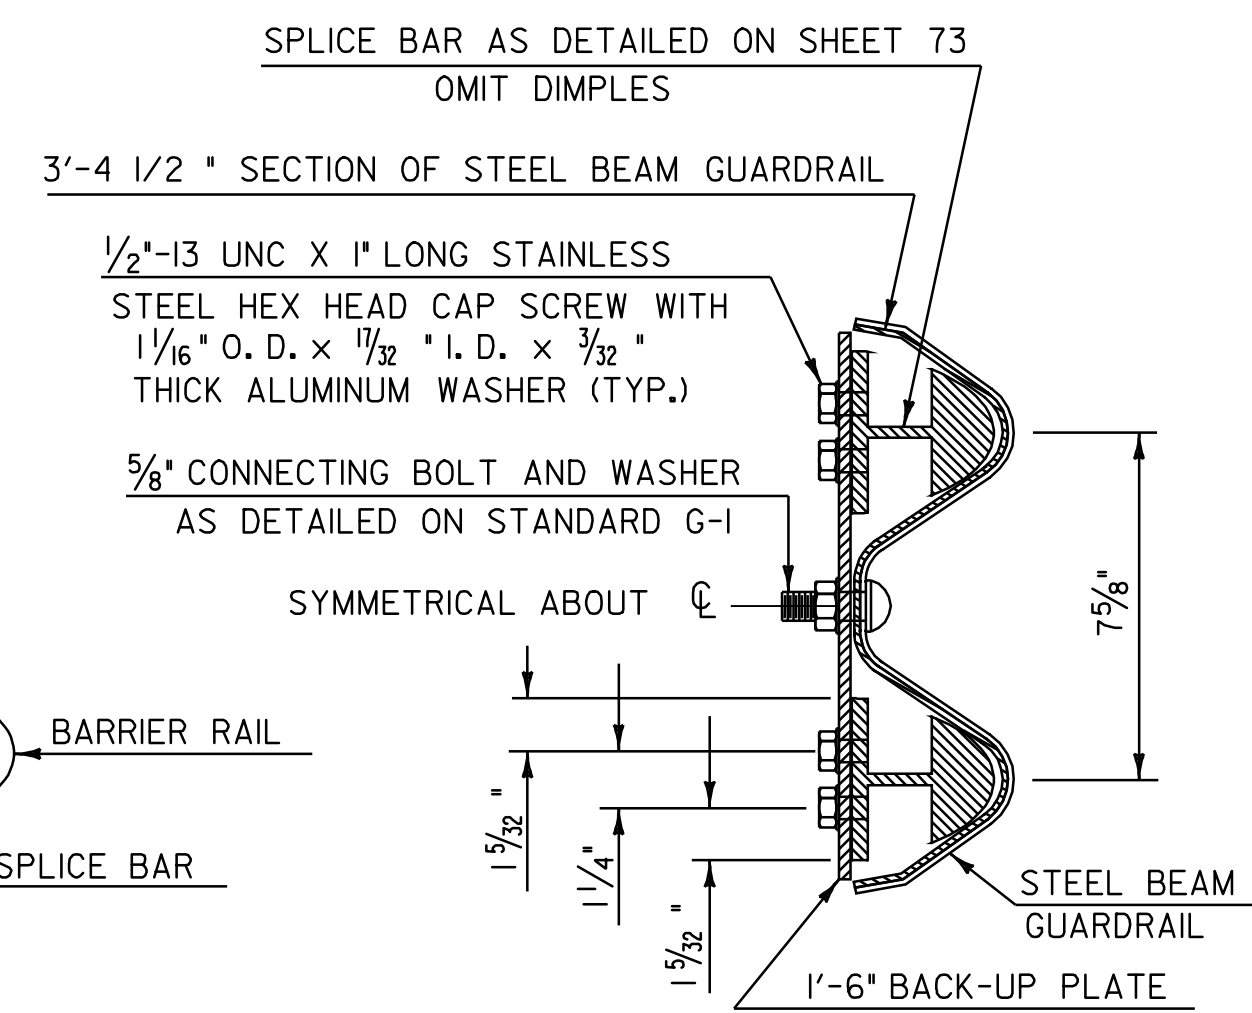

**SECTION B – B**

## NOTES

1. POST 1 THROUGH 7 SHALL BE EXTRUDED ALUMINUM.
2. ALL STRUCTURAL STEEL SHALL BE ASTM A-36 GALVANIZED AFTER FABRICATION.
3. ALL ITEMS NOT OTHERWISE INDICATED SHALL MEET THE SPECIFICATION REQUIREMENTS OF THE STANDARD SHEETS ON WHICH THEY ARE DETAILED.
4. SEE STANDARD G-1 FOR STEEL BEAM GUARDRAIL DETAILS.
5. THE COST OF ALL MATERIALS AND LABOR FOR THE SPLICE BETWEEN THE ALUMINUM APPROACH RAILING AND THE STEEL BEAM GUARDRAIL SHALL BE INCIDENTAL TO ITEM 621.74 ALUMINUM APPROACH RAILING.
6. DIMENSIONS SHOWN ARE FROM A REFERENCE LINE AT THE FACE OF POST FOR A NORMAL CROWNED SECTION. APPROPRIATE CORRECTIONS SHALL BE MADE FOR CROSS SLOPES OTHER THAN A NORMAL SECTION.
7. SEE SHEET 74 FOR ALUMINUM APPROACH RAILING DIMENSIONS TABLE.

# ALUMINUM APPROACH RAILING SHEET #1

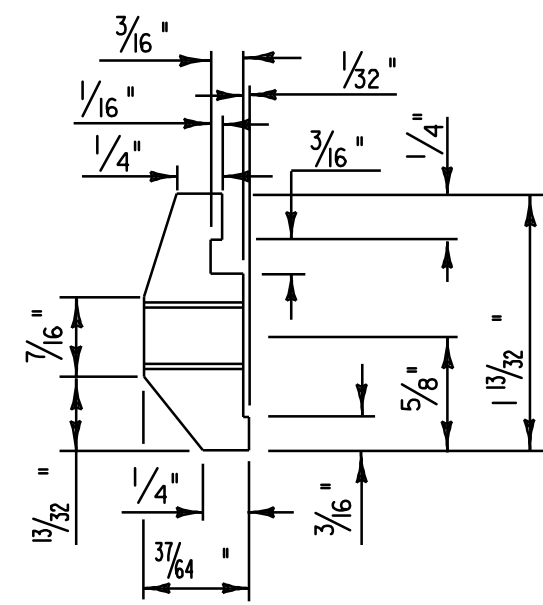
PROJECT NAME: WALLINGFORD - RUTLAND TOWN  
PROJECT NUMBER: NH 2408(I)S

FILE NAME: p04b050.dgn  
PROJECT LEADER: D.E.G.  
DESIGNED BY: J.S.P.  
IPARM FILE: p04b050aarl.i


PLOT DATE: \$DATE\$  
DRAWN BY: C.A.K.  
CHECKED BY: D.E.G.  
SHEET 72 OF 80




POST CONNECTION  
HAND RAIL SECTION




POST CONNECTION  
ELEVATION

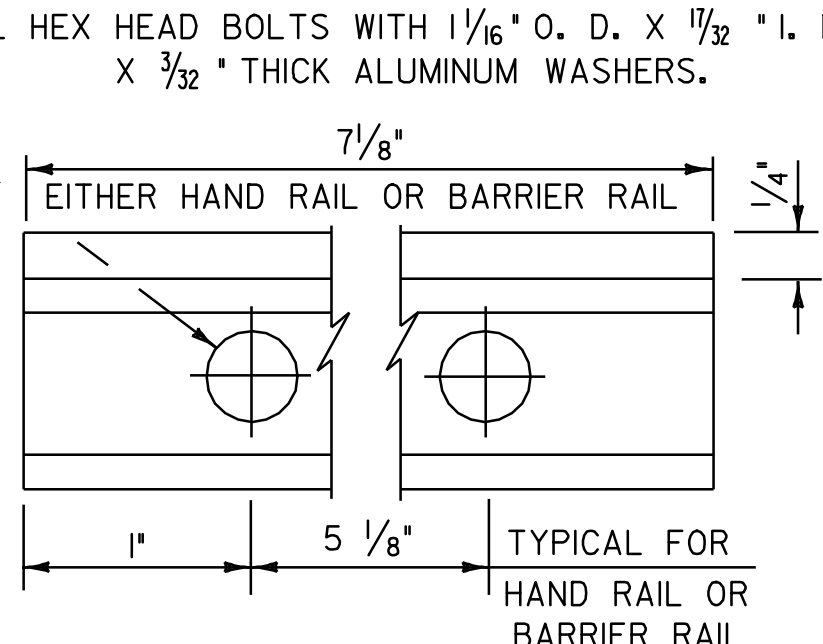


POST CONNECTION  
BARRIER RAIL SECTION

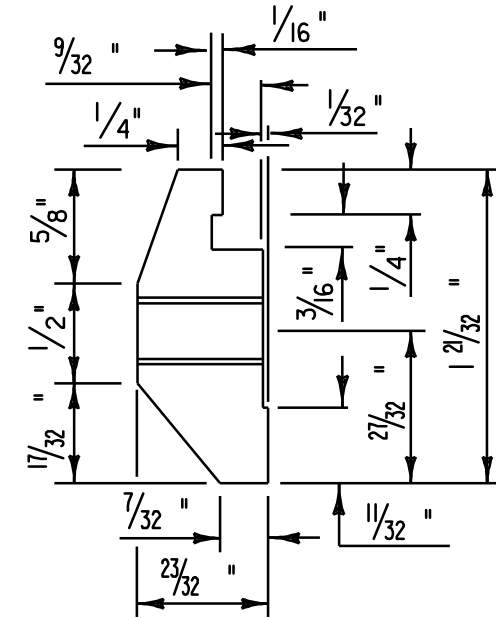

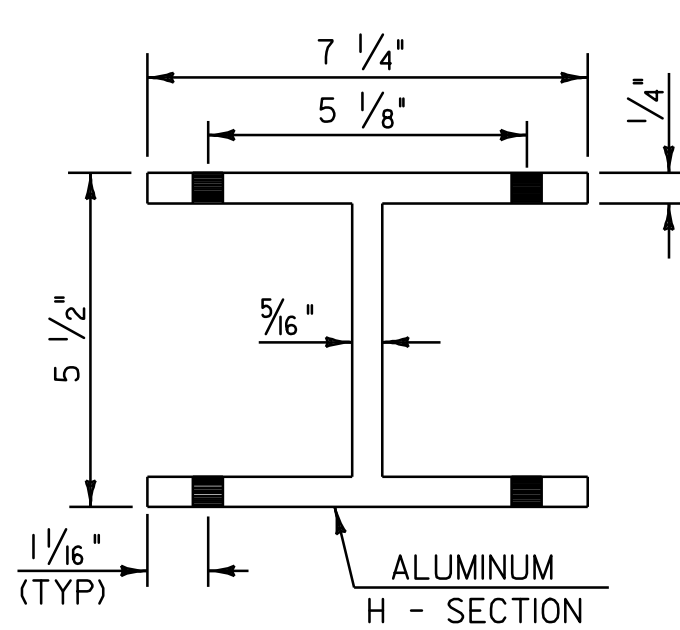PLAN VIEW OF  
OFFSET BLOCK  
(TO BE USED ON  
SUPERSTRUCTURE  
ON CURB SIDE)




POST BASE  
PLAN

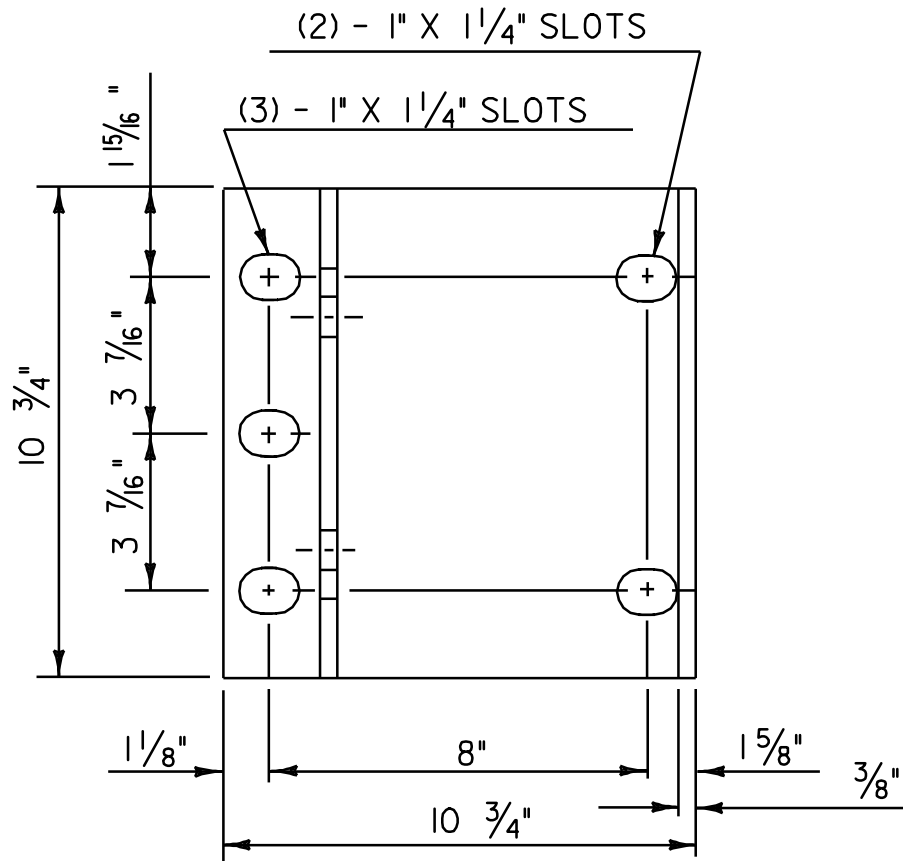


NOTES

- ANCHOR BOLTS, WASHERS AND HEAVY HEX NUTS MAY BE ANY OF THE FOLLOWING:
  - ASTM A449 GALVANIZED, OR
  - AASHTO M164 (ASTM A325) GALVANIZED
  - BOLTS AND WASHERS OF STAINLESS STEEL ASTM A276, TYPE 304 (MINIMUM ULTIMATE STRENGTH OF 100,000 PSI) WITH STAINLESS STEEL NUTS OF ASTM A194, GRADE 8NA.
- ALUMINUM POSTS, POST BASES, SPLICE BARS, CONNECTION BARS, RAILS AND BALUSTER FRAMES SHALL CONFORM TO ASTM B221  
  
 $F_y = 35,000 \text{ PSI}$
- ALUMINUM BALUSTER TUBES SHALL CONFORM TO ASTM B210 ALLOY 6061-T5 OR 6063-T5.
- ALUMINUM RAIL END CAPS SHALL CONFORM TO ASTM B26 ALLOY 356-T6.
- THE POST, RAIL, AND OFFSET BLOCK CONNECTION BOLTS SHALL BE EITHER ASTM A193 OR ASTM A320. EITHER ONE SHALL BE CLASS 1, B8 GRADE AISI 304 WITH AN ULTIMATE TENSILE STRENGTH OF 75,000 PSI. NUTS FOR EITHER OF THE ABOVE BOLTS SHALL BE ASTM A194, GRADE 8, STAINLESS STEEL WITH AN ULTIMATE TENSILE STRENGTH OF 75,000 PSI.
- SET SCREWS FOR ATTACHING BALUSTERS TO RAILING SHALL BE ASTM F880, TYPE 303 MATERIAL.
- RIVETS SHALL BE COLD DRIVEN HIGH BUTTON HEAD "CONE POINT", CONFORMING TO ASTM B316 ALLOY 6061-T6.
- THE ANCHOR PLATE FOR THE POST ANCHOR ASSEMBLY SHALL BE ASTM A36 STRUCTURAL STEEL.
- WELDING SHALL CONFORM TO THE REQUIREMENTS OF SUBSECTION 506.10 USING THE GMAW-INERT GAS PROCESS AND AWS ER 5356 ELECTRODE WIRE.
- UNLESS OTHERWISE SPECIFIED, ANCHOR BOLTS SHALL BE CAST INTO THE CONCRETE AS DETAILED.
- WHENEVER FEASIBLE BARRIER RAIL AND HAND RAIL SECTIONS, SHALL BE FULL LENGTH SECTIONS (40' + ) AND WHEN POSSIBLE SHALL BE ATTACHED TO THREE POSTS. RAILS SHALL BE SPLICED AT EACH DECK JOINT AND INTERMITTENTLY AS REQUIRED. SPLICES SHALL OCCUR WITHIN THE SAME PANEL.
- ENDS OF RAILS SHALL BE CUT SQUARE AND GROUND FREE OF BURRS OR RAGGED EDGES. EXPOSED ENDS SHALL BE CAPPED.
- THE CONCRETE CONTACT SURFACE AT THE POST BASE SHALL BE BUSH HAMMERED AND/OR SHIMMED AS REQUIRED FOR PROPER POST ALIGNMENT. POST HEIGHT ADJUSTMENTS LESS THAN 1/4" SHALL BE WITH 1/16" AND 1/8" SHIMS. CORRECTIONS EXCEEDING 1/4" SHALL BE WITH EPOXY MORTAR CONFORMING WITH SECTION 530. FABRIC BEARING PADS AND ANY REQUIRED SHIMS OR EPOXY MORTAR ARE INCIDENTAL TO THE UNIT PRICE BID FOR THE RAILING.
- SHIMS AND 1/8" FABRIC BEARING PADS SHALL BE 10 3/4" SQUARE WITH SLOTTED HOLES SIZED AND LOCATED THE SAME AS THE POST BASE DETAIL. FABRIC BEARING PADS SHALL CONFORM TO SUBSECTION 731.01 OR 731.02, SHIM MATERIAL SHALL BE ASTM B 209 ALLOY 100-0.
- EXTRUDED SECTIONS ARE DETAILED TO COMPLY WITH CURRENT AASHTO-AGC-ARTBA STANDARDS. MINOR VARIATIONS OF THE DETAILS SHOWN MAY BE CONSIDERED PROVIDING THEY DO NOT REDUCE THE STRENGTH CAPACITY OF THE RAIL SYSTEM.
- ALUMINUM WASHERS SHALL BE ASTM B209 ALLOY ACLAD 2024-T4.

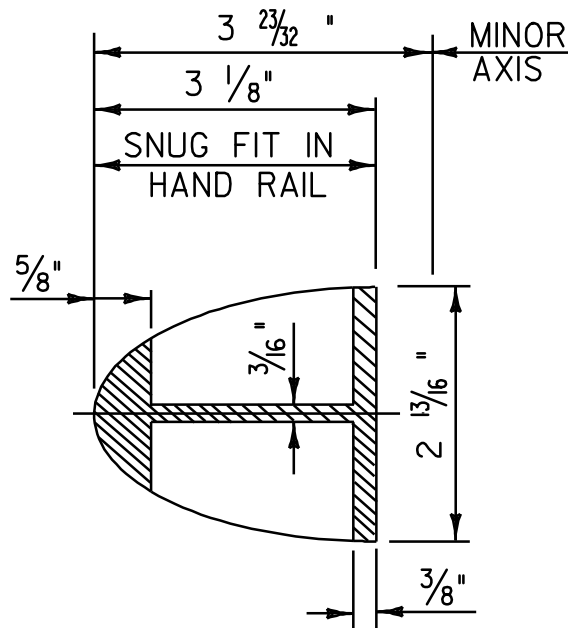
HAND RAIL  
SPLICE SECTION




ELEVATION OF  
HAND RAIL SPLICE BAR

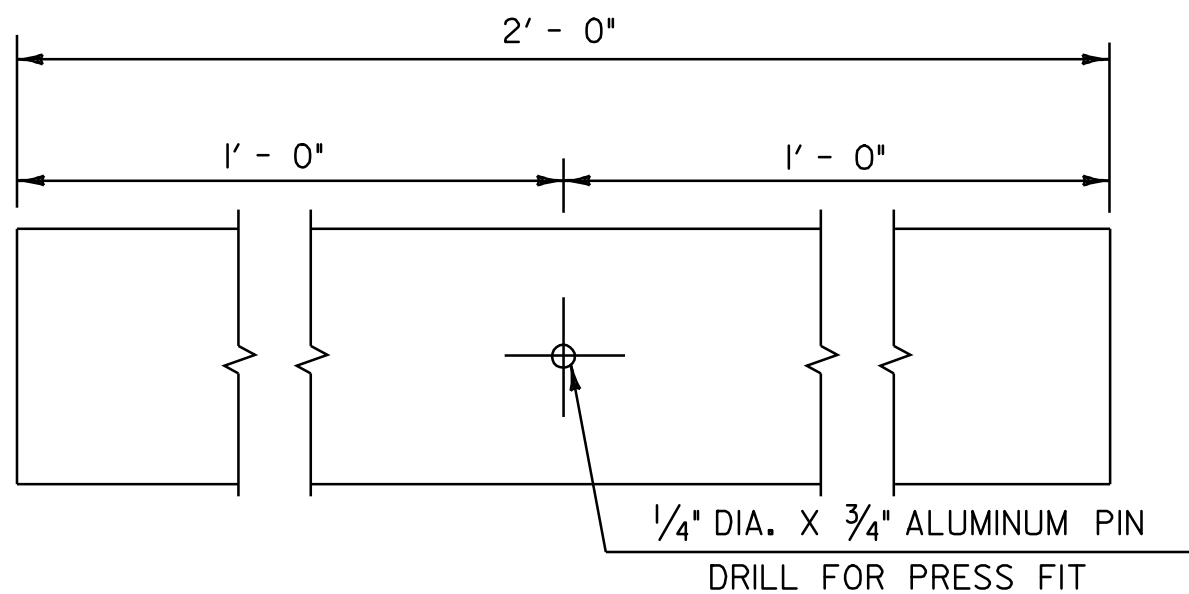


BARRIER RAIL  
SPLICE SECTION

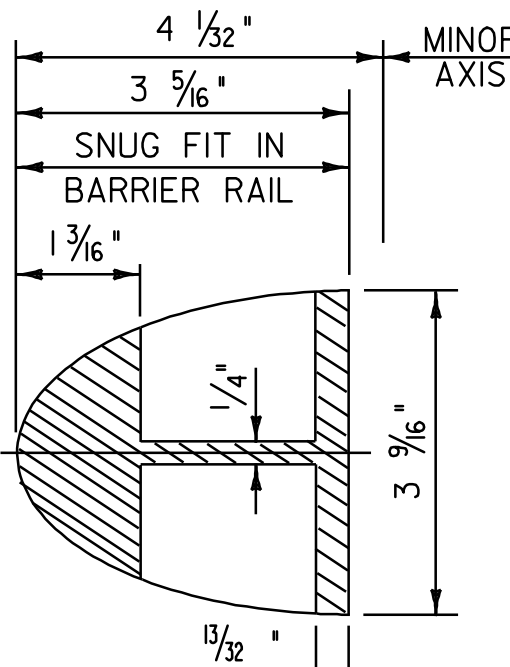

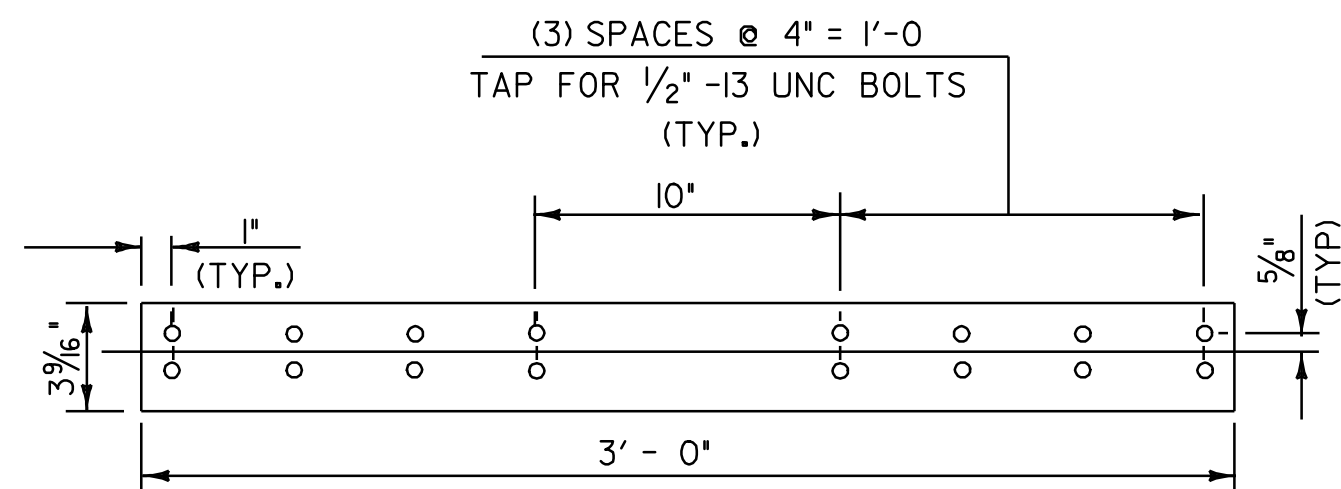
ELEVATION OF STD. BARRIER RAIL SPLICE BAR  
(FROM BACK)




POST BASE  
FRONT ELEVATION

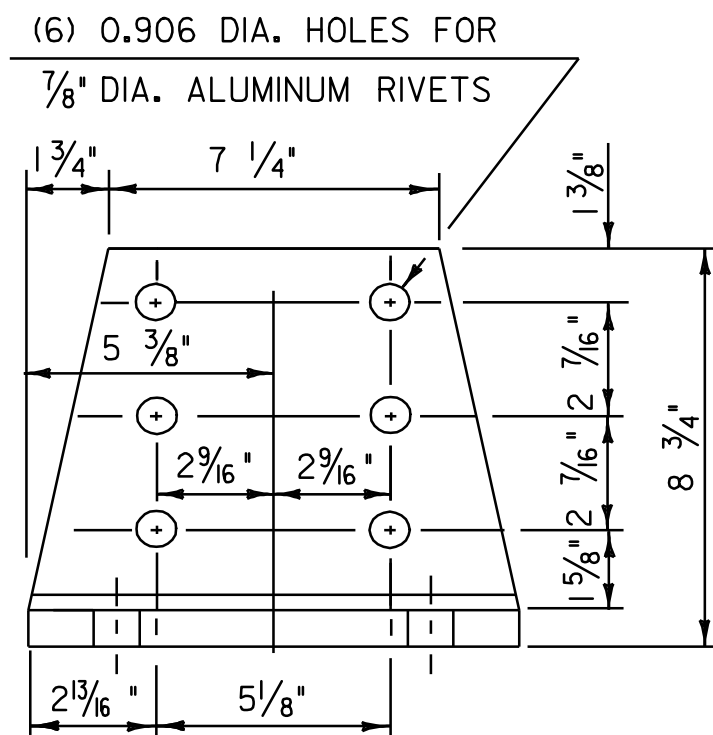


POST BASE  
SECTION

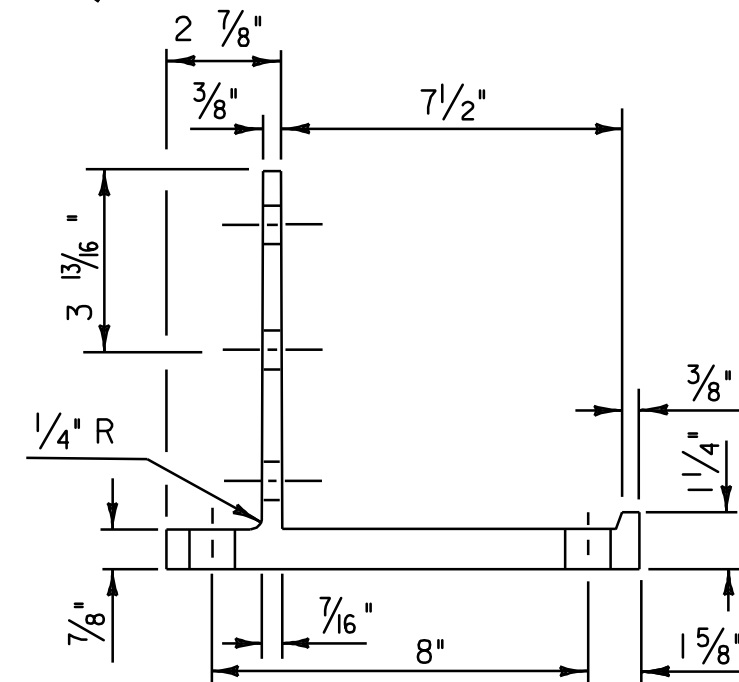


HAND RAIL END CAP

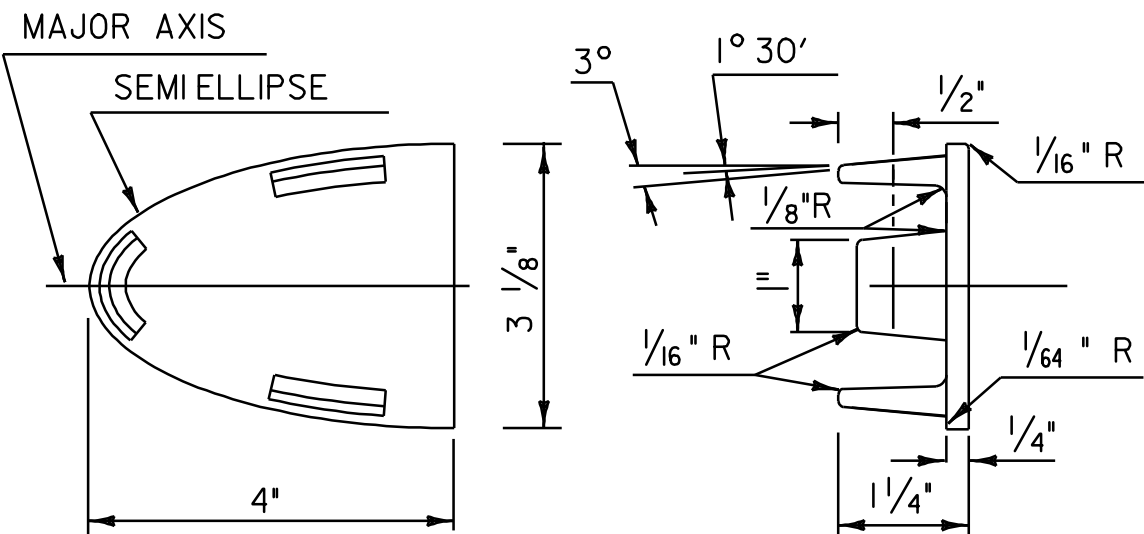


BARRIER RAIL END CAP

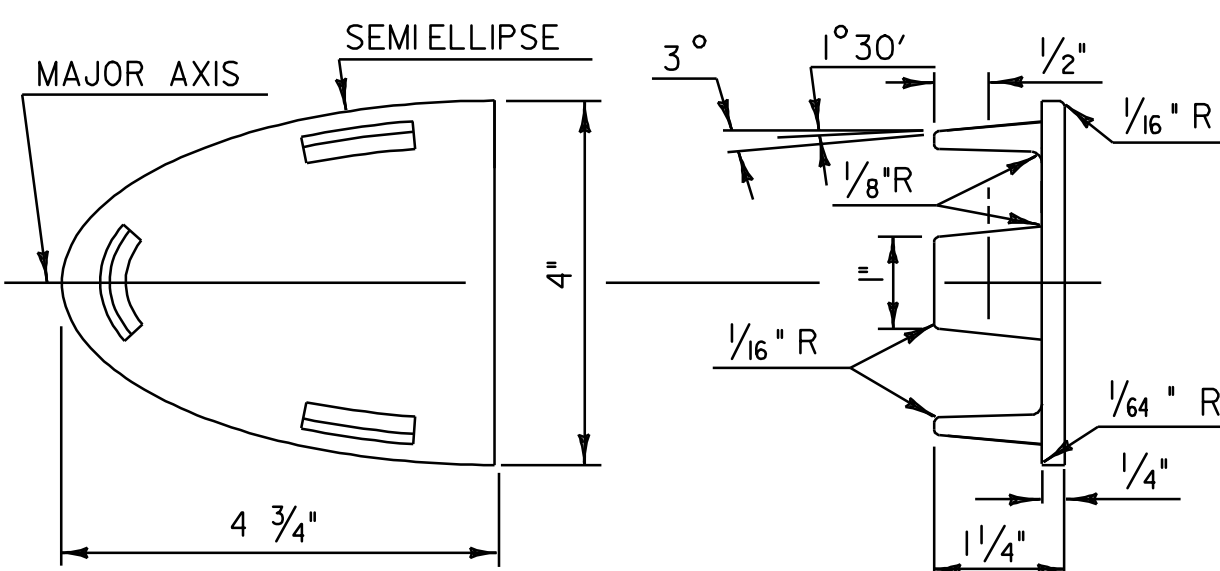


HAND RAIL SECTION

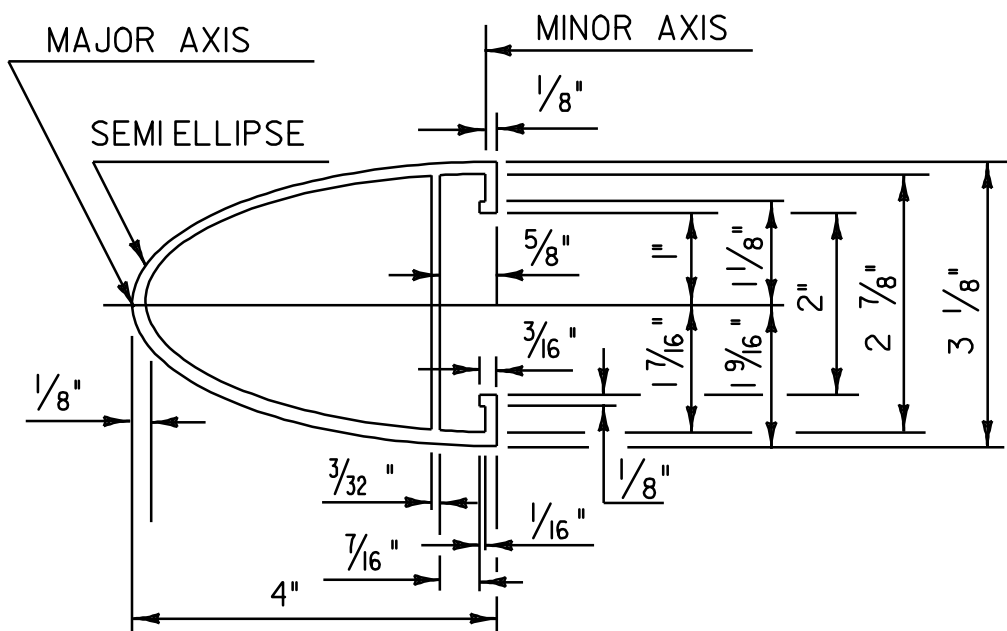


BARRIER RAIL SECTION

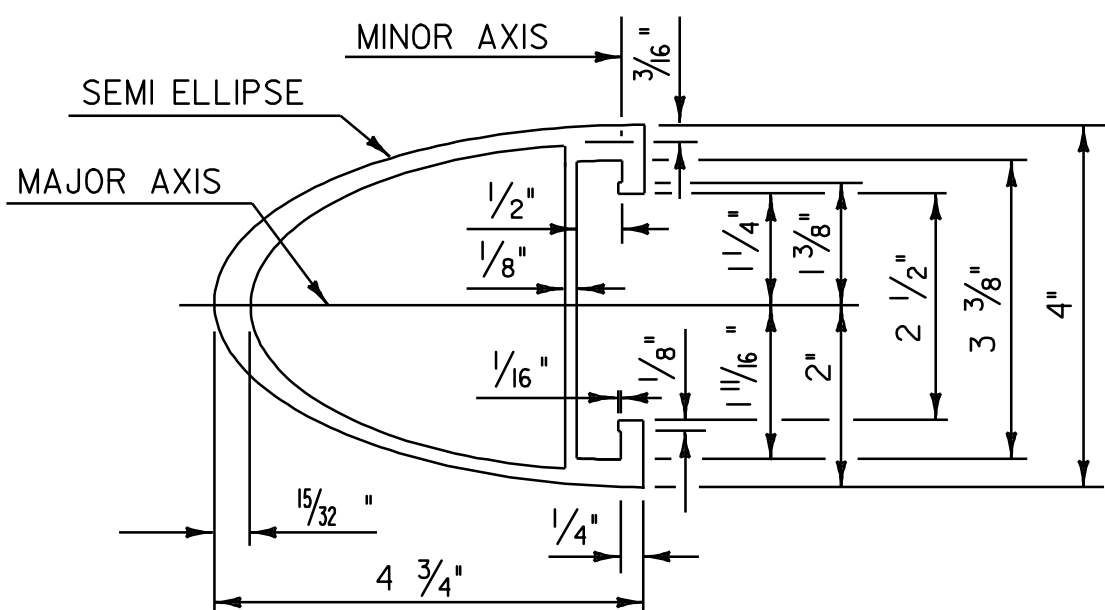

POST ANCHOR ASSEMBLY

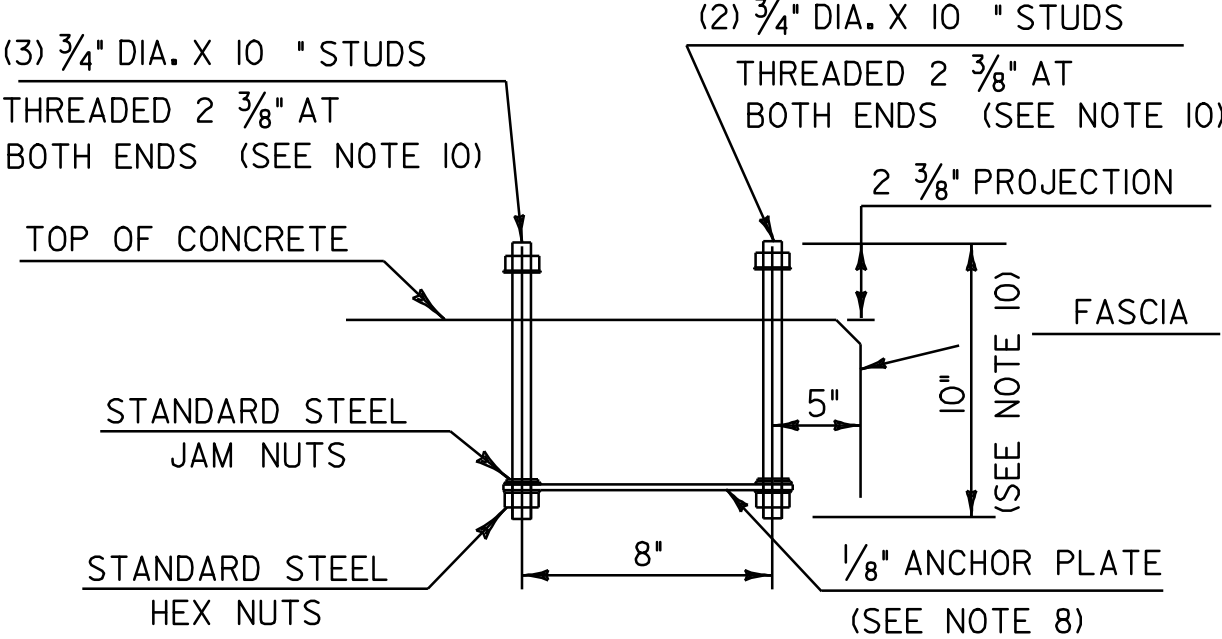

ANCHOR PLATE

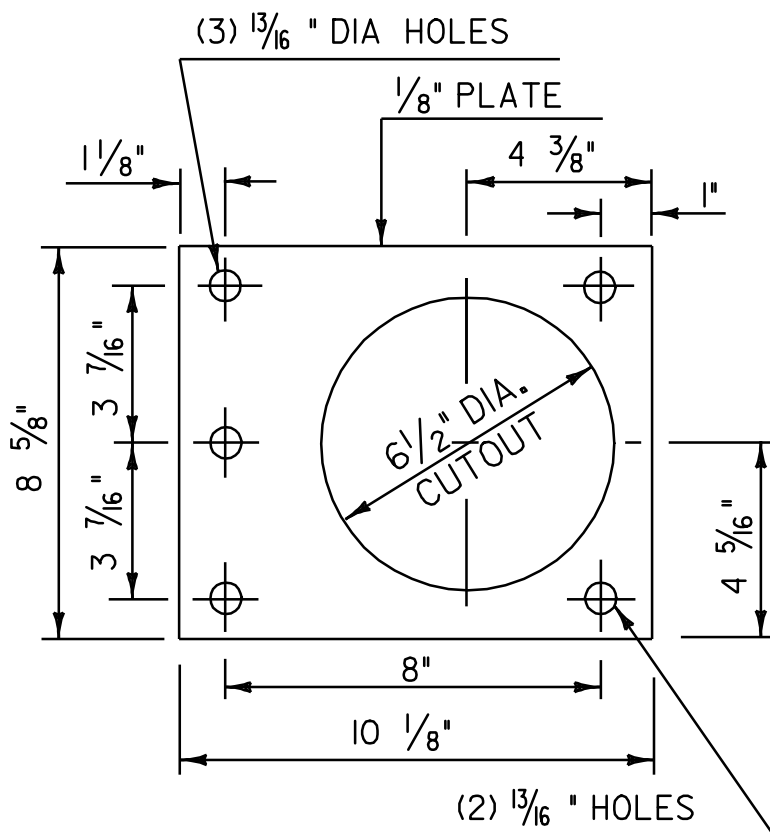

ALUMINUM  
APPROACH  
RAILING  
SHEET #2

|                                          |                     |
|------------------------------------------|---------------------|
| PROJECT NAME: WALLINGFORD - RUTLAND TOWN |                     |
| PROJECT NUMBER: NH 2408(1)S              |                     |
| FILE NAME: p04b050.dgn                   | PLOT DATE: \$DATE\$ |
| PROJECT LEADER: D.E.G.                   | DRAWN BY: C.A.K.    |
| DESIGNED BY: J.S.P.                      | CHECKED BY: D.E.G.  |
| IPARM FILE: p04b050aar2.i                | SHEET 73 OF 80      |



| ALUMINUM APPROACH RAILING<br>RAIL DIMENSIONS FOR A CURB CONDITION |                        |          |          |                         |          |         |          |
|-------------------------------------------------------------------|------------------------|----------|----------|-------------------------|----------|---------|----------|
| POST<br>No.                                                       | RAIL HEIGHT DIMENSIONS |          |          | OFFSET BLOCK DIMENSIONS |          |         |          |
|                                                                   | A                      | B        | C        | D                       | E        | F       | G        |
| 1                                                                 | 45 1/2                 | 35 1/2   | 23 1/4   | 10 7/16                 | 12 3/16  | 27 1/4  | 17 3/16  |
| 2                                                                 | 42 15/16               | 34 1/4   | 22 11/16 | 9 1/8                   | 11 9/16  | 25 1/4  | 16 9/16  |
| 3                                                                 | 40 7/16                | 33 1/16  | 22 1/8   | 7 3/4                   | 10 15/16 | 23 5/16 | 15 15/16 |
| 4                                                                 | 37 7/8                 | 31 7/8   | 21 9/16  | 6 7/16                  | 10 5/16  | 21 5/16 | 15 5/16  |
| 5                                                                 | -                      | 30 5/16  | 20 3/4   | -                       | 9 1/2    | -       | 14 1/2   |
| 6                                                                 | -                      | 28 11/16 | 20       | -                       | 8 11/16  | -       | 13 11/16 |
| 7                                                                 | -                      | 27 1/8   | 19 1/4   | -                       | 7 13/16  | -       | 12 13/16 |

ALL REMAINING POSTS ARE TO HAVE THE  
SAME DIMENSIONS AS POST NO. 7

|     |              |
|-----|--------------|
|     | CURB<br>SIDE |
| "X" | 13/16        |
| "Y" | 3/8          |
| "Z" | 3/16         |

BRIDGE 90-S  
STA. 68+60.7 - STA. 68+88.0 LT

SEE SHEETS 72 & 73 FOR ALUMINUM APPROACH  
RAILING DETAILS

|   |        |
|---|--------|
| H | 18 1/2 |
| I | 8 7/8  |
| J | 14 3/4 |
| K | 27 3/8 |
| L | 38 1/4 |

| ALUMINUM APPROACH RAILING<br>RAIL DIMENSIONS FOR A CURB CONDITION |                        |          |          |                         |          |         |          |
|-------------------------------------------------------------------|------------------------|----------|----------|-------------------------|----------|---------|----------|
| POST<br>No.                                                       | RAIL HEIGHT DIMENSIONS |          |          | OFFSET BLOCK DIMENSIONS |          |         |          |
|                                                                   | A                      | B        | C        | D                       | E        | F       | G        |
| 1                                                                 | 44 11/16               | 34 7/8   | 22 1/4   | 10 1/4                  | 12 11/16 | 27 1/2  | 17 11/16 |
| 2                                                                 | 42 5/16                | 33 3/4   | 21 13/16 | 9                       | 12       | 25 1/2  | 17       |
| 3                                                                 | 39 15/16               | 32 11/16 | 21 3/8   | 7 11/16                 | 11 5/16  | 23 9/16 | 16 5/16  |
| 4                                                                 | 37 9/16                | 31 9/16  | 20 15/16 | 6 7/16                  | 10 5/8   | 21 5/8  | 15 5/8   |
| 5                                                                 | -                      | 30 1/16  | 20 3/8   | -                       | 9 11/16  | -       | 14 11/16 |
| 6                                                                 | -                      | 28 9/16  | 19 13/16 | -                       | 8 3/4    | -       | 13 3/4   |
| 7                                                                 | -                      | 27 1/16  | 19 3/16  | -                       | 7 7/8    | -       | 12 7/8   |

ALL REMAINING POSTS ARE TO HAVE THE  
SAME DIMENSIONS AS POST NO. 7

|     |              |
|-----|--------------|
|     | CURB<br>SIDE |
| "X" | 3/4          |
| "Y" | 3/8          |
| "Z" | 1/8          |

BRIDGE 90-S  
STA. 68+60.7 - STA. 68+88.0 RT

SEE SHEETS 72 & 73 FOR ALUMINUM APPROACH  
RAILING DETAILS

|   |        |
|---|--------|
| H | 18     |
| I | 8 1/4  |
| J | 14 1/4 |
| K | 27 3/8 |
| L | 38     |

| ALUMINUM APPROACH RAILING<br>RAIL DIMENSIONS FOR A CURB CONDITION |                        |          |          |                         |          |         |          |
|-------------------------------------------------------------------|------------------------|----------|----------|-------------------------|----------|---------|----------|
| POST<br>No.                                                       | RAIL HEIGHT DIMENSIONS |          |          | OFFSET BLOCK DIMENSIONS |          |         |          |
|                                                                   | A                      | B        | C        | D                       | E        | F       | G        |
| 1                                                                 | 45 1/2                 | 35 1/2   | 23 1/4   | 10 7/16                 | 12 3/16  | 27 1/4  | 17 3/16  |
| 2                                                                 | 42 15/16               | 34 1/4   | 22 11/16 | 9 1/8                   | 11 9/16  | 25 1/4  | 16 9/16  |
| 3                                                                 | 40 7/16                | 33 1/16  | 22 1/8   | 7 3/4                   | 10 15/16 | 23 5/16 | 15 15/16 |
| 4                                                                 | 37 7/8                 | 31 7/8   | 21 9/16  | 6 7/16                  | 10 5/16  | 21 5/16 | 15 5/16  |
| 5                                                                 | -                      | 30 5/16  | 20 3/4   | -                       | 9 1/2    | -       | 14 1/2   |
| 6                                                                 | -                      | 28 11/16 | 20       | -                       | 8 11/16  | -       | 13 11/16 |
| 7                                                                 | -                      | 27 1/8   | 19 1/4   | -                       | 7 13/16  | -       | 12 13/16 |

ALL REMAINING POSTS ARE TO HAVE THE  
SAME DIMENSIONS AS POST NO. 7

|     |              |
|-----|--------------|
|     | CURB<br>SIDE |
| "X" | 13/16        |
| "Y" | 3/8          |
| "Z" | 3/16         |

BRIDGE 96-S  
STA. 287+72.7 - STA. 288+00.0 LT

SEE SHEETS 72 & 73 FOR ALUMINUM APPROACH  
RAILING DETAILS

|   |        |
|---|--------|
| H | 18 1/2 |
| I | 8 7/8  |
| J | 14 3/4 |
| K | 27 3/8 |
| L | 38 1/4 |

| ALUMINUM APPROACH RAILING<br>RAIL DIMENSIONS FOR A CURB CONDITION |                        |         |         |                         |          |         |          |
|-------------------------------------------------------------------|------------------------|---------|---------|-------------------------|----------|---------|----------|
| POST<br>No.                                                       | RAIL HEIGHT DIMENSIONS |         |         | OFFSET BLOCK DIMENSIONS |          |         |          |
|                                                                   | A                      | B       | C       | D                       | E        | F       | G        |
| 1                                                                 | 43 7/8                 | 34 1/16 | 21 7/16 | 10 1/4                  | 12 11/16 | 27 1/2  | 17 11/16 |
| 2                                                                 | 41 5/8                 | 33 1/16 | 21 1/8  | 9                       | 12       | 25 1/2  | 17       |
| 3                                                                 | 39 5/16                | 32 1/16 | 20 3/4  | 7 11/16                 | 11 5/16  | 23 9/16 | 16 5/16  |
| 4                                                                 | 37 1/16                | 31 1/16 | 20 7/16 | 6 7/16                  | 10 5/8   | 21 5/8  | 15 5/8   |
| 5                                                                 | -                      | 29 3/4  | 20      | -                       | 9 11/16  | -       | 14 11/16 |
| 6                                                                 | -                      | 28 3/8  | 19 5/8  | -                       | 8 3/4    | -       | 13 3/4   |
| 7                                                                 | -                      | 27 1/16 | 19 3/16 | -                       | 7 7/8    | -       | 12 7/8   |

ALL REMAINING POSTS ARE TO HAVE THE  
SAME DIMENSIONS AS POST NO. 7

|     |              |
|-----|--------------|
|     | CURB<br>SIDE |
| "X" | 3/4          |
| "Y" | 5/16         |
| "Z" | 1/8          |

BRIDGE 90-S  
STA. 72+37.0 - STA. 72+64.3 LT

SEE SHEETS 72 & 73 FOR ALUMINUM APPROACH  
RAILING DETAILS

|   |        |
|---|--------|
| H | 20     |
| I | 7 1/2  |
| J | 14 1/8 |
| K | 27 1/4 |
| L | 37 7/8 |

| ALUMINUM APPROACH RAILING<br>RAIL DIMENSIONS FOR A CURB CONDITION |                        |         |         |                         |         |         |         |
|-------------------------------------------------------------------|------------------------|---------|---------|-------------------------|---------|---------|---------|
| POST<br>No.                                                       | RAIL HEIGHT DIMENSIONS |         |         | OFFSET BLOCK DIMENSIONS |         |         |         |
|                                                                   | A                      | B       | C       | D                       | E       | F       | G       |
| 1                                                                 | 44                     | 34 1/16 | 21 1/2  | 10 5/16                 | 12 9/16 | 27 7/16 | 17 9/16 |
| 2                                                                 | 41 11/16               | 33 1/16 | 21 3/16 | 9 1/16                  | 11 7/8  | 25 1/2  | 16 7/8  |
| 3                                                                 | 39 3/8                 | 32 1/16 | 20 7/8  | 7 3/4                   | 11 3/16 | 23 1/2  | 16 3/16 |
| 4                                                                 | 37 1/16                | 31 1/16 | 20 1/2  | 6 7/16                  | 10 9/16 | 21 9/16 | 15 9/16 |
| 5                                                                 | -                      | 29 3/4  | 20 1/16 | -                       | 9 5/8   | -       | 14 5/8  |
| 6                                                                 | -                      | 28 3/8  | 19 5/8  | -                       | 8 3/4   | -       | 13 3/4  |
| 7                                                                 | -                      | 27 1/16 | 19 3/16 | -                       | 7 7/8   | -       | 12 7/8  |

ALL REMAINING POSTS ARE TO HAVE THE  
SAME DIMENSIONS AS POST NO. 7

|     |              |
|-----|--------------|
|     | CURB<br>SIDE |
| "X" | 3/4          |
| "Y" | 5/16         |
| "Z" | 1/8          |

BRIDGE 90-S  
STA. 72+37.0 - STA. 72+64.3 RT

SEE SHEETS 72 & 73 FOR ALUMINUM APPROACH  
RAILING DETAILS

|   |        |
|---|--------|
| H | 19     |
| I | 7 1/2  |
| J | 14 1/4 |
| K | 27 1/4 |
| L | 38     |

| ALUMINUM APPROACH RAILING<br>RAIL DIMENSIONS FOR A CURB CONDITION |                        |          |          |                         |          |         |          |
|-------------------------------------------------------------------|------------------------|----------|----------|-------------------------|----------|---------|----------|
| POST<br>No.                                                       | RAIL HEIGHT DIMENSIONS |          |          | OFFSET BLOCK DIMENSIONS |          |         |          |
|                                                                   | A                      | B        | C        | D                       | E        | F       | G        |
| 1                                                                 | 44 11/16               | 34 7/8   | 22 1/4   | 10 1/4                  | 12 11/16 | 27 1/2  | 17 11/16 |
| 2                                                                 | 42 5/16                | 33 3/4   | 21 13/16 | 9                       | 12       | 25 1/2  | 17       |
| 3                                                                 | 39 15/16               | 32 11/16 | 21 3/8   | 7 11/16                 | 11 5/16  | 23 9/16 | 16 5/16  |
| 4                                                                 | 37 9/16                | 31 9/16  | 20 15/16 | 6 7/16                  | 10 5/8   | 21 5/8  | 15 5/8   |
| 5                                                                 | -                      | 30 1/16  | 20 3/8   | -                       | 9 11/16  | -       | 14 11/16 |
| 6                                                                 | -                      | 28 9/16  | 19 13/16 | -                       | 8 3/4    | -       | 13 3/4   |
| 7                                                                 | -                      | 27 1/16  | 19 3/16  | -                       | 7 7/8    | -       | 12 7/8   |

ALL REMAINING POSTS ARE TO HAVE THE  
SAME DIMENSIONS AS POST NO. 7

|     |              |
|-----|--------------|
|     | CURB<br>SIDE |
| "X" | 3/4          |
| "Y" | 3/8          |
| "Z" | 1/8          |

BRIDGE 96-S  
STA. 289+53.0 - STA. 289+80.3 LT


SEE SHEETS 72 & 73 FOR ALUMINUM APPROACH  
RAILING DETAILS

|   |        |
|---|--------|
| H | 18     |
| I | 8 1/4  |
| J | 14 1/4 |
| K | 27 3/8 |
| L | 38     |

ALL DIMENSIONS ARE IN INCHES UNLESS OTHERWISE NOTED

| ALUMINUM<br>APPROACH<br>RAILING<br>SHEET #3 | PROJECT NAME: WALLINGFORD - RUTLAND TOWN |                     |
|---------------------------------------------|------------------------------------------|---------------------|
|                                             | PROJECT NUMBER: NH 2408(I)S              |                     |
|                                             | FILE NAME: p04b050.dgn                   | PLOT DATE: \$DATE\$ |
|                                             | PROJECT LEADER: D.E.G.                   | DRAWN BY: C.A.K.    |
|                                             | DESIGNED BY: J.S.P.                      | CHECKED BY: D.E.G.  |
|                                             | IPARM FILE: p04b050aar3.i                | SHEET 74 OF 80      |




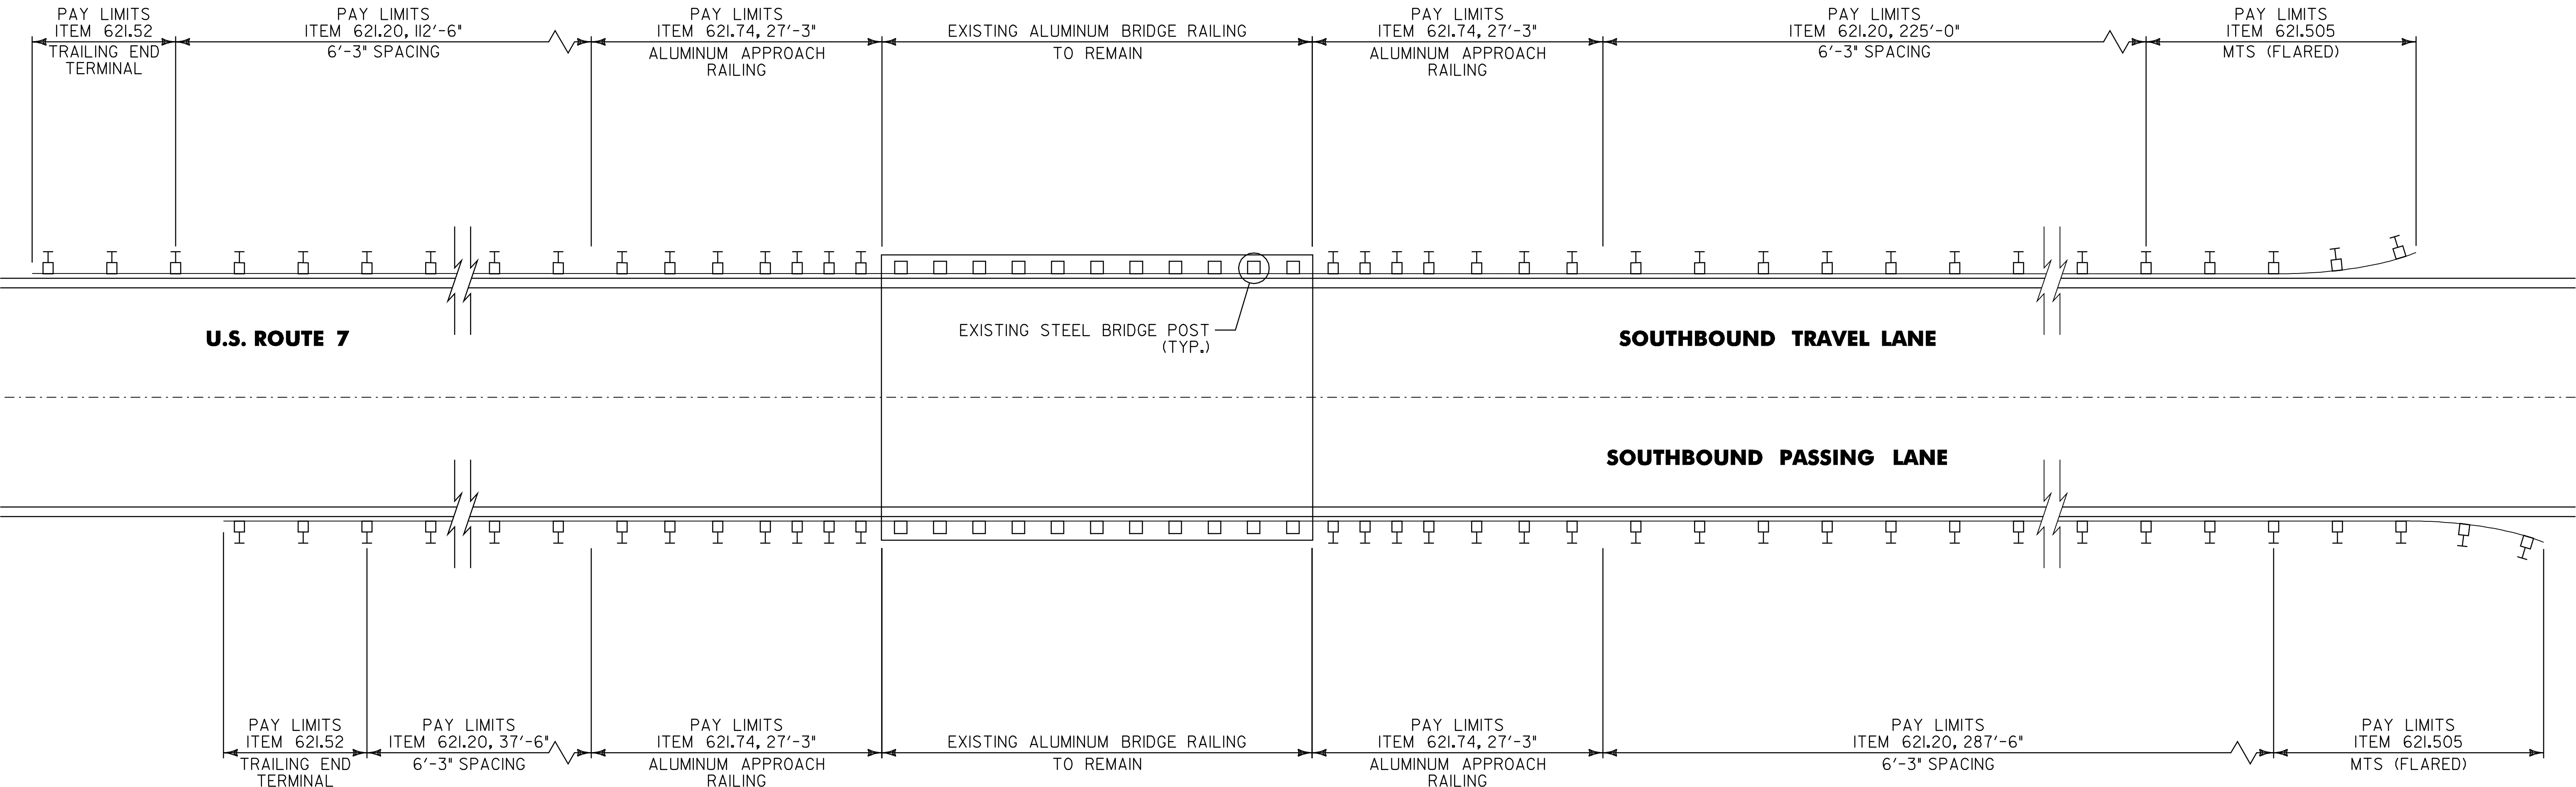

**BR 90-S CLARENDON MM 1.338 = STA. 70+64.64**  
N.T.S.

|                                       |                                          |                     |
|---------------------------------------|------------------------------------------|---------------------|
| <b>BRIDGE<br/>DETAIL<br/>SHEET #1</b> | PROJECT NAME: WALLINGFORD - RUTLAND TOWN |                     |
|                                       | PROJECT NUMBER: NH 2408(I)S              |                     |
|                                       | FILE NAME: p04b050.dgn                   | PLOT DATE: \$DATE\$ |
|                                       | PROJECT LEADER: D.E.G.                   | DRAWN BY: C.A.K.    |
|                                       | DESIGNED BY: J.S.P.                      | CHECKED BY: D.E.G.  |
|                                       | IPARM FILE: p04b050bdl.i                 | SHEET 75 OF 80      |



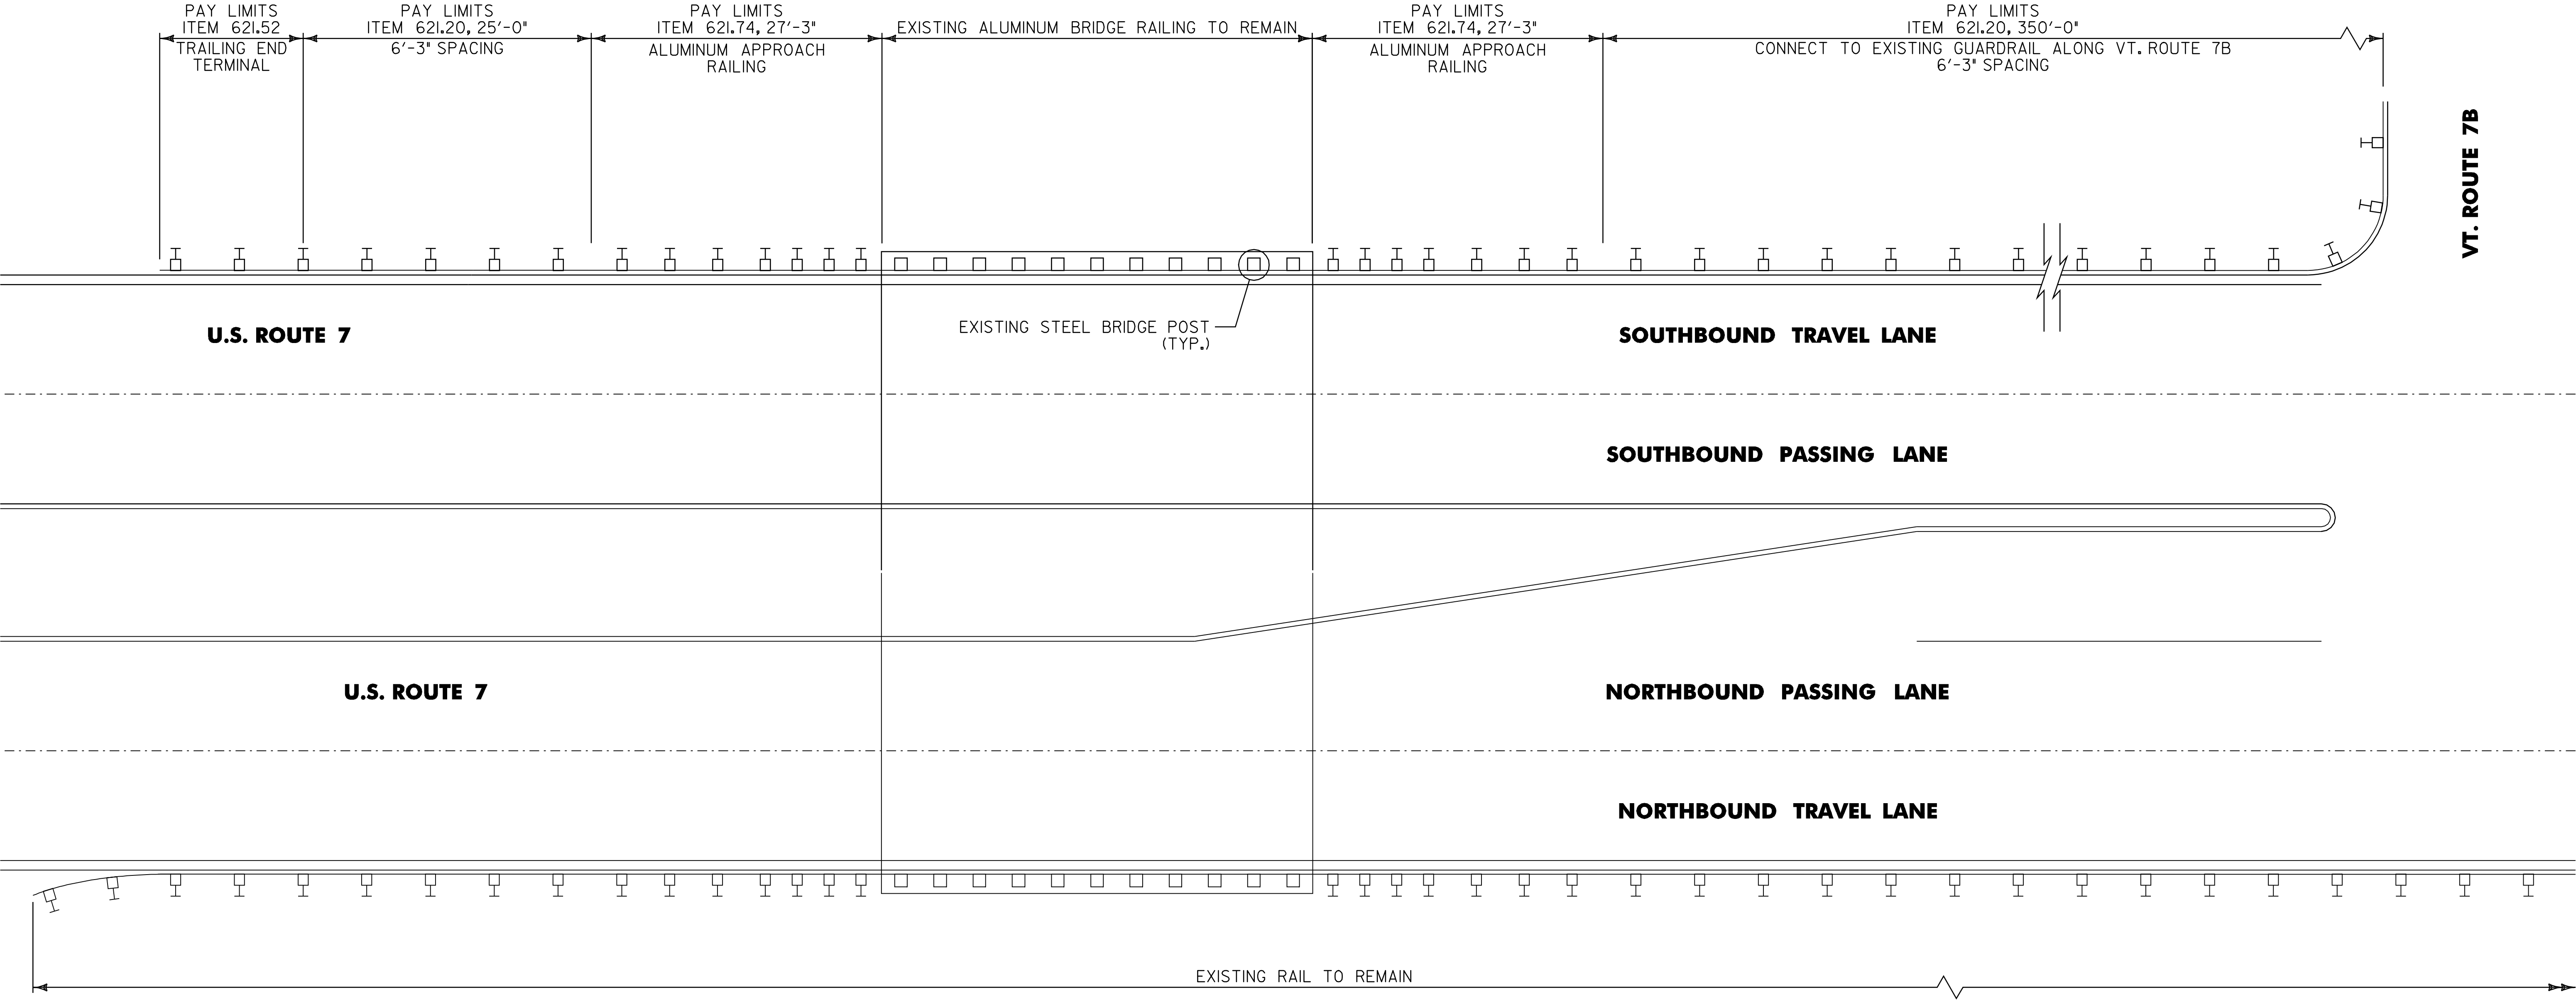


**BR 96-S CLARENDON MM 5.469 = STA. 288+76.32**  
N.T.S.


|                                       |                                                                                                     |                                                                                 |
|---------------------------------------|-----------------------------------------------------------------------------------------------------|---------------------------------------------------------------------------------|
| <b>BRIDGE<br/>DETAIL<br/>SHEET #2</b> | PROJECT NAME: WALLINGFORD - RUTLAND TOWN                                                            |                                                                                 |
|                                       | PROJECT NUMBER: NH 2408(I)S                                                                         |                                                                                 |
|                                       | FILE NAME: p04b050.dgn<br>PROJECT LEADER: D.E.G.<br>DESIGNED BY: J.S.P.<br>IPARM FILE: p04b050bd2.i | PLOT DATE: \$DATE\$<br>DRAWN BY: C.A.K.<br>CHECKED BY: D.E.G.<br>SHEET 76 OF 80 |



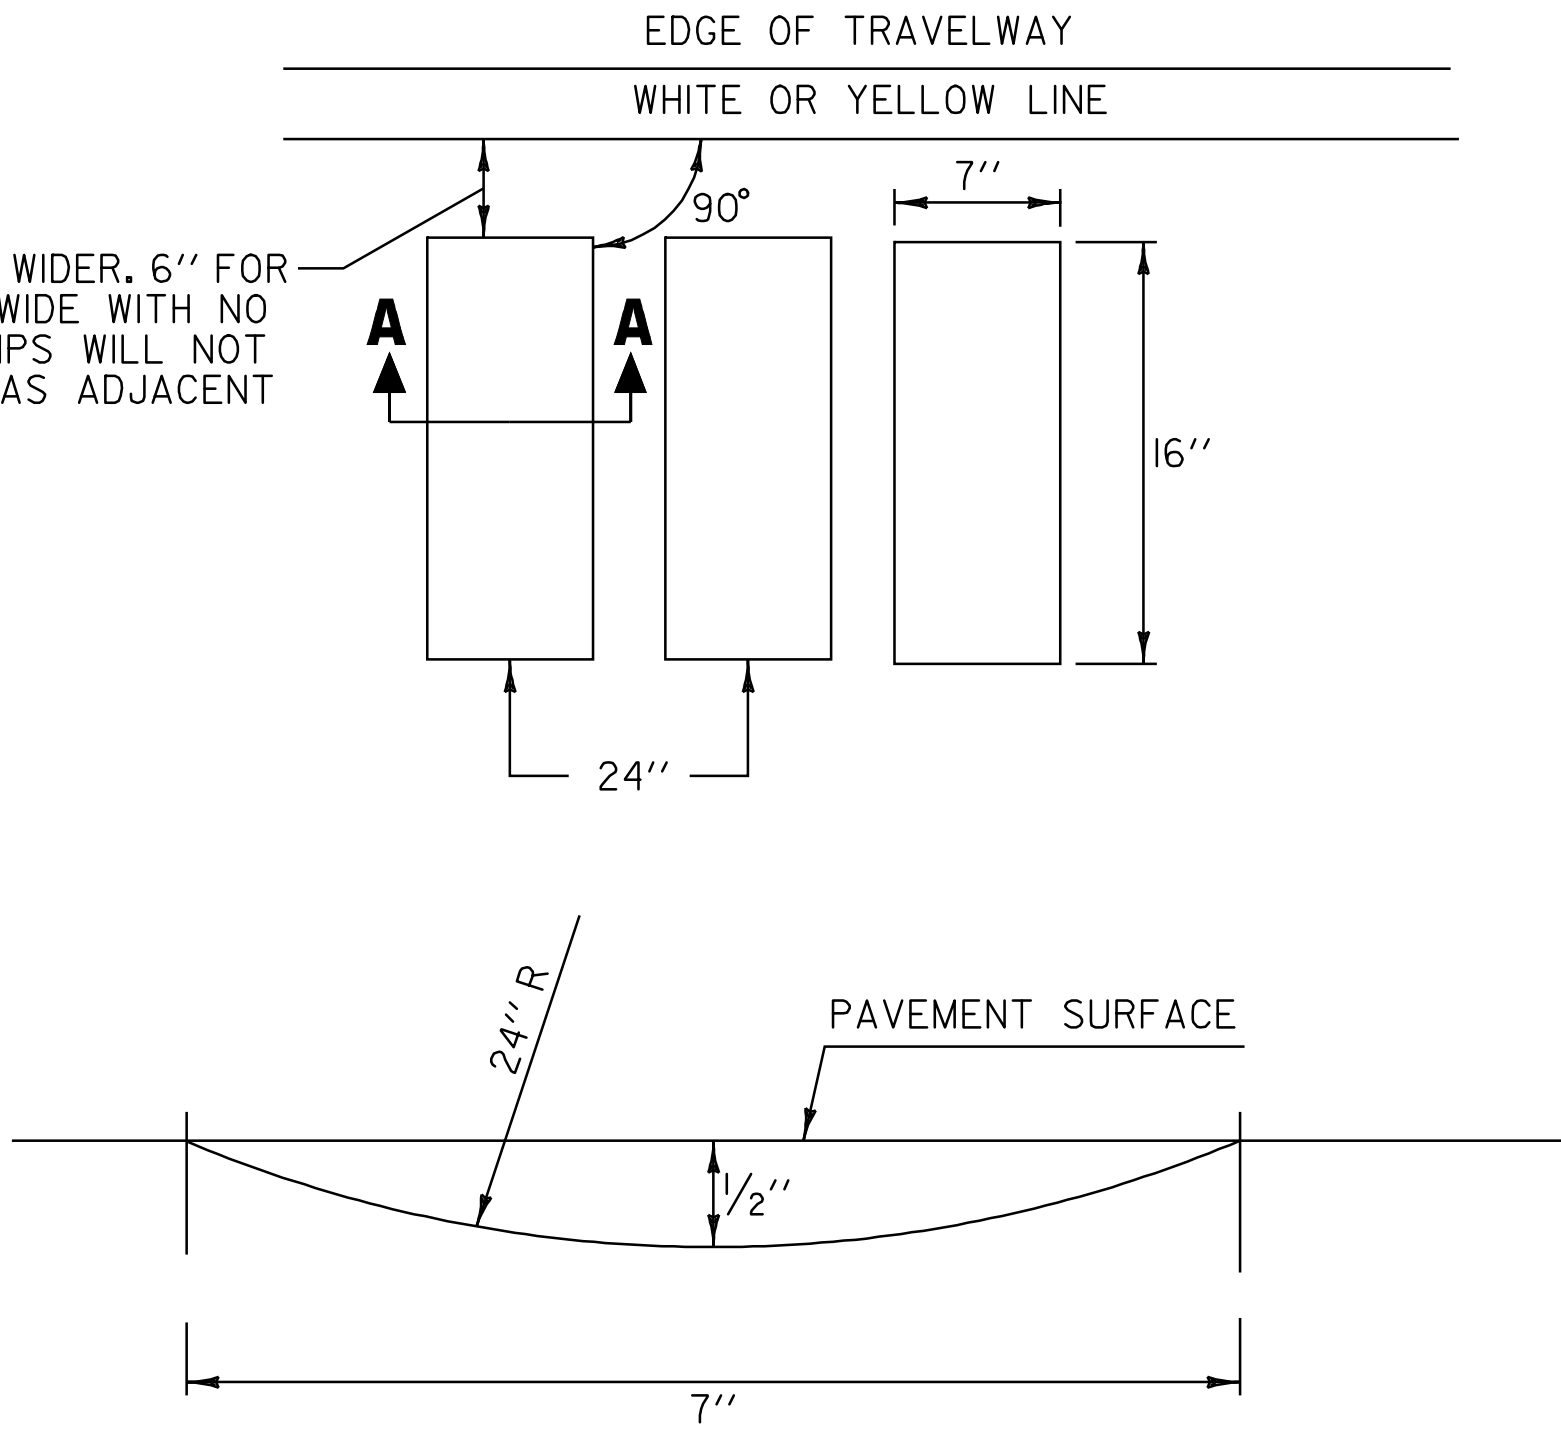
30'' FOR ALL SHOULDERS 6' OR WIDER. 6'' FOR ALL SHOULDERS LESS THAN 6' WIDE WITH NO GUARDRAIL. MILLED RUMBLE STRIPS WILL NOT BE REQUIRED IN GUARDRAIL AREAS ADJACENT TO THE 4' SHOULDER.



SECTION A-A  
TYPICAL MILLING DETAIL

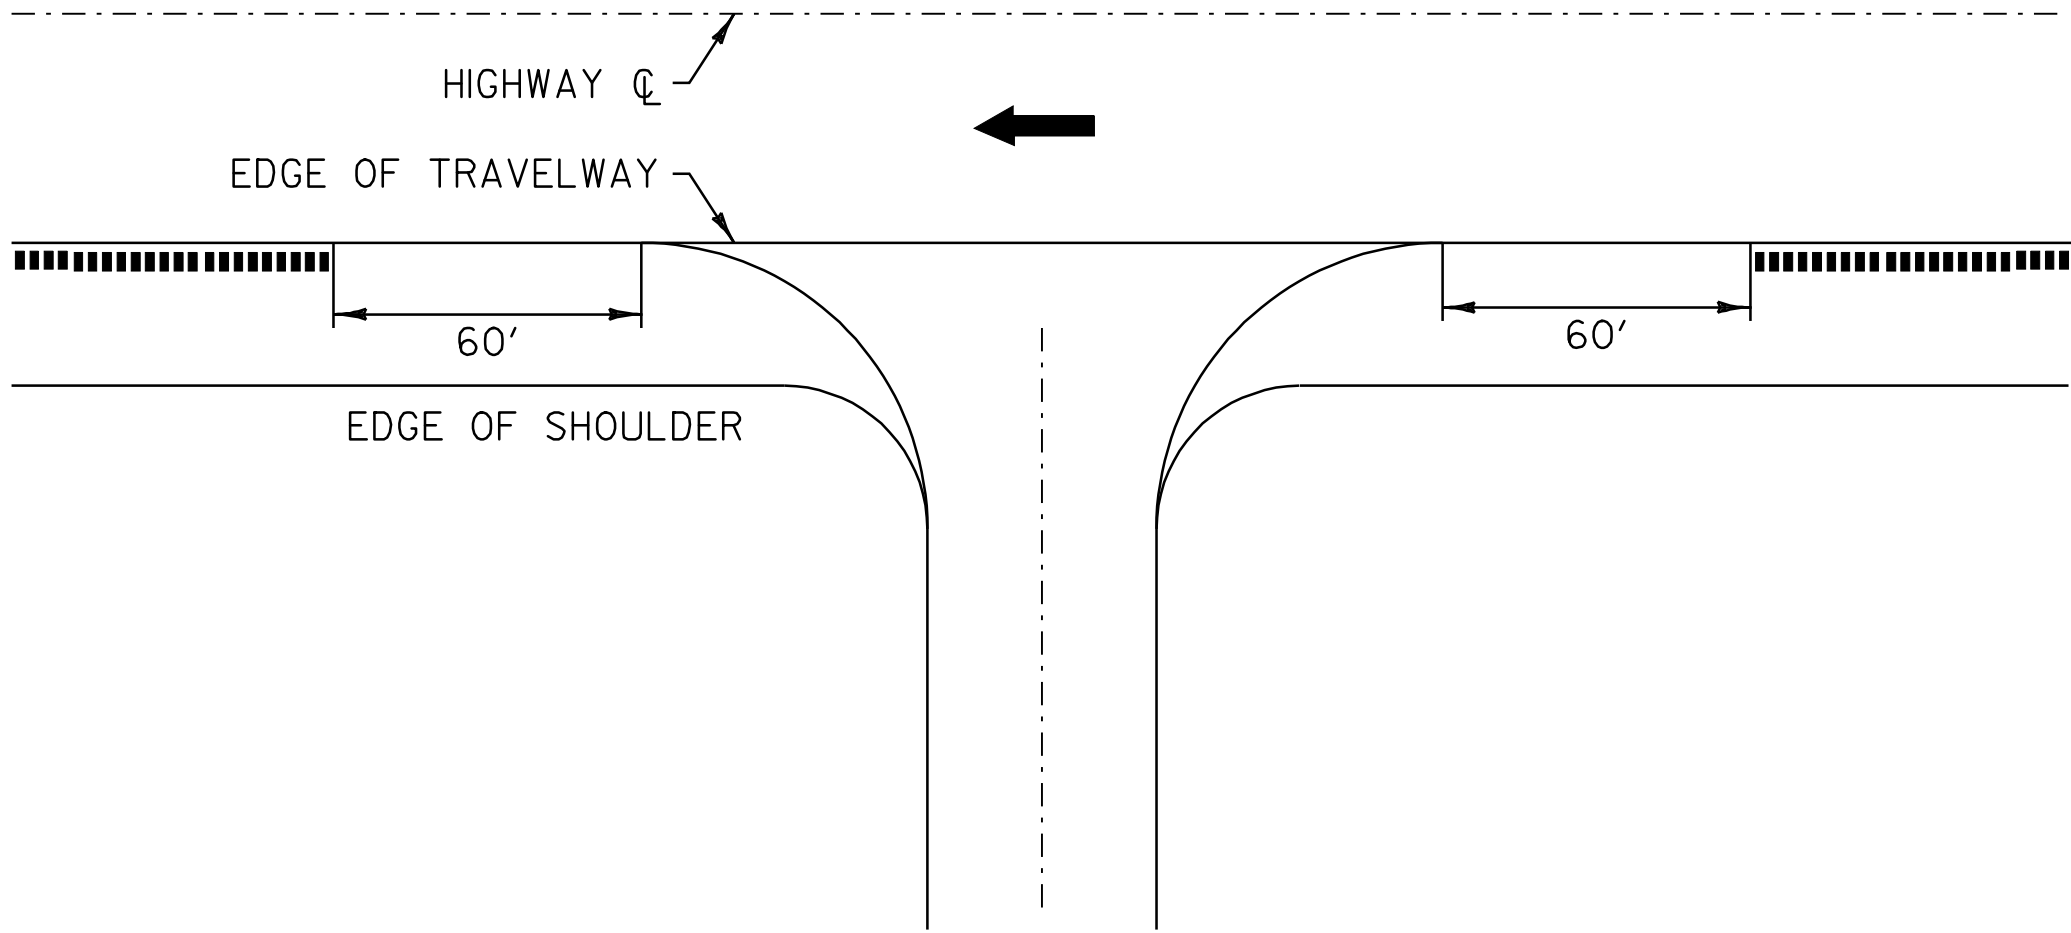

U-TURN AND SIDE ROAD DETAIL

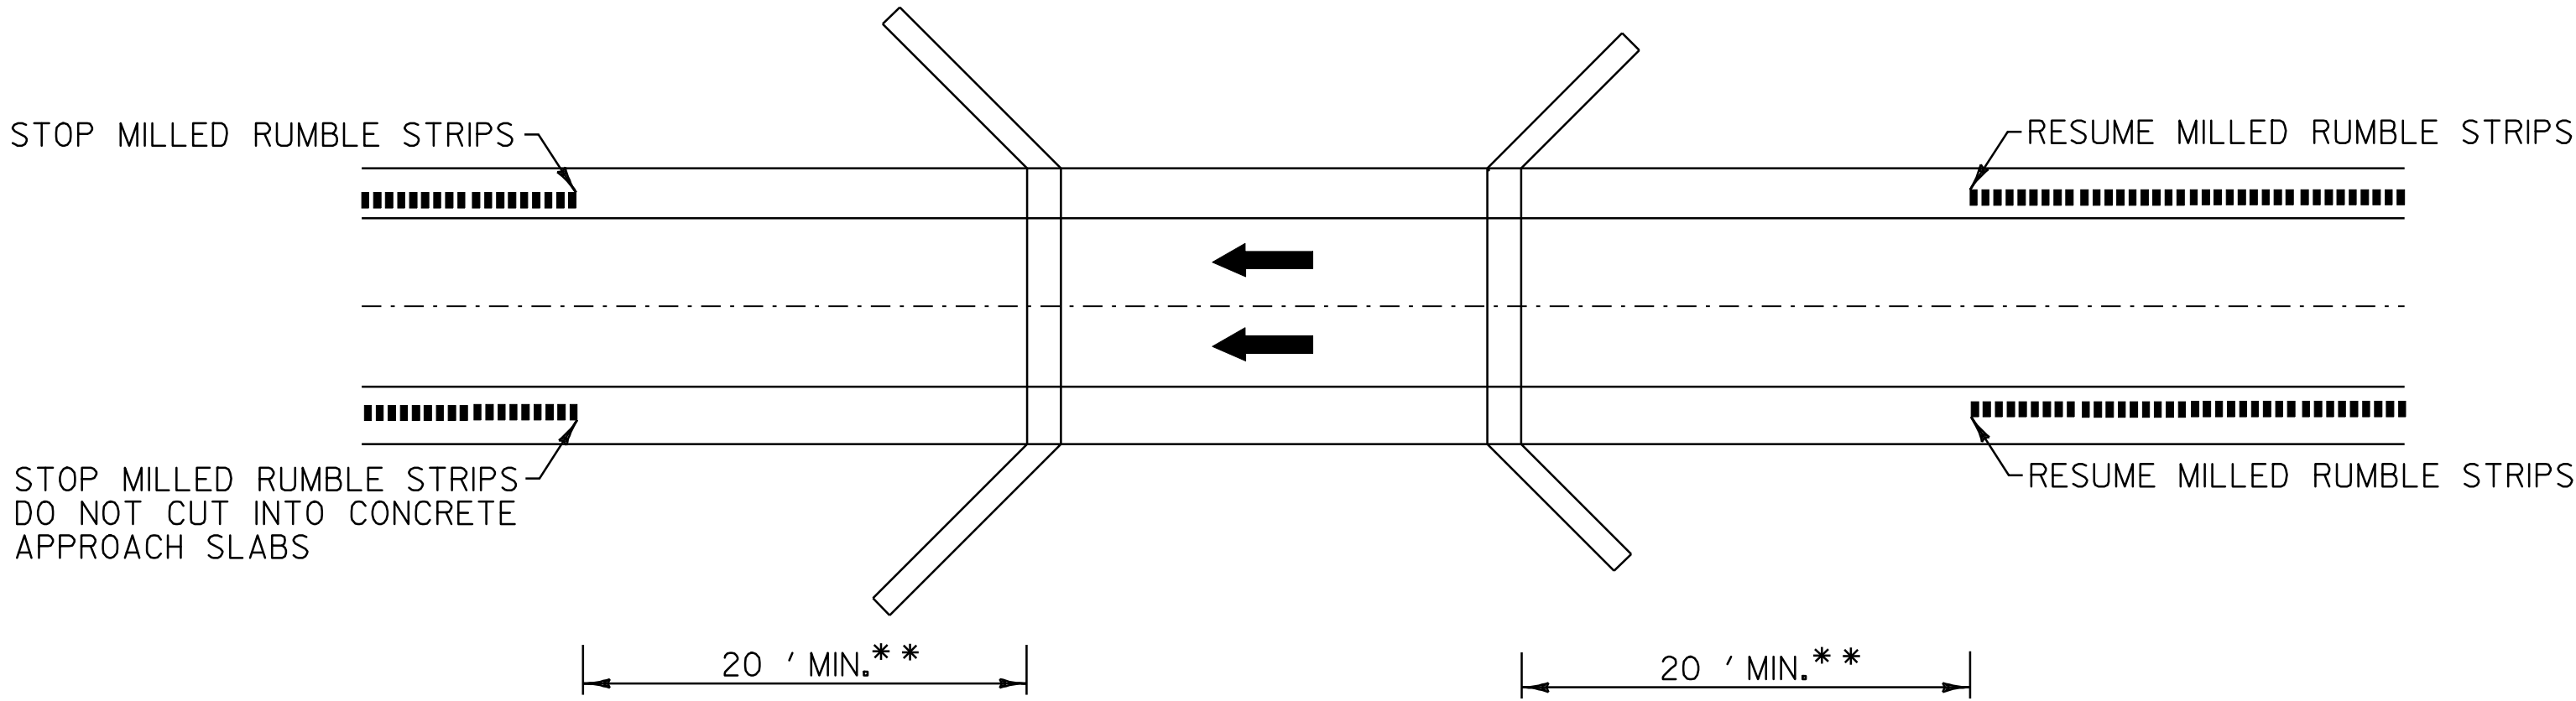

BRIDGE DETAIL

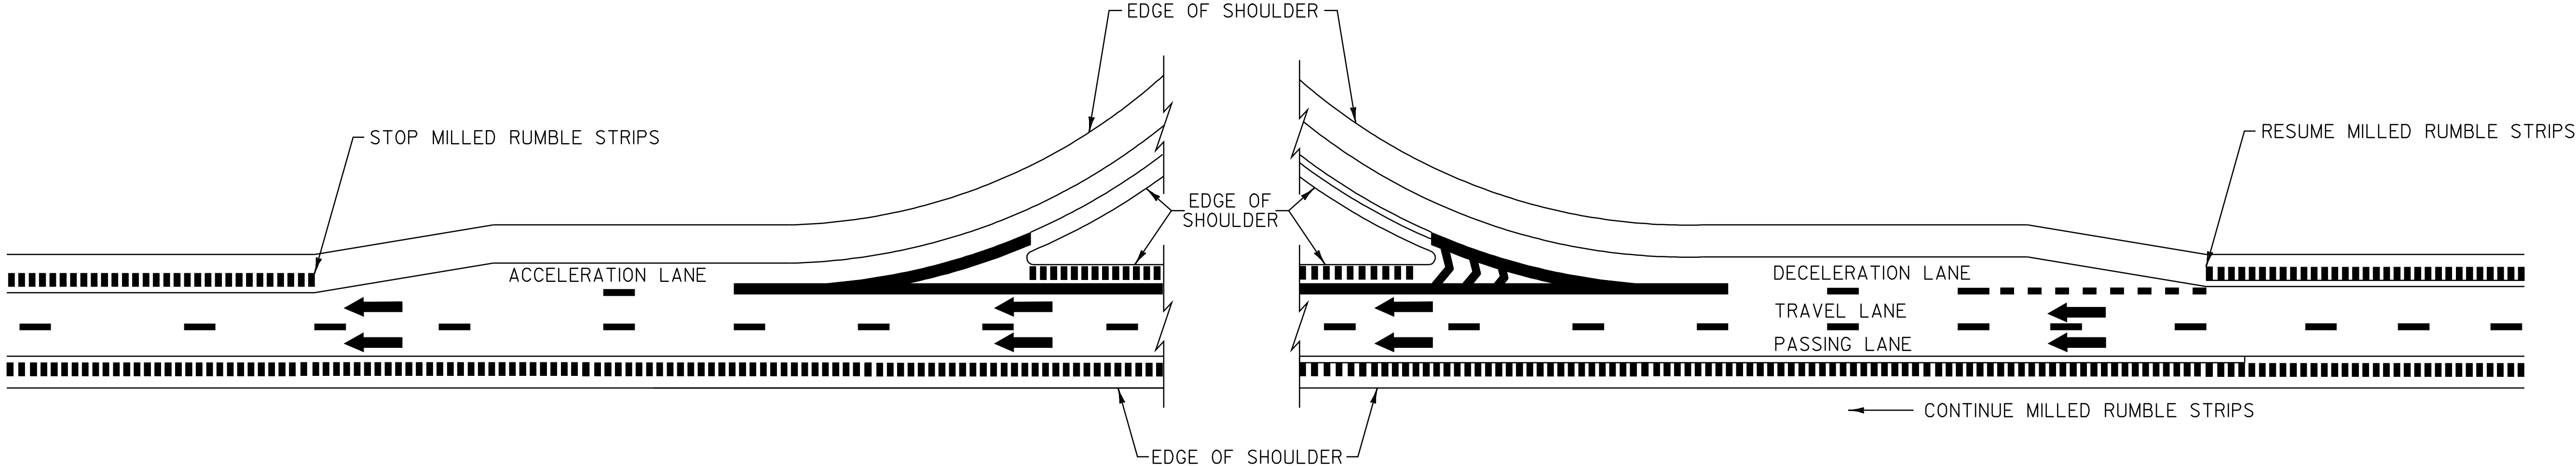
\*\* BRIDGE RAIL WILL DETERMINE MINIMUM DISTANCE IN SOME CASES.

LEGEND  
← DIRECTION OF TRAFFIC FLOW  
..... MILLED RUMBLE STRIPS


MILLED  
RUMBLE  
STRIP DETAIL  
SHEET #1

PROJECT NAME: WALLINGFORD - RUTLAND TOWN  
PROJECT NUMBER: NH 2408(I)S  
FILE NAME: p04b050.dgn  
PROJECT LEADER: D.E.G.  
DESIGNED BY: J.S.P.  
IPARM FILE: p04b050rsdl.i  
PLOT DATE: \$DATE\$  
DRAWN BY: C.A.K.  
CHECKED BY: D.E.G.  
SHEET 77 OF 80





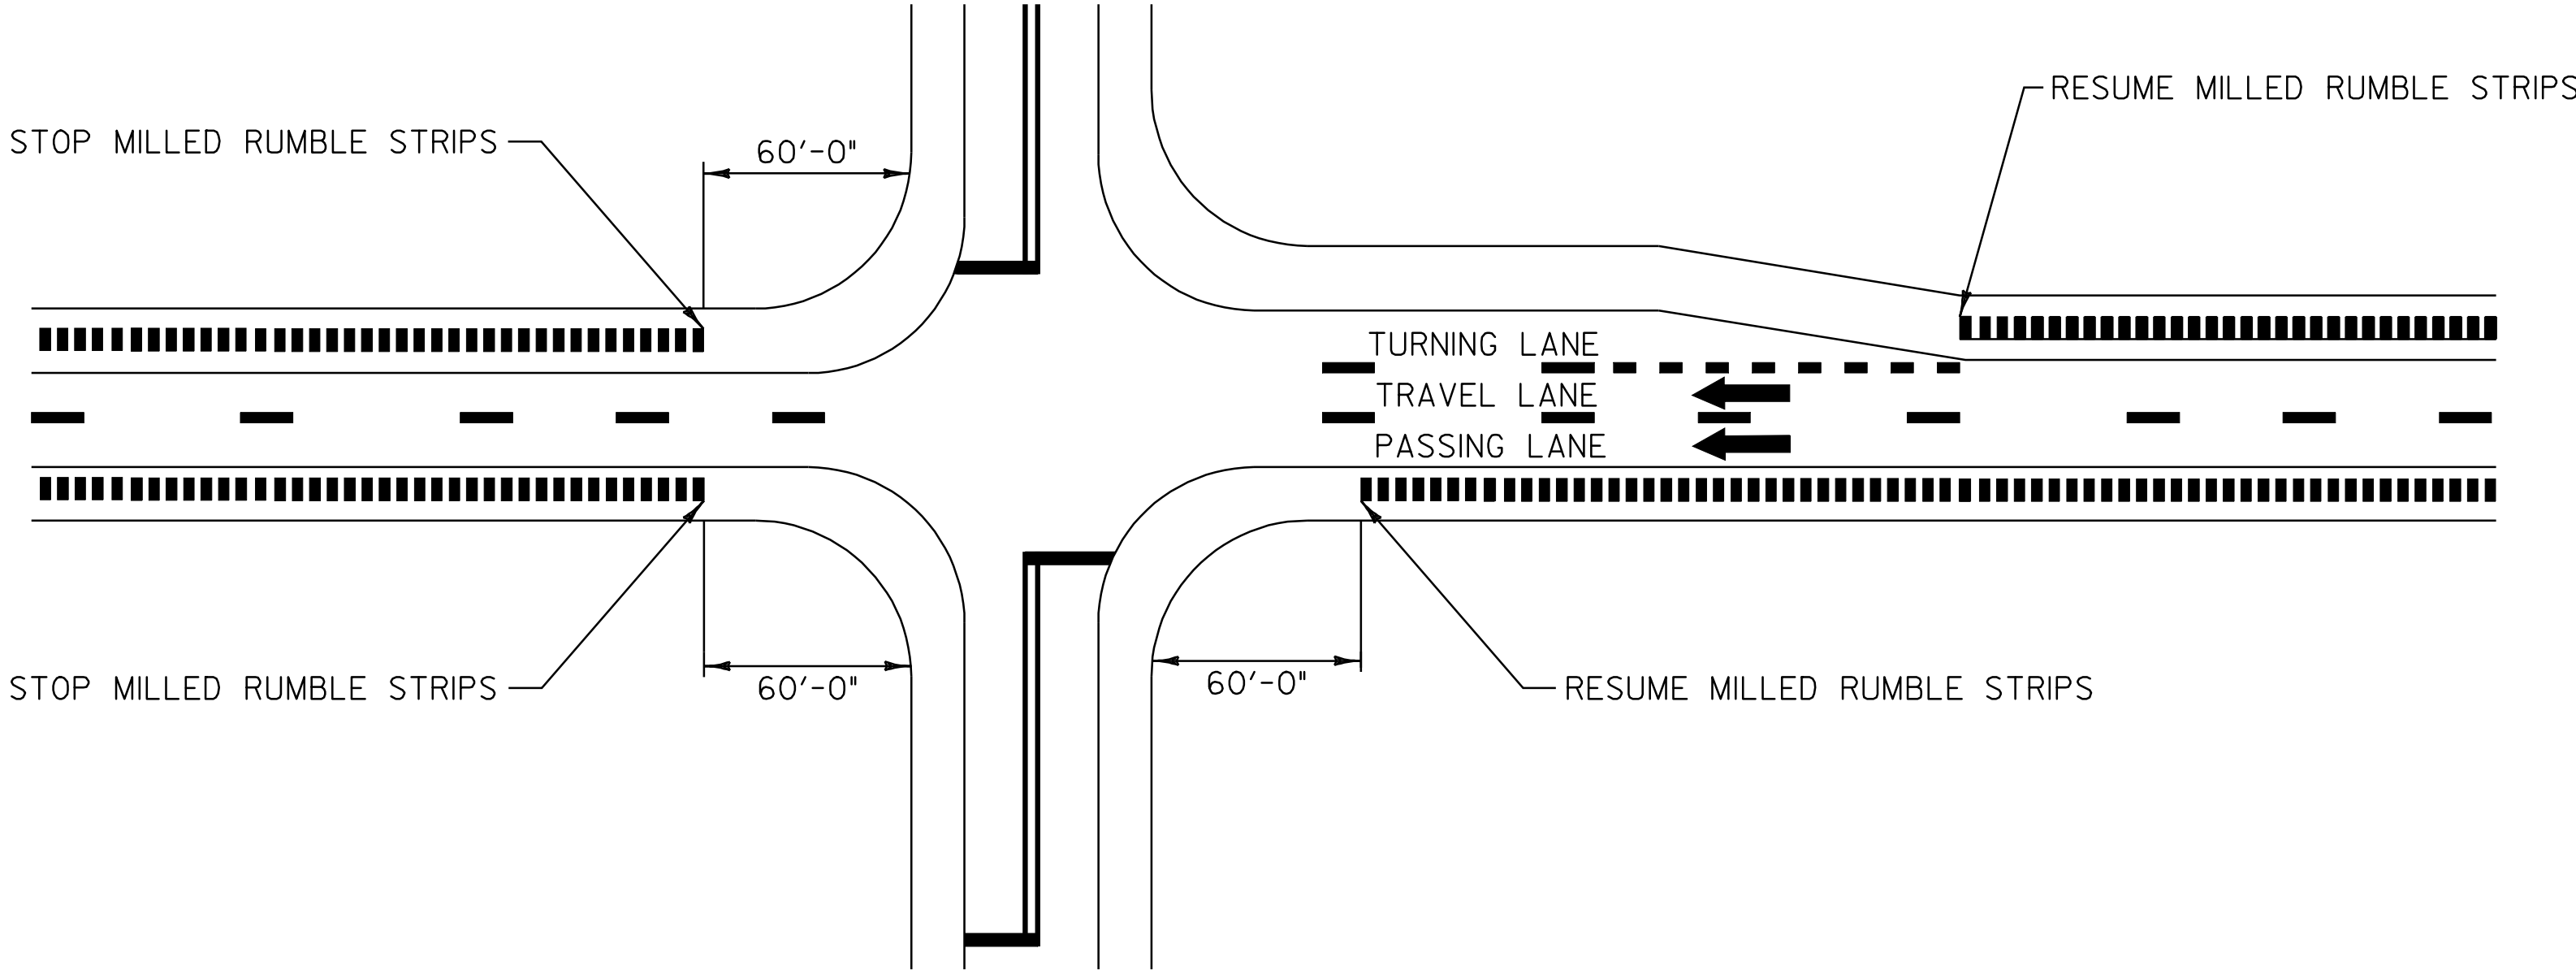**TYPICAL MILLED RUMBLE STRIPS AT  
PARALLEL DECELERATION AND ACCELERATION LANES**



**TYPICAL MILLED RUMBLE STRIPS  
AT INTERSECTIONS**

NOTE:  
1. THIS TYPICAL MAY BE MODIFIED AT THE DISCRETION OF THE RESIDENT  
ENGINEER IF ACTUAL FIELD CONDITIONS NECESSITATE SUCH ACTIONS.


**LEGEND**

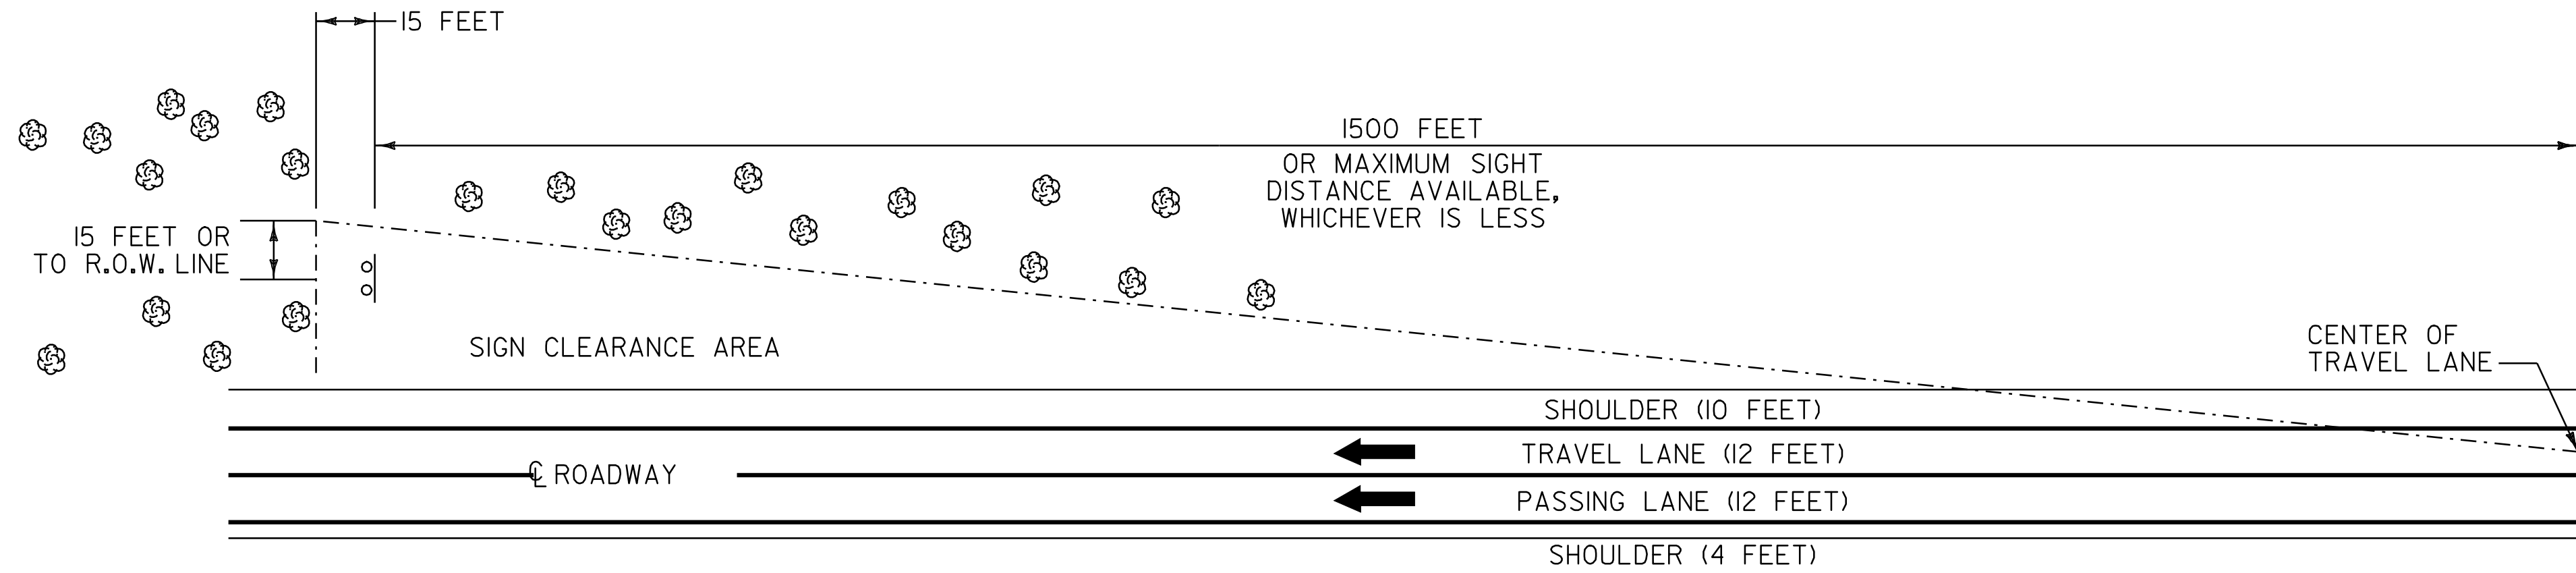← DIRECTION OF TRAFFIC FLOW

..... MILLED RUMBLE STRIPS

|                                              |                                          |                     |
|----------------------------------------------|------------------------------------------|---------------------|
| MILLED<br>RUMBLE<br>STRIP DETAIL<br>SHEET #2 | PROJECT NAME: WALLINGFORD - RUTLAND TOWN |                     |
|                                              | PROJECT NUMBER: NH 2408(I)S              |                     |
|                                              | FILE NAME: p04b050.dgn                   | PLOT DATE: \$DATE\$ |
|                                              | PROJECT LEADER: D.E.G.                   | DRAWN BY: C.A.K.    |
|                                              | DESIGNED BY: J.S.P.                      | CHECKED BY: D.E.G.  |
|                                              | IPARM FILE: p04b050rsd2.i                | SHEET 78 OF 80      |





### THINNING AND TRIMMING DETAIL

SIGN LOCATIONS:

CLARENDON STA. 104+00.0, LT  
CLARENDON STA. 148+32.0, LT

#### NOTE:

THE CONTRACTOR SHALL REMOVE ALL WOODY STEMMED GROWTH INCLUDING BRUSH, SAPLINGS AND TREE LIMBS GROWING WITHIN OR PROJECTING INTO THE CLEARANCE AREA DOWN TO GROUND LEVEL OR AT LEAST 10 FEET BELOW THE BOTTOM OF THE SIGN, WHICHEVER IS LESS. PAYMENT WILL BE FOR ITEM 201.31 THINNING AND TRIMMING AND WILL BE PAID FOR PER EACH SIGN INSTALLATION. NO CHEMICALS SUCH AS POISONS OR DEFOLIANTS WILL BE ALLOWED.

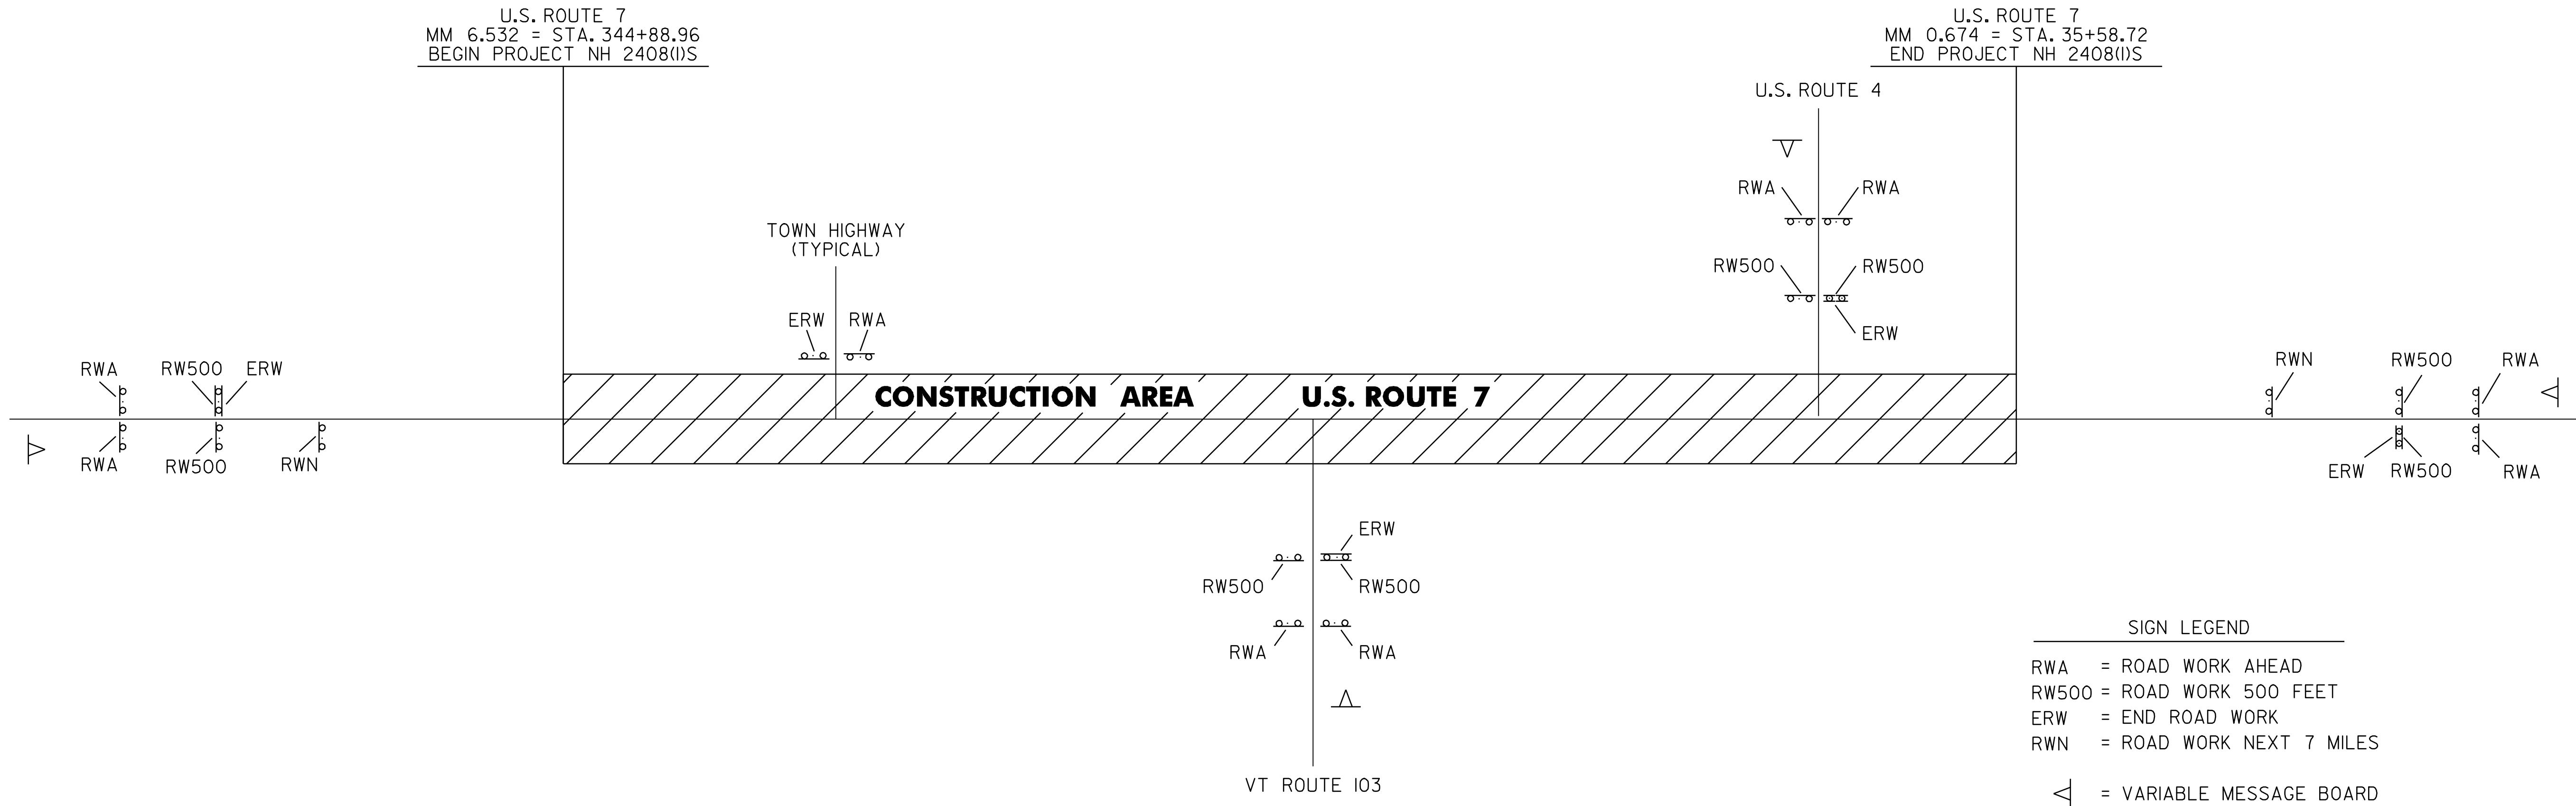
MISCELLANEOUS  
DETAIL  
SHEET

PROJECT NAME: WALLINGFORD - RUTLAND TOWN  
PROJECT NUMBER: NH 2408(I)S

FILE NAME: p04b050.dgn  
PROJECT LEADER: D.E.G.  
DESIGNED BY: J.S.P.  
IPARM FILE: p04b050md.i

PLOT DATE: \$DATE\$  
DRAWN BY: C.A.K.  
CHECKED BY: D.E.G.  
SHEET 79 OF 80





CONSTRUCTION APPROACH SIGNING

NOTES:

- SEE VAOT STD. E-100 FOR ADDITIONAL SIGN PLACEMENT.
- CONSTRUCTION ZONE SIGN LAYOUT SHALL BE IN ACCORDANCE WITH SECTION 6 OF THE LATEST EDITION OF THE MANUAL OF UNIFORM TRAFFIC CONTROL DEVICES (MUTCD).
- CONSTRUCTION SIGNS SHALL BE IN NEW OR LIKE NEW CONDITION PER VAOT STANDARDS.
- DIAMOND SHAPED SIGNS SHALL BE 4' X 4' WITH BLACK LEGEND ON FLUORESCENT ORANGE BACKGROUND.
- REFLECTIVE SHEETING SHALL BE TYPE VII OR BETTER.
- CONSTRUCTION ZONE SIGNS SHALL BE INSTALLED ON TWO POSTS EACH OR AS AN NCHRP REPORT 350 COMPLIANT SIGN/STAND SYSTEM.
- VARIABLE MESSAGE BOARDS ARE OPTIONAL AND ARE TO BE USED AS DIRECTED BY THE RESIDENT ENGINEER.

| HIGHWAY NAME               | RWA | ERW | RW500 | RWN | OTHER                 |
|----------------------------|-----|-----|-------|-----|-----------------------|
| U.S. ROUTE 7-BEGIN PROJECT | 2   | 1   | 2     | 1   | I-VAR. MESSAGE BOARD  |
| VT. ROUTE 7B               | 2   | 1   | 2     |     |                       |
| BUMP ROAD (T-26)           | 1   | 1   |       |     |                       |
| MIDDLE ROAD (T-1)          | 1   | 1   |       |     |                       |
| VT. ROUTE 7B               | 2   | 1   | 2     |     |                       |
| CROSSROAD ROAD (T-19)      | 1   | 1   |       |     |                       |
| VT. ROUTE 103              | 2   | 1   | 2     |     | I-VAR. MESSAGE BOARD  |
| VT. ROUTE 7B               | 2   | 1   | 2     |     |                       |
| N. SHREWSBURY ROAD (T-4)   | 2   | 2   | 2     |     |                       |
| VT. ROUTE 7B               | 4   | 2   | 4     |     |                       |
| MIDDLE ROAD (T-3)          | 1   | 1   |       |     |                       |
| WIND CREST ROAD (T-35)     | 1   | 1   |       |     |                       |
| U.S. ROUTE 4               | 2   | 1   | 2     |     | I-VAR. MESSAGE BOARD  |
| DIAMOND RUN MALL PLACE     | 1   | 1   |       |     |                       |
| U.S. ROUTE 7-END PROJECT   | 2   | 1   | 2     | 1   | I-VAR. MESSAGE BOARD  |
| TOTAL                      | 26  | 17  | 20    | 2   | 4-VAR. MESSAGE BOARDS |

CONSTRUCTION  
APPROACH  
SIGNING  
DETAIL SHEET

|                                          |                     |
|------------------------------------------|---------------------|
| PROJECT NAME: WALLINGFORD - RUTLAND TOWN |                     |
| PROJECT NUMBER: NH 2408(I)S              |                     |
| FILE NAME: p04b050.dgn                   | PLOT DATE: \$DATE\$ |
| PROJECT LEADER: D.E.G.                   | DRAWN BY: C.A.K.    |
| DESIGNED BY: J.S.P.                      | CHECKED BY: D.E.G.  |
| IPARM FILE: p04b050cas.i                 | SHEET 80 OF 80      |