

SEE NEXT SHEET FOR INDEX OF SHEETS

STATE OF VERMONT AGENCY OF TRANSPORTATION




PROPOSED IMPROVEMENT BRIDGE PROJECT TOWN OF JAY COUNTY OF ORLEANS

ROUTE NO : VT 105 (MINOR ARTERIAL) BRIDGE # 50

PROJECT LOCATION
BEGINNING AT A POINT ON VT. ROUTE 105 APPROXIMATELY 6.15 MILES EASTERLY
OF THE RICHFORD / JAY TOWN LINE AND EXTENDING EASTERLY FOR 0.007 MILES.

PROJECT DESCRIPTION
CONSTRUCTION OF A NEW BOX CULVERT ON THE EXISTING ALIGNMENT
WITH NECESSARY ROADWAY APPROACHES AND CHANNEL WORK.

LENGTH OF STRUCTURE : 17.00 FEET 0.0032 MILES
LENGTH OF ROADWAY : 19.00 FEET 0.0036 MILES
LENGTH OF PROJECT : 36.00 FEET 0.0068 MILES

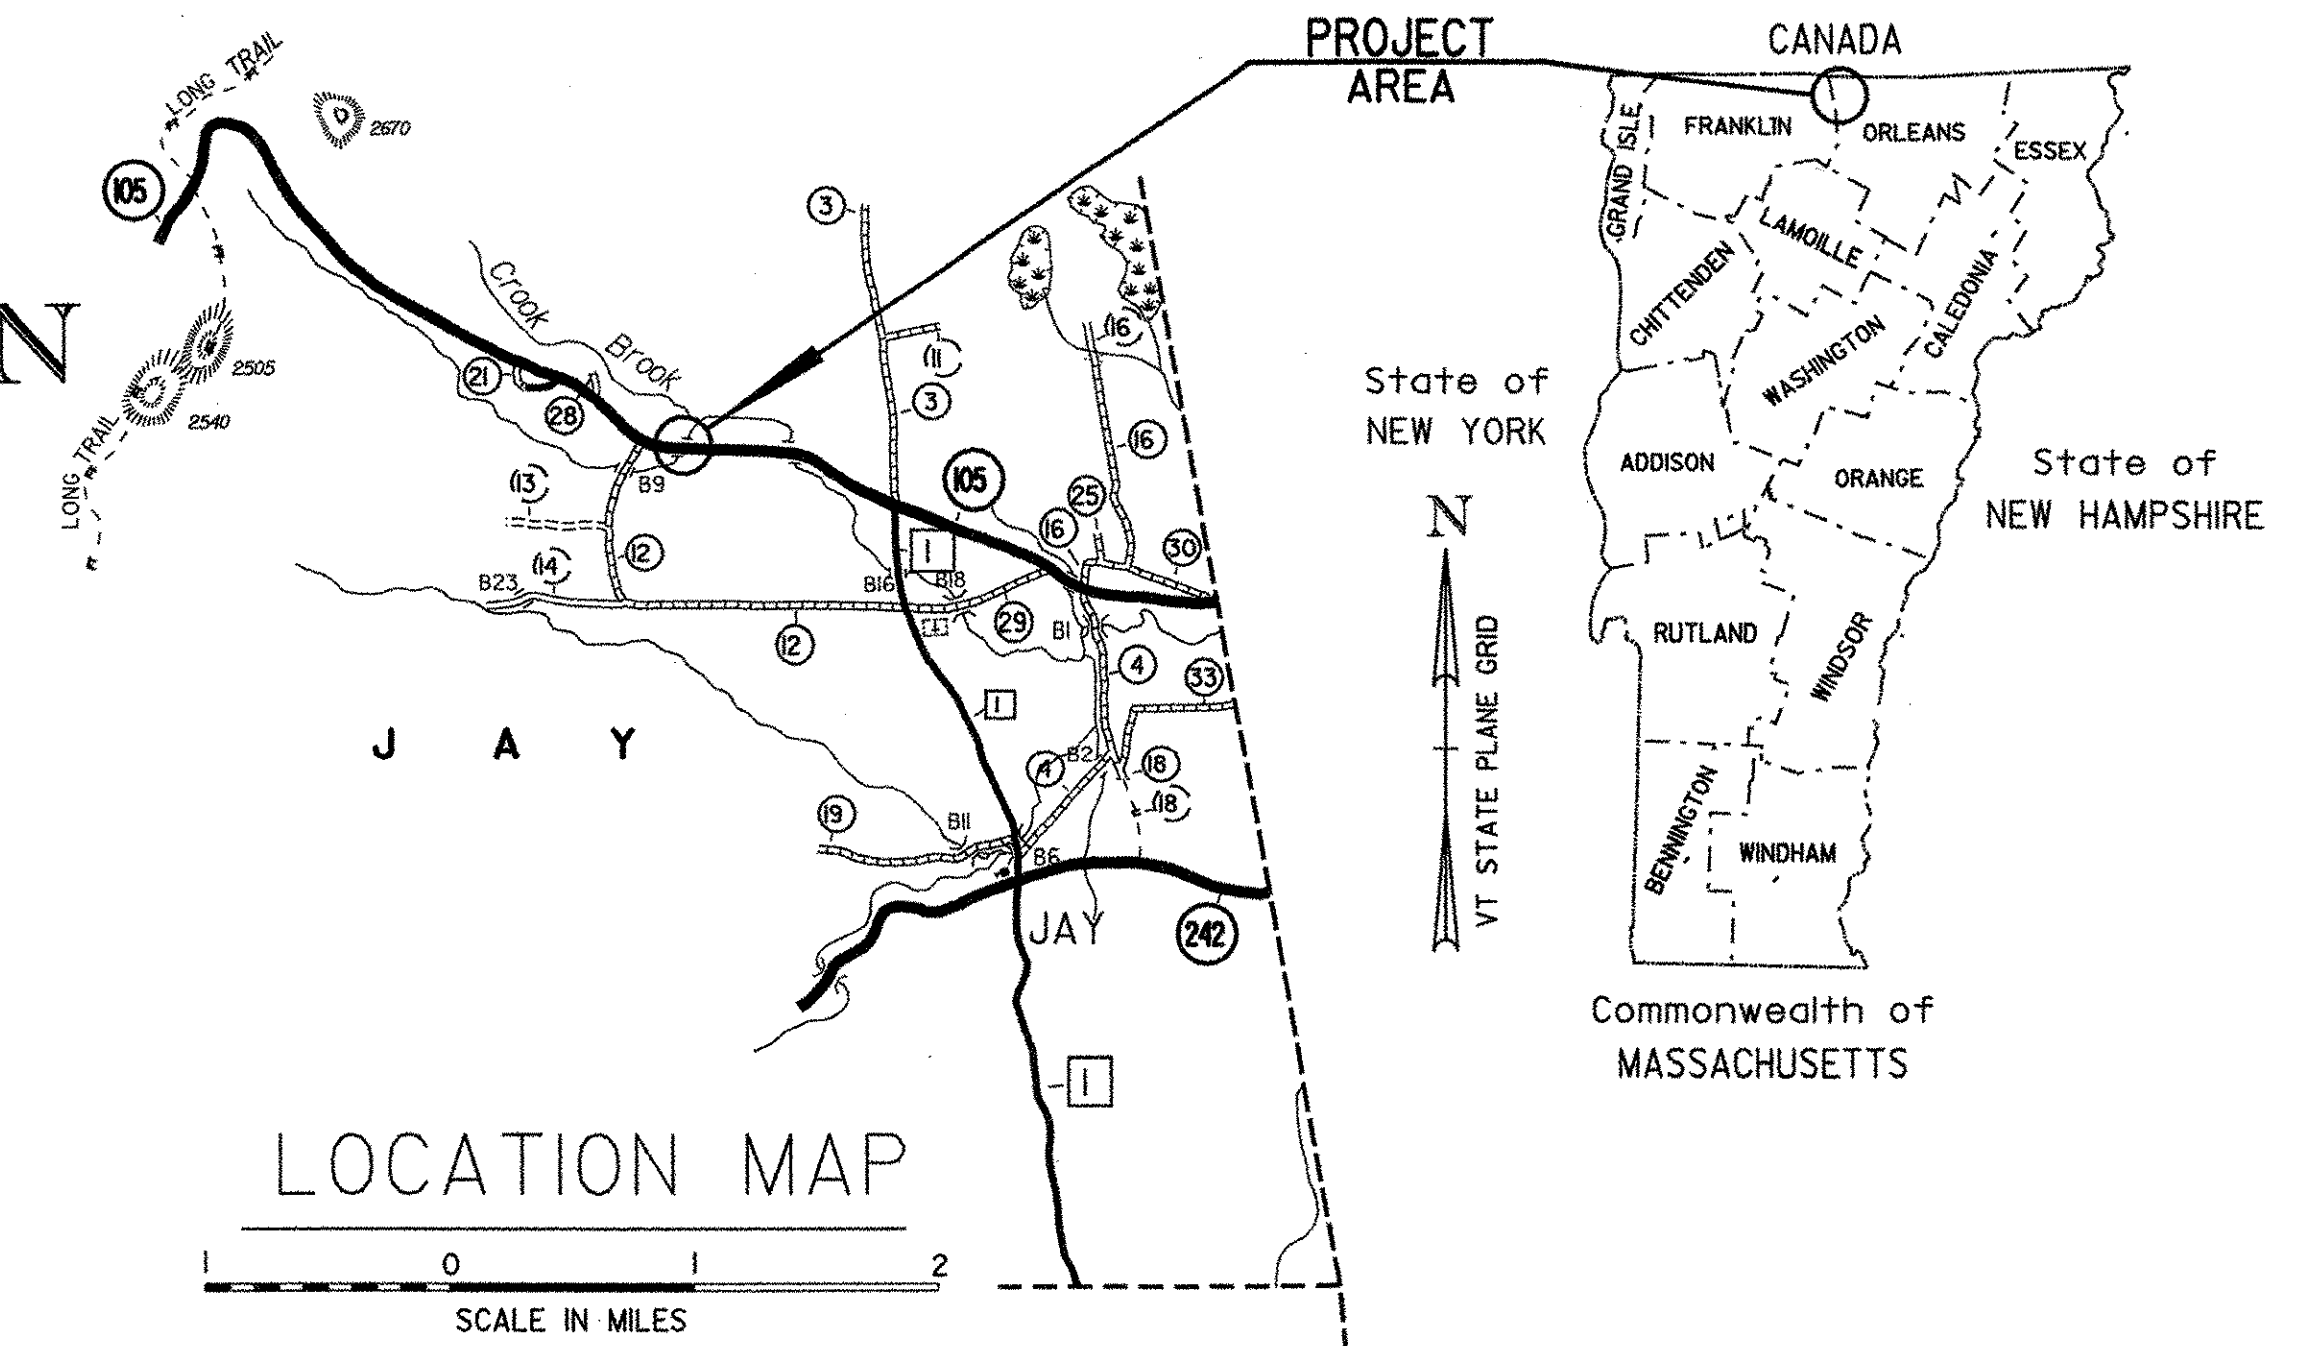


RECORD PLANS	
CONTRACTOR:	S.D. IRELAND BROTHERS CORP. - BURLINGTON, VT
RESIDENT ENGINEER:	DOUG BUMPS
CONSTRUCTION BEGAN:	JULY 16, 2007
CONSTRUCTION COMPLETE:	AUGUST 1, 2007
RECORD PLANS BY:	DOUG BUMPS & CHIP PIERCE
I HEREBY CERTIFY THAT ALL THE CONSTRUCTION REQUIRED BY THIS SET OF DRAWINGS HAS BEEN ACCOMPLISHED AS INDICATED HEREIN.	
BY	<i>[Signature]</i> RESIDENT ENGINEER
DATE	3/5/08
NOTE: Any further information concerning final quantities, amounts or other details relative to this project may be found at Central Files in the electronic archives.	

CONVENTIONAL SYMBOLS	
COUNTY LINE	
TOWN LINE	
LIMITS OF ACCESS	
POINT OF ACCESS	
FENCE LINE	
STONE WALL	
TRAVELED WAY	
GUARD RAIL	
RAILROAD	
SURVEY LINE	
CULVERT	
POWER POLE	
TELEPHONE POLE	
TREES	
CONTROL OF ACCESS	
PROPERTY LINE	
R.O.W. TAKING LINE	
SLOPE RIGHTS	
TOP OF CUT	
TOE OF SLOPE	

SURVEYED BY : R. GILMAN
SURVEYED DATE : NOVEMBER 2004

DATUM
VERTICAL ASSUMED
HORIZONTAL ASSUMED

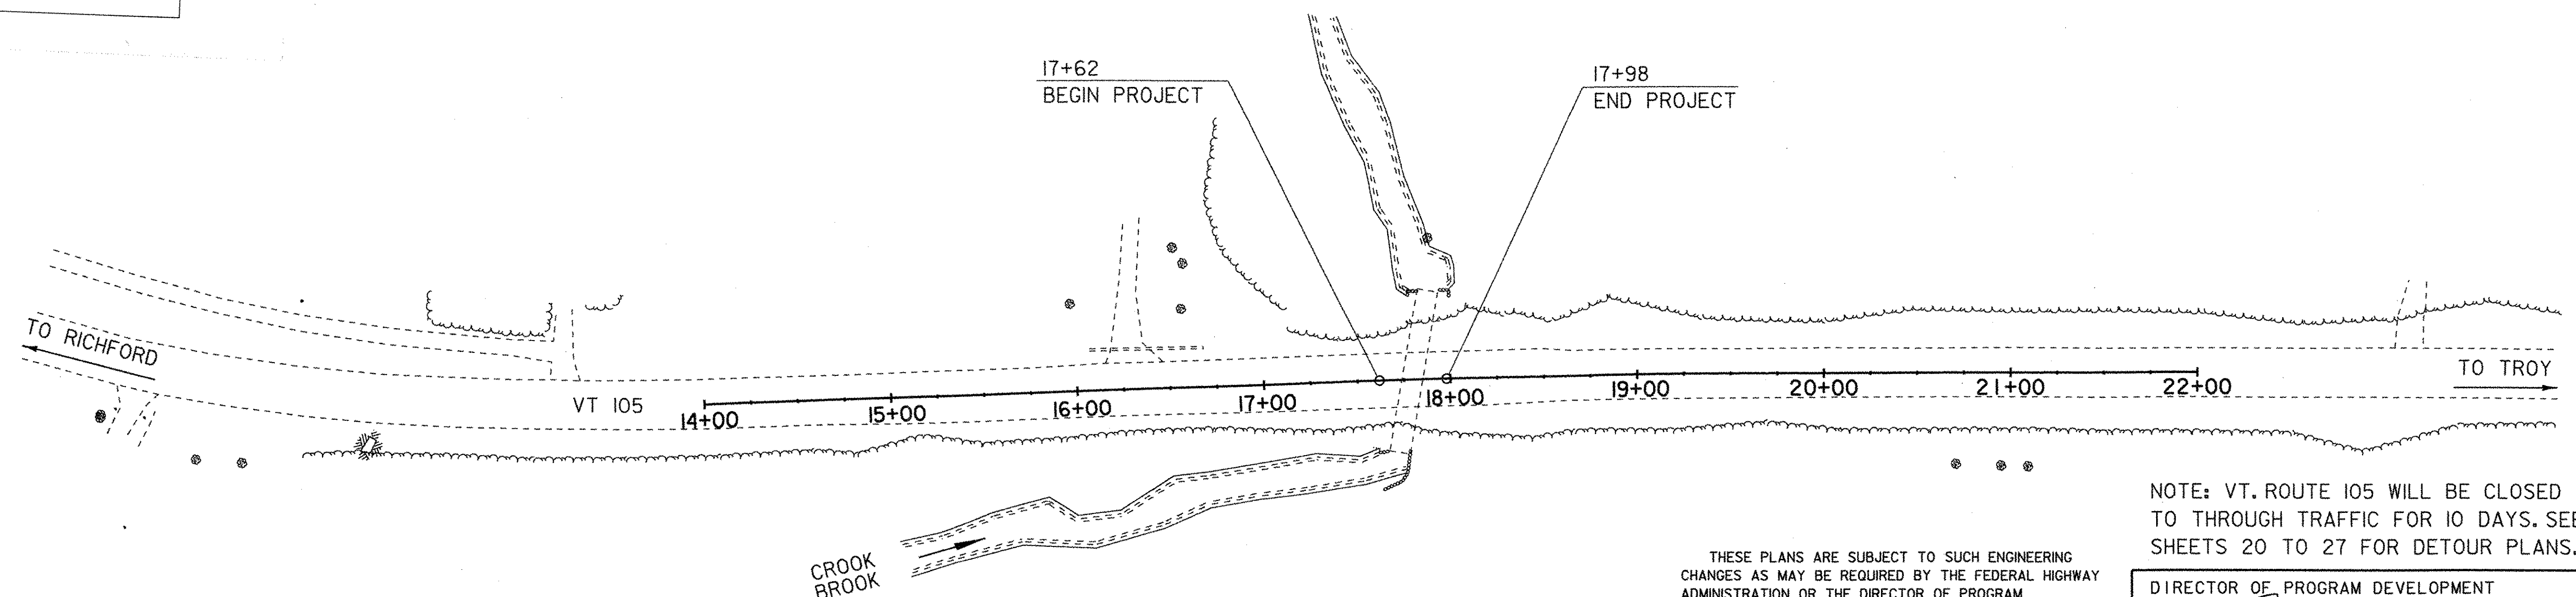

0 50 100
SCALE

THESE PLANS ARE SUBJECT TO SUCH ENGINEERING CHANGES AS MAY BE REQUIRED BY THE FEDERAL HIGHWAY ADMINISTRATION OR THE DIRECTOR OF PROGRAM DEVELOPMENT.
CONSTRUCTION IS TO BE CARRIED ON IN ACCORDANCE WITH THESE PLANS AND THE STANDARD SPECIFICATIONS FOR CONSTRUCTION DATED 2006, AS APPROVED BY THE FEDERAL HIGHWAY ADMINISTRATION ON JUNE 15, 2006 FOR USE ON THIS PROJECT, INCLUDING ALL SUBSEQUENT REVISIONS AND SUCH REVISED SPECIFICATIONS AND SPECIAL PROVISIONS AS ARE INCORPORATED IN THESE PLANS.

NOTE: VT. ROUTE 105 WILL BE CLOSED TO THROUGH TRAFFIC FOR 10 DAYS. SEE SHEETS 20 TO 27 FOR DETOUR PLANS.

DIRECTOR OF PROGRAM DEVELOPMENT
APPROVED *[Signature]* DATE 10-3-06

PROJECT MANAGER : W. SYMONDS

PROJECT NAME : JAY
PROJECT NUMBER : ST STP CULV (2)

SHEET 1 OF 39 SHEETS

02-OCT-2006 04bl40title.1

PRELIMINARY INFORMATION SHEET

INDEX OF SHEETS

1.

TITLE SHEET
2.

PRELIMINARY INFORMATION SHEET
3.

TYPICAL SECTIONS SHEET
4.

TIE SHEET
- 5.-6.

QUANTITY SHEETS
7.

PLAN SHEET
8.

PROFILE AND MATERIAL TRANSITIONS SHEET
- 9.-10.

BLANK
11. -12.

EROSION CONTROL NARRATIVE SHEETS
13. - 15.

EROSION CONTROL PLAN SHEETS
16. - 19.

EROSION CONTROL DETAIL SHEETS
20. - 27.

DETOUR SHEETS
28.

BORING INFORMATION SHEET
29.

BORING LOG SHEET
30.

GENERAL NOTES
31.

BOX LAYOUT SHEET
32.

PLAN & ELEVATION SHEET
- 33.-35.

MAINLINE CROSS SECTION SHEETS
- 36.-39.

CHANNEL CROSS SECTION SHEETS

STANDARDS

B-5 6/1/1994

D-3 6/1/1994

E-100 1/2/2004
E-100A 1/2/2004
E-101 5/30/2003
E-102 6/30/2003
E-102A 5/1/2004
E-107A 8/8/1995
E-127 8/8/1995
E-136A 8/8/1995
E-136B 8/8/1995
E-160 5/20/1999
E-161 8/18/1995
E-163 5/20/1999
E-164 5/20/1999

G-1 1/3/2000

G-1D 1/3/2000
G-19 11/15/2002

FINAL HYDRAULIC REPORT

HYDROLOGIC DATA

Date: March 11, 2005

DRAINAGE AREA : 1.5 sq. mi.

CHARACTER OF TERRAIN : Hilly to mountainous, mostly forested.

STREAM CHARACTERISTICS : Moderately steep, mostly stable with some bank erosion.

NATURE OF STREAMBED : Mostly cobbles and gravel.

PEAK FLOW DATA

Q 2.33 = 95 cfs

Q 50 = 310 cfs

Q 10 = 200 cfs

Q 100 = 360 cfs

Q 25 = 260 cfs

Q 500 = 500 cfs

DATE OF FLOOD OF RECORD : Unknown

ESTIMATED DISCHARGE: Unknown

WATER SURFACE ELEV.: Unknown

NATURAL STREAM VELOCITY : @ Q50 = 10.3 fps

ICE CONDITIONS : Moderate

DEBRIS: Moderate

DOES THE STREAM REACH MAXIMUM HIGHWATER ELEV. RAPIDLY? Yes

IS ORDINARY RISE RAPID? Yes

IS STAGE AFFECTED BY UPSTREAM OR DOWNSTREAM CONDITIONS? No

IF YES, DESCRIBE:

WATERSHED STORAGE: 1%

HEADWATERS:

UNIFORM: X

IMMEDIATELY ABOVE SITE:

EXISTING STRUCTURE INFORMATION

STRUCTURE TYPE: 10'-8" X 6'-11" CGMPPA

YEAR BUILT: 1955

CLEAR SPAN(NORMAL TO STREAM): 10'-8"

VERTICAL CLEARANCE ABOVE STREAMBED: 6'-11"

WATERWAY OF FULL OPENING: 58 sq. ft.

DISPOSITION OF STRUCTURE: Remove

TYPE OF MATERIAL UNDER SUBSTRUCTURE: Unknown

WATER SURFACE ELEVATIONS AT:

Q2.33 = 1244.0'

Q10 = 1246.2'

Q25 = 1247.0'

Q50 = 1247.6'

Q100 = 1248.4'

VELOCITY = 9.3 fps

" 11.8 fps

" 12.8 fps

" 13.5 fps

" 14.1 fps

LONG TERM STREAMBED CHANGES: Probable streambed degradation downstream.

Scour hole at outlet.

IS THE ROADWAY OVERTOPPED BELOW Q100: No

FREQUENCY: Above Q100

RELIEF ELEVATION: 1249.5'

DISCHARGE OVER ROAD @Q100: None

UPSTREAM STRUCTURE

TOWN: Jay

DISTANCE: 1,300'

HIGHWAY #: T.H. 12

STRUCTURE #: 9

CLEAR SPAN: 8'

CLEAR HEIGHT: 9'

YEAR BUILT: Unknown

FULL WATERWAY: 72 sq. ft.

STRUCTURE TYPE: Bridge

DOWNSTREAM STRUCTURE

TOWN: Jay

DISTANCE: 2,800'

HIGHWAY #: VT 105

STRUCTURE #: 51

CLEAR SPAN: 15'-10"

CLEAR HEIGHT: 9'-10"

YEAR BUILT: 1955

FULL WATERWAY: 122 sq. ft.

STRUCTURE TYPE: CGMPPA

TRAFFIC DATA					
YEAR	ADT	DHV	% D	% T	ADTT
2005	610	130	60	21	120
2025	790	140	60	29	210
20 year ESAL for flexible pavement from 2006 to 2026 : 1,240,000					
40 year ESAL for flexible pavement from 2006 to 2046 : 3,110,000					
Design Speed : 50 mph					

PROPOSED STRUCTURE

STRUCTURE TYPE: Precast concrete box with stone fill in the bottom.

CLEAR SPAN(NORMAL TO STREAM): 15'

VERTICAL CLEARANCE ABOVE STREAMBED: 6' maximum to 4.7' minimum

WATERWAY OF FULL OPENING: 81 sq. ft.

WATER SURFACE ELEVATIONS AT:

Q2.33 = 1244.0'

Q10 = 1245.8'

Q25 = 1246.2'

Q50 = 1246.5'

Q100 = 1246.8'

VELOCITY= 8.2 fps

" 7.6 fps

" 8.7 fps

" 9.5 fps

" 10.1 fps

IS THE ROADWAY OVERTOPPED BELOW Q100: No

FREQUENCY: Above Q100

RELIEF ELEVATION: 1249.5'

DISCHARGE OVER ROAD @Q100: None

AVERAGE LOW ELEVATION OF SUPERSTRUCTURE: 1247.2'

VERTICAL CLEARANCE: @ Q50 = 0.7'

SCOUR: NRNA

REQUIRED CHANNEL PROTECTION: Stone Fill, Type III

PERMIT INFORMATION

AVERAGE DAILY FLOW: 3 cfs

ORDINARY LOW WATER: 1 cfs

ORDINARY HIGH WATER: 40 cfs

DEPTH OR ELEVATION: Less than 0.5'

2.0'

TEMPORARY BRIDGE REQUIREMENTS

STRUCTURE TYPE: No temporary bridge required.

CLEAR SPAN (NORMAL TO STREAM):

VERTICAL CLEARANCE ABOVE STREAMBED:

WATERWAY AREA OF FULL OPENING:

ADDITIONAL INFORMATION

DESIGN CRITERIA

1. DESIGN LIVE LOAD AASHTO HS-25

2. DESIGN SPAN 15' CLEAR SPAN

3. ALLOWABLE LOAD FOR SPREAD FOOTINGS ON SOIL ON LEDGE

4. ALLOWABLE LOAD FOR PILING TYPE ESTIMATED LENGTH

5. STRUCTURAL STEEL AASHTO M270MM270 GRADE N/A

6. REINFORCNG STEEL GRADE 60

7. CONCRETE, HIGH PERFORMANCE CLASS A fc: N/A

CONCRETE, HIGH PERFORMANCE CLASS B fc: 3500 psi

8. DESIGN SOIL UNIT WEIGHT 140 pcf

9. DESIGN LOAD FOR SPREAD FOOTINGS ON SOIL

TRAFFIC MAINTENANCE

1. IS TRAFFIC TO BE MAINTAINED? ROAD CLOSED TO THROUGH TRAFFIC *

IF YES, ON EXISTING STRUCTURE? NA

OR ON TEMPORARY BRIDGE? NA

ONE OR TWO-WAY TRAVEL? NA

2. TRAFFIC CONTROL SIGNALS REQUIRED? NA

3. ARE SIDEWALKS REQUIRED? NA

IF SO, ON WHAT SIDE? NA

* SEE SHEETS 20-27 FOR DETOUR PLAN

PROJECT NAME: JAY

PROJECT NUMBER: ST STP CULV (2)

FILE NAME: s04b140pi.xls

PROJECT MANAGER: W. SYMONDS

DESIGNED BY: T. FILLBACH

PRELIMINARY INFORMATION SHEET

PLOT DATE: 10/11/2006

DRAWN BY: G. SHANGRAW

CHECKED BY: T. SUMNER

SHEET 2 OF 39

MATERIAL ITEM	TOLERANCE
PAVEMENT	± 1/4" TOTAL THICKNESS
BASE COURSE	± 1/2"
SUBBASE	± 1"
SAND BORROW	± 1"

3 '' BITUMINOUS CONCRETE PAVEMENT, TYPE III (2 - 1 1/2'' LIFTS) (PG 58-34)
6 '' BITUMINOUS CONCRETE PAVEMENT, TYPE I OR II (2 - 3'' LIFTS) (PG 58-34)
18 '' SUBBASE OF DENSE GRADED CRUSHED STONE
24 '' SAND BORROW

SEEDING FORMULA RURAL AREAS

% WT.	LBS./A.	NAME	PUR %	GERM %
37.5	22.5	CREeping RED FESCUE	98	85
37.5	22.5	TALL FESCUE	95	90
5.0	3.0	RED TOP	95	90
15.0	9.0	BIRDSFOOT TREFOL	98	85
5.0	3.0	ANNUAL RYEGRASS	95	85
100.0	60.0			

GENERAL NOTES




SEED MIXTURE: SHALL NOT HAVE A WEED CONTENT EXCEEDING 0.40% BY WEIGHT AND SHALL BE FREE OF ALL NOXIOUS SEED.

SEED: TO BE APPLIED PER SEEDING FORMULAS OR AS DIRECTED BY THE ENGINEER.

FERTILIZER: FORMULA 10-20-10, TO BE USED WITH SEED, APPLIED AT THE RATE OF 500 LBS./ACRE. (HYDRO SEEDERS MAY USE 19-19-19 FORMULA).

AGRICULTURAL LIMESTONE: TO BE APPLIED AT THE RATE OF 2 TONS/ACRE, OR AS DIRECTED BY THE ENGINEER.

HAY MULCH: TO BE PLACED ON EARTH SLOPES AT THE RATE OF 2 TONS/ACRE, OR AS DIRECTED BY THE ENGINEER.

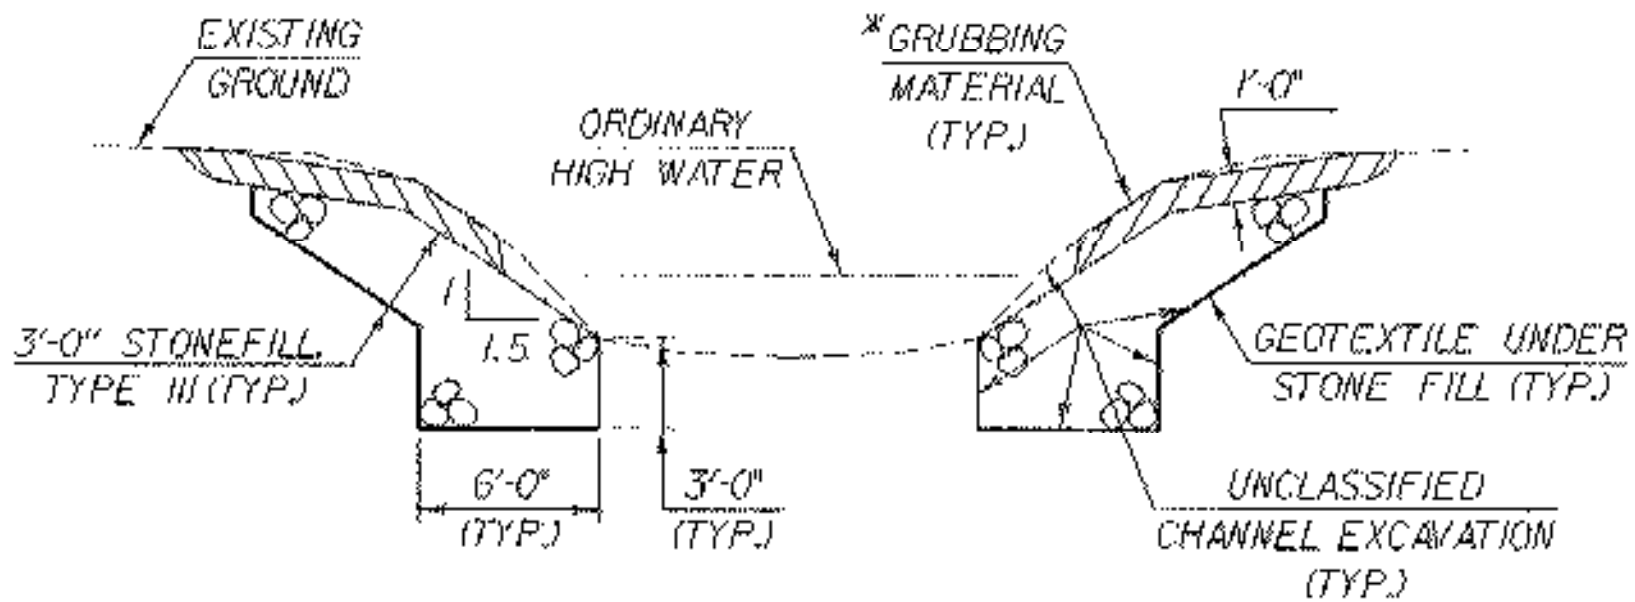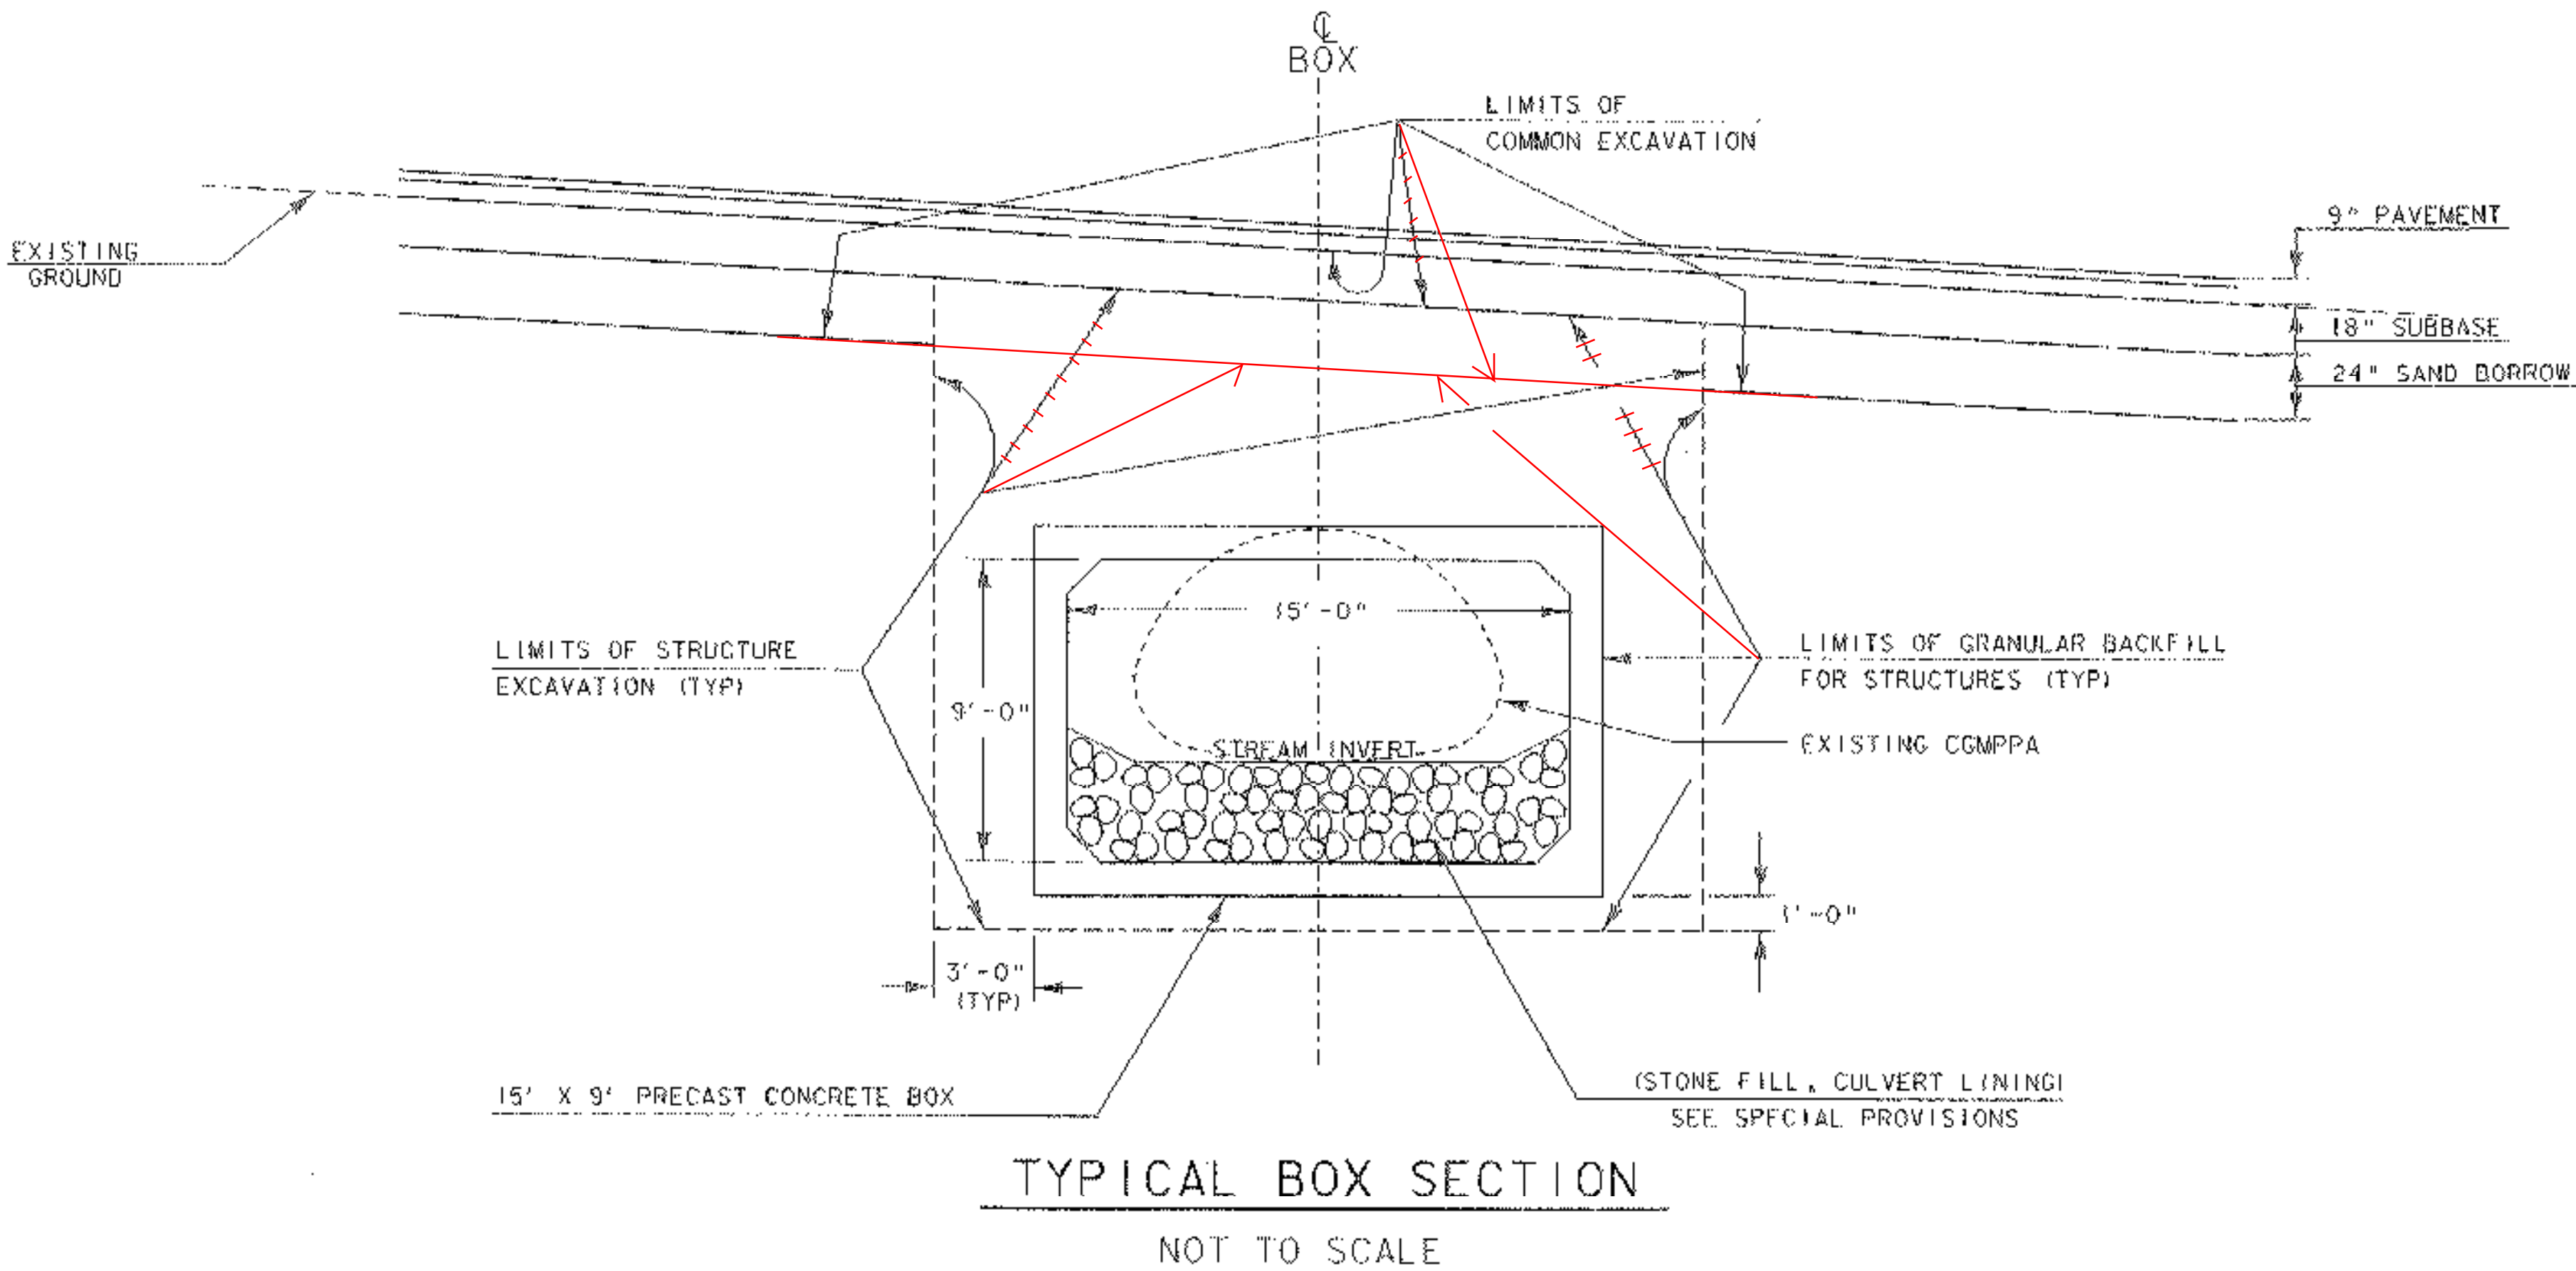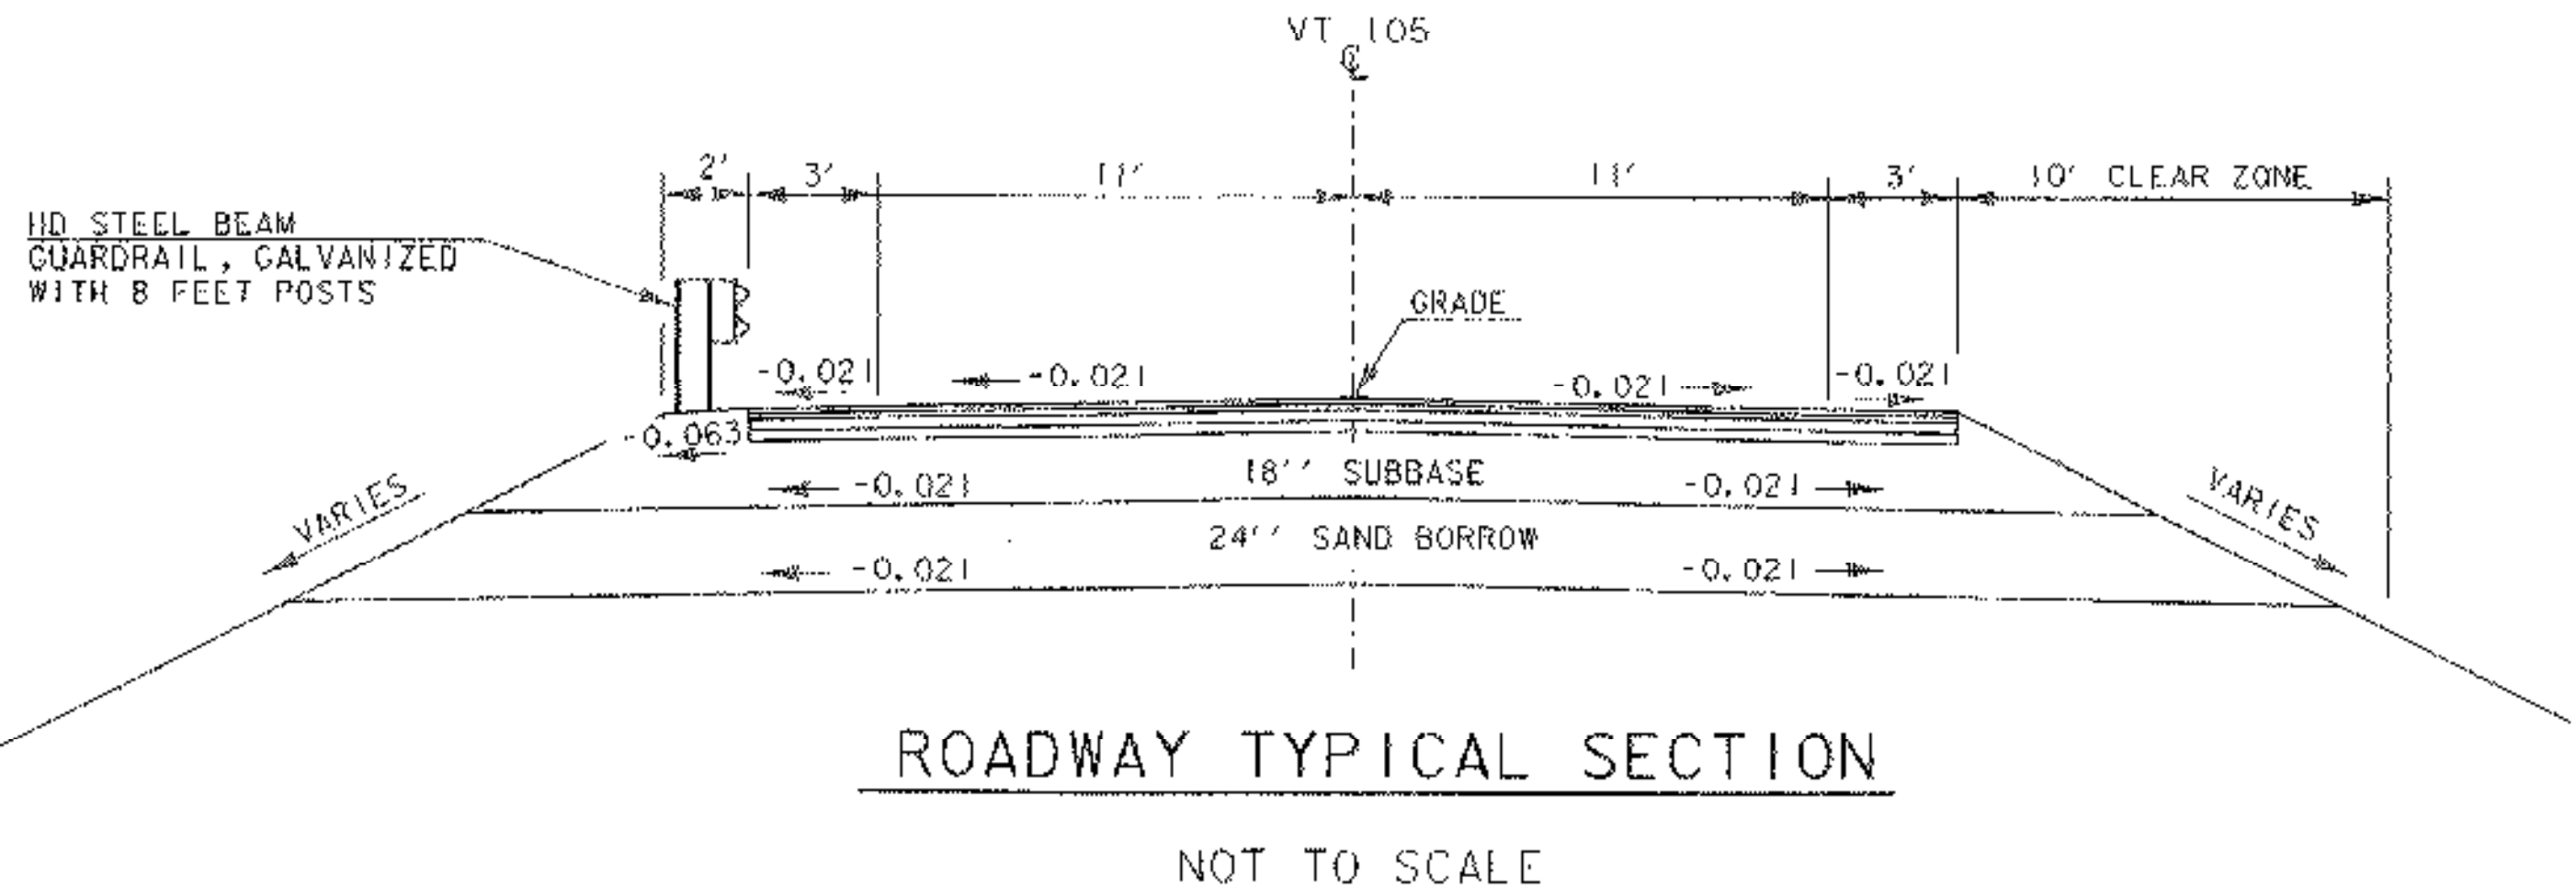



TYPICAL CHANNEL SECTION
(NOT TO SCALE)
*GRUBBING MATERIAL SHALL NOT BE PLACED ON THE STONE FILL IN THE BOX.
WHENEVER CHANNEL SLOPE INTERSECT'S ROADWAY SUBBASE, GRUBBING MATERIAL SHALL BEGIN AT THE BOTTOM OF SUBBASE.

TYPICAL SECTIONS

PROJECT NAME:	JAY
PROJECT NUMBER:	ST STP CULV (2)
FILE NAME:	04b140\so4b140typ.dgn
PROJECT LEADER:	W. SYMONDS
DESIGNED BY:	T. FILLBACH
04b140typ.i	
PLOT DATE:	23-OCT-2006
DRAWN BY:	G. SHANGRAW
CHECKED BY:	T. SUMNER
SHEET	3 OF 39




GPS CONTROL POINTS

TRAVERSE TIES

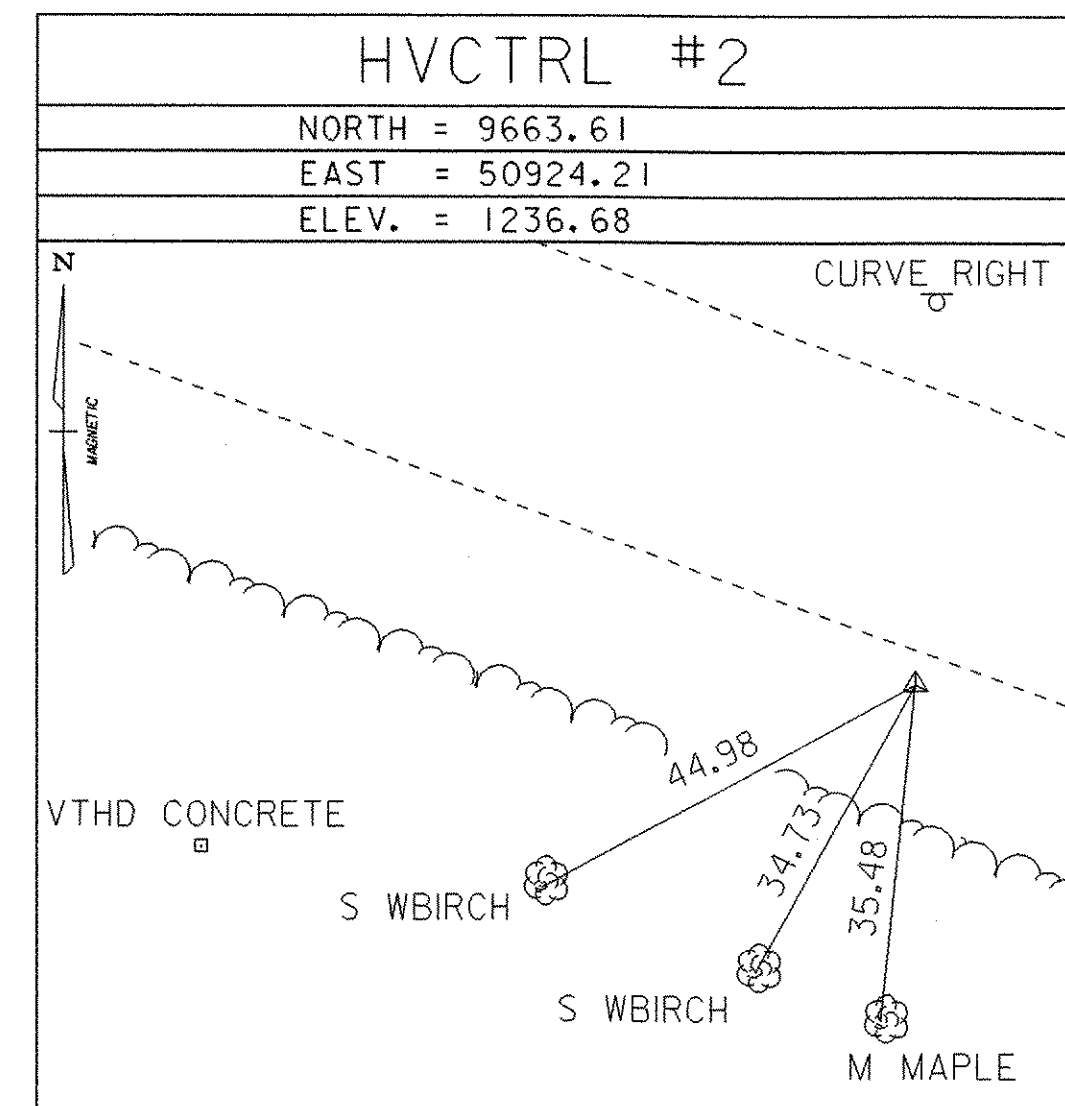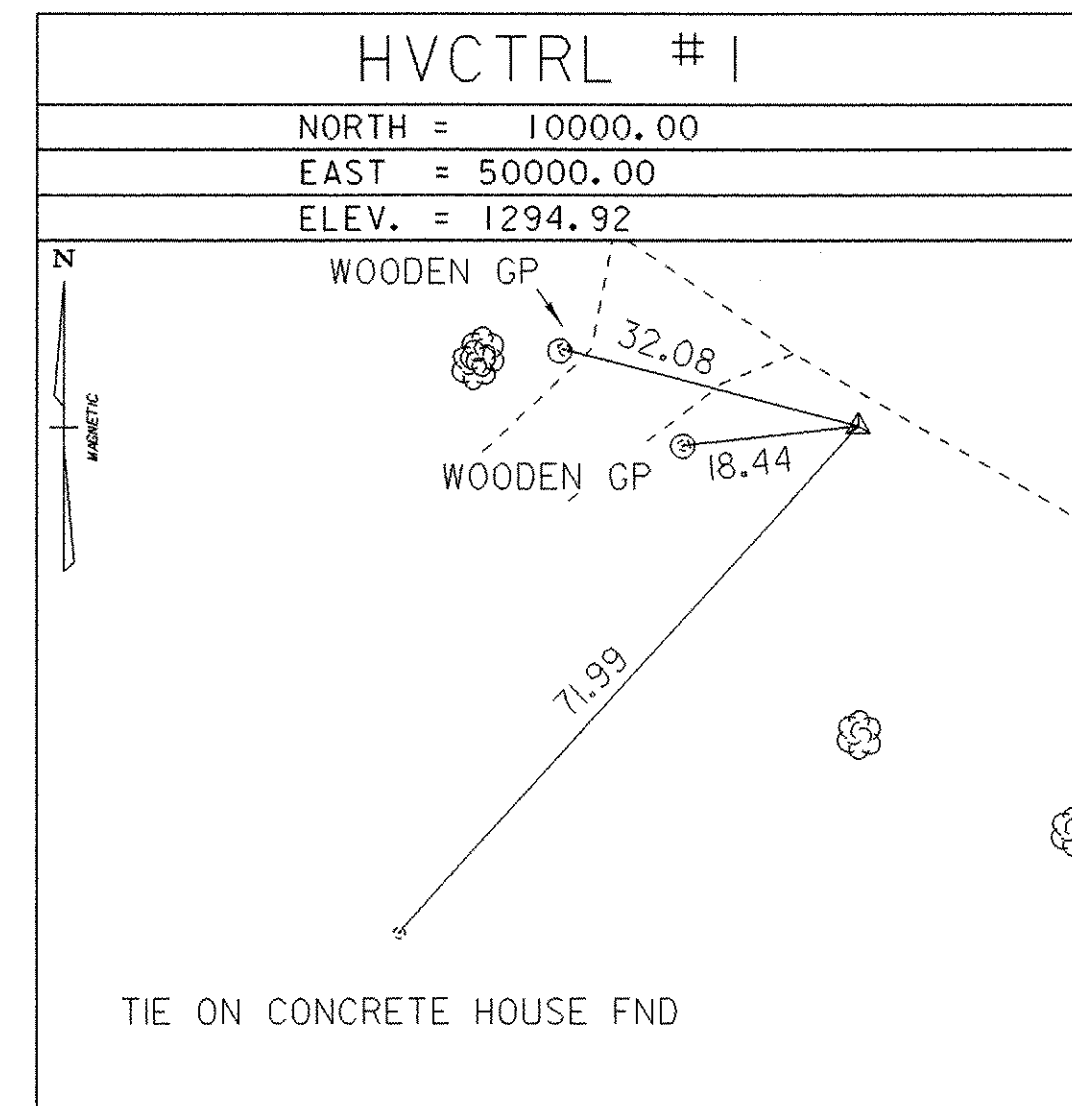

• Traverse Completed 11-08-2004 by R. Gilman P.C. & P. Winters

ALIGNMENT TIES

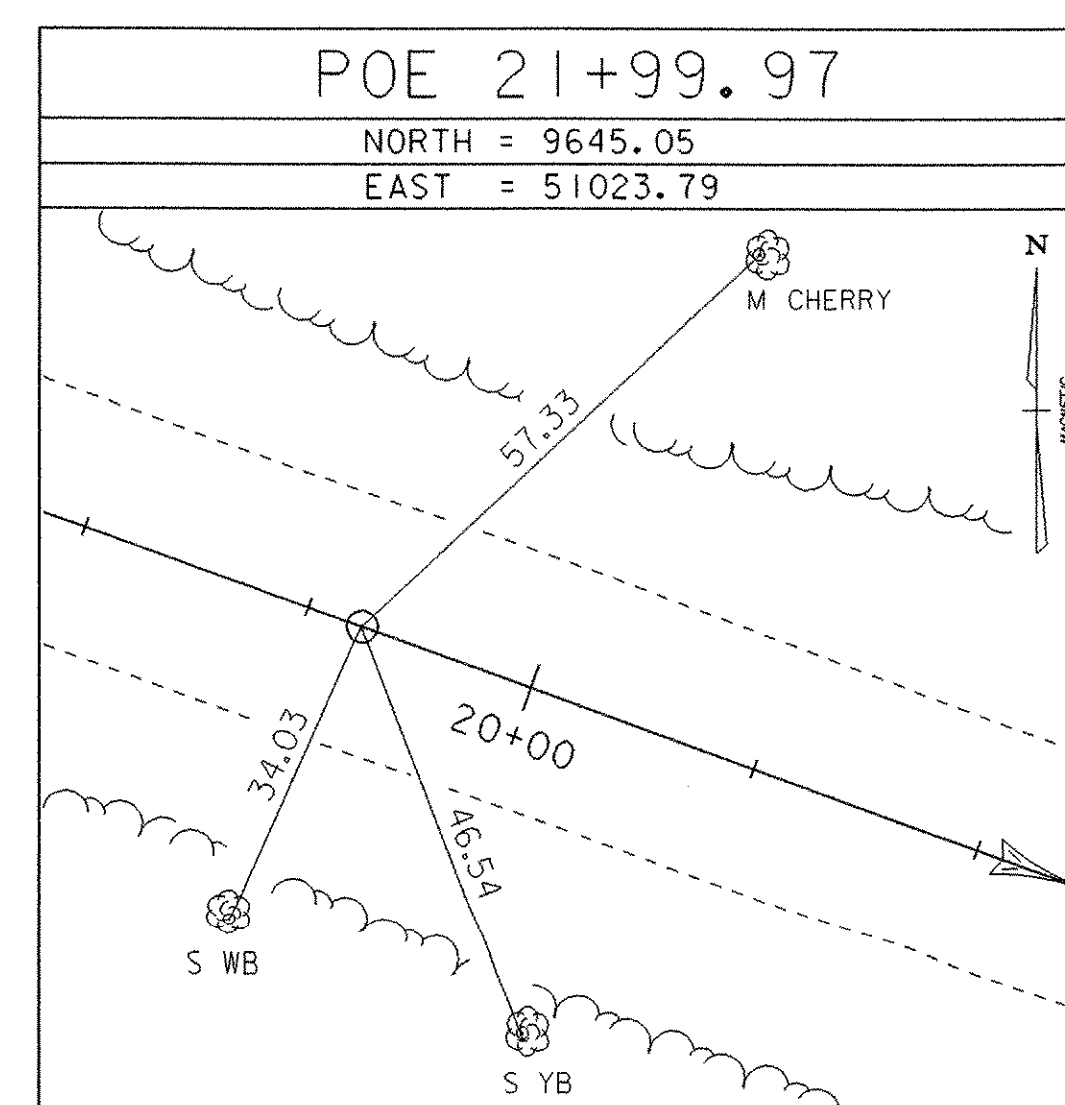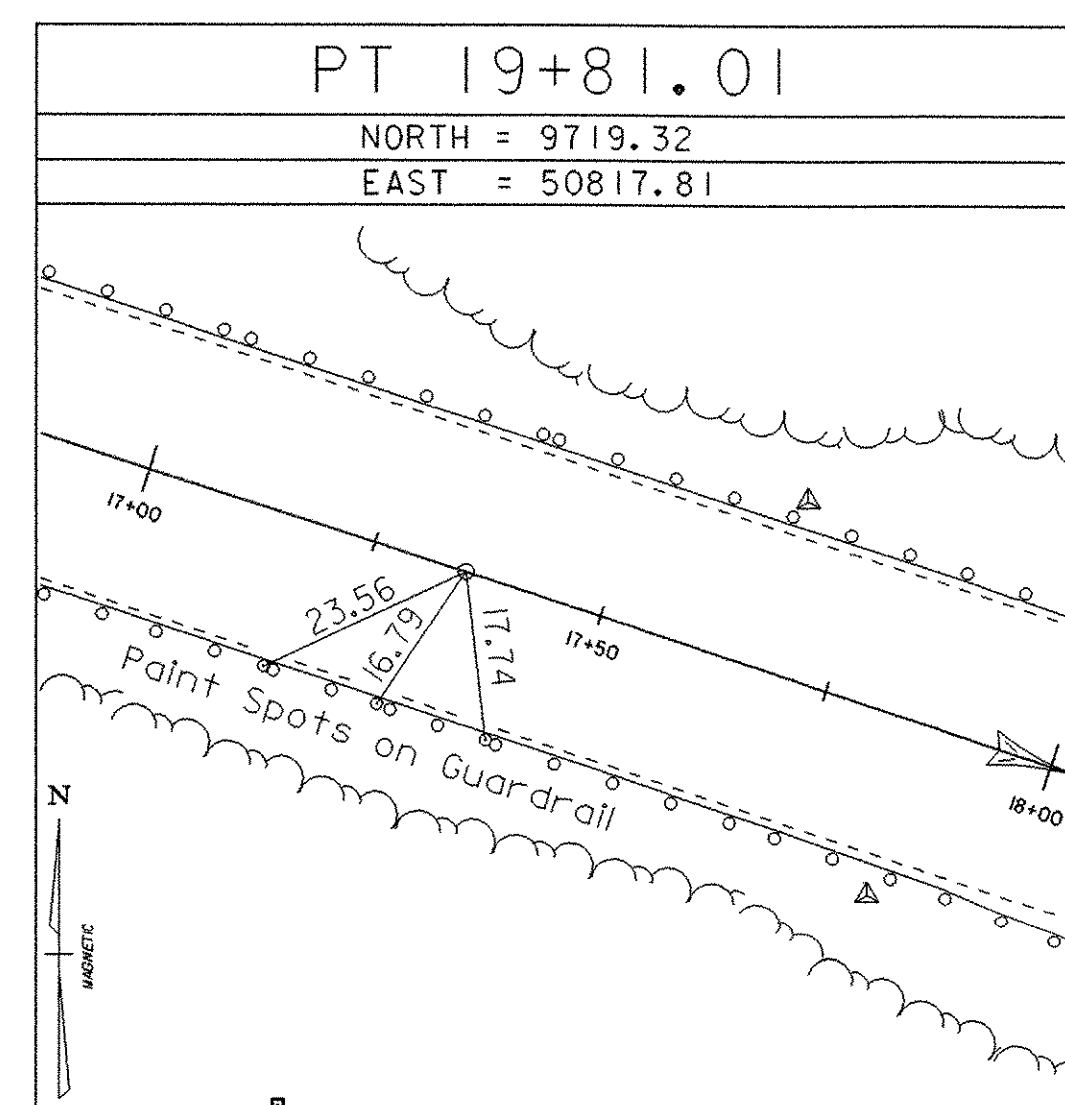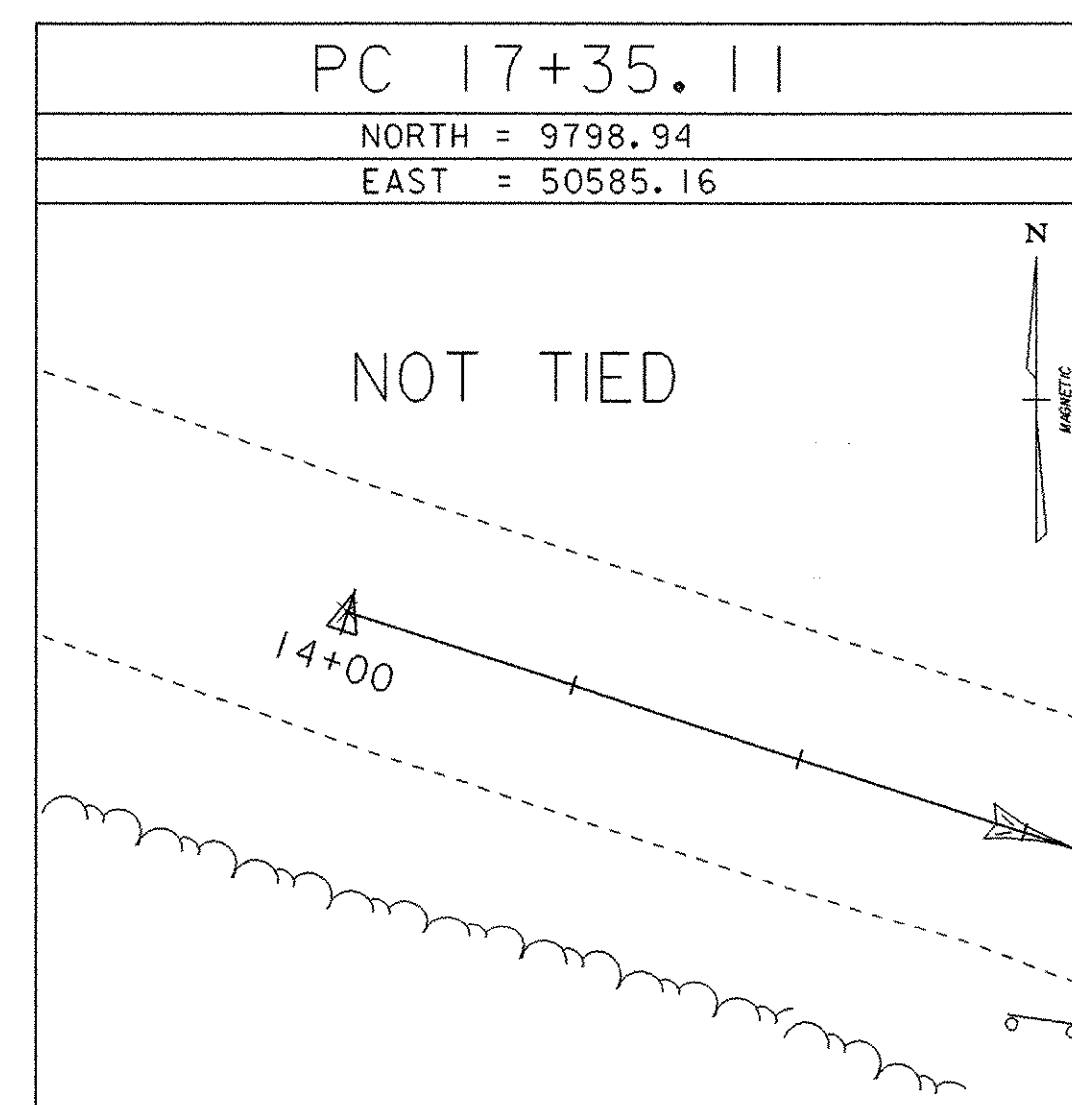

• Alignment Staked 05-15-2006 by R. Gilman P.C. & P. Winters

DATUM

VERTICAL NAVD 1929

HORIZONTAL ASSUMED

ADJUSTMENT N/A

TIE SHEET



PROJECT NAME: JAY
PROJECT NUMBER: ST STP CULV (2)

FILE NAME: 04b140\survey\04b140t1.dgn
PROJECT LEADER: W. SYMONDS
DESIGNED BY: R. Gilman
PLOT DATE: 23-OCT-2006
DRAWN BY: R. BULLOCK
CHECKED BY: P. WINTERS
SHEET 4 OF 39

STATE OF VERMONT AGENCY OF TRANSPORTATION														QUANTITY SHEET									
SUMMARY OF ESTIMATED QUANTITIES												TOTALS		DESCRIPTIONS				DETAILED SUMMARY OF QUANTITIES					
								ROADWAY	EROSION CONTROL	BRIDGE	FULL C.E. ITEMS	GRAND TOTAL	FINAL	UNIT	ITEMS	ITEM NUMBER	ROUND	QUANTITIES	UNIT	ITEMS			
								1				1		LS	CLEARING AND GRUBBING, NCLUDING INDIVIDUAL TREES AND STUMPS	201.10							
								520				520		CY	COMMON EXCAVATION	203.15							
										210		210		CY	UNCLASSIFIED CHANNEL EXCAVATION	203.27							
								130				130		CY	SAND BORROW	203.31							
								10	10			20		CY	TRENCH EXCAVATION OF EARTH	204.20							
										900		900		CY	STRUCTURE EXCAVATION	204.25							
										500		500		CY	GRANULAR BACKFILL FOR STRUCTURES	204.30							
								315				315		SY	COLD PLANING, BITUMNOUS PAVEMENT	210.10							
								170				170		CY	SUBBASE OF DENSE GRADED CRUSHED STONE	301.35							
								3				3		CWT	EMULSIFIED ASPHALT	404.65							
								250				250		TON	MEDIUM DUTY BITUMINOUS CONCRETE PAVEMENT (PG 58-34)	406.27							
										80		80		SY	SHEET MEMBRANE WATERPROFNG, PREFORMED SHEET	519.21							
										1		1		EACH	REMOVAL OF STRUCTURE (975 SF - EST.)	529.15							
										1		1		LS	PRECAST CONCRETE STRUCTURE (15' X 9' X 80' BOX)	540.10							
								10				10		HR	ALL PURPOSE EXCAVATOR RENTAL, TYPE I	608.25							
								8				8		CY	STONE FILL, TYPE I	613.10							
										12		12		CY	STONE FILL, TYPE II	613.11							
										200		200		CY	STONE FILL, TYPE III	613.12							
								450				450		LF	HD STEEL BEAM GUARDRAIL, GALVANIZED W/8 FEET POSTS	621.215							
								3				3		EACH	MANUFACTURED TERMINAL SECTION, FLARED	621.50							
								434				434		LF	REMOVAL AND DISPOSAL OF GUARDRAIL	621.80							
								100				100		HR	FLAGGERS	630.15							
											1	1		LS	FIELD OFFICE, ENGINEERS	631.10							
											1	1		LS	TESTING EQUIPMENT, BITUMINOUS	631.17							
											1	1		LU	FIELD OFFICE TELEPHONE (N.A.B.I.)	631.25							
								1				1		LS	MOBILIZATION/DEMOBILIZATION	635.11							
								1				1		LS	TRAFFIC CONTROL	641.10							
								2				2		EACH	PORTABLE CHANGEABLE MESSAGE SIGN	641.15							
								410				410		LF	DURABLE 4 INCH WHITE LINE, THERMOPLASTIC	646.402							
								410				410		LF	DURABLE 4 INCH YELLOW LNE, THERMOPLASTIC	646.412							
										275		275		SY	GEOTEXTILE UNDER STONE FILL	649.31							
								10				10		LB	SEED	651.15							
								60				60		LB	FERTILIZER	651.18							
								.5				.5		TON	AGRICULTURAL LIMESTONE	651.20							
								.5				.5		TON	HAYMULCH	651.25							
								70				70		SY	GRUBBING MATERIAL	651.40							
								1				1		LS	EPSC PLAN	652.10							
								15				15		HR	MONITORNG EPSC PLAN	652.20							
								1				1		LU	MAINTENANCE OF EPSC PLAN (N.A.B.I.)	652.30							
								620				620		SY	TEMPORARY EROSION MATTING	653.20							
																		PROJECT NAME: JAY					
																		PROJECT NUMBER: ST STP CULV(2)					
																		FILE NAME: S04B140QS.XLS					
																		PROJECT MANAGER: W. SYMONDS					
																		DESIGNED BY: T. FILLBACH					
																		PLOT DATE: 10/10/2006					
																		DRAWN BY: G. SHANGRAW					
																		CHECKED BY: J. LACROIX					
																		QUANTITY SHEET #1					
																		SHEET 5 OF 39					

QUANTITY SHEET

[illegible]

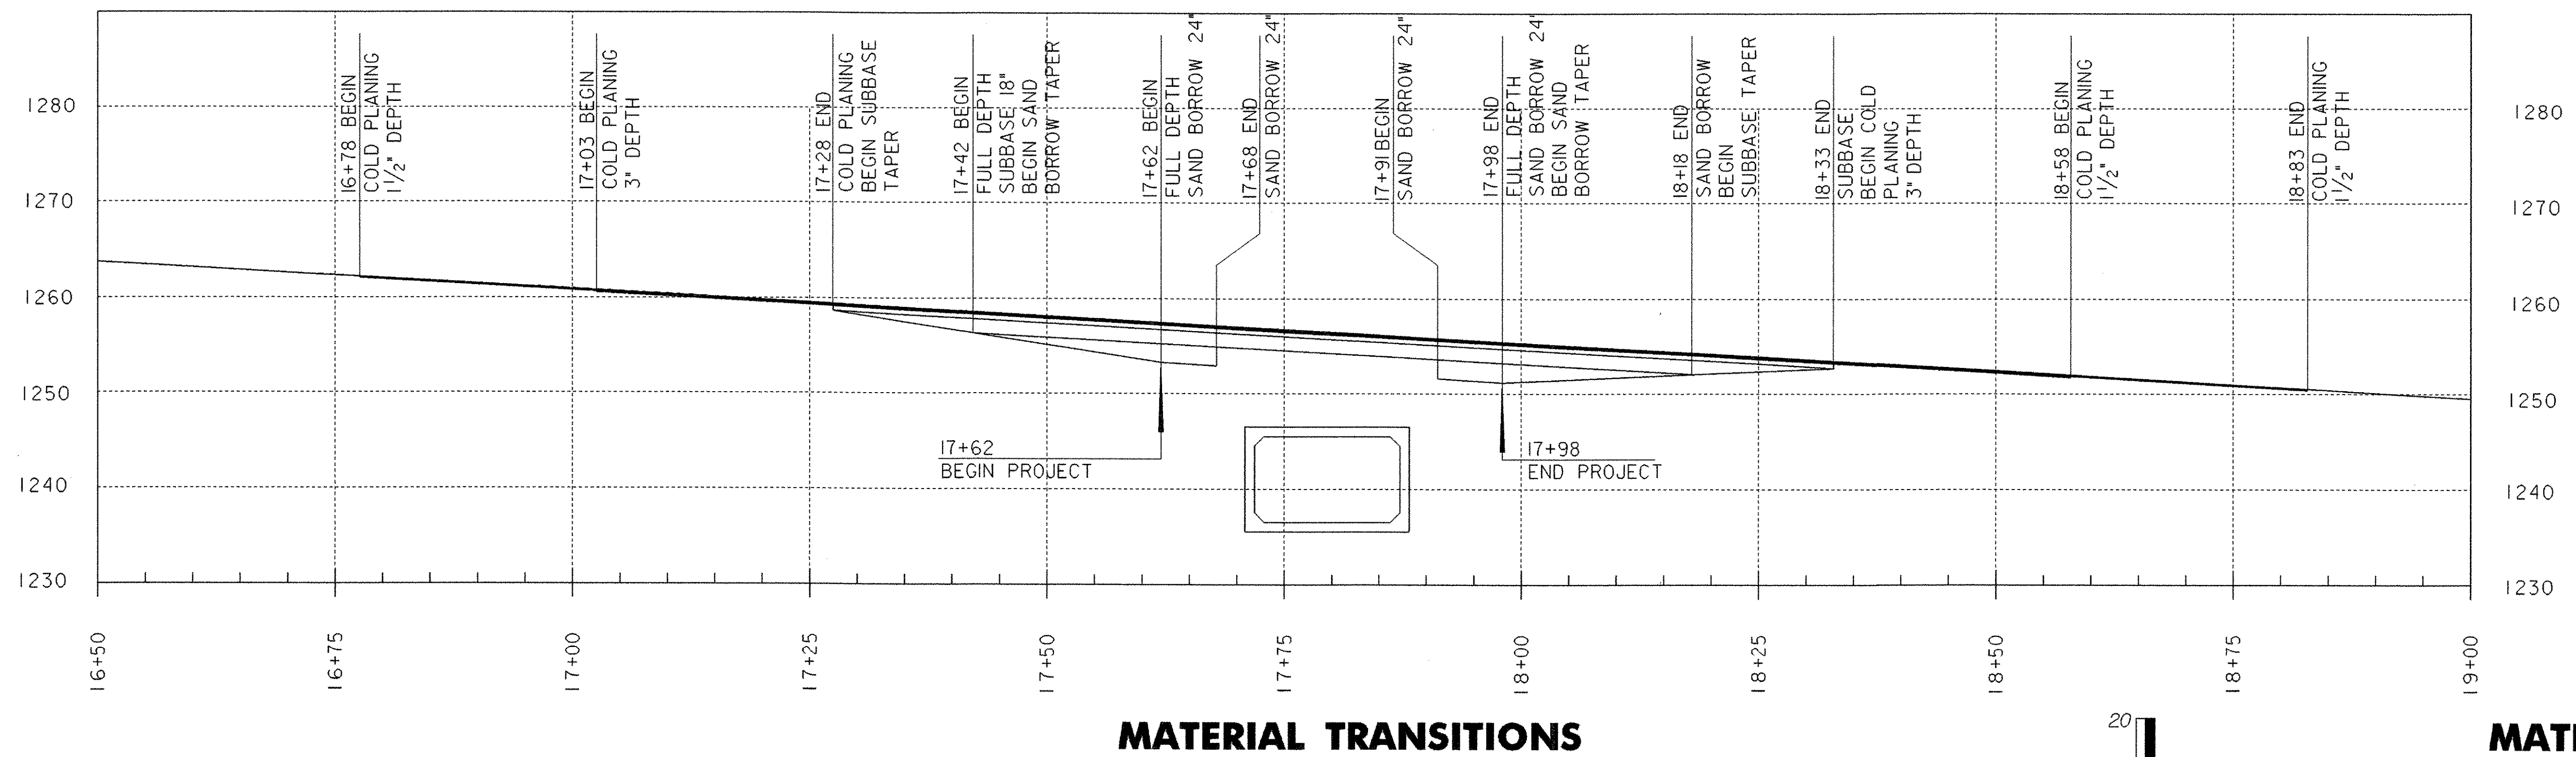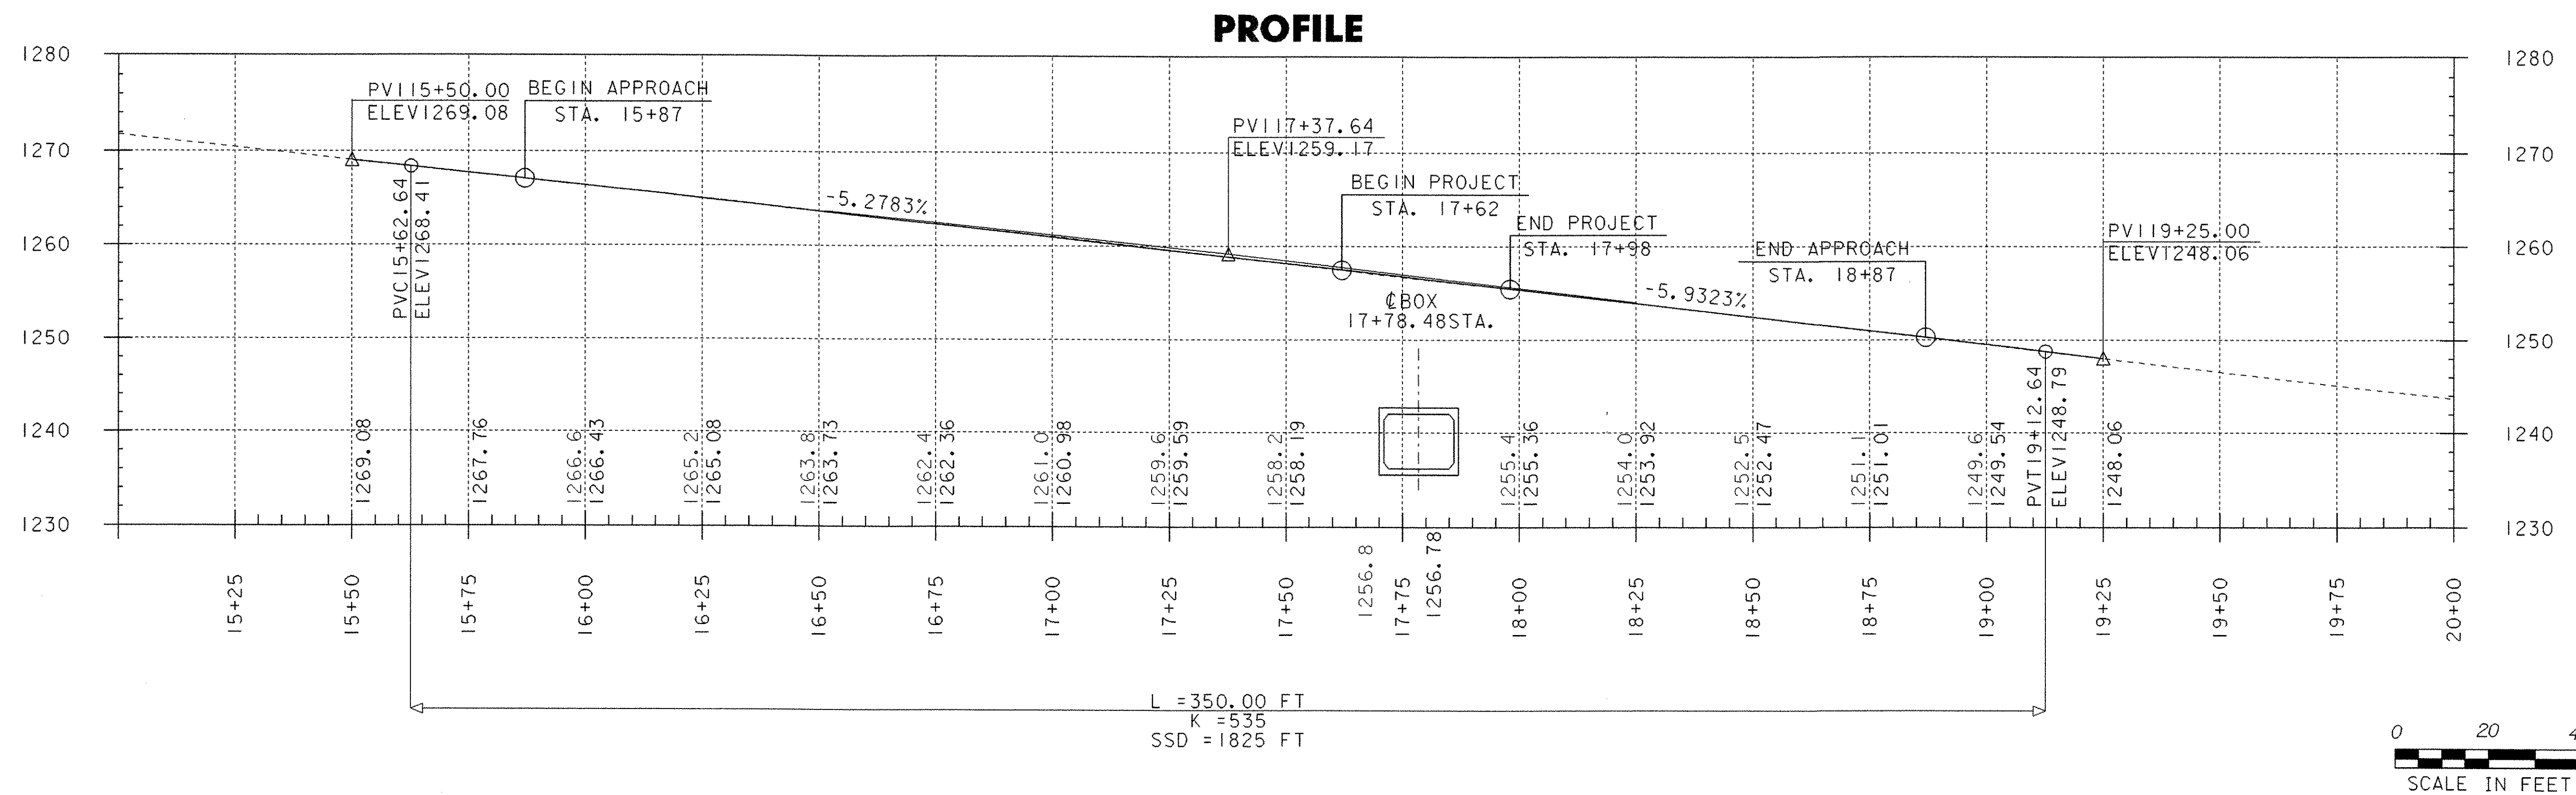

PROJECT NAME: JAY	
PROJECT NUMBER: ST STP CULV (2)	
FILE NAME: 04b140\s04b140bdr.dgn	PLOT DATE: 23-OCT-2006
PROJECT LEADER: W. SYMONDS	DRAWN BY: G. SHANGRAW
DESIGNED BY: T. FILLBACH	CHECKED BY: T. SUMNER
04b140profile.i	SHEET 8 OF 39

EROSION CONTROL NARRATIVE

GENERAL EROSION PROVENTION & SEDIMENT CONTROL (EPSC) GUIDELINES

The Erosion Control plans are intended as a guide for preventing soil erosion and controlling sediment. The work outlined in this narrative consists of applying measures throughout the duration of the project to control erosion and minimize the sedimentation of the receiving waters.

A Temporary erosion control plan will be submitted by the contractor for approval by the Agency of Transportation.

The contractor will use other temporary or permanent erosion control devices as necessitated by the sequence of construction and as directed by the Resident Engineer. See Subsection 105.23 of the 2006 Vermont Standard Specifications for Construction.

The contractor shall coordinate the installation, use, and removal of erosion and sediment control measures with construction activities to assure economical, effective, and continuous erosion and sediment control. The contractor shall employ temporary stabilization practices in incremental stages as construction activities proceed.

The Resident Engineer may direct the installation of certain erosion control measures in order to forestall or mitigate potential or existing erosion problems, or to respond to storm events or damage by construction operations.

The contractor shall install erosion and sediment control measures as sequenced on the EPSC Plan, or as directed by the Resident Engineer. The type, size, and location of any erosion control device shall not be changed unless prior approval is obtained from the Resident Engineer. Any approved changes shall be noted on the EPSC Plans and discussed in the weekly report. The contractor shall inspect all erosion control measures daily and after each rainfall event. The contractor shall repair all damaged erosion control measures immediately. All erosion control measures that trap sediment, such as sediment basins and silt fences, shall be cleaned out when their capacity reaches 50%.

The Resident Engineer' s approval should be obtained prior to installing any erosion controls not specified in the EPSC Plans. However, in emergency situations where the Resident Engineer is not immediately available, the contractor should repair or install the erosion controls as he/she deems necessary and report the incident to the Resident Engineer as soon as it is practical.

The contractor shall control all sediment-laden runoff within the project site. Clean runoff from outside the project site shall be routed through the project site using diversion berms, diversion channels, and temporary or permanent culverts.

Construction equipment will not be allowed to operate on the outside of the perimeter control measures.

Construction equipment will not be allowed to cross a flowing stream, or disturb the existing stream banks, unless authorized by the Resident Engineer.

All in-stream construction must take place in a dry channel between June 1st and October 1st.

In general, preserve existing vegetation, shrubs, and trees whenever possible.

Silt fence shall be placed at the toes of all fill slopes and shall be constructed so that flows cannot bypass the ends. Areas directly below (downhill) of the silt fences must be un-disturbed and vegetated.

As construction progresses, implementation of additional erosion control measures may be required as deemed necessary by the On-Site Coordinator and as approved by the Resident Engineer.

INFORMATION REQUIRED FROM CONTRACTOR

Much of the erosion control information shown on the erosion control plans and described in this narrative is general in nature. More site specific information is not yet available as a contractor has not yet been selected. The following list outlines some of the specific information that is not included in the erosion control plans and described in this narrative:

1. The location of vehicle tracking pads.
2. The location of stockpiles, staging areas, and disposal areas.
3. A specific timetable of construction and earthwork activities.
4. The name, title, qualifications, and contact information for the on-site project coordinator.
5. The sequencing of construction activities and specific measures that will be implemented in conjunction with these activities.
6. The Contractor is required to submit the "EPSC Contractor Checklist" for review and approval by the VTrans Construction Environmental Engineer prior to commencement of construction.

DESCRIPTION OF PROJECT

This project involves reconstruction of bridge # 50 over Crook Brook on VT 105 in the town of Jay. Crook Brook is characterized as a moderately steep stream with some bank erosion but mostly stable. The streambed consists of Gravel and Cobbles. The total drainage area is 1.5 square miles.

Features of concern with respect to erosion control include embankments immediately adjacent to the project. A new buried precast concrete box will be constructed on the existing alignment. Traffic will be maintained with a detour as shown on the project plans. The construction limits do not approach any buildings or any other structures outside the project limits.

It is anticipated that the project will last one construction season.

Disturbed area (excluding waste, borrow, and staging areas) = 0.20 acres. Estimated Total disturbed area (including waste, staging, and borrow) is anticipated to be less than 1 Acre.

SITE INVENTORY ANALYSIS

1. OFF SITE DRAINAGE CHARACTERISTICS AND TOPGRAPHY

The area outside the immediate vicinity of this project is primarily Mixed dense woods, and is hilly to mountainous. VT Route 105 is a paved state highway, and is in excess of 6% gradient. There is very limited development, consisting mainly of farms which are located approximately 3000 feet westerly of the project. There is a gravel drive approximately 150 feet westerly of the outlet end of the culvert. A drive culvert beneath the drive drains roadside and drainage from a mown field into the wetland area near the outlet end of the culvert.

2. DRAINAGE, WATERWAYS, AND BODIES OF WATER.

There is a manmade pond and a large mown field northwesterly of the project, approximately 100 feet distance from the nearest disturbed soils, and at a higher elevation than the project. The Pond eventually drains into Crook Brook further downstream of the project. A Wetland area has been identified and is located along the northwestern streambank, just outside the project limits. It is shown on the project plans.

3. DESCRIPTION OF EXISTING VEGETATIVE COVER

In the immediate vicinity of the project, the existing ground cover is mostly grassy with intermittent deciduous shrubs and small trees, as depicted on the plans by the area survey.

4.DESCRIPTION OF EXISTING SOILS

A detailed description of the soil types expected to be encountered in the project area is unavailable at this time. For the purpose of this narrative we are using engineering judgment to classify the soils expected to be encountered.

The soils are mostly engineered fills from a previous project. This soil exhibits a high percolation rate that results in low erodability.

5. SENSITIVE RESOURCE AREAS

In the immediate vicinity of the project, only identified area are Crook Brook, and the Riparian Buffer.

DESCRIPTION OF SLOPES

The existing shape of the project area can be seen by looking at the erosion control existing conditions sheet where the existing contours are shown. The contours are shown in dashed and depict the half foot interval. Major contours are shown at 5 foot intervals, and are labeled.

EXISTING SLOPES

Generally speaking, the project impacts steep but short slopes.

PROPOSED SLOPES

Fill slopes that are 1-2 (50%) or flatter will be seeded and mulched, 1-1.5 slopes will be sodded or lined with stone fill. These slopes will be protected until they are fully vegetated. The slopes along the channel banks will be lined with heavy stone and are at 1-1.5 (67%) slope.

MAINTENANCE PLAN FOR EROSION AND SEDIMENT CONTROLS

- The following maintenance schedule will be followed throughout the duration of the project.
1. An assigned individual who can be associated with the day-to-day operations of the project shall do monitoring of the construction site. The inspector will be familiar with this plan and with erosion & sediment control procedures and with road and bridge construction techniques. Site reviews will be performed at least once every seven calendar days, and within 24 hours of a storm event great enough to cause water to leave the construction site.
 2. A copy of the Erosion Prevention and Sediment Control Weekly Plan Review prepared by the site reviewer shall be given to the Resident Engineer each week. The report will be filled out in accordance with the item 652.20 MONITORING EPSC Plan.
 3. The plan preparer will be available for on-site consultations with the Resident Engineer within twenty four hours of the request.
 4. All silt fences and stone check dams will be inspected each site visit by the designated inspector, as described below:
 - i. These controls will be maintained in good condition. Any silt fence or stone check dam that is ineffective will be repaired or replaced immediately.
 - ii. Sediment deposits will be removed when they reach one-half the height of the sediment control device.
 - iii. All sediments removed will be deposited in an upland portion of the project site, or disposed off-site in the designated project waste site.
 5. All slopes will be checked each site visit and any eroded areas will be immediately repaired. Temporary stabilization methods will be used as necessary until final stabilization measures are in place.
 6. Both temporary & permanent seeding & mulching will be checked each site visit for vegetative growth. Any areas requiring re-vegetation will be repaired immediately.
 7. Drainage structures will be cleaned as necessary to remove any sediment buildup in the sump of the structures or at the inlet of the structure.
 - i. Any inlet control found to be ineffective will be replaced as necessary and will be done immediately.
 - ii. All sediments removed will be deposited in an upland portion of the project site, or disposed off-site in the designated project waste site.
 8. Temporary construction accesses will be monitored each site visit. Any control found to be ineffective will be promptly replaced.
 9. All temporary erosion control devices will stay in place until final grass growth has been established and complete stabilization of the areas has occurred.
 10. Once stabilization has occurred, all temporary erosion control measures will be removed and all disturbed areas will be stabilized with erosion matting and/or seed & mulch.

PROJECT NAME:	JAY
PROJECT NUMBER:	ST STP CULV (2)
FILE NAME: 04b140\604b140xc01.dgn	PLOT DATE: 23-OCT-2006
PROJECT LEADER: W. SYMONDS	DRAWN BY: T. FILLBACH
DESIGNED BY: T. FILLBACH	CHECKED BY: C.DIGIAMMARINO
EROSION CONTROL NARRATIVE	SHEET 11 OF 39

EROSION CONTROL NARRATIVE

SPECIFIC GUIDELINES

PHASE 1 - ESTABLISH PERIMETER EROSION CONTROLS

Prior to any construction or staging, the contractor will install Vehicle Tracking pads leading to staging areas and the project site to prevent the tracking of silts and sediments offsite. Coarse stone fill over filter fabric should be utilized where an already established stable entrance does not exist. The crushed stone product used for the construction of the Vehicle Tracking pads shall be monitored for sediment accumulation and replaced as necessary as directed by the Resident Engineer. Vehicle Tracking pads shall also be established and maintained at all offsite waste and borrow areas.

After the clearing of trees and shrubs, but prior to any grubbing and excavation, construct perimeter controls to ensure that any sediment does not leave the site. Water treated with Sediment traps and basins may be directed to nearby streams or swales.

Install perimeter silt barrier in areas of proposed work as shown on the plans prior to grubbing and filling activities. In areas of high exposure, it may be necessary to double up protection with additional silt fencing or placement of hay bales behind the silt fencing. In areas of exposed ledge, stone check dams will be utilized.

During grubbing operations, stone check dam barriers shall be installed at any obvious concentrated flow discharge points, or as directed by the Resident Engineer.

After the grubbing activity all areas of exposed soils shall be temporarily stabilized with mulching & seeding, erosion matting, as soon as practicable and before any predicted rainfall event. These temporary erosion control measures can be placed in any combination in areas of potential erosion as deemed necessary by the Resident Engineer.

After perimeter controls are in place, and prior to grading operations, construct temporary onsite sediment traps and provide inlet protection where necessary. Grade disturbed areas to drain towards sediment trap where possible.

All material stockpiles, including but not limited to, grubbing material, sand borrow, earth borrow, granular borrow, topsoil, subbase, and any excavated waste piles shall also have silt fence installed around the base of the stockpile. The Contractor is required to obtain clearance by the VTrans Environmental Section prior to commencement of construction.

PHASE 2 - ESTABLISH CULVERT EROSION CONTROLS

New slopes steeper than 50% (1-2 slope) will be constructed with stone fill for slope stabilization as the embankment construction progresses. All collected sediments should be removed from the settling structures and the ground shaped to its final grade and slope. Dispose of the collected sediments in an upland portion of the project, or in a manner approved by the Resident Engineer that will not result in sediments or pollutants entering the stream. The final design of the Sediment Basin will be provided by the Contractor.

PHASE 3 - ESTABLISH ROADWAY EROSION CONTROLS

On any partially completed permanent cut and fill slopes, all exposed soils will be stabilized with erosion matting or seeded and mulched.

The subbase material should be placed as soon as the subgrade has reached its final grade and slope. The traveling surface will be graded to promote sheet flow off the surface onto slopes, or flows will be directed to collection areas and shall be transported down the fill slopes to sediment traps or settling basins.

All graded areas shall be permanently stabilized following final grading activities. All areas that are graded outside of the growing season shall be treated with slope stabilization until seeding & mulching can be performed.

PHASE 4 - FINAL EROSION CONTROLS

Removal of silt fence shall commence only after all upslope areas are stabilized and well established, and the Resident Engineers has approved the removal.

Remove perimeter silt fences, and sediment traps, only after any toe-of-fill ditches have stabilized and vegetation is well established.


Remove all remaining temporary erosion control measures, regrade any areas if necessary, treat all regraded areas with erosion matting and or mulch & seed, and establishment of any final erosion control devices as deemed necessary by the Resident Engineer.


PROJECT NAME:	JAY
PROJECT NUMBER:	ST STP CULV (2)
FILE NAME: 04b140\s04b140xc1.dgn	PLOT DATE: 23-OCT-2006
PROJECT LEADER: W. SYMONDS	DRAWN BY: T. FILLBACH
DESIGNED BY: T. FILLBACH	CHECKED BY: C. DIGIAMMARINO
EROSION CONTROL NARRATIVE	SHEET 12 OF 39



EXISTING CONDITIONS AND RESOURCES

PROJECT NAME:	JAY	PLOT DATE:	23-OCT-2006
PROJECT NUMBER:	ST STP CULV (2)	DRAWN BY:	T. FILLBACH
FILE NAME:	04b140\04b140ero.dgn	CHECKED BY:	C. DIGIAMMARINO
PROJECT LEADER:	W. SYMONDS	SHEET	13 OF 39
DESIGNED BY:	T. FILLBACH		
s04b140eroex1st.l			

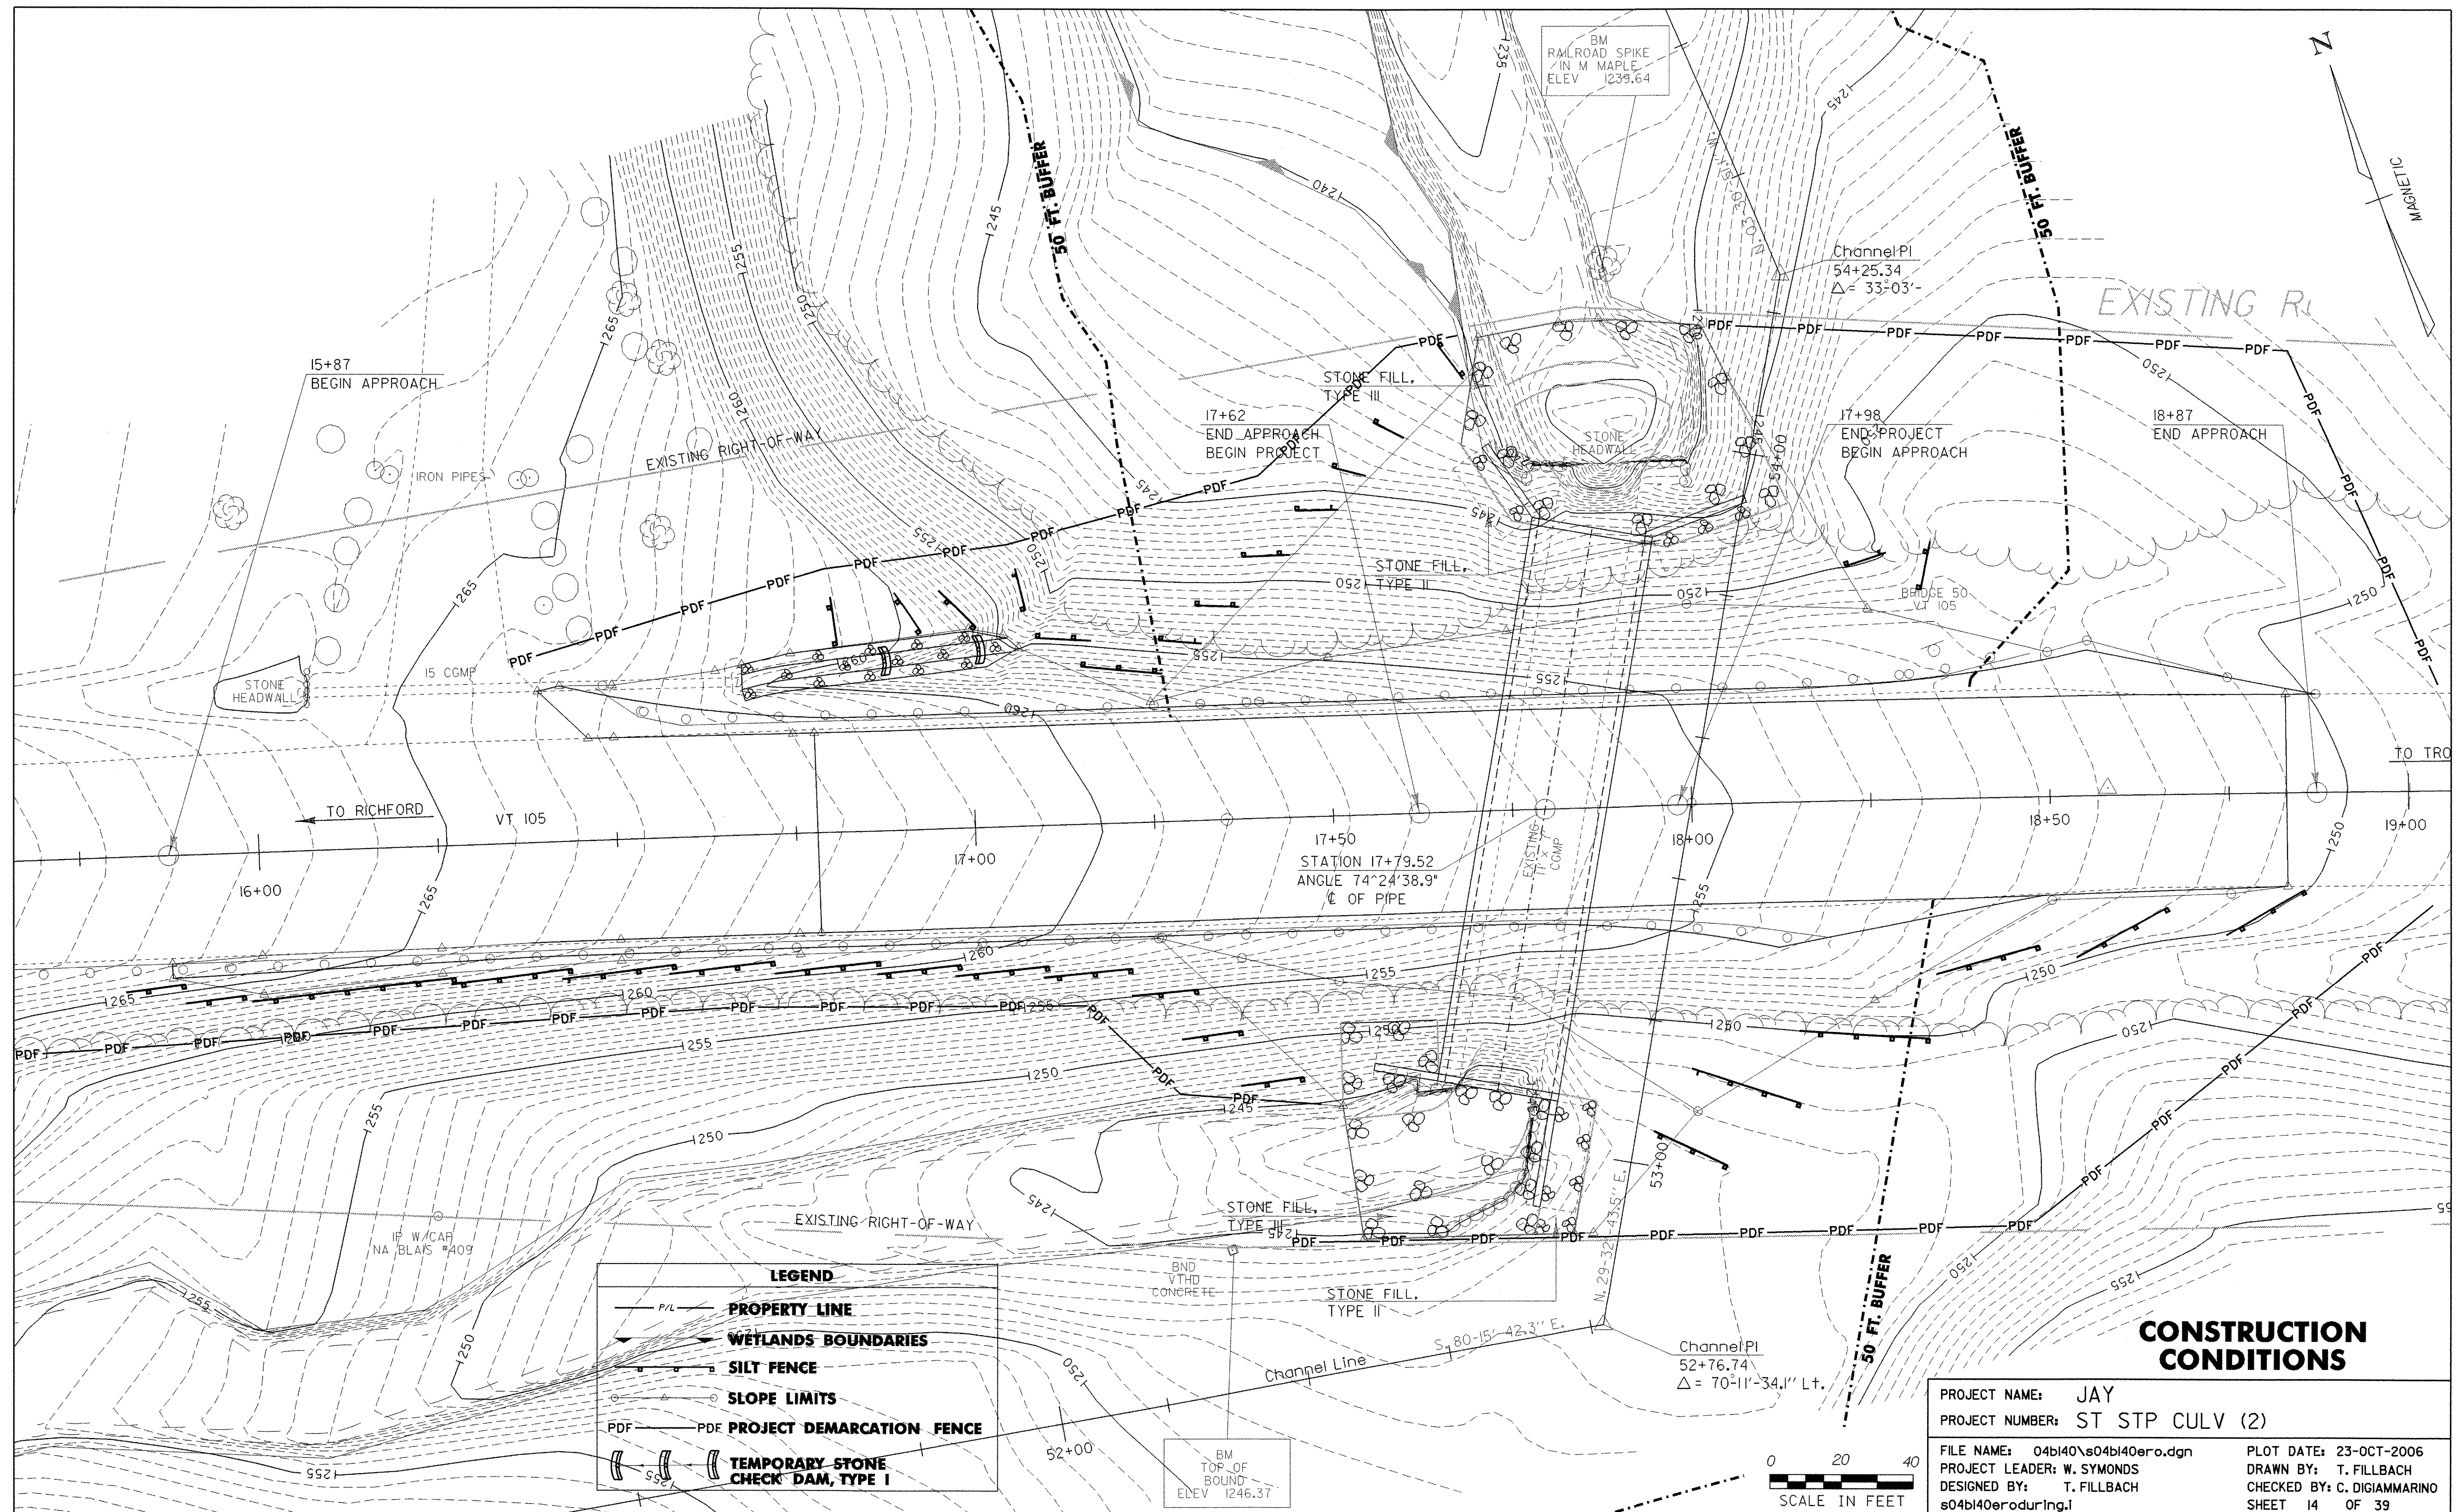

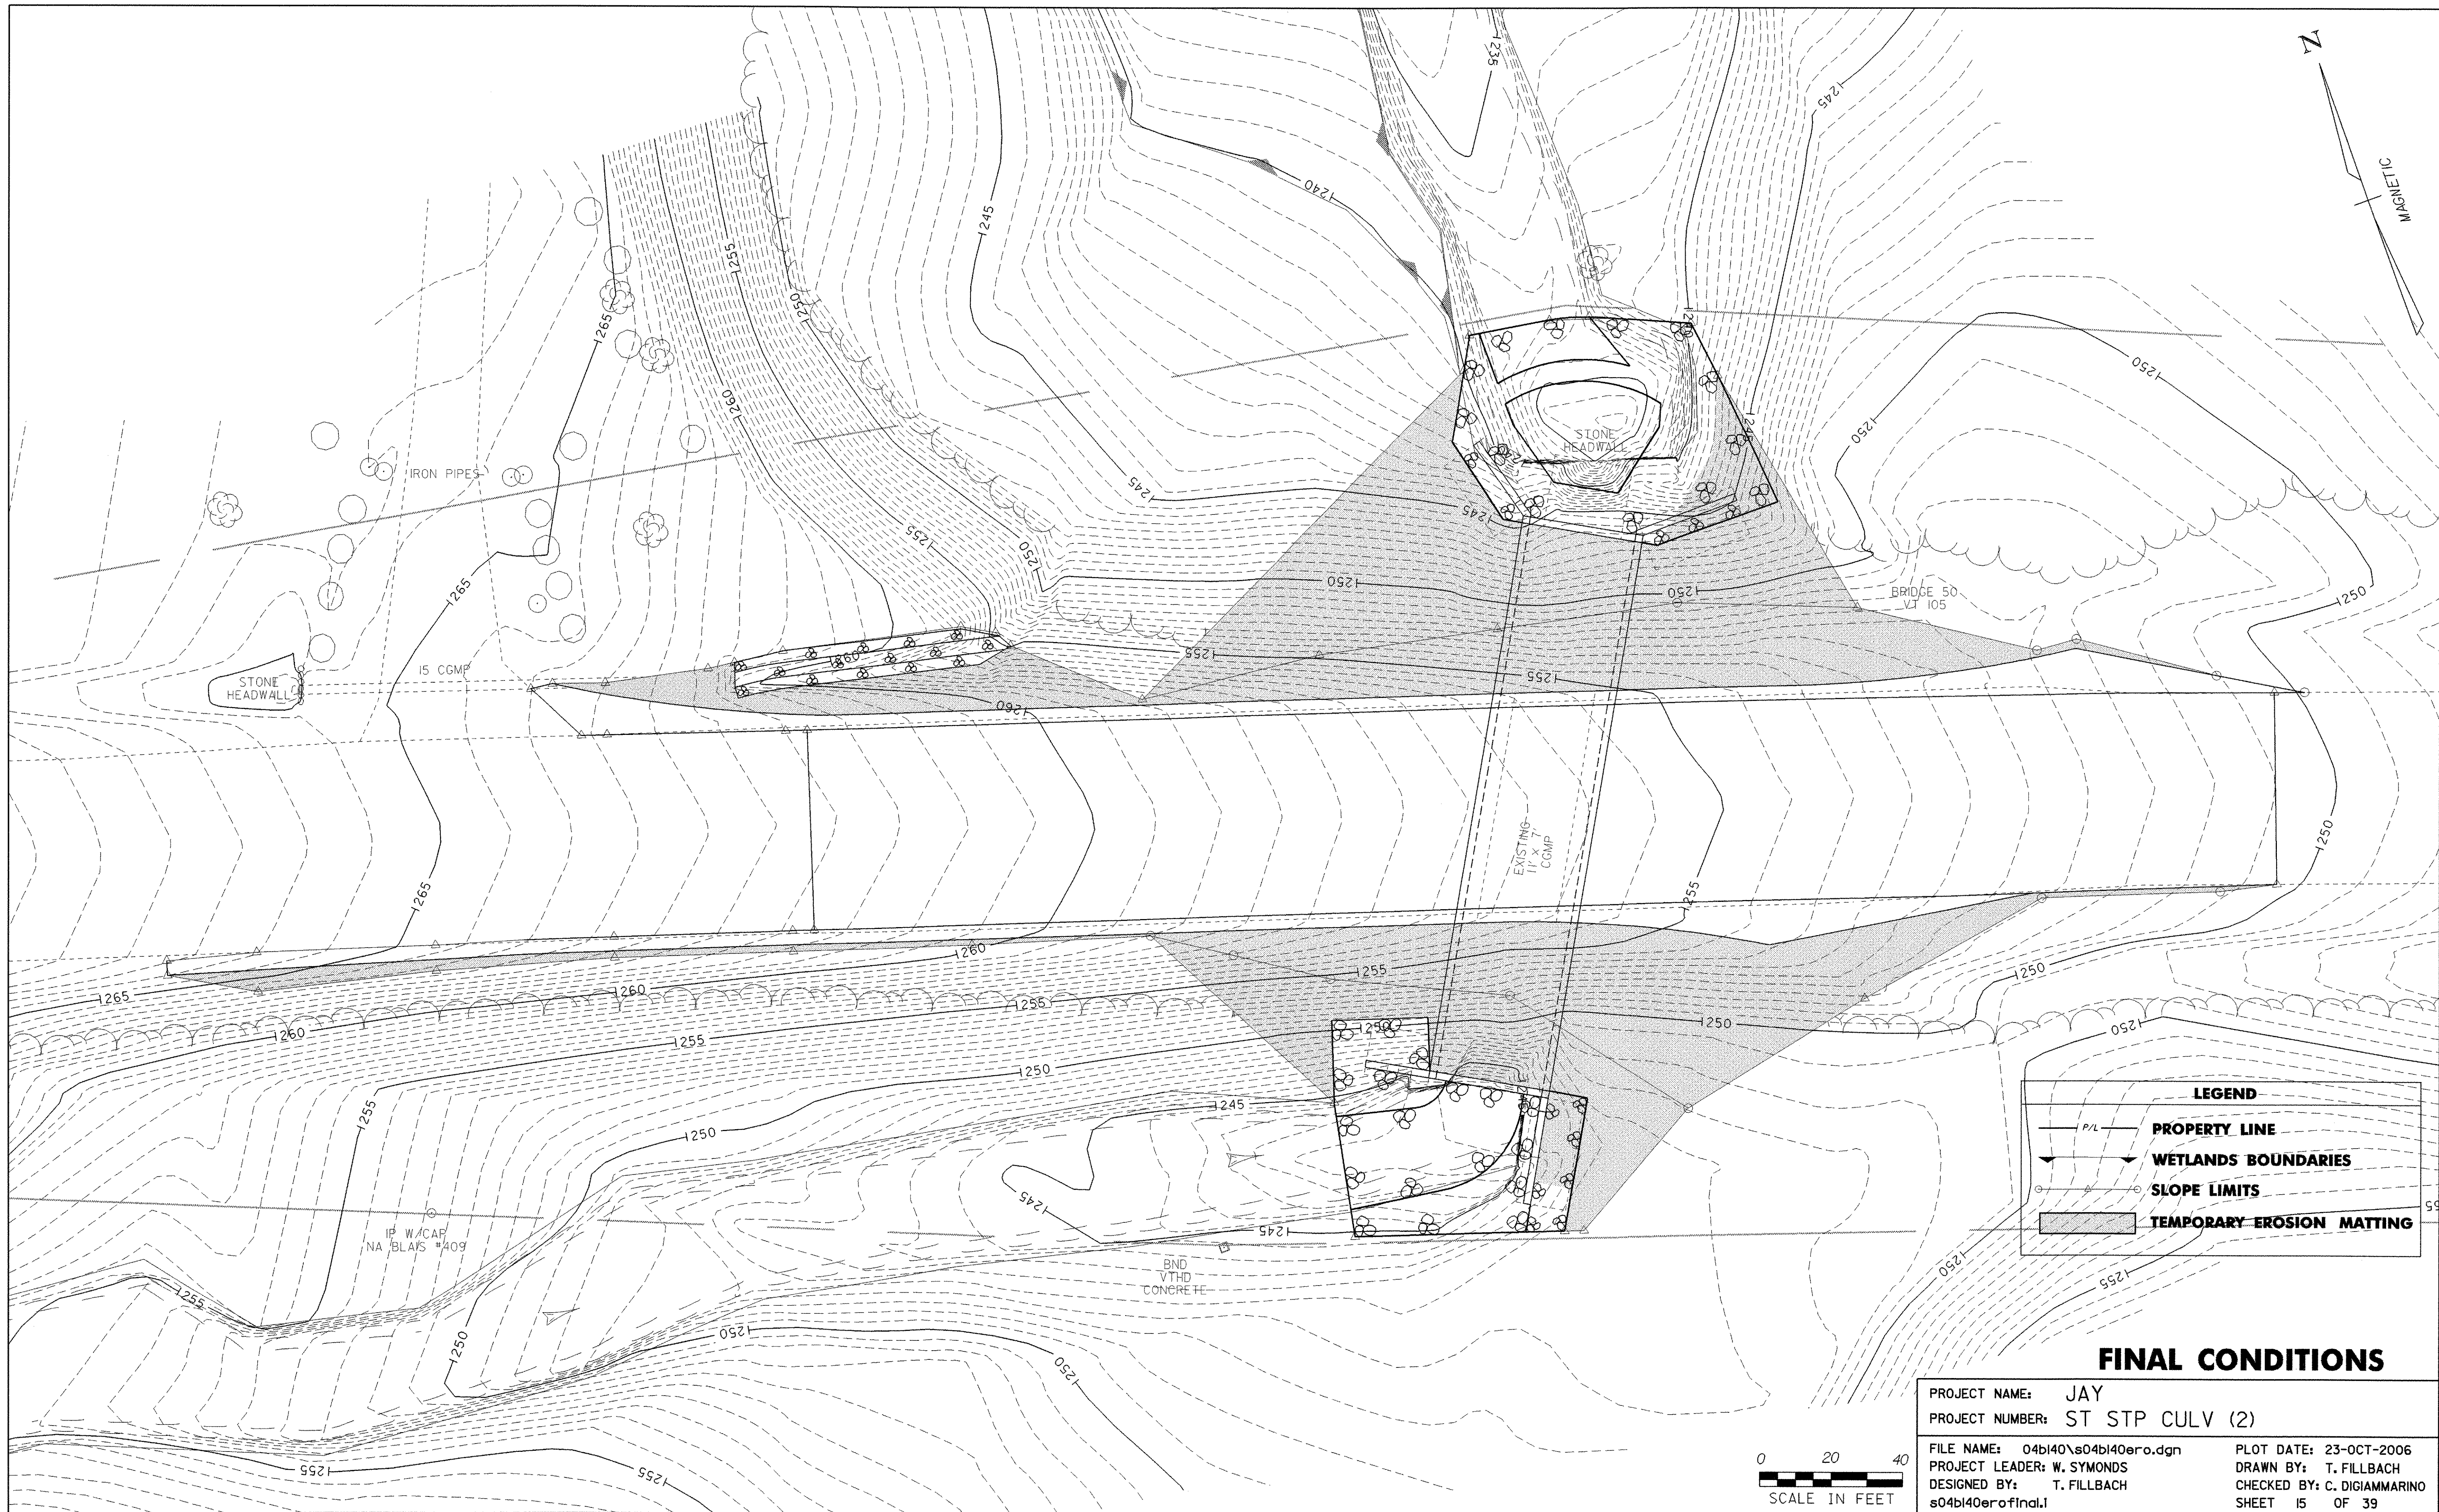



LEGEND

- P/L — PROPERTY LINE
- WETLANDS BOUNDARIES
- SLOPE LIMITS
- TEMPORARY EROSION MATTING

FINAL CONDITIONS

PROJECT NAME:	JAY	PLOT DATE:	23-OCT-2006
PROJECT NUMBER:	ST STP CULV (2)	DRAWN BY:	T. FILLBACH
FILE NAME:	04b140\04b140ero.dgn	CHECKED BY:	C. DIGIAMMARINO
PROJECT LEADER:	W. SYMONDS	SHEET	15 OF 39
DESIGNED BY:	T. FILLBACH		
s04b140erofinal.l			

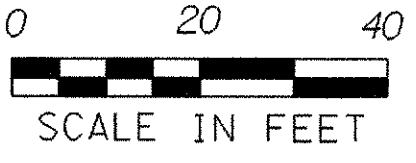

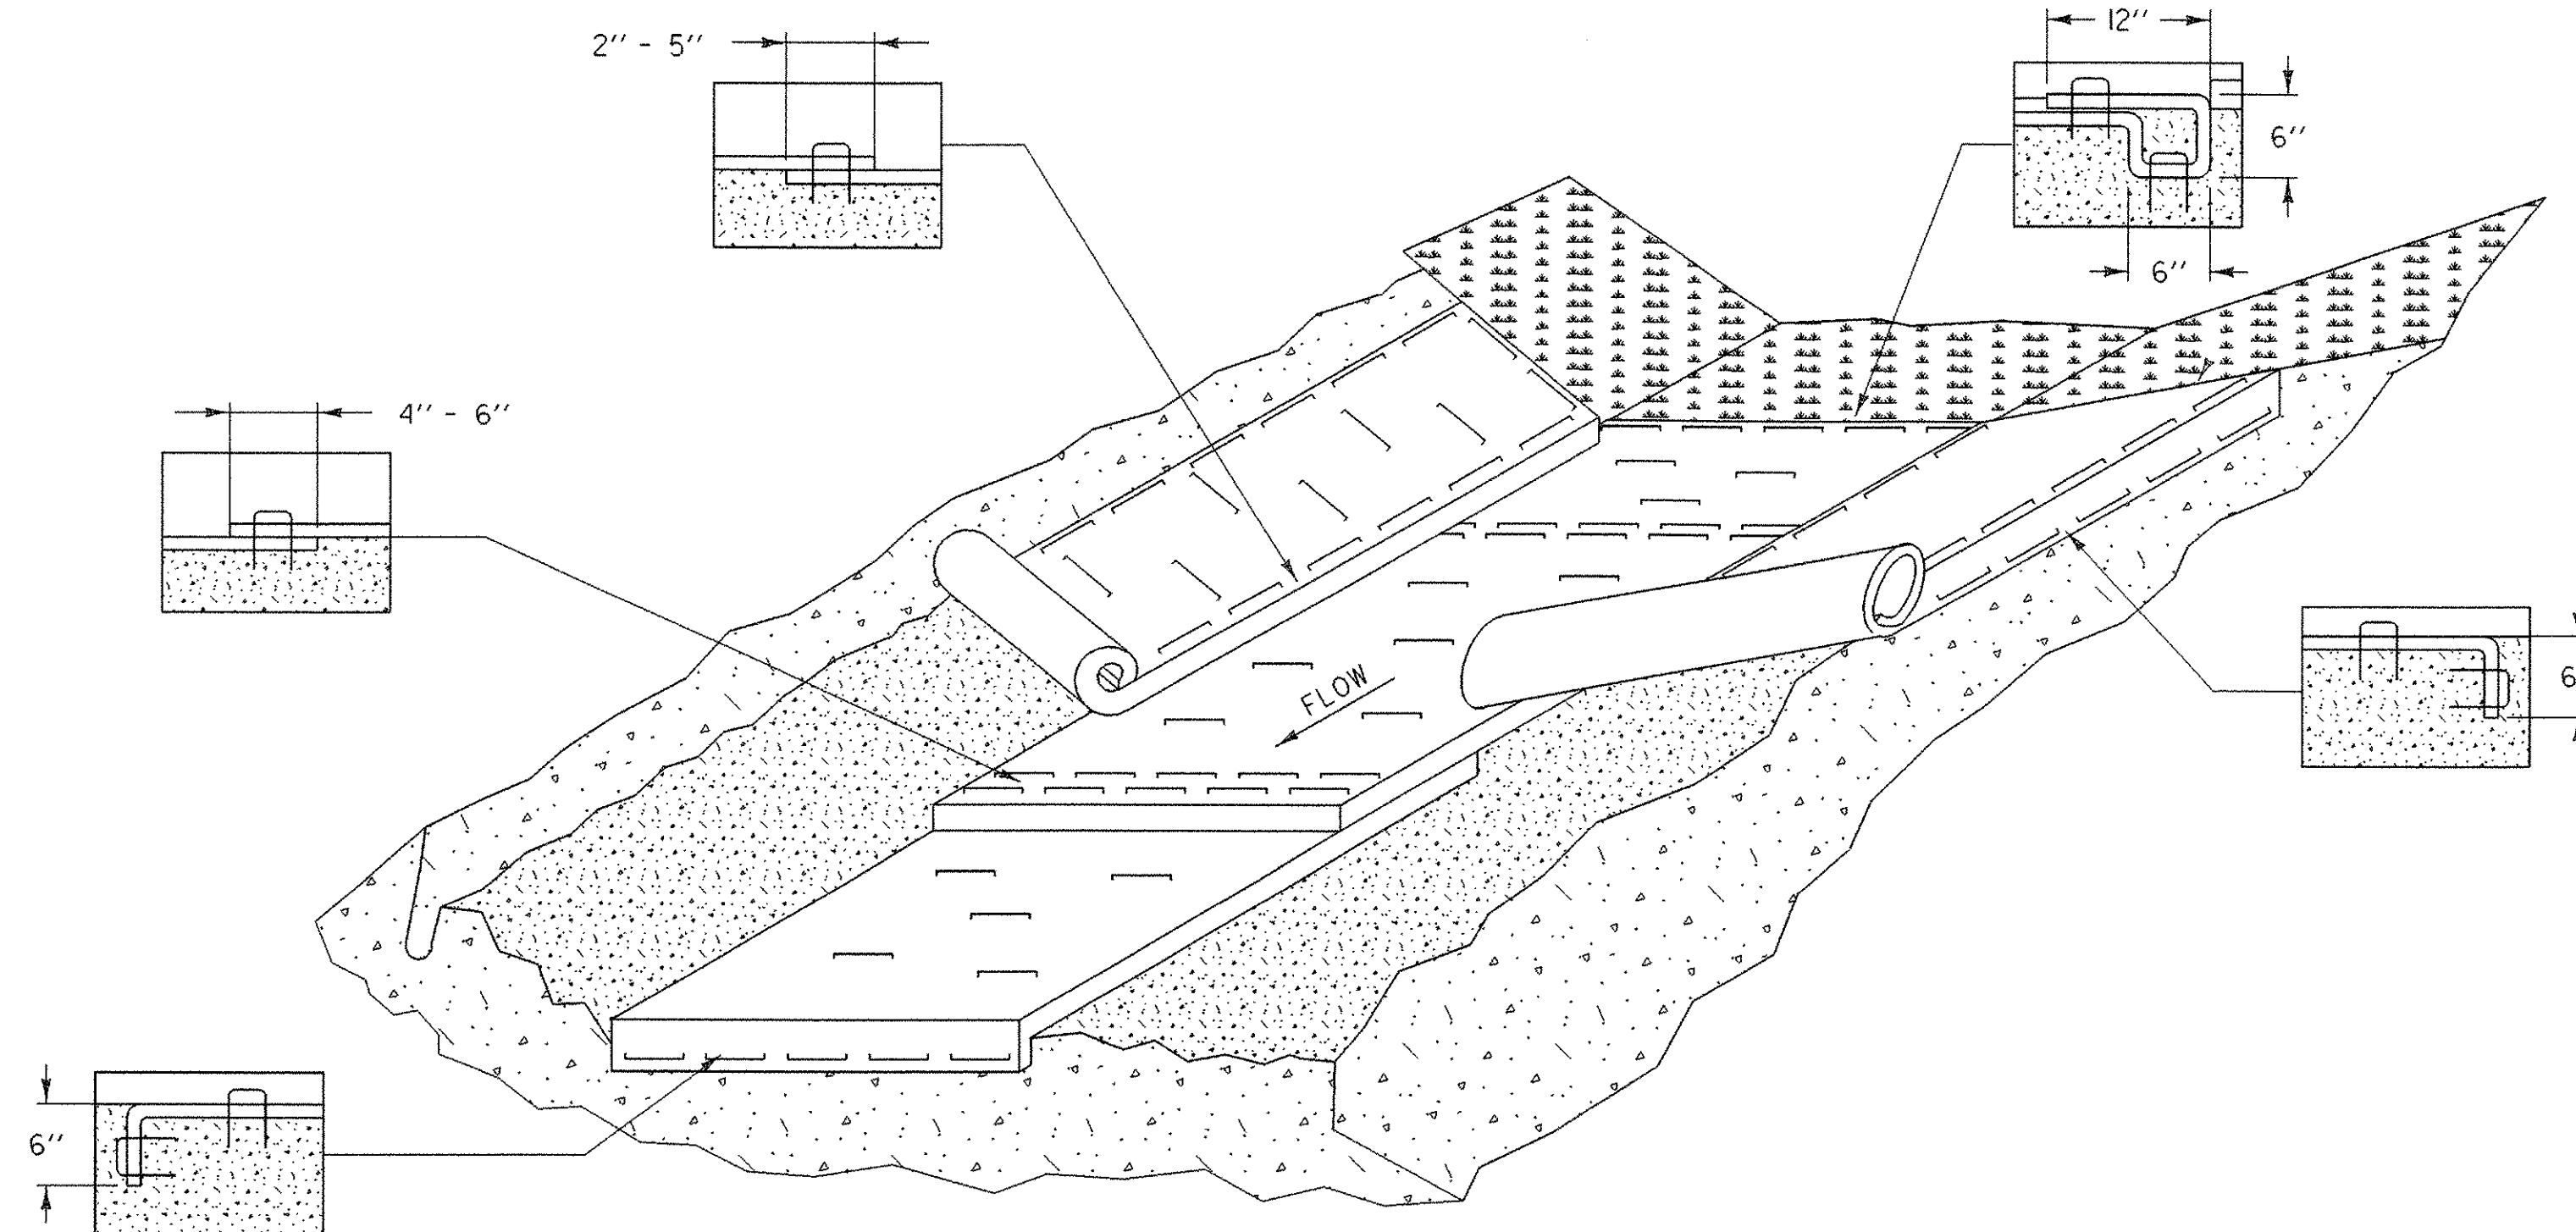


EROSION MATTING FOR DITCHES

APPLICATION NOTES:

- THE PURPOSE OF LINING THE DITCH WITH EROSION MATTING IS TO REDUCE EROSION AND AID THE ESTABLISHMENT OF VEGETATION AT LOW VELOCITIES.
- TYPE OF EROSION MATTING TO BE USED SHOULD BE BASED ON FACTORS SPECIFIC TO EACH APPLICATION. SEE SPECIFICATIONS AND PRODUCT RECOMMENDATIONS FOR SUITABILITY.

GENERAL NOTES:

- WATER MAY NEED TO BE DIVERTED TO ALLOW PROPER MATTING INSTALLATION.
- GRADE AND SMOOTH CHANNEL TO PROVIDE GOOD MATTING TO SOIL SURFACE CONTACT.
- APPLY FERTILIZER, LIME, AND SEED PRIOR TO PLACING MATTING.
- INSTALL MATTING IN THE CENTER OF THE CHANNEL, IN THE DIRECTION OF THE WATER FLOW.
- INSTALL MATTING ON THE SIDE SLOPES OF THE CHANNEL, OVERLAPPING THE CENTER MAT.
- ANCHOR MATTING AS SHOWN, UTILIZING ANCHOR STAPLES. STAPLE PLACEMENT SHALL BE DETERMINED BY THE MANUFACTURER'S INSTALLATION INSTRUCTIONS.
- EROSION MATTING SHALL BE INSPECTED EVERY SEVEN (7) CALENDAR DAYS AND WITHIN 24 HOURS OF A STORM EVENT GREAT ENOUGH TO CAUSE WATER TO LEAVE THE CONSTRUCTION SITE.
- EROSION MATTING SHALL BE REPAIRED AND RESTAPLED AS NECESSARY TO ENSURE PROPER FUNCTION.

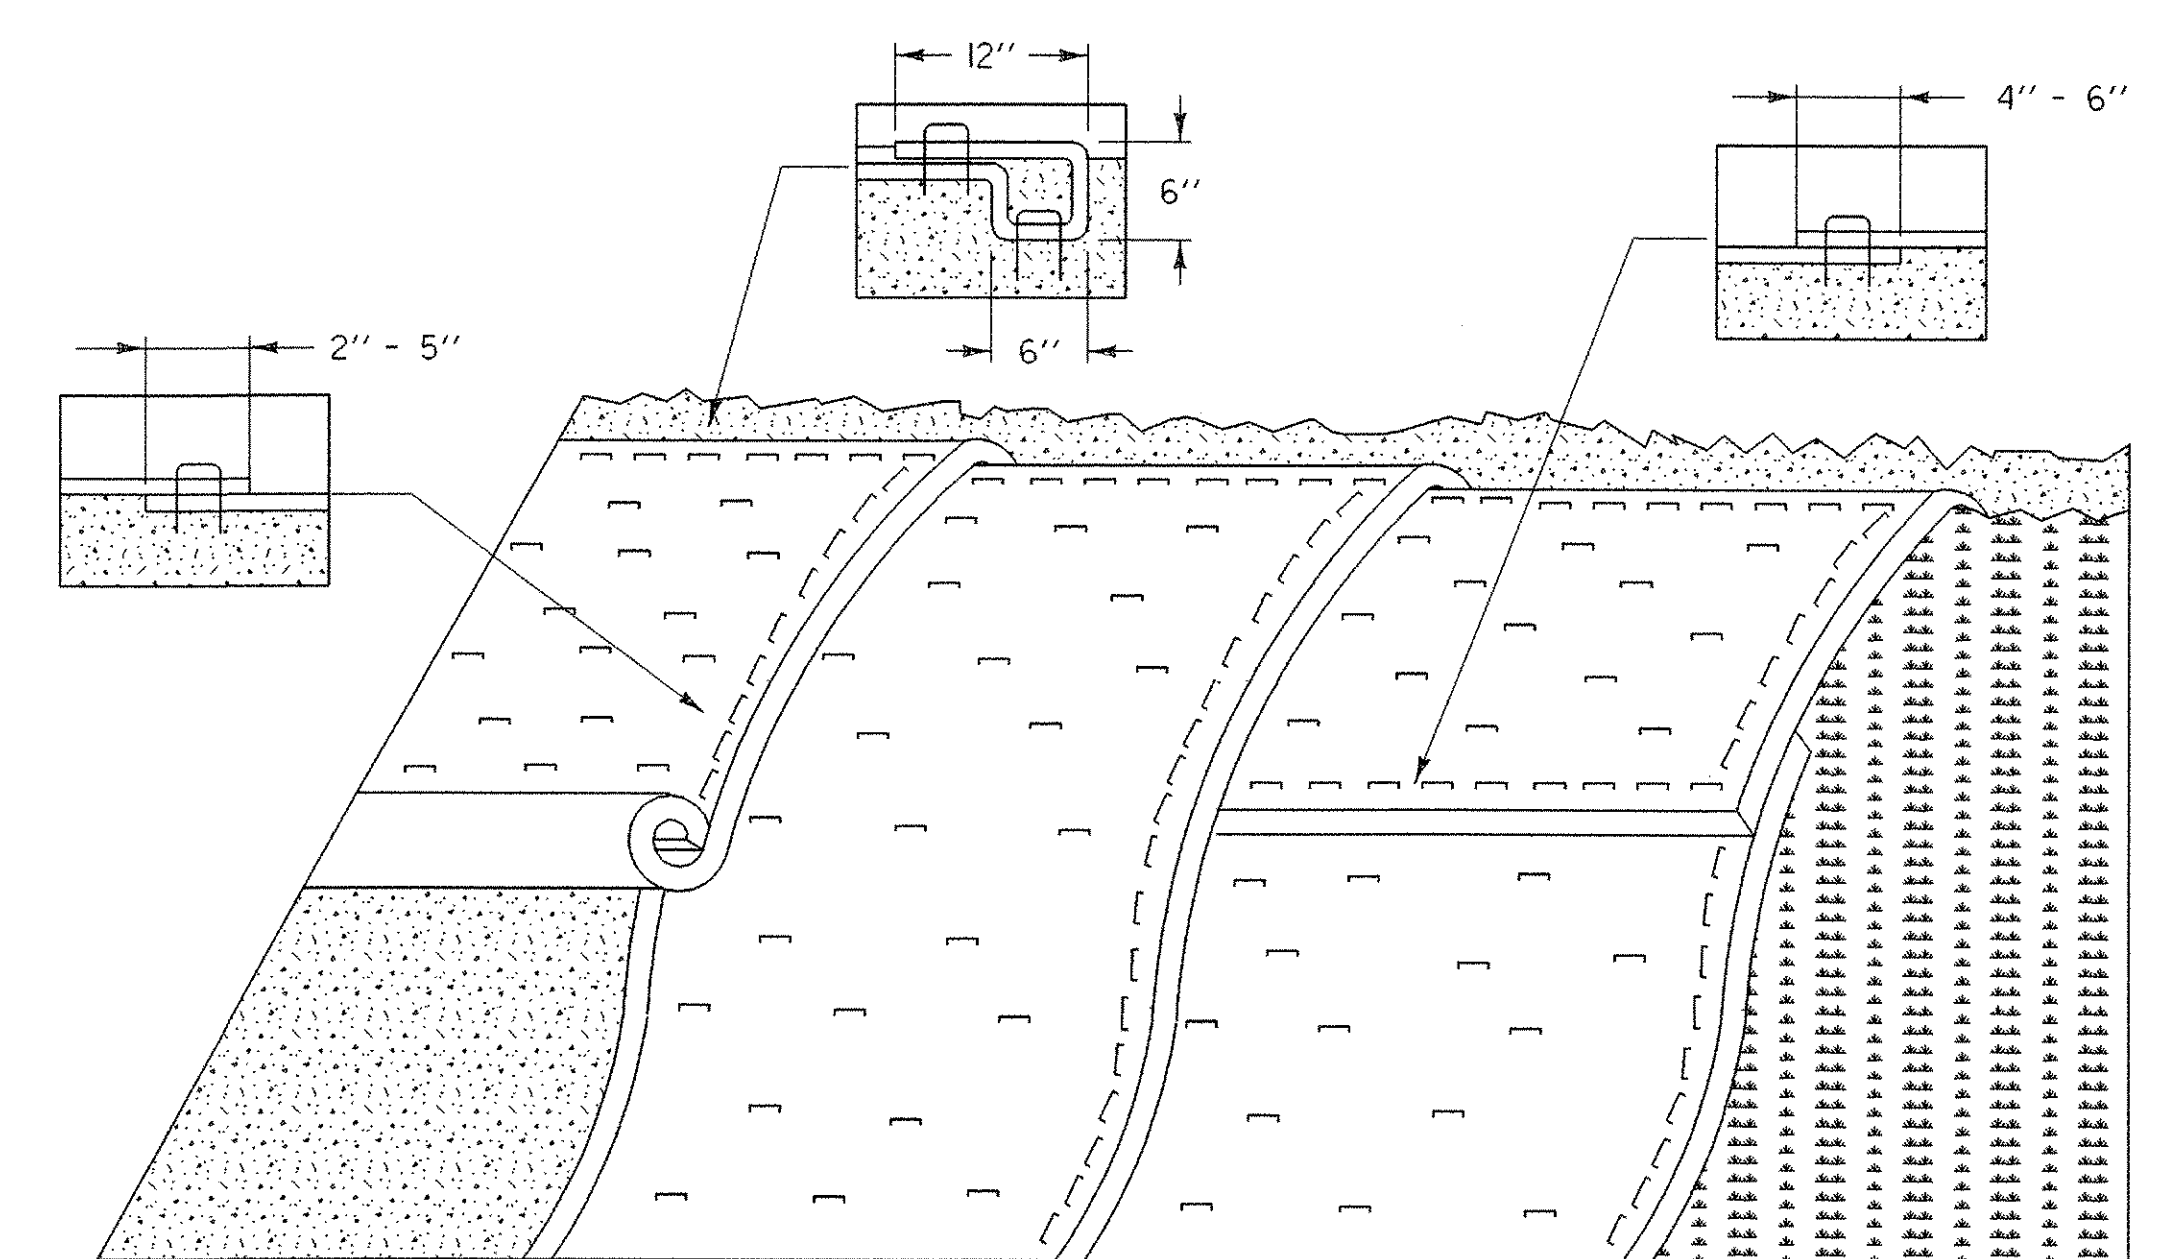

EROSION MATTING FOR SLOPES

APPLICATION NOTES:

- THE PURPOSE OF EROSION MATTING ON SLOPES IS TO REDUCE EROSION AND AID THE ESTABLISHMENT OF VEGETATION
- EROSION CONTROL MATTING SHALL BE USED FOR THE FOLLOWING REASONS:
 - SLOPES $> 3H:1V$
 - AREAS WHERE SEED AND MULCH WILL NOT STAY IN PLACE ALONE
 - WHERE SEEDING IS OUTSIDE THE GROWING SEASON.

GENERAL NOTES:

- GRADE AND SMOOTH THE SLOPE TO PROVIDE GOOD MATTING TO SOIL SURFACE CONTACT.
- APPLY FERTILIZER, LIME, AND SEED PRIOR TO PLACING MATTING.
- ANCHOR MATTING AS SHOWN, UTILIZING ANCHOR STAPLES. STAPLE PLACEMENT SHALL BE DETERMINED BY THE MANUFACTURER'S INSTALLATION INSTRUCTIONS.
- UNROLL EROSION MATTING VERTICALLY DOWN SLOPE IN THE DIRECTION OF WATER FLOW.
- OVERLAP UPPER MATTING OVER LOWER MATTING AS SHOWN.
- OVERLAP ADJACENT MATTING AS SHOWN.
- CUT EXCESS MATTING AT END OF SLOPE AND ANCHOR THE END.
- EROSION MATTING SHALL BE INSPECTED EVERY SEVEN (7) CALENDAR DAYS AND WITHIN 24 HOURS OF A STORM EVENT GREAT ENOUGH TO CAUSE WATER TO LEAVE THE CONSTRUCTION SITE.
- EROSION MATTING SHALL BE REPAIRED AND RESTAPLED AS NECESSARY TO ENSURE PROPER FUNCTION.

REVISIONS AND CORRECTIONS

JULY 15, 2005

N. GARBACK

EROSION PREVENTION & SEDIMENT CONTROL DETAILS EROSION MATTING FOR DITCHES & SLOPES

PROJECT NAME: JAY
PROJECT NUMBER: ST STP CULV (2)

FILE NAME: 04b140\epsc.dgn PLOT DATE: 23-OCT-2006
PROJECT LEADER: W. SYMONDS DRAWN BY: G. SHANGRAW
DESIGNED BY: T. FILLBACH CHECKED BY: J. LACROIX
epsc1.i SHEET 16 OF 39

SILT FENCE

APPLICATION NOTES:


- A. THE PRIMARY PURPOSE OF SILT FENCE IS TO REDUCE RUNOFF VELOCITY AND TRAP SEDIMENT. VELOCITY IS REDUCED, WATER IS IMPOUNDED BEHIND THE MEASURE, AND SEDIMENT FALLS OUT OF SUSPENSION.
- B. SILT FENCE SHALL NOT BE USED ACROSS CONCENTRATED FLOW.

GENERAL NOTES:



- 1. SILT FENCE SHALL GENERALLY BE PLACED A MINIMUM OF 5 FEET BEYOND TOE OF SLOPE, 10 FEET PREFERRED, TO PROVIDE ADEQUATE AREA FOR SEDIMENT STORAGE AND FACILITATE MAINTENANCE OF SEDIMENT CONTAINMENT AREA.
- 2. SILT FENCE SHALL BE INSTALLED ON A LINE OF EQUAL ELEVATION (CONTOUR). IT MAY BE INSTALLED AT INTERMEDIATE POINTS UP SLOPES AS WELL AS AT THE BOTTOM, AS SHOWN IN THE DETAIL.
- 3. ALL ENDS SHALL BE 'J' HOOKED TO TRAP SEDIMENT.
- 4. IN AREAS WITH TWO SLOPES, SILT FENCE SHALL BE USED TO ERECT A DAM AND TRAP SEDIMENT AT THE BASE OF THE STEEPER SLOPE.
- 5. THE BOTTOM EDGE OF SILT FENCE SHALL BE BURIED A MINIMUM OF 6 INCHES BELOW GROUND, AND KEYED IN 4 INCHES. THE FENCE SHALL BE INSTALLED WITH THE POSTS ON THE DOWNSTREAM SIDE OF THE FABRIC.
- 6. MAXIMUM DRAINAGE AREA TRIBUTARY TO 100 FEET OF SILT FENCE SHALL BE 0.25 ACRES.
- 7. THE FOLLOWING ARE MAXIMUM LENGTHS FOR SILT FENCE INSTALATIONS:

CONSTRUCTED SLOPE	SLOPE LENGTH (LS) FT	HORIZONTAL LENGTH (LH) FT
3H : 1V	80	75
4H : 1V	130	125
5H : 1V	200	200
> 5H : 1V	250	250

- 8. WHERE ELONGATION IS >50%, POST SPACING SHALL NOT EXCERED 4 FEET. WHERE ELONGATION IS <50%, POST SPACING SHALL NOT EXCEED 6 FEET.
- 9. SILT FENCE SHALL BE INSPECTED EVERY SEVEN (7) CALENDAR DAYS AND WITHIN 24 HOURS OF A STORM EVENT GREAT ENOUGH TO CAUSE WATER TO LEAVE THE CONSTRUCTION SITE.
- 10. SILT FENCE SHALL BE CLEANED AND REPAIRED AS NEEDED. SEDIMENT SHALL BE REMOVED WHEN ACCUMULATION REACHES ONE-HALF OF THE MEASURE HEIGHT. SEDIMENT SHALL BE DISPOSED OF AT AN APPROVED WASTE SITE.
- 11. SILT FENCE SHALL BE REMOVED WHEN THE AREA HAS BEEN STABILIZED. AT TIME OF REMOVAL OF THE SILT FENCE, THE DISTURBED AREA SHALL BE REPAIRED AND STABILIZED.

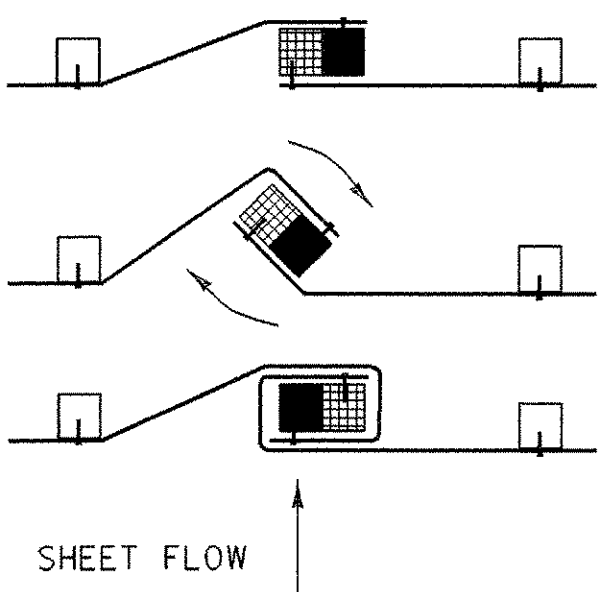

SPlicing DETAIL
NOT TO SCALE

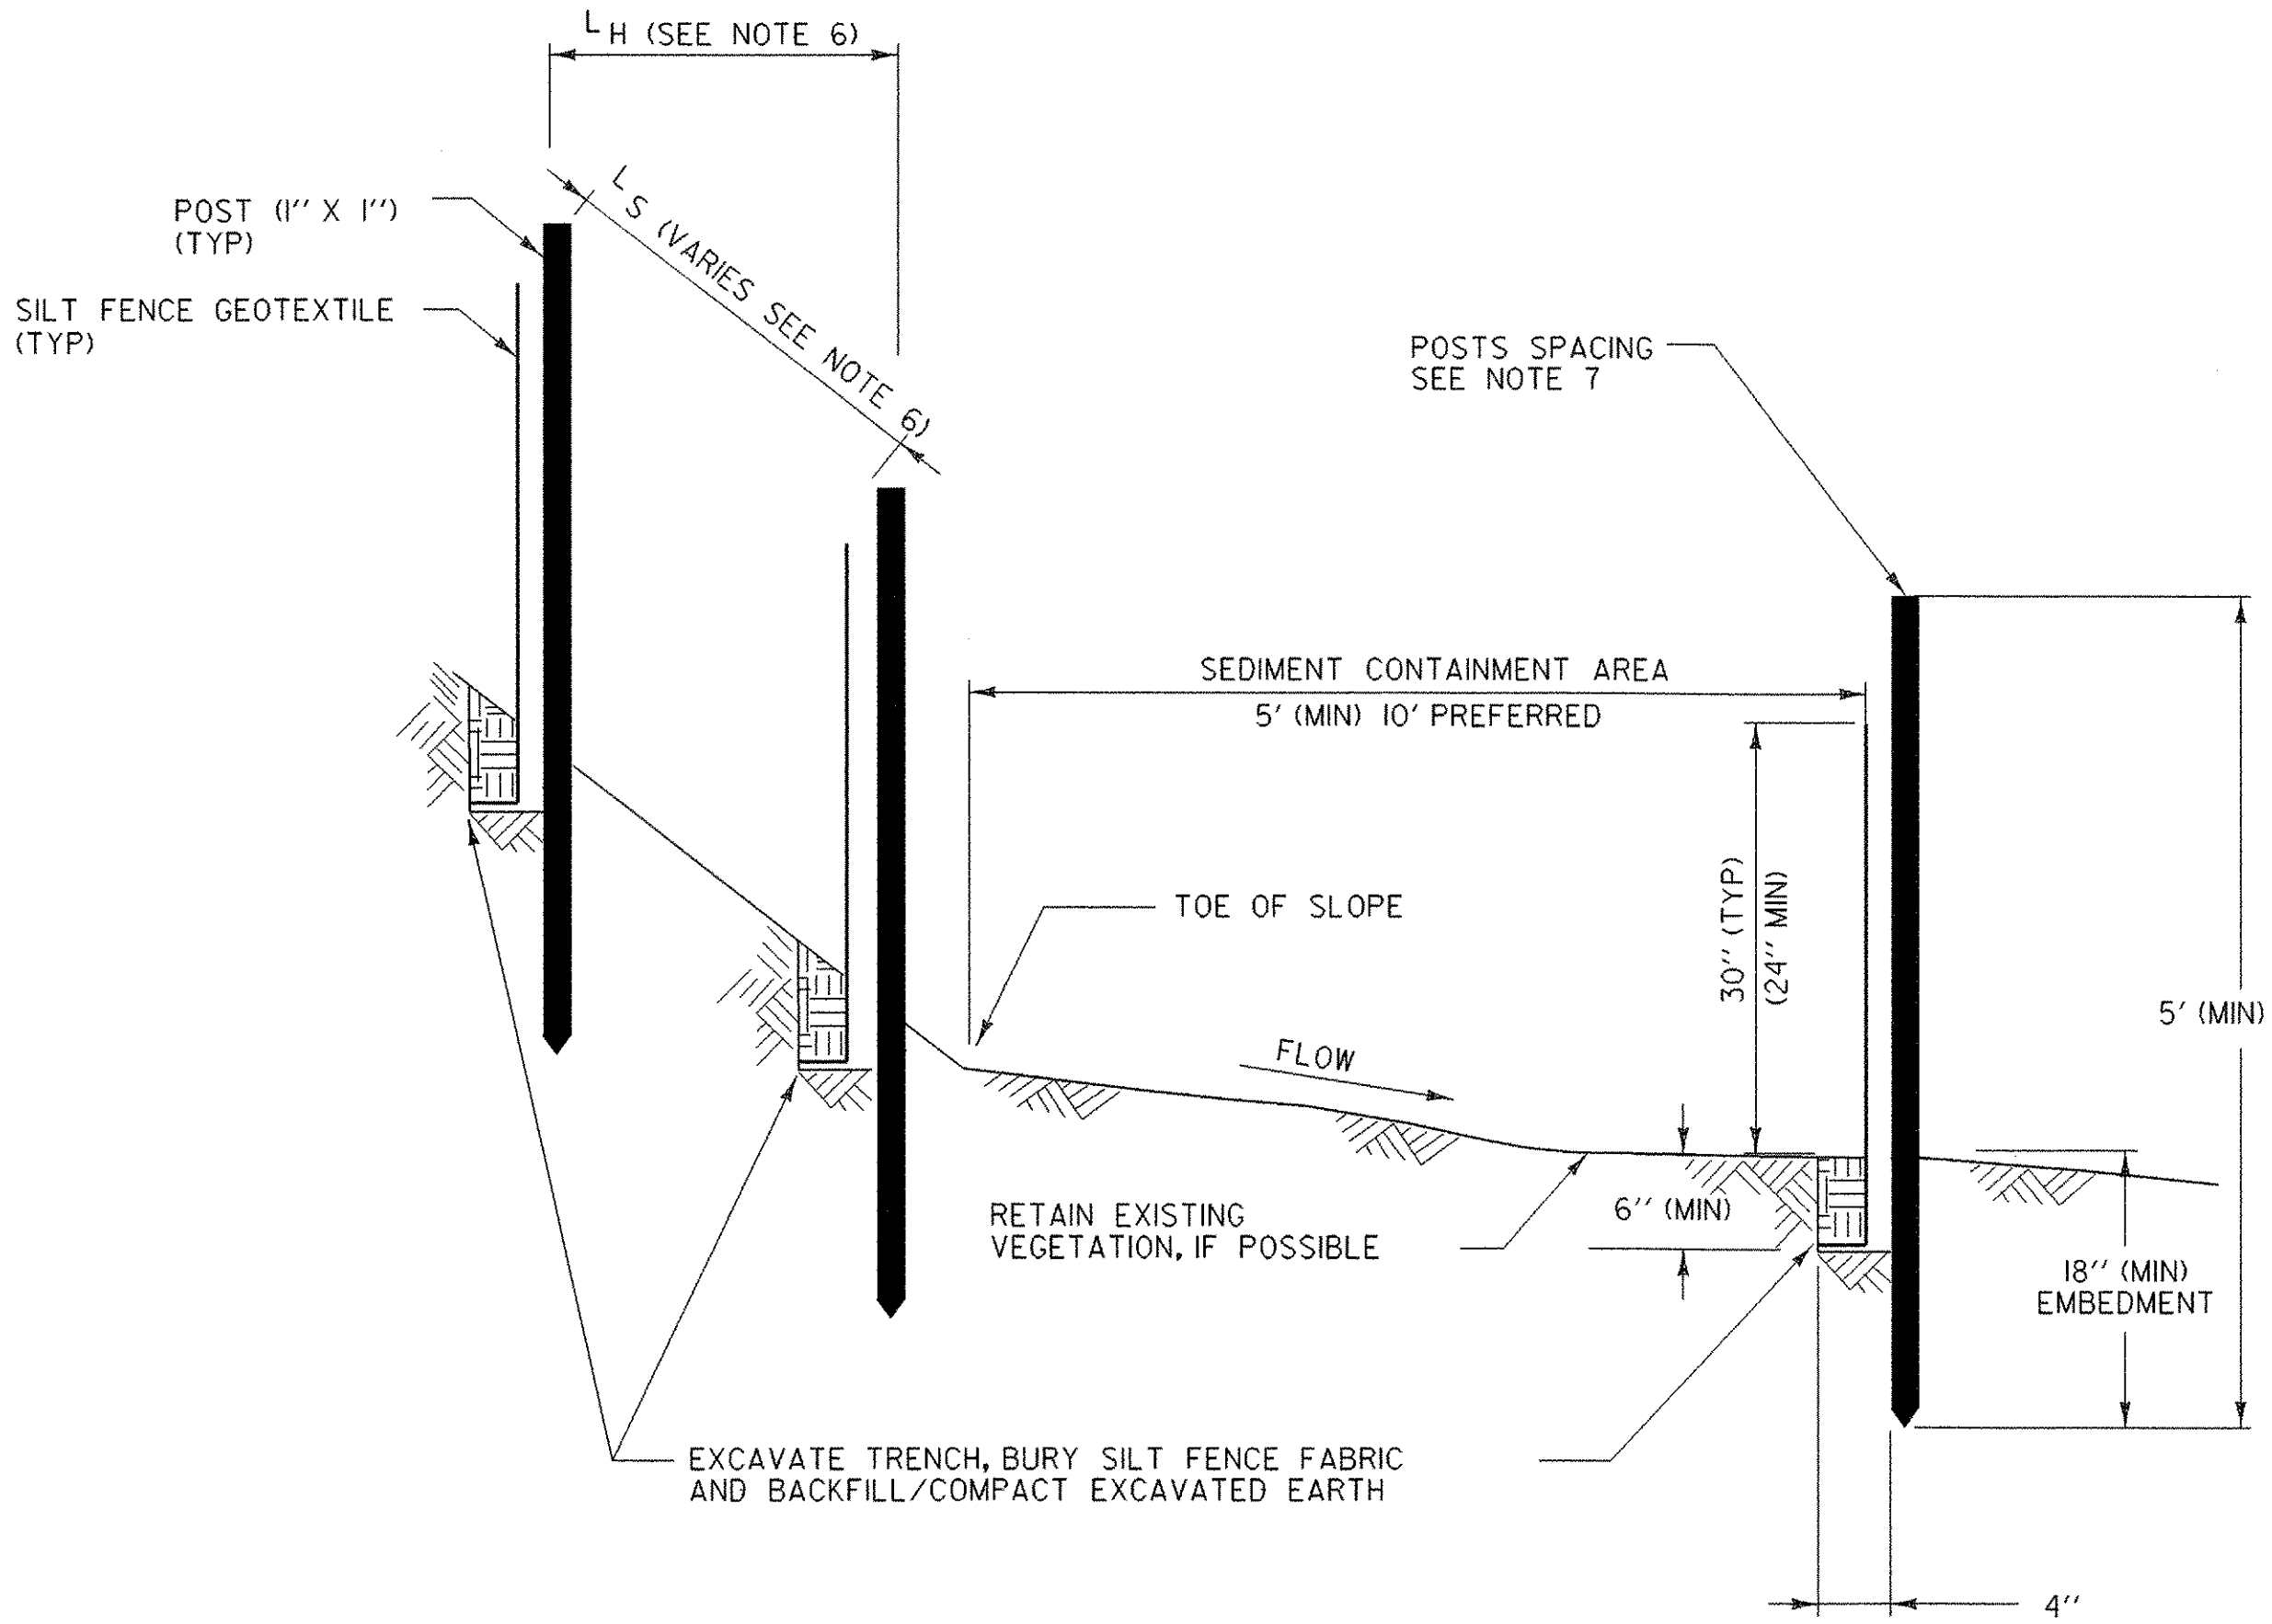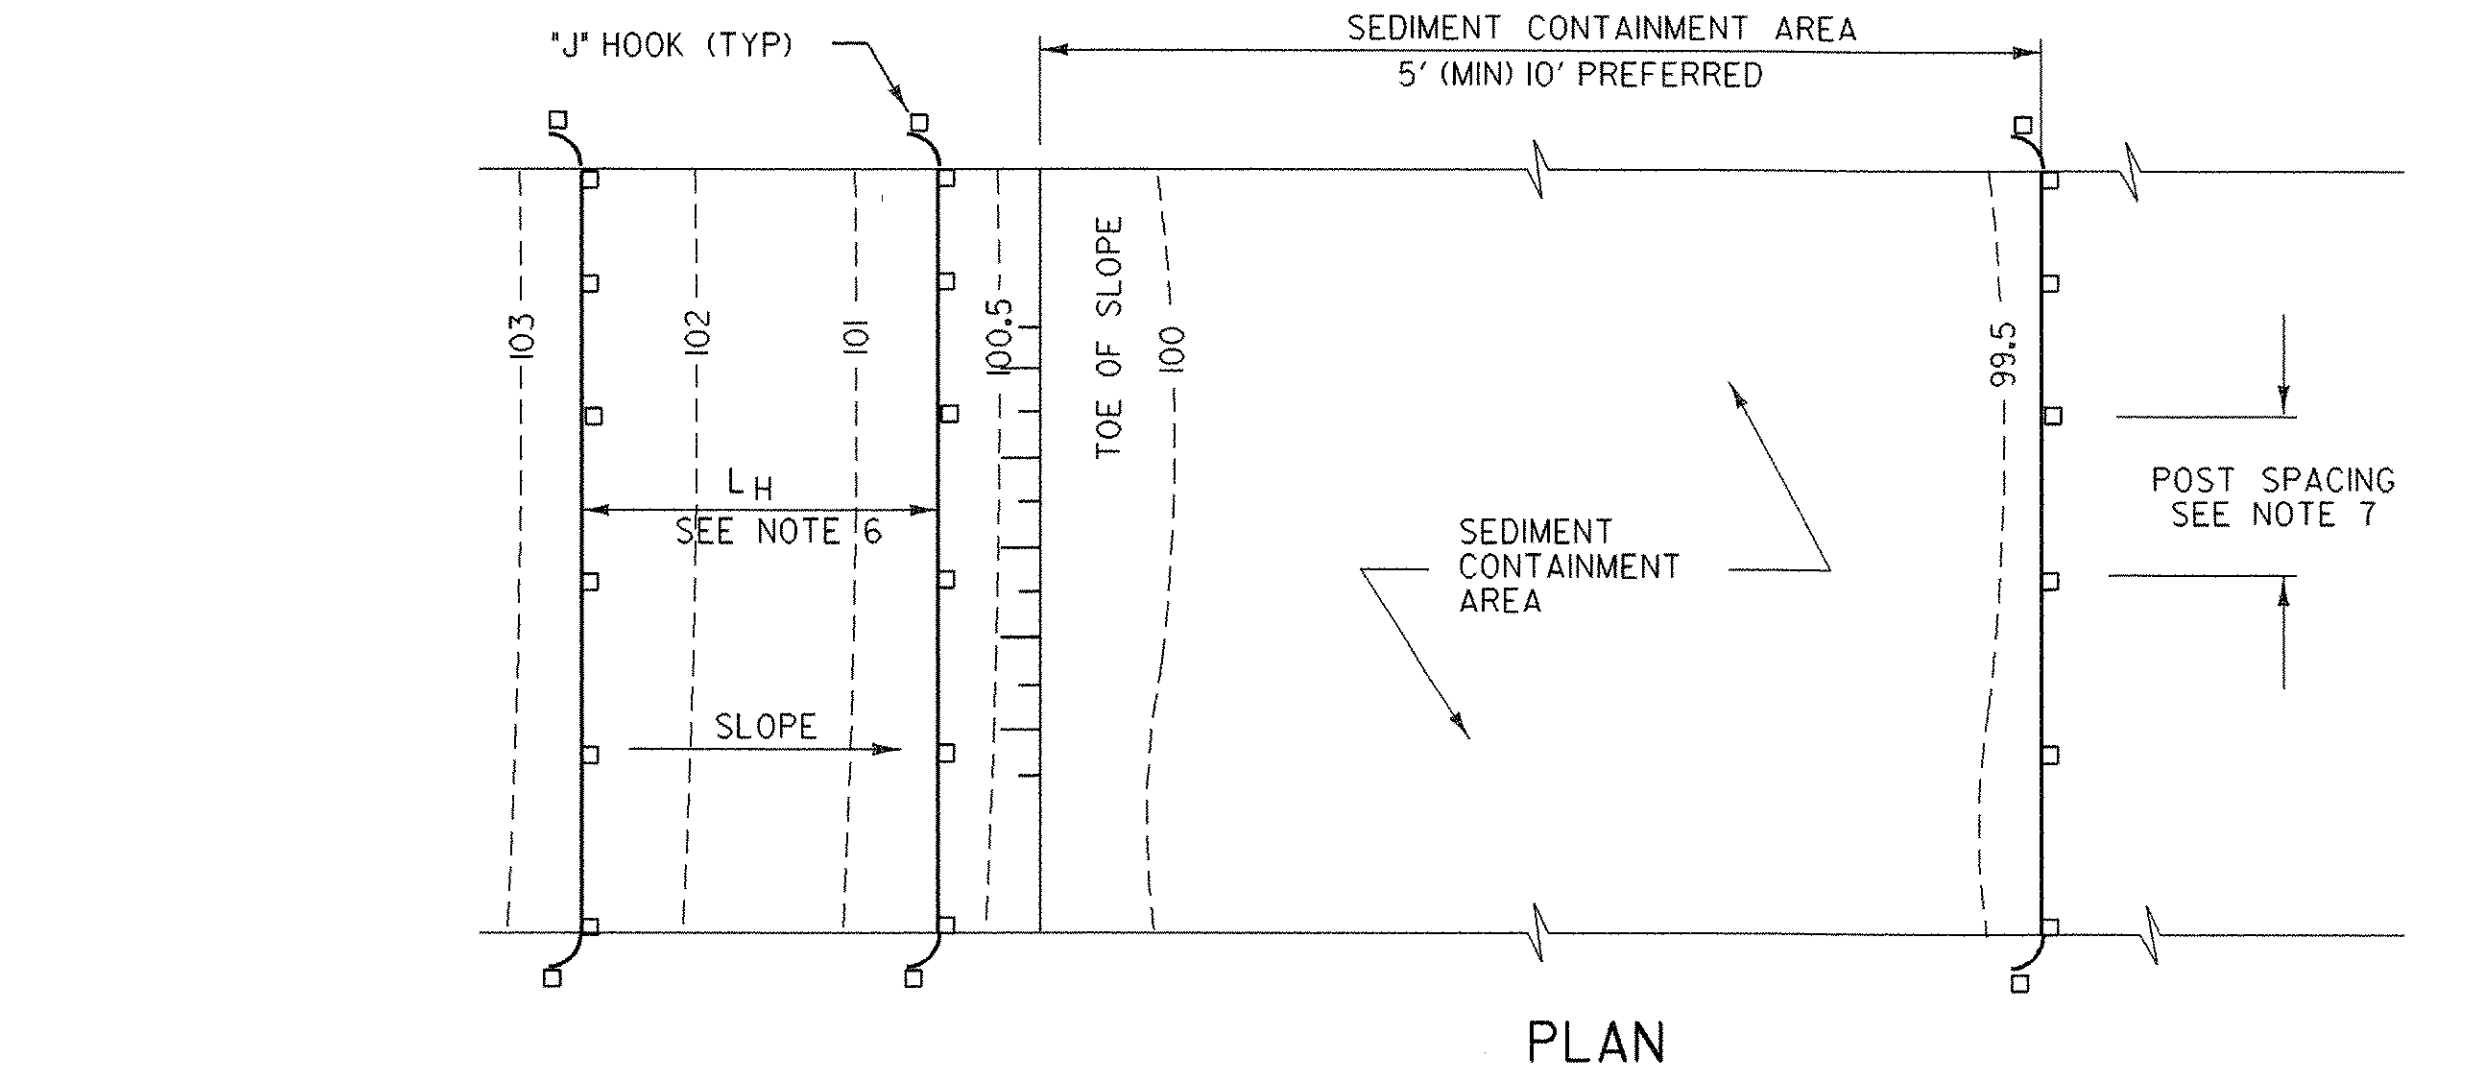

SECTION
SILT FENCE - TEMPORARY
NOT TO SCALE

REVISIONS AND CORRECTIONS
JULY 15, 2005 N. GARBICK

EROSION PREVENTION &
SEDIMENT CONTROL DETAILS
SILT FENCE

PROJECT NAME: JAY
PROJECT NUMBER: ST STP CULV (2)
FILE NAME: 04b140\epsc.dgn PLOT DATE: 23-OCT-2006
PROJECT LEADER: W. SYMONDS DRAWN BY: G. SHANGRAW
DESIGNED BY: T. FILLBACH CHECKED BY: J. LACROIX
epsc3.i SHEET 18 OF 39


STABILIZED VEHICLE TRACKING PAD

APPLICATION NOTES:


A. THE PURPOSE OF A STABILIZED VEHICLE TRACKING PAD IS TO REDUCE OR ELIMINATE THE TRACKING OF SEDIMENT ONTO PUBLIC RIGHTS OF WAY OR STREETS.

GENERAL NOTES:


1. STONE SIZE - USE CLEAN STONE WITH GRADATION BETWEEN 2 INCHES AND 4 INCHES .
2. LENGTH - 50 FEET (MIN)
3. THICKNESS - 18 INCHES (MIN)
4. WIDTH - 12 FEET (MIN)
5. GEOTEXTILE UNDER STONE WILL BE PLACED OVER THE ENTIRE AREA PRIOR TO PLACING OF STONE.
6. SURFACE WATER - ALL SURFACE WATER FLOWING OR DIVERTED TOWARD VEHICLE TRACKING PADS SHALL BE PIPED ACROSS THE ENTRANCE AS DIRECTED BY THE ENGINEER, IF PIPING IS IMPRACTICAL, A MOUNTABLE BERM WITH 5:1 SLOPES WILL BE PERMITTED.
7. PROPOSED DRAINAGE PIPES SHALL BE SIZED WITH SUFFICIENT CAPACITY TO CARRY DITCH FLOWS. ALTERNATIVE WAYS OF TRANSPORTING DITCH DRAINAGE ACROSS VEHICLE TRACKING PADS MAY BE PROPOSED BY THE CONTRACTOR FOR APPROVAL BY THE ENGINEER.
8. WHEN WASHING OF VEHICLE IS NECESSARY, IT SHALL BE DONE ON AN AREA STABILIZED WITH STONE WHICH DRAINS INTO AN APPROVED SEDIMENT TRAPPING DEVICE.
9. MEASURES SHALL BE INSPECTED EVERY SEVEN (7) CALENDAR DAYS AND WITHIN 24 HOURS OF A STORM EVENT GREAT ENOUGH TO CAUSE WATER TO LEAVE THE CONSTRUCTION SITE.
10. MAINTENANCE- THE ENTRANCE SHALL BE MAINTAINED IN A CONDITION WHICH WILL PREVENT TRACKING OR FLOWING OF SEDIMENT ONTO PUBLIC RIGHTS-OF-WAY. ALL SEDIMENT SPILLED, DROPPED, WASHED, OR TRACKED ONTO PUBLIC RIGHTS-OF-WAY MUST BE REMOVED IMMEDIATELY.
11. AT THE TIME OF REMOVAL OF THE STABILIZED VEHICLE TRACKING PAD THE DISTURBED AREA SHALL BE REPAIRED AND STABILIZED.
12. PAYMENT OF THE STABILIZED VEHICLE TRACKING PAD SHALL BE MADE UNDER APPLICABLE ITEMS INCLUDED IN THE CONTRACT PLANS OR UNDER THE FIELD MAINTENANCE OF EROSION & SEDIMENT CONTROL PLAN ITEM.
13. PAYMENT FOR MONITORING STABILIZED VEHICLE TRACKING PADS SHALL BE MADE UNDER THE MONITORING EROSION & SEDIMENT CONTROL PLAN ITEM.
14. PAYMENT FOR MAINTAINING THE VEHICLE TRACKING PAD SHALL BE MADE UNDER THE MAINTENANCE OF EROSION & SEDIMENT CONTROL PLAN ITEM, UNLESS MAINTENANCE IS REQUIRED DUE TO POOR INSTALLATION PRACTICES.

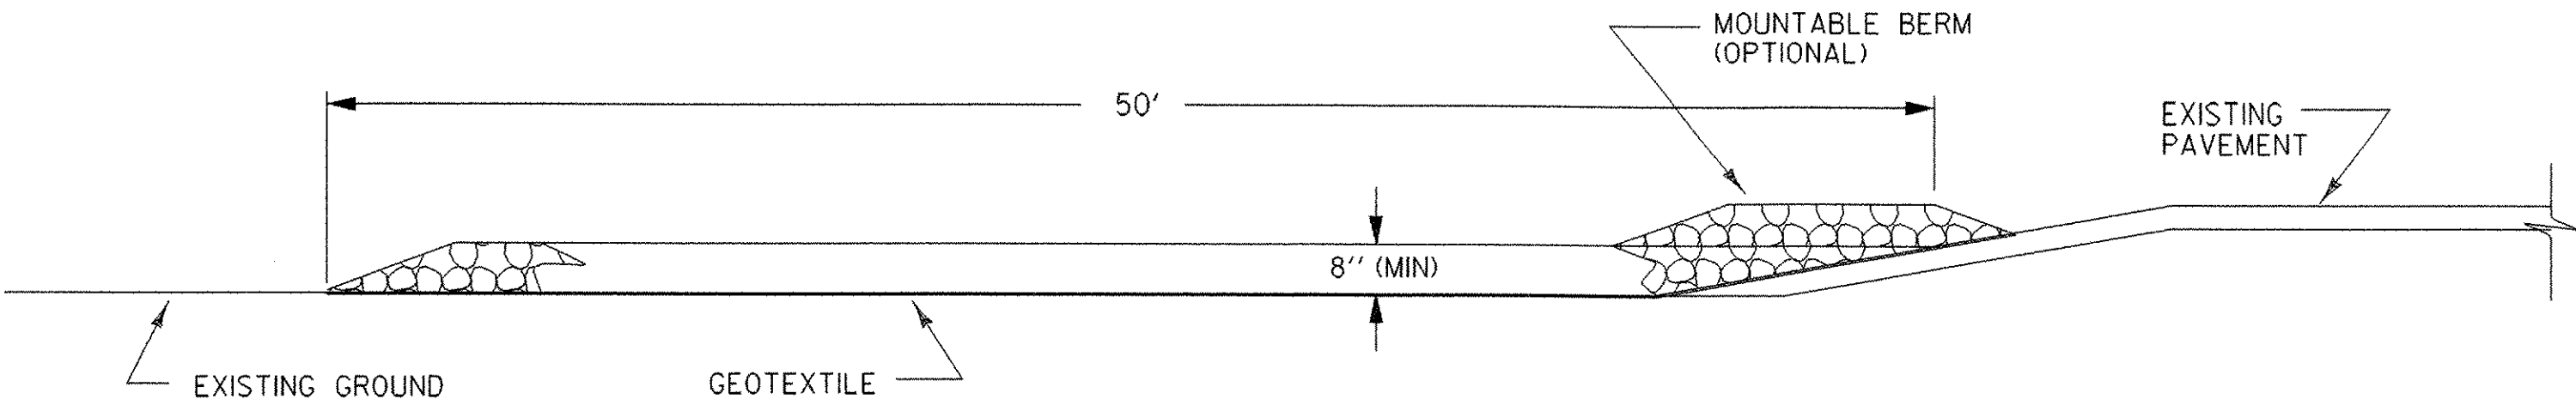

TYPICAL VEHICLE TRACKING PAD PROFILE
(CUT AND DITCH SECTIONS)

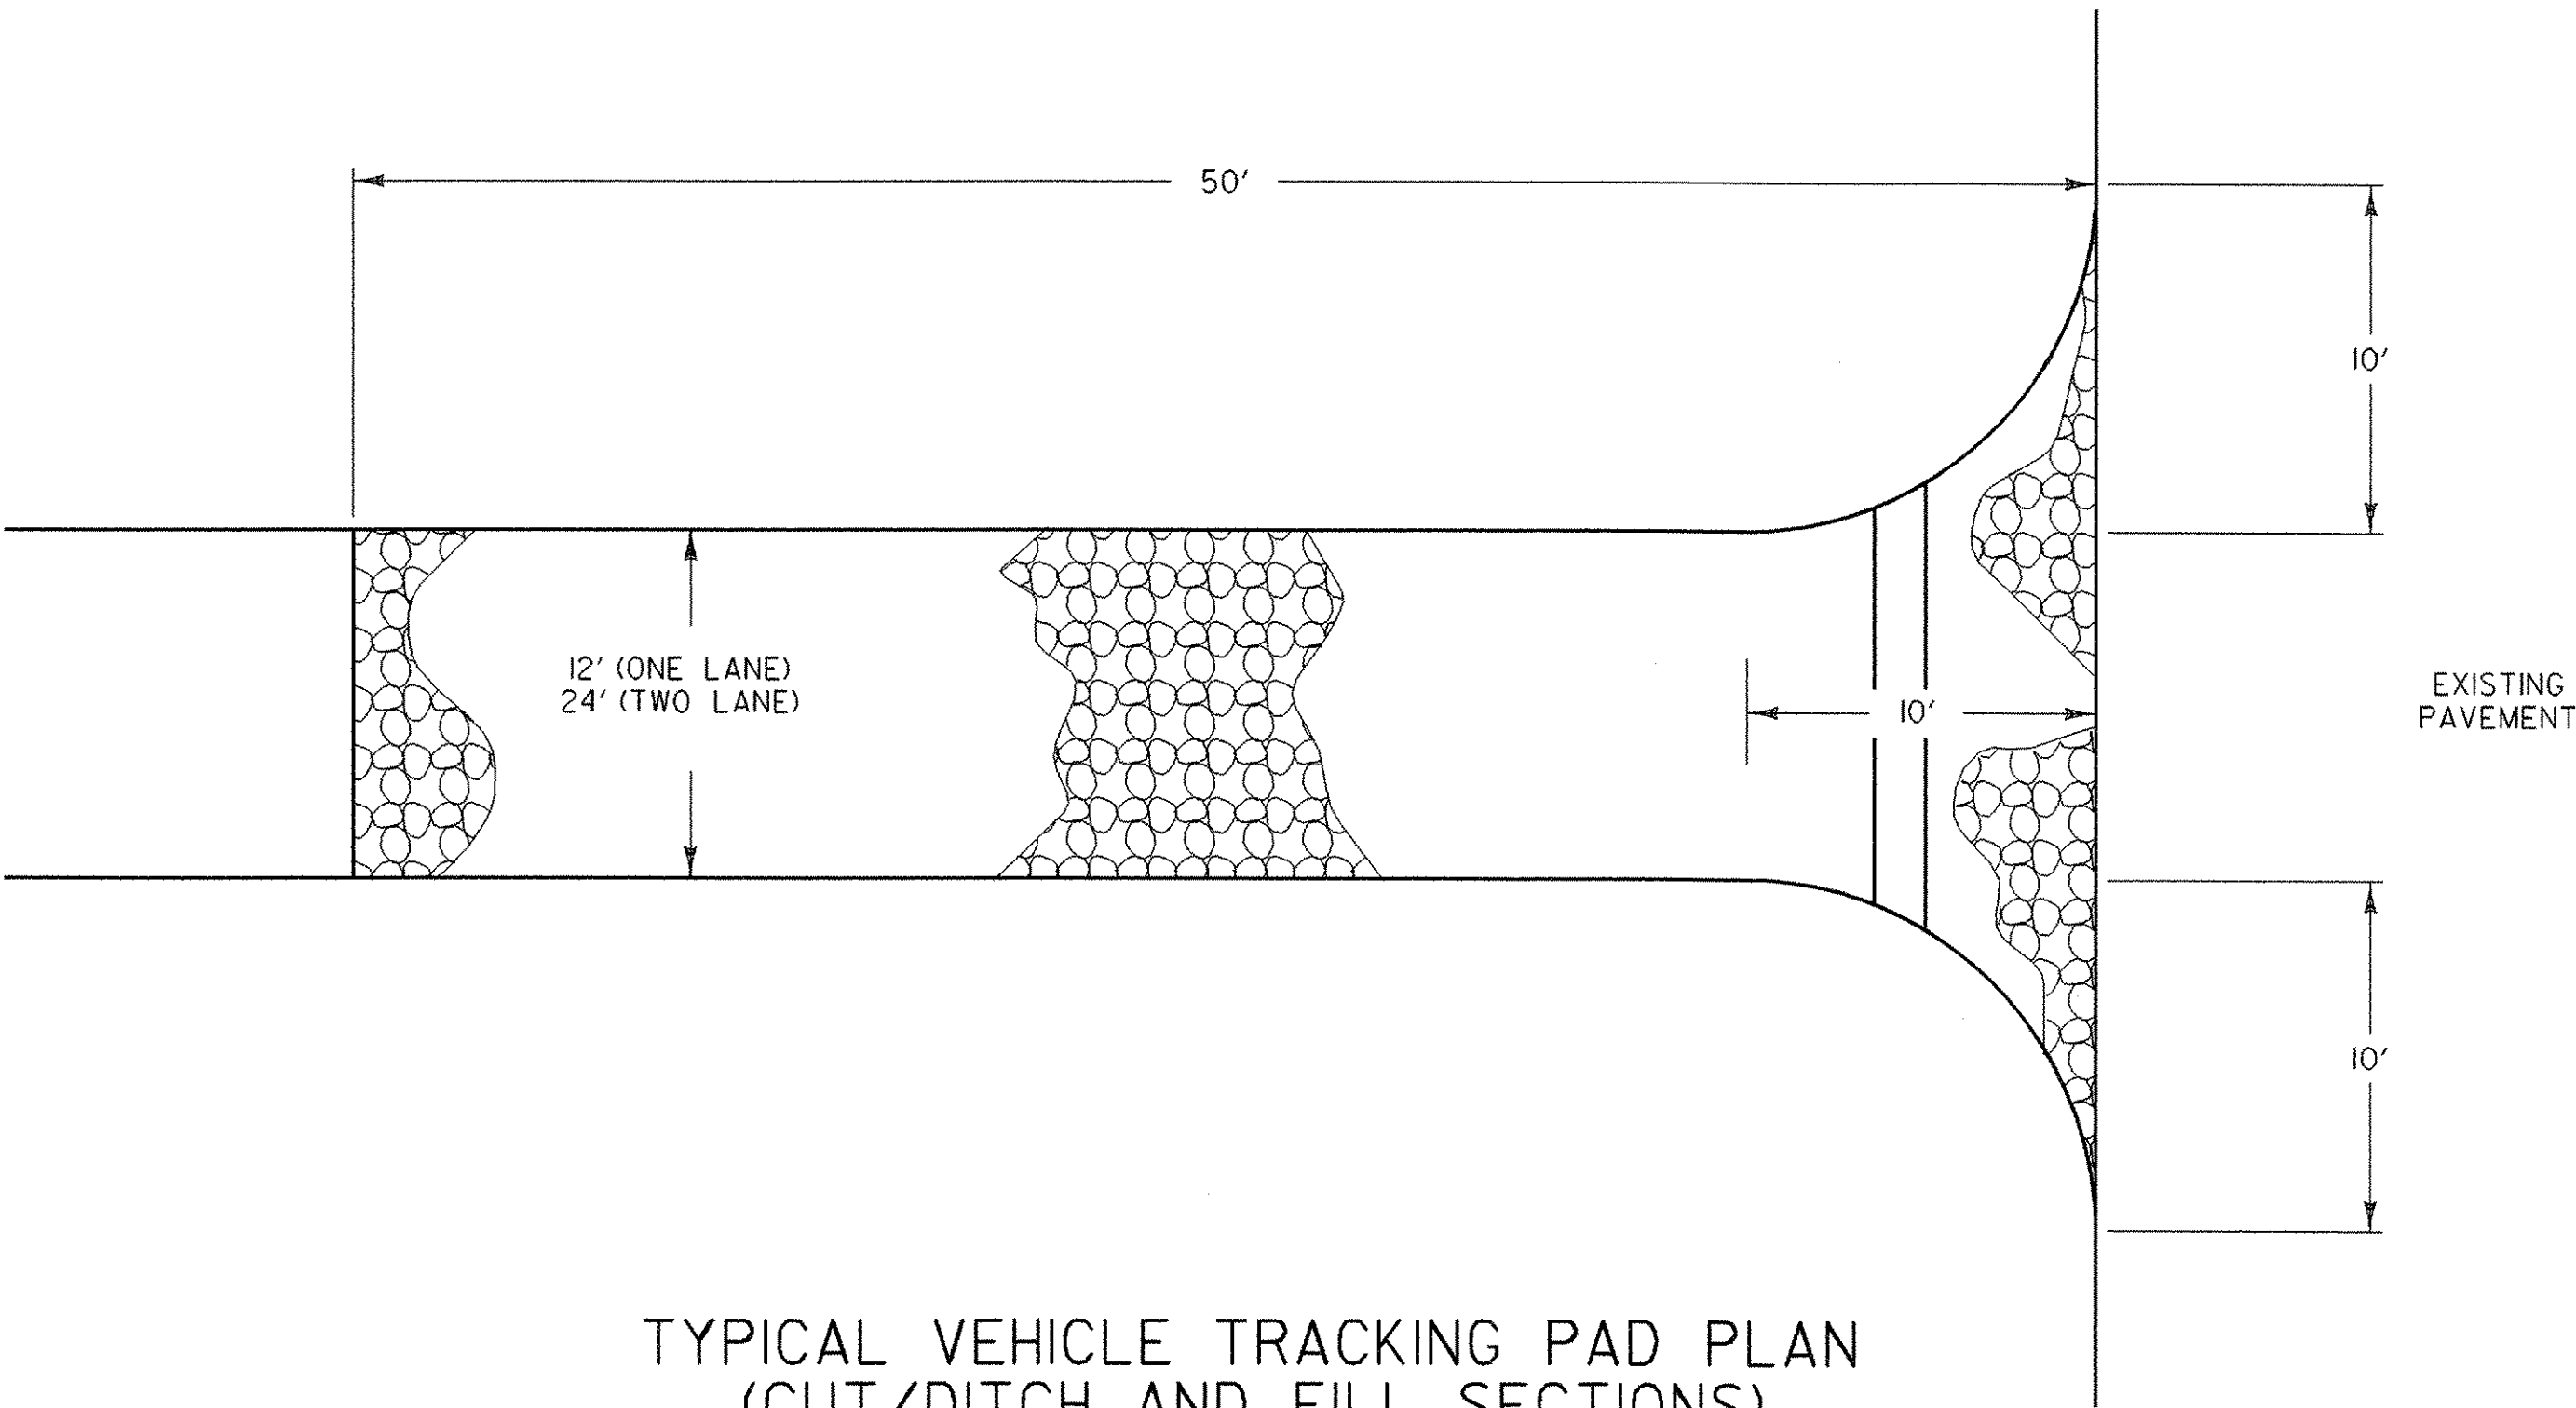

TYPICAL VEHICLE TRACKING PAD PLAN
(CUT/DITCH AND FILL SECTIONS)

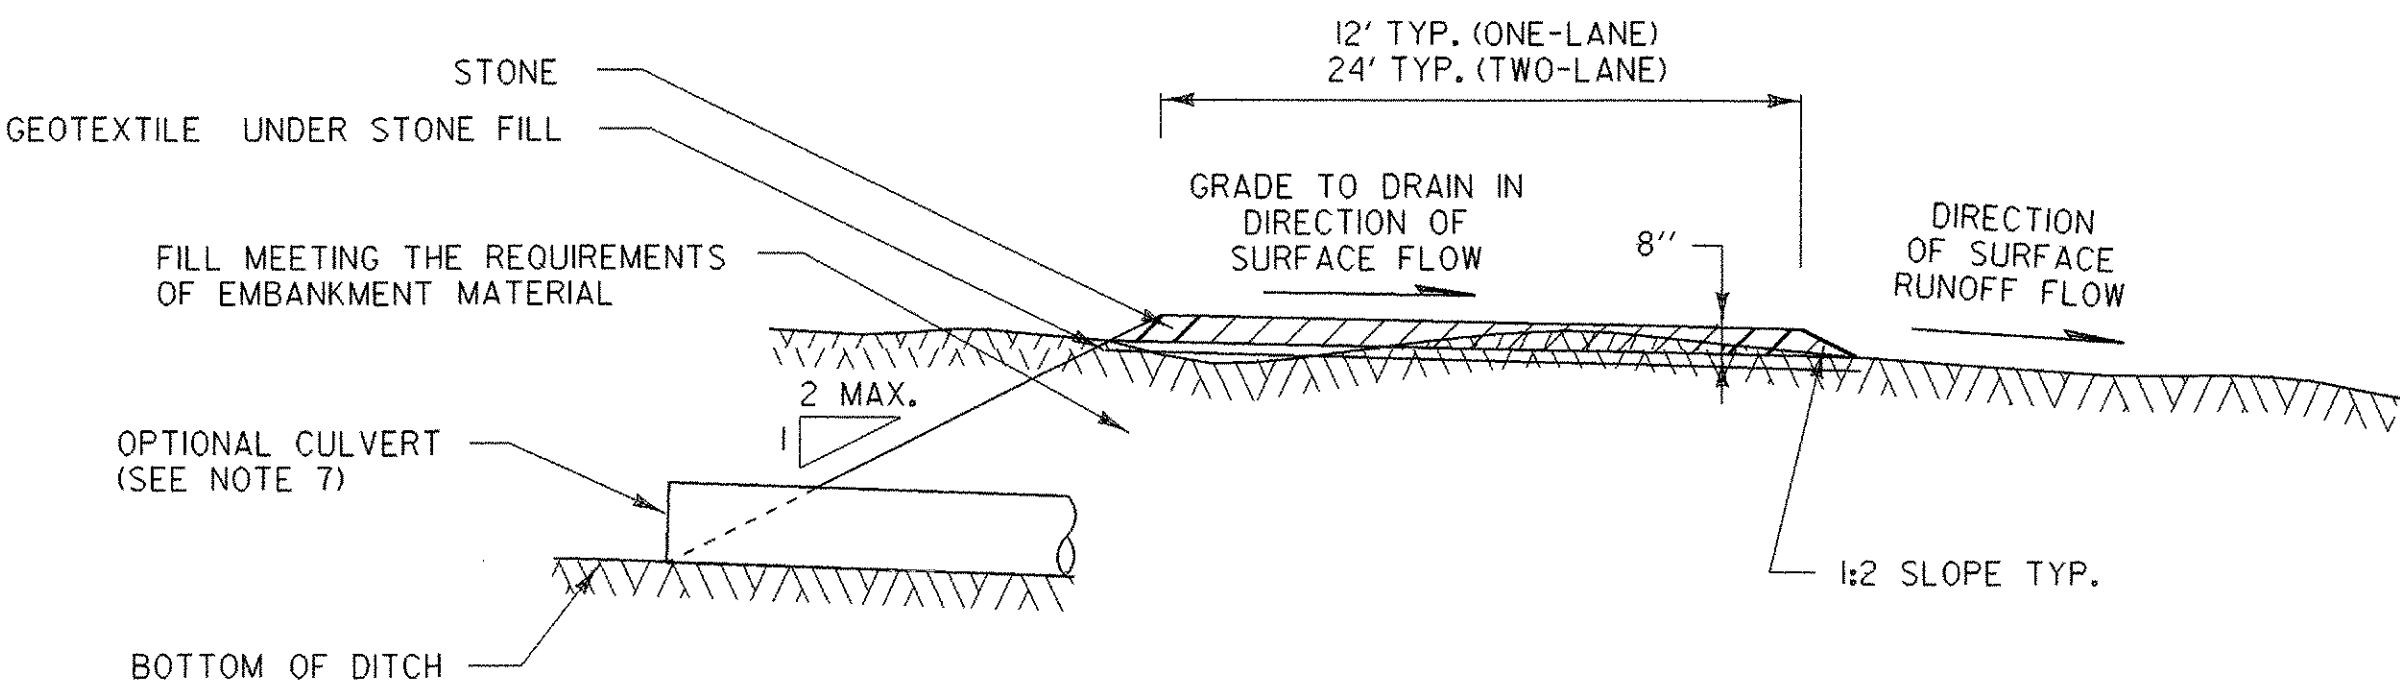



TYPICAL VEHICLE TRACKING PAD SECTION

REVISIONS AND CORRECTIONS
MAY 18, 2004 N. GARBACH

EROSION PREVENTION &
SEDIMENT CONTROL DETAILS
VEHICLE TRACKING PAD


PROJECT NAME: JAY
PROJECT NUMBER: ST STP CULV (2)
FILE NAME: 04b140\epsc.dgn PLOT DATE: 23-OCT-2006
PROJECT LEADER: W. SYMONDS DRAWN BY: G. SHANGRAW
DESIGNED BY: T. FILLBACH CHECKED BY: J. LACROIX
epsc4.i SHEET 19 OF 39

THIS PROJECT WILL REQUIRE TWO (2) PORTABLE CHANGABLE MESSAGE SIGNS.
THE TWO PORTABLE CHANGABLE MESSAGE SIGNS SHALL BE FULLY OPERATIONAL
A MINIMUM OF TWO WEEKS PRIOR TO THE CLOSURE OF VT.105. SEE DETOUR
SHEET #1 FOR PLACEMENT DETAILS AND THE PROPOSED MESSAGE.

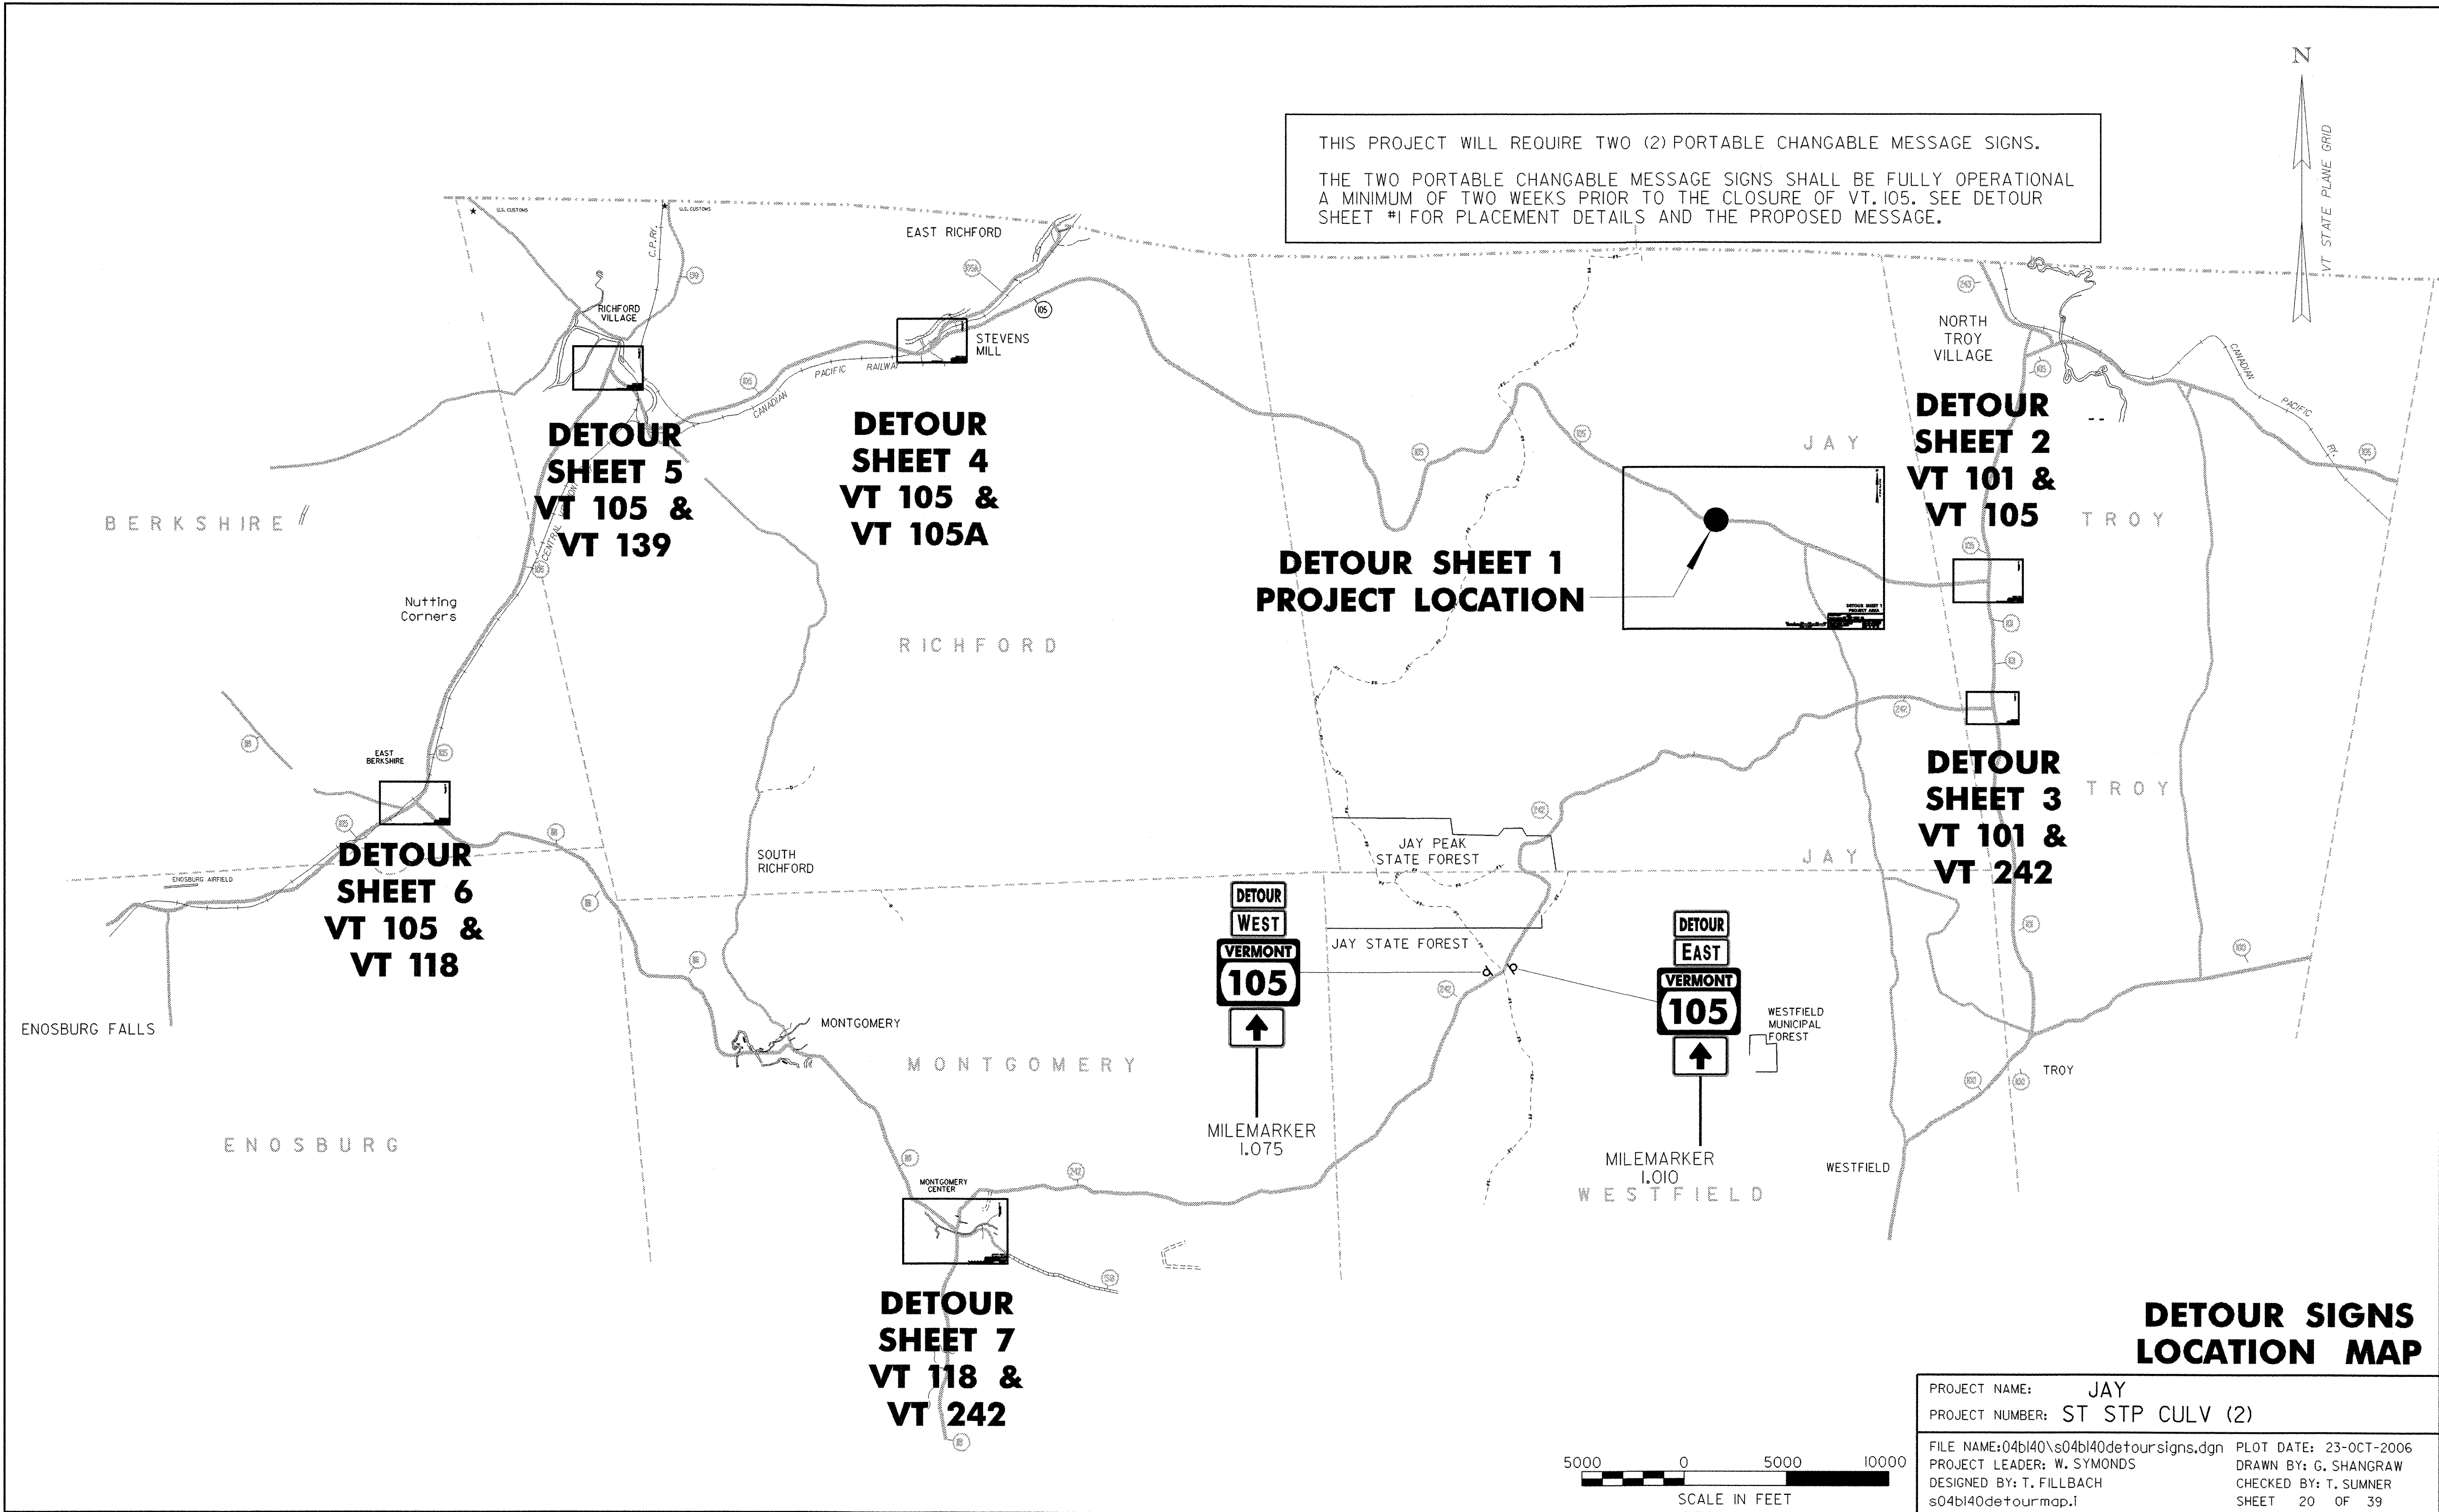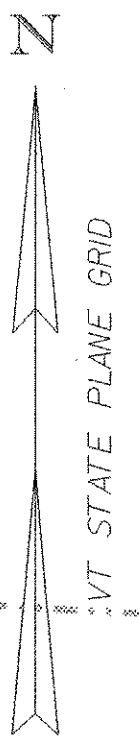


DETOUR SIGNS LOCATION MAP


PROJECT NAME:	JAY	FILE NAME:	s04b140\detoursigns.dgn	PLOT DATE:	23-OCT-2006
PROJECT NUMBER:	ST STP CULV (2)	PROJECT LEADER:	W. SYMONDS	DRAWN BY:	G. SHANGRAW
		DESIGNED BY:	T. FILLBACH	CHECKED BY:	T. SUMNER
			s04b140detourmap.i		SHEET 20 OF 39

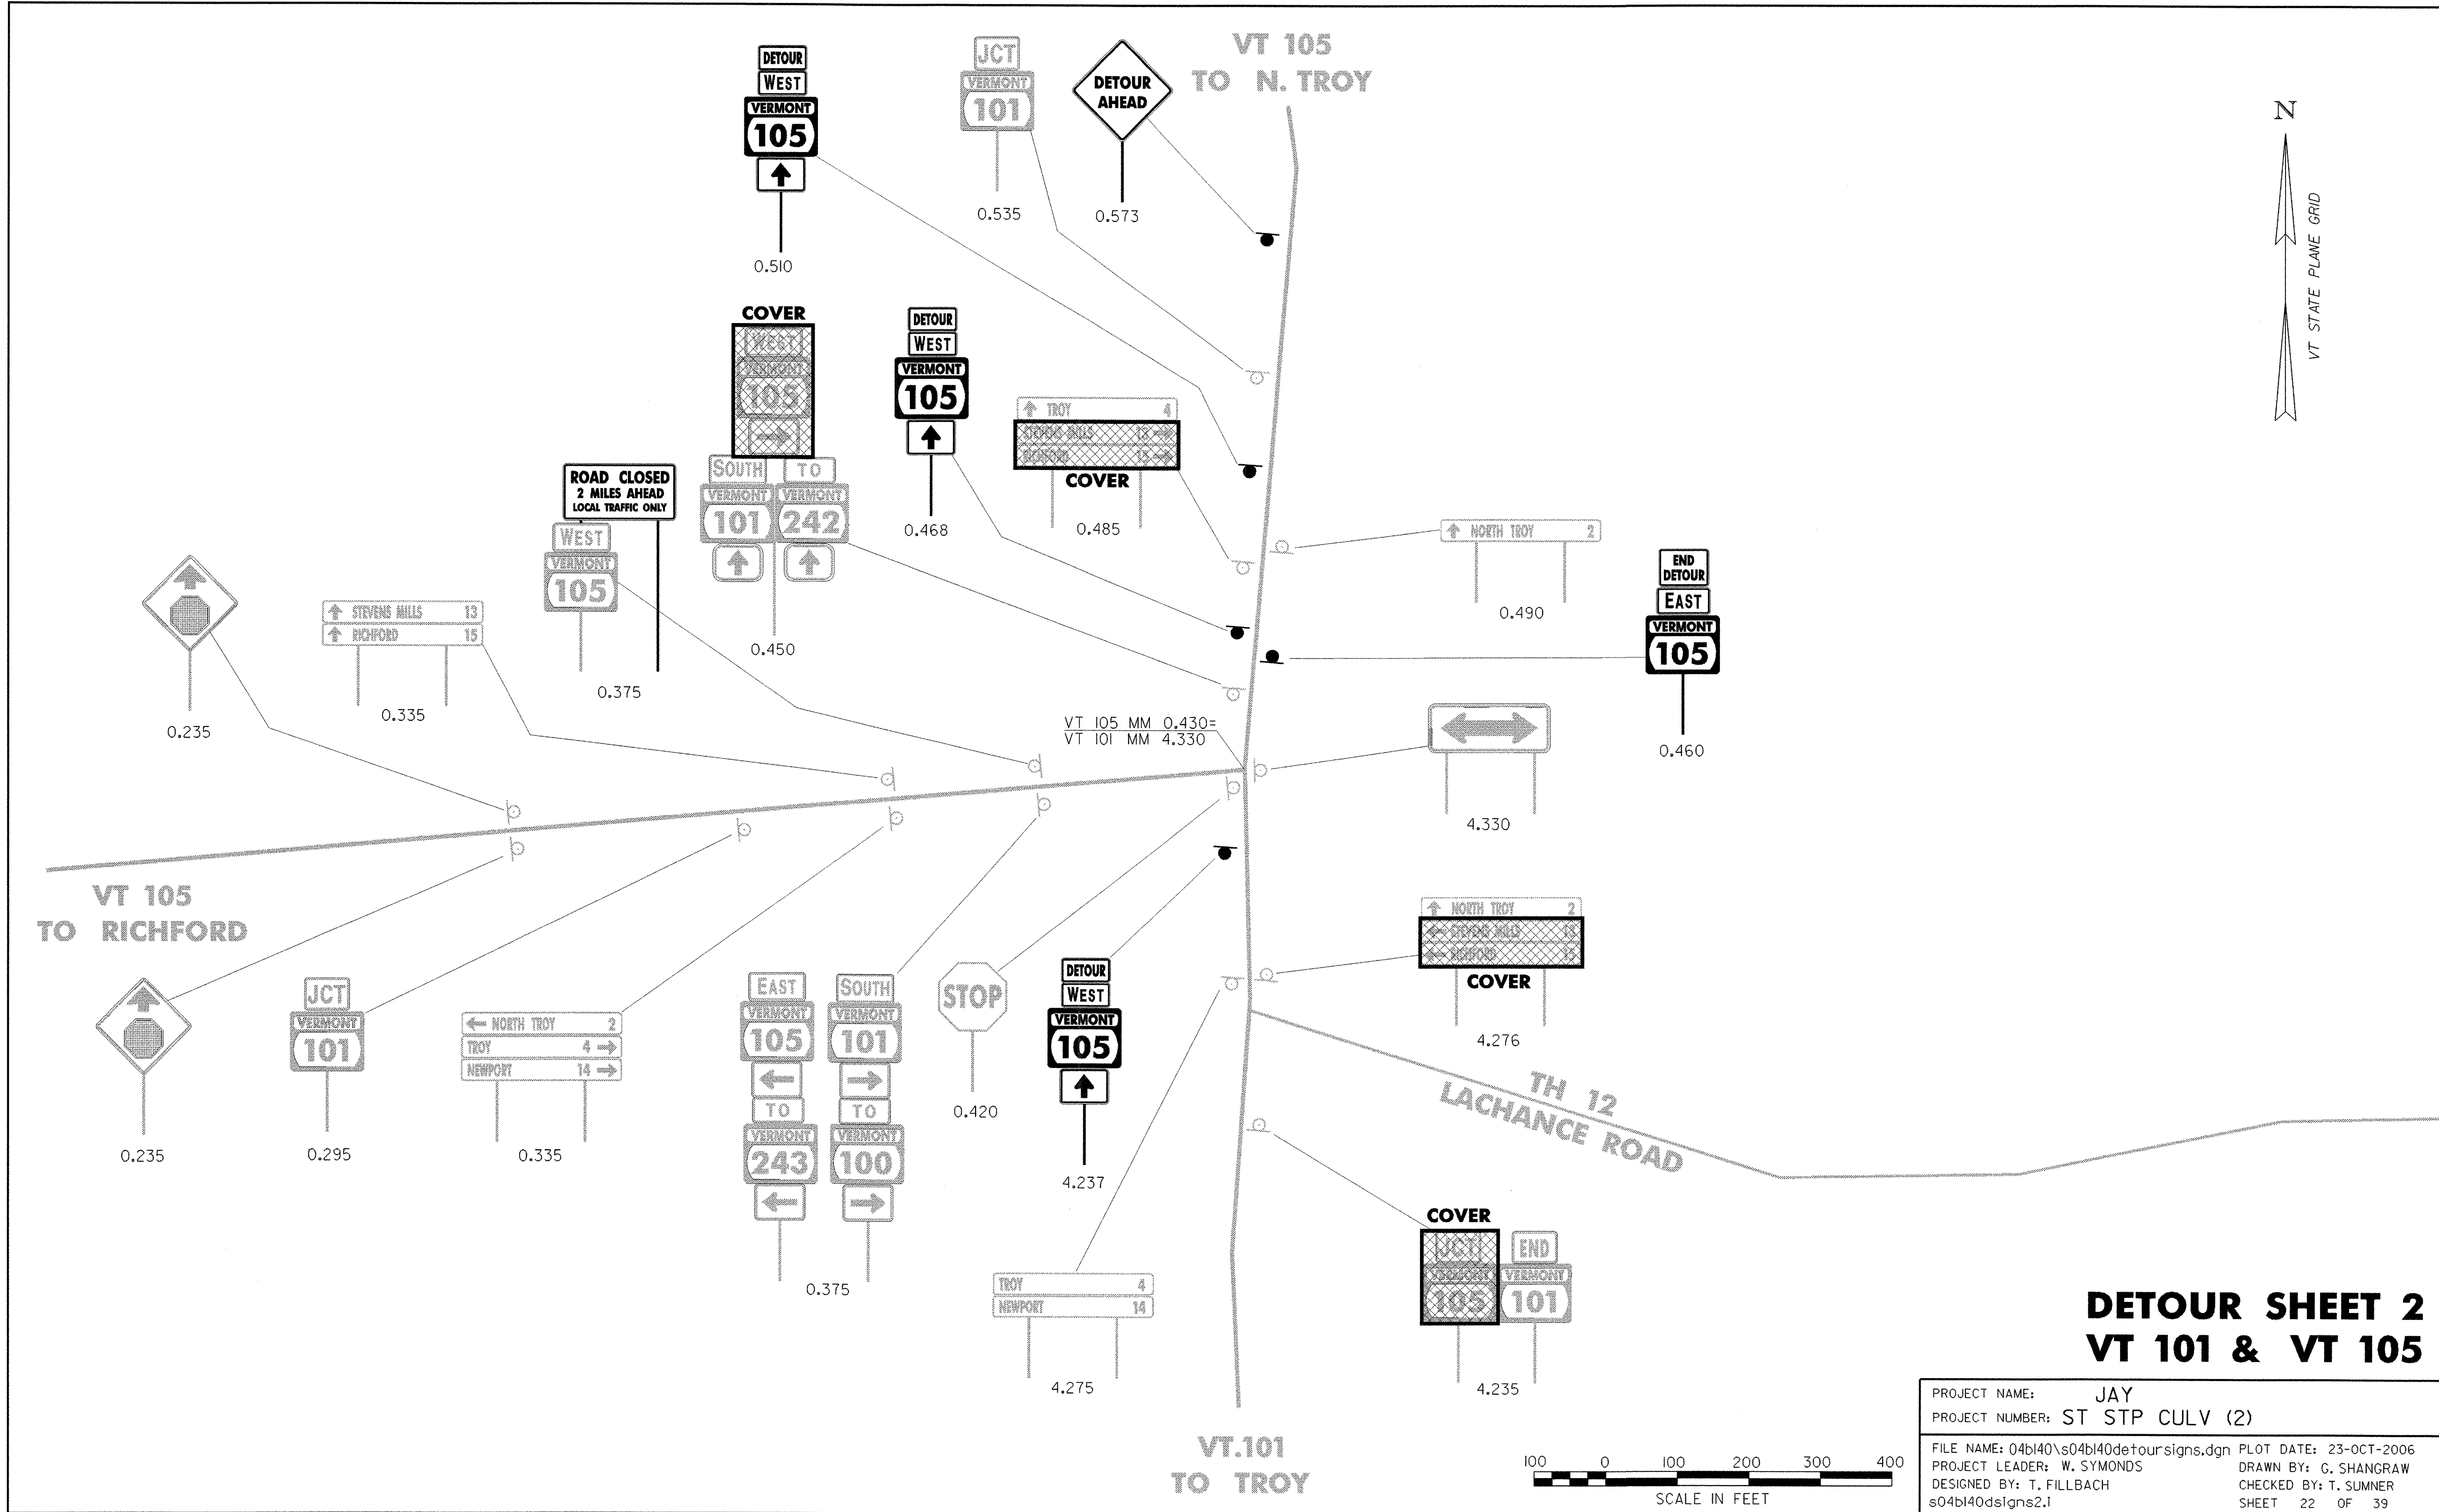

DETOUR SHEET 2 VT 101 & VT 105



PROJECT NAME:	JAY	FILE NAME:	04b140\04b140detoursigns.dgn	PLOT DATE:	23-OCT-2006
PROJECT NUMBER:	ST STP CULV (2)	PROJECT LEADER:	W. SYMONDS	DRAWN BY:	G. SHANGRAW
		DESIGNED BY:	T. FILLBACH	CHECKED BY:	T. SUMNER
			s04b140dsigns2.1		SHEET 22 OF 39

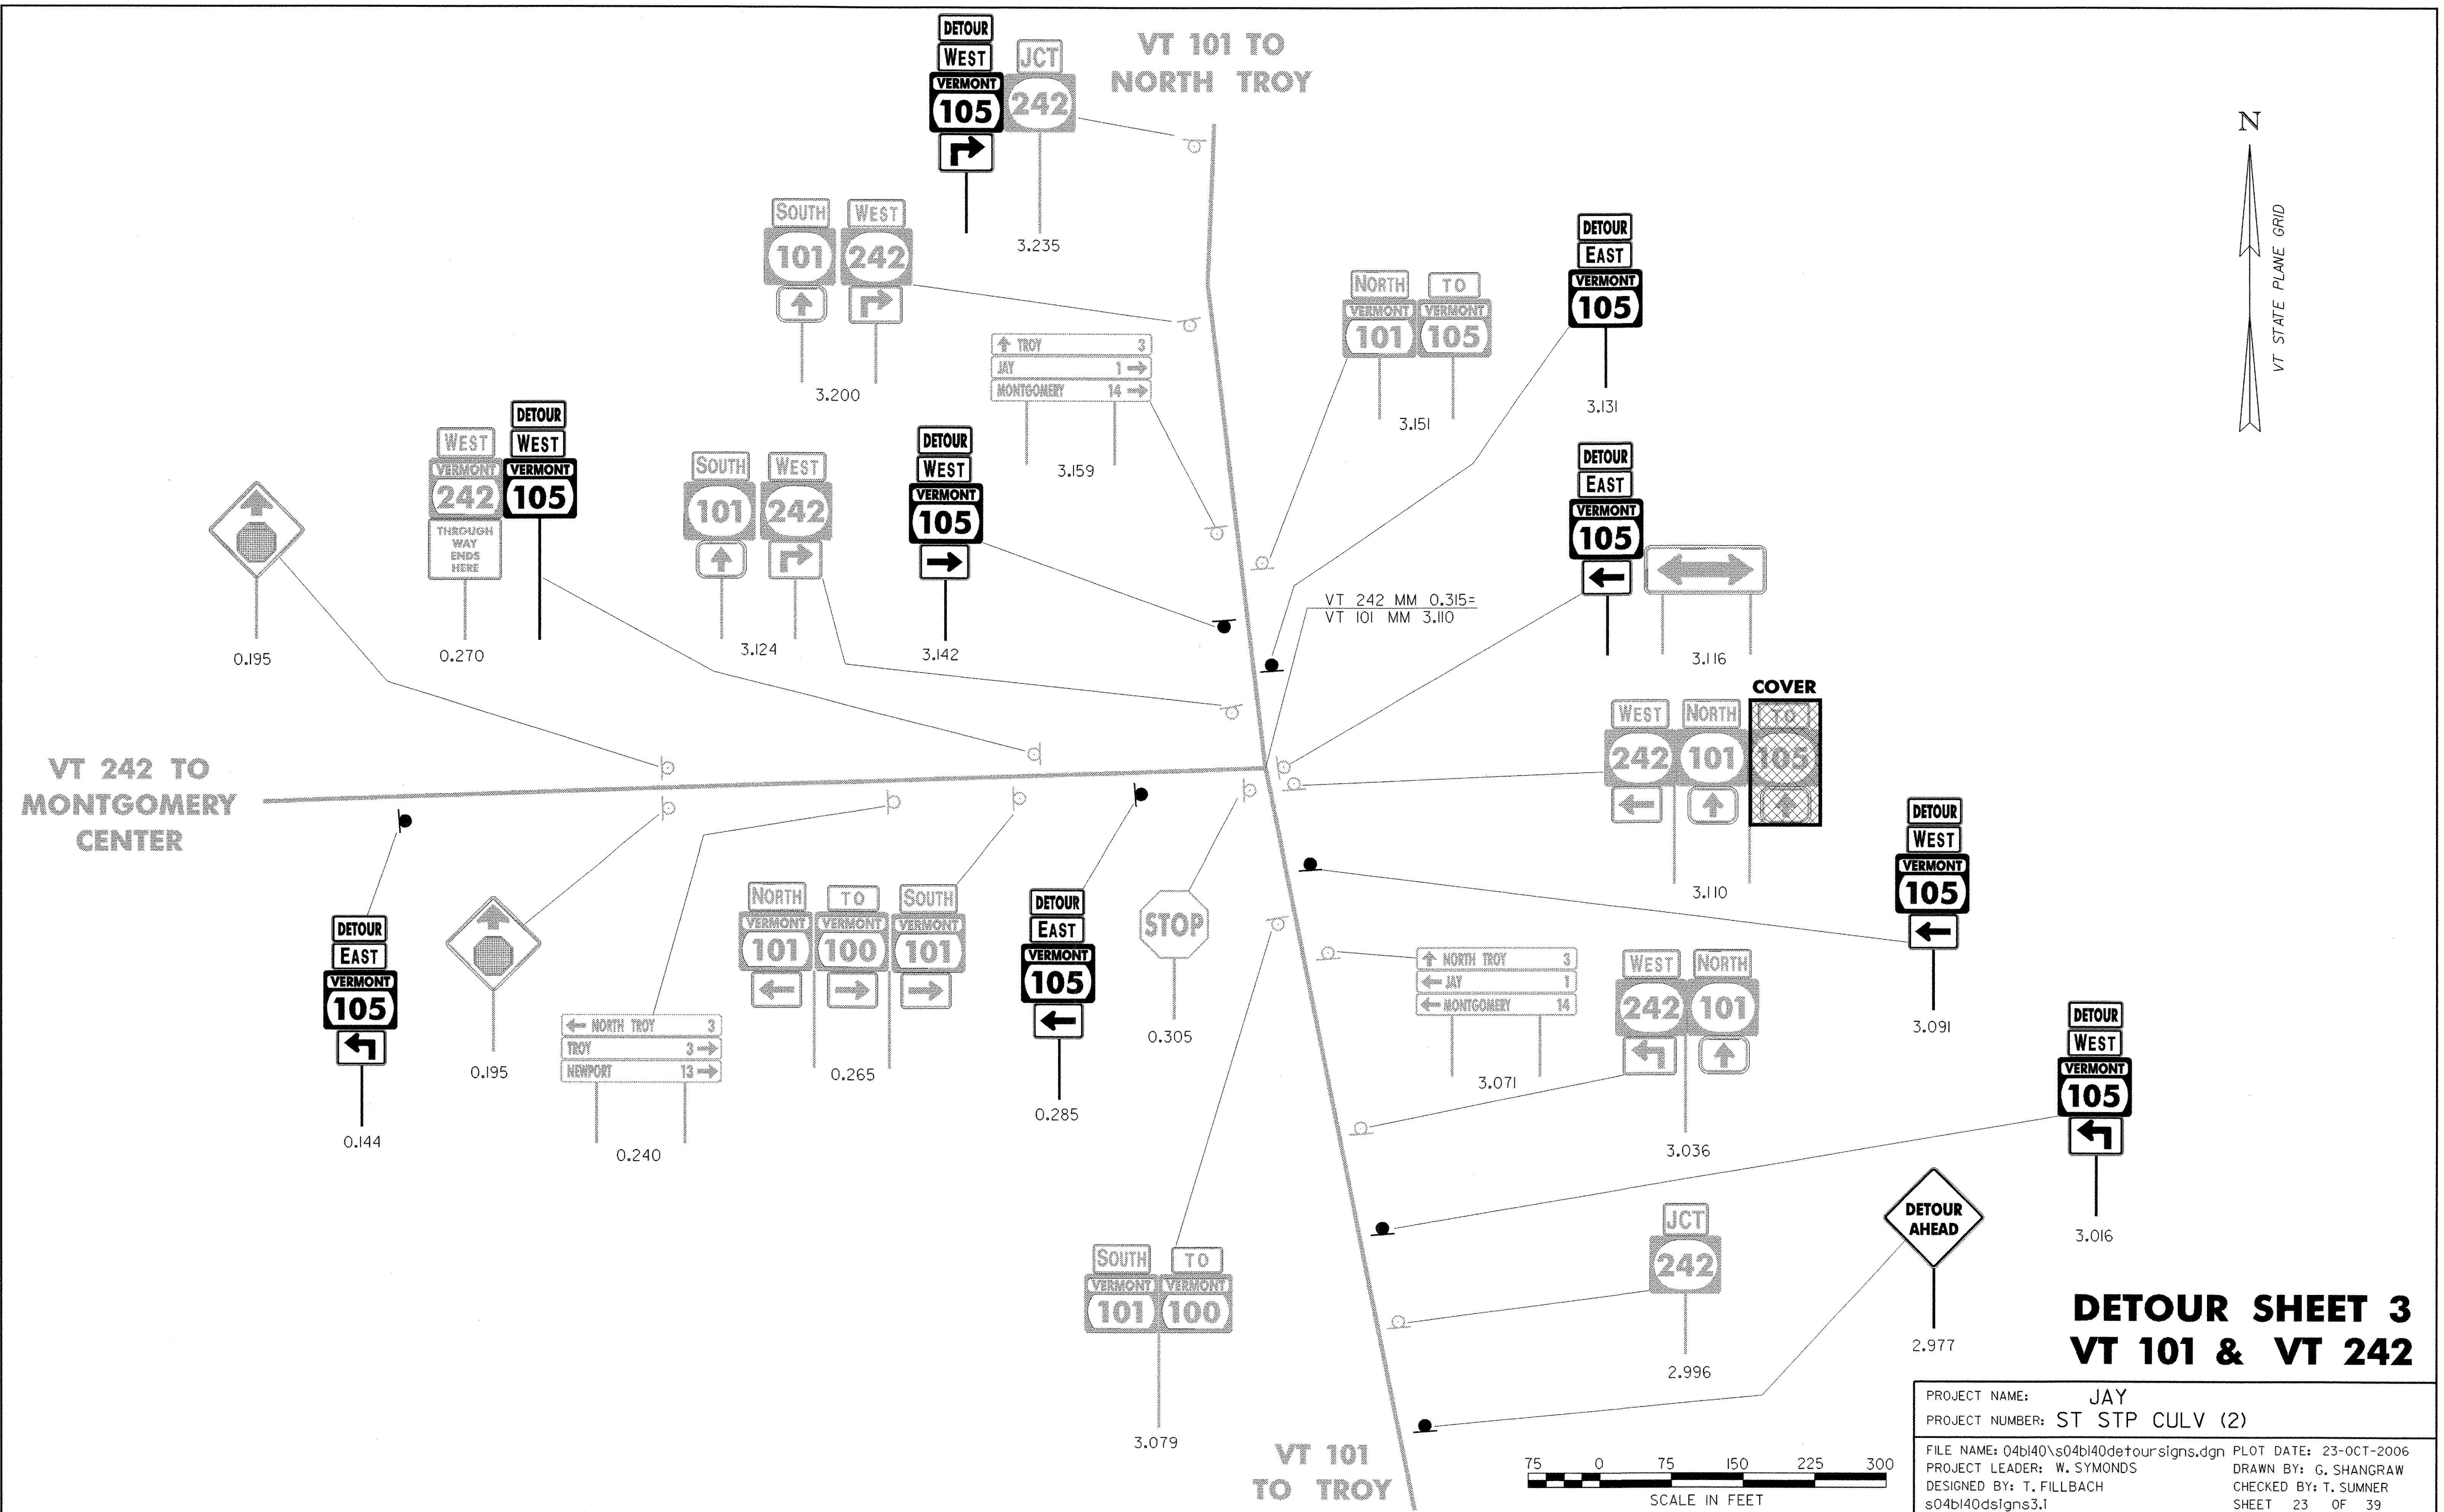

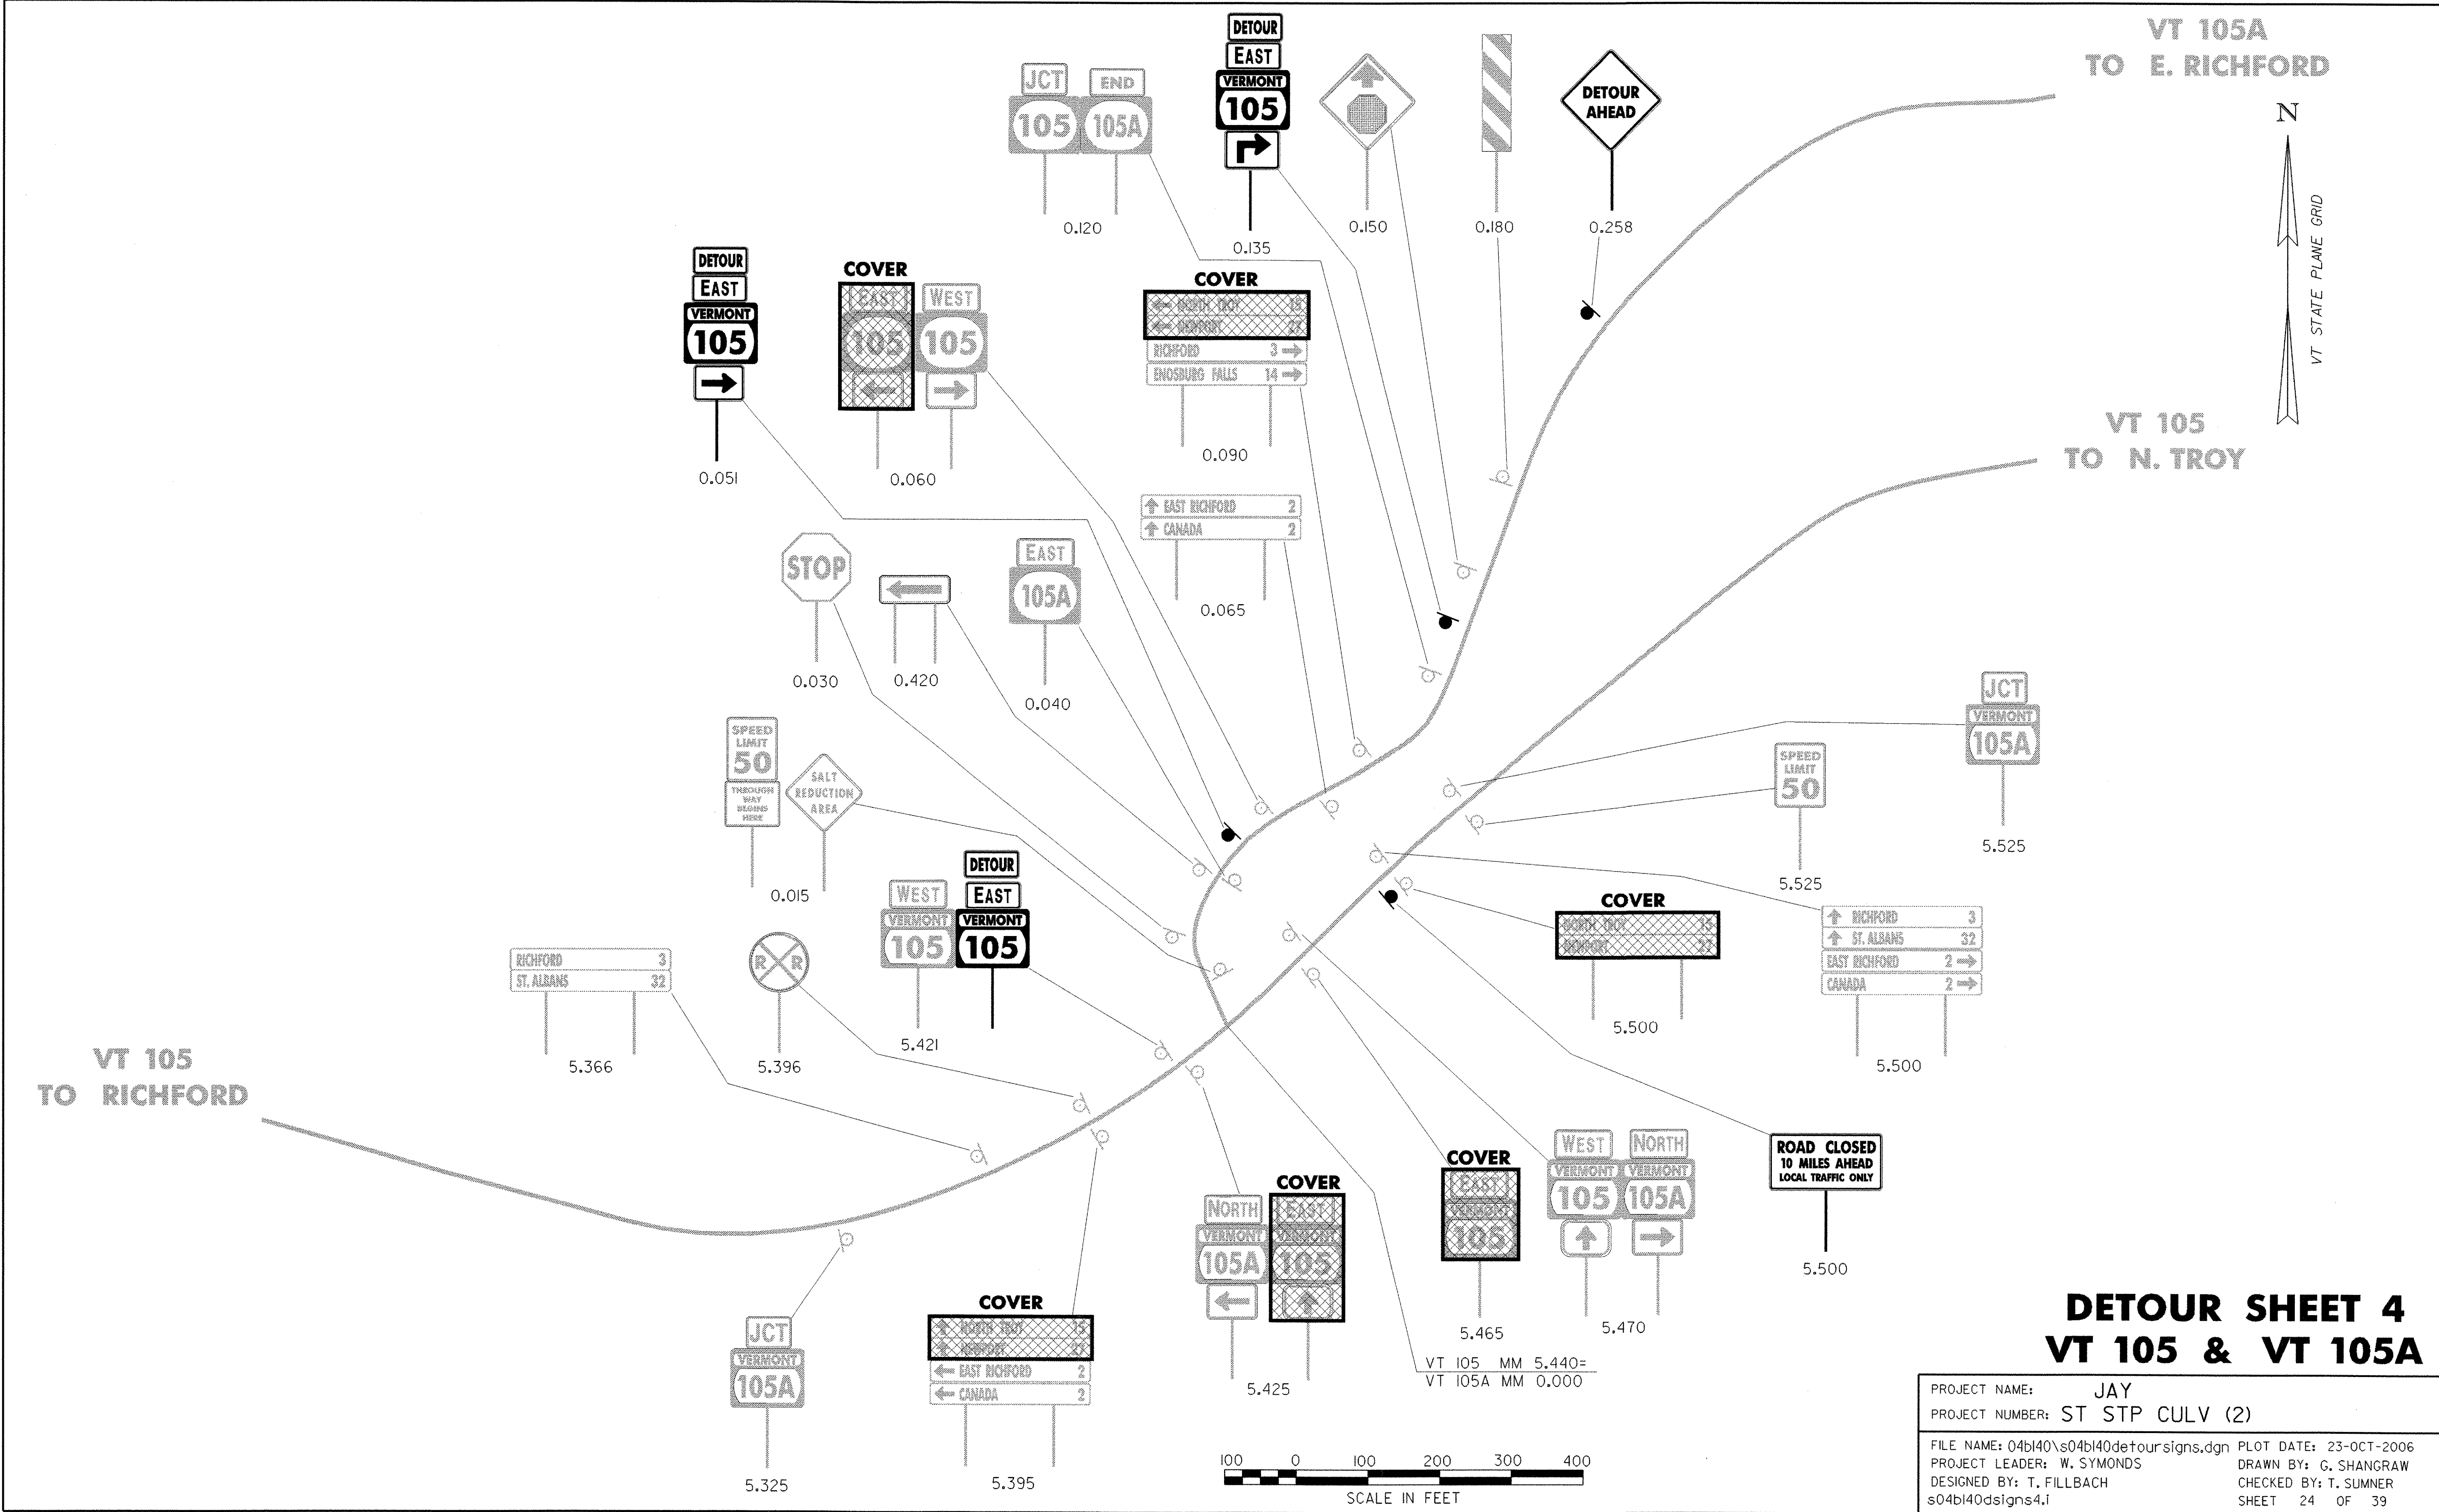



**DETOUR SHEET 4
VT 105 & VT 105A**

PROJECT NAME: JAY	
PROJECT NUMBER: ST STP CULV (2)	
FILE NAME: 04bl40\s04bl40detoursigns.dgn	PLOT DATE: 23-OCT-2006
PROJECT LEADER: W. SYMONDS	DRAWN BY: G. SHANGRAW
DESIGNED BY: T. FILLBACH	CHECKED BY: T. SUMNER
s04bl40dsigns4.i	SHEET 24 OF 39

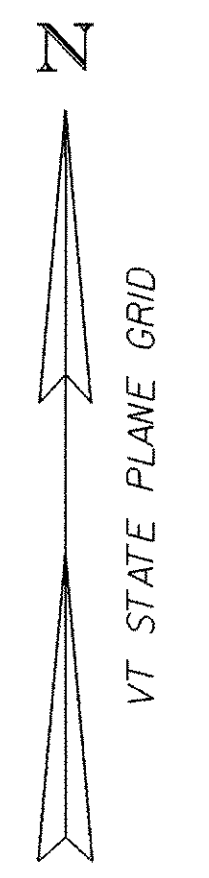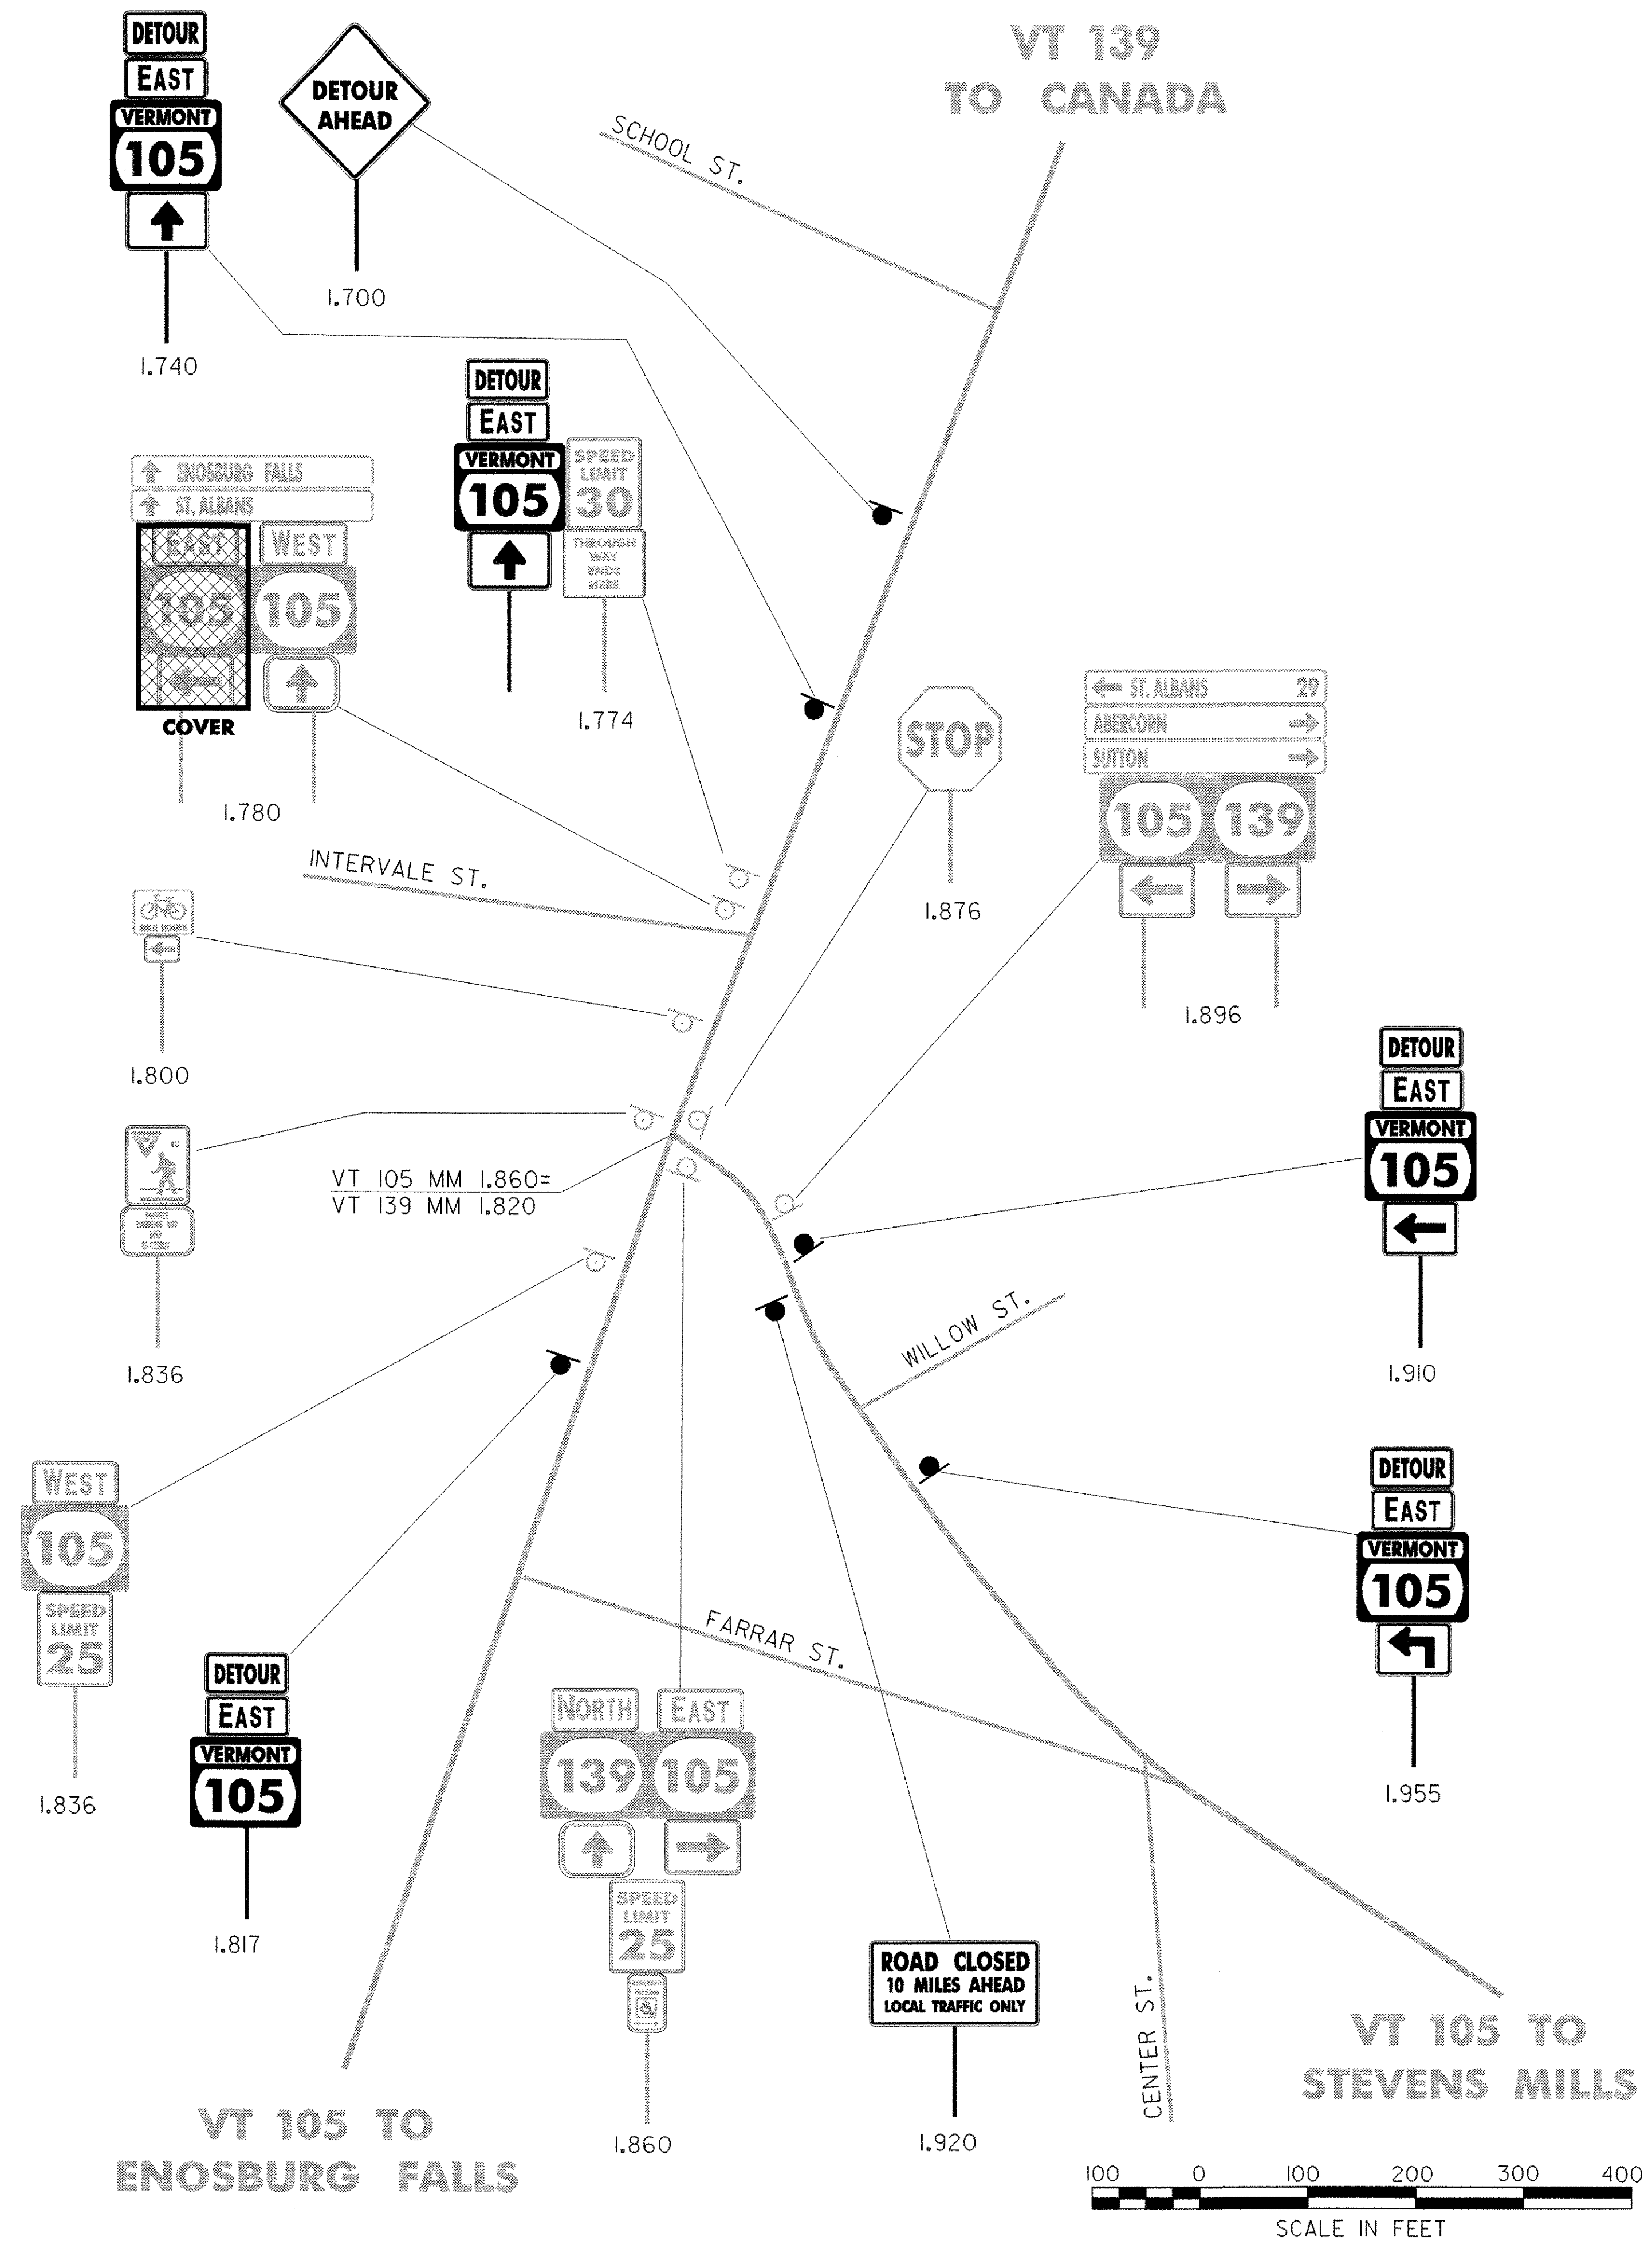


DETOUR SHEET 5 VT 105 & VT 139

PROJECT NAME:	JAY	PLOT DATE:	23-OCT-2006
PROJECT NUMBER:	ST STP CULV (2)	DRAWN BY:	G. SHANGRAW
FILE NAME:	04b140\s04b140detoursigns.dgn	CHECKED BY:	T. SUMNER
PROJECT LEADER:	W. SYMONDS	SHEET	25 OF 39
DESIGNED BY:	T. FILLBACH		

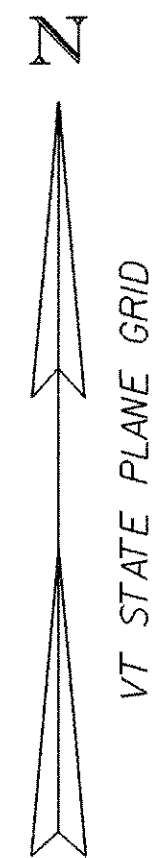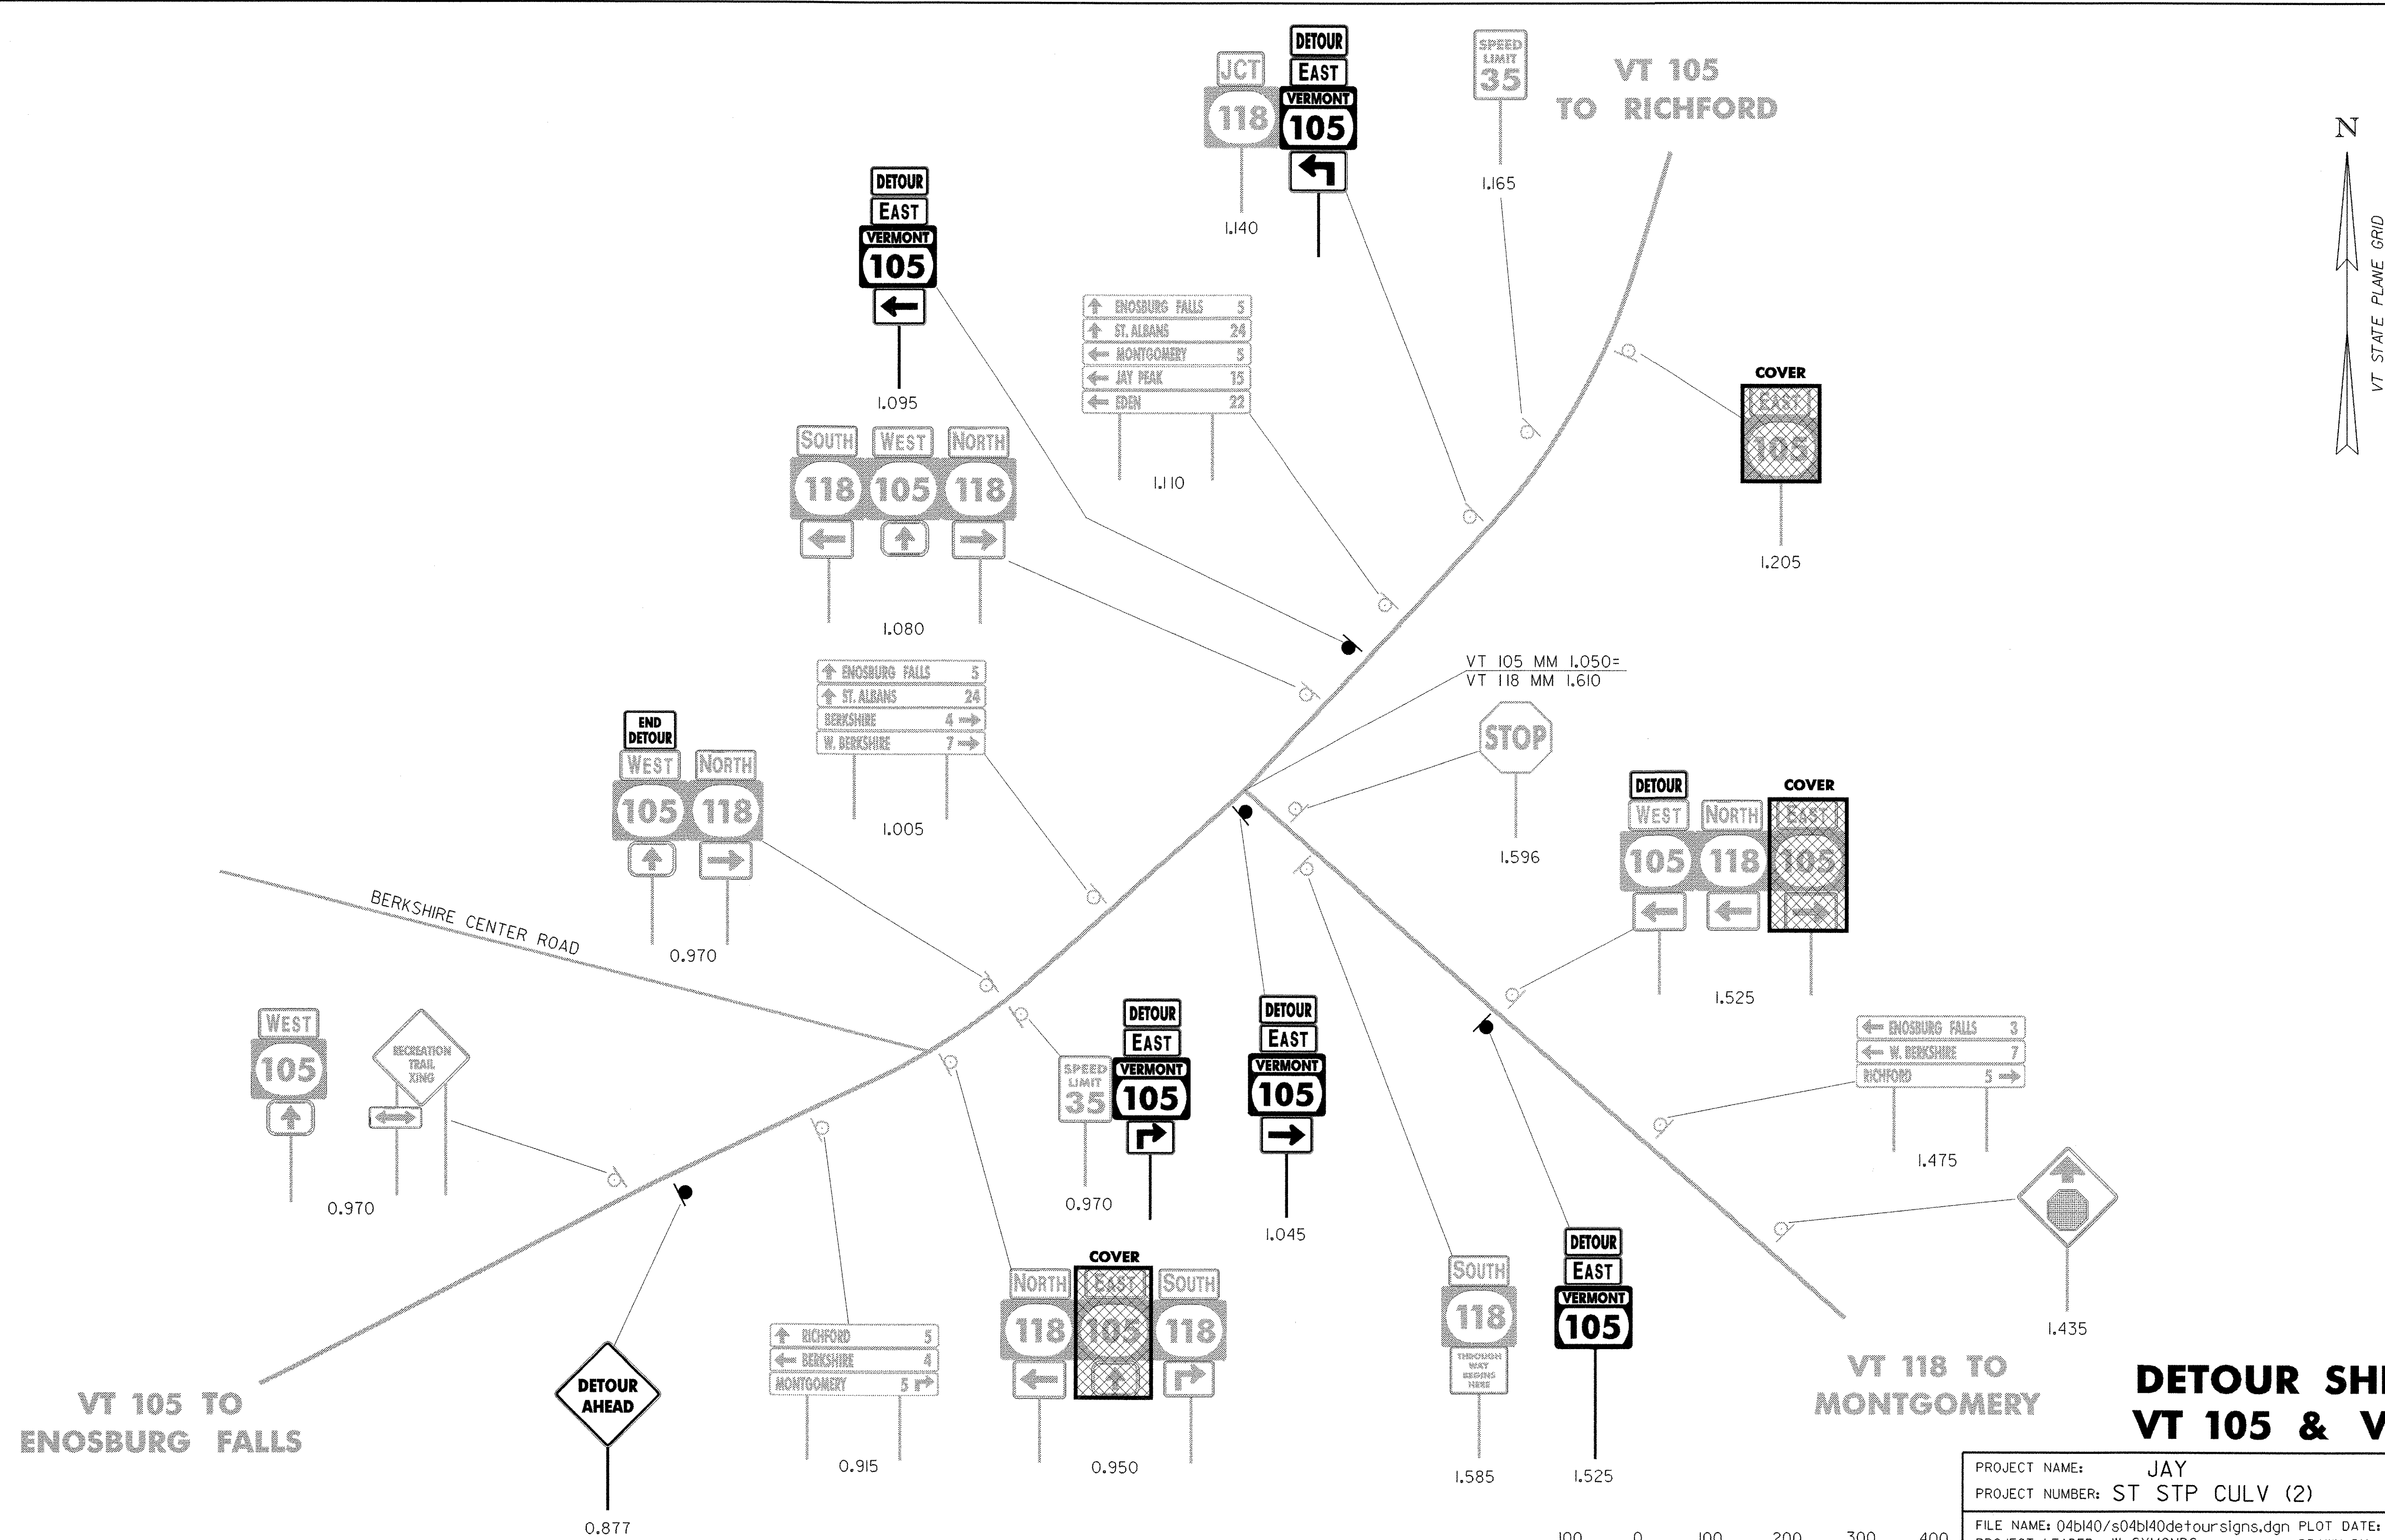

DETOUR SHEET 6 **VT 105 & VT 118**


PROJECT NAME:	JAY	FILE NAME:	04b140/s04b140detoursigns.dgn	PLOT DATE:	23-OCT-2006
PROJECT NUMBER:	ST STP CULV (2)	PROJECT LEADER:	W. SYMONDS	DRAWN BY:	G. SHANGRAW
		DESIGNED BY:	T. FILLBACH	CHECKED BY:	T. SUMNER
			s04b140dsigns6.1	SHEET	26 OF 39

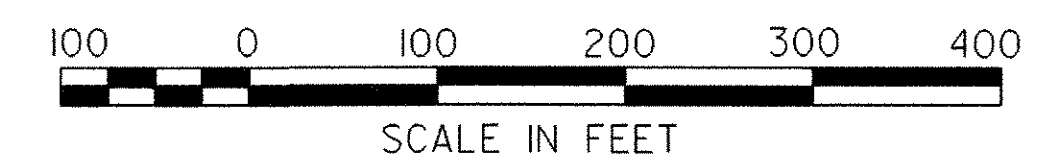

VT 118 TO
E. BERKSHIRE

SPEED
LIMIT
30
DETOUR
WEST
VERMONT
105

← MONTGOMERY 2
← EAST BERKSHIRE 9
JAY PEAK SKI AREA 11
JAY 13
NORTH VERMONT 118
EAST VERMONT 242
DETOUR
EAST
VERMONT
105

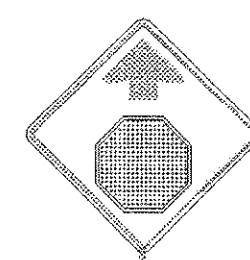


DETOUR
WEST
VERMONT
105

JCT
VERMONT
118
END
VERMONT
242

EMERGENCY
VEHICLES

VT 242
TO JAY

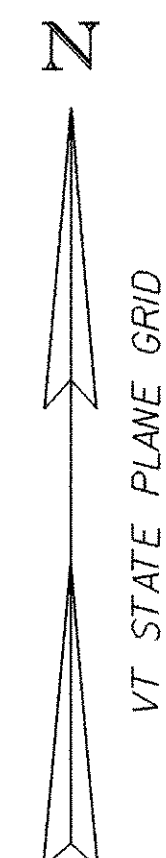

5.755

3.690

3.670

3.655

3.630

5.615

DETOUR
EAST
VERMONT
105

STOP

THROUGH
WAY
ENDS
HERE

3.785

3.750

3.685

3.740


3.770

3.650

3.620

DETOUR
EAST
VERMONT
105

5.710

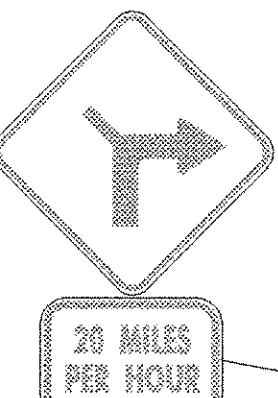

20 MILES
PER HOUR

DETOUR
EAST
VERMONT
105

5.690

VT 118 MM 5.625=
VT 242 MM 3.790

GRANNY GRUNTS ROAD

STOP

4.735

VT 118 MM 5.579=
VT 58 MM 4.740

VT 58
TO LOWELL

DETOUR
EAST
VERMONT
105

4.735

DETOUR
EAST
VERMONT
105

DETOUR
EAST
VERMONT
105

← JAY PEAK SKI AREA 11
← JAY 13
EDEN 15 →
EAST VERMONT 242
SOUTH VERMONT 118
TO VERMONT 58

5.670

MONTGOMERY 2 →
EAST BERKSHIRE 9 →
← EDEN 15
← HYDE PARK 24
SOUTH VERMONT 118
EAST VERMONT 58
NORTH VERMONT 118

5.615

DETOUR
WEST
VERMONT
105

5.585

EAST
58

← MONTGOMERY 2
← EAST BERKSHIRE 9
JAY PEAK SKI AREA 11
JAY 13
LOWELL 9 →

5.475

NORTH VERMONT 118
EAST VERMONT 58
TO VERMONT 242

5.530

DETOUR
EAST
VERMONT
105

5.553

JCT
58
JCT
VERMONT
242

LEGAL LOAD
LIMIT
24,000
POUNDS
SPEED
LIMIT
25

4.720

SOUTH VERMONT 118
NORTH VERMONT 118
TO EAST VERMONT 242

4.720

SALT
REDUCTION
AREA
NEXT
15 MILES

5.515

SOUTH
VERMONT
118

5.500

SPEED
LIMIT
40

5.485

VT 118 TO
BELVIDERE
CORNERS

4.720

DETOUR
AHEAD

5.410

REDUCED
SPEED
AHEAD

150 0 150 300 450 600
SCALE IN FEET

DETOUR SHEET 7 VT 118 & VT 242

PROJECT NAME:	JAY	FILE NAME:	04bl40\04bl40detoursigns.dgn	PLOT DATE:	23-OCT-2006
PROJECT NUMBER:	ST STP CULV (2)	PROJECT LEADER:	W. SYMONDS	DRAWN BY:	G. SHANGRAW
		DESIGNED BY:	T. FILLBACH	CHECKED BY:	T. SUMNER
			s04bl40dsigns7.i		SHEET 27 OF 39

SOIL CLASSIFICATION

AASHTO	
A1	Gravel and Sand
A3	Fine Sand
A2	Silty or Clayey Gravel and Sand
A4	Silty Soil - Low Compressibility
A5	Silty Soil - Highly Compressible
A6	Clayey Soil - Low Compressibility
A7	Clayey Soil - Highly Compressible

ROCK QUALITY DESIGNATION

R.Q.D. (%)	ROCK DESCRIPTION
<25	Very Poor
25 to 50	Poor
51 to 75	Fair
76 to 90	Good
>90	Excellent

SHEAR STRENGTH

UNDRAINED SHEAR STRENGTH IN P.S.F.	CONSISTENCY
<250	Very Soft
250-500	Soft
500-1000	Med. Stiff
1000-2000	Stiff
2000-4000	Very Stiff
>4000	Hard

CORRELATION GUIDE OF "N" TO DENSITY/CONSISTENCY

DENSITY (GRANULAR SOILS)		CONSISTENCY (COHESIVE SOILS)	
N	DESCRIPTIVE TERM	N	DESCRIPTIVE TERM
<5	Very Loose	<2	Very Soft
5-10	Loose	2-4	Soft
11-24	Med. Dense	5-8	Med. Stiff
25-50	Dense	9-15	Stiff
>50	Very Dense	16-30	Very Stiff
		31-60	Hard
		>60	Very Hard


COMMONLY USED SYMBOLS

▼	Water Elevation
⊙	Standard Penetration Boring
⊕	Auger Boring
⊖	Rod Sounding
S	Sample
N	Standard Penetration Test
	Blow Count Per Foot For:
	2" O.D. Sampler
	1 3/8" I.D. Sampler
	Hammer Weight Of 140 Lbs.
	Hammer Fall Of 30"
VS	Field Vane Shear Test
US	Undisturbed Soil Sample
B	Blast
DC	Diamond Core
MD	Mud Drill
WA	Wash Ahead
HSA	Hollow Stem Auger
AX	Core Size 1 1/8"
BX	Core Size 1 5/8"
NX	Core Size 2 1/8"
M	Double Tube Core Barrel Used
LL	Liquid Limit
PL	Plastic Limit
PI	Plasticity Index
NP	Non Plastic
w	Moisture Content (Dry Wgt. Basis)
D	Dry
M	Moist
MTW	Moist To Wet
W	Wet
Sat	Saturated
Bo	Boulder
Gr	Gravel
Sa	Sand
Si	Silt
Cl	Clay
HP	Hardpan
Le	Ledge
NLTD	No Ledge To Depth
CNPF	Can Not Penetrate Further
TLOB	To Ledge Or Boulder
NR	No Recovery
Rec.	Recovery
1/2 Rec.	Percent Recovery
ROD	Rock Quality Designation
CBR	California Bearing Ratio
<	Less Than
>	Greater Than
R	Refusal (N > 100)

COLOR			
blk	Black	pnk	Pink
bl	Blue	pu	Purple
brn	Brown	rd	Red
dk	Dark	tn	Tan
gry	Gray	wh	White
grn	Green	yel	Yellow
lt	Light	mltc	Multicolored
or	Orange		

BORING CHART

HOLE NUMBER	STATION	OFFSET	GROUND ELEVATION
#1	17+79.00	40.25 RT	1246.4
#2	17+94.37	37.00 LT	1247.81

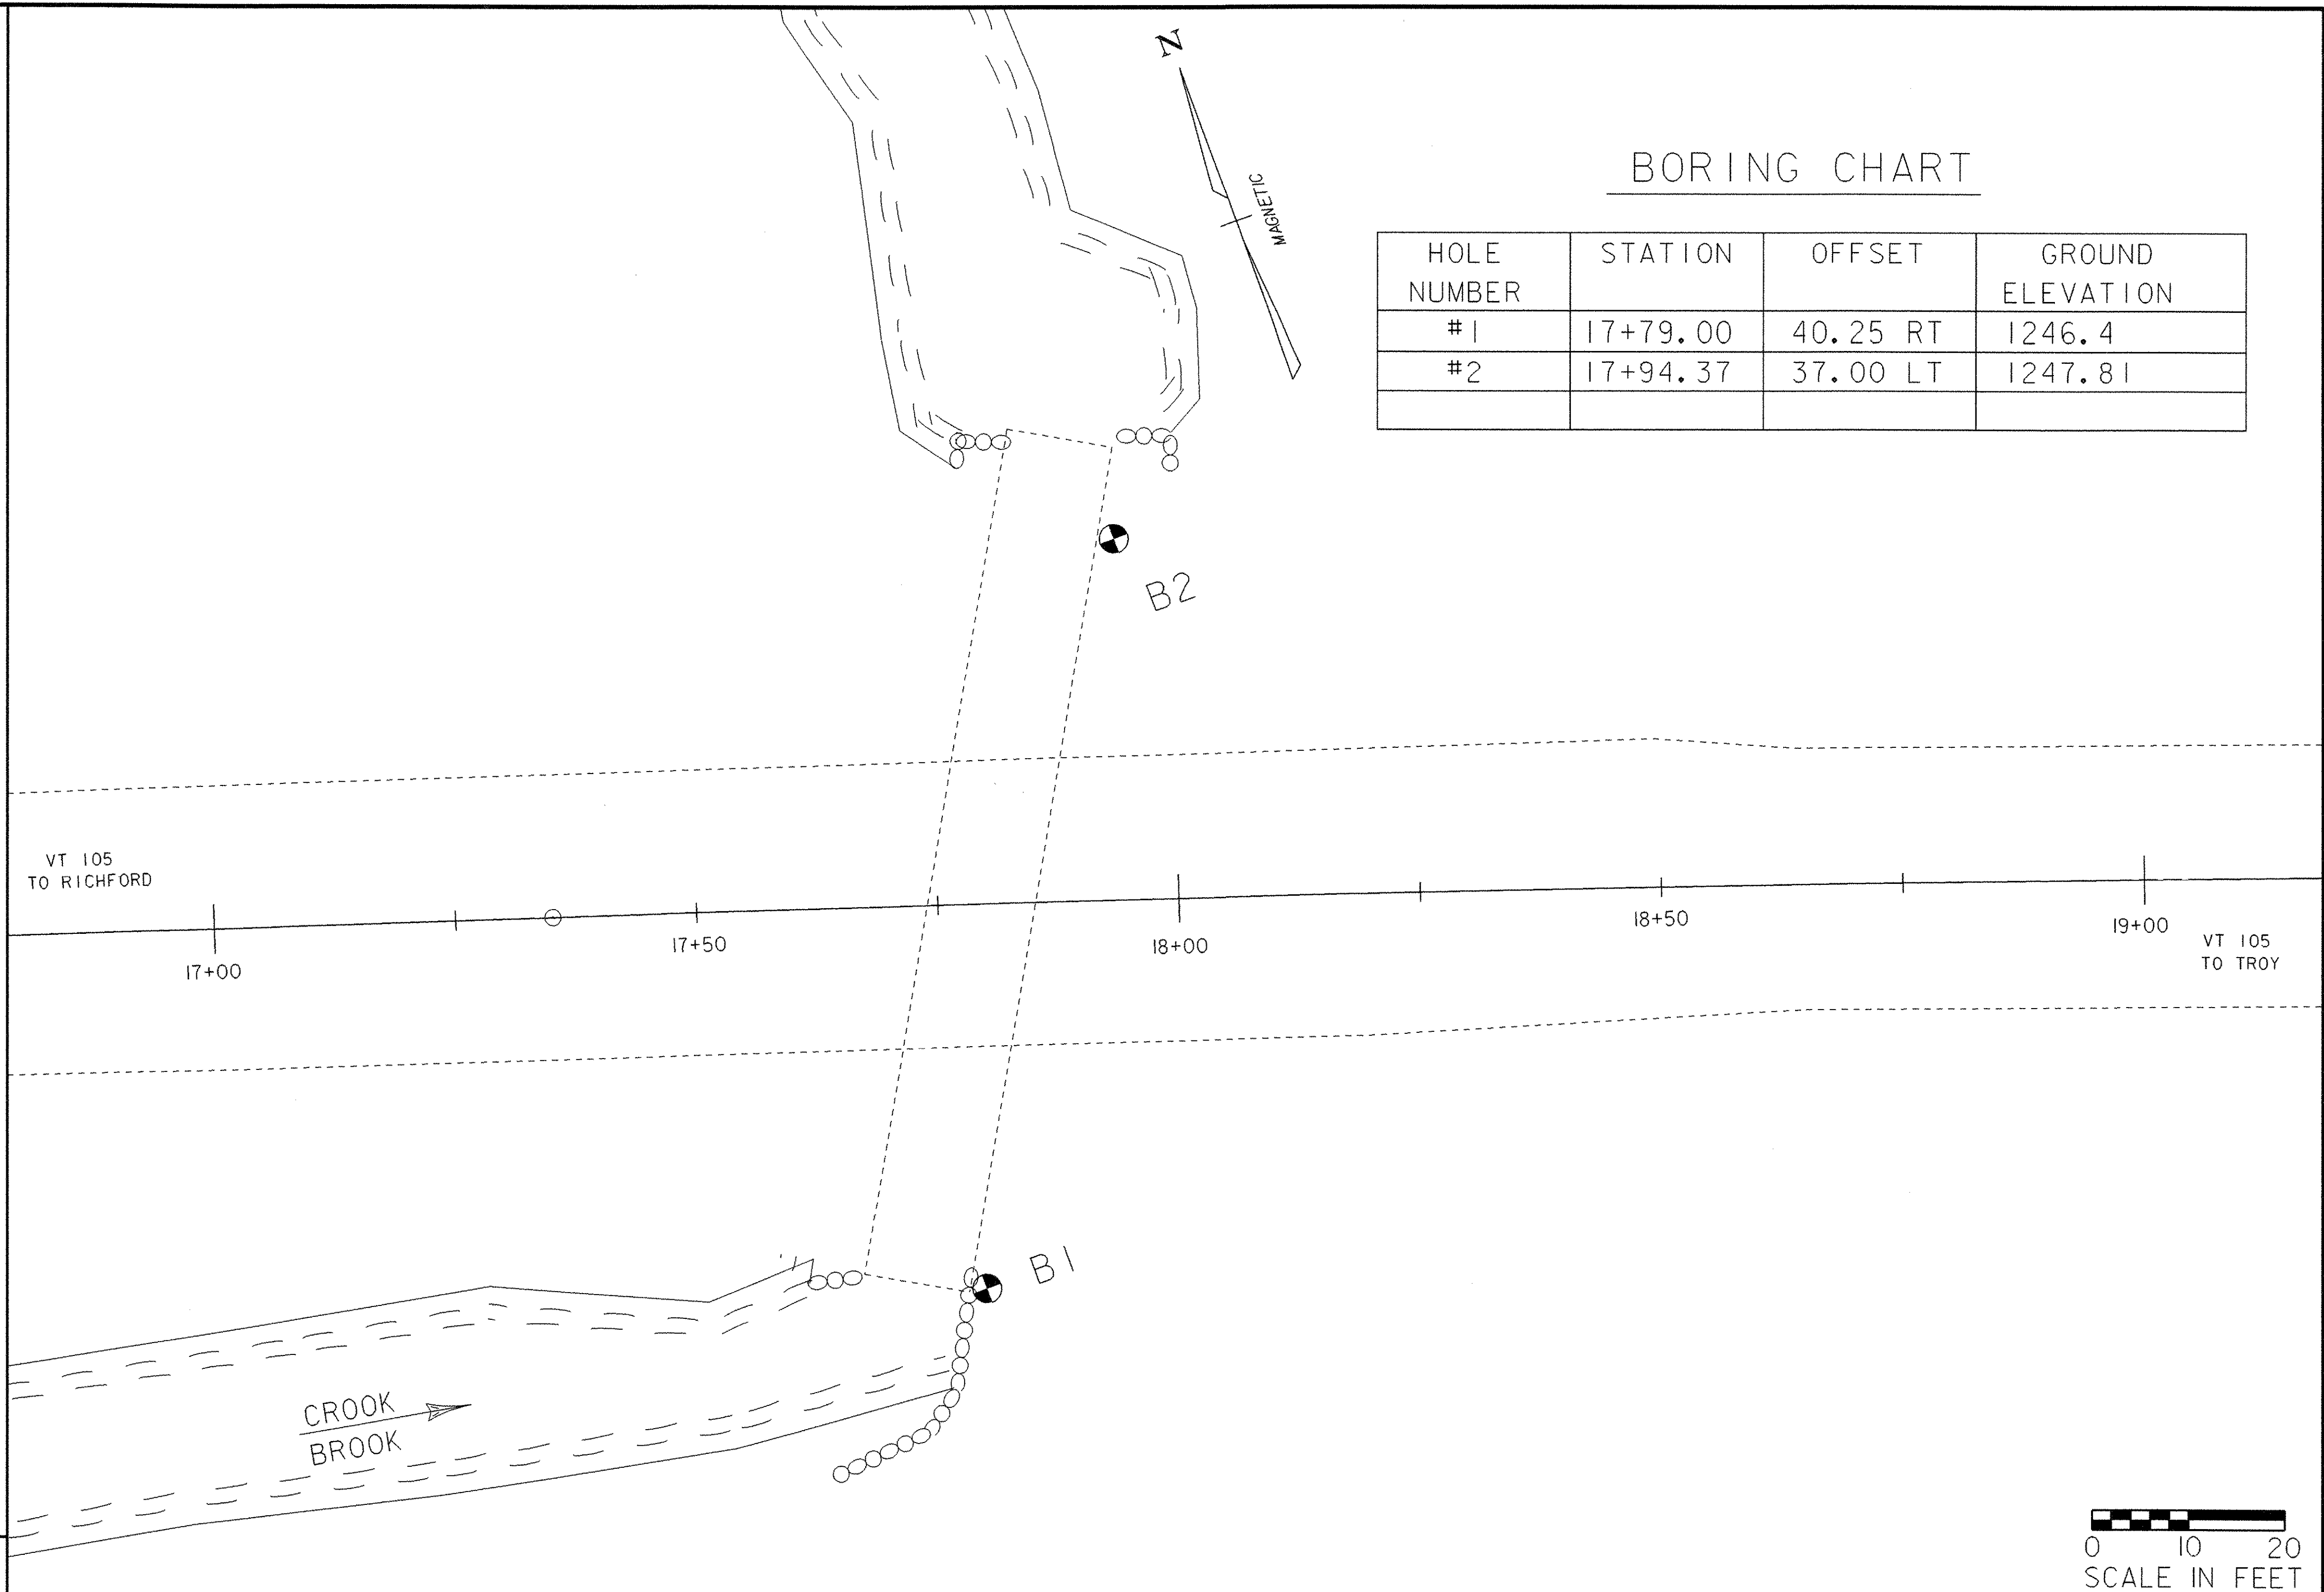

DEFINITIONS (AASHTO)

BEDROCK (LEDGE) - Rock in its native location of indefinite thickness.

BOULDER - A rock fragment with an average dimension > 12 inches.

COBBLE - Rock fragments with an average dimension between 3 and 12 inches.

GRAVEL - Rounded particles of rock < 3" and > 0.075" (#10 sieve).

SAND - Particles of rock < 0.075" (#10 sieve) and > 0.0025" (#200 sieve).

SILT - Soil < 0.0025" (#200 sieve), non or slightly plastic and exhibits no strength when air-dried.

CLAY - Fine grained soil, exhibits plasticity when moist and considerable strength when air-dried.

VARVED - Alternate layers of silt and clay.

HARDPAN - Extremely dense soil, cemented layer, not softened when wet.

MUCK - Soft organic soil (containing > 10% organic material).

MOISTURE CONTENT - Weight of water divided by dry weight of soil.

FLOWING SAND - Granular soil so saturated (loose) that it flows into drill casing during extraction of wash rod.

STRIKE - Angle from magnetic north to line of intersection of bed with a horizontal plane.

DIP - Inclination of bed with a horizontal plane.

GENERAL NOTES

1. The subsurface explorations shown herein were made between 6/30/05 and 7/14/05 by the Agency.

2. Soil and rock classifications, properties and descriptions are based on engineering interpretation from available subsurface information by the Agency and may not necessarily reflect actual variations in subsurface conditions that may be encountered between individual boring or sample locations.

3. Observed water levels and/or conditions indicated are as recorded at the time of exploration and may vary according to the prevailing rainfall, methods of exploration and other factors.

4. Engineering judgement was exercised in preparing the subsurface information presented herein. Analysis and interpretation of subsurface data was performed and interpreted for Agency design and estimating purposes. Presentation of the information in the Contract is intended to provide the Contractor access to the same data available to the Agency. The subsurface information is presented in good faith and is not intended as a substitute for personal investigation, independent interpretation, independent analysis or judgement by the Contractor.


5. Pictorial structure details shown on the boring plan layout or soils profile are for illustrative purposes only and may not accurately portray final contract details.

6. Terminology used on boring logs to describe the hardness, degree of weathering, and spacing of fractures, joints and other discontinuities in the bedrock is defined in the AASHTO Manual on Subsurface Investigations, 1988.


STATE OF VERMONT
AGENCY OF TRANSPORTATION

Town Of	JAY	Bridge No.	50
Highway No.	VT 105	Log Sta.	
		Surv. Sta.	
BORING INFORMATION SHEET			
Designed By	T. FILLBACH	Drawn By	G. SHANGRAW
Checked By	T. SUMNER	Bridge Design Supervisor	W. SYMONDS
PROJECT	JAY	PROJECT NO.	ST STP CULV (2)
I.G.C. Info.			
Bridge Sheet No.		Sheet	28 of 39

s04b140bor. i

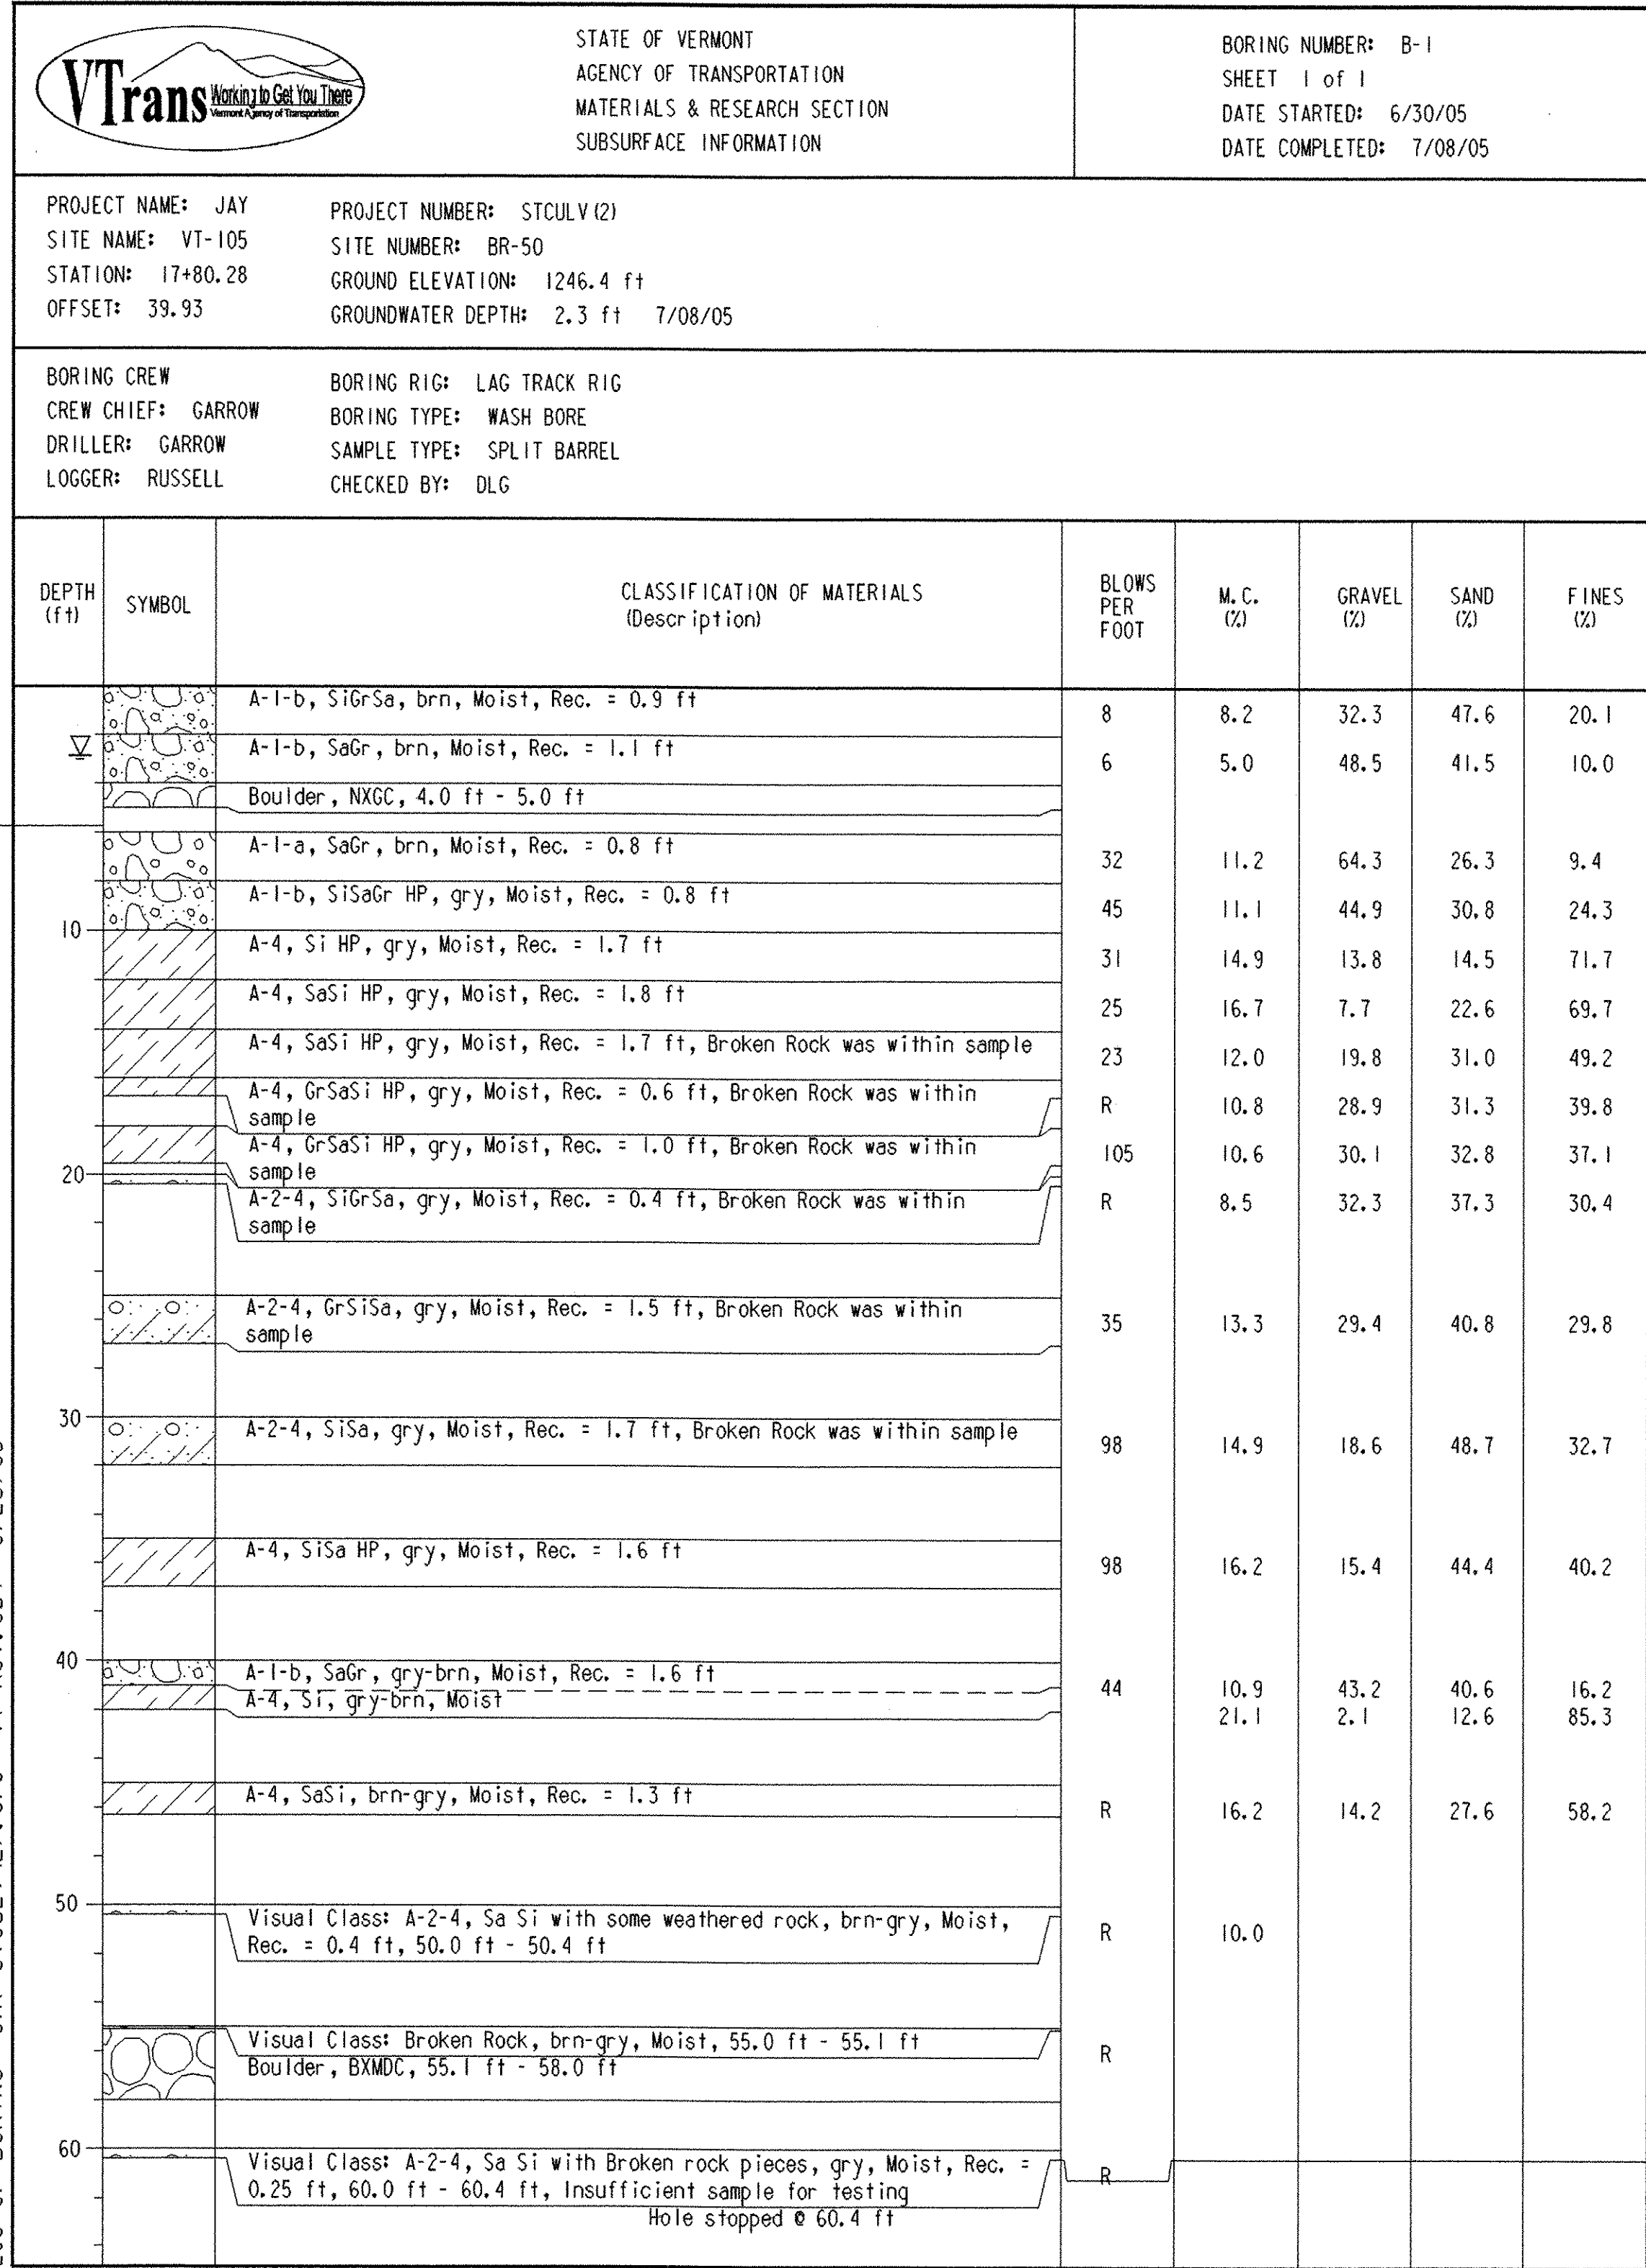

LOG OF BORING JAY STCULV (2).GPJ VT AOT.GDT 8/23/05

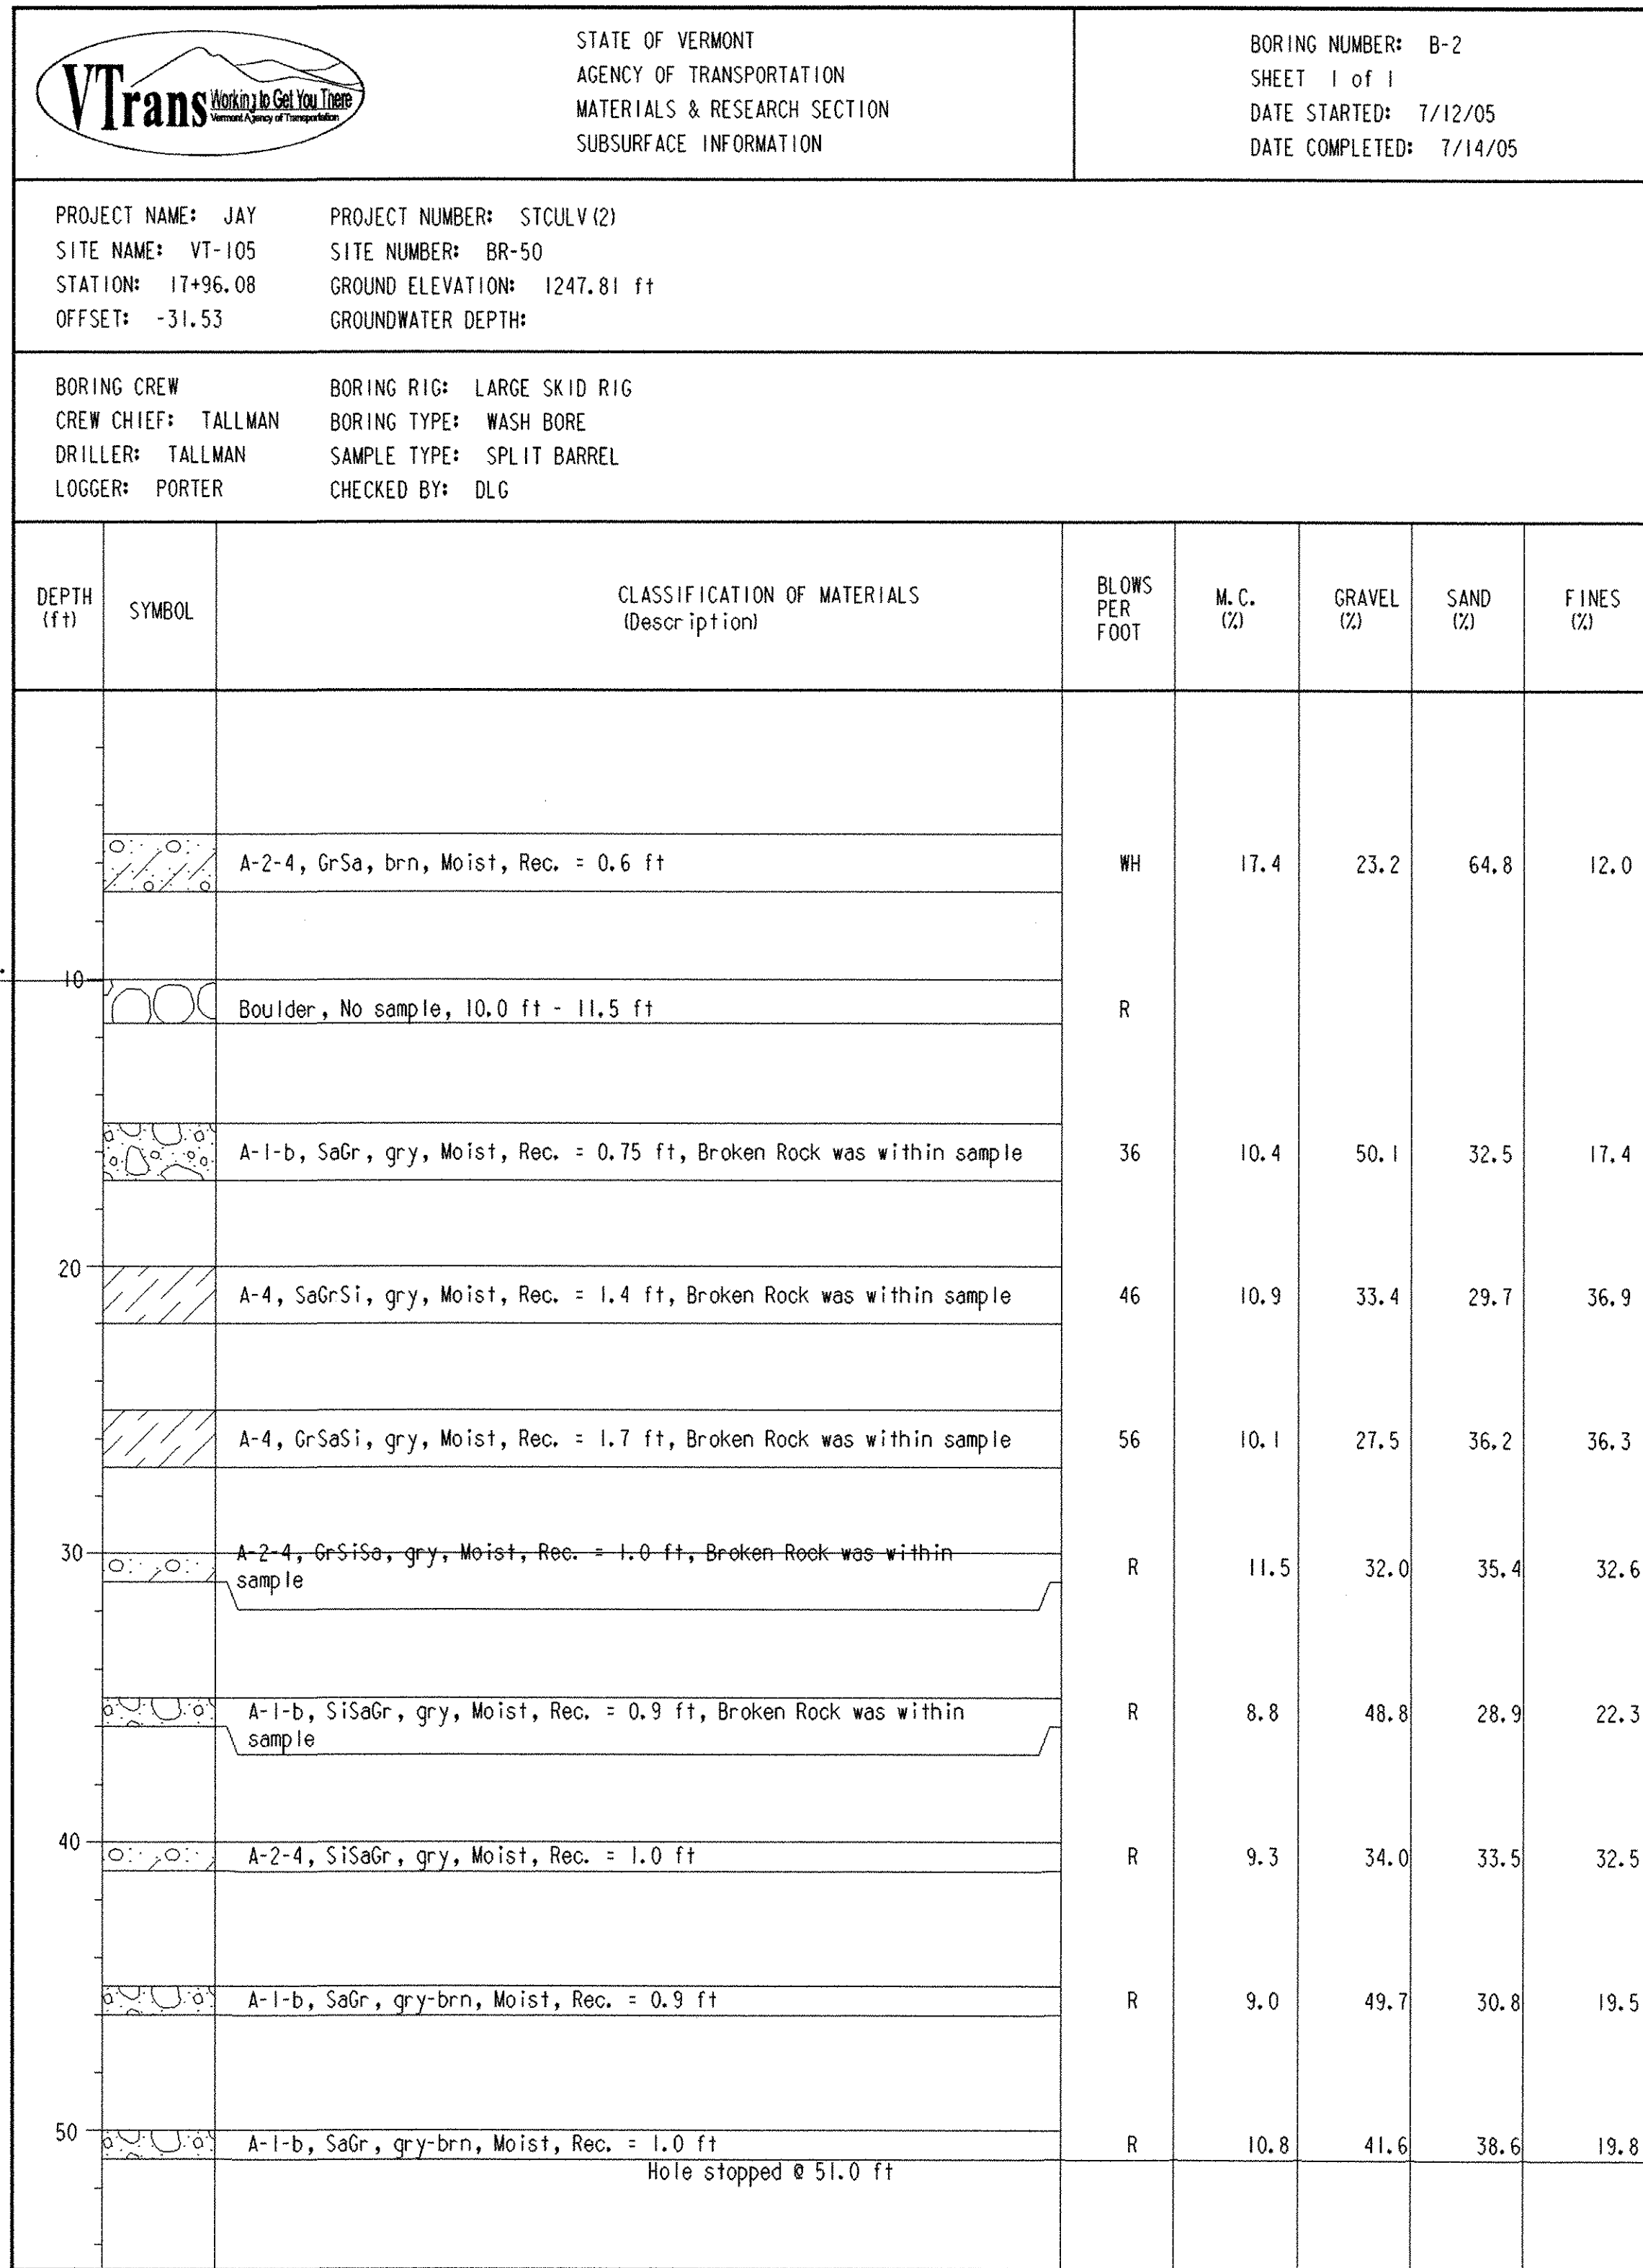

LOG OF BORING JAY STCULV (2).GPJ VT AOT.GDT 9/7/05

BORING LOGS

PROJECT NAME:	JAY
PROJECT NUMBER:	ST STP CULV (2)
FILE NAME:	Q4b140/s04b140bor.dgn
PROJECT LEADER:	W. SYMONDS
DESIGNED BY:	T. FILLBACH
s04b140borlogs.i	
PLOT DATE:	23-OCT-2006
DRAWN BY:	G. SHANGRAW
CHECKED BY:	T. SUMNER
SHEET	29 OF 39

GENERAL NOTES

GENERAL

1.

ALL MATERIALS AND CONSTRUCTION SHALL CONFORM TO THE AGENCY OF TRANSPORTATION'S STANDARD SPECIFICATIONS FOR CONSTRUCTION, DATED 2006, AND ITS LATEST REVISIONS, AND THE AASHTO STANDARD SPECIFICATIONS FOR HIGHWAY BRIDGES, SEVENTEENTH (17TH) EDITION, AND ITS LATEST REVISIONS.
2.

IN-STREAM CONSTRUCTION SHALL BE RESTRICTED TO JUNE 1 TO OCTOBER 1 UNLESS THE CONTRACTOR OBTAINS WRITTEN PERMISSION FROM THE AGENCY OF NATURAL RESOURCES TO DO WORK OUTSIDE OF THAT TIME FRAME.
3.

ALL DIMENSIONS ARE HORIZONTAL OR VERTICAL AND ARE GIVEN AT 68 DEGREES F UNLESS OTHERWISE NOTED.
4.

ITEM 404.65 EMULSIFIED ASPHALT IS TO BE APPLIED AT A RATE OF .015 GAL/SY BETWEEN SUCCESSIVE COURSES OF PAYMENT OR AS DIRECTED BY THE ENGINEER.
5.

ITEM 900.625 SPECIAL PROVISION (WATER REPELLENT, SILANE) SHALL BE APPLIED TO ALL EXPOSED SURFACES OF THE WINGWALLS AND HEADWALLS. WATER REPELLENT, SILANE SHALL BE APPLIED TO THE EXPOSED INSIDE SURFACE OF THE BOX STARTING AT THE OPENING AT EACH END AND EXTENDING 3 FEET INTO THE BOX, INCLUDING THE TOP SURFACE OF THE BOTTOM SLAB AND THE BOTTOM SURFACE OF THE TOP SLAB.
6.

ITEM 529.15 "REMOVAL OF STRUCTURE" SHALL BE USED FOR REMOVAL OF THE PIPE AND ANY PORTIONS OF THE HEADWALLS AND WINGWALLS NOT REMOVED UNDER THE ITEMS "STRUCTURE EXCAVATION" OR "UNCLASSIFIED CHANNEL EXCAVATION".
7.

REINFORCING STEEL PLACEMENT TOLERANCES SHALL BE AS FOLLOWS:

SPACING +/- 1"
CLEARANCE +/- ¼"
8.

ALL EXPOSED EDGES OF CONCRETE SHALL BE CHAMFERED 1" X 1".
9.

W150 x 13.5 STEEL POSTS AND OFFEST BLOCKS SHALL BE USED WITH HEAVY DUTY STEEL GUARDRAIL.

TRAFFIC CONTROL

10.

THE CONTRACTOR SHALL BE RESPONSIBLE FOR THE REGIONAL DETOUR PACKAGE AS SHOWN IN THE PLANS.
11.

THE CONTRACTOR SHALL BE RESPONSIBLE FOR SUPPLYING THE LOCAL TRAFFIC CONTROL PACKAGE IDENTIFYING THE CONSTRUCTION PROJECT BEFORE, DURING, AND AFTER THE BRIDGE CLOSURE PERIOD. THE CONTRACTOR SHALL SUBMIT A DETAILED TRAFFIC CONTROL PLAN TO THE RESIDENT ENGINEER FOR ALL STAGES OF CONSTRUCTION. ALL COSTS SHALL BE INCLUDED IN ITEM 641.10, TRAFFIC CONTROL.
12.

ACCESS TO ALL EXISTING DRIVES SHALL BE MAINTAINED AT ALL TIMES DURING ALL PHASES OF CONSTRUCTION.
13.

INSTALLATION OF DETOUR SIGNS SHALL NOT BLOCK ANY EXISTING TRAFFIC CONTROL SIGN ASSEMBLIES. THE CONTRACTOR SHALL TRY TO MAINTAIN AT LEAST 200 FEET BETWEEN SIGN ASSEMBLIES.
14.

THE CONTRACTOR SHALL CONTACT DIG SAFE AT 1-888-344-7233 PRIOR TO BREAKING GROUND TO INSTALL ANY SIGN POSTS.
15.

ALL SIGNS THAT ARE 36" x 36" OR LARGER SHALL BE ON TWO POSTS.

PRECAST CONCRETE NOTES

16.

DESIGN CRITERIA:

A. SOIL UNIT WEIGHT = 140 PCF
B. DESIGN LIVE LOAD = HS-25-44
C. MAX. WINGWALL FOOTING PRESSURE = 4 KSF
D. FACTOR OF SAFETY FOR SLIDING >= 2.0
E. FACTOR OF SAFETY FOR OVERTURNING >= 1.5
F. DESIGN FILL OVER BOX = 11 FEET
17.

ALL CONCRETE SHALL BE PRECAST. ITEM 540.10 PRECAST CONCRETE STRUCTURE INCLUDES ALL BOX SEGMENTS, HEADWALLS, AND WINGWALLS. ALL CONNECTIONS SHALL BE DESIGNED BY THE FABRICATOR AND SHALL BE CONSIDERED INCIDENTAL TO ITEM 540.10. ALL CONNECTIONS MUST BE SUBMITTED TO THE PROJECT MANAGER FOR APPROVAL.
18.

THE PRECAST BOX SECTIONS ARE SHOWN FOR REFERENCE ONLY. THE ACTUAL DIMENSIONS AND SHAPE WILL BE DEPENDENT ON THE FABRICATOR. ALL UNITS EXCEPT THE FIRST AND LAST WILL BE THE SAME SHAPE AND THE SAME LENGTH. THE MINIMUM INSIDE DIMENSIONS SHALL BE 9'-0" IN HEIGHT AND 15'-0" IN WIDTH. THE OVERALL LENGTH OF THE BOX SHALL BE 80'-0" ALONG THE STREAMBED GRADE. THE EXPOSED ENDS OF THE FIRST AND LAST UNITS SHALL BE VERTICAL.
19.


THE EXTERIOR (TOP AND SIDES) OF ALL CONCRETE BOX JOINTS ALONG WITH ALL LIFTING HOLES SHALL BE FILLED WITH MORTAR TYPE IV AFTER BEING SET IN THEIR FINAL POSITION. THIS WORK SHALL BE CONSIDERED INCIDENTAL TO ITEM 540.10.
20.

A TWO (2) FOOT WIDE STRIP OF MEMBRANE WATERPROOFING SHALL BE APPLIED AT EACH BOX JOINT (TOP AND SIDES). MEMBRANE SHALL BE CENTERED ON THE JOINT AND COVER THE FULL WIDTH OF THE TOP AND FULL HEIGHT OF THE SIDES. THE SIDES SHALL BE COVERED FIRST AND THE TOP WILL FOLLOW. ANY OVERLAPPING OF MEMBRANE SHALL BE DONE IN A SHINGLE TYPE STYLE TO SHED WATER AND SHALL OVERLAP A MINIMUM OF ONE FOOT. PAYMENT FOR MEMBRANE SHALL BE UNDER ITEM 519.21 SHEET MEMBRANE WATERPROOFING, PREFORMED SHEET.
21.

THE STRUCTURE WILL BE AT A 4.33% GRADE SIMULATING THAT OF THE STREAM.

GENERAL NOTES

PROJECT NAME:	JAY
PROJECT NUMBER:	ST STP CULV (2)
FILE NAME: 04b140\04b140xc1.dgn	PLOT DATE: 23-OCT-2006
PROJECT LEADER: W. SYMONDS	DRAWN BY: T. FILLBACH
DESIGNED BY: T. FILLBACH	CHECKED BY: T. SUMNER
GENERAL NOTES SHEET	SHEET 30 OF 39

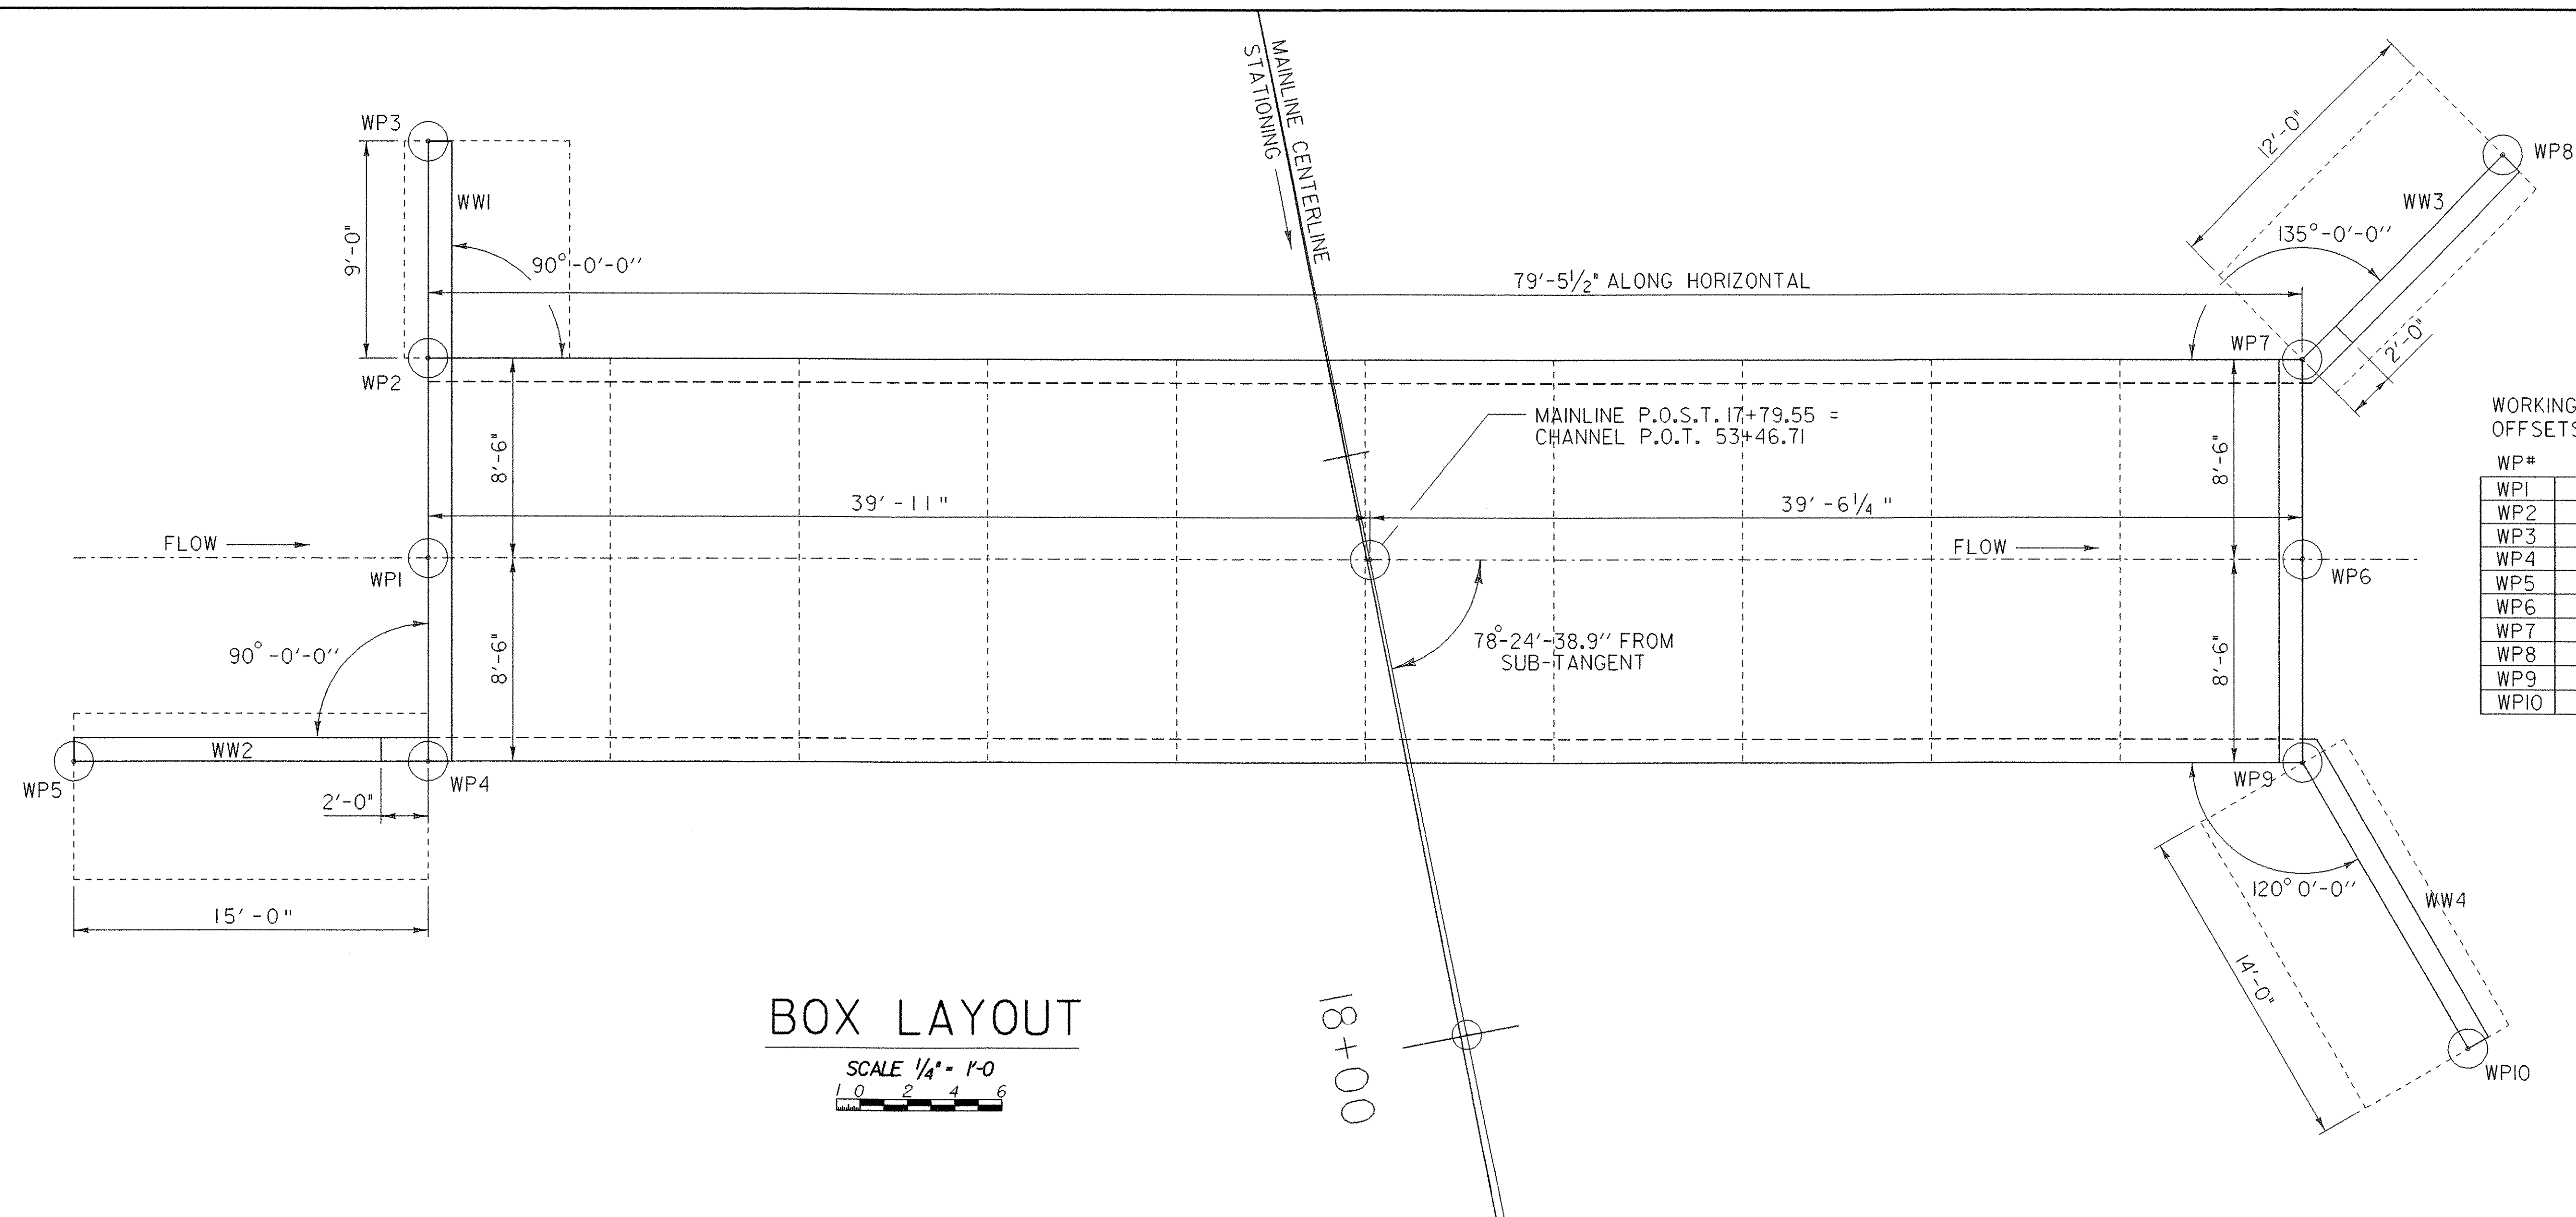


WORKING POINTS STATIONS &
OFFSETS FROM CHANNEL LINE

WP#	STATION	OFFSET
WP1	53+06.78	20.02 LT.
WP2	53+06.78	28.52 LT.
WP3	53+06.78	37.52 LT.
WP4	53+06.78	11.52 LT.
WP5	52+91.78	11.52 LT.
WP6	53+86.23	20.02 LT.
WP7	53+86.23	28.52 LT.
WP8	53+94.71	37.00 LT.
WP9	53+86.23	11.52 LT.
WP10	53+93.23	0.61 RT.


BOX LAYOUT

SCALE 1/4" = 1'-0"

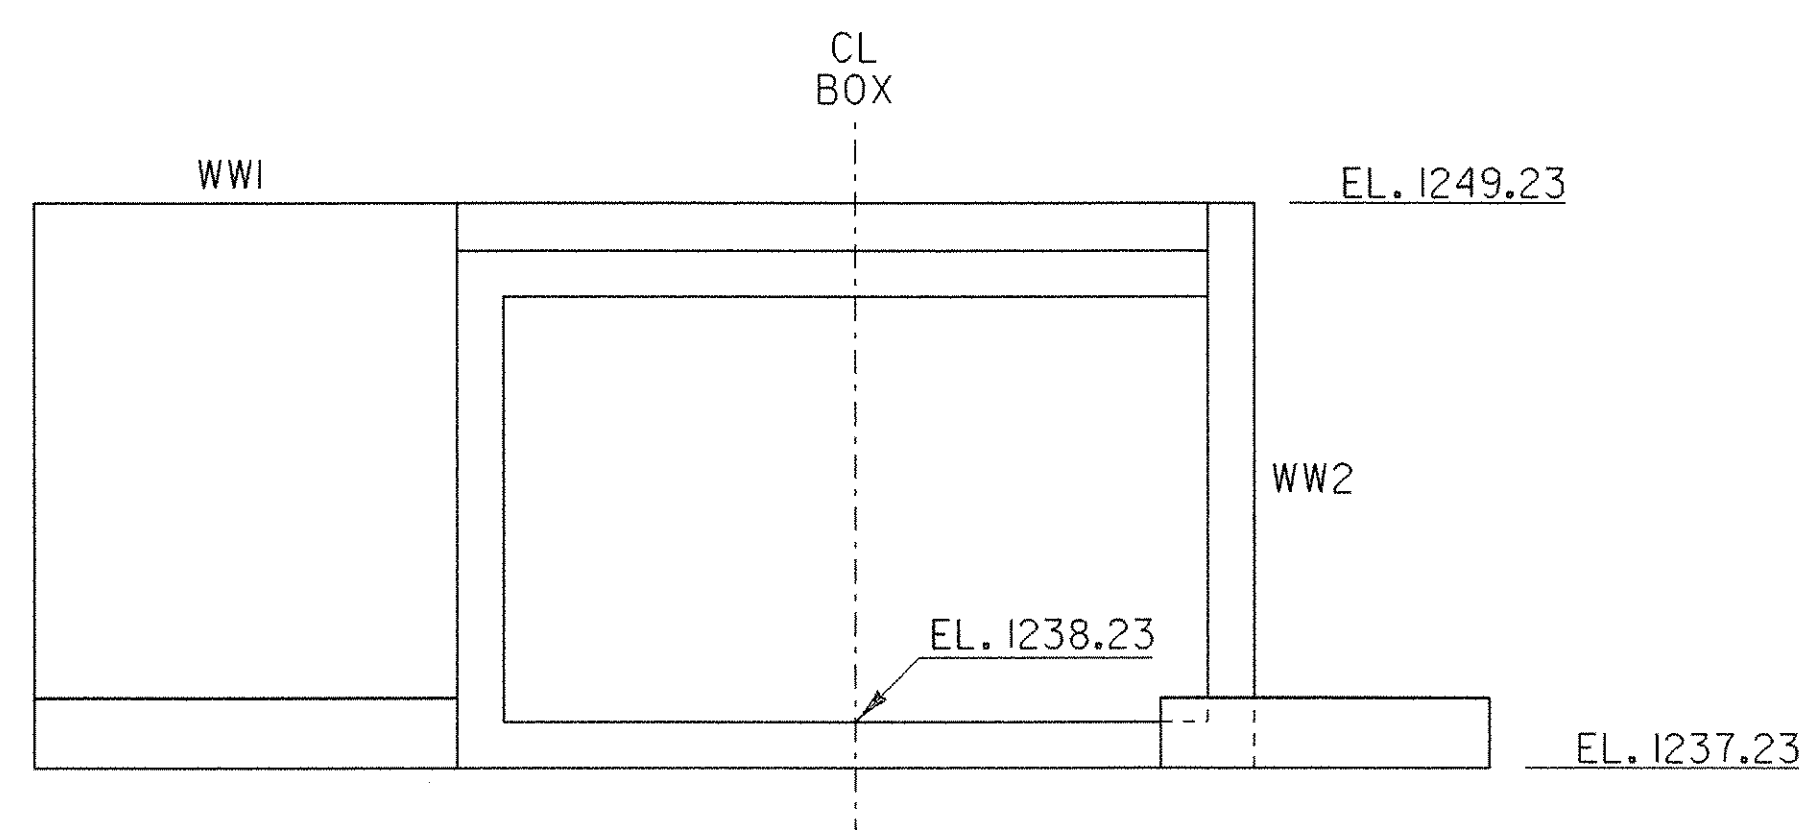

INLET ELEVATION

SCALE 1/4" = 1'-0"

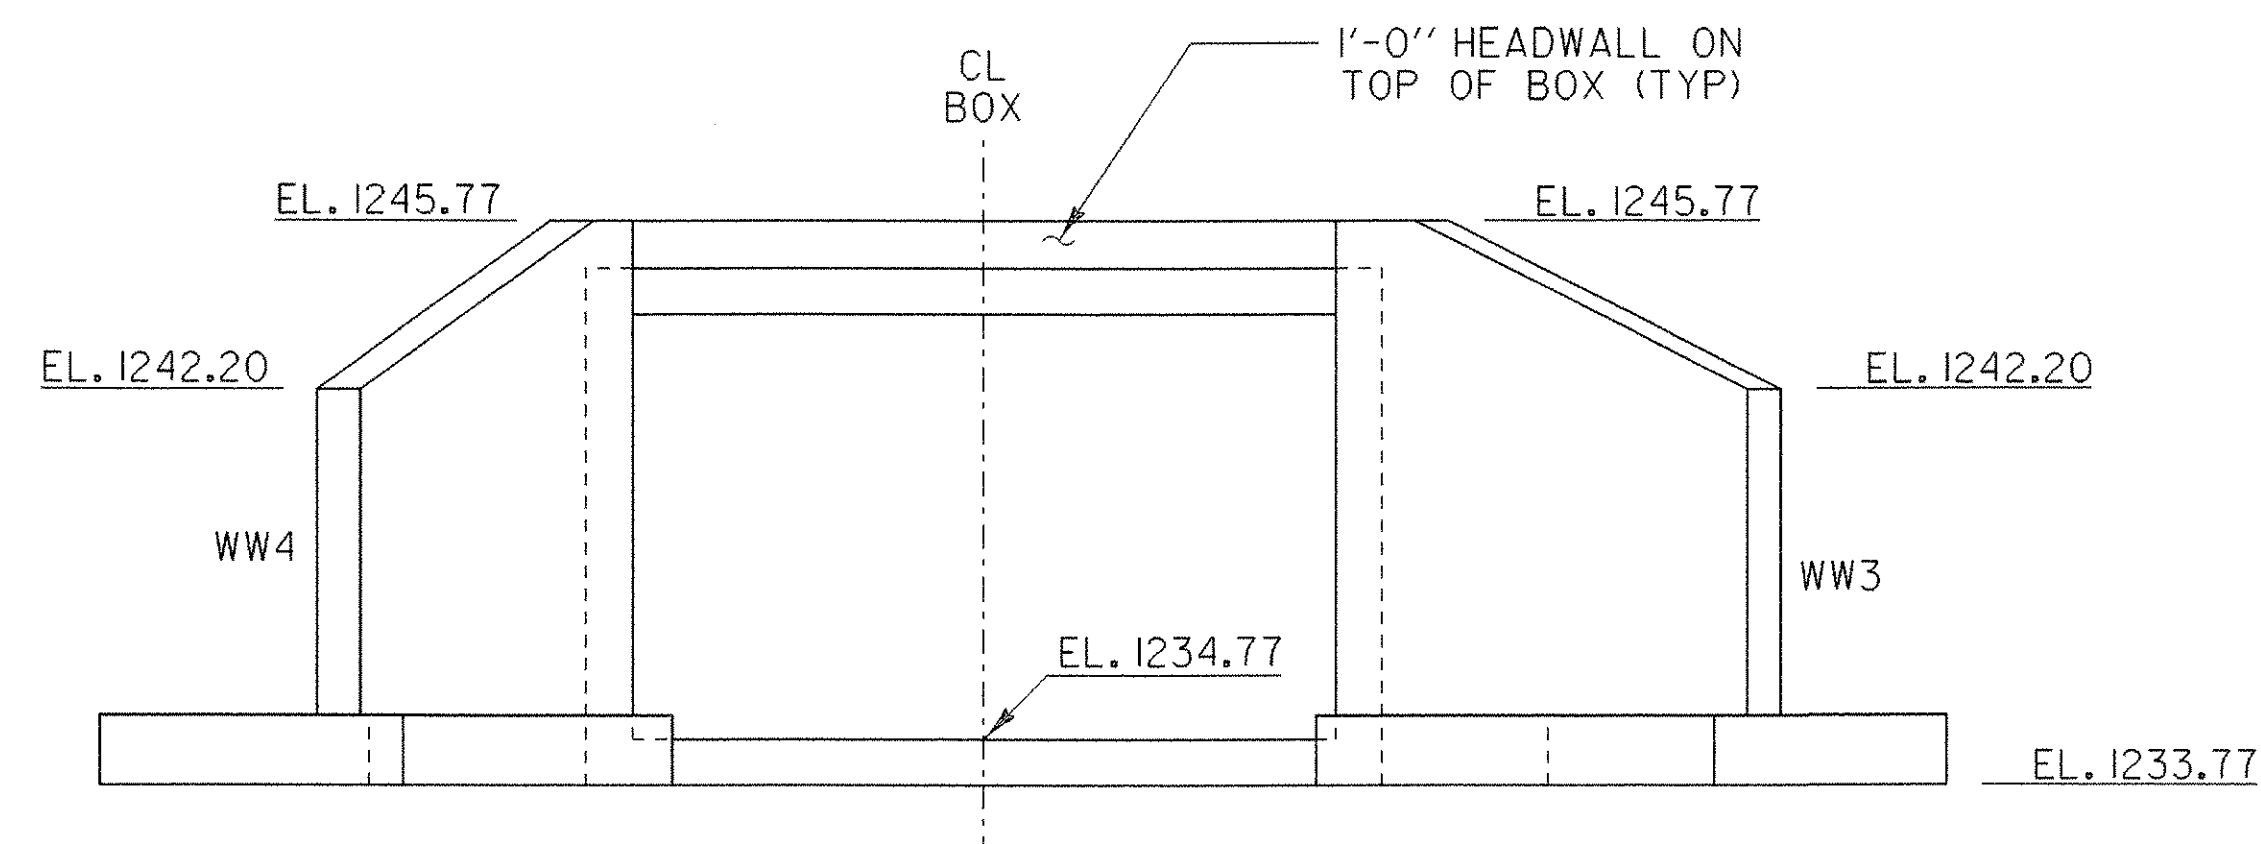



OUTLET ELEVATION


SCALE 1/4" = 1'-0"

NOTE: DIMENSIONS SHOWN ARE BASED ON
AN ASSUMED WALL THICKNESS OF 1'-0".


BOX LAYOUT

PROJECT NAME:	JAY
PROJECT NUMBER:	ST STP CULV (2)
FILE NAME:	Structures/s04b140boxplan.dgn
PROJECT LEADER:	W. SYMONDS
DESIGNED BY:	T. FILLBACH
DRAWN BY:	G. SHANGRAW
CHECKED BY:	T. SUMNER
SHEET	31 OF 39

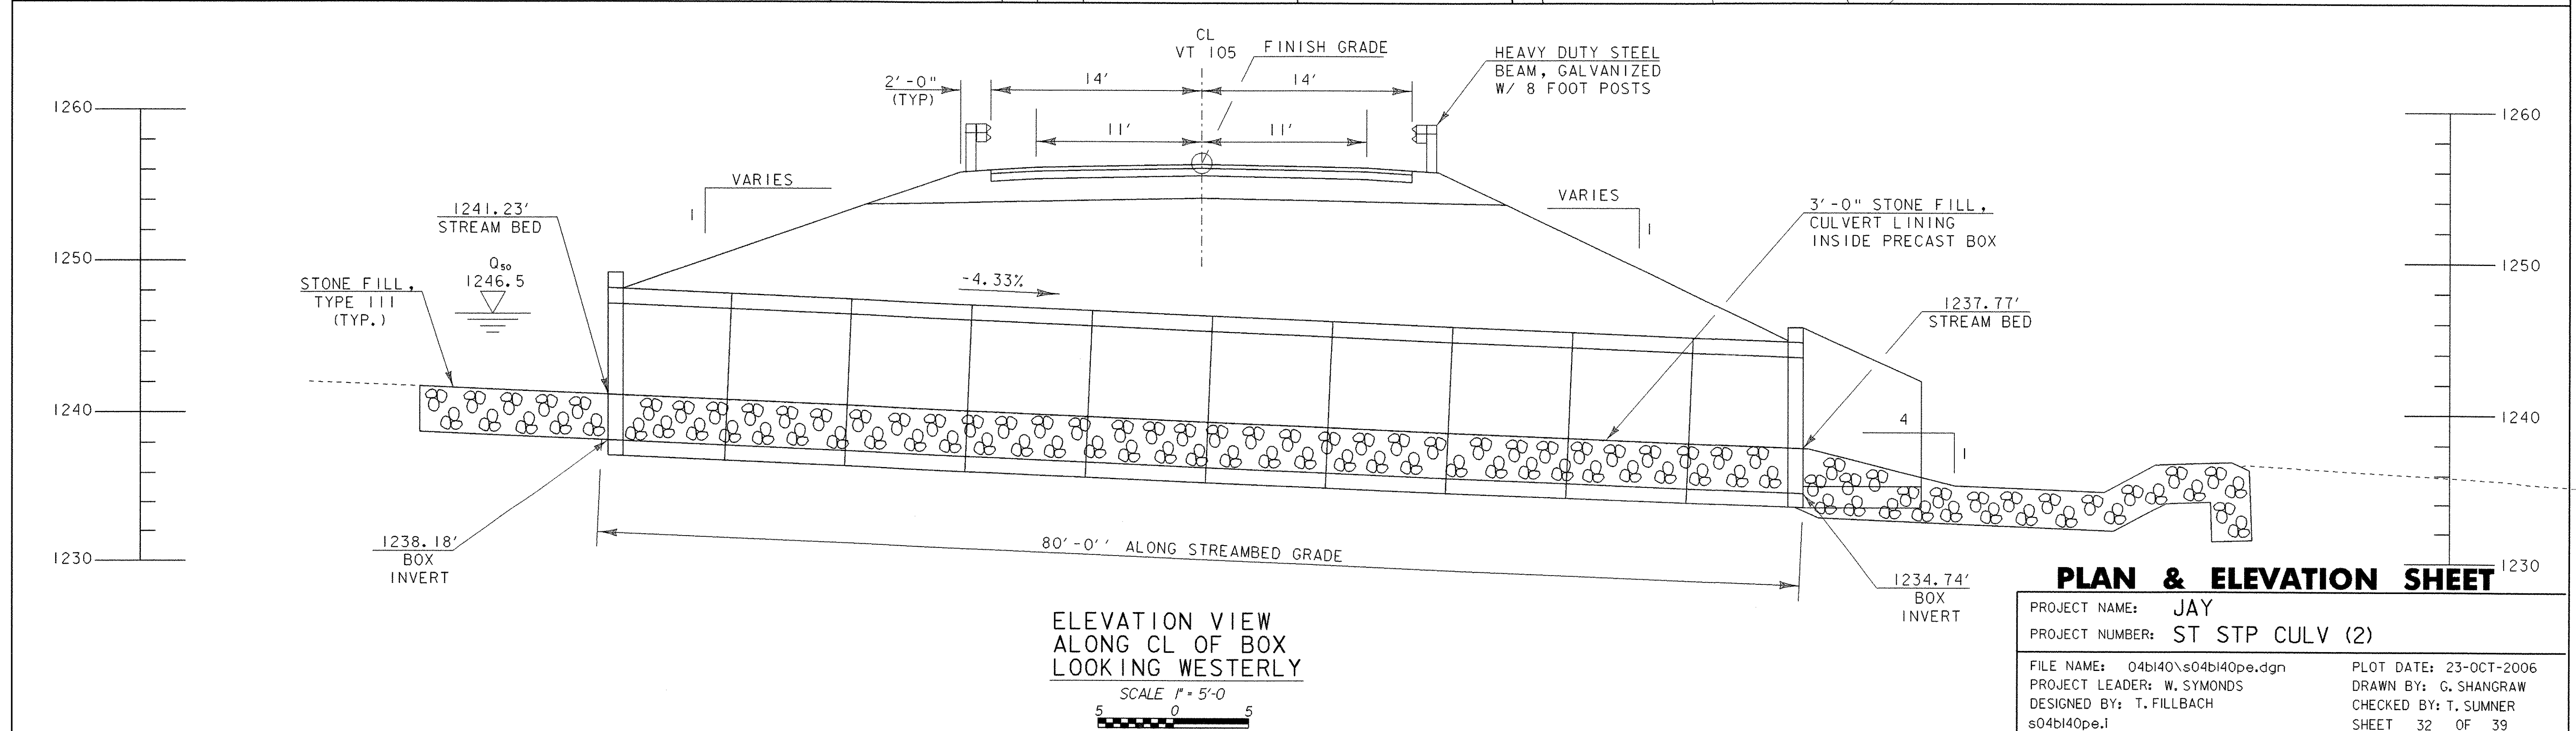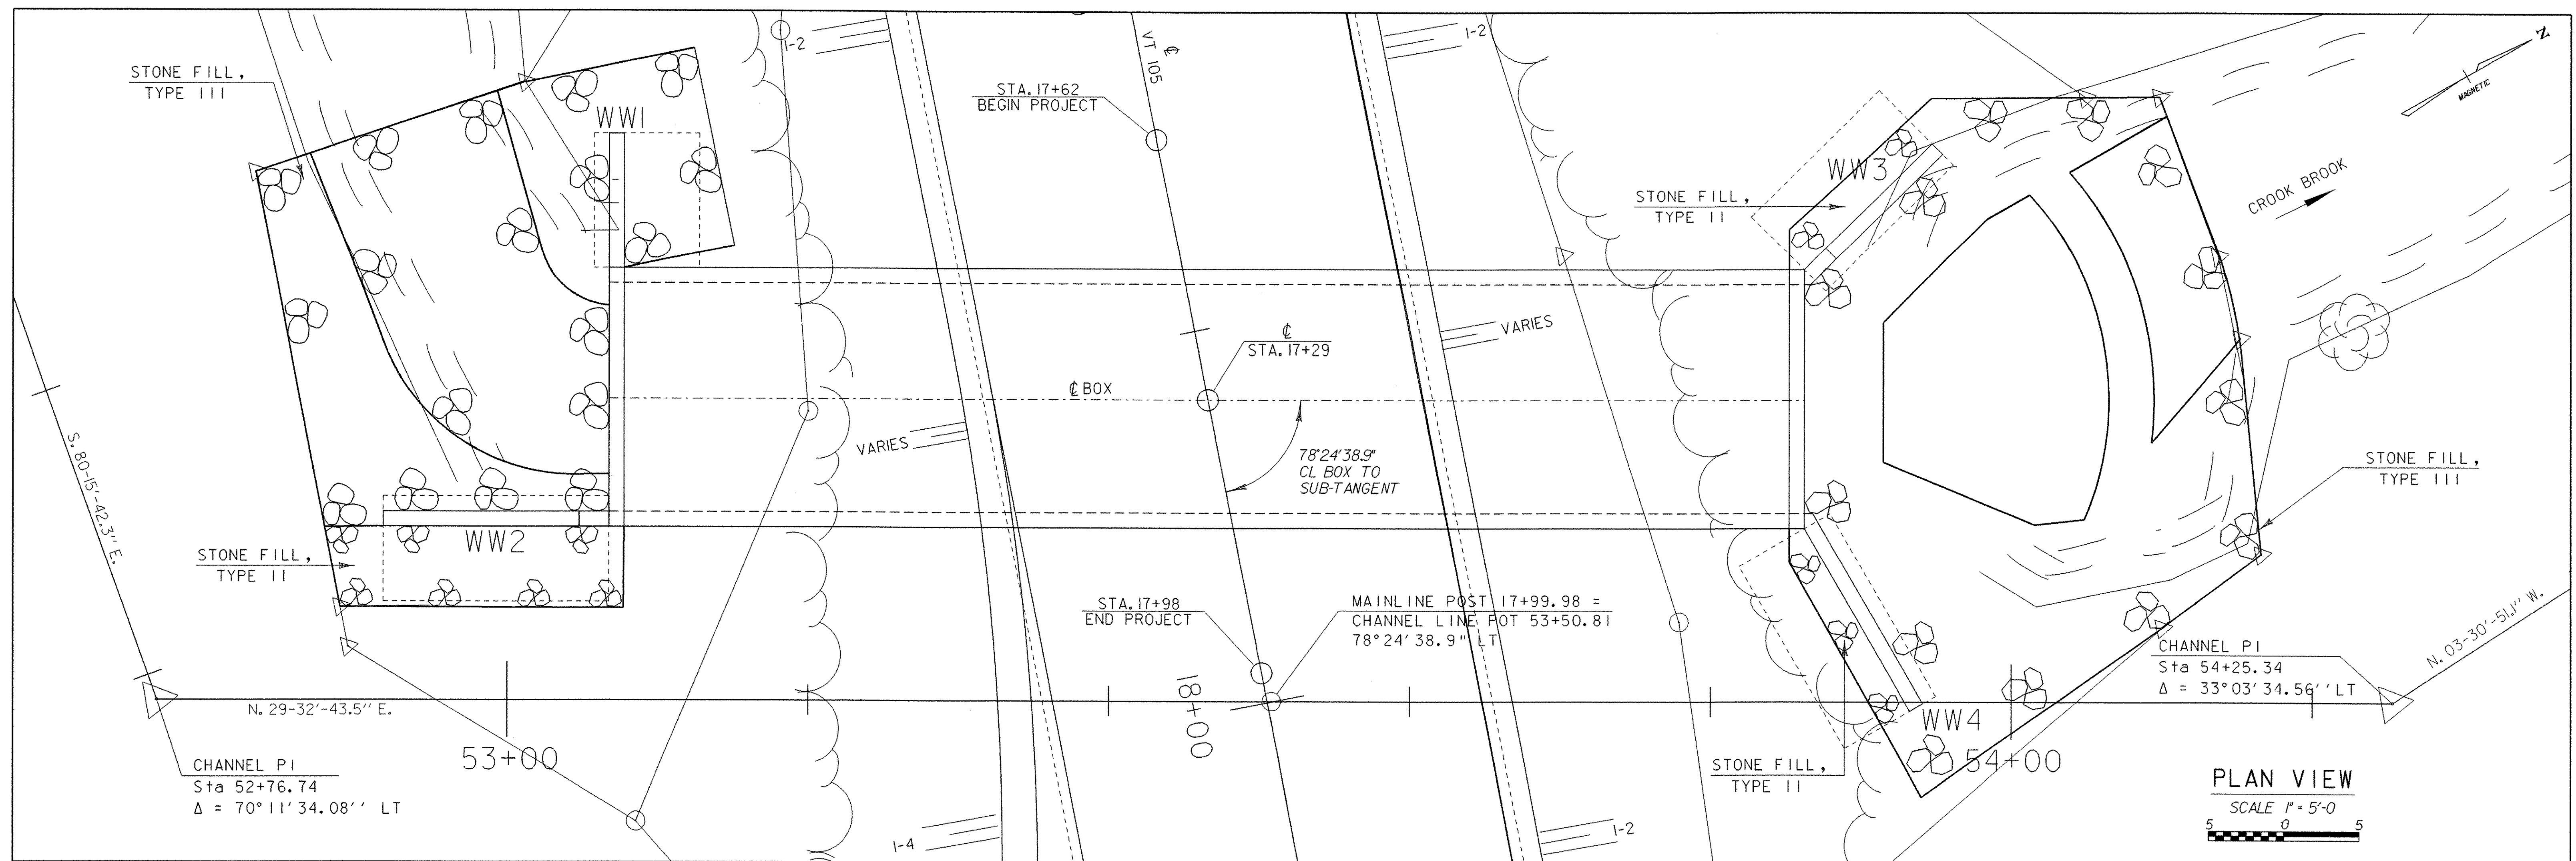


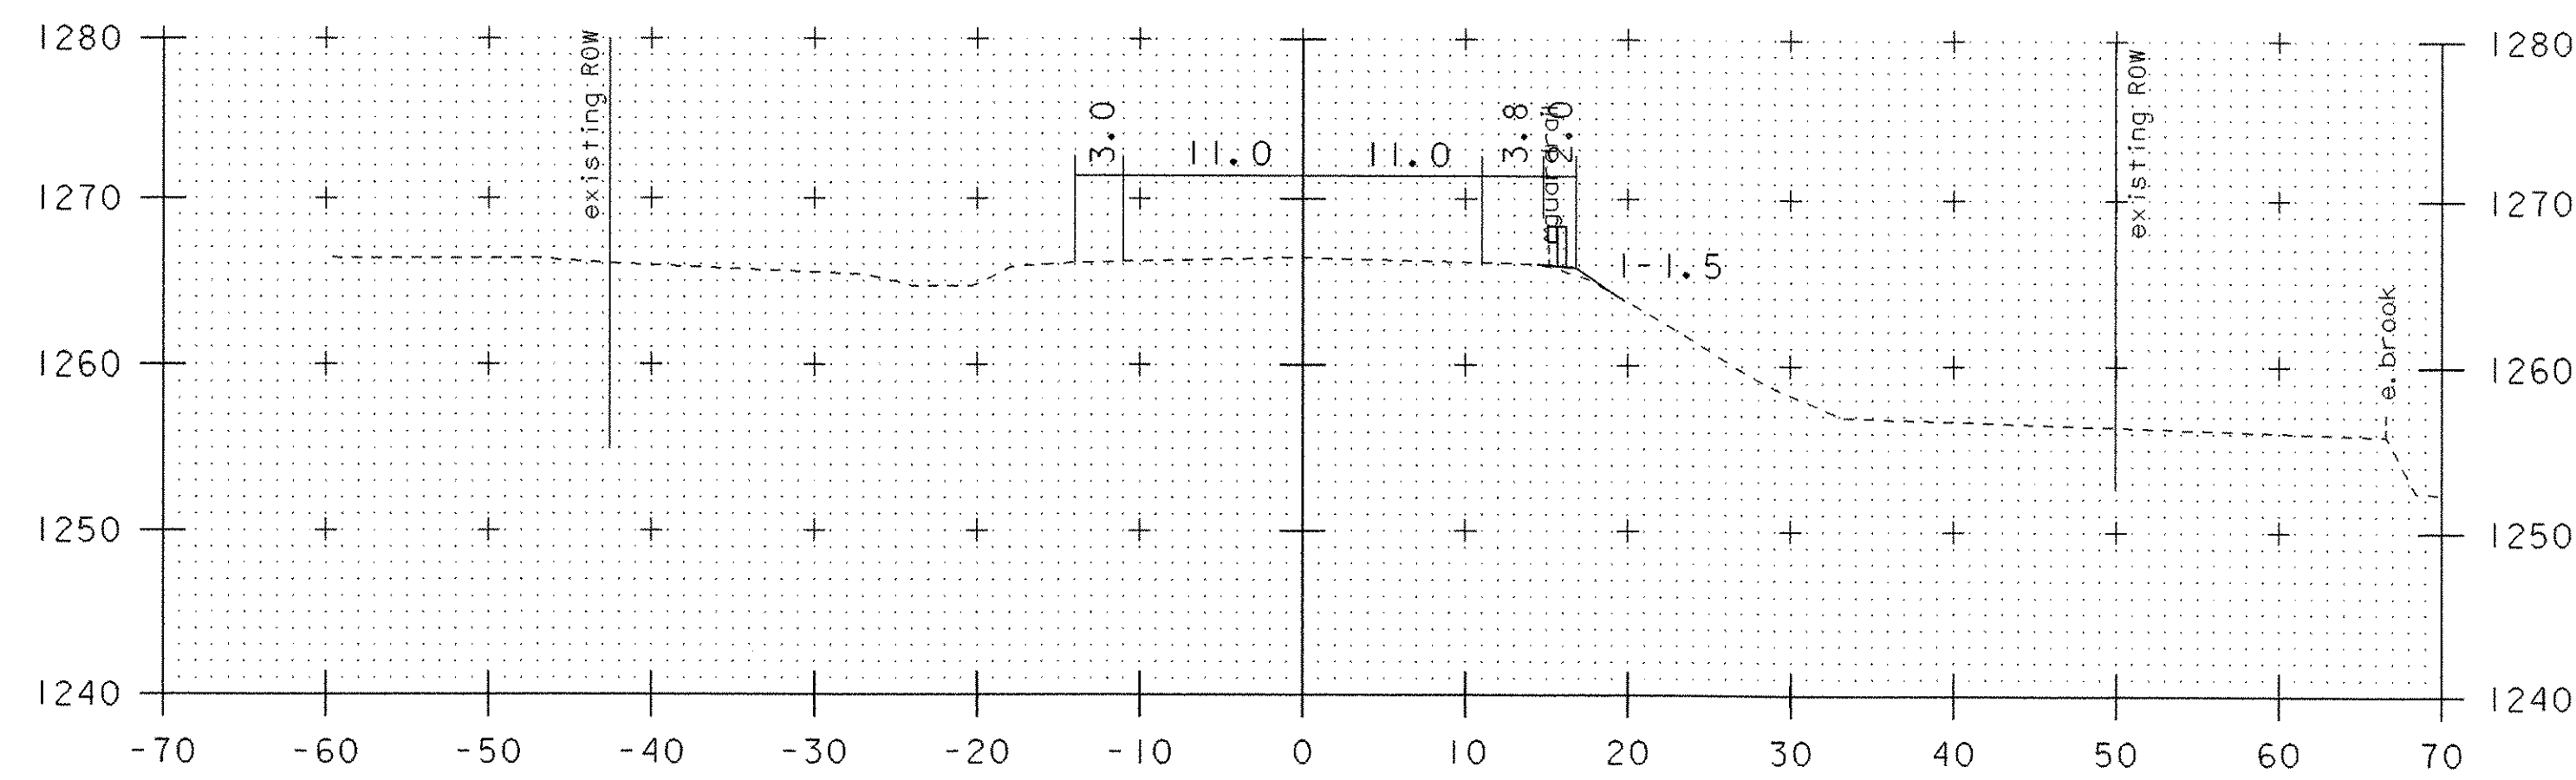


BEGIN APPROACH STA 15+87 16+00

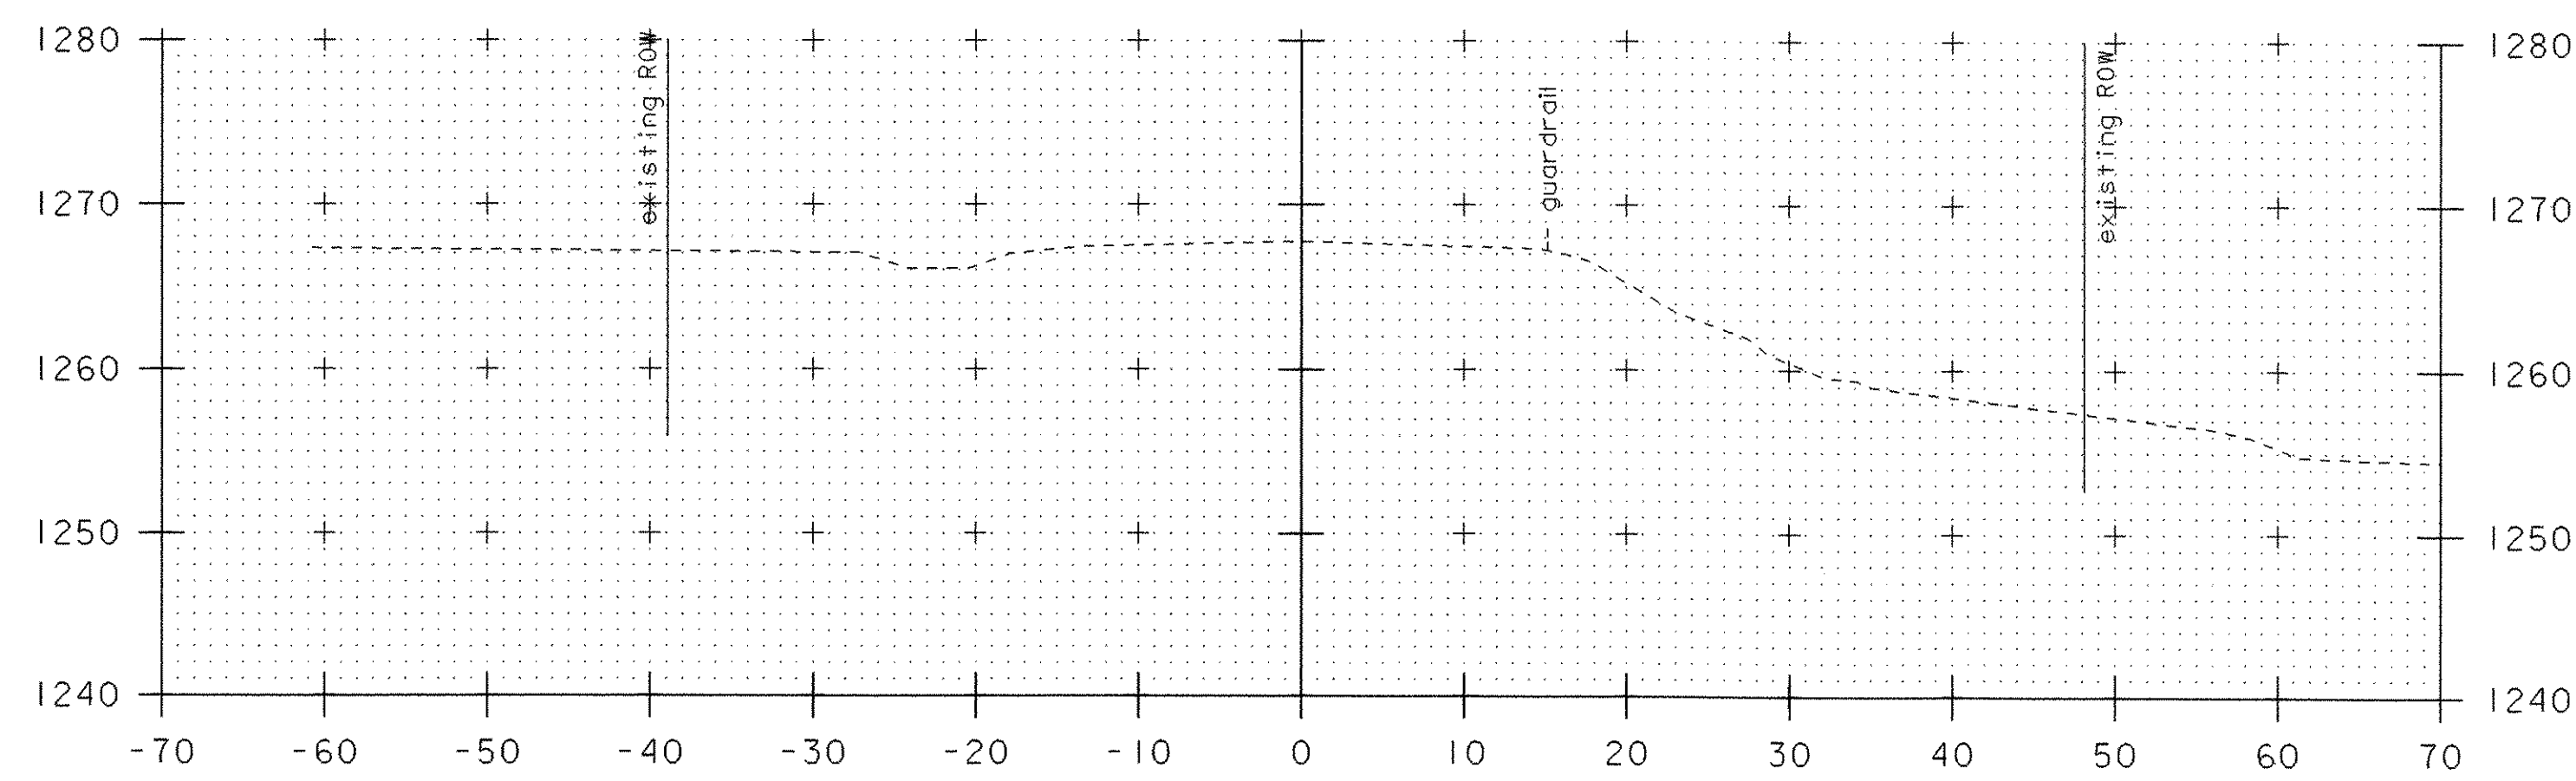


15+75

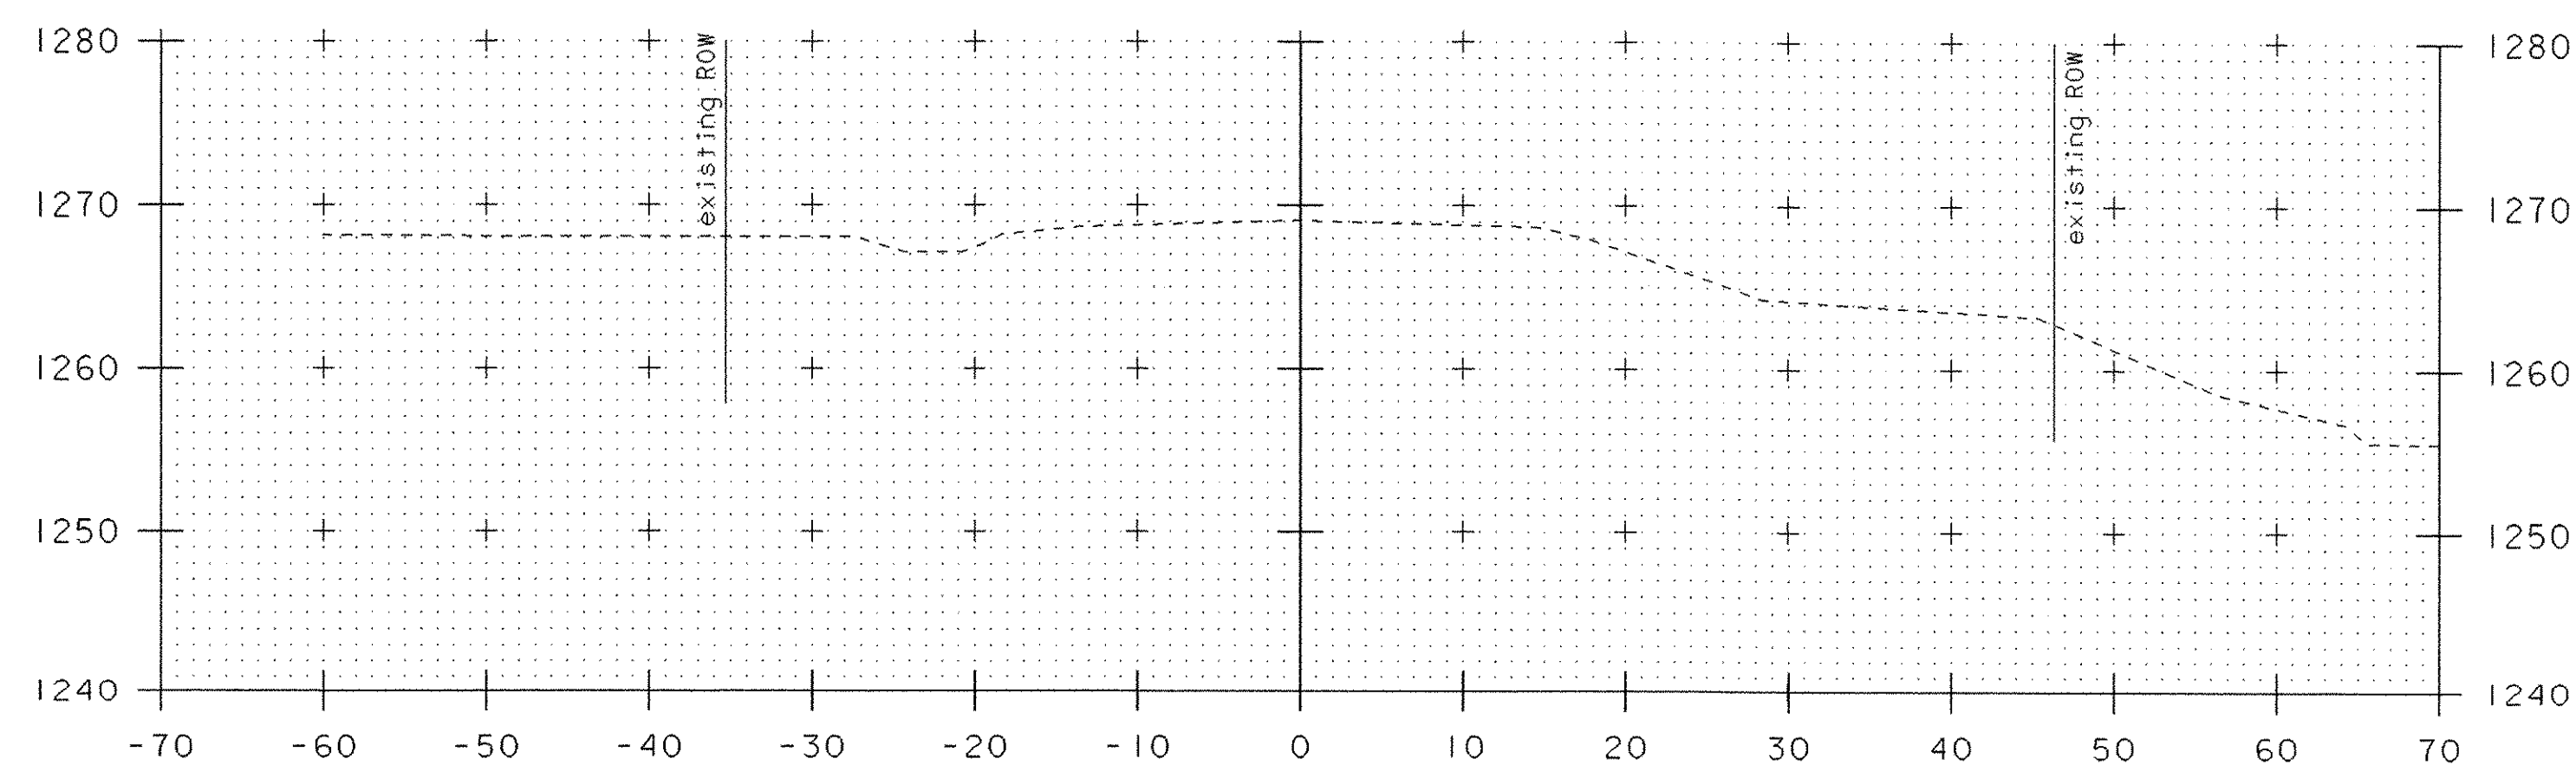

15+50

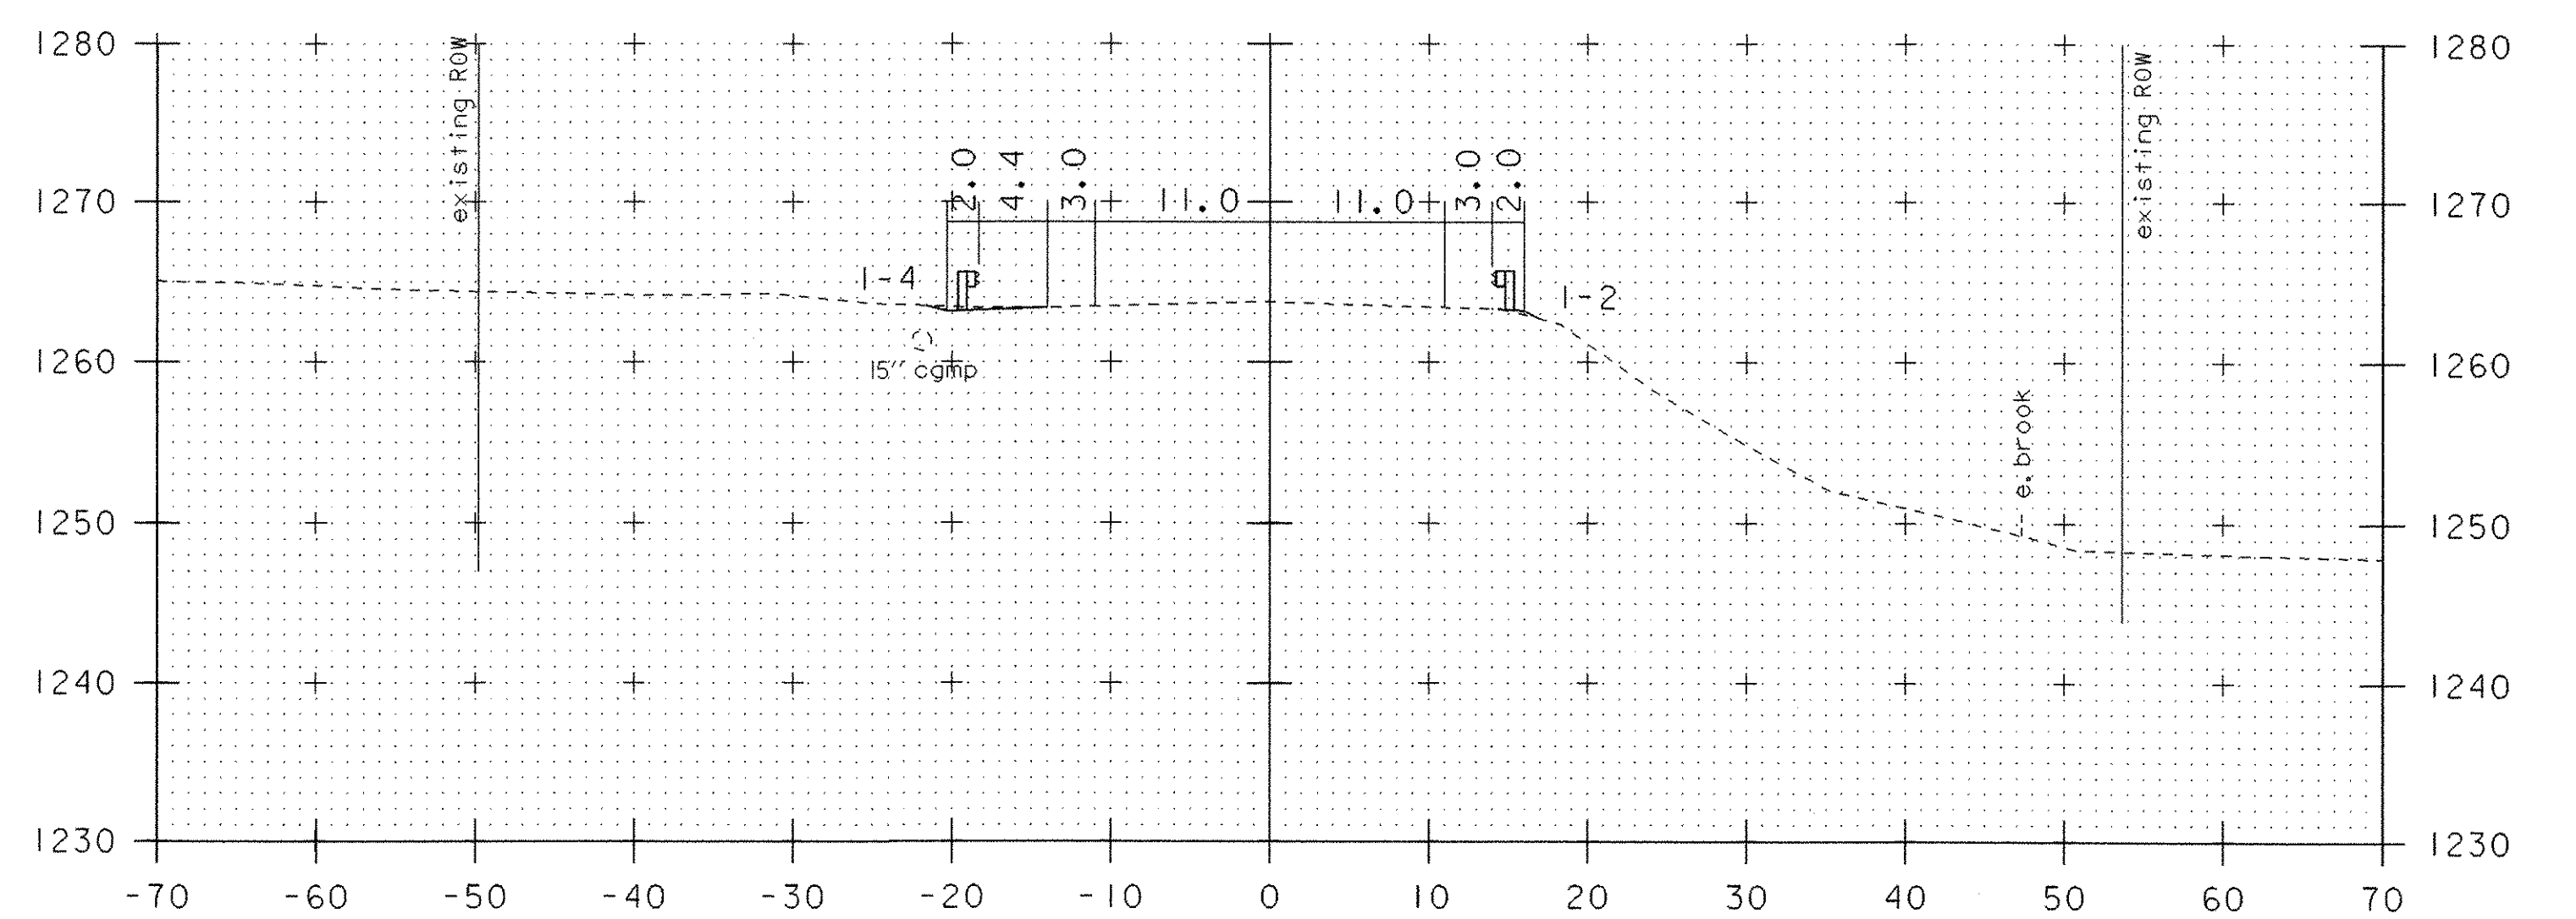






16+50

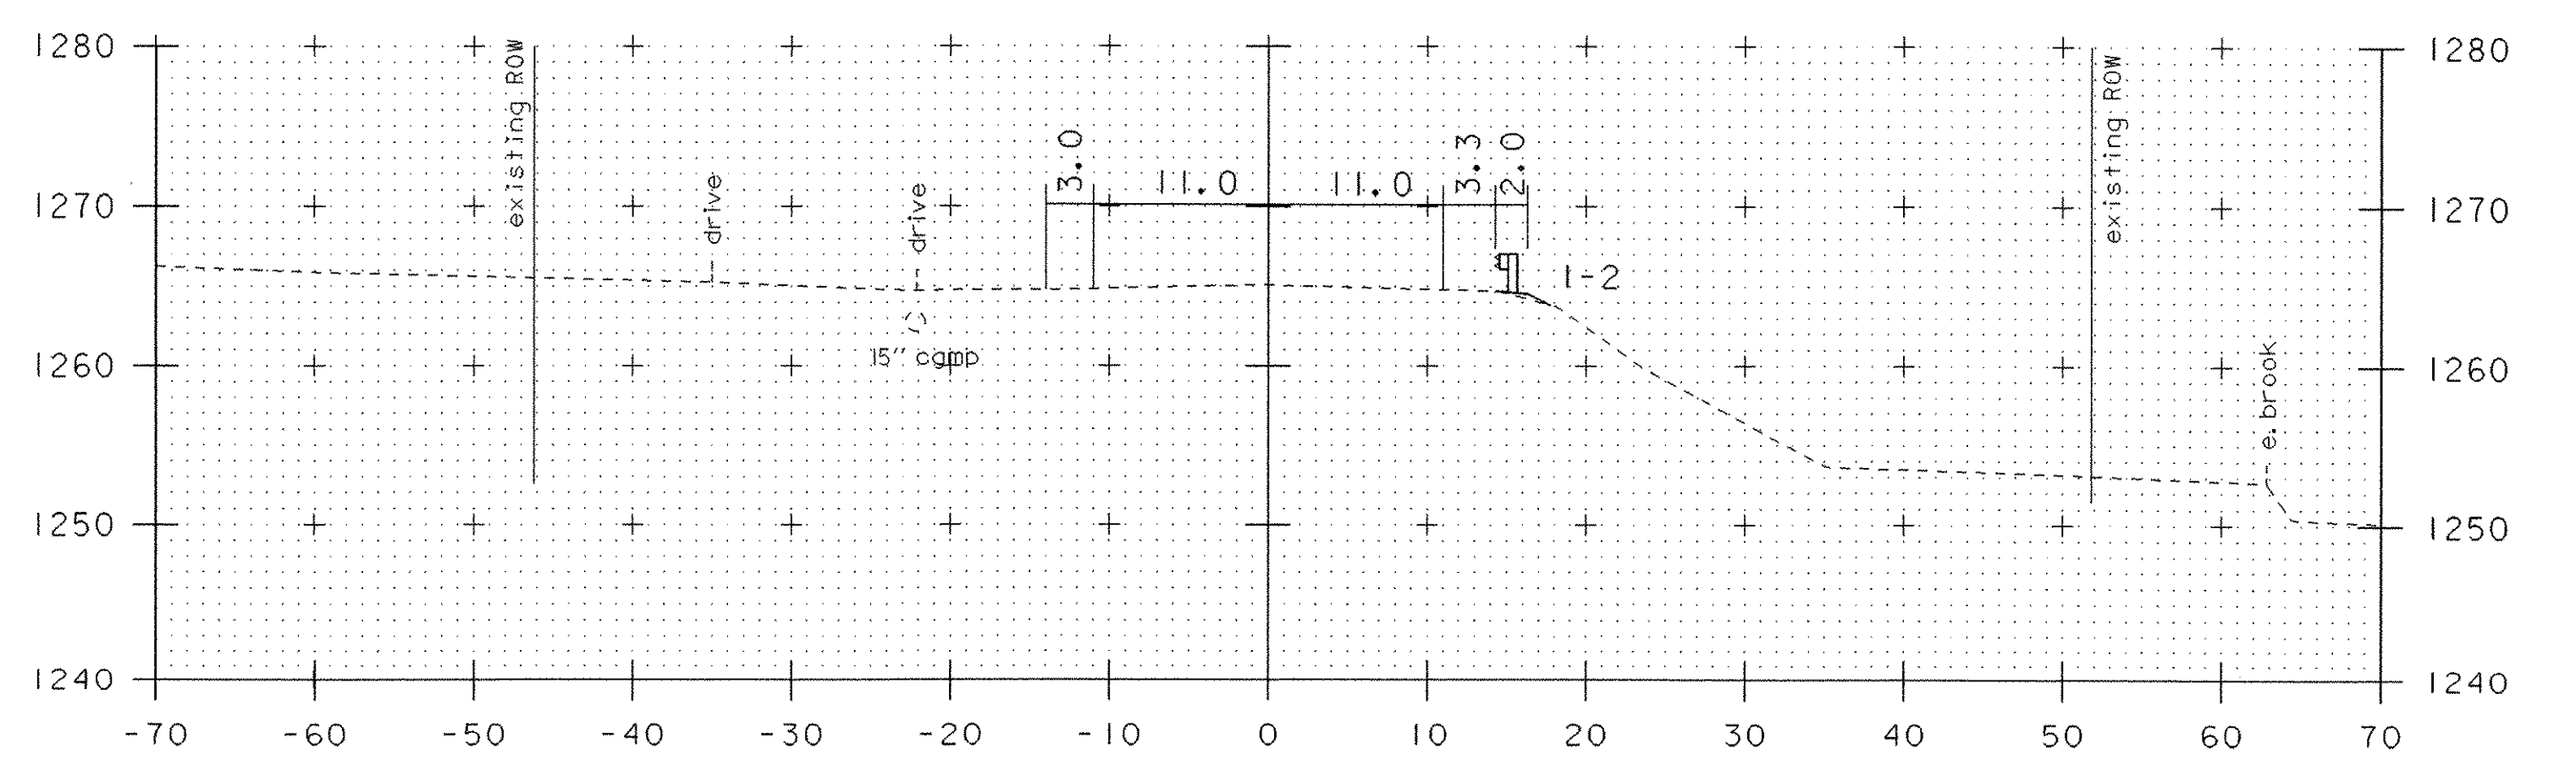

16+25







MAINLINE CROSS SECTIONS

PROJECT NAME:	JAY	FILE NAME:	04b140\s04b140bdr.dgn	PLOT DATE:	23-OCT-2006
PROJECT NUMBER:	ST STP CULV (2)	PROJECT LEADER:	W. SYMONDS	DRAWN BY:	G. SHANGRAW
		DESIGNED BY:	T. SUMNER	CHECKED BY:	J. LACROIX
			04b140xsl.j	SHEET	33 OF 39

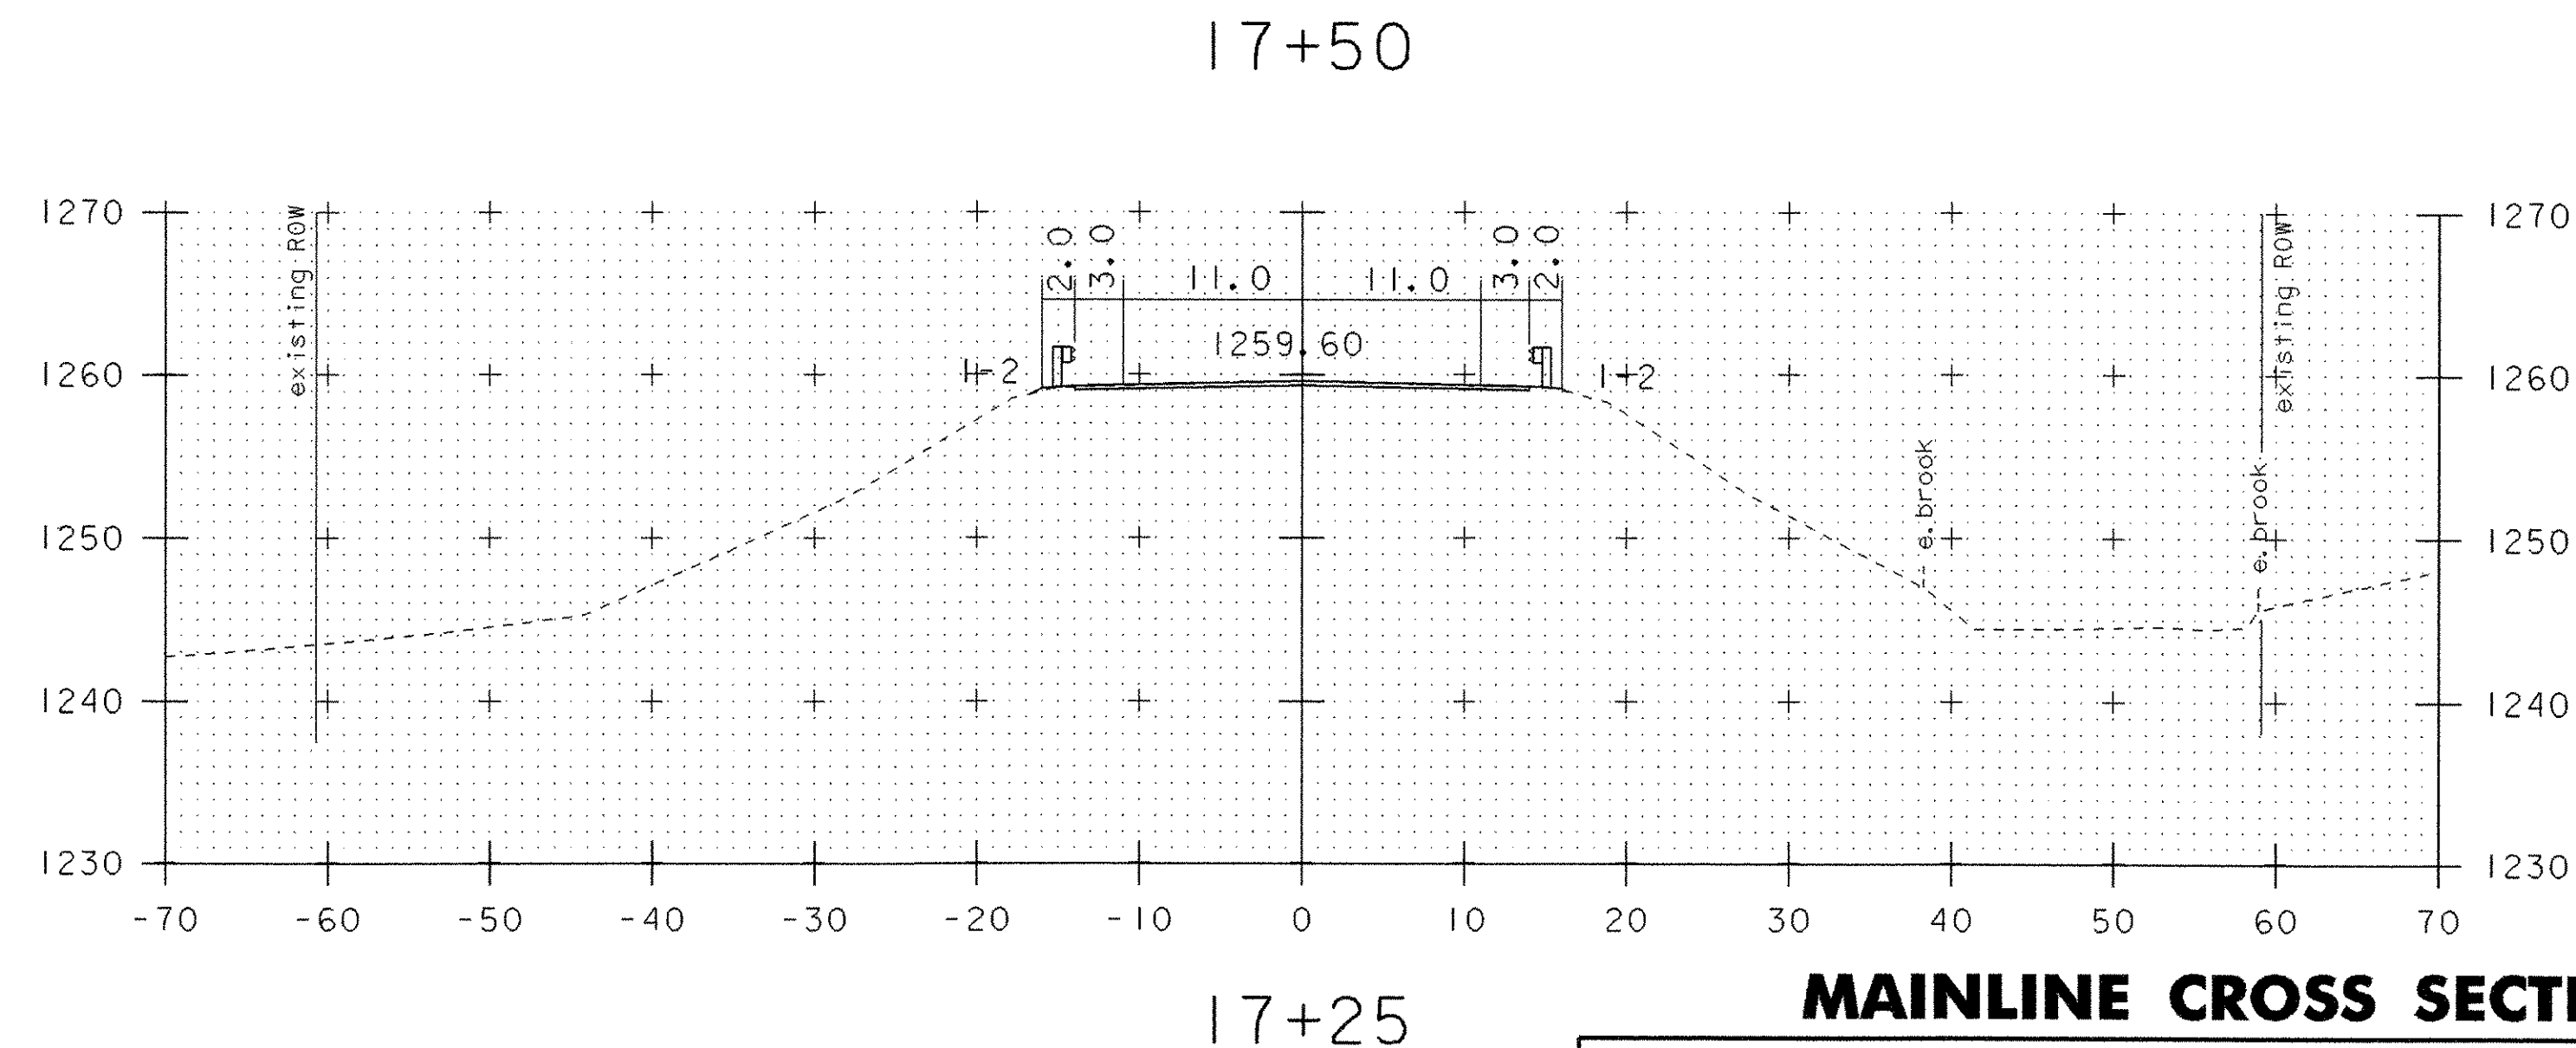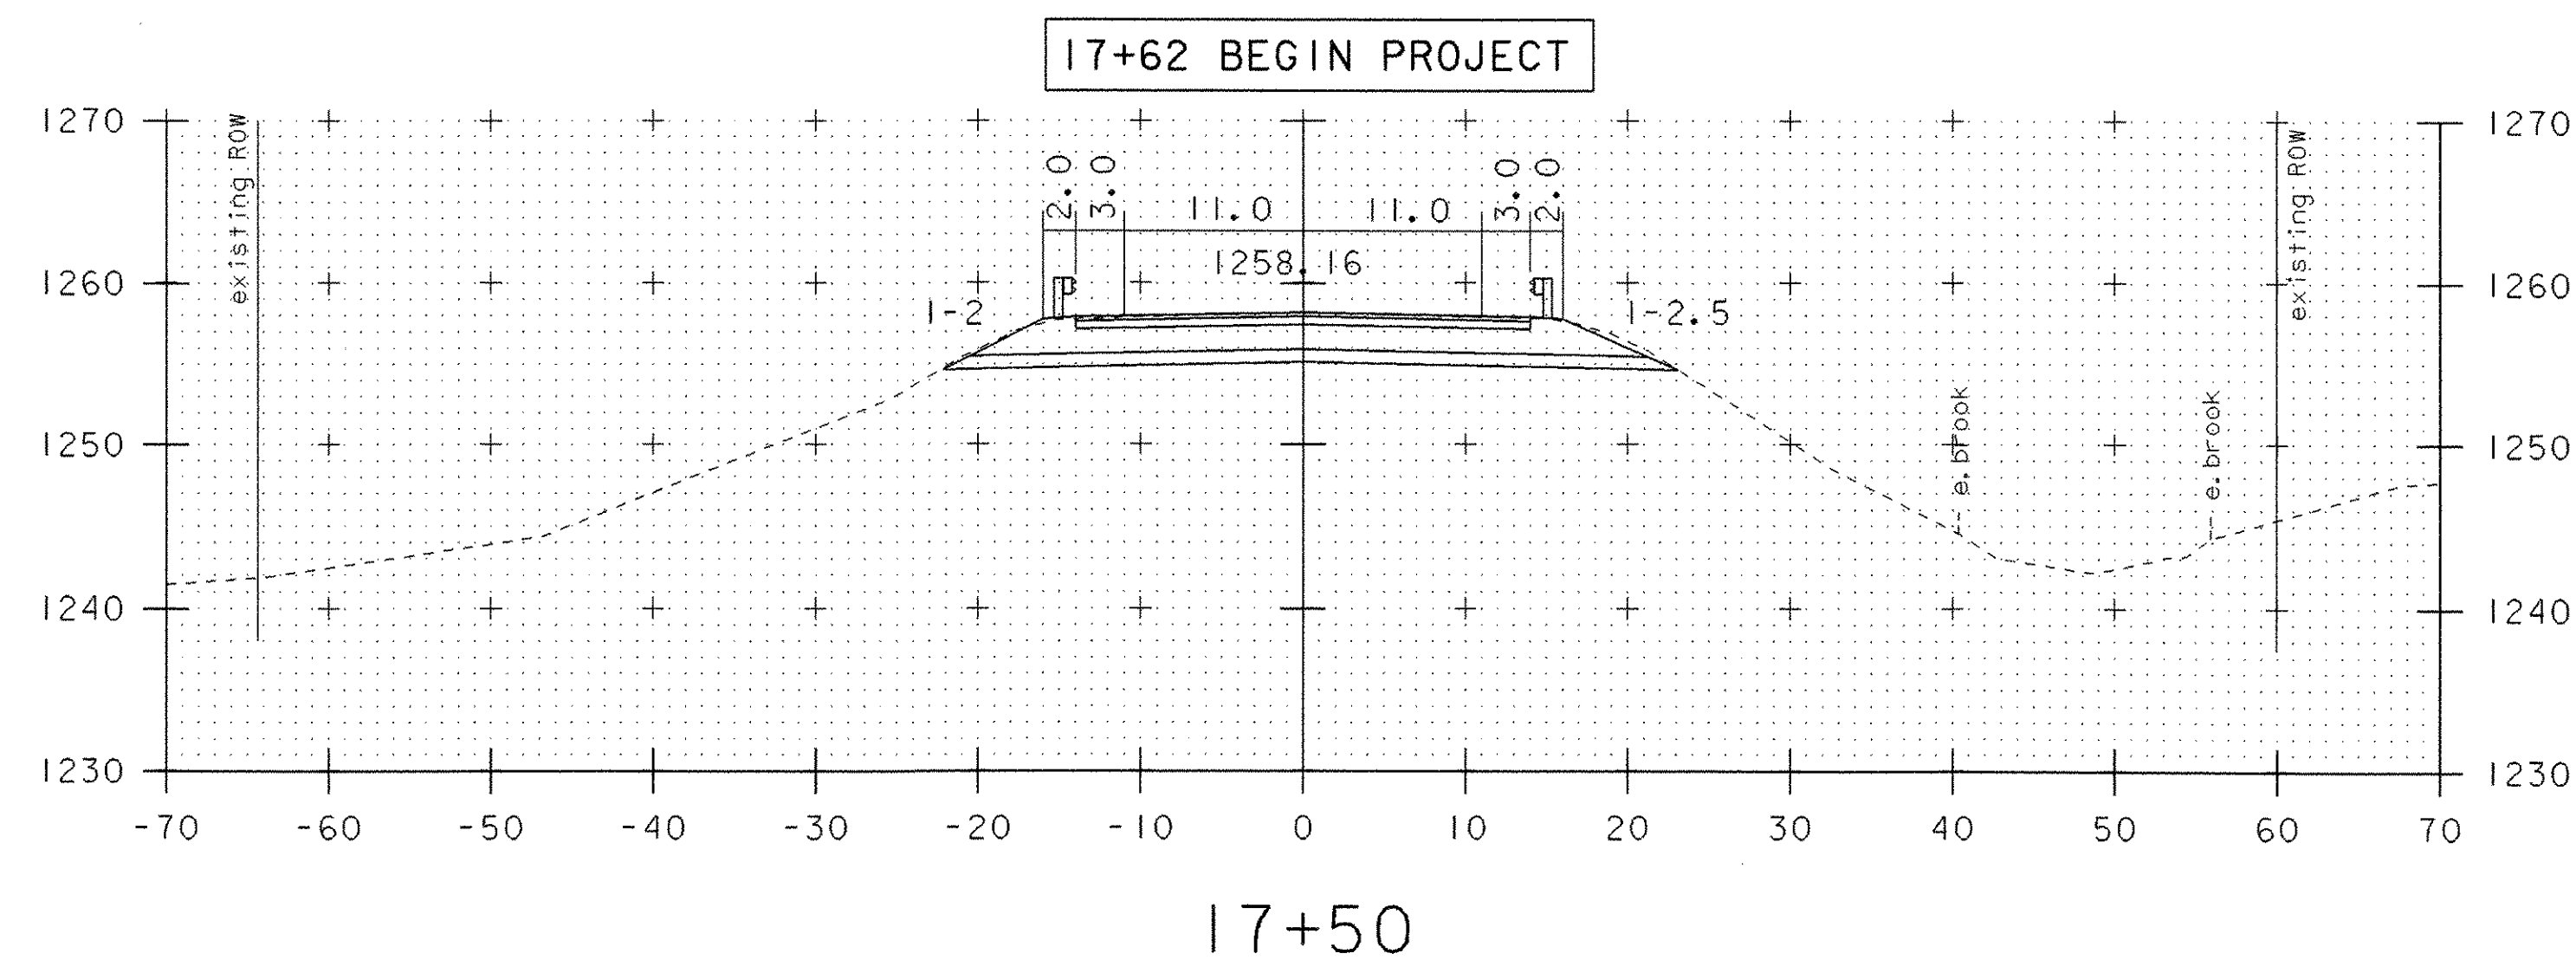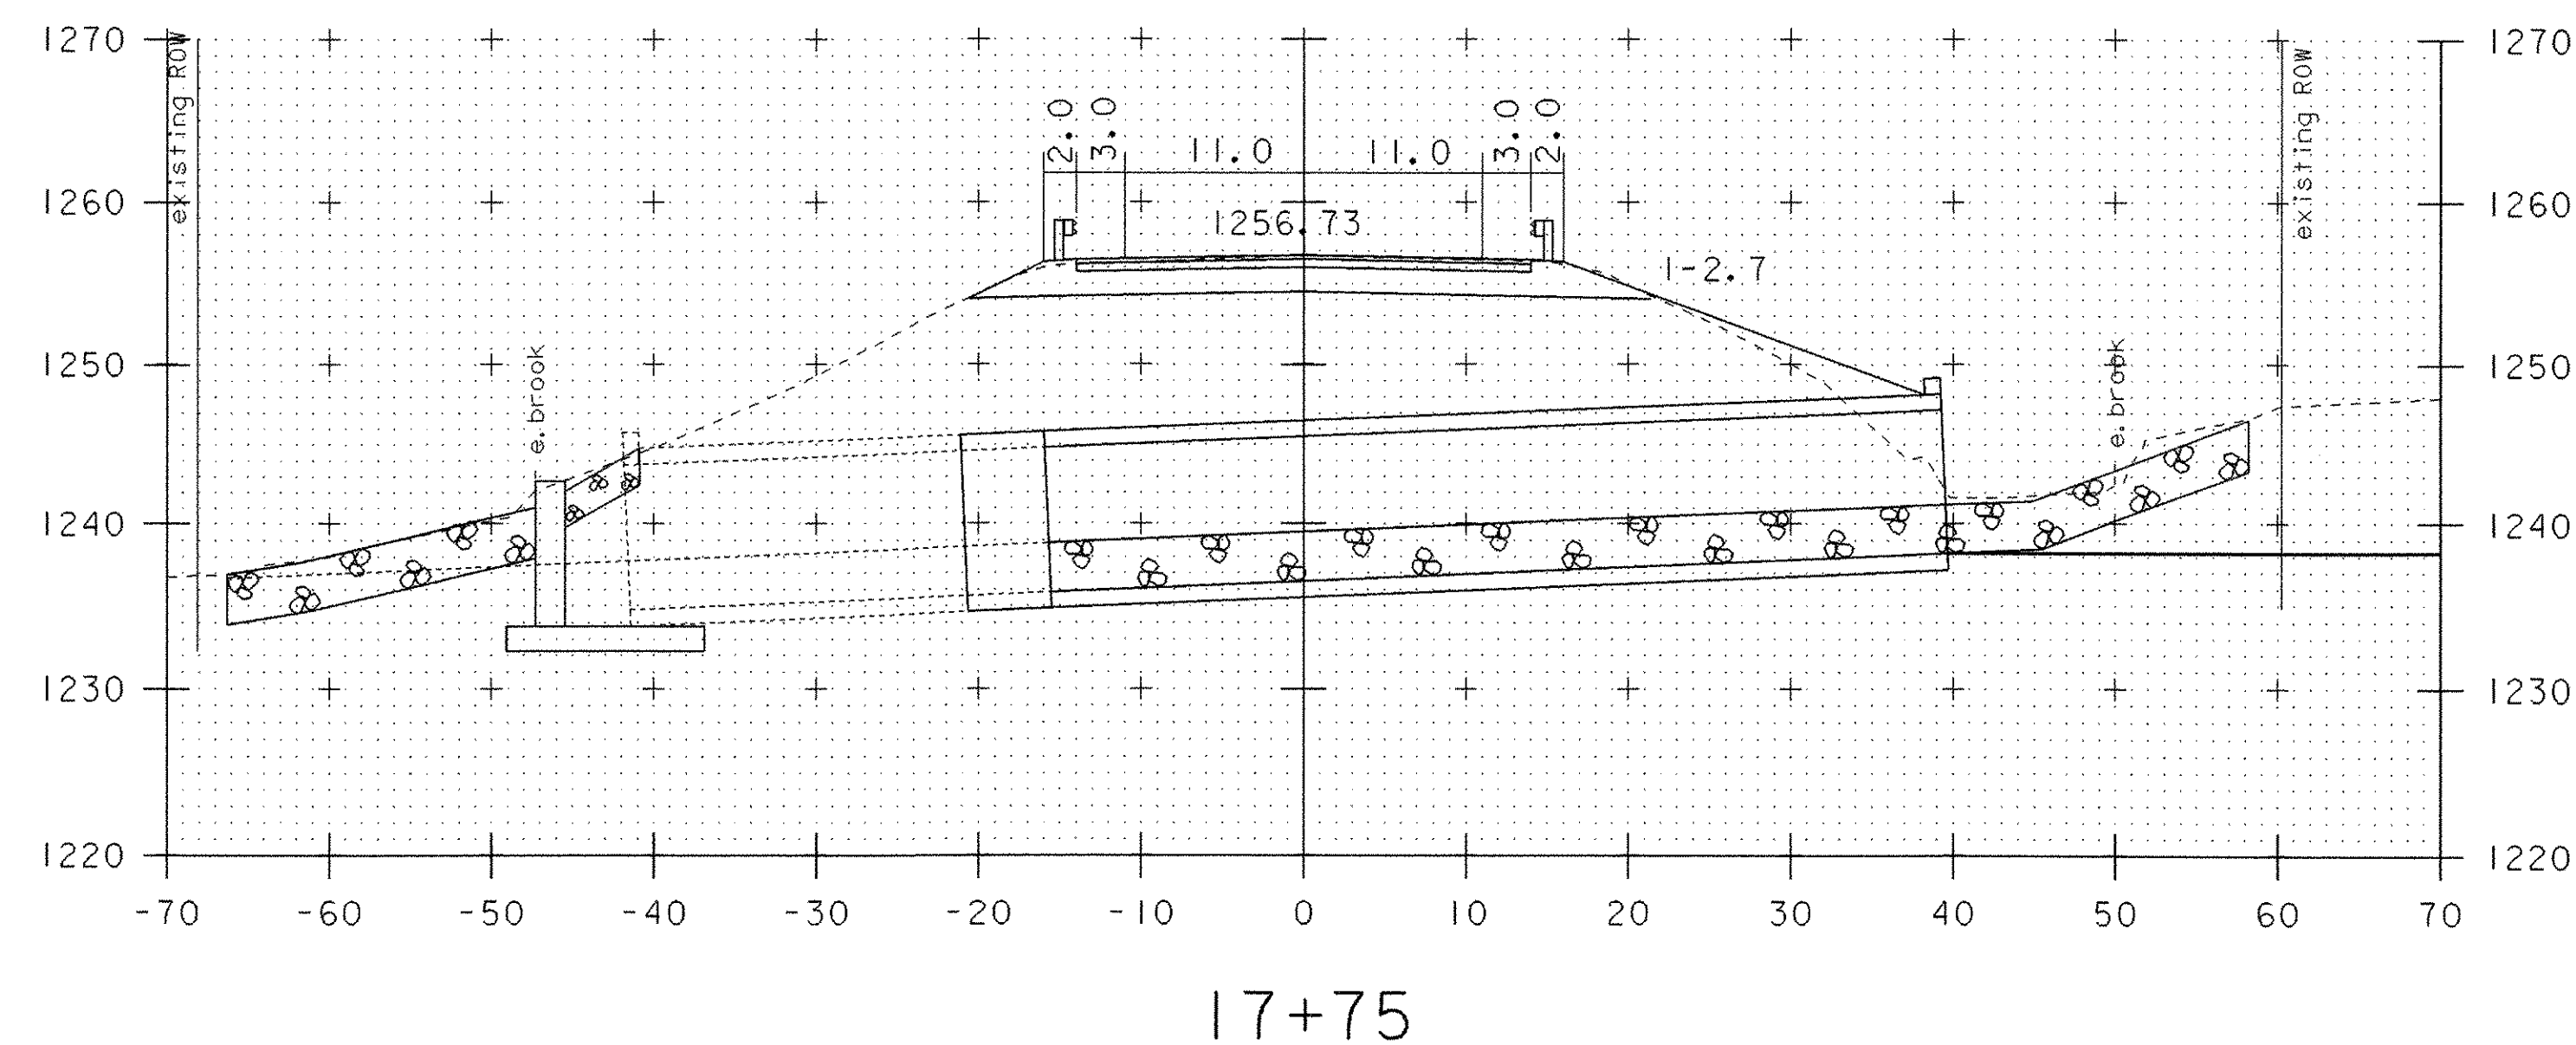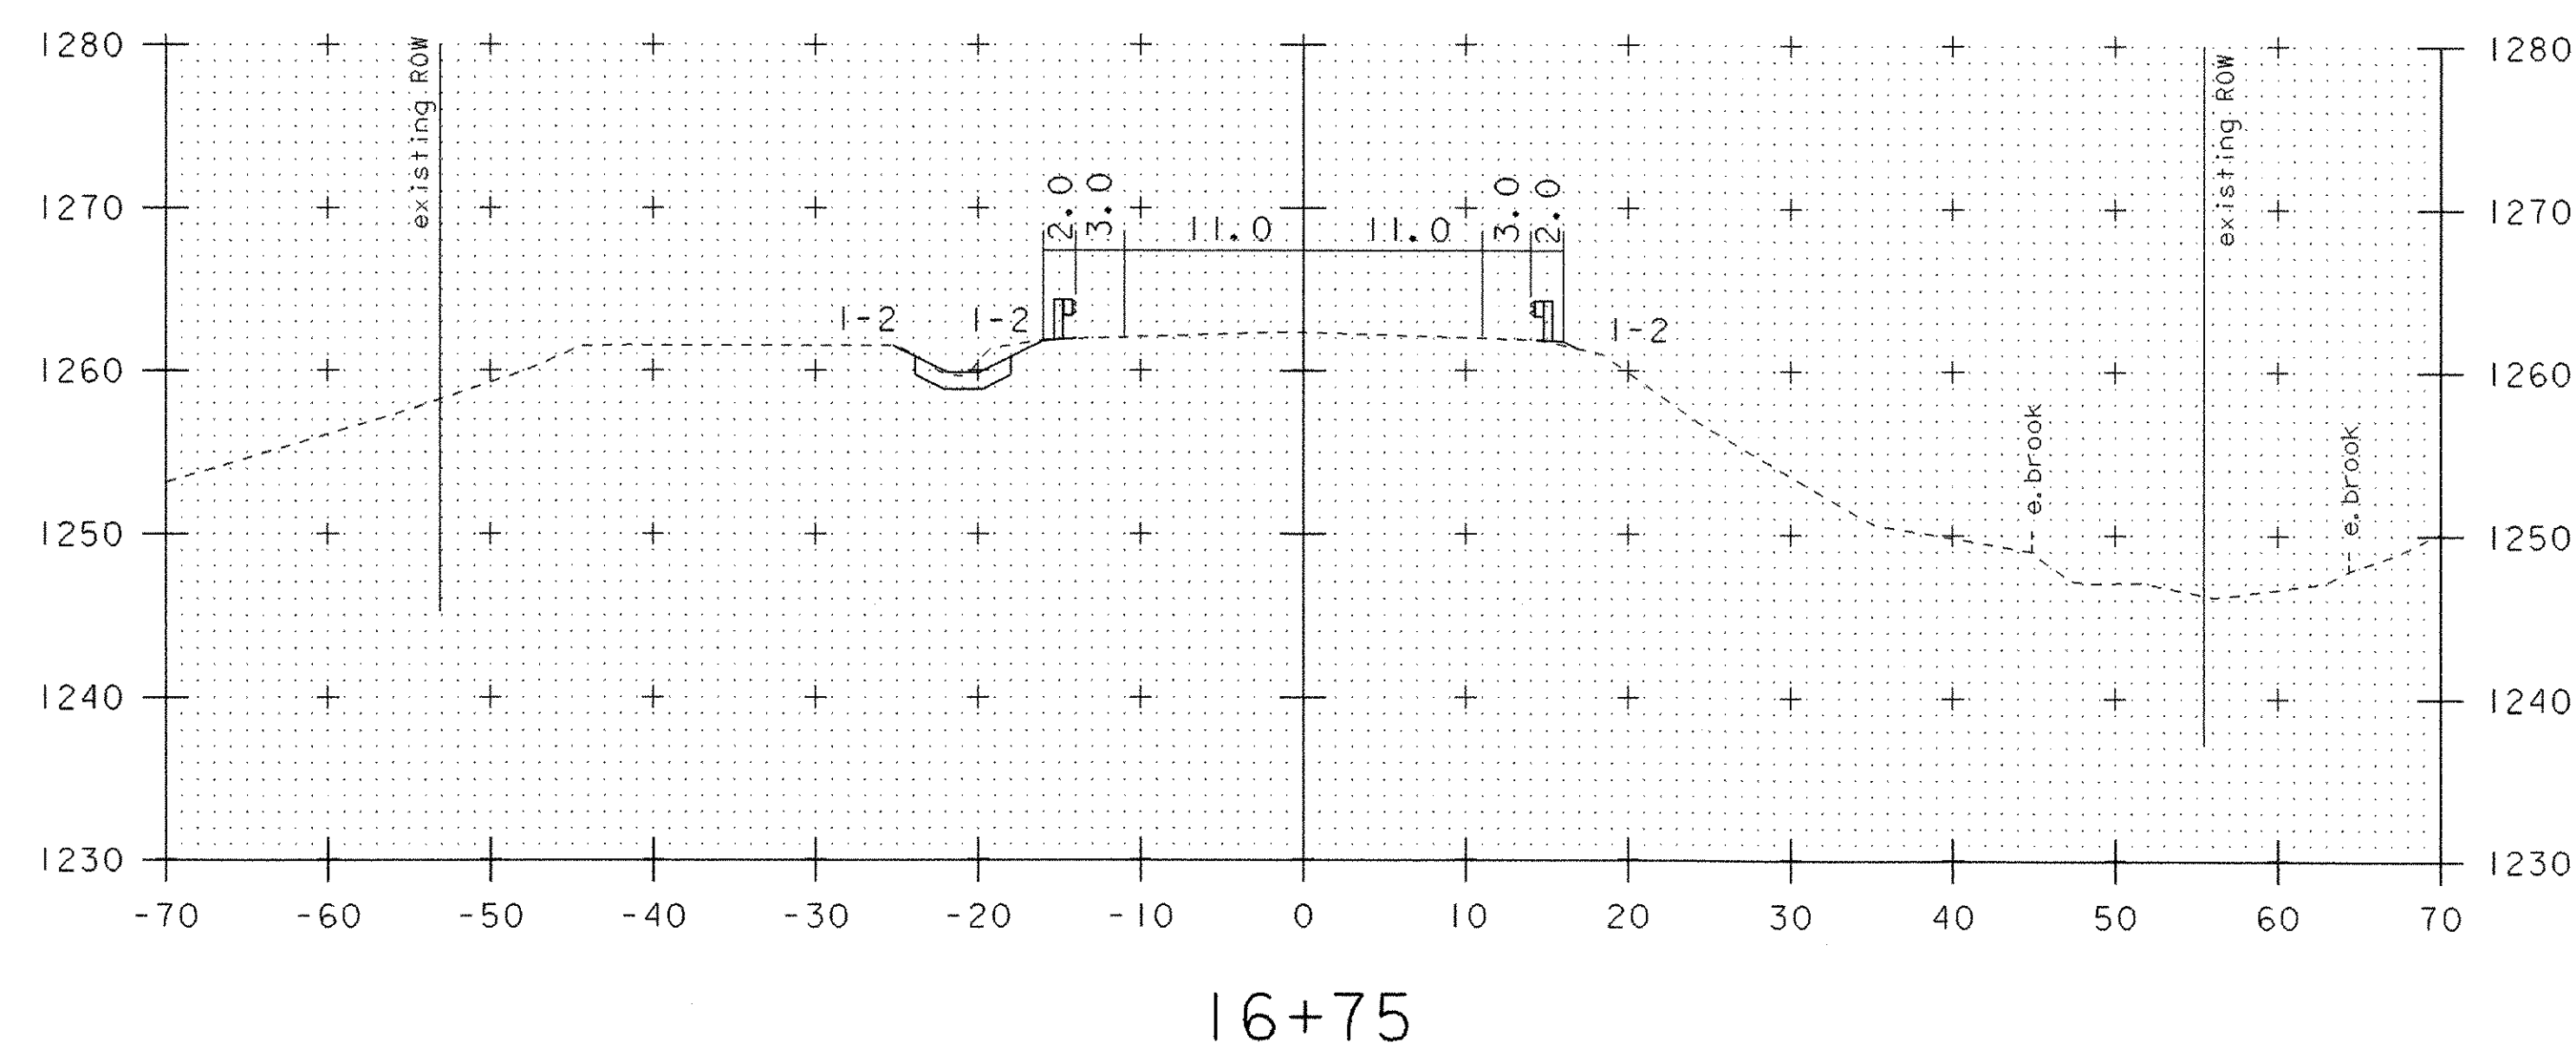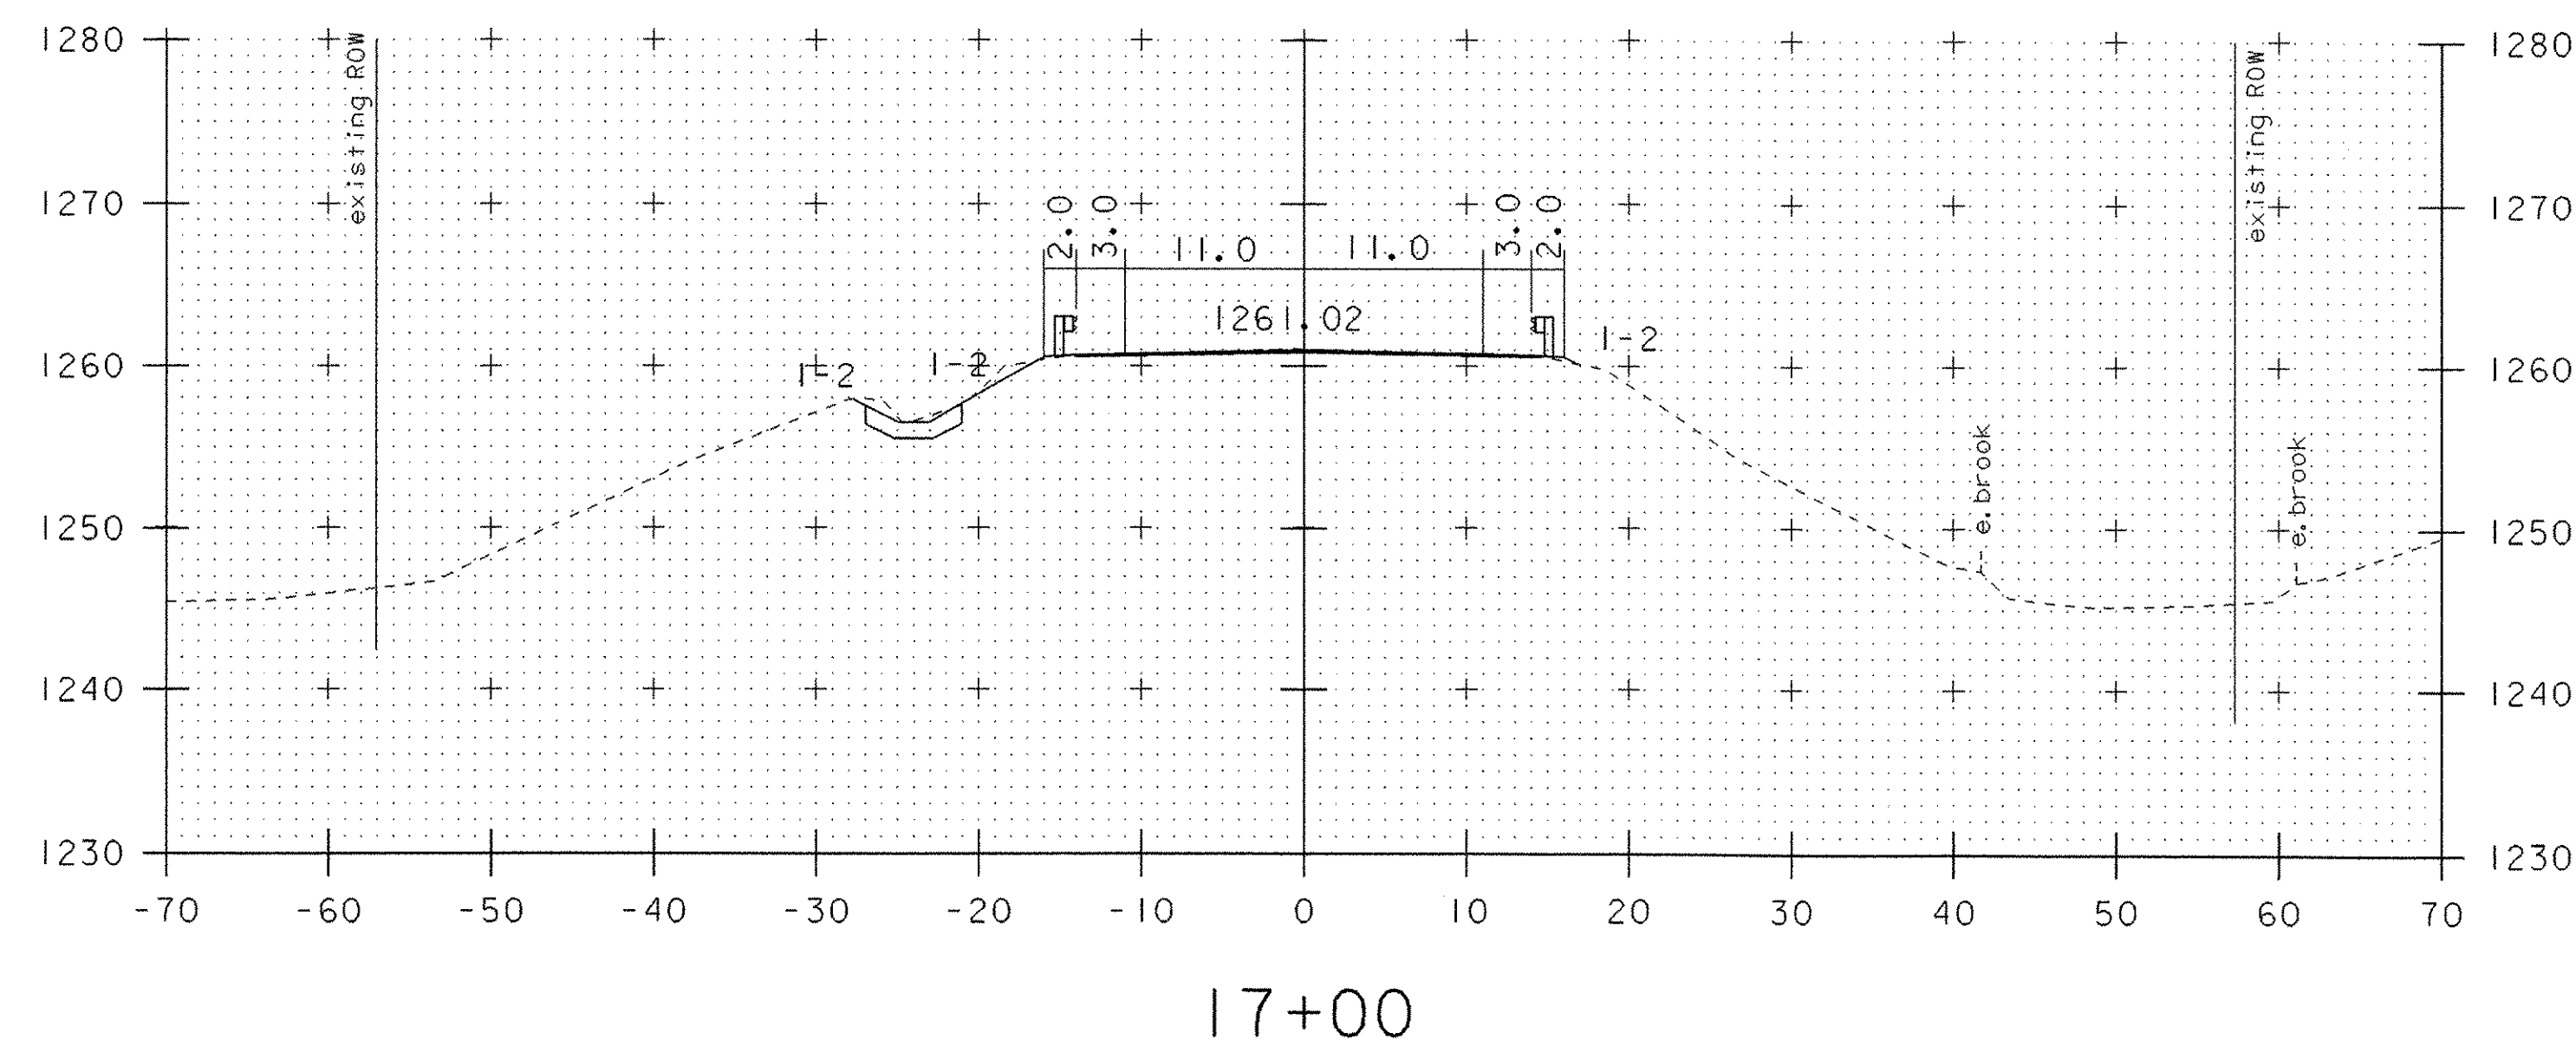

MAINLINE CROSS SECTIONS


PROJECT NAME:	JAY
PROJECT NUMBER:	ST STP CULV (2)
FILE NAME:	04b140\s04b140bdr.dgn
PROJECT LEADER:	W. SYMONDS
DESIGNED BY:	T. SUMNER
04b140xs2.1	
PLOT DATE:	23-OCT-2006
DRAWN BY:	G. SHANGRAW
CHECKED BY:	J. LACROIX
SHEET	34 OF 39

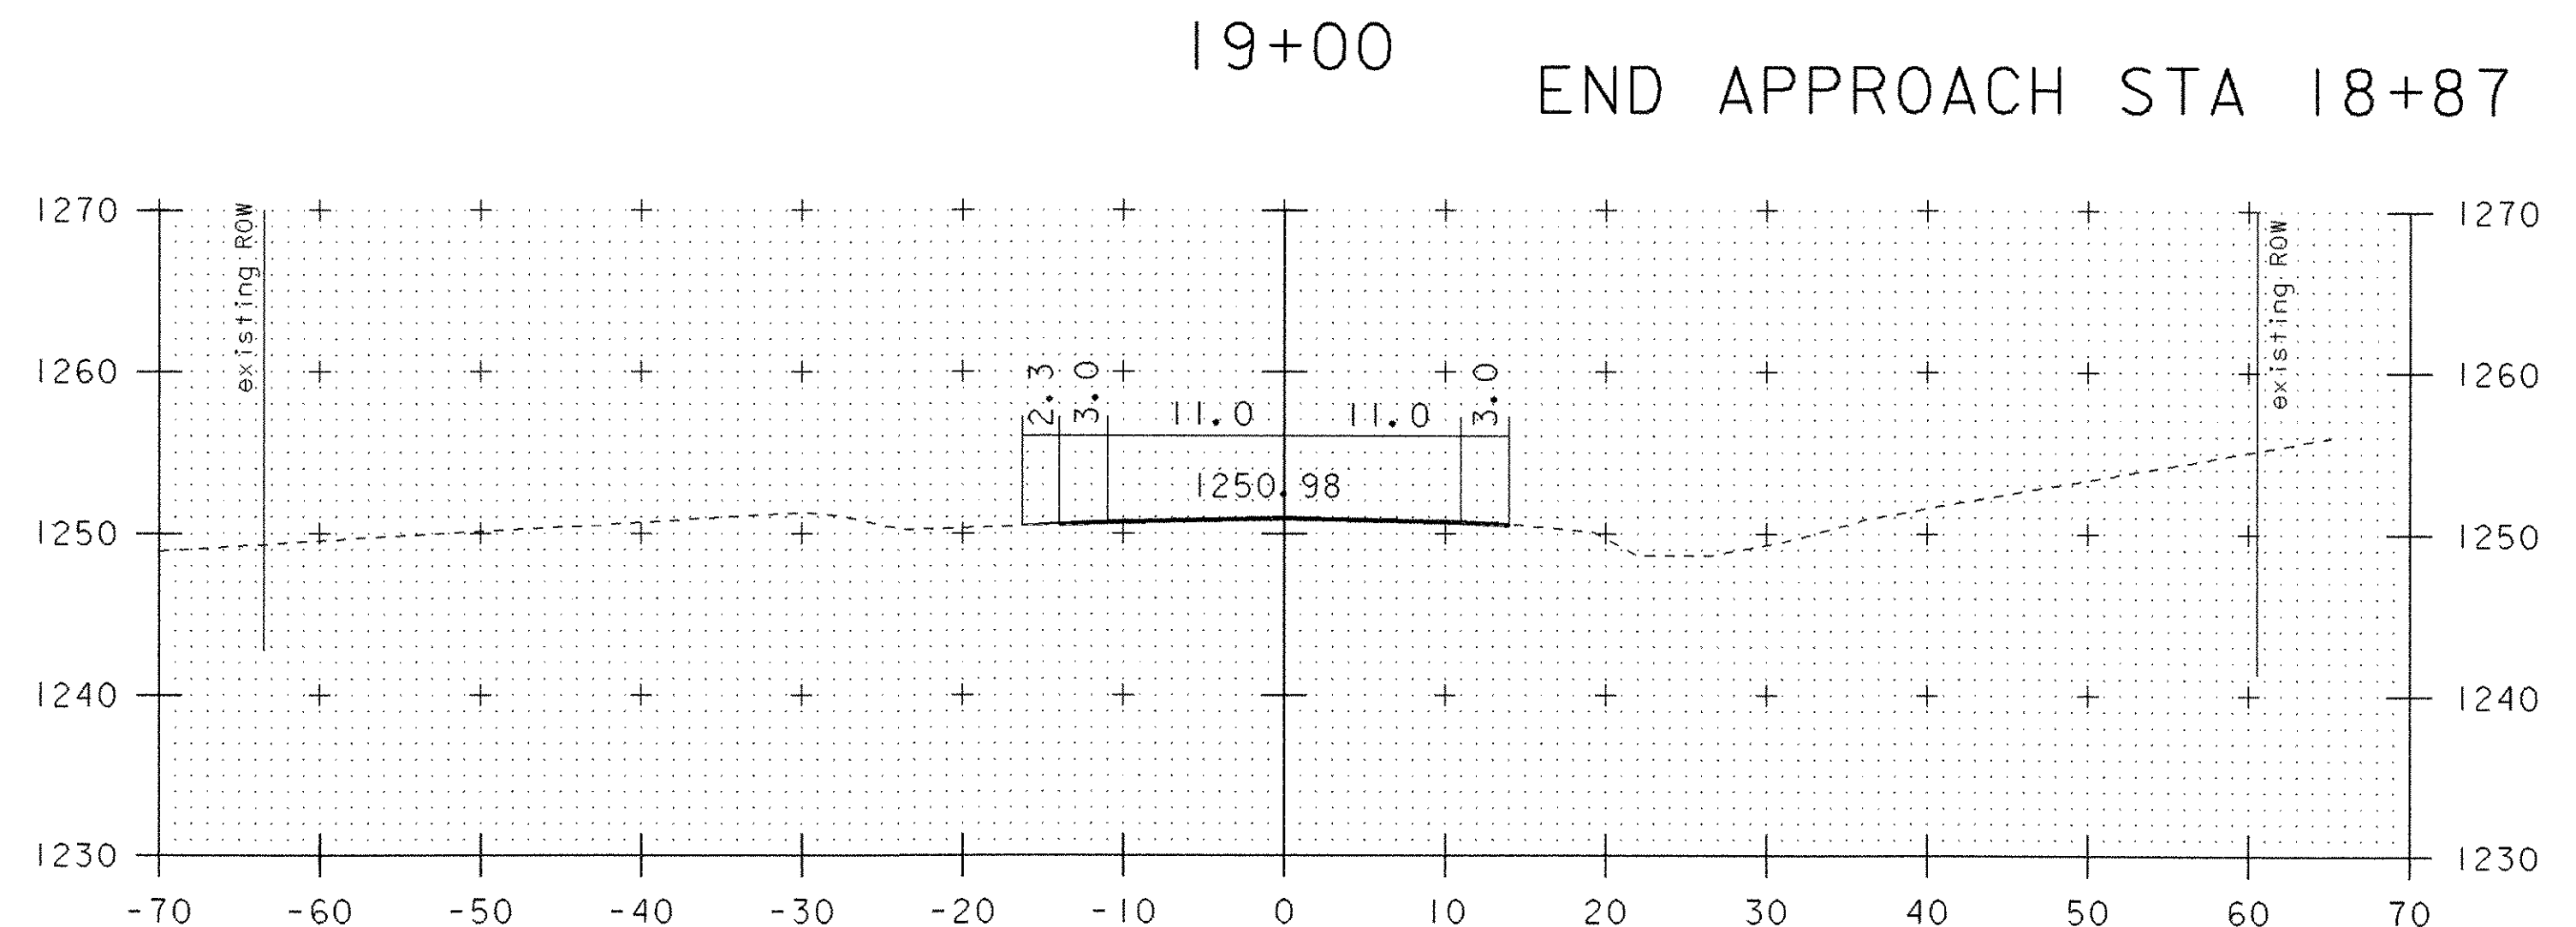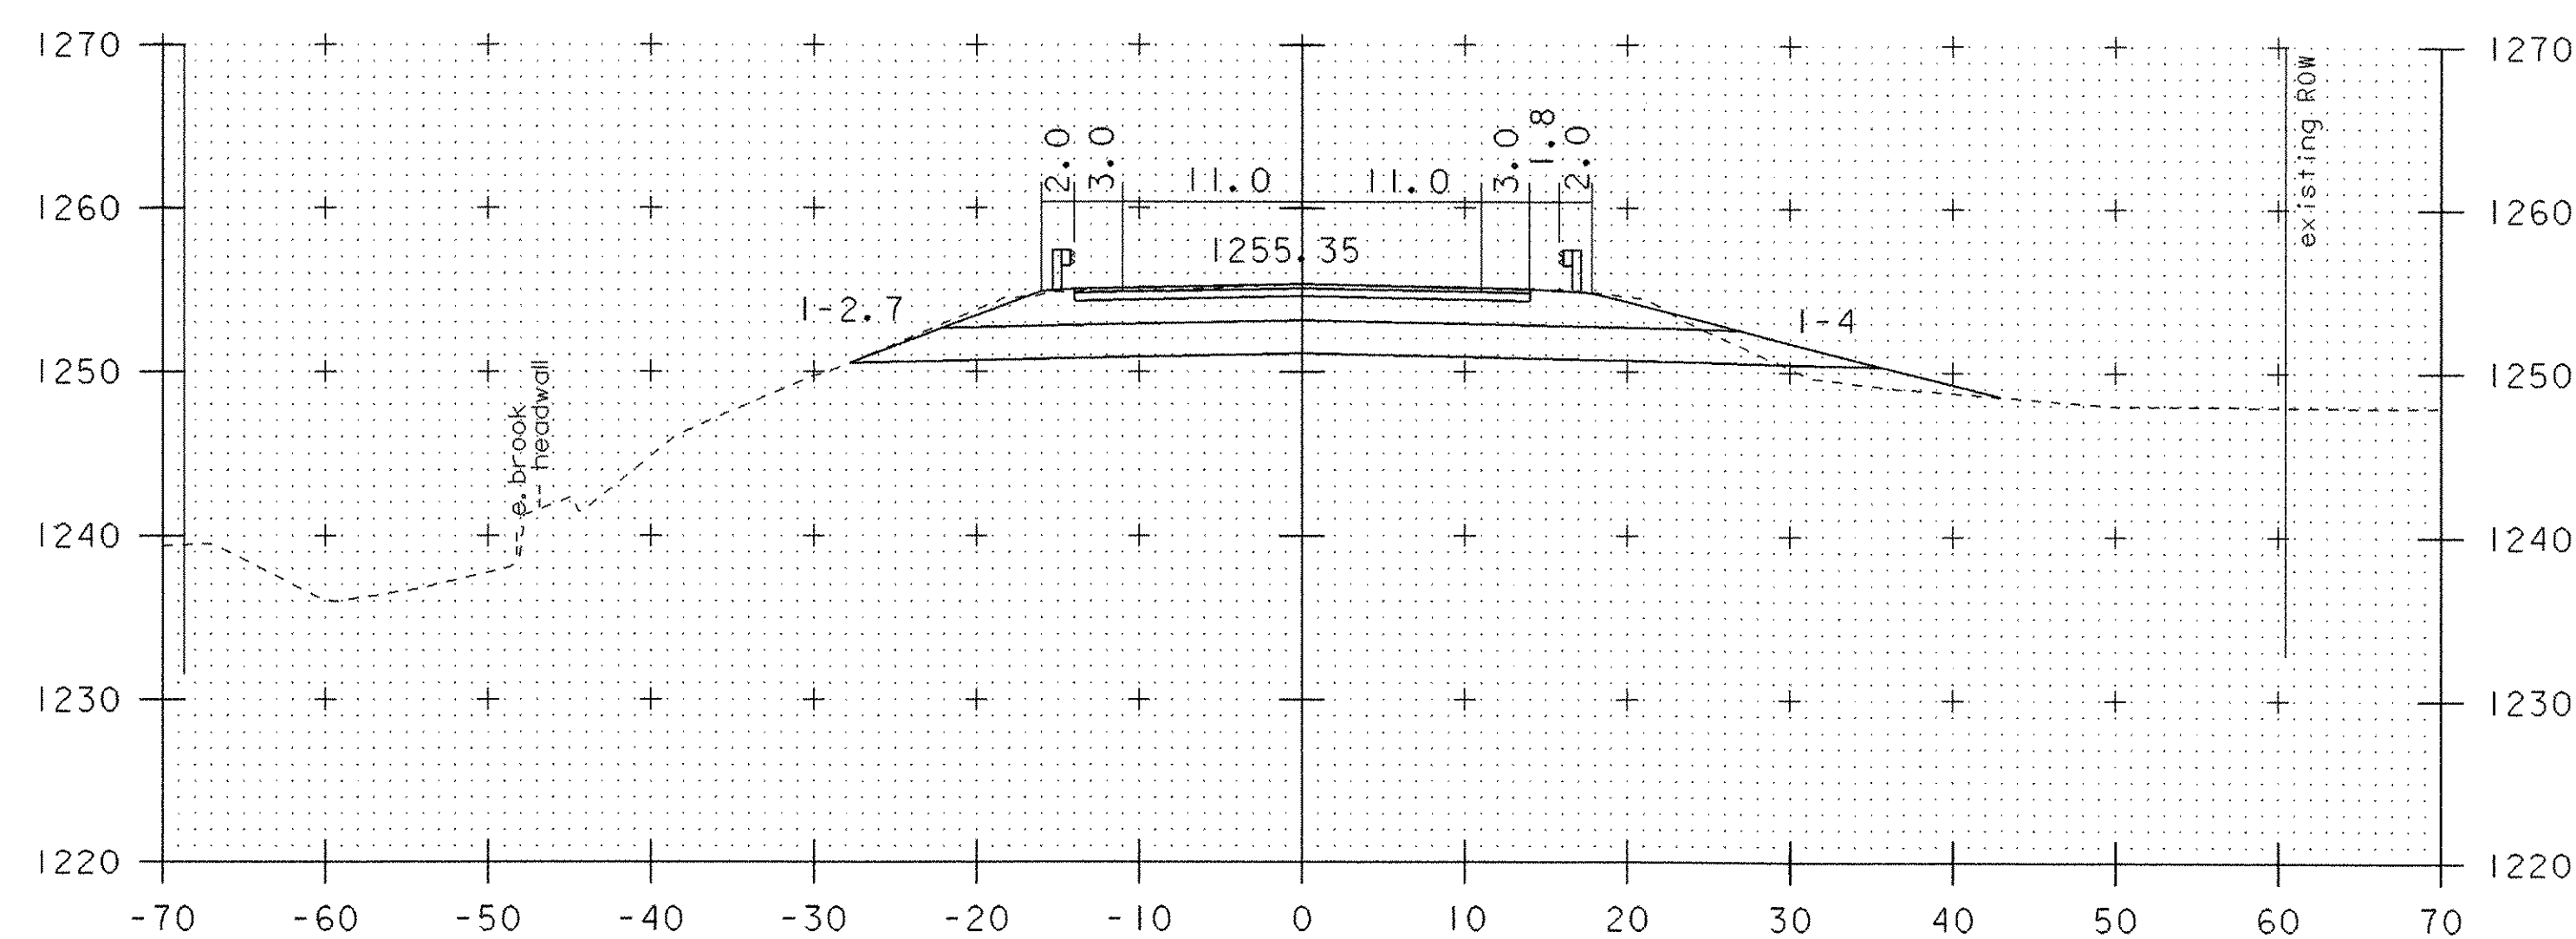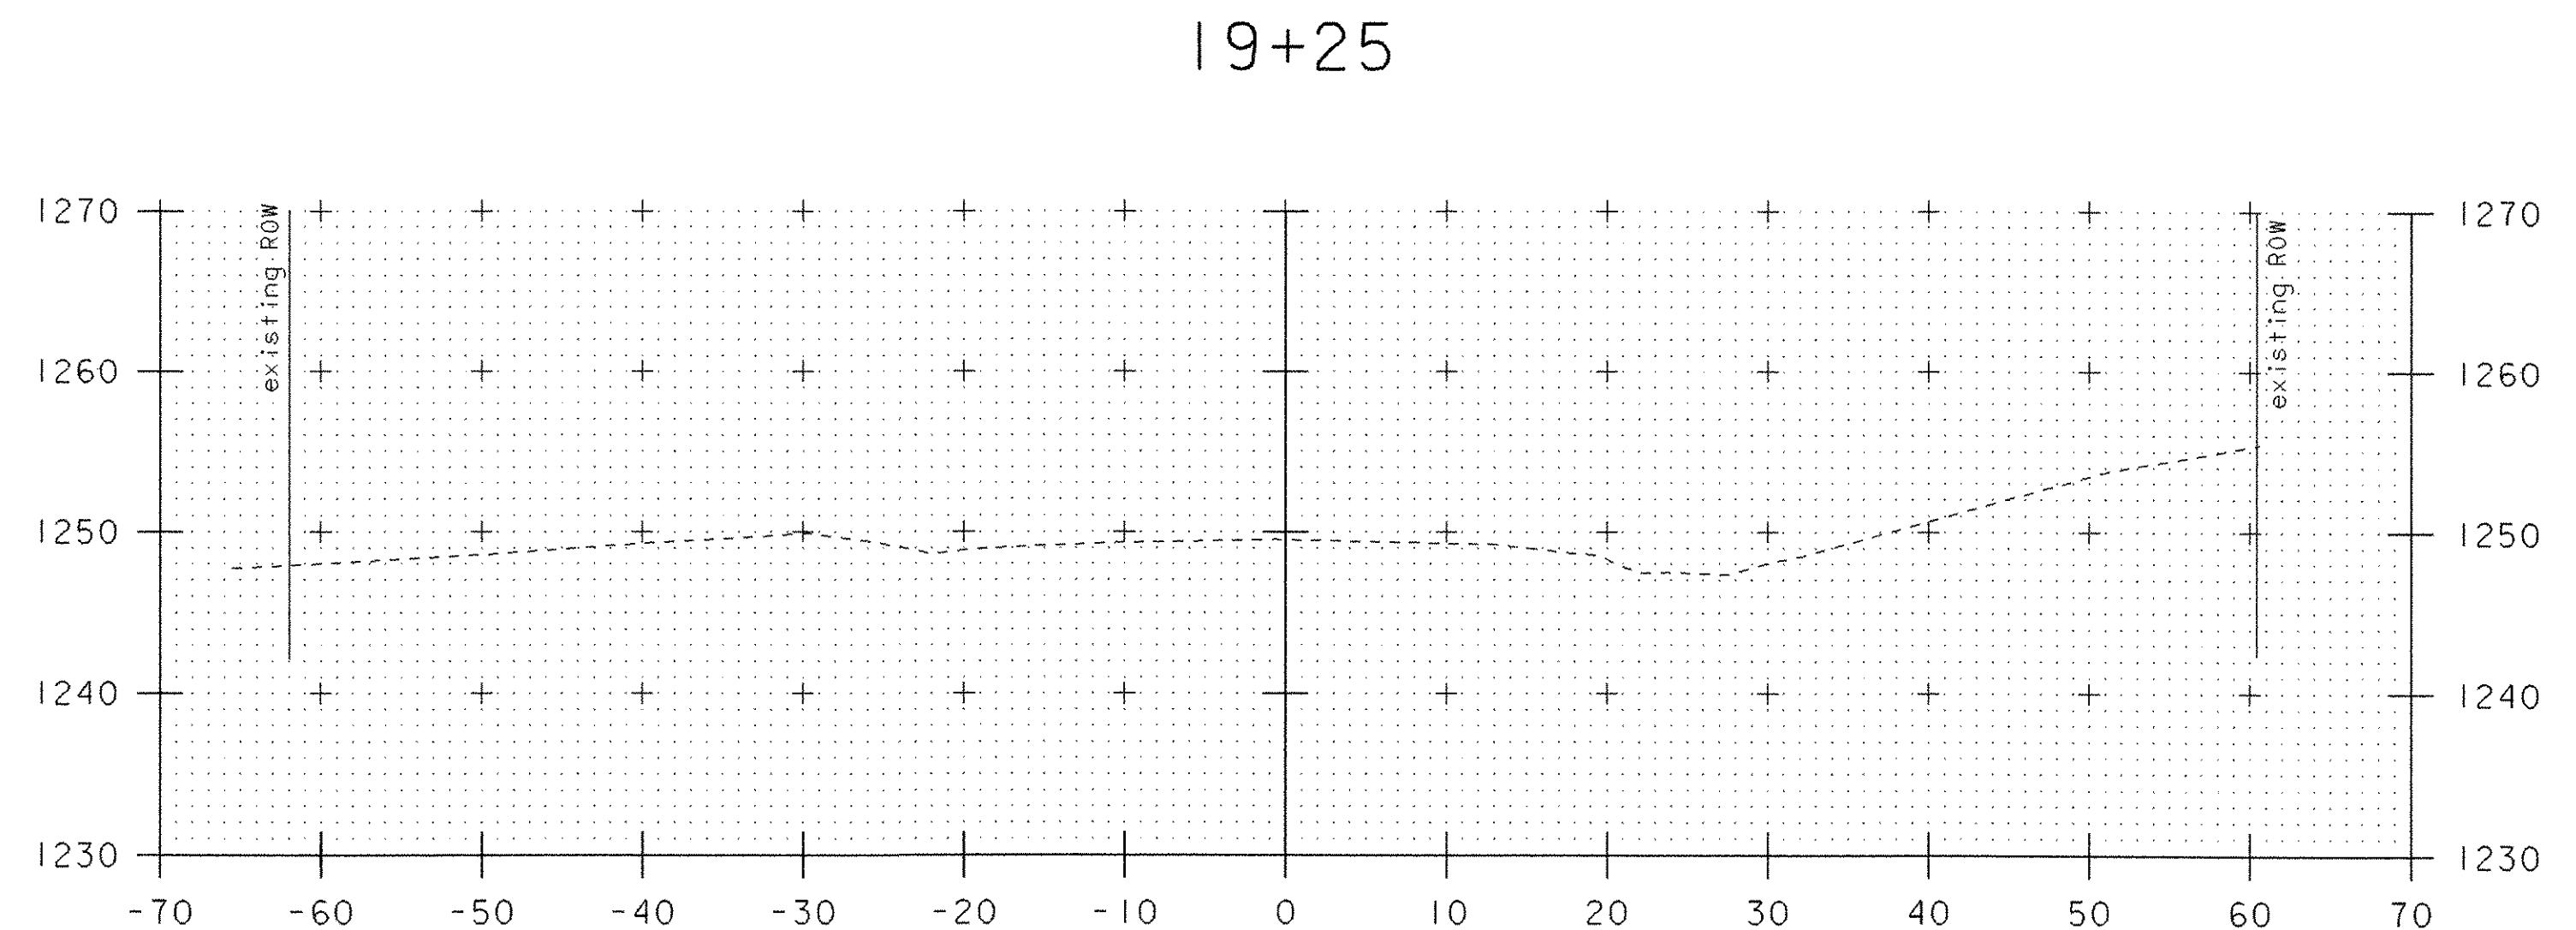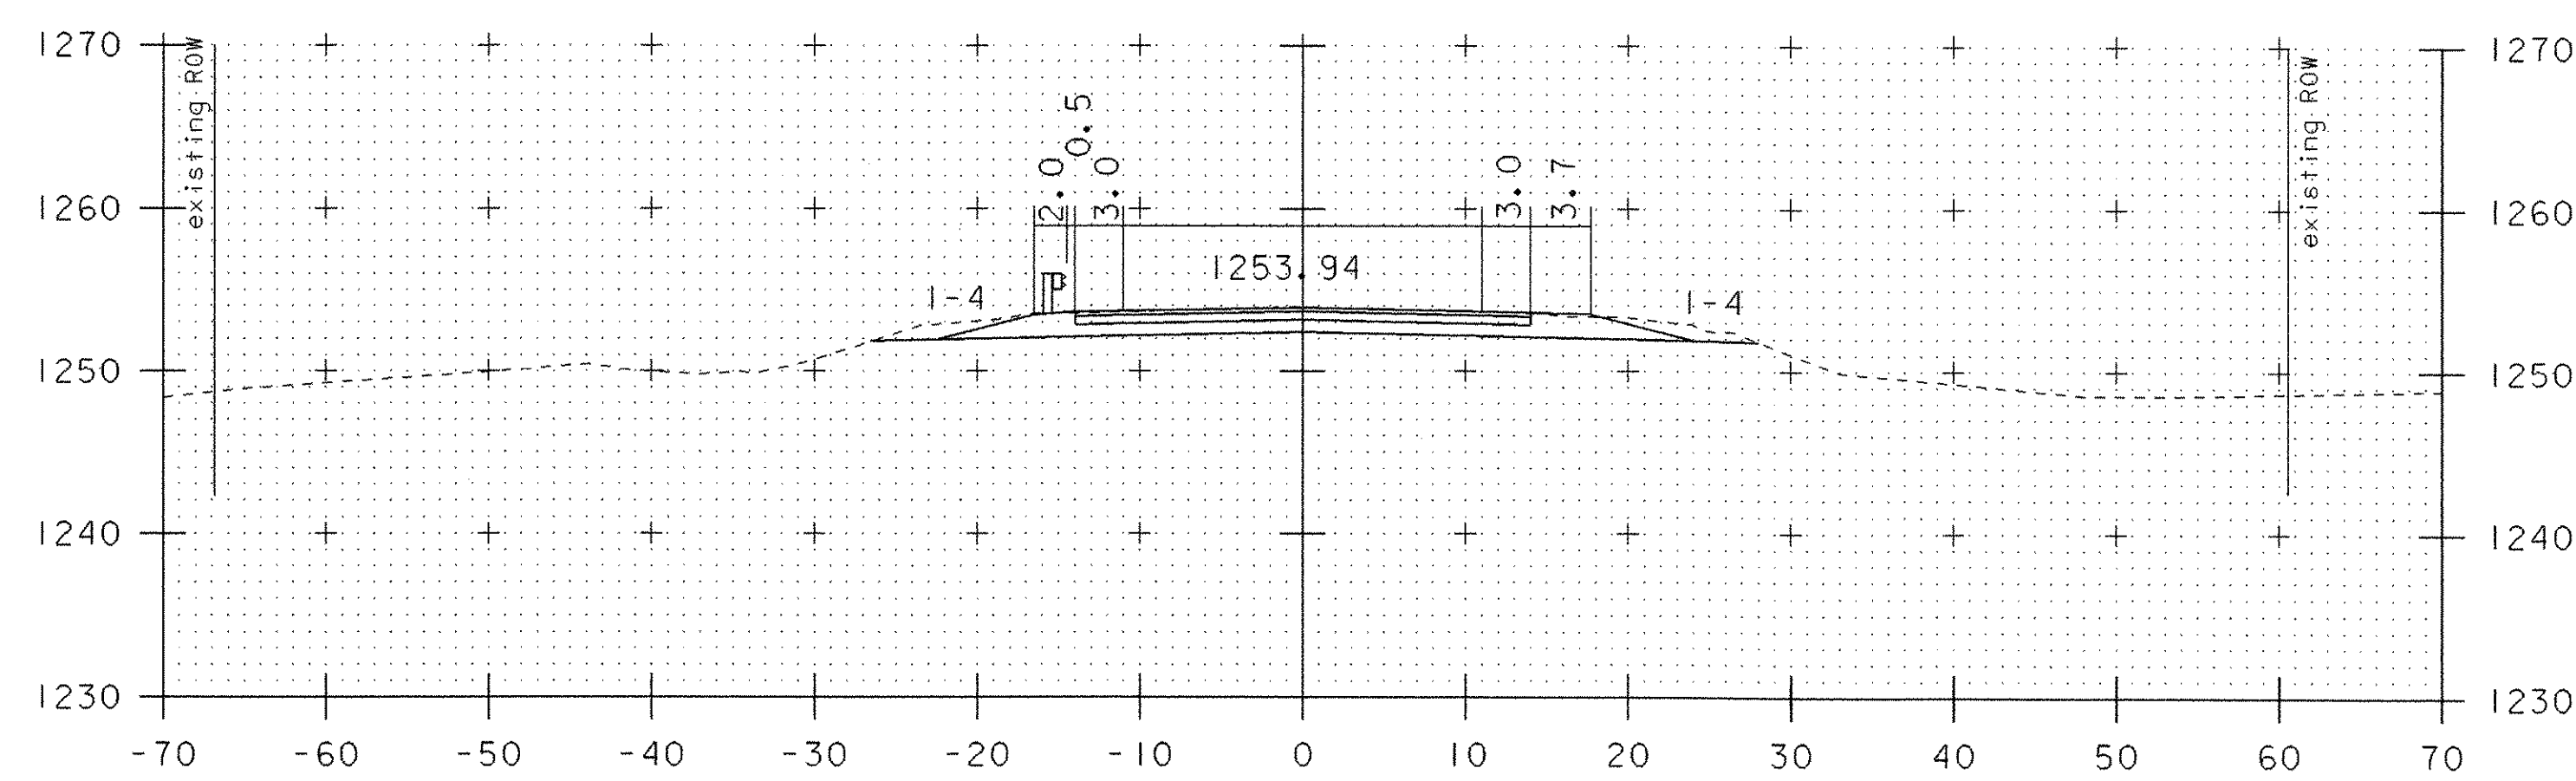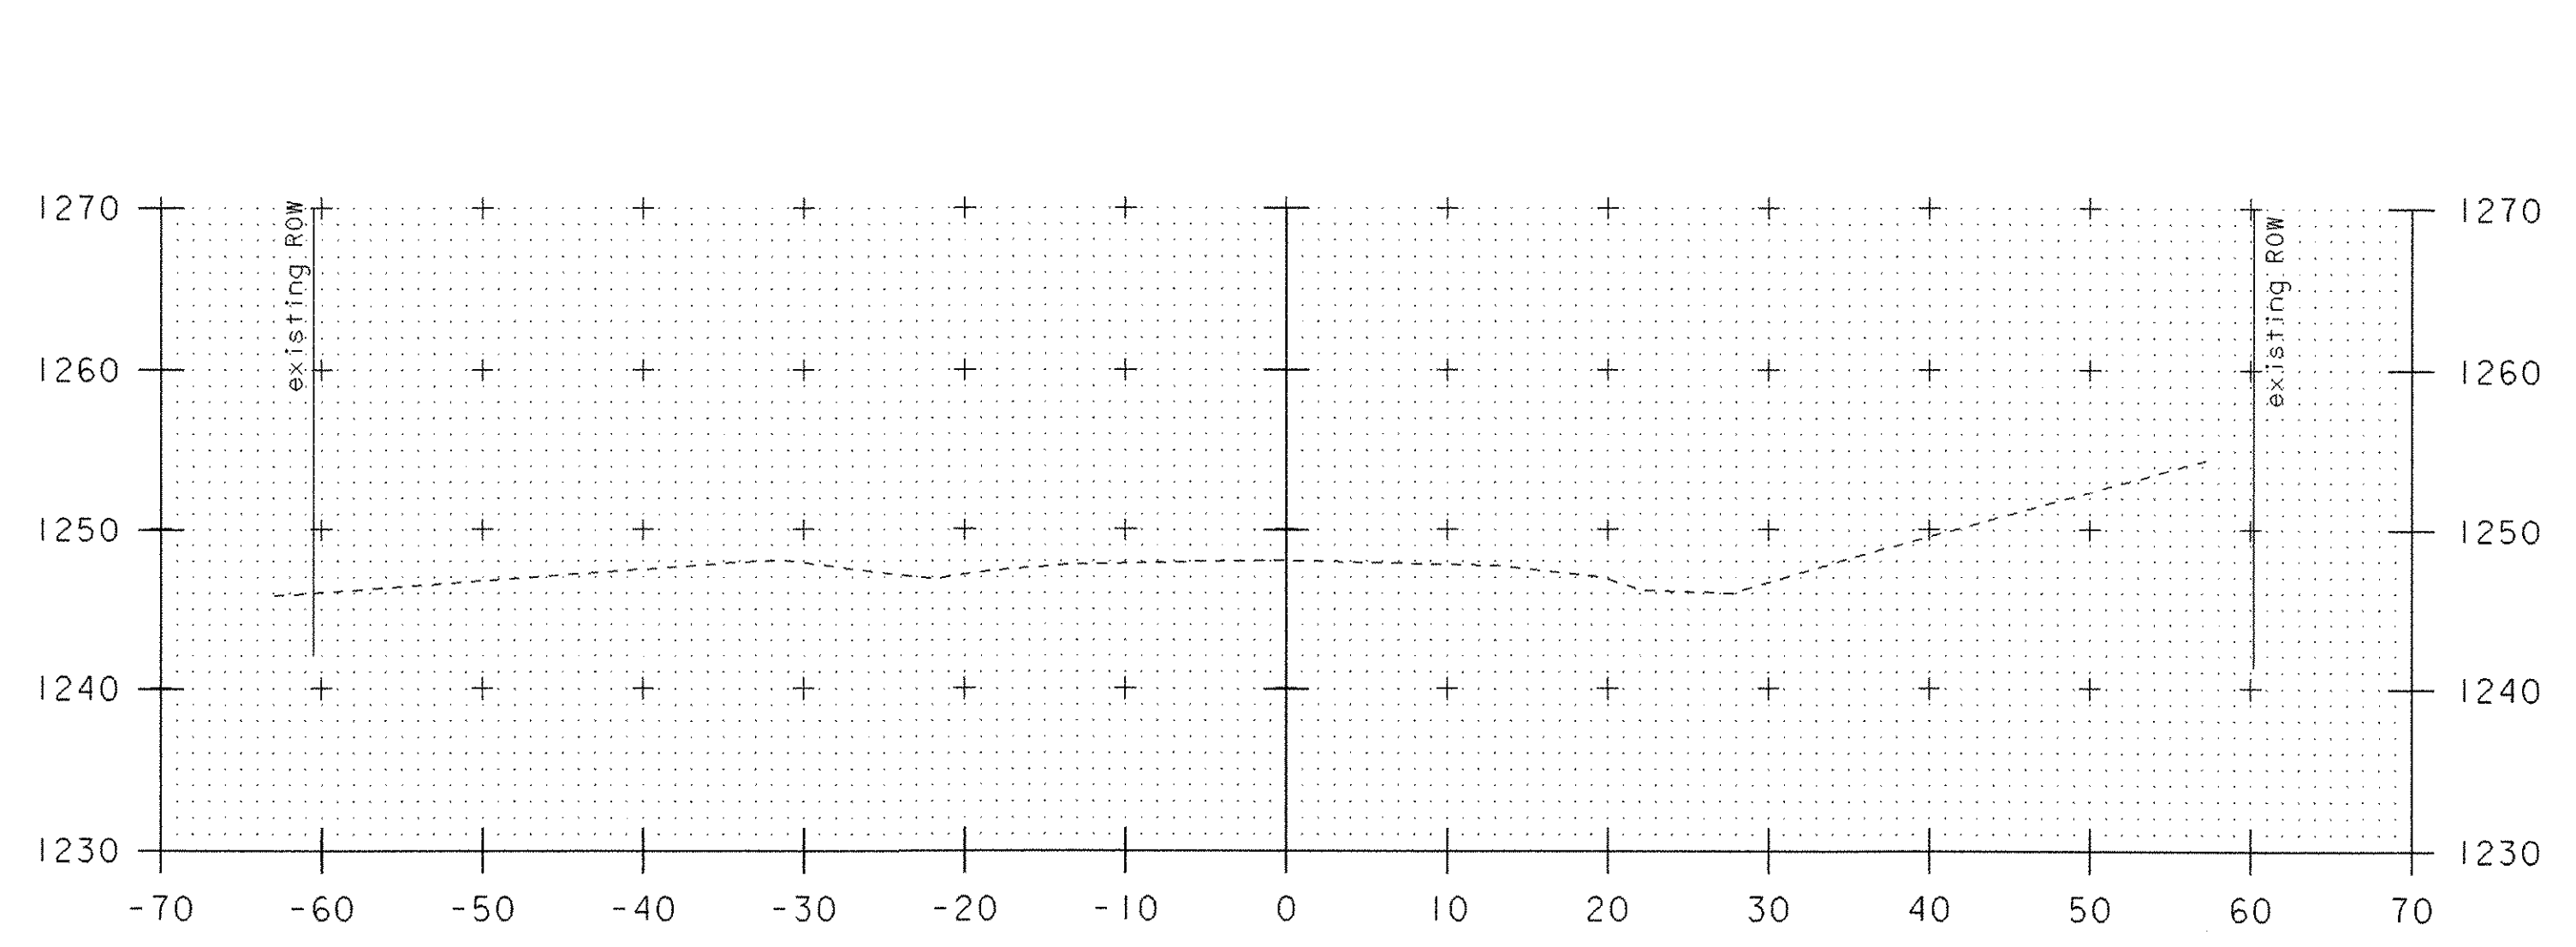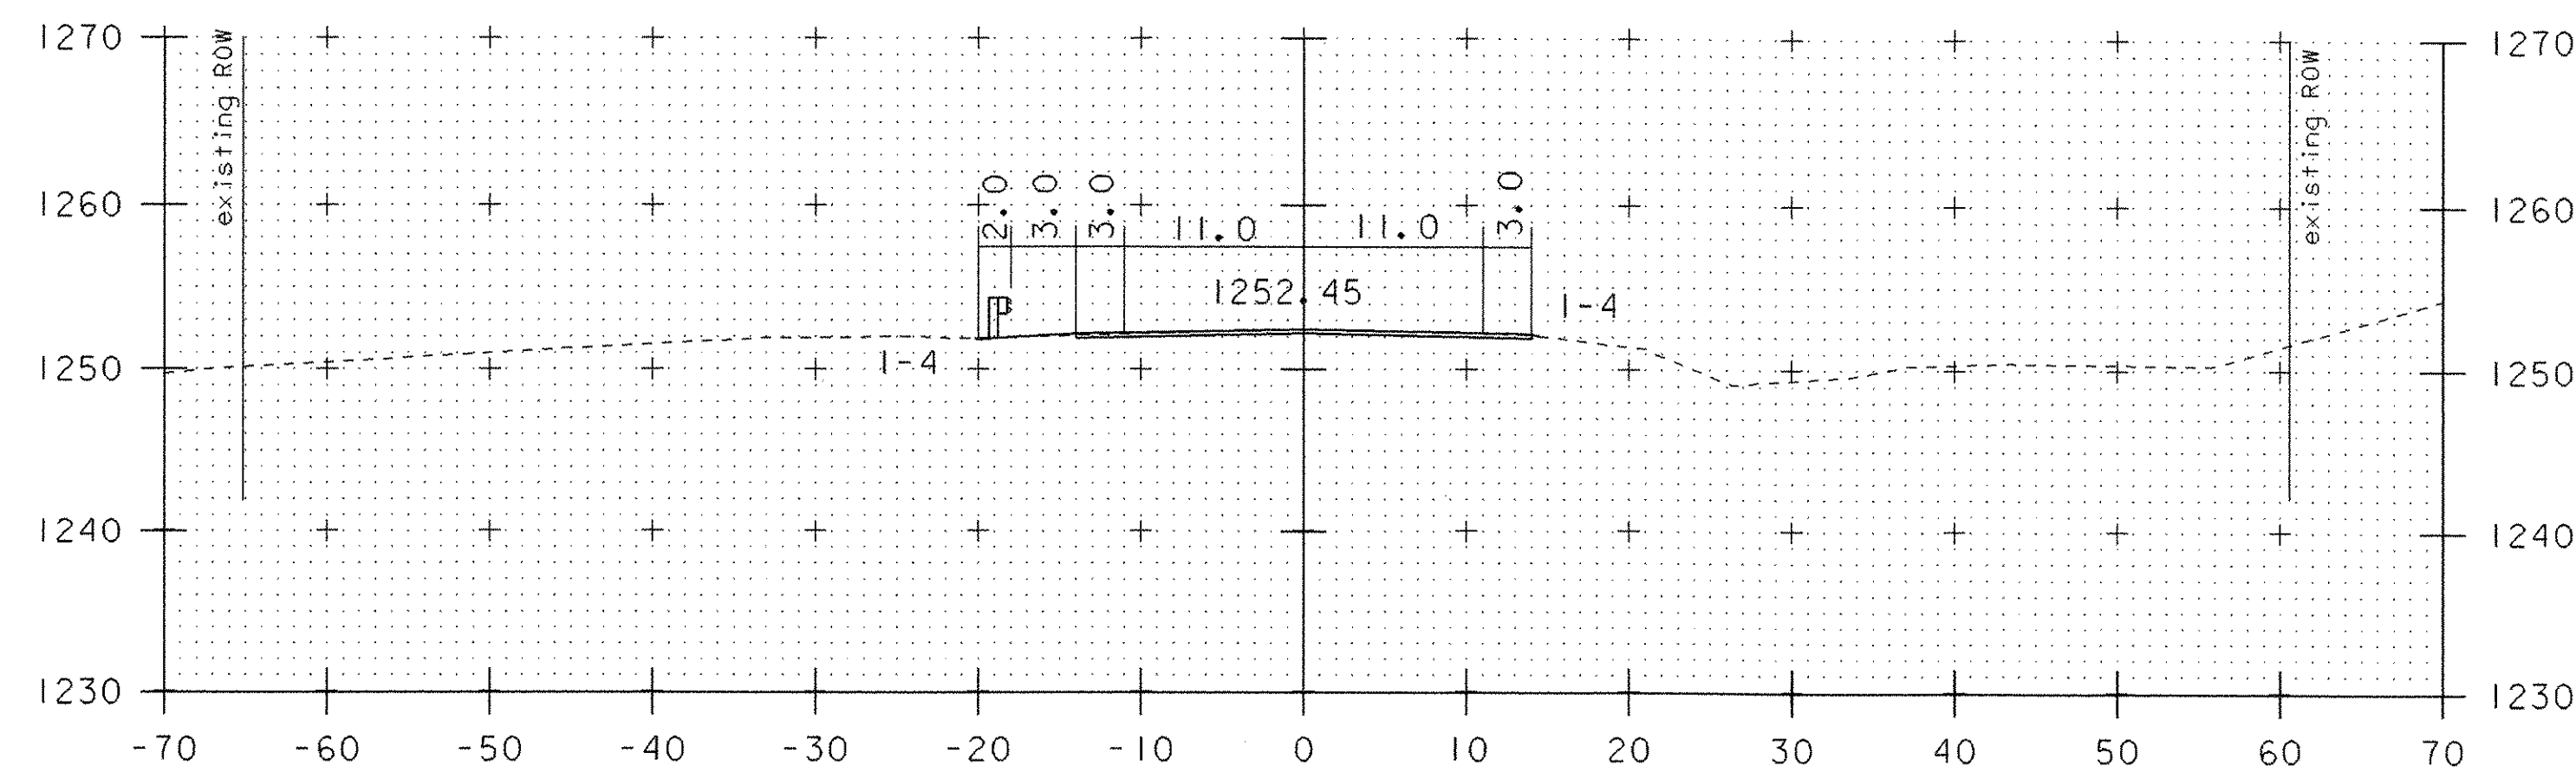


END APPROACH STA 18+87

MAINLINE CROSS SECTIONS


PROJECT NAME:	JAY	PLOT DATE:	23-OCT-2006
PROJECT NUMBER:	ST STP CULV (2)	DRAWN BY:	G. SHANGRAW
FILE NAME:	04b140\s04b140bdr.dgn	CHECKED BY:	J. LACROIX
PROJECT LEADER:	W. SYMONDS	SHEET	35 OF 39
DESIGNED BY:	T. SUMNER		
04b140xs3.i			

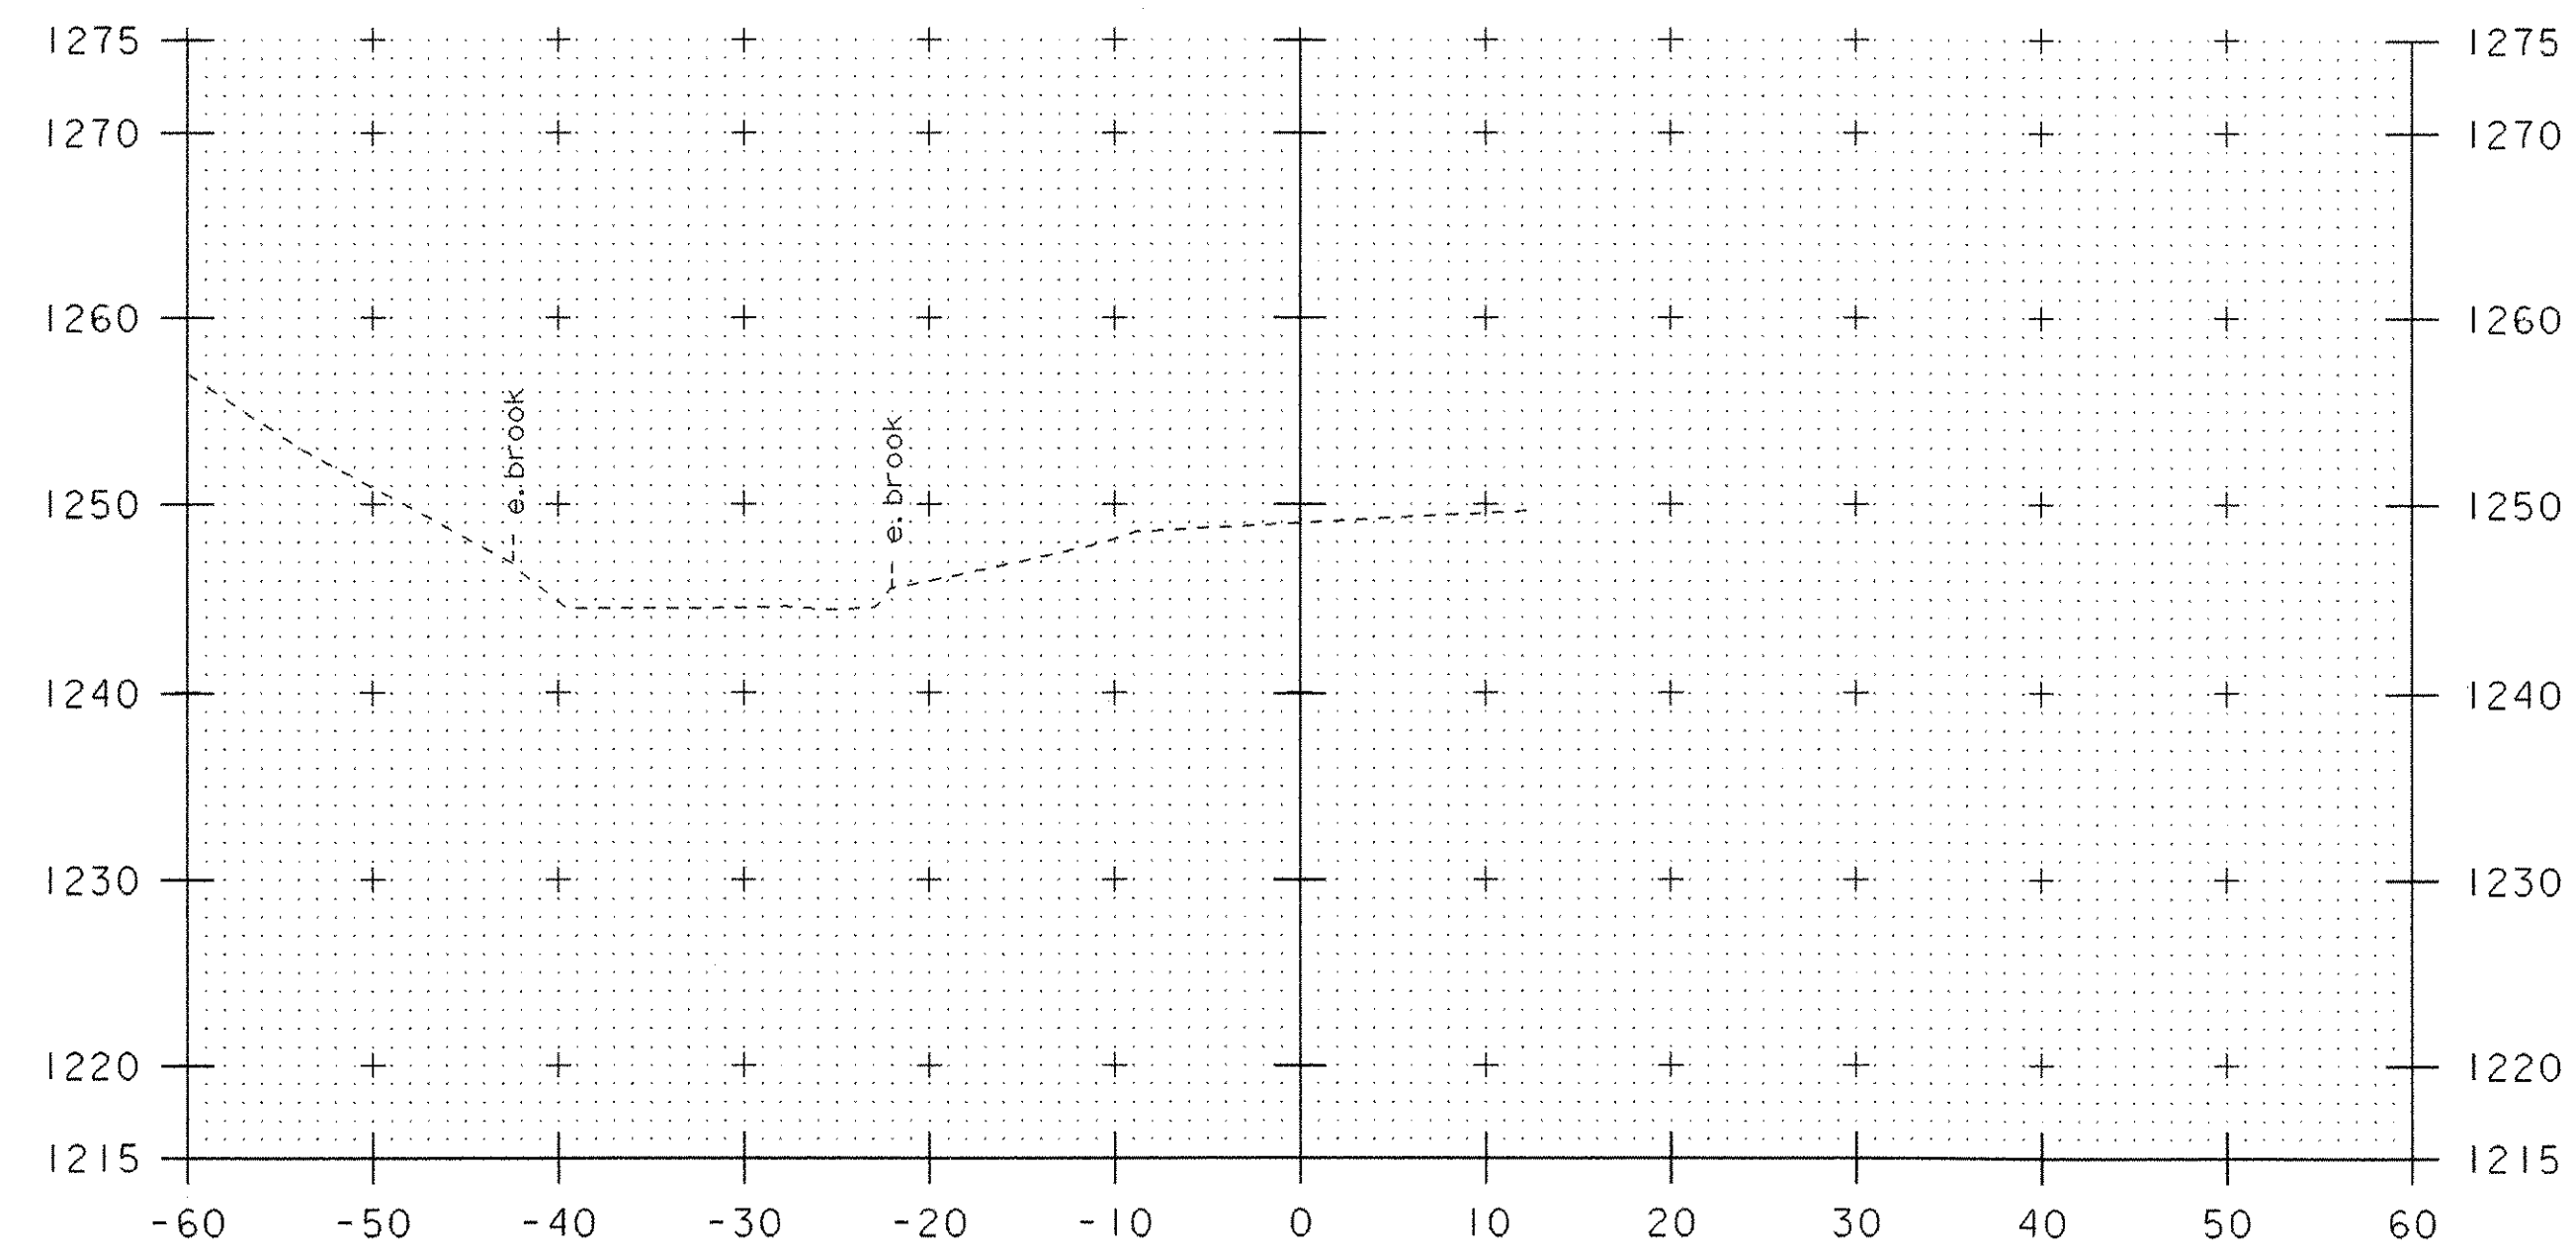


52+20

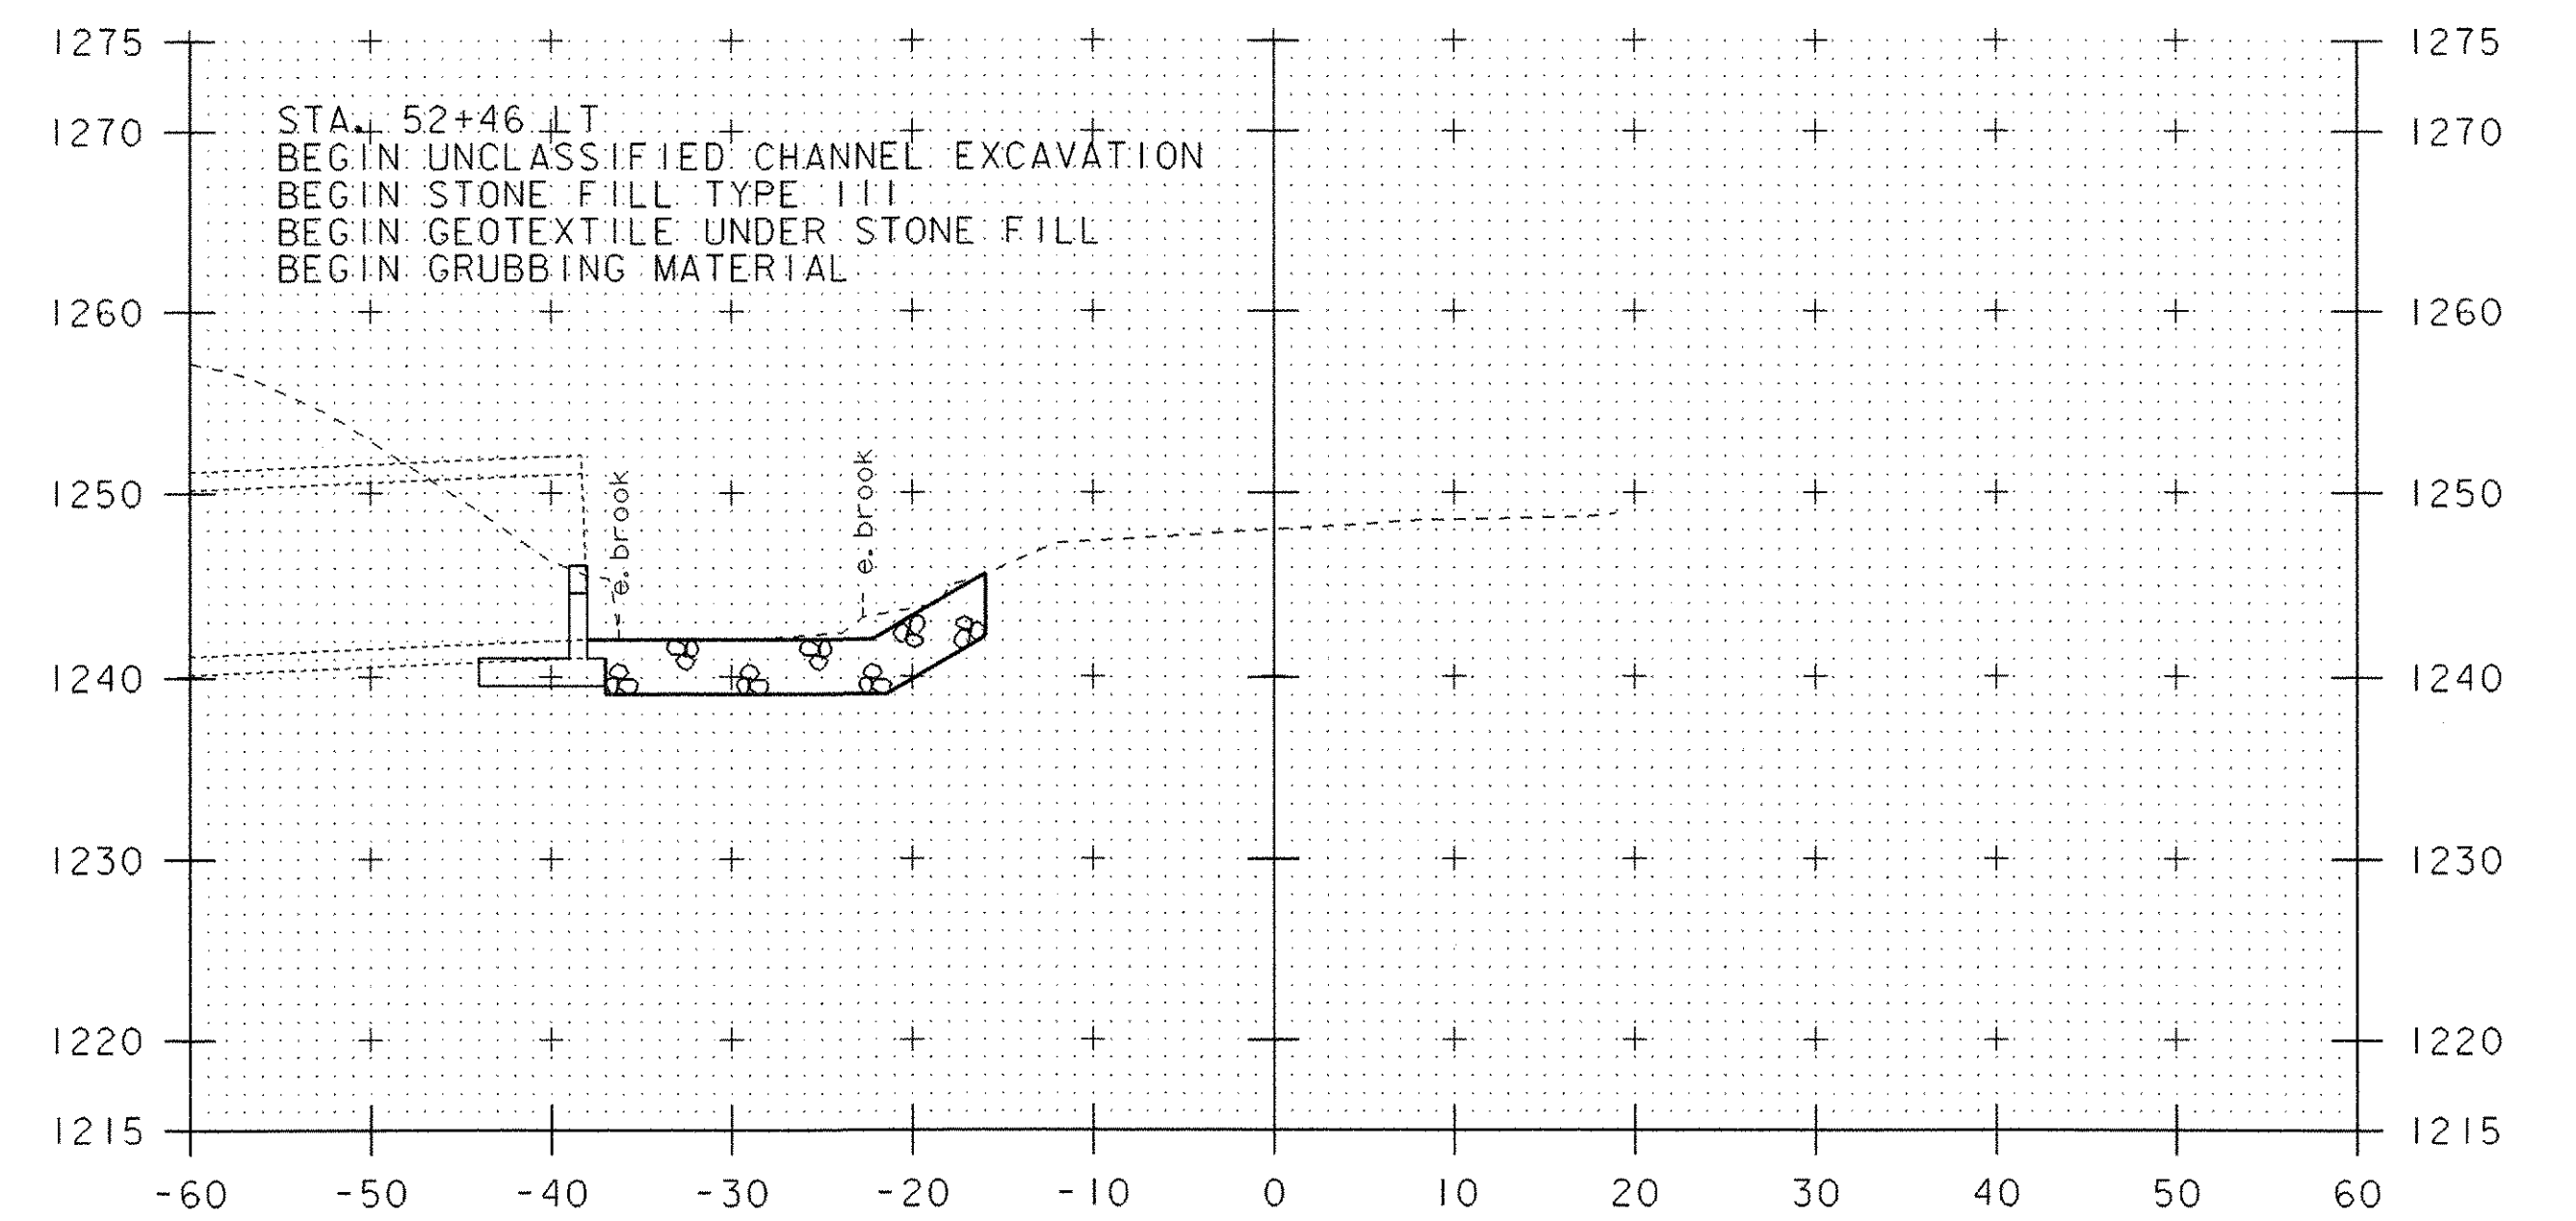

52+60

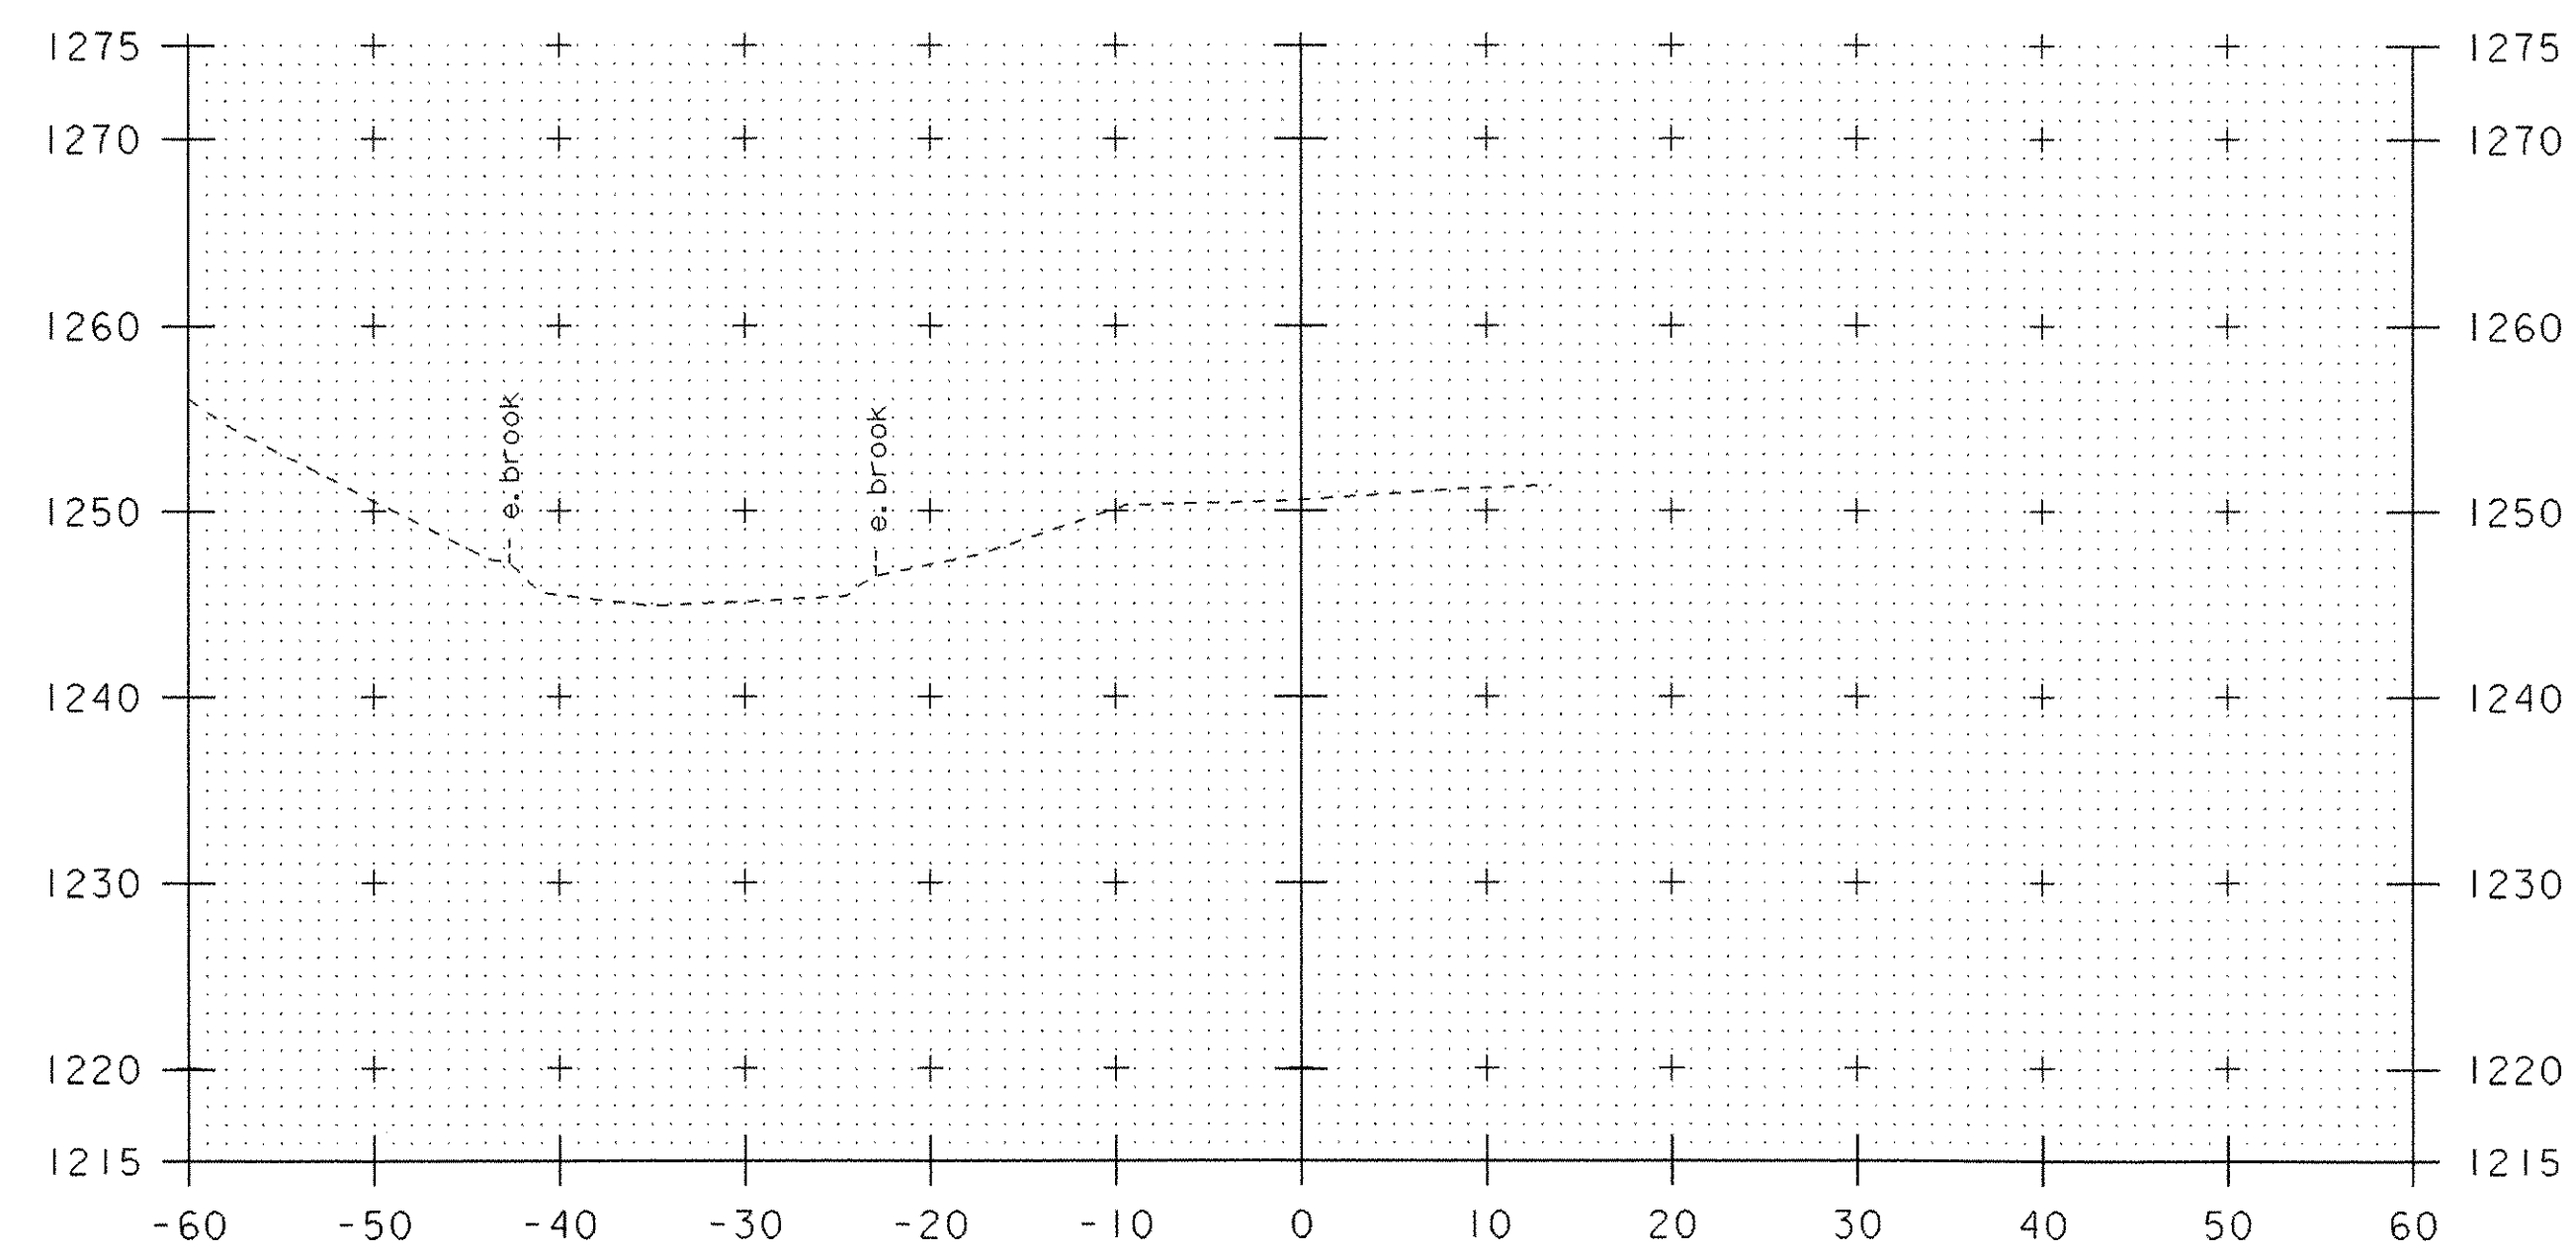


52+00

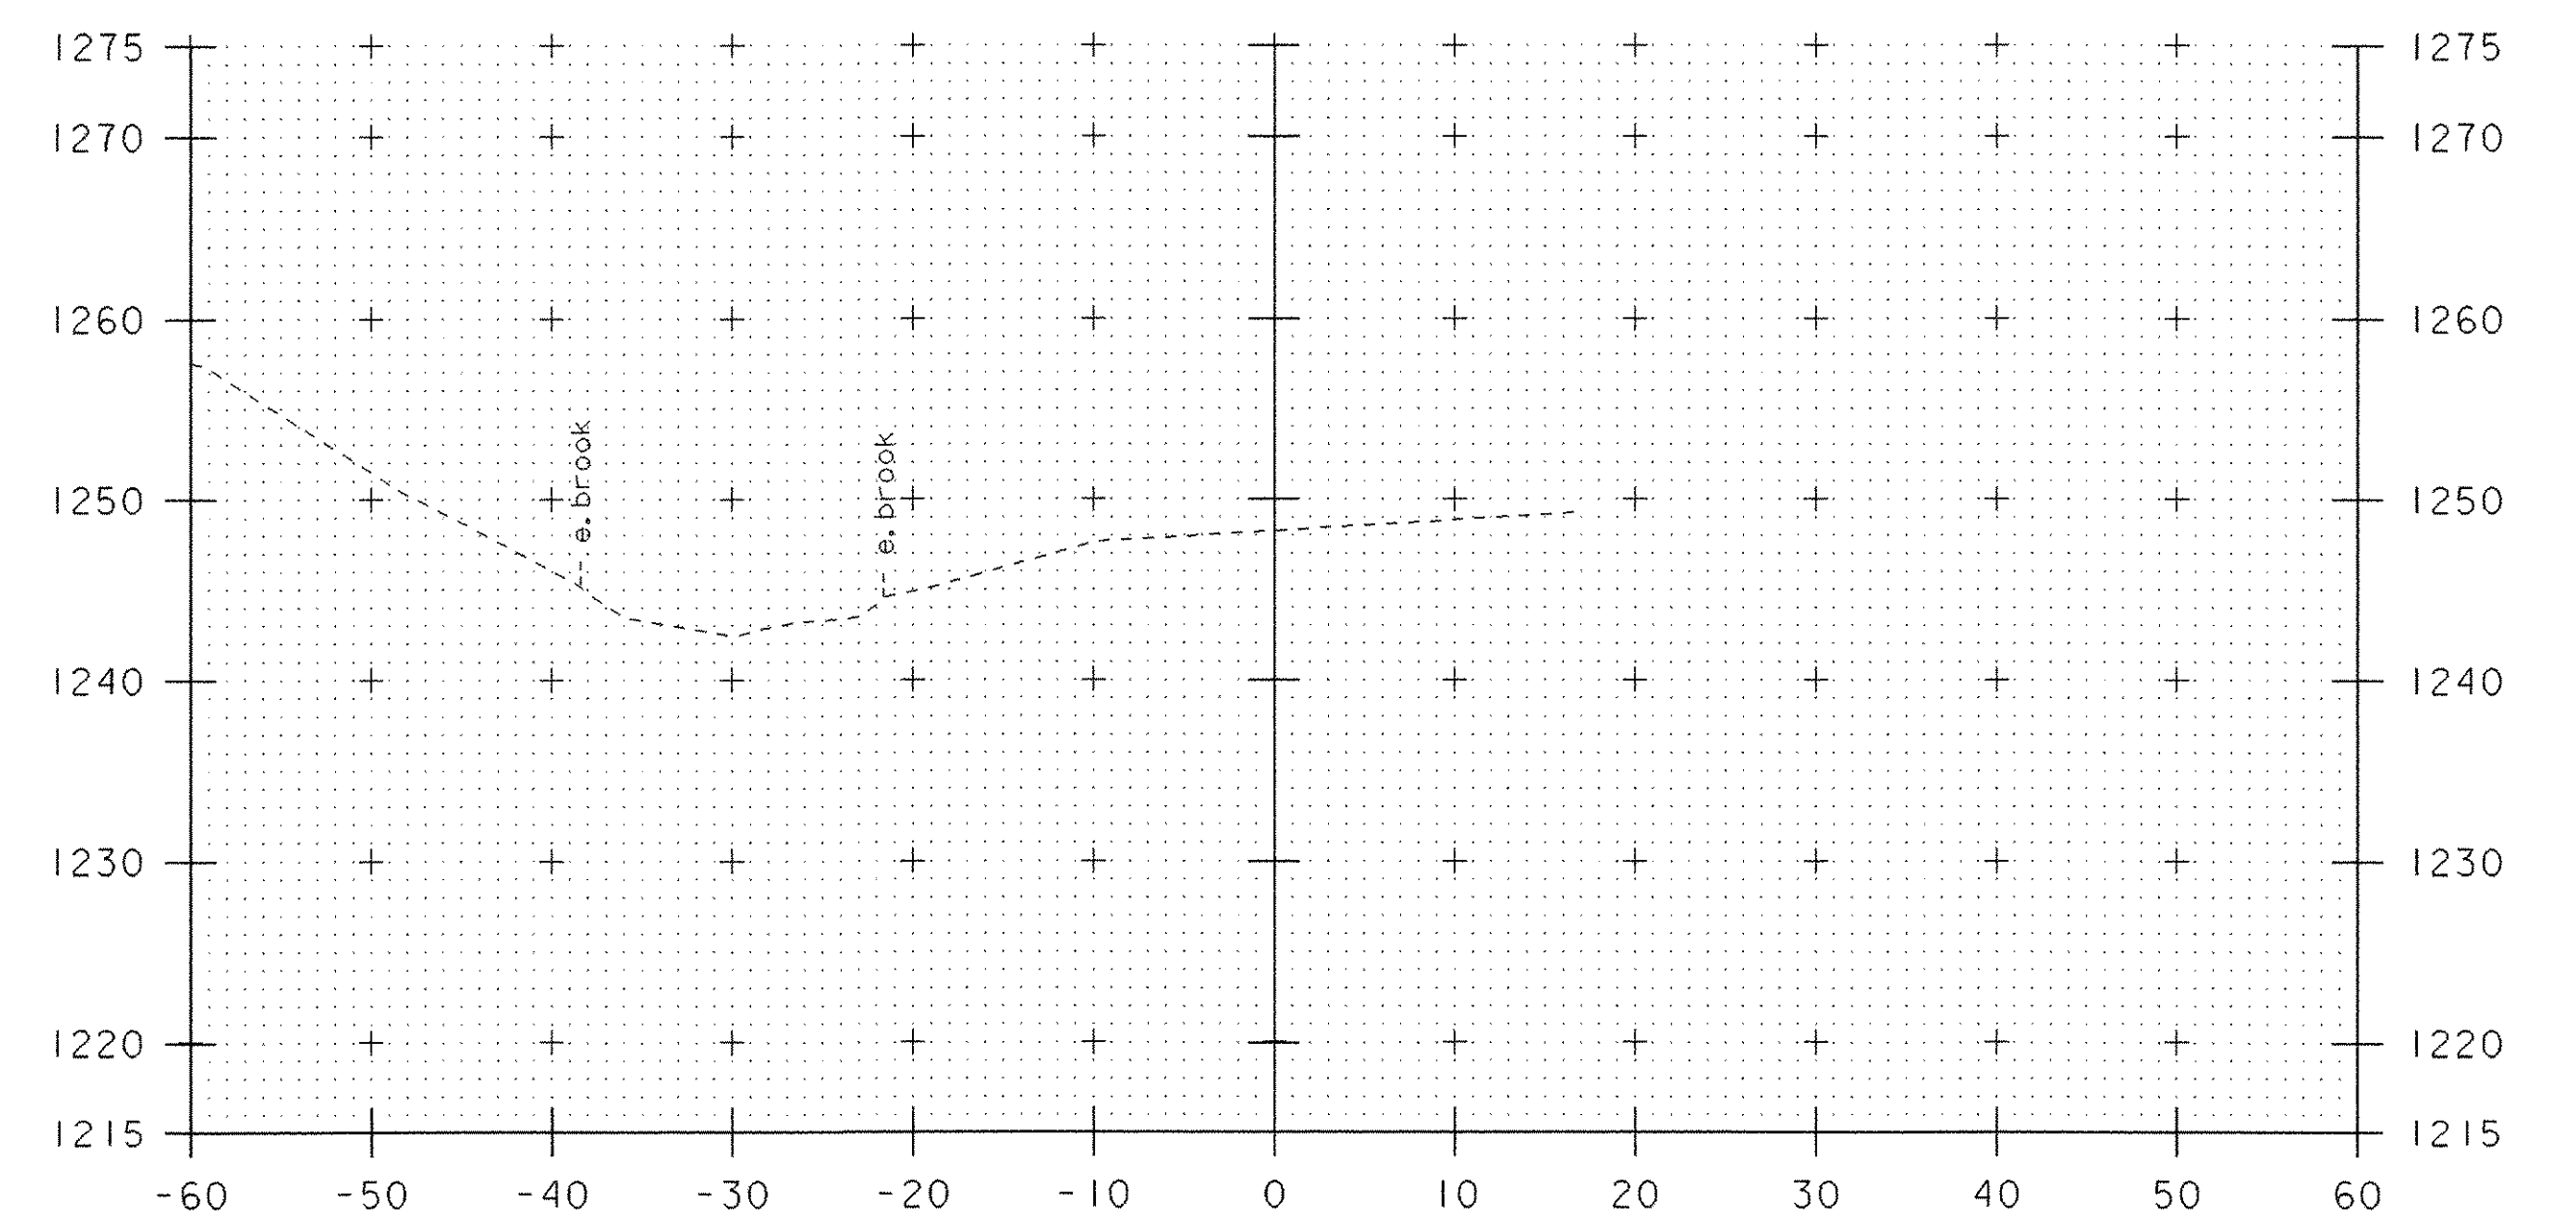


52+40

CHANNEL CROSS SECTIONS


PROJECT NAME:	JAY
PROJECT NUMBER:	ST STP CULV (2)
FILE NAME:	04bl40\s04bl40bdr.dgn
PROJECT LEADER:	W. SYMONDS
DESIGNED BY:	T. SUMNER
04bl40chxsl.i	
PLOT DATE:	23-OCT-2006
DRAWN BY:	G. SHANGRAW
CHECKED BY:	J. LACROIX
SHEET	36 OF 39

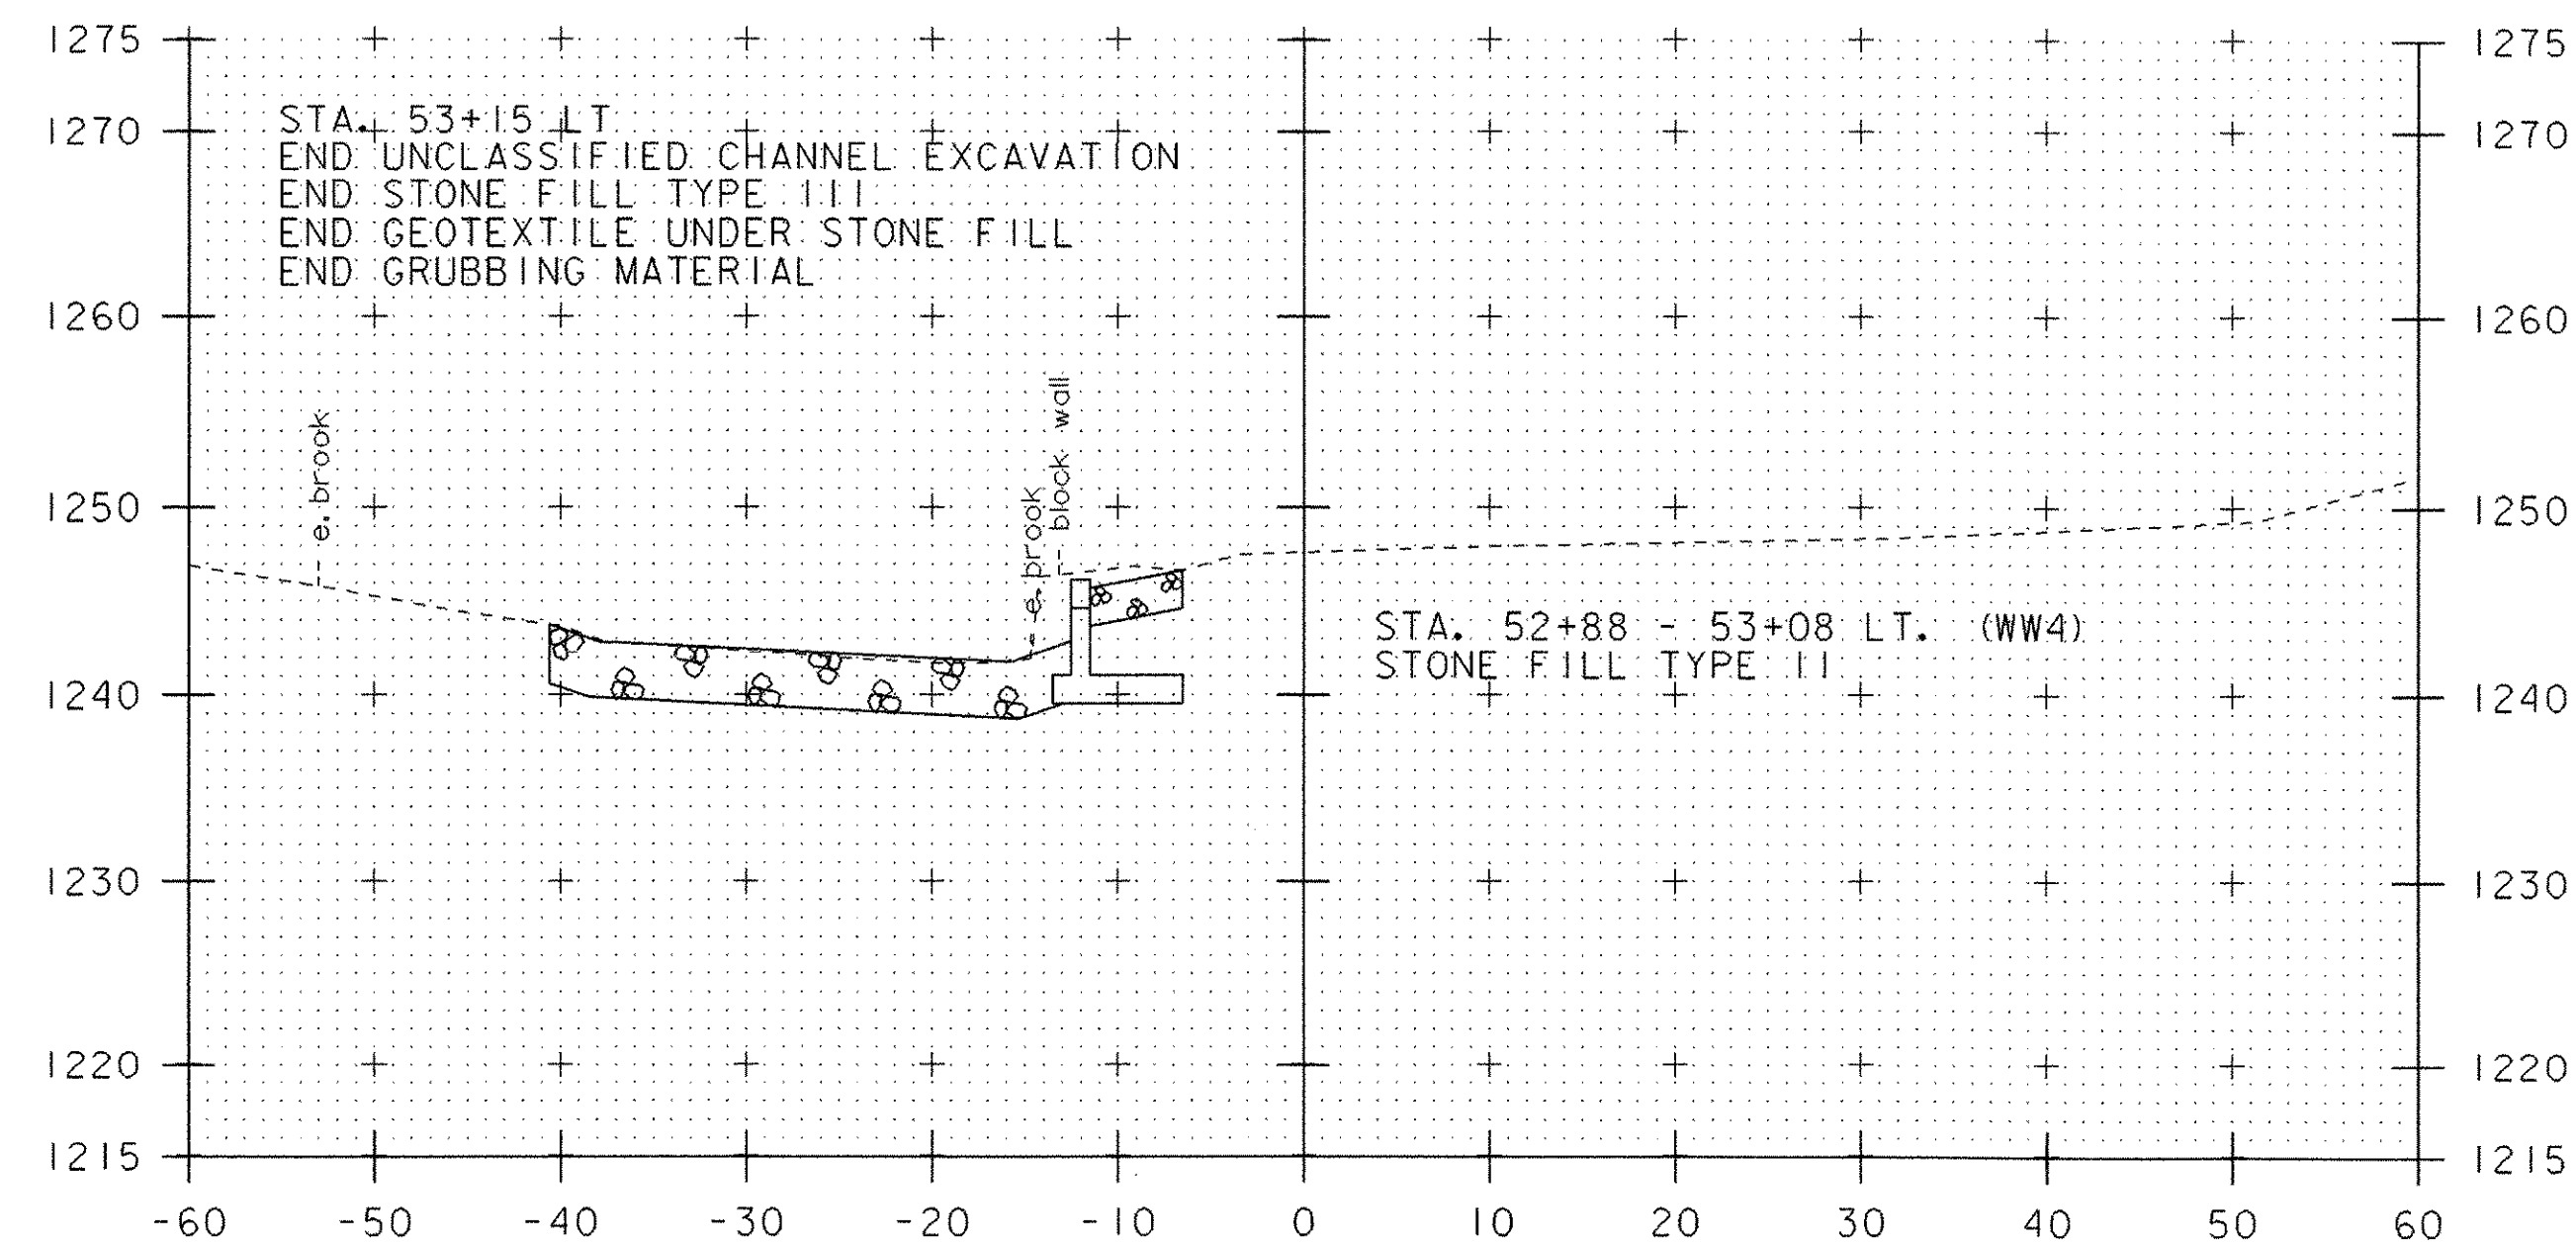


53+00

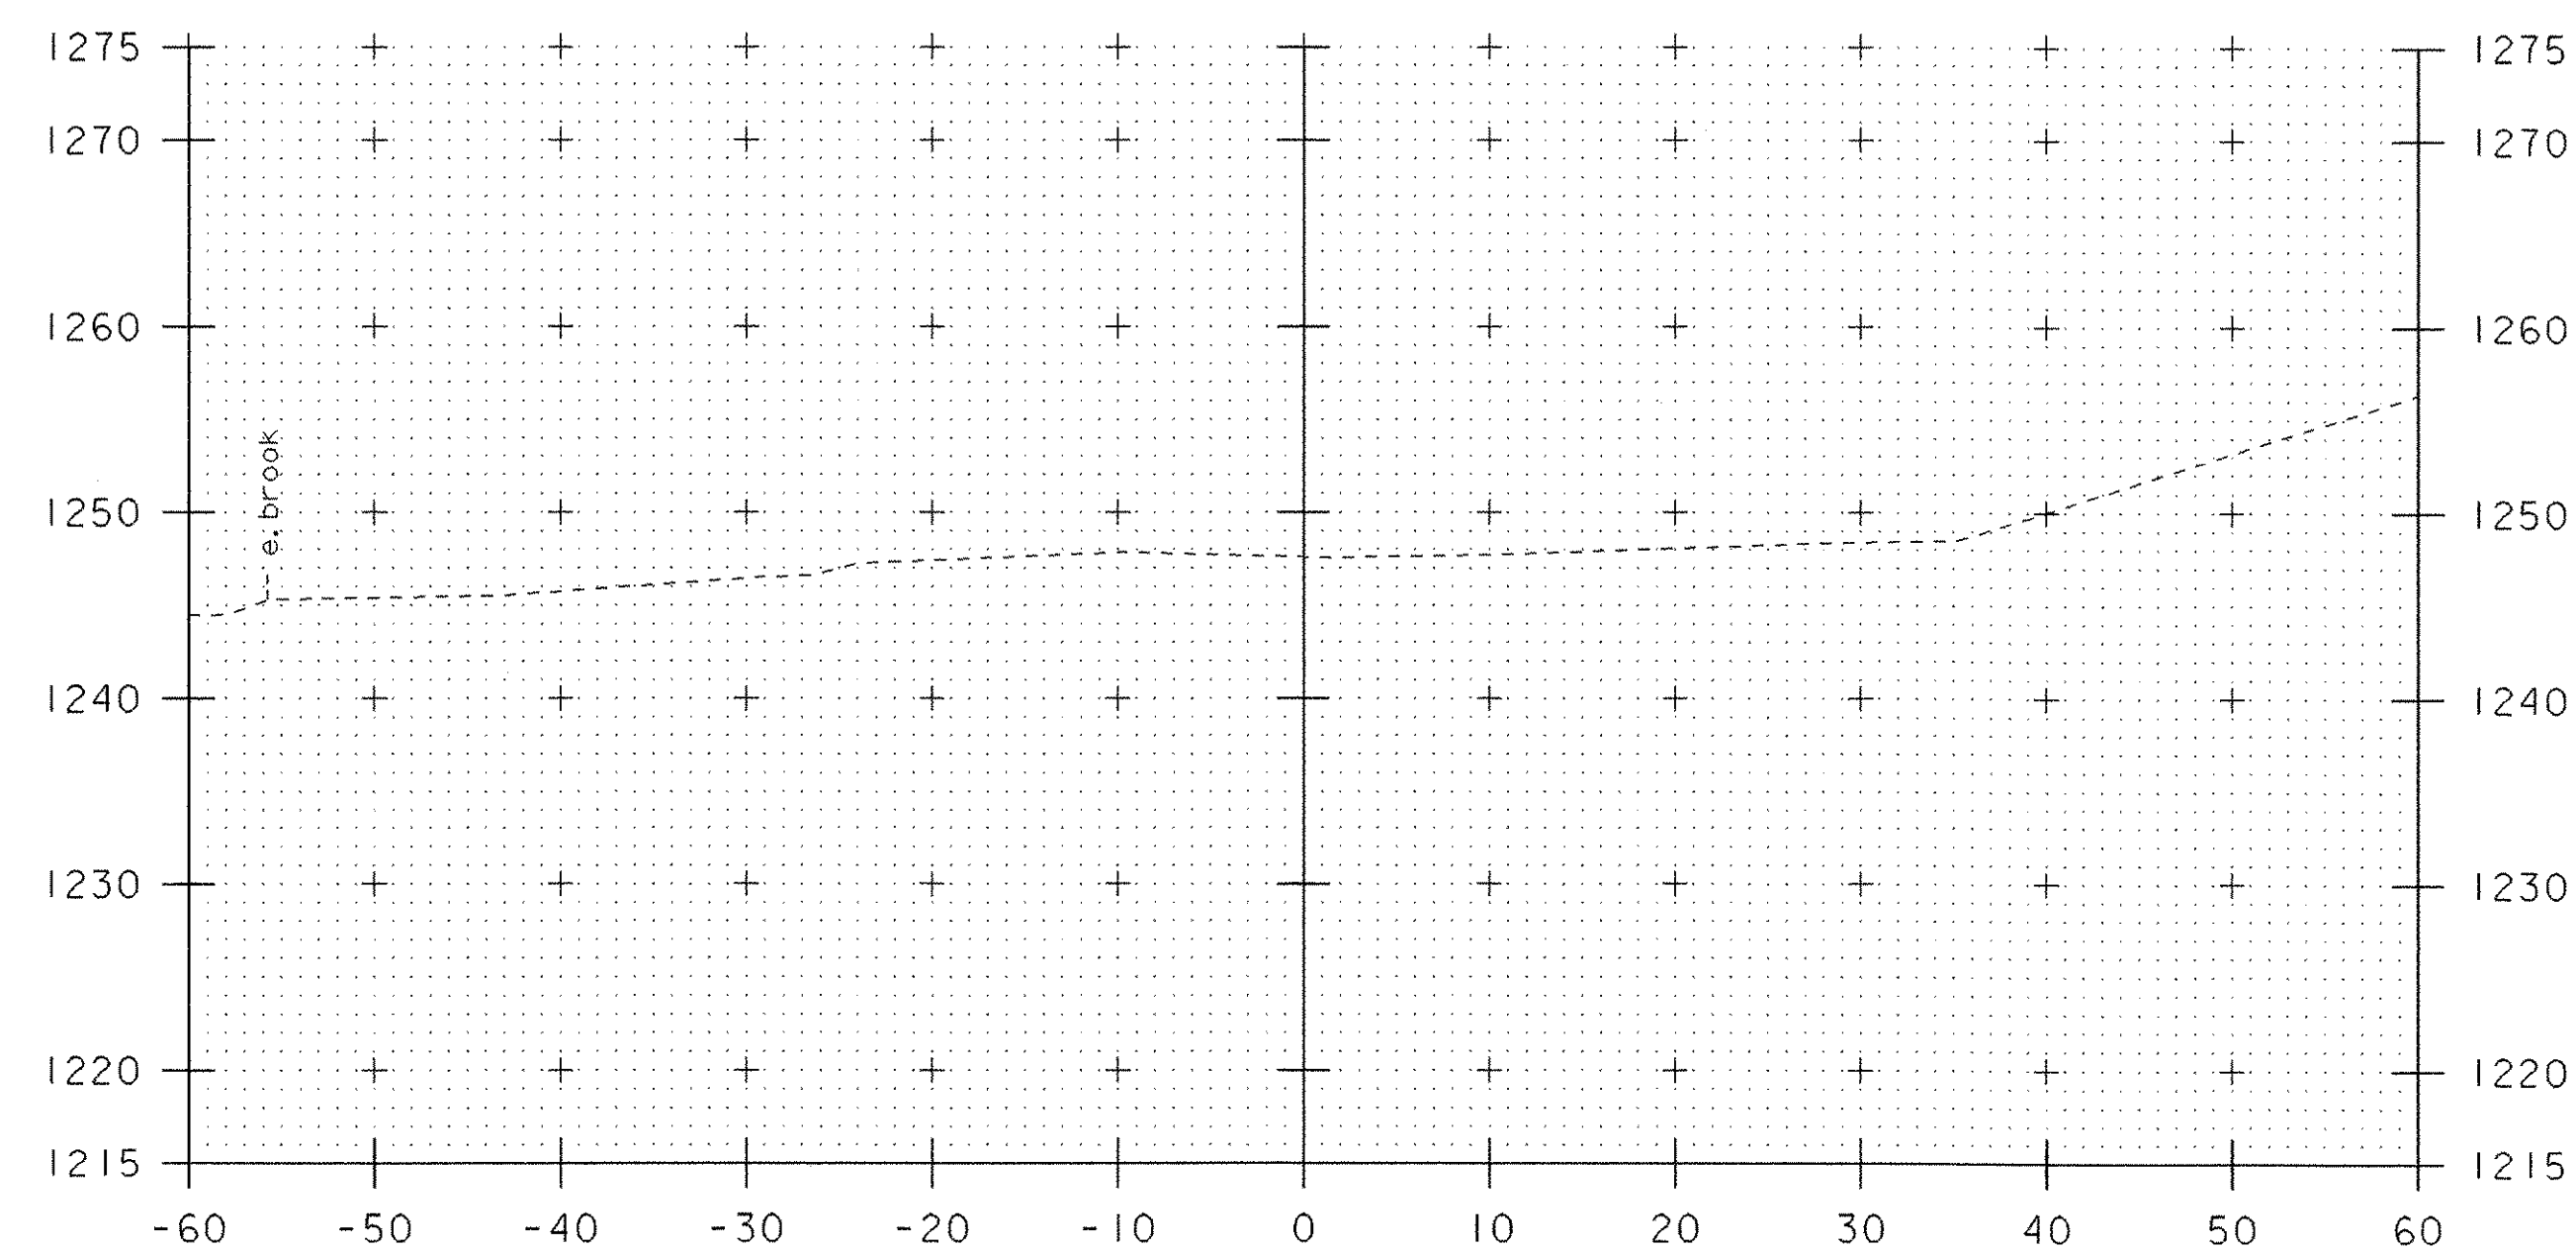

52+80

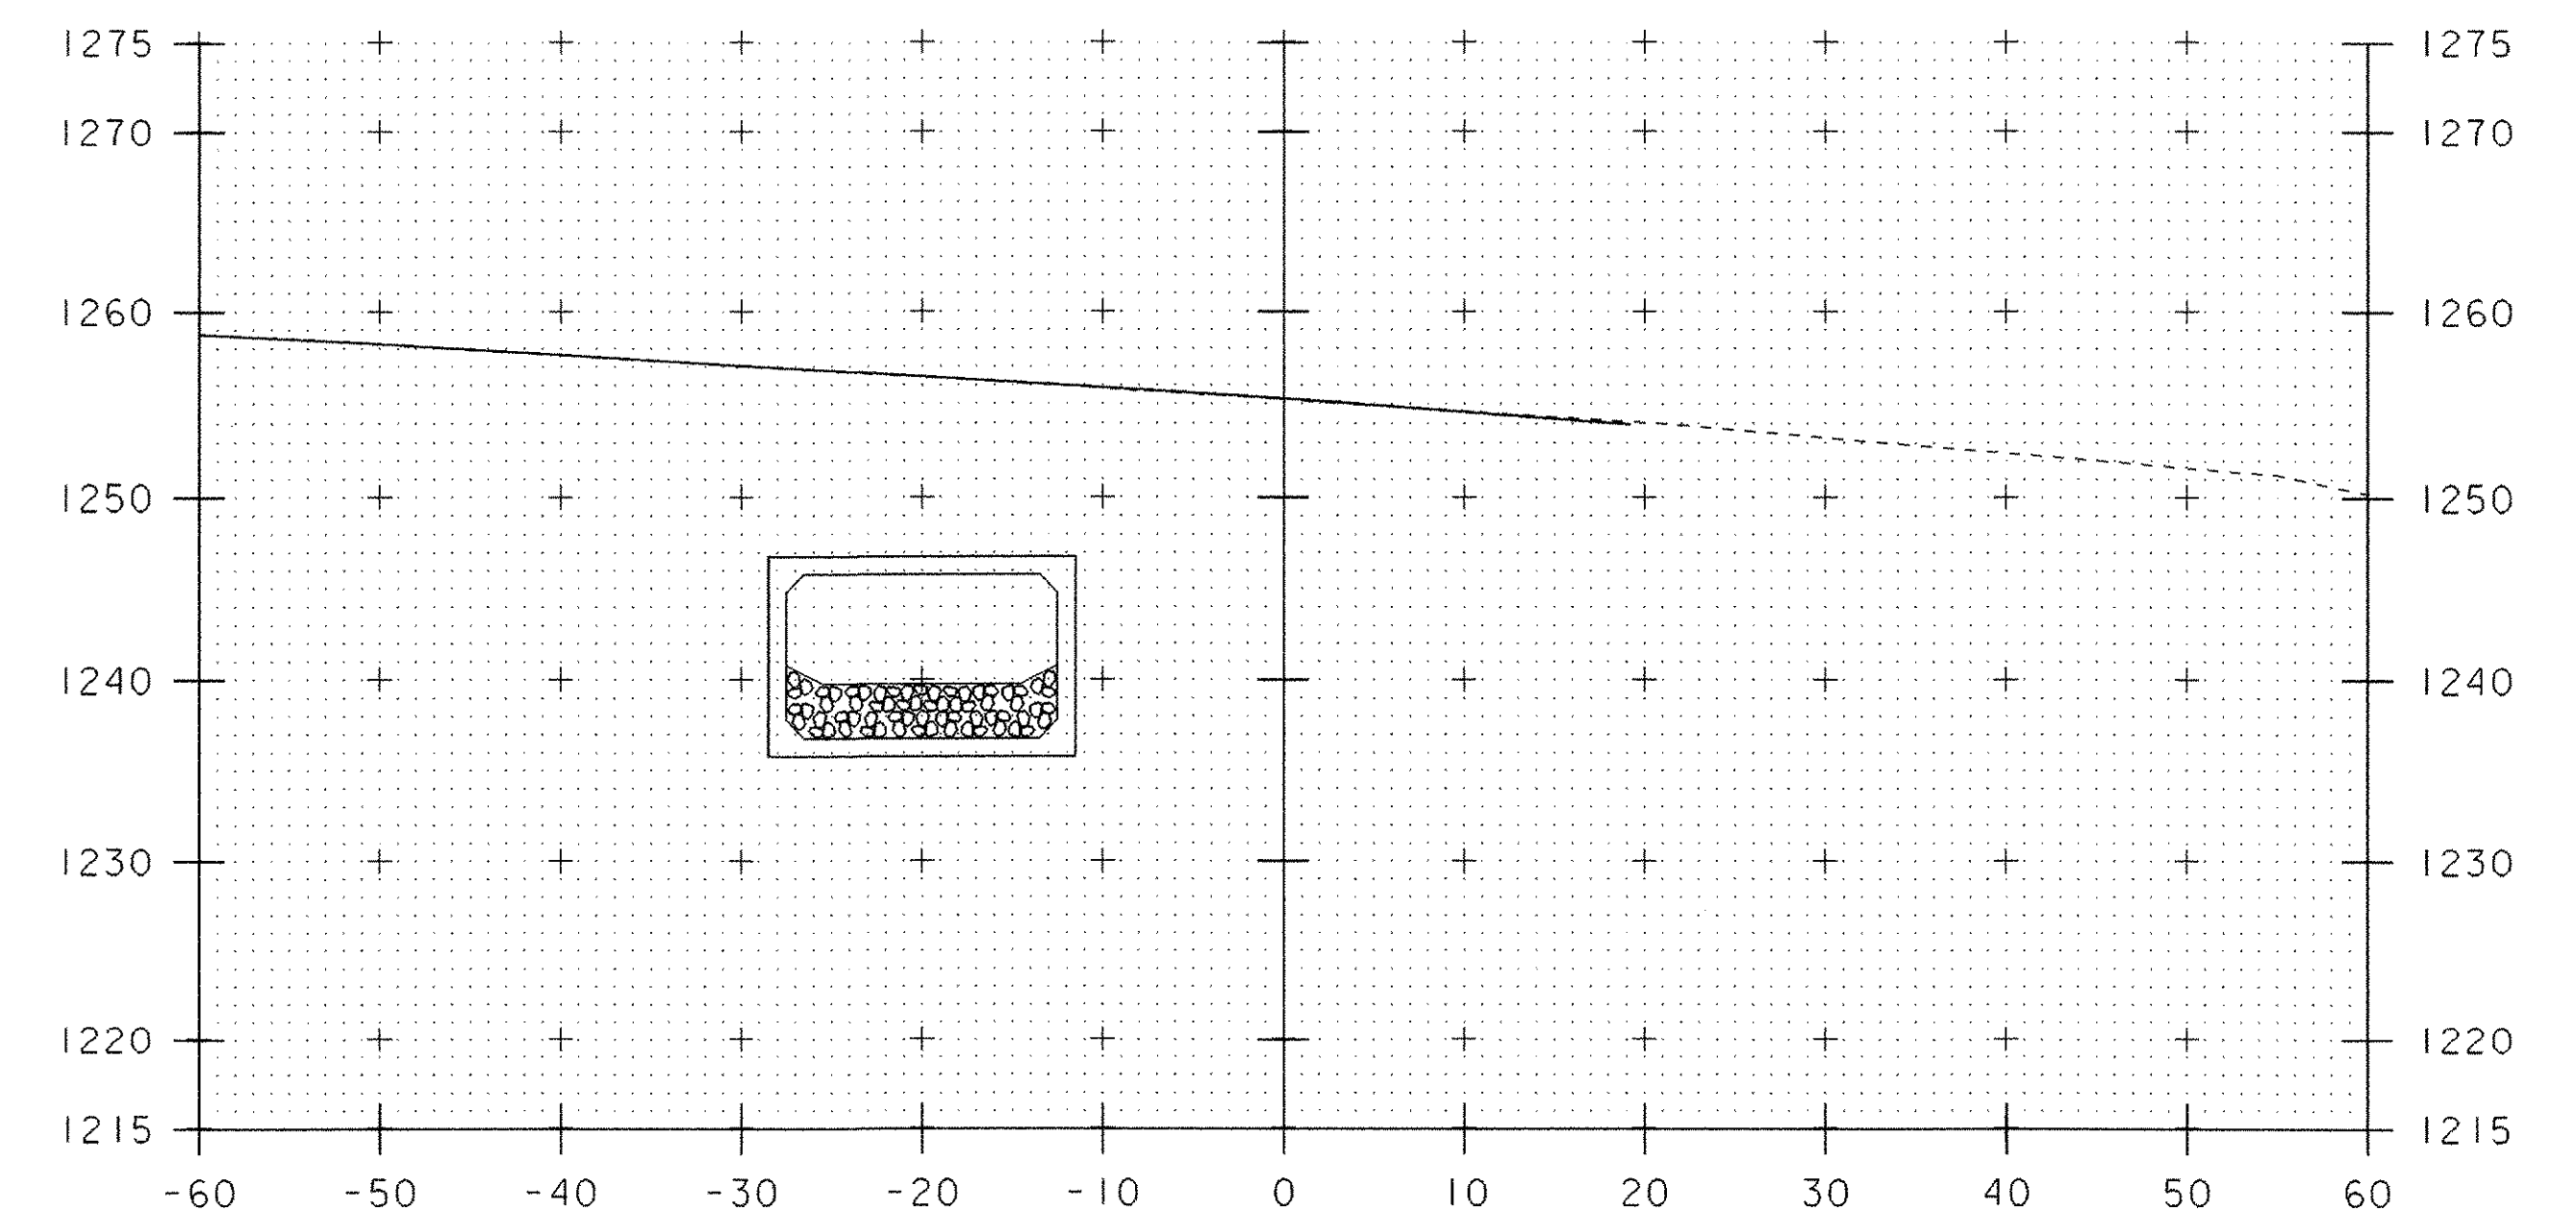

53+40




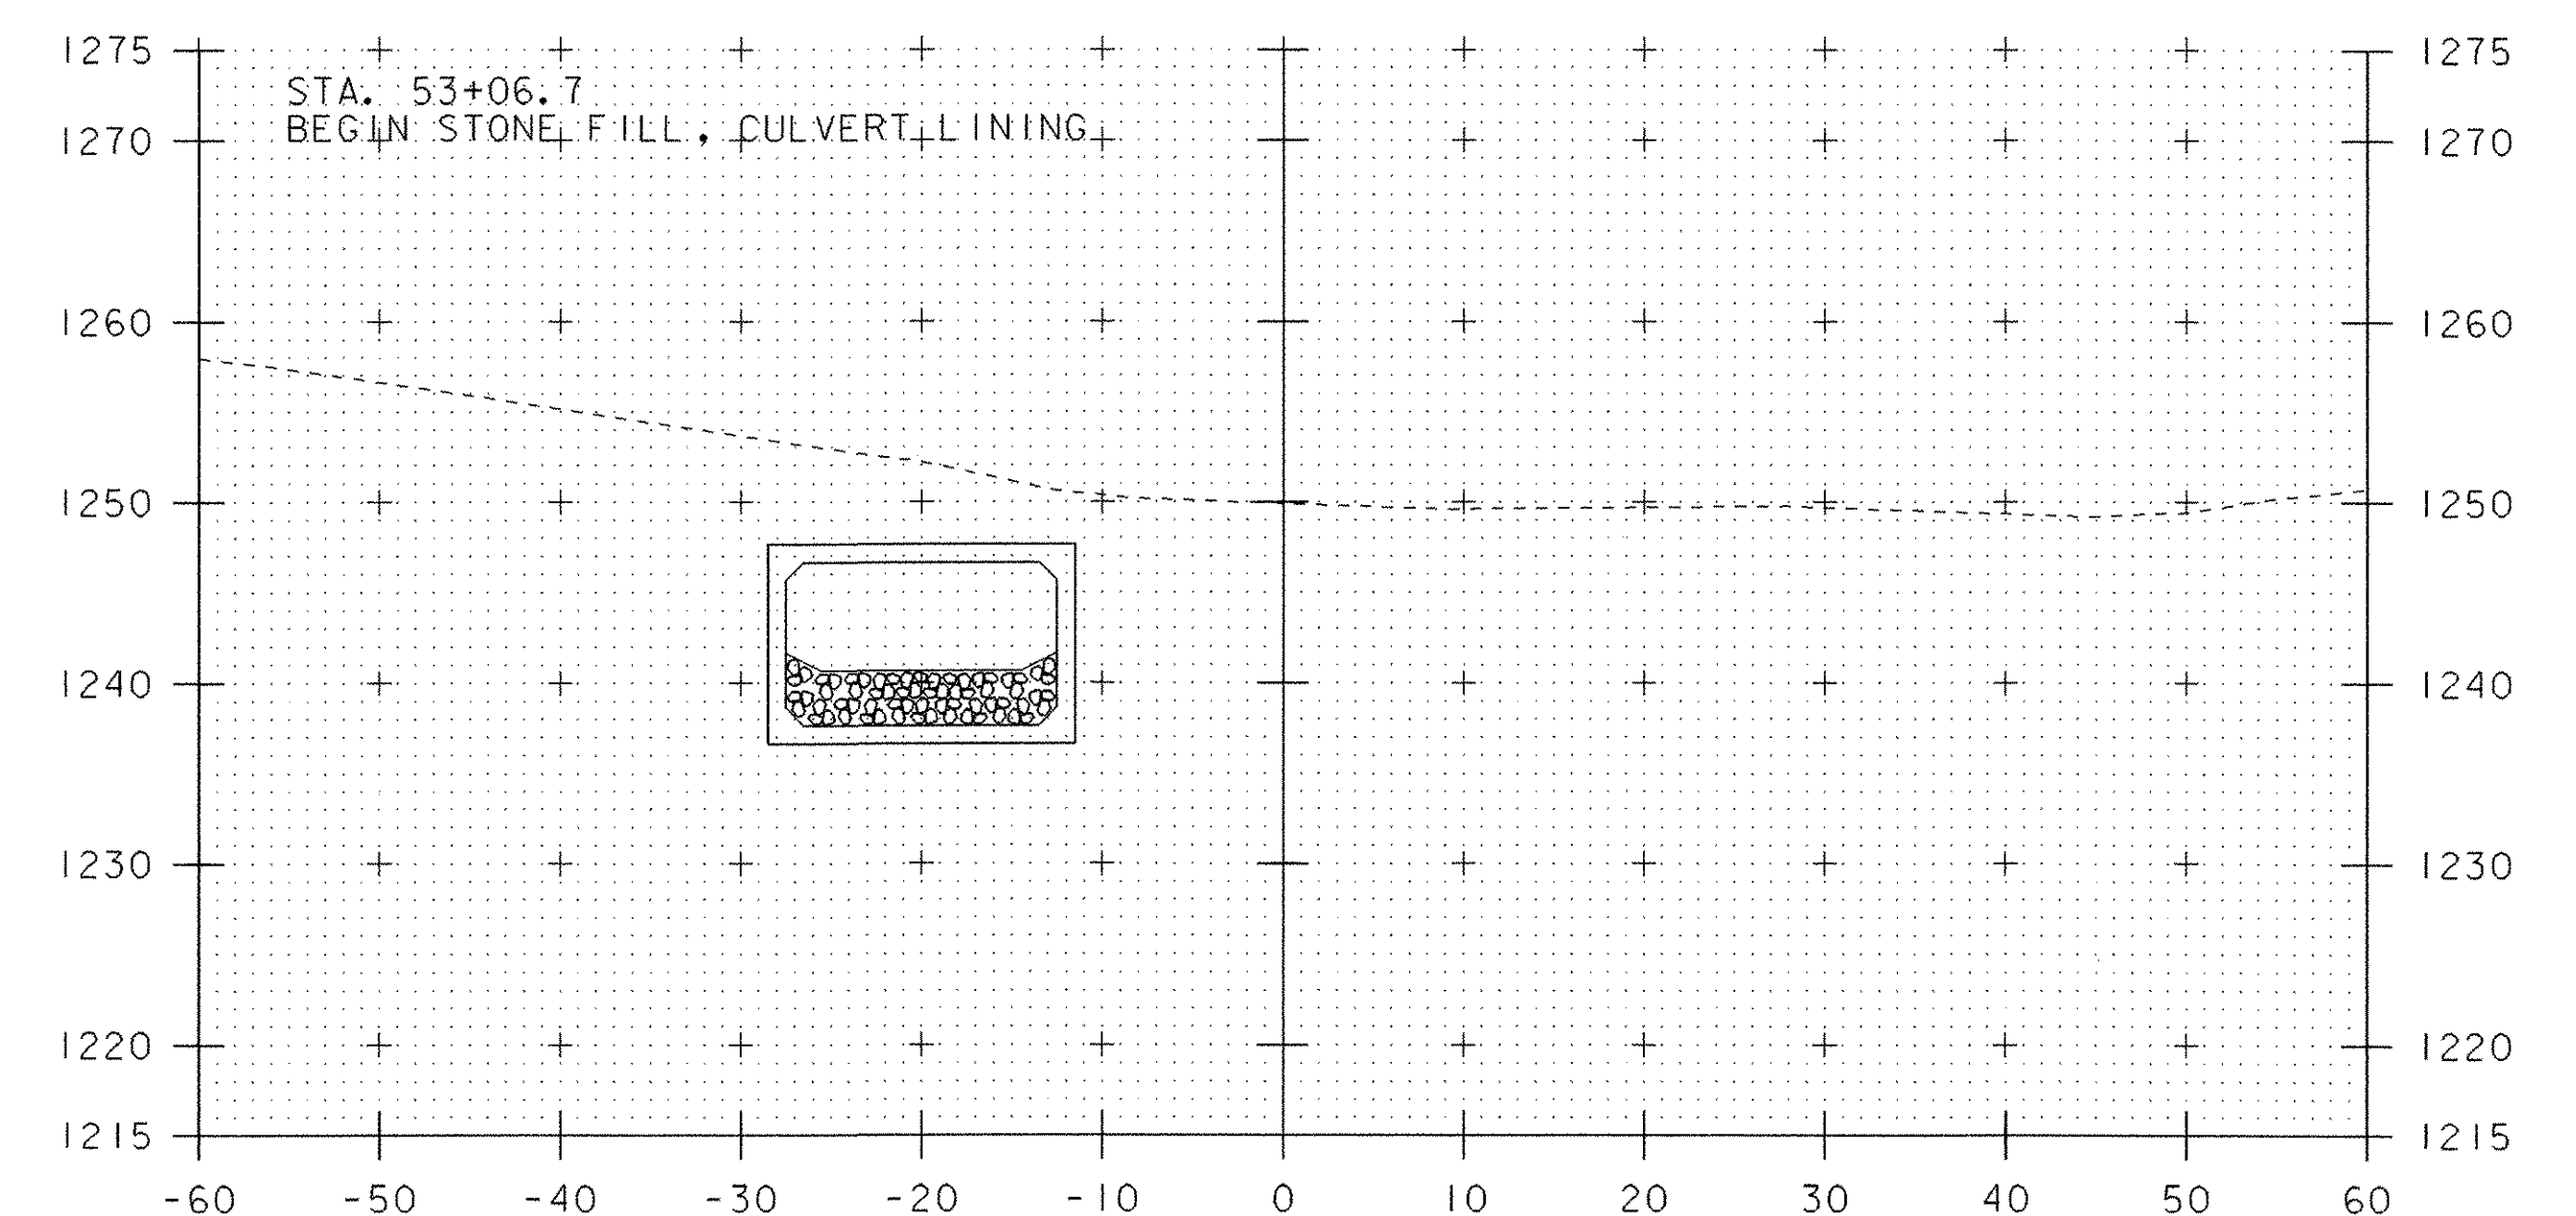


53+20

53+06.7
BEGIN BOX


CHANNEL CROSS SECTIONS

PROJECT NAME:	JAY
PROJECT NUMBER:	ST STP CULV (2)
FILE NAME:	04b140\s04b140bdr.dgn
PROJECT LEADER:	W. SYMONDS
DESIGNED BY:	T. SUMNER
04b140chxs2.i	
PLOT DATE:	23-OCT-2006
DRAWN BY:	G. SHANGRAW
CHECKED BY:	J. LACROIX
SHEET	37 OF 39

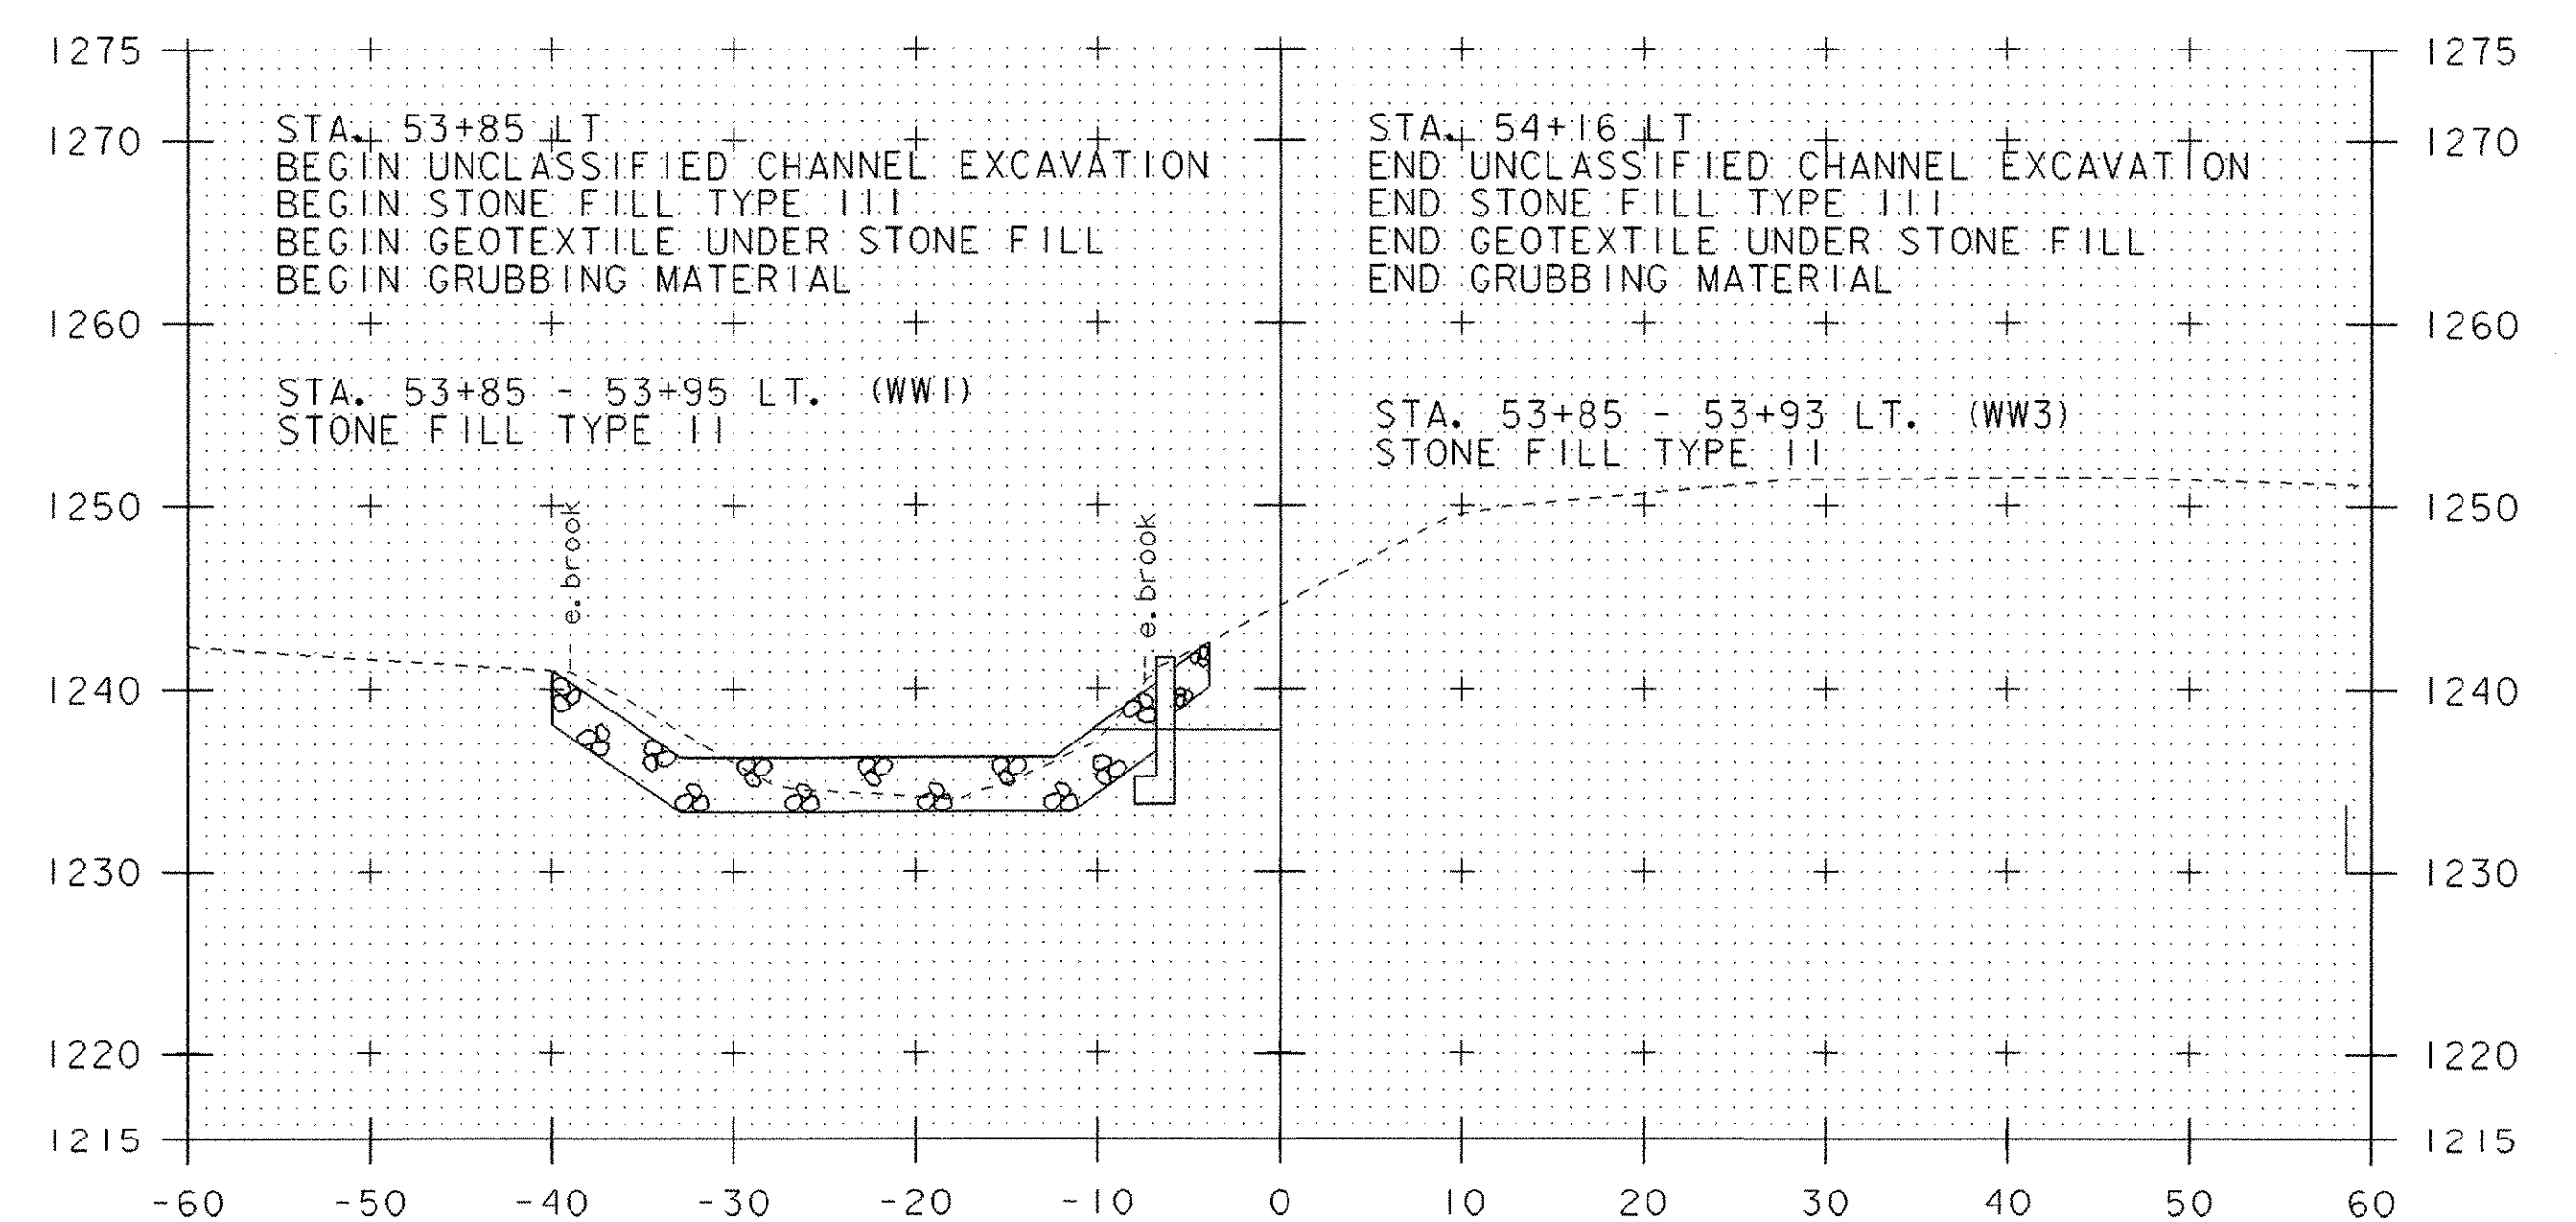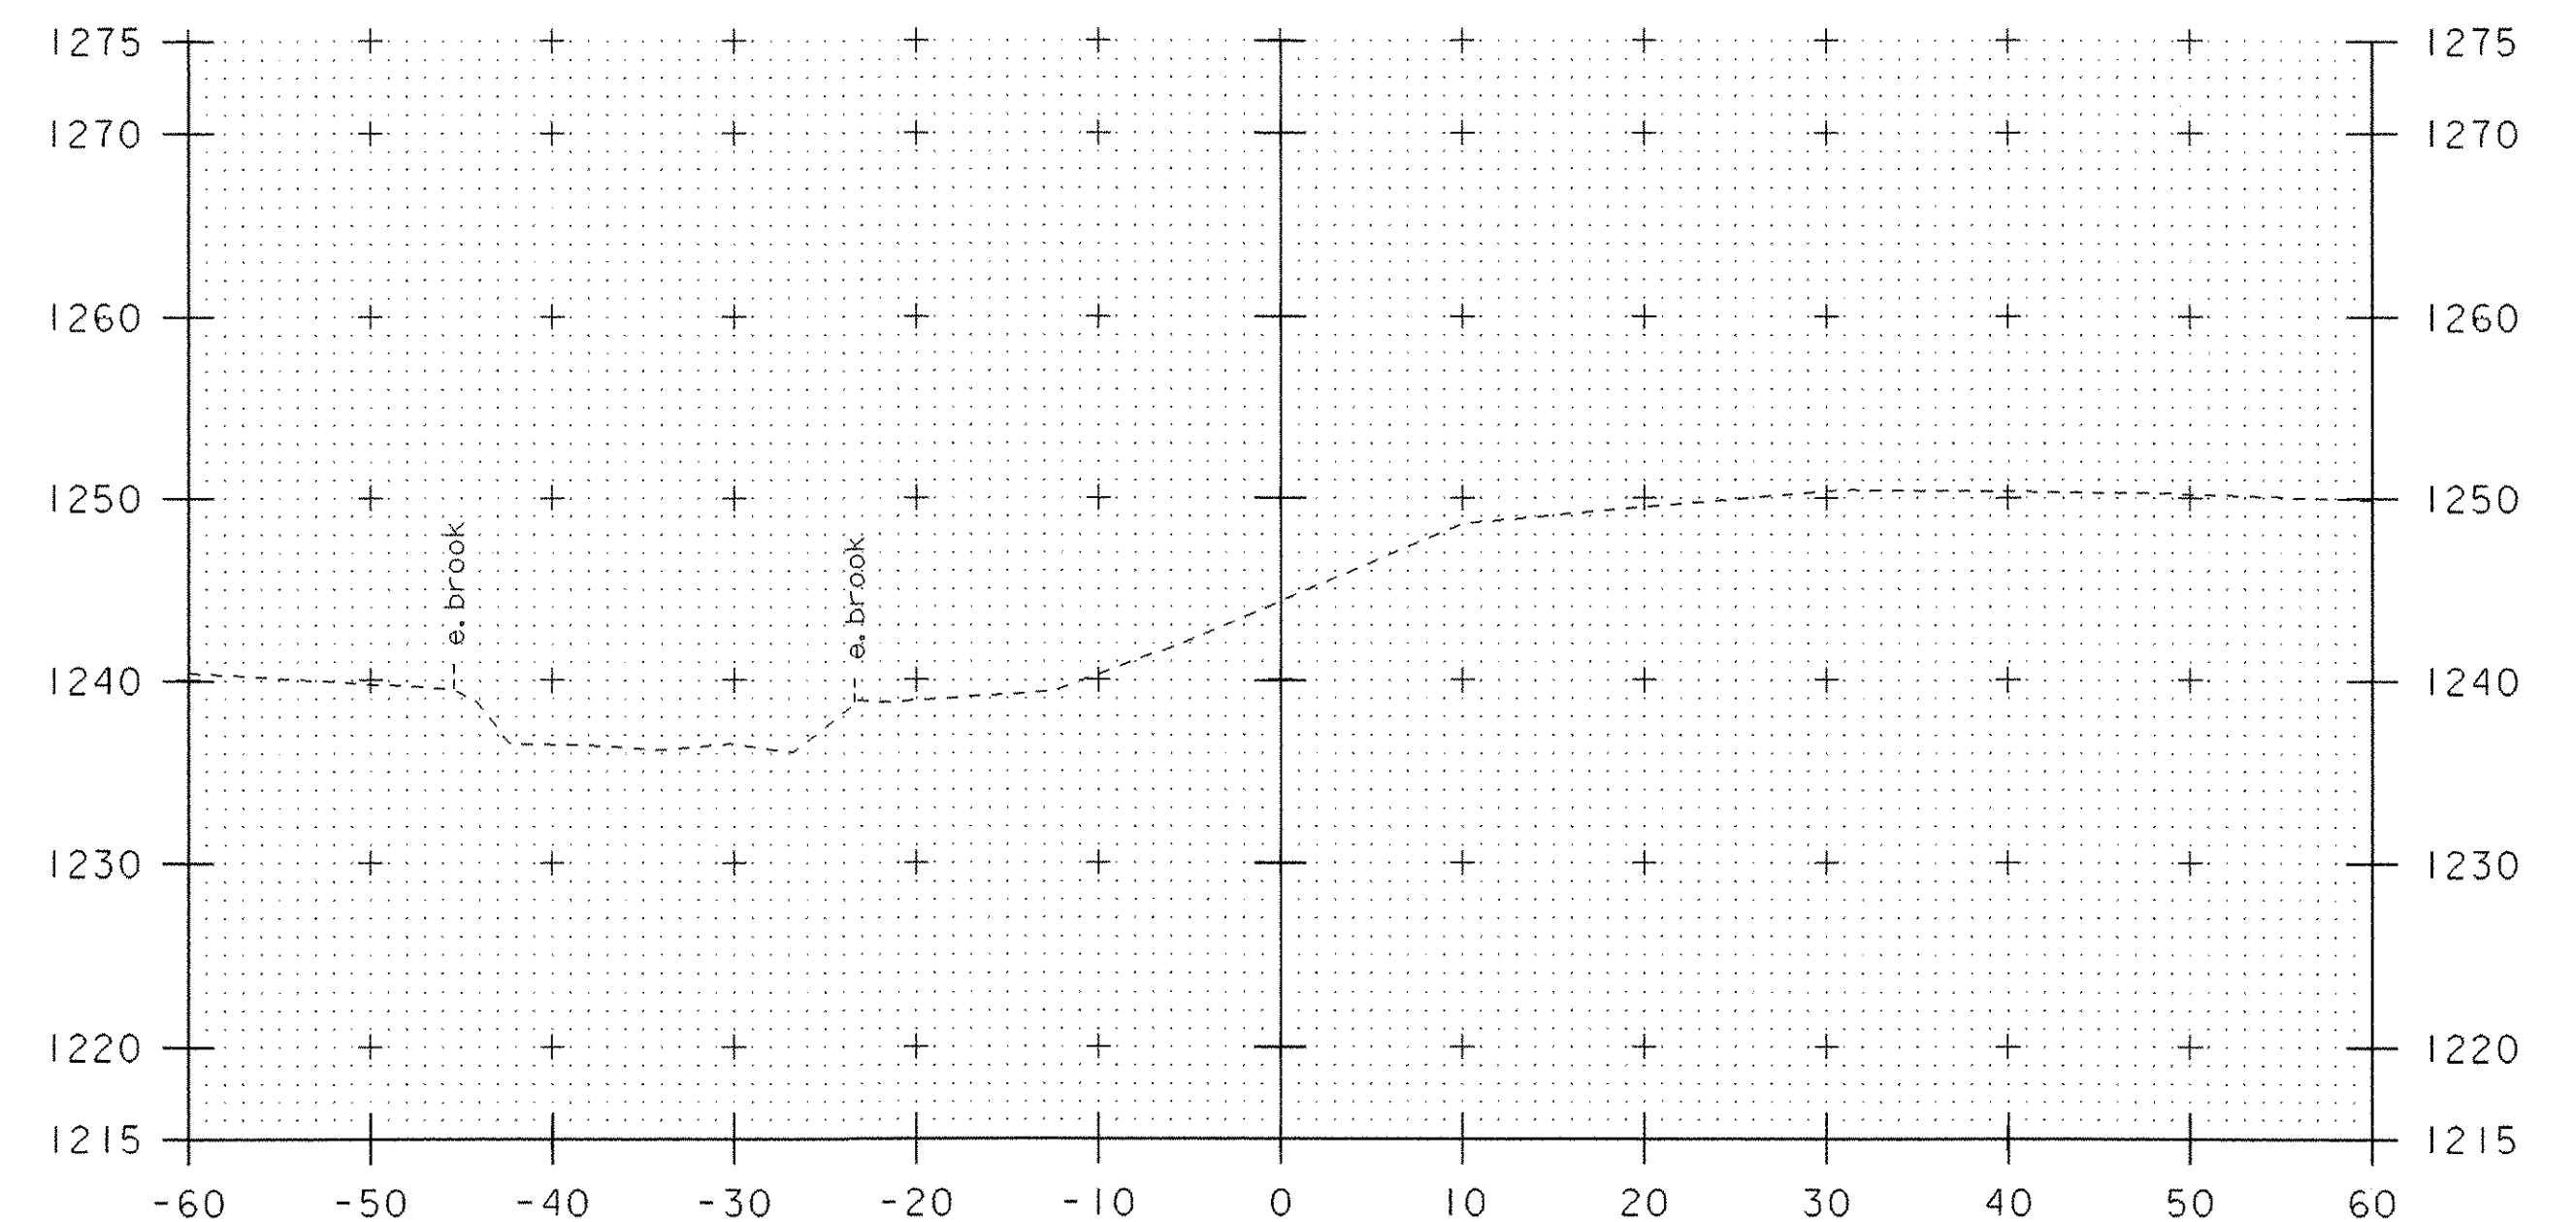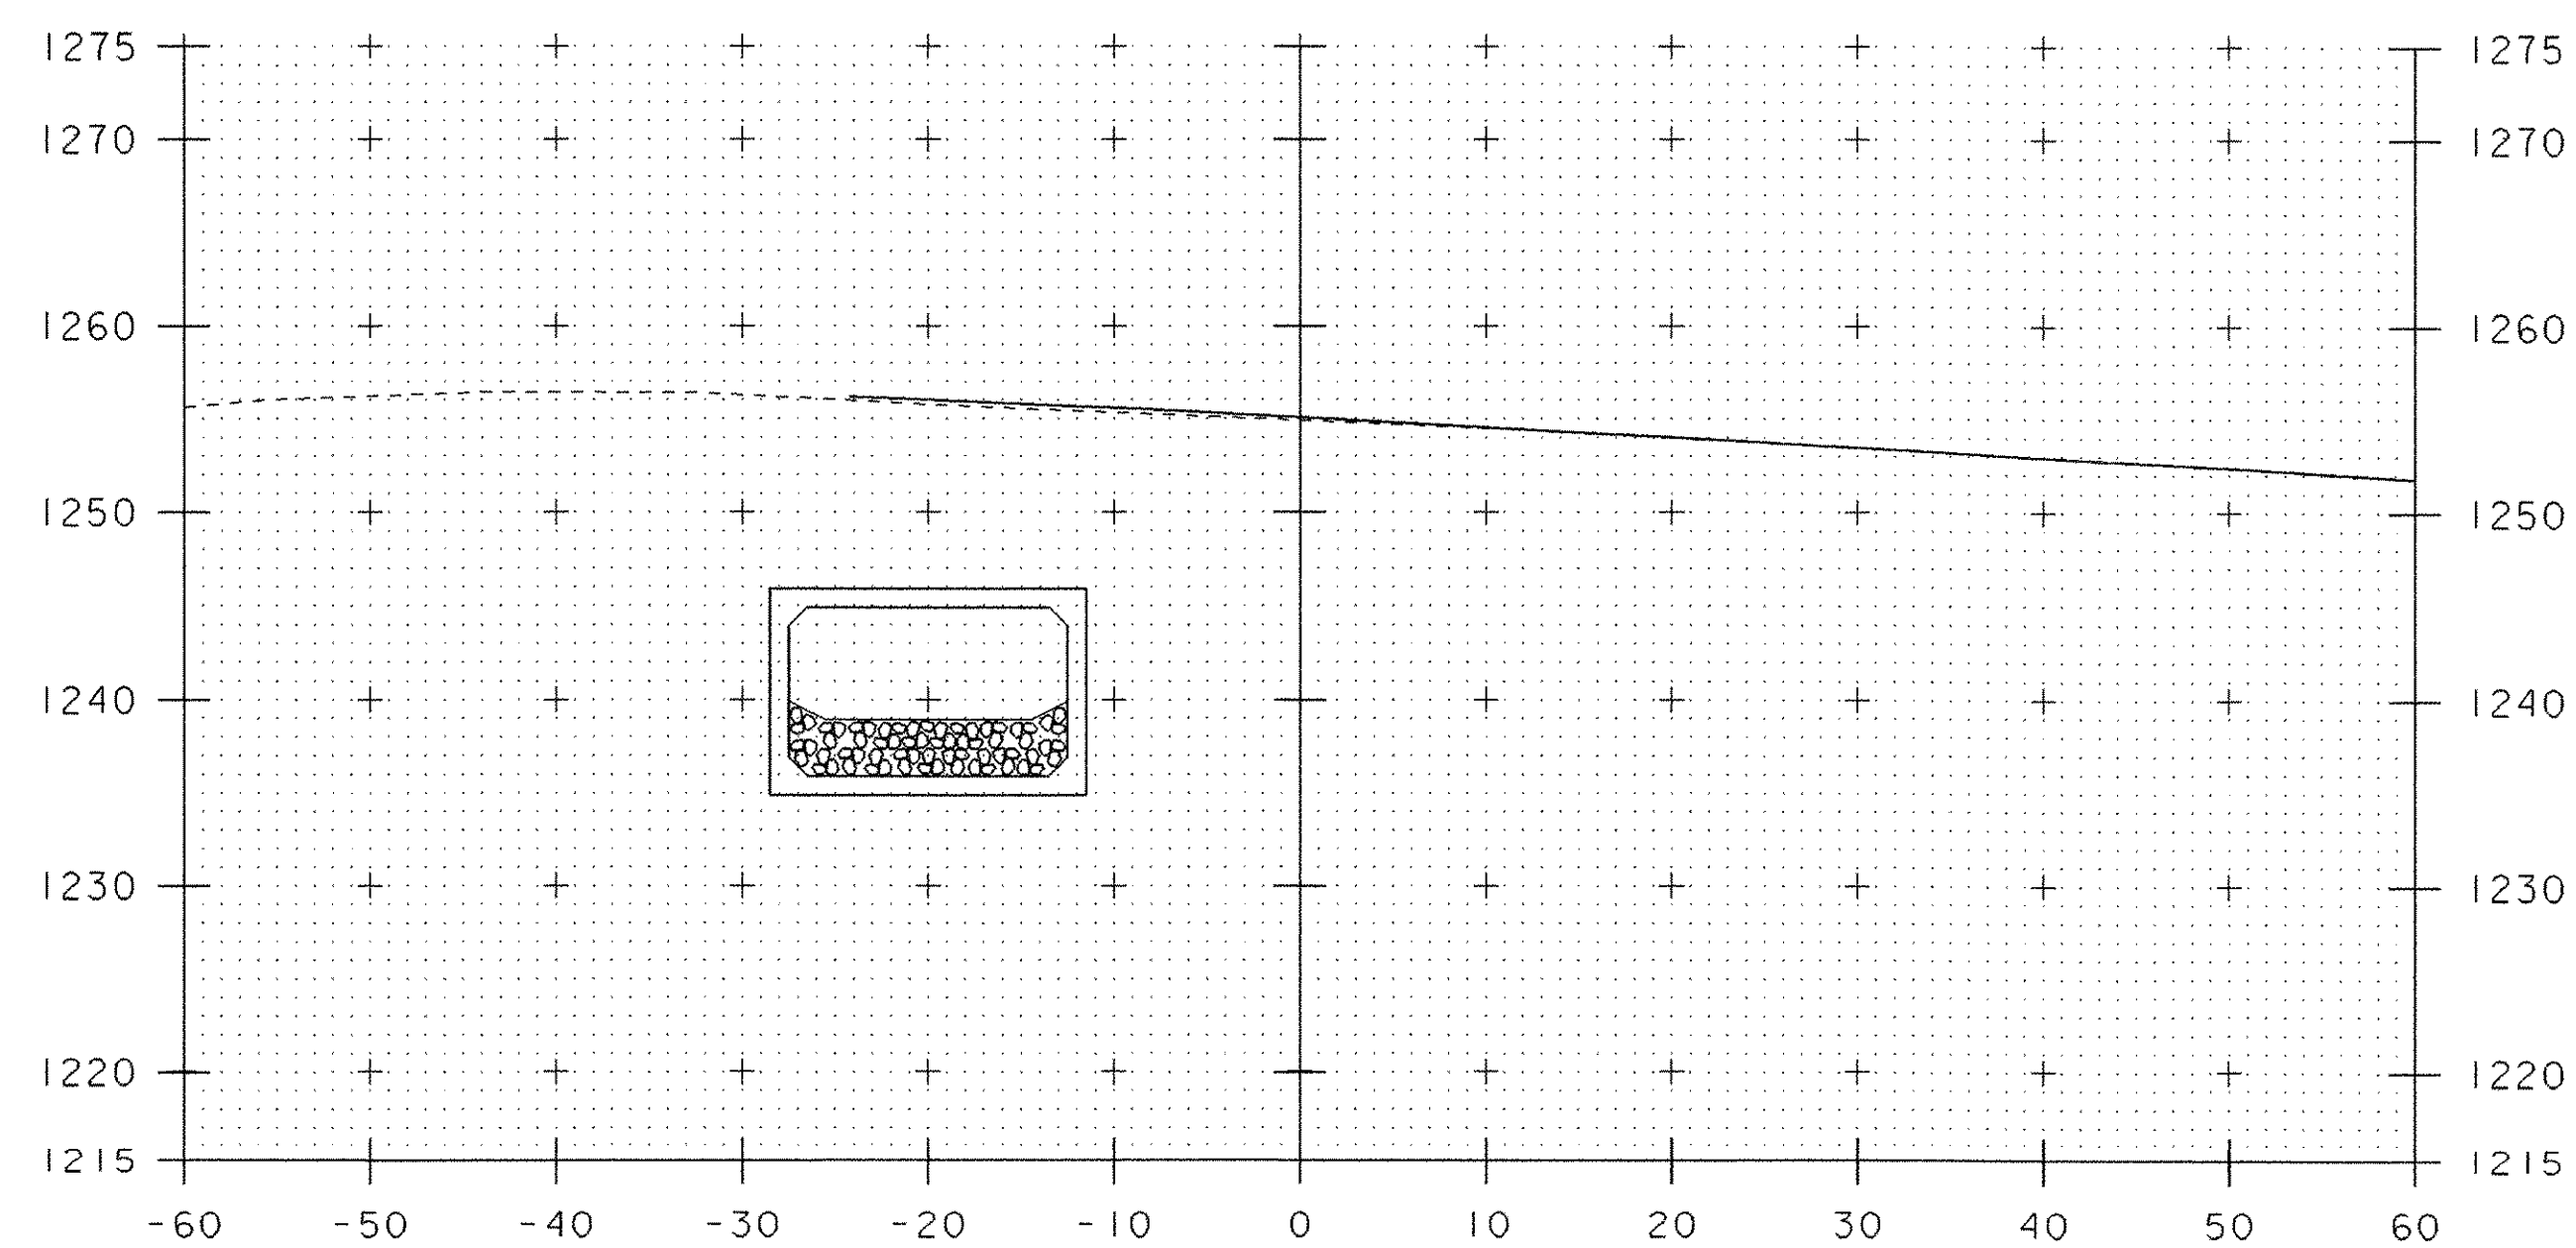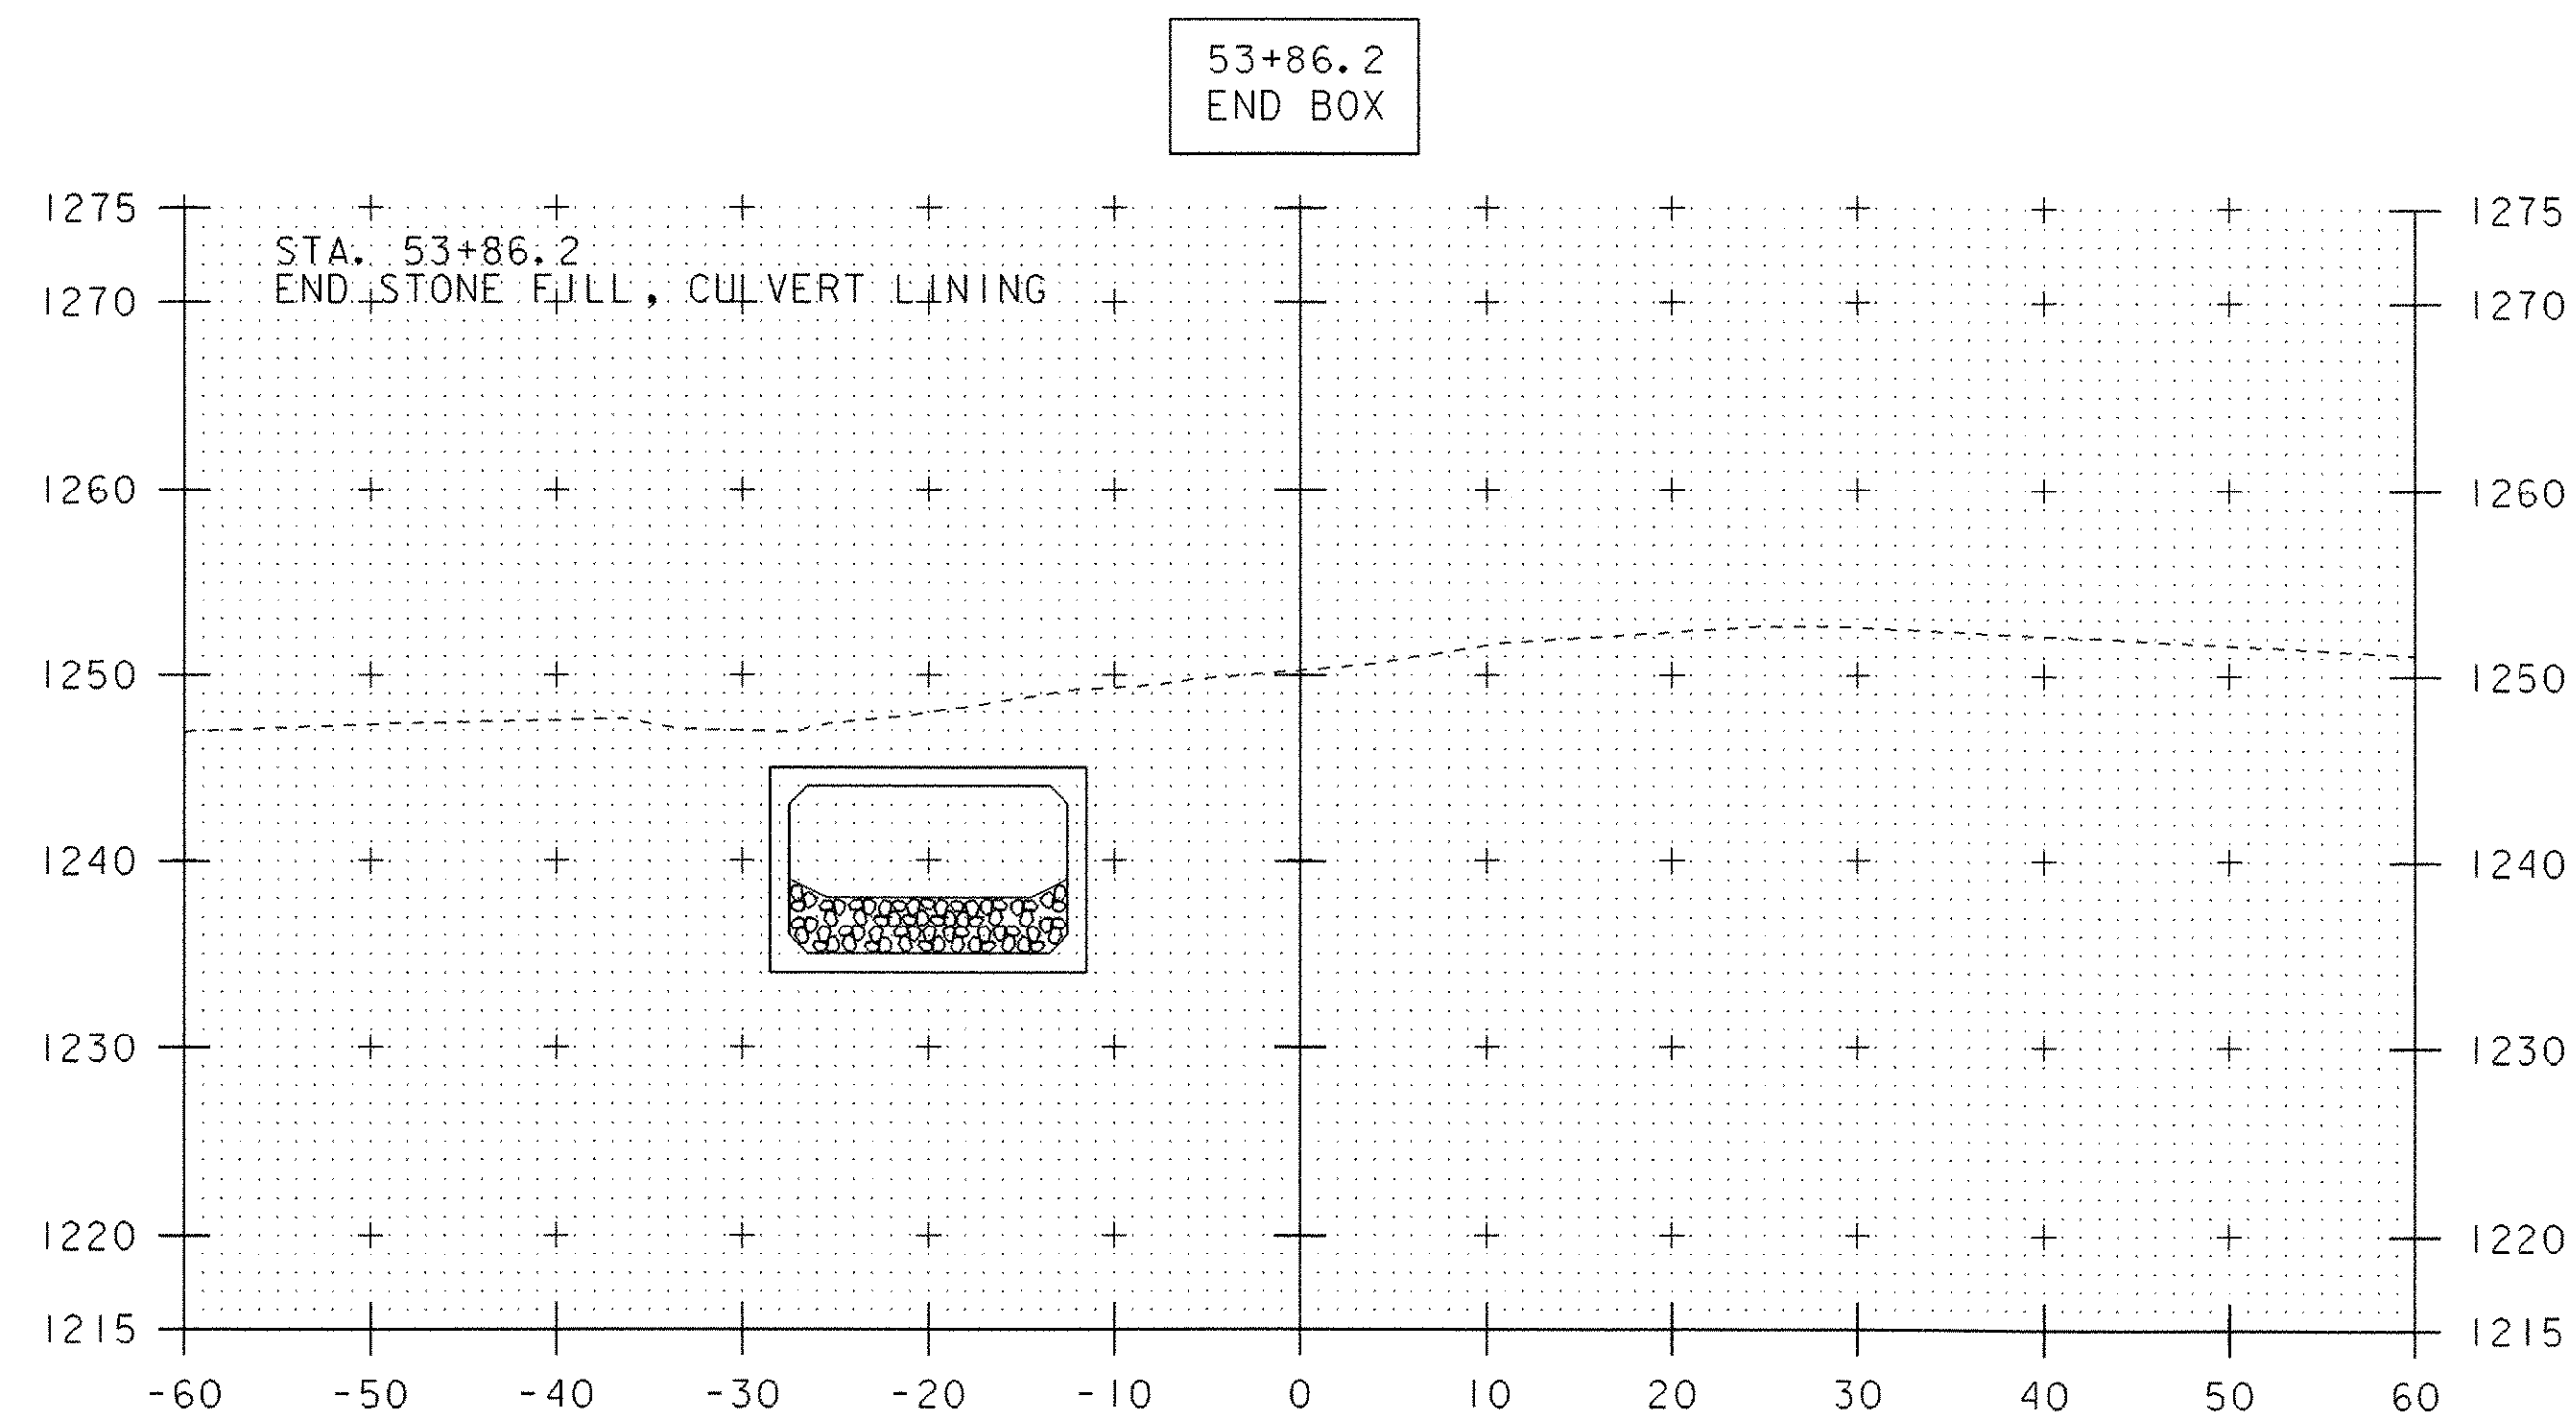


CHANNEL CROSS SECTIONS


PROJECT NAME:	JAY	FILE NAME:	04b140\04b140bdr.dgn	PLOT DATE:	23-OCT-2006
PROJECT NUMBER:	ST STP CULV (2)	PROJECT LEADER:	W. SYMONDS	DRAWN BY:	G. SHANGRAW
		DESIGNED BY:	T. SUMNER	CHECKED BY:	J. LACROIX
		04b140chxs3.i		SHEET	38 OF 39

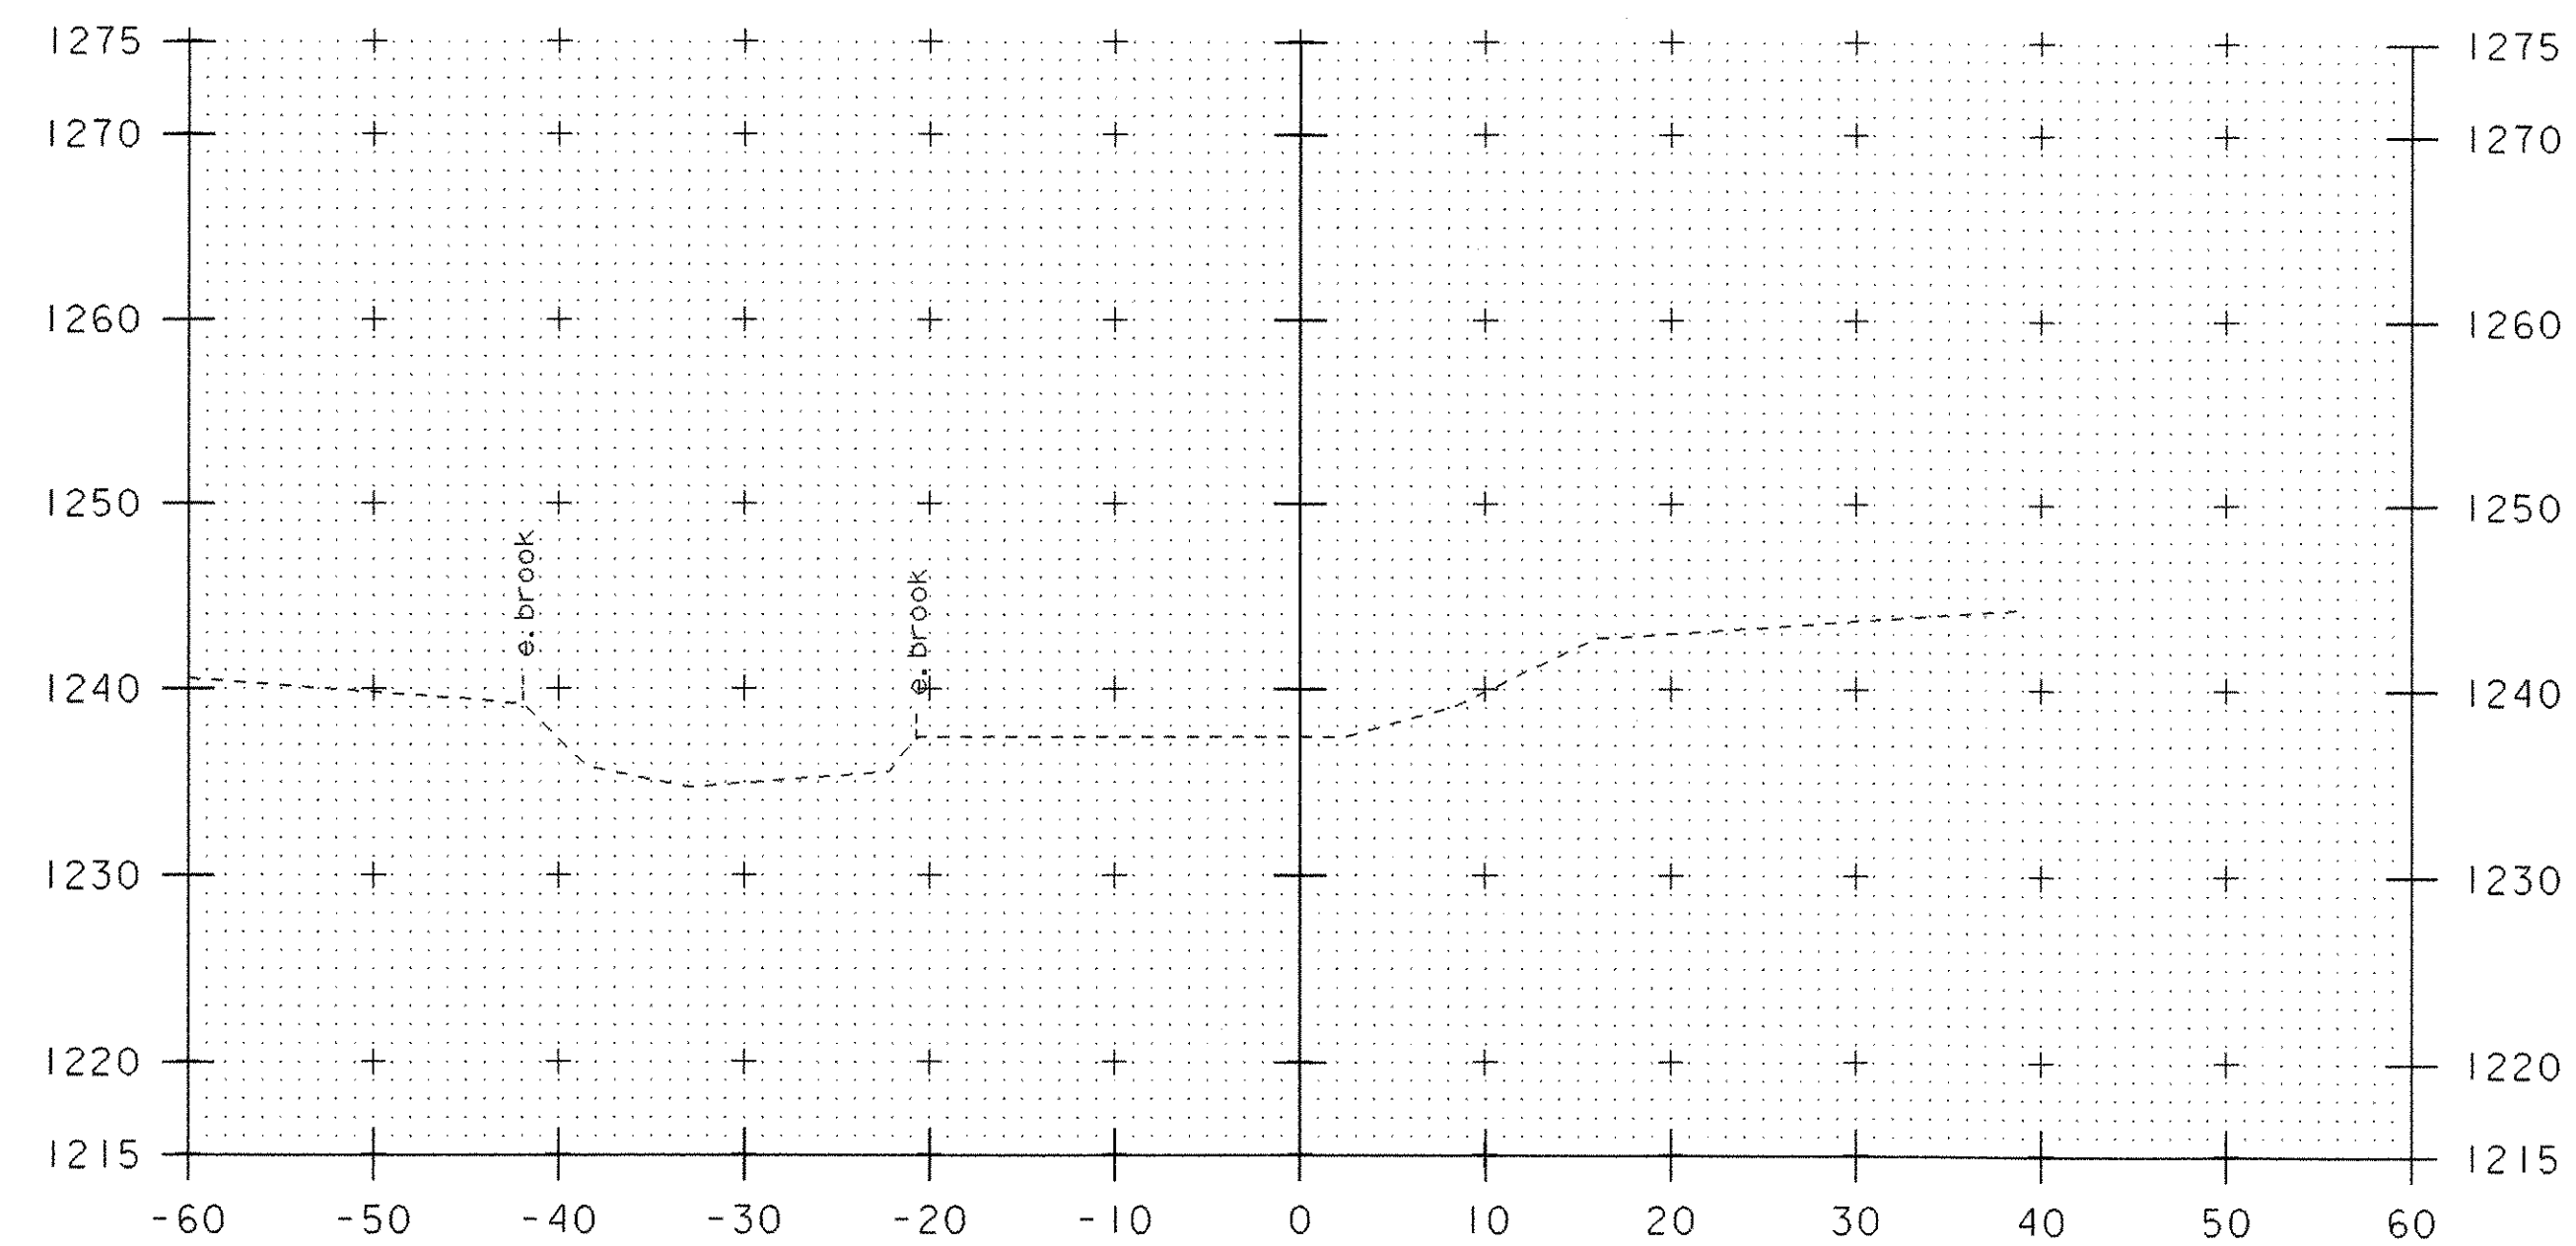


54+60

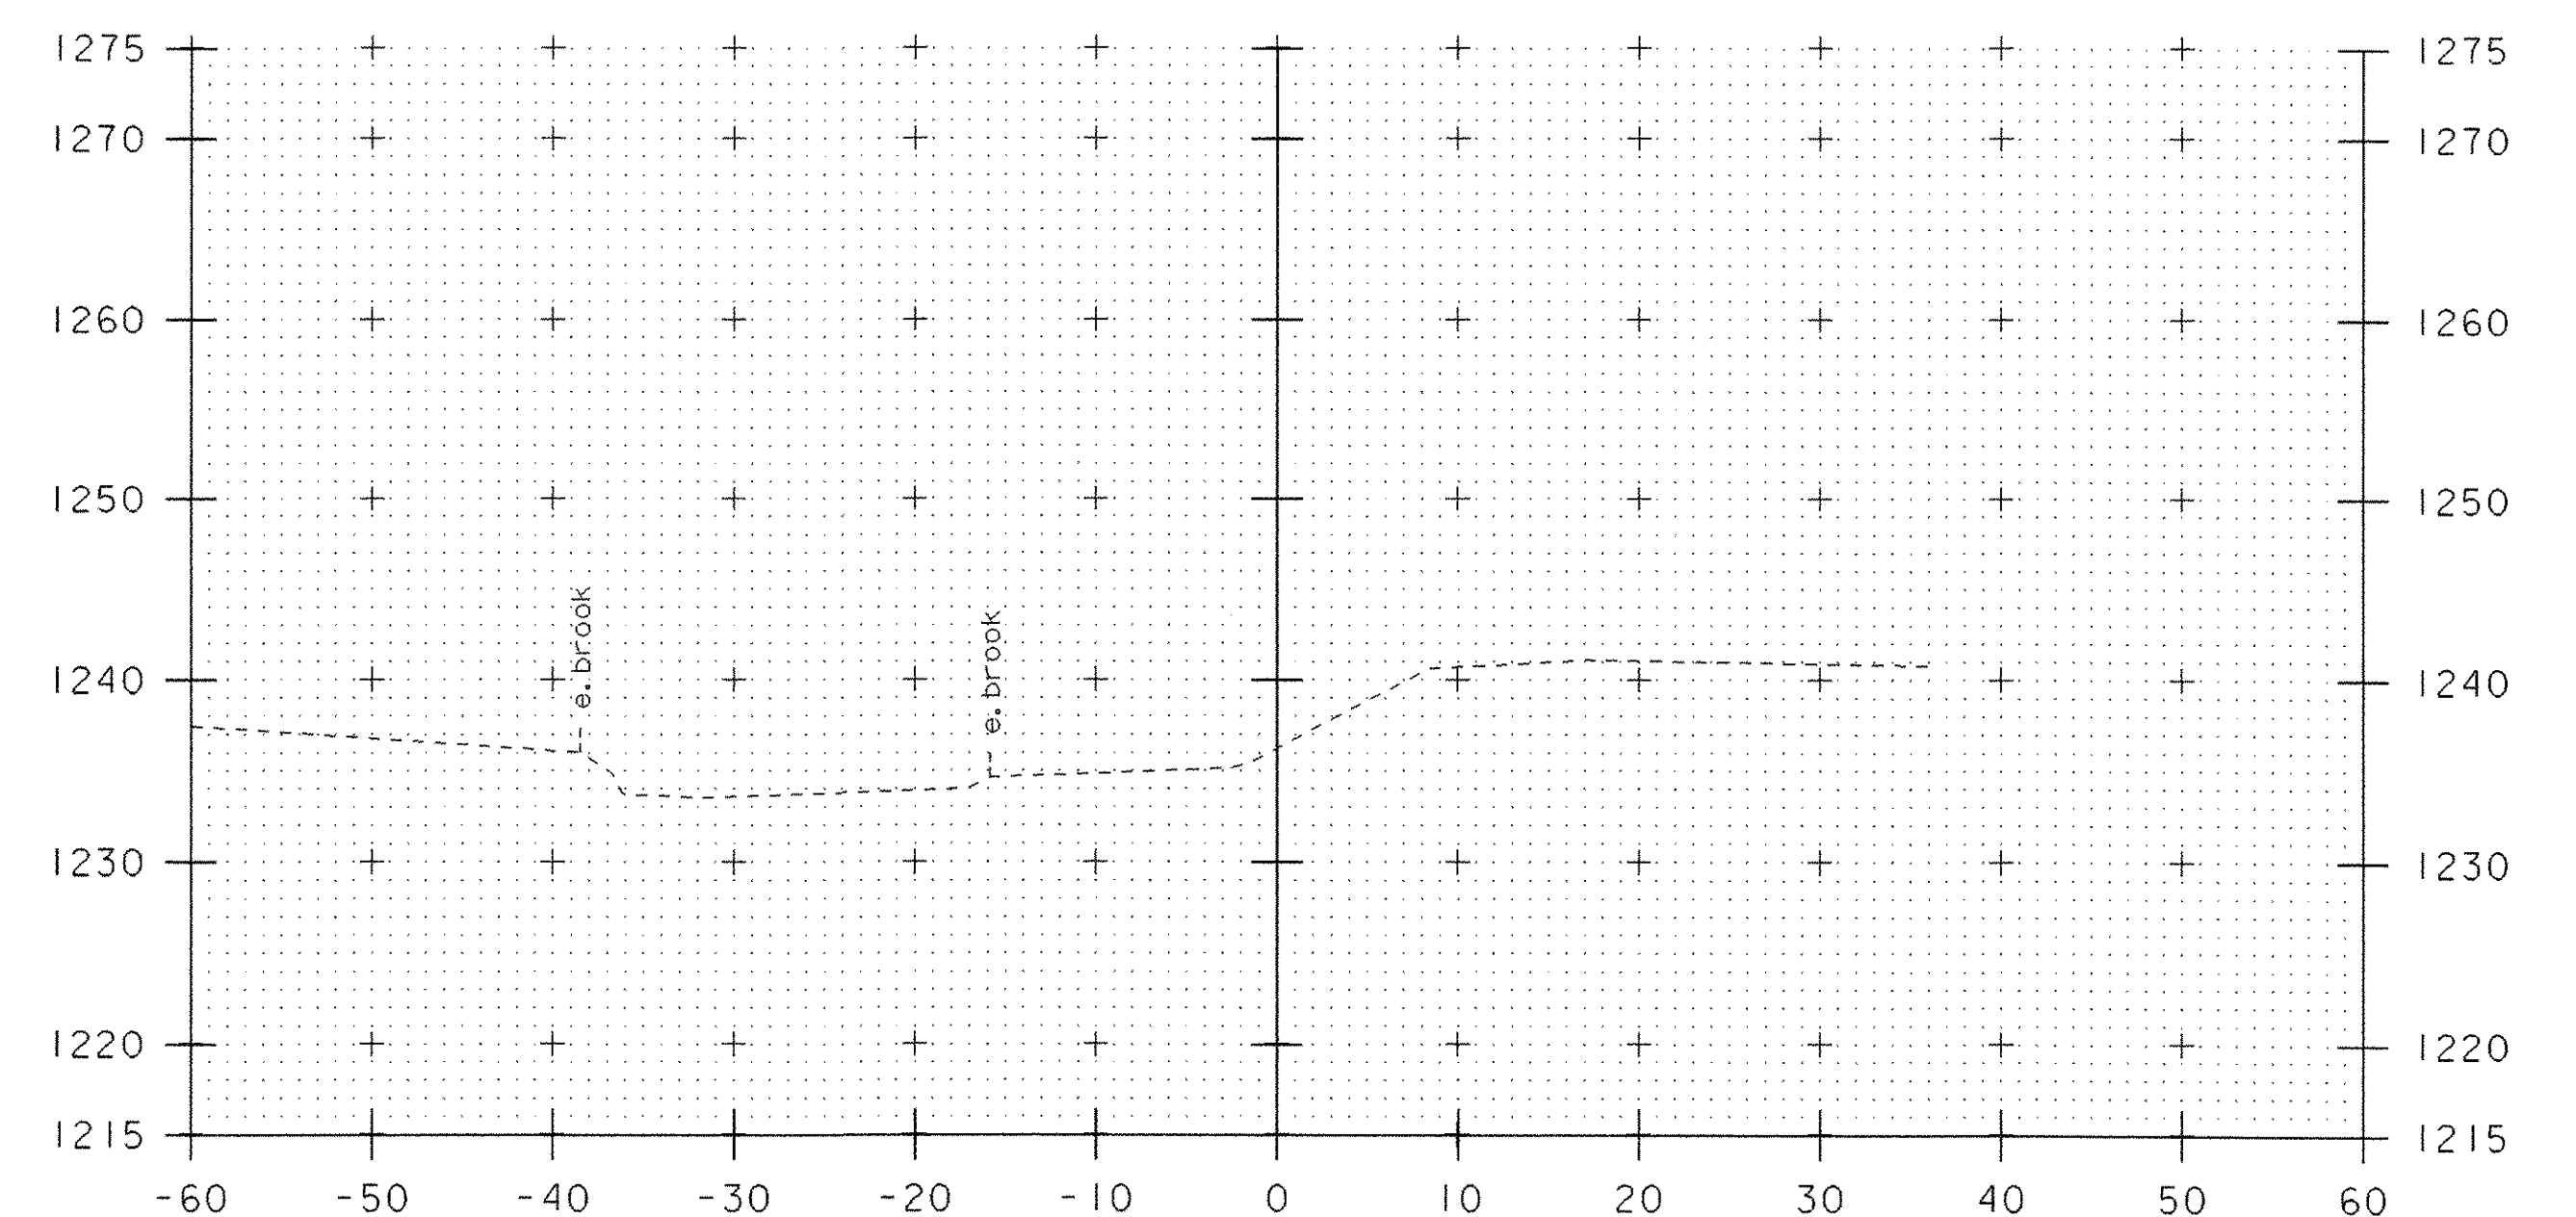

55+00

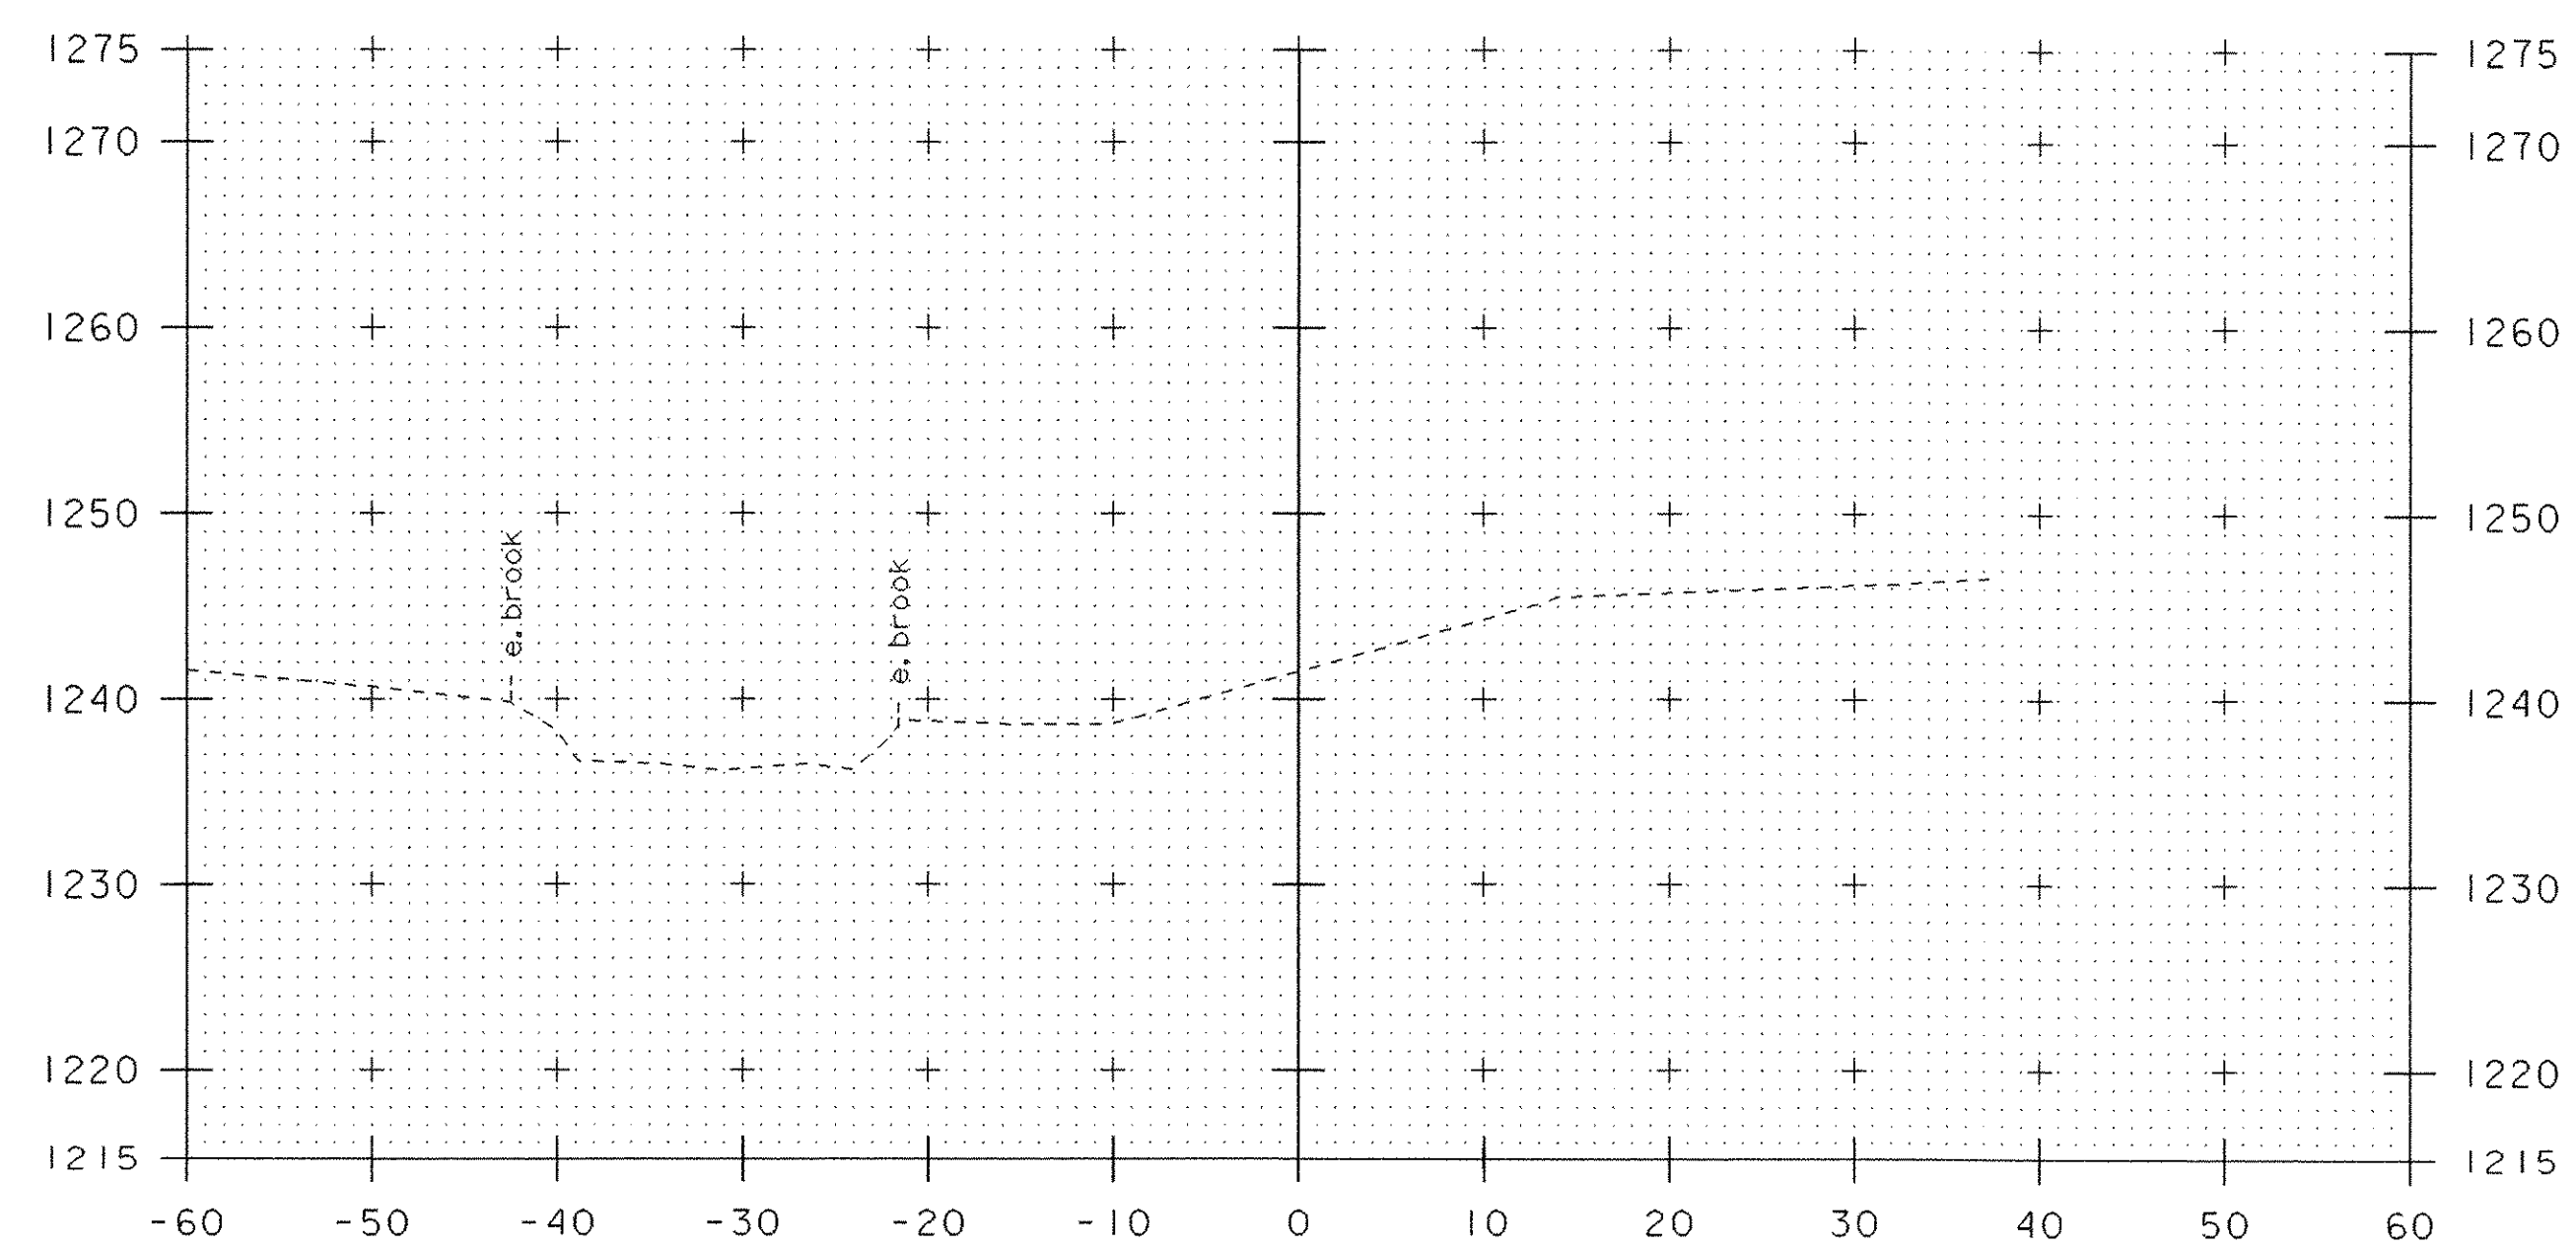

54+40

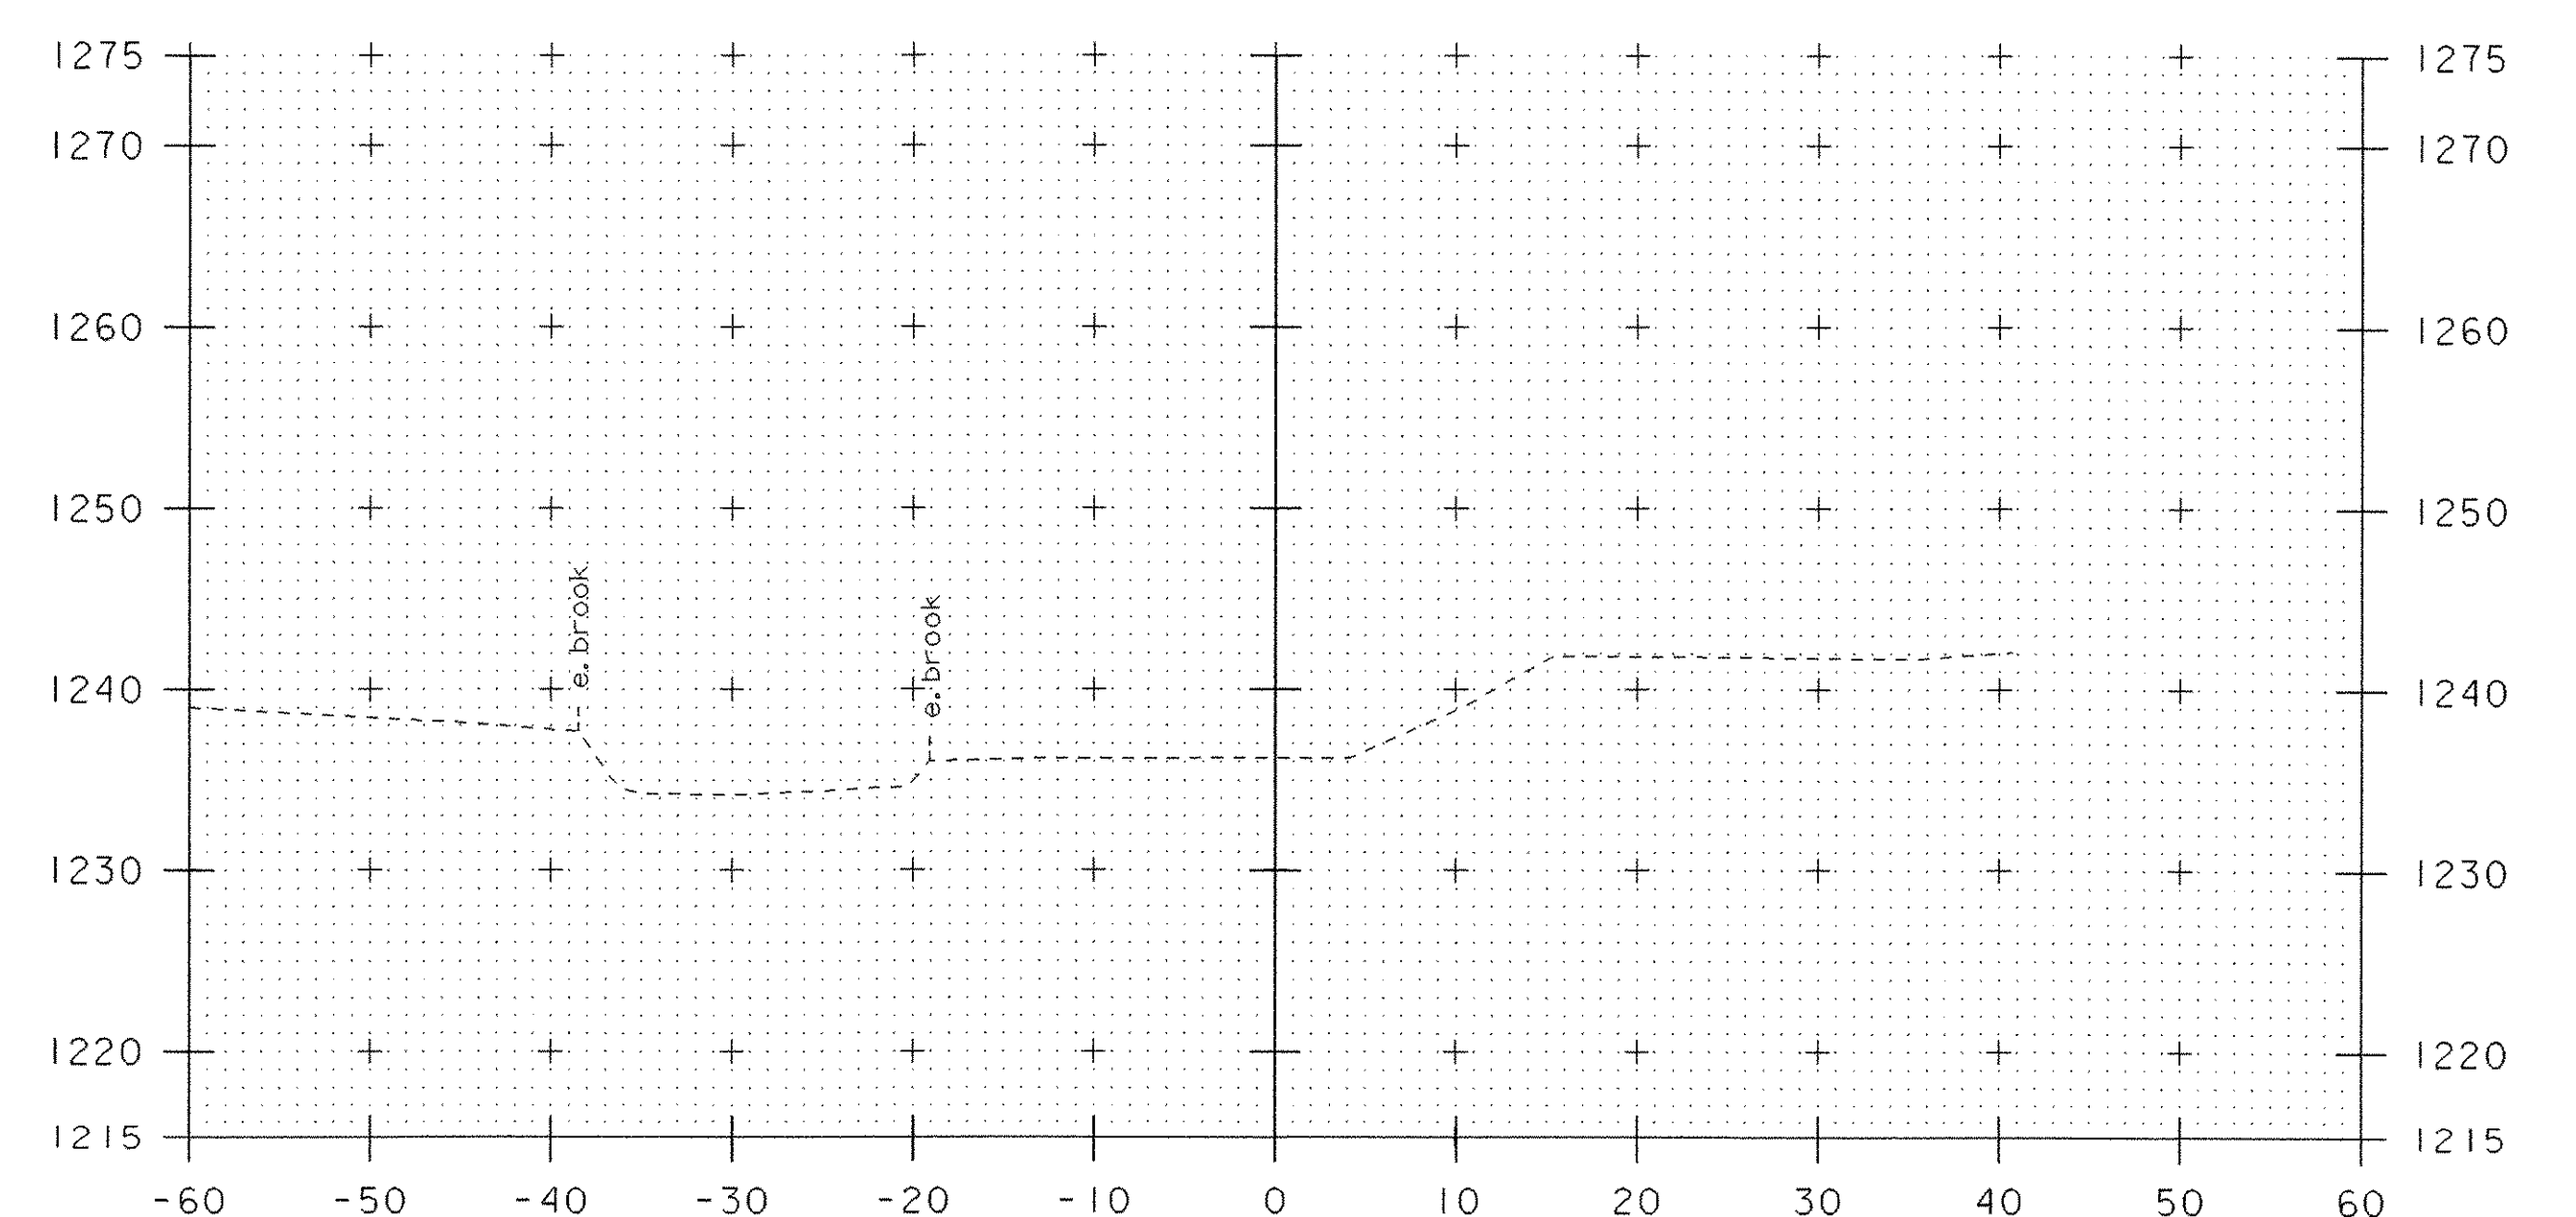

54+80

CHANNEL CROSS SECTIONS

PROJECT NAME:	JAY	FILE NAME:	04bl40\s04bl40bdr.dgn	PLOT DATE:	23-OCT-2006
PROJECT NUMBER:	ST STP CULV (2)	PROJECT LEADER:	W. SYMONDS	DRAWN BY:	G. SHANGRAW
		DESIGNED BY:	T. SUMNER	CHECKED BY:	J. LACROIX
			04bl40chxs4.i	SHEET	39 OF 39

RECEIVED

OK'D BY JEL OK'D BY _____

MAY 25 2007

RESUBMIT _____ APPROVED 5/29/07

BY _____ DATE _____

Project Number: 2007.004.002
Page 1 of 11

DESIGN COMPUTATIONS FOR

**VT 105, Bridge #50
15'-0" x 9'-0" Box Culvert
Jay, Vermont
County of Orleans
(Wingwalls Revised 5/24/07)**


PREPARED FOR:

**Camp Precast Concrete Products
78 Precast Road
Milton, Vermont 05468**

PREPARED BY:



184 Court Street, Binghamton, New York 13901
TEL: 607-231-6600 FAX: 607-231-6650
EMAIL: precast@deltaengineers.com
INTERNET: www.deltaengineers.com

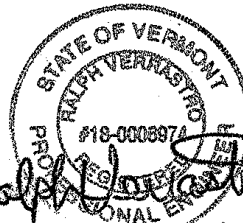

5-24-07

BOXCAR

Version 2.00 for Windows
12 May 2000

A Computer Program for the Structural
Design of Reinforced Concrete Box
Culverts

Developed by

Simpson Gumpertz & Heger Inc.
Arlington Massachusetts
in cooperation with

The Federal Highway Administration
and
The American Concrete Pipe Association

The successful application and use of this software product
is dependent on the application of skilled engineering
judgment and is the responsibility of the user. The user
must select input values suitable to his specific
installation. The information presented in the computer
output is for review, interpretation, application and
approval by a qualified engineer.

ANY IMPLIED OR EXPRESS WARRANTIES COVERING THE
SOFTWARE PROGRAM OR PROGRAM USER MANUAL INCLUDING
ANY WARRANTIES OF MERCHANTABILITY OR FITNESS FOR A
PARTICULAR PURPOSE ARE EXPRESSLY EXCLUDED. SIMPSON
GUMPERTZ & HEGER INC., THE AMERICAN CONCRETE PIPE
ASSOCIATION, AND THE FEDERAL HIGHWAY ADMINISTRATION
SHALL NOT BE LIABLE FOR SPECIAL, INCIDENTAL, CONSEQUENTIAL
INDIRECT OR OTHER SIMILAR DAMAGES ARISING FROM BREACH
OF WARRANTY, BREACH OF CONTRACT OR OTHER LEGAL THEORY
EVEN IF SUCH PARTIES HAVE BEEN ADVISED OF SUCH DAMAGES.

Date: 05-10-2007
Time: 09:31:23

Filename - 070402

Job Description - 15'x9' Box Culvert

GEOMETRY

Span	15. ft	Top Slab Thickness	12. in.
Rise	9. ft	Bottom Slab Thickness	12. in.
Min. Depth of Fill	11. ft	Sidewall Thickness	10. in.
Max. Depth of Fill	11. ft	Length of Precast	6.25 ft
Depth Increment	0. ft	Section	

HAUNCH DIMENSIONS

Top Vertical	8. in.
Top Horizontal	8. in.
Bottom Vertical	8. in.
Bottom Horizontal	8. in.

CONCRETE COVERS

Top Outside	1.00 in.
Bottom Outside	1.00 in.
Sidewall Outside	1.00 in.
Top Inside	1.00 in.
Bottom Inside	1.00 in.
Sidewall Inside	1.00 in.

MATERIAL PROPERTIES

Main Reinforcing Yield Stress	60000. psi
Design Concrete Strength	5000. psi
Concrete Density	150. pcf

DESIGN SPECIFICATION

AASHTO Standard

LOAD FACTORS

Dead Load: Shear and Moment	1.30
Thrust	1.00
Live Load: Shear and Moment	2.17
Thrust	1.00

LOAD MODIFIERS

Dead Load: Shear and Moment	1.00
Thrust	1.00
Live Load: Shear and Moment	1.00
Thrust	1.00

STRENGTH REDUCTION FACTORS

Flexure	0.90
Shear	0.85

REINFORCING DATA

	DIAMETER	SPACING
Top Slab Outside Face(AS7)	0.5 in.	8 in.
Bottom Slab Outside Face(AS8)	0.5 in.	8 in.
Sidewall Outside Face(AS1)	1 in.	9 in.
Top Slab Inside Face(AS2)	1.128 in.	7 in.
Bottom Slab Inside Face(AS3)	1 in.	6 in.
Sidewall Inside Face(AS4)	0.5 in.	10 in.

The diameters are used to estimate depth to tension reinforcing from compression face. They do not represent required reinforcing diameters.

SOIL LOAD DATA

Soil Density	140 pcf
Minimum Lateral Pressure Coefficient	0.25
Maximum Lateral Pressure Coefficient	0.50
Installation Type	Embankment/Compacted
Soil-Structure Interaction Factor	1.132

LIVE LOAD DATA

Live Load	AASHTO HS-Series
Live Load Magnitude	25 US tons
Tire Footprint Length	.0 in.
Tire Footprint Width	.0 in.
Live Load Distribution Factor	1.75
Direction of travel	Parallel to span
Impact Factor	1.00
Lane Load	0.0 psf

SURCHARGE LOADS

Vertical Pressure	0.0 psf
Horiz. Pressure at Culvert Top	0.0 psf
Horiz. Pressure at Culvert Bottom	0.0 psf
Application Code	Additional Dead Load

FLUID LOADS

Depth of Fluid	9.0 ft
Fluid Density	62.5 pcf

BOX CULVERT DESIGN SUMMARY SHEET

15.00 ft Span x 9.00 ft Rise

I N S T A L L A T I O N D A T A

Height of Fill Over Culvert, ft	11.00
Soil Unit Weight, pcf	140.
Minimum Lateral Soil Pressure Coefficient	0.250
Maximum Lateral Soil Pressure Coefficient	0.500
Soil-Structure Interaction Factor	1.132
Installation Type	Embankment/Compacted

L O A D I N G D A T A

Design Specification	AASHTO Standard
Dead Load Factor - Moment and Shear	1.30
Dead Load Factor - Thrust	1.00
Live Load Factor - Moment and Shear	2.17
Live Load Factor - Thrust	1.00
Dead Load Modifier - Moment and Shear	1.00
Dead Load Modifier - Thrust	1.00
Live Load Modifier - Moment and Shear	1.00
Live Load Modifier - Thrust	1.00
Strength Reduction Factor-Flexure	0.90
Strength Reduction Factor-Diagonal Tension	0.85
Live Load	
Live Load Type	AASHTO HS-Series
Live Load Magnitude, US tons	25.
Tire Footprint Length, in.	1.0
Tire Footprint Width, in.	1.0
Live Load Distribution Factor	1.75
Direction of travel	Parallel to span
Impact Factor	1.00
Lane Load, psf	0.0

M A T E R I A L P R O P E R T I E S

Minimum Specified Reinforcing Yield Strength, ksi	60.0
Concrete - Specified Compressive Strength, ksi	5.0

G E O M E T R Y

Top Slab Thickness, in.	12.0
Side Wall Thickness, in.	10.0
Bottom Slab Thickness, in.	12.0
Top Horizontal Haunch Dimension, in.	8.0
Bottom Horizontal Haunch Dimension, in.	8.0
Top Vertical Haunch Dimension, in.	8.0

G E O M E T R Y (Continued)


Bottom Vertical Haunch Dimension, in.	8.0
Concrete Cover Over Steel, in.	
Top Slab - Outside Face	1.00
Bottom Slab - Outside Face	1.00
Side Wall - Outside Face	1.00
Top Slab - Inside Face	1.00
Bottom Slab - Inside Face	1.00
Side Wall - Inside Face	1.00

R E I N F O R C I N G D A T A

LOCATION	AREA (in. ² /ft)	STIRRUPS REQUIRED?
TRANSVERSE		
Side Wall - Outside Face (AS1)	1.012	No
Top Slab - Inside Face (AS2)	1.643	No
Bottom Slab - Inside Face (AS3)	1.574	No
Side Wall - Inside Face (AS4)	0.240	No
Top Slab - Outside Face (AS7)	0.288	No
Bottom Slab - Outside Face (AS8)	0.288	No

Notes:

- 1 Sidewall outside face steel (AS1) is bent at the culvert corners and extended 27 in. from the bend point into the top slab. The top slab outside face steel (AS7) must lap the AS1 steel in accordance with AASHTO provisions for tension lap splices. To obtain the total AS1 extension into the top slab, the tension lap splice length must be calculated and added to the 27 in. extension length.
- 2 Sidewall outside face steel (AS1) is bent at the culvert corners and extended 27 in. from the bend point into the bottom slab. The bottom outside face steel (AS8) must lap the AS1 steel in accordance with AASHTO provisions for tension lap splices. To obtain the total AS1 extension into the bottom slab, the tension lap splice length must be calculated and added to the 27 in. extension length.
- 3 There may be negative moment from the outside corner of the box to 34 in. across the top slab
- 4 There may be negative moment from the outside corner of the box to 37 in. across the bottom slab.
- 5 BOXCAR does not check for differential deflection of the top slab between adjacent box sections for service live load.

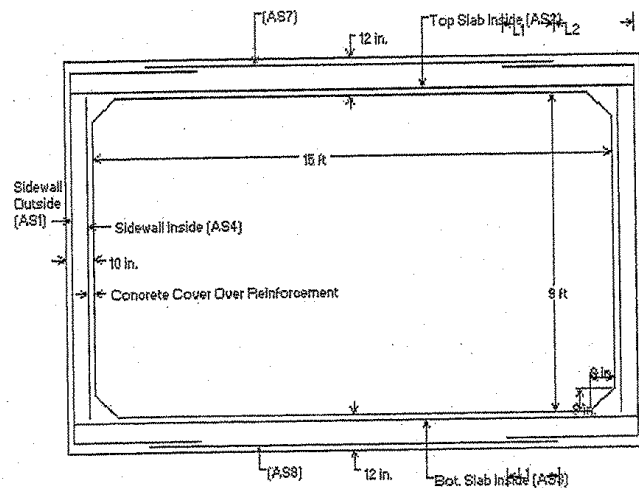

- * <L1> is Splice Length
- * <L2> is AS1 Extension
- * (AS7) is Top Slab Outside
- * (AS8) is Bottom Slab Outside
- * See Box Culvert Design Summary Sheet for transverse and distribution reinforcement, as required.
- * For sidewall thicknesses of 6 in. and above, extend AS2 and AS3 a min. of 4 in. beyond the inside face of the sidewall. For thicknesses less than 6 in., extend AS2 and AS3 at least to within 1-1/2 in. of the outside face of the sidewall.

Notes:

- 1) Other reinforcement schemes that provide the required reinforcement areas at all locations identified in the program output are acceptable.
- 2) Longitudinal reinforcement is not shown for clarity, see AASHTO M259 for longitudinal reinforcement and for additional requirements.

DESIGN DATA

SOIL

Soil Density= 140 pcf
Soil Friction Angle (Phi)= 34 deg.
Angle of wall friction (delta)= 22 deg.
Back slope angle (beta)= 21 deg.
Broken backslope angle (beta')= 21 deg.
Slope - Back face of wall= 90 deg.
Allowable Bearing Capacity= 4000 psf
Ka= 0.3458
KaH= 0.3206
KaV= 0.1295
EP= 48.41
EP(H)= 44.88
EP(V)= 18.13

WALL GEOMETRY

Stem Height hs= 10.50 ft
Stem Thickness ts= 10.00 in
Base Thickness tb= 18.00 in
Toe Width lt= 1.00 ft
Heel Width lh= 6.5 ft
Surcharge hsc= 0 ft

Wall Height-H= 12.00 ft
Total Base Width Lb= 8.33 ft
Weight of Wall & Slab = 3188 lbs/ft
Bar cover stem = 1.5 in
Bar cover toe/heel = 1.5 in
Height at back of soil wedge Ht = 14.50 ft

ACTIVE FORCES

Pq(H)= 0.00
Pa(H)= 4715.31 lb/ft

Moment Arm

7.25
4.83 ft

Overturning Mom., Mo=

Moment

0.00 ft-lbs/ft
22782.97 ft-lbs/ft
22782.97 ft-lbs/ft

RETAINING FORCES

Stem Wall - w1= 1312.50 lbs
Base Slab - w2= 1875.00 lbs
Soil above heel - w3= 9555.00 lbs
Soil wedge - w4= 1135.28 lbs
PaV= 1905.11 lb/ft
Total W= 15782.89 lbs

Safety factor against overturning=

1.42 ft
4.17 ft
5.08 ft
6.17 ft
8.33 ft

Resisting Mom., Mr=

1859.38 ft-lbs/ft
7812.50 ft-lbs/ft
48571.25 ft-lbs/ft
7000.88 ft-lbs/ft
15875.89 ft-lbs/ft
81119.90 ft-lbs/ft

3.56 OK

RESULTANT OF WALL FORCES


Sum of vertical forces Rv= 15783 lbs
Resultant location a= 3.70 ft
Eccentricity e= 0.47 ft L/6= 1.39
Pressure at toe of wall= Resultant in middle third
P1 2535.47 psf OK
P2 1252.42 psf

CHECK SLIDING

Sliding Coeff. = 0.45
Safety Factor, Sliding = 1.51 OK

Project: County of Orleans V7105
15' x 9' Culvert
Client: Camp Precast
Job Number: 2007.004.002
File Name: Cantwall.xls
Entered By: CJB / 5/26
Checked By: KES
Date: 5/24/2007
Sheet: 9 of 11

Denotes input field

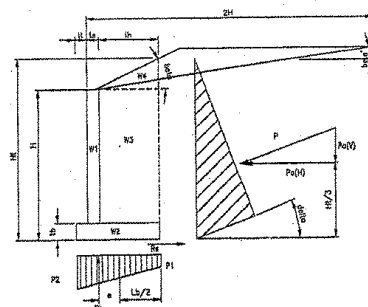

Delta Engineers, PC
184 Court Street
Binghamton, NY 13901
(607)231-6600 Fax (607)231-6650

REINFORCING DESIGN

TECHNICAL DATA

Concrete Strength	5	ksi
Yield Strength	60	ksi
Unit Weight of Concrete	150	pcf
E	4.03E+06	
n	7.2	
k	0.403	
j	0.866	
K	392	

Capacity Reduction Factors:

Phi - Moment	0.9
Phi - Shear	0.85

Load Factors:

Gamma	1.3
Beta - LL	1.3
Beta - DL	1

References:

1. "Specifications for Highway Bridges, 17th Ed." - AASHTO
2. "Design Manual for Segmental Retaining Walls" - Concrete Masonry Association
3. "Building Code Requirements for Structural Concrete" - ACI 318.

Project:	County of Orleans VT105
	15' x 9' Culvert
Client:	Camp Precast
Job Number:	2007.004.002
File Name:	Cantwall.xls
Entered By:	CJB / 506
Checked By:	RC
Date:	5/24/2007
Sheet:	10 of 11

b1= 0.8 (.85-.05(fc-4))

Rho min	0.003333333 (200/Fy)
Rho max	0.025153061 (.75Rho-b)
Zmax	130 Severe Exposure

Delta Engineers, PC
184 Court Street
Binghamton, NY 13901
(607)231-6600 Fax (607)231-6650

Stem Vert. Moments.

Design Height, hw= 13.00 ft
Force, P1= 3789.89 lbs/ft
Cantilever Moment, Ma= 16416.69 ft-lbs/ft
Mu= 27.74
Stem d= 8.125 in

Project: County of Orleans VT105
15' x 9' Culvert
Client: Camp Precast
Job Number: 2007.004.002
File Name: Cantwall.xls
Entered By: CJB/SDG
Checked By: KE
Date: 5/24/2007
Sheet: 11 of 11

Trial Bar Size and Spacing As= 0.88 in.sq/ft.
Rho 0.009062287 Rho*n= 0.06520425
a=As*Fy/.85*fc*b 1.039 in
ΦMn 30.24 kip-ft
k= 0.302
j= 0.899
fs= 30.51 ksi
dc= 1.875 in
A= 22.5 sq.in
Z= 108.1 kips/in

> Mu(27.74 kip-ft) ,OK

Use # 6 @ 6 in

Heel Reinf.

Total Weight= 2044.32 lbs/ft
Design Span, s= 6.50 ft
Cantilever Mom., Mdl= 48105.72 ft-lbs/ft
Mu= 62.54
Heel d= 16.0625 in

Trial Bar Size and Spacing As= 1.20 in.sq/ft.
Rho 0.006239382 Rho*n= 0.04489311
a=As*Fy/.85*fc*b 1.415 in
ΦMn 83.10 kip-ft
k= 0.258
j= 0.914
fs= 32.70 ksi
dc= 1.9375 in
A= 23.25 sq.in
Z= 116.2 kips/in

Use # 7 @ 6 in

> Mu(62.54 kip-ft) ,OK

Toe Reinf.

Design Span, s= 1.00 ft.
Cantilever Mom., Mdl= 1242.08 ft-lbs/ft
Mu= 1.61
Toe d= 16.25 in

Trial Bar Size and Spacing As= 0.20 in.sq/ft.
Rho 0.001006921 Rho*n= 0.00724492
a=As*Fy/.85*fc*b 0.231 in
ΦMn 14.26 kip-ft
k= 0.113
j= 0.962
fs= 4.85 ksi
dc= 1.75 in
A= 42 sq.in
Z= 20.3 kips/in

Use # 4 @ 12 in

> Mu(1.61 kip-ft) ,OK

Check Shear Stresses

Stem wall Vu= 6404.92 lbs Vn= 11720.29 lbs
Heel Vu= 19554.49 lbs Vn= 23170.12 lbs

OK
OK

RECEIVED

OK'D BY JEL OK'D BY _____

MAY 25 2007

RESUBMIT _____ APPROVED 5/29/07 (As Noted)
BY WJW DATE _____

MANUFACTURED BY:



PRECAST INC.
78 PRECAST ROAD
MILTON, VERMONT 05468
PHONE(802)893-2401 FAX(802)893-1542

PROJECT:

VT 105, BRIDGE #50
15'-0" X 9'-0" BOX CULVERT
JAY, VT
COUNTY OF ORLEANS

PREPARED BY:



184 COURT STREET, BINGHAMTON, NY 13901
PHONE(607)231-6600 FAX(607)231-6650

ENGINEER OF RECORD:

STATE OF VERMONT
AGENCY OF TRANSPORTATION

DESIGN NOTES

AS PROVIDED BY EOR:

1. DESIGN PER AASHTO 17TH EDITION WITH HS-25 LOADING.
2. UNIT WEIGHT OF SOIL = 140 PCF
3. ALLOWABLE BEARING PRESSURE = 4000 PSF
4. DESIGN EARTH COVER = 11'

ASSUMPTIONS: (TO BE VERIFIED BY EOR)


1. f_c @ 28 DAYS = 5000 PSI
2. REINFORCEMENT = BAR PER ASTM A615, GRADE 60
3. COEFFICIENT OF SLIDING = 0.45
4. MATERIALS AND MANUFACTURING PER ASTM C1433.

GENERAL NOTES:

1. ALL EXPOSED EDGES OF CONCRETE & TOP SLAB EXTERIOR EDGES SHALL BE CHAMFERED 1"x1"
2. REINFORCING STEEL PLACEMENT TOLERANCE
A) SPACING: $\pm 1"$
B) CLEARANCE: $\pm \frac{1}{4}"$

DRAWING SCHEDULE

SHEET NO.	DESCRIPTION	REVISIONS	
		REV. NO.	DATE
1	COVER SHEET	1	5/21/07
2	PLAN VIEW, & ELEVATION VIEW	2	5/24/07
3	END VIEWS & WINGWALL SECTION	2	5/24/07
4	REINFORCING & CONNECTION DETAILS	1	5/21/07
5	WINGWALL DETAILS	2	5/24/07
6	WINGWALL DETAILS	2	5/24/07

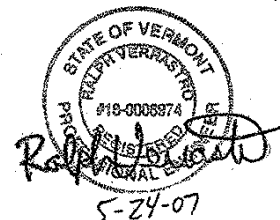

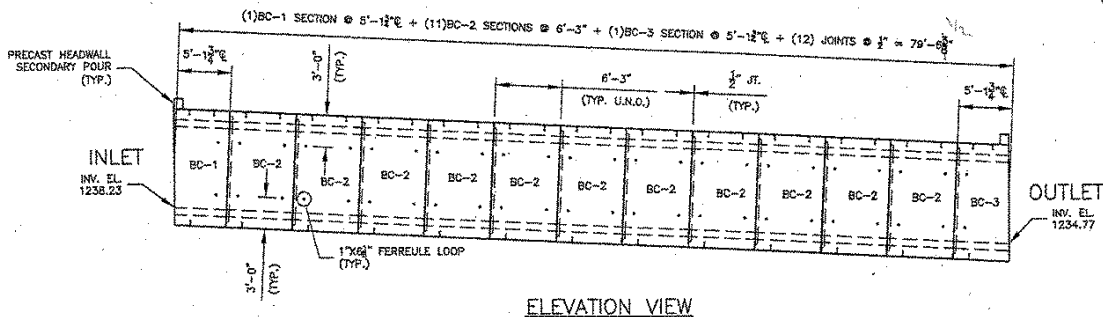
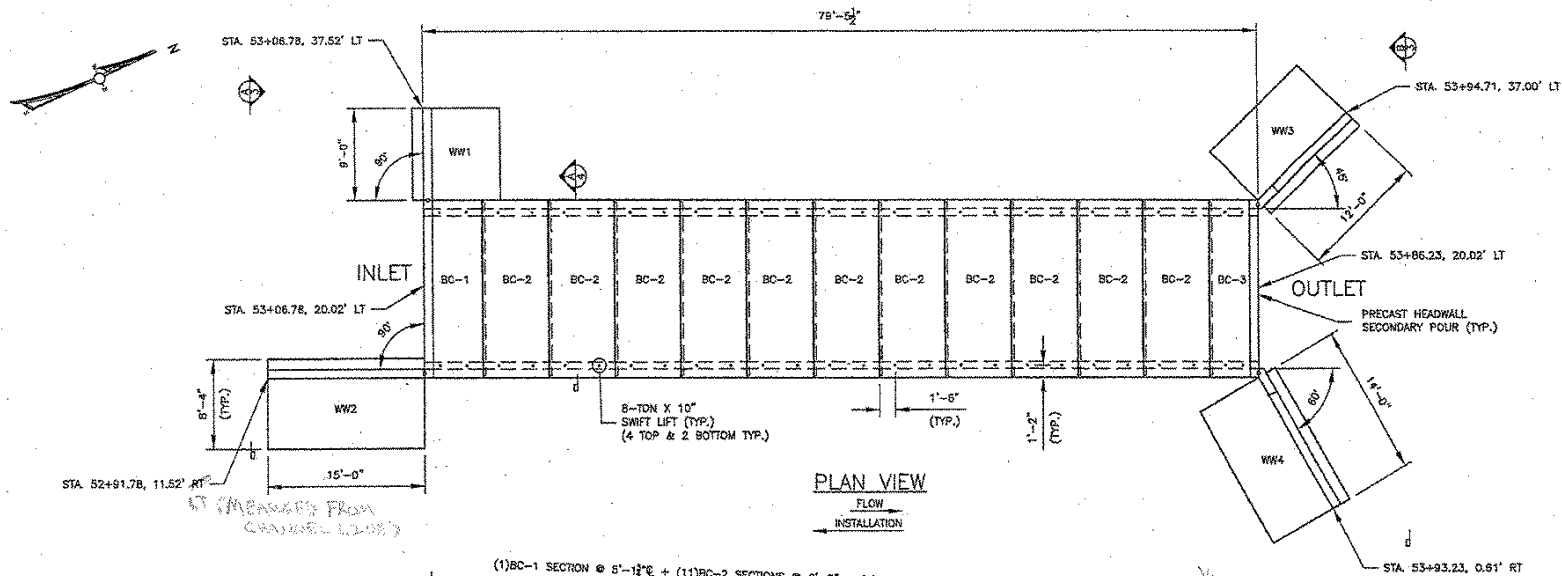


TABLE OF UNITS				
MARK	QTY	LENGTH	VOL. (CY)	WEIGHT (LBS)
BC-1	1	5'-1 1/2"	9.94	40,250
BC-2	11	6'-3"	11.39	46,150
BC-3	1	5'-1 1/2"	9.94	40,250
WW1	1	9'-0"	6.83	27,660
WW2	1	15'-0"	11.38	45,130
WW3	1	12'-0"	9.11	36,900
WW4	1	14'-0"	10.63	43,050


NOTE: CULVERT WEIGHTS INCLUDE HEADWALLS

RECEIVED
CK'D BY JEL OK'D BY _____

MAY 25 2007

RESUBMIT _____ APPROVED 5/29/07


BY SY DATE _____

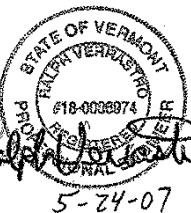


2	5/24/07	REVISED WINGWALLS
1	5/21/07	REVISED WINGWALLS
REV. NO.	DATE	REVISION

PREPARED BY: **DELTA ENGINEERS**
184 COURT STREET, BINGHAMTON, NY 13901
TEL: (607) 731-6500 FAX: (607) 731-6650


PREPARED FOR:	
CAMP PRECAST INC. 78 PRECAST ROAD MILTON, VERMONT 05468 PHONE (802) 893-2401 FAX (802) 893-1542	
DATE: 5/15/07	SAFETY TITLE: PLAN VIEW & ELEVATION VIEW
REASON: N.T.S.	DESIGN BY: CJB
PROJECT: VT 105, BRIDGE #50 15'-0" X 9'-0" BOX CULVERT JAY, VT	
CONTRACTOR:	SHEET NO. SD-61
THEIR PROJ. NO. 2007-004-002	SHEET NO. 2 OF 2

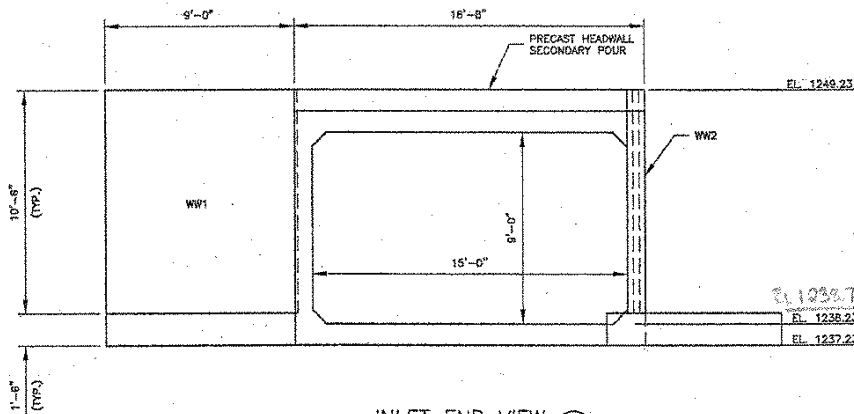

INLET END VIEW (A)

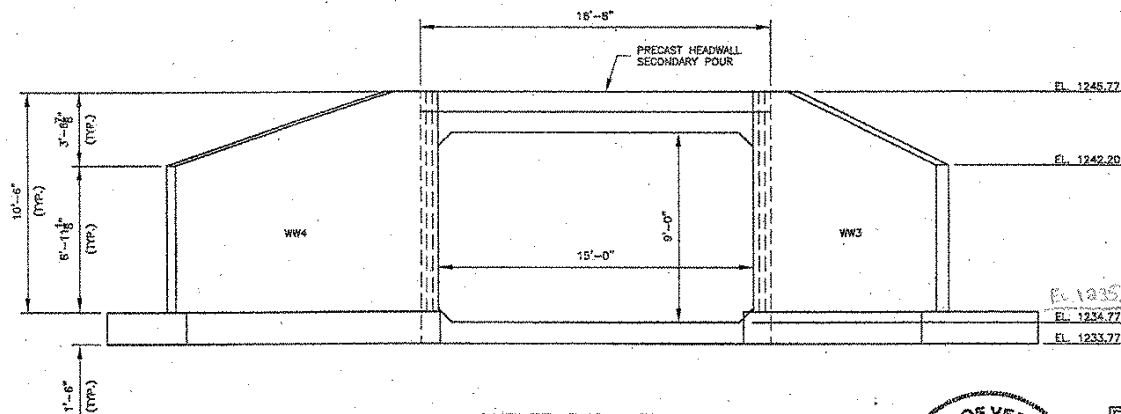


OUTLET END VIEW (B)

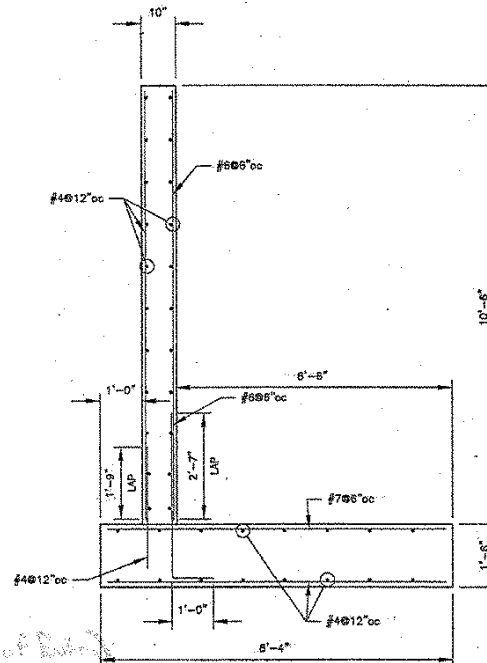


WINGWALL REINFORCING SECTION
(ALL COVER 1 1/2")


RECEIVED
OK'D BY JEL OK'D BY _____
MAY 25 2007
RESUBMIT _____ APPROVED 5/29/07 (As noted)
BY WJ DATE _____

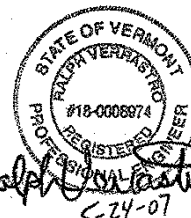


PREPARED BY: DELTA ENGINEERS 184 COURT STREET, BINGHAMTON, NY 13901 TEL: (607) 231-6800 FAX: (607) 231-6650		PREPARED FOR: PRECAST INC. 78 PRECAST ROAD MILTON, VERMONT 05468 PHONE: (802) 883-2401 FAX: (802) 883-1542	
REV. NO. 2 1	DATE 5/24/07 5/21/07	REVISION REVISED WINGWALLS REVISED WINGWALL DETAIL	DATE 5/15/07 N.T.S.
PROJECT: VT 105, BRIDGE #50 15'-0" X 9'-0" BOX CULVERT JAY, VT		DRAWN BY: CJB CHECKED BY: JEL	
CONTRACTOR: SD-01		DATE: 2007.004.002	

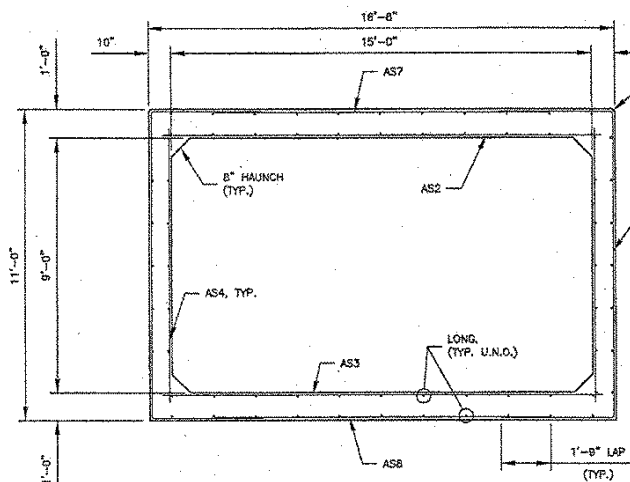

TYPICAL SECTION
(1' CLR. TYP.)

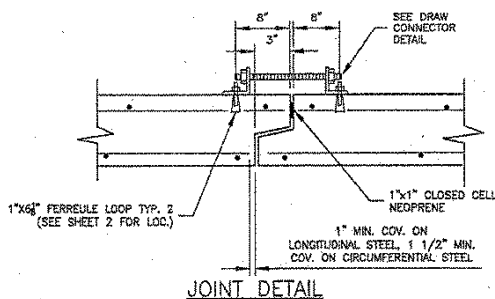


JOINT DETAIL

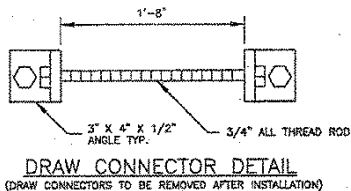


DRAW CONNECTOR DETAIL
(DRAW CONNECTORS TO BE REMOVED AFTER INSTALLATION)

BAR LIST									
MARK	SIZE	SPA	TYPE	LENGTH	A	B	C		
AS1	8	9"	"U"	18'-10"	4'-0"	10'-10"	4'-0"		
AS2	9	7"	STR.	15'-8"	---	---	---		
AS3	8	6"	STR.	18'-8"	---	---	---		
AS4	4	10"	STR.	9'-8"	---	---	---		
AS7	4	8"	STR.	12'-0"	---	---	---		
AS8	4	8"	STR.	12'-0"	---	---	---		
LONG.	4	12"	STR.	6'-1"	---	---	---		


NOTE: BAR LIST FOR STANDARD 6'-3" SECTIONS. ADJUST QTY'S & LENGTHS AS REQ'D FOR END SECTIONS

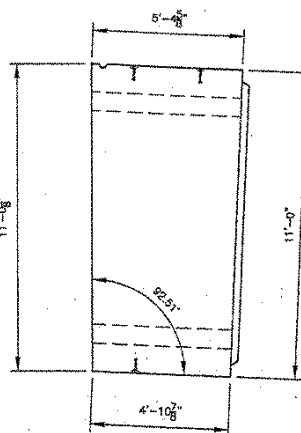

PIECEMARK BC-1
ELEVATION VIEW
(HEADWALL NOT SHOWN)

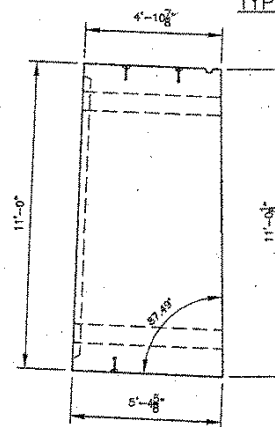

PIECEMARK BC-3
ELEVATION VIEW
(HEADWALL NOT SHOWN)

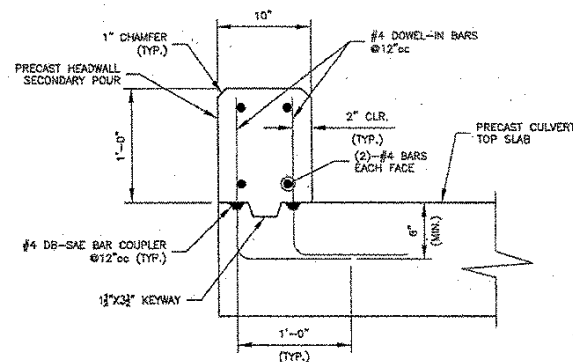

TYPICAL HEADWALL DETAIL


RECEIVED

CK'D BY JEL OK'D BY

MAY 25 2007


RESUBMIT APPROVED

BY DATE

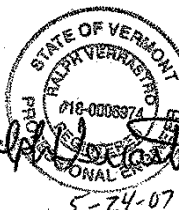


5-24-07


PREPARED FOR:		CAMP	
PRECAST INC.		78 PRECAST ROAD	
MILTON, VERMONT 05468		PHONE (802) 893-2401 FAX (802) 893-1542	
1	5/21/07	REVISED PER COMMENTS	
REV. NO.	DATE	REVISION	
PREPARED BY:		DELTA ENGINEERS	
194 COURT STREET, BINGHAMTON, NY 13901		TEL: (607) 231-6600 FAX: (607) 231-6850	
5/16/07		SHEET TITLE: REINFORCING & CONNECTION DETAILS	
SCALE: N.T.S.		DRAWN BY: CJB	
PROJECT: VT 105, BRIDGE #50		SHEET NO: 52	
15'-0" X 9'-0" BOX CULVERT		JAY, VT	
DRAWN BY: SD-01		SHEET NO: 4 OF 5	

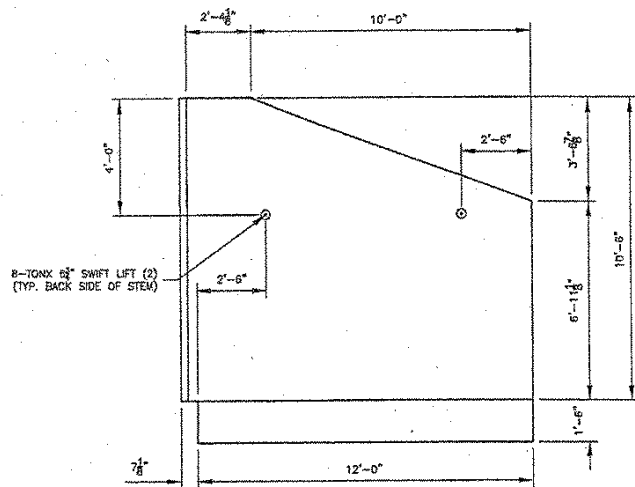


ELEVATION VIEW WW3

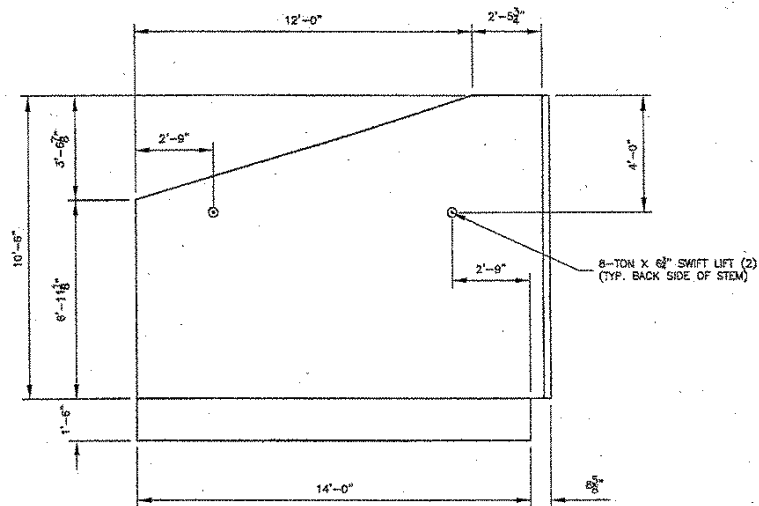

ELEVATION VIEW WW4

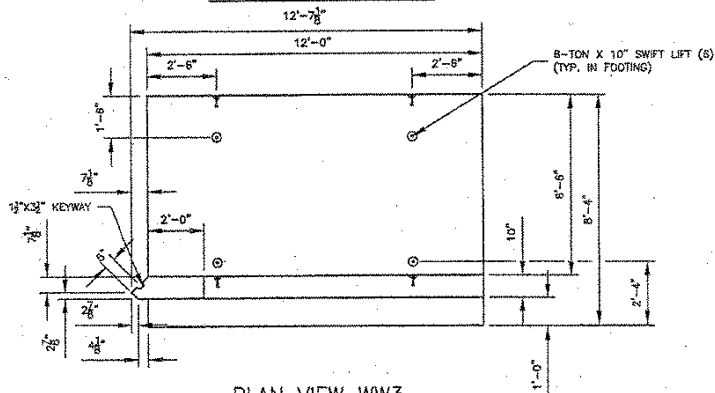

PLAN VIEW WW3

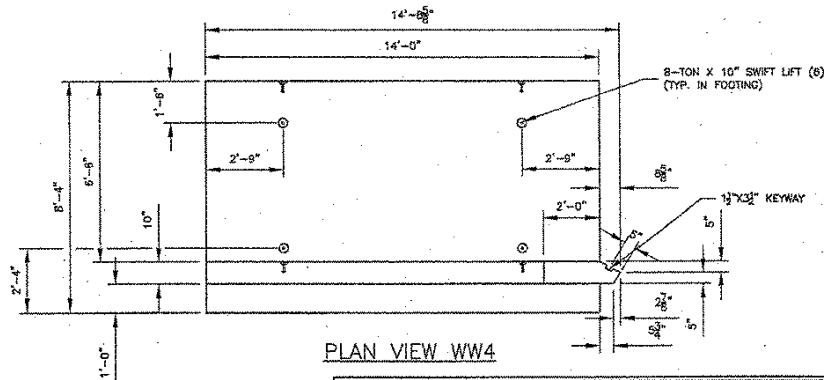

PLAN VIEW WW4


RECEIVED

CK'D BY JEL OK'D BY _____

MAY 25 2007

RESUBMIT _____ APPROVED 5/24/07

BY WY DATE _____

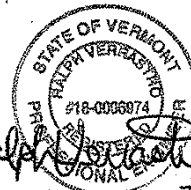

REV. NO.	DATE	REVISION
2	5/24/07	REVISED WINGWALLS
1	5/21/07	REVISED PER COMMENTS

PREPARED BY:

DELTA
ENGINEERS

184 COURT STREET, BINGHAMTON, NY 13901
TEL: (607) 731-6600 FAX: (607) 731-6600

PREPARED FOR:



PRECAST INC.
78 PRECAST ROAD
MILTON, VERMONT 05468
PHONE (802) 893-2401 FAX (802) 893-1542

DATE: 5/15/07 SHEET TITLE: WINGWALL DETAILS

SCALE: N.T.S.

PROJECT:

VT 105, BRIDGE #50
15'-0" X 9'-0" BOX CULVERT
JAY, VT

CONTRACTOR:

DELTA PROJ. NO.: 2007.004.002

DWG. NO.: SD-01

SHEET NO.: 5 OF 6