



DATE	BY	CHKD	APPROVED
PROJECT		SHEET NO.	
SHEET NO.		SHEET NO.	

DATE	BY	CHKD	APPROVED
PROJECT		SHEET NO.	
SHEET NO.		SHEET NO.	

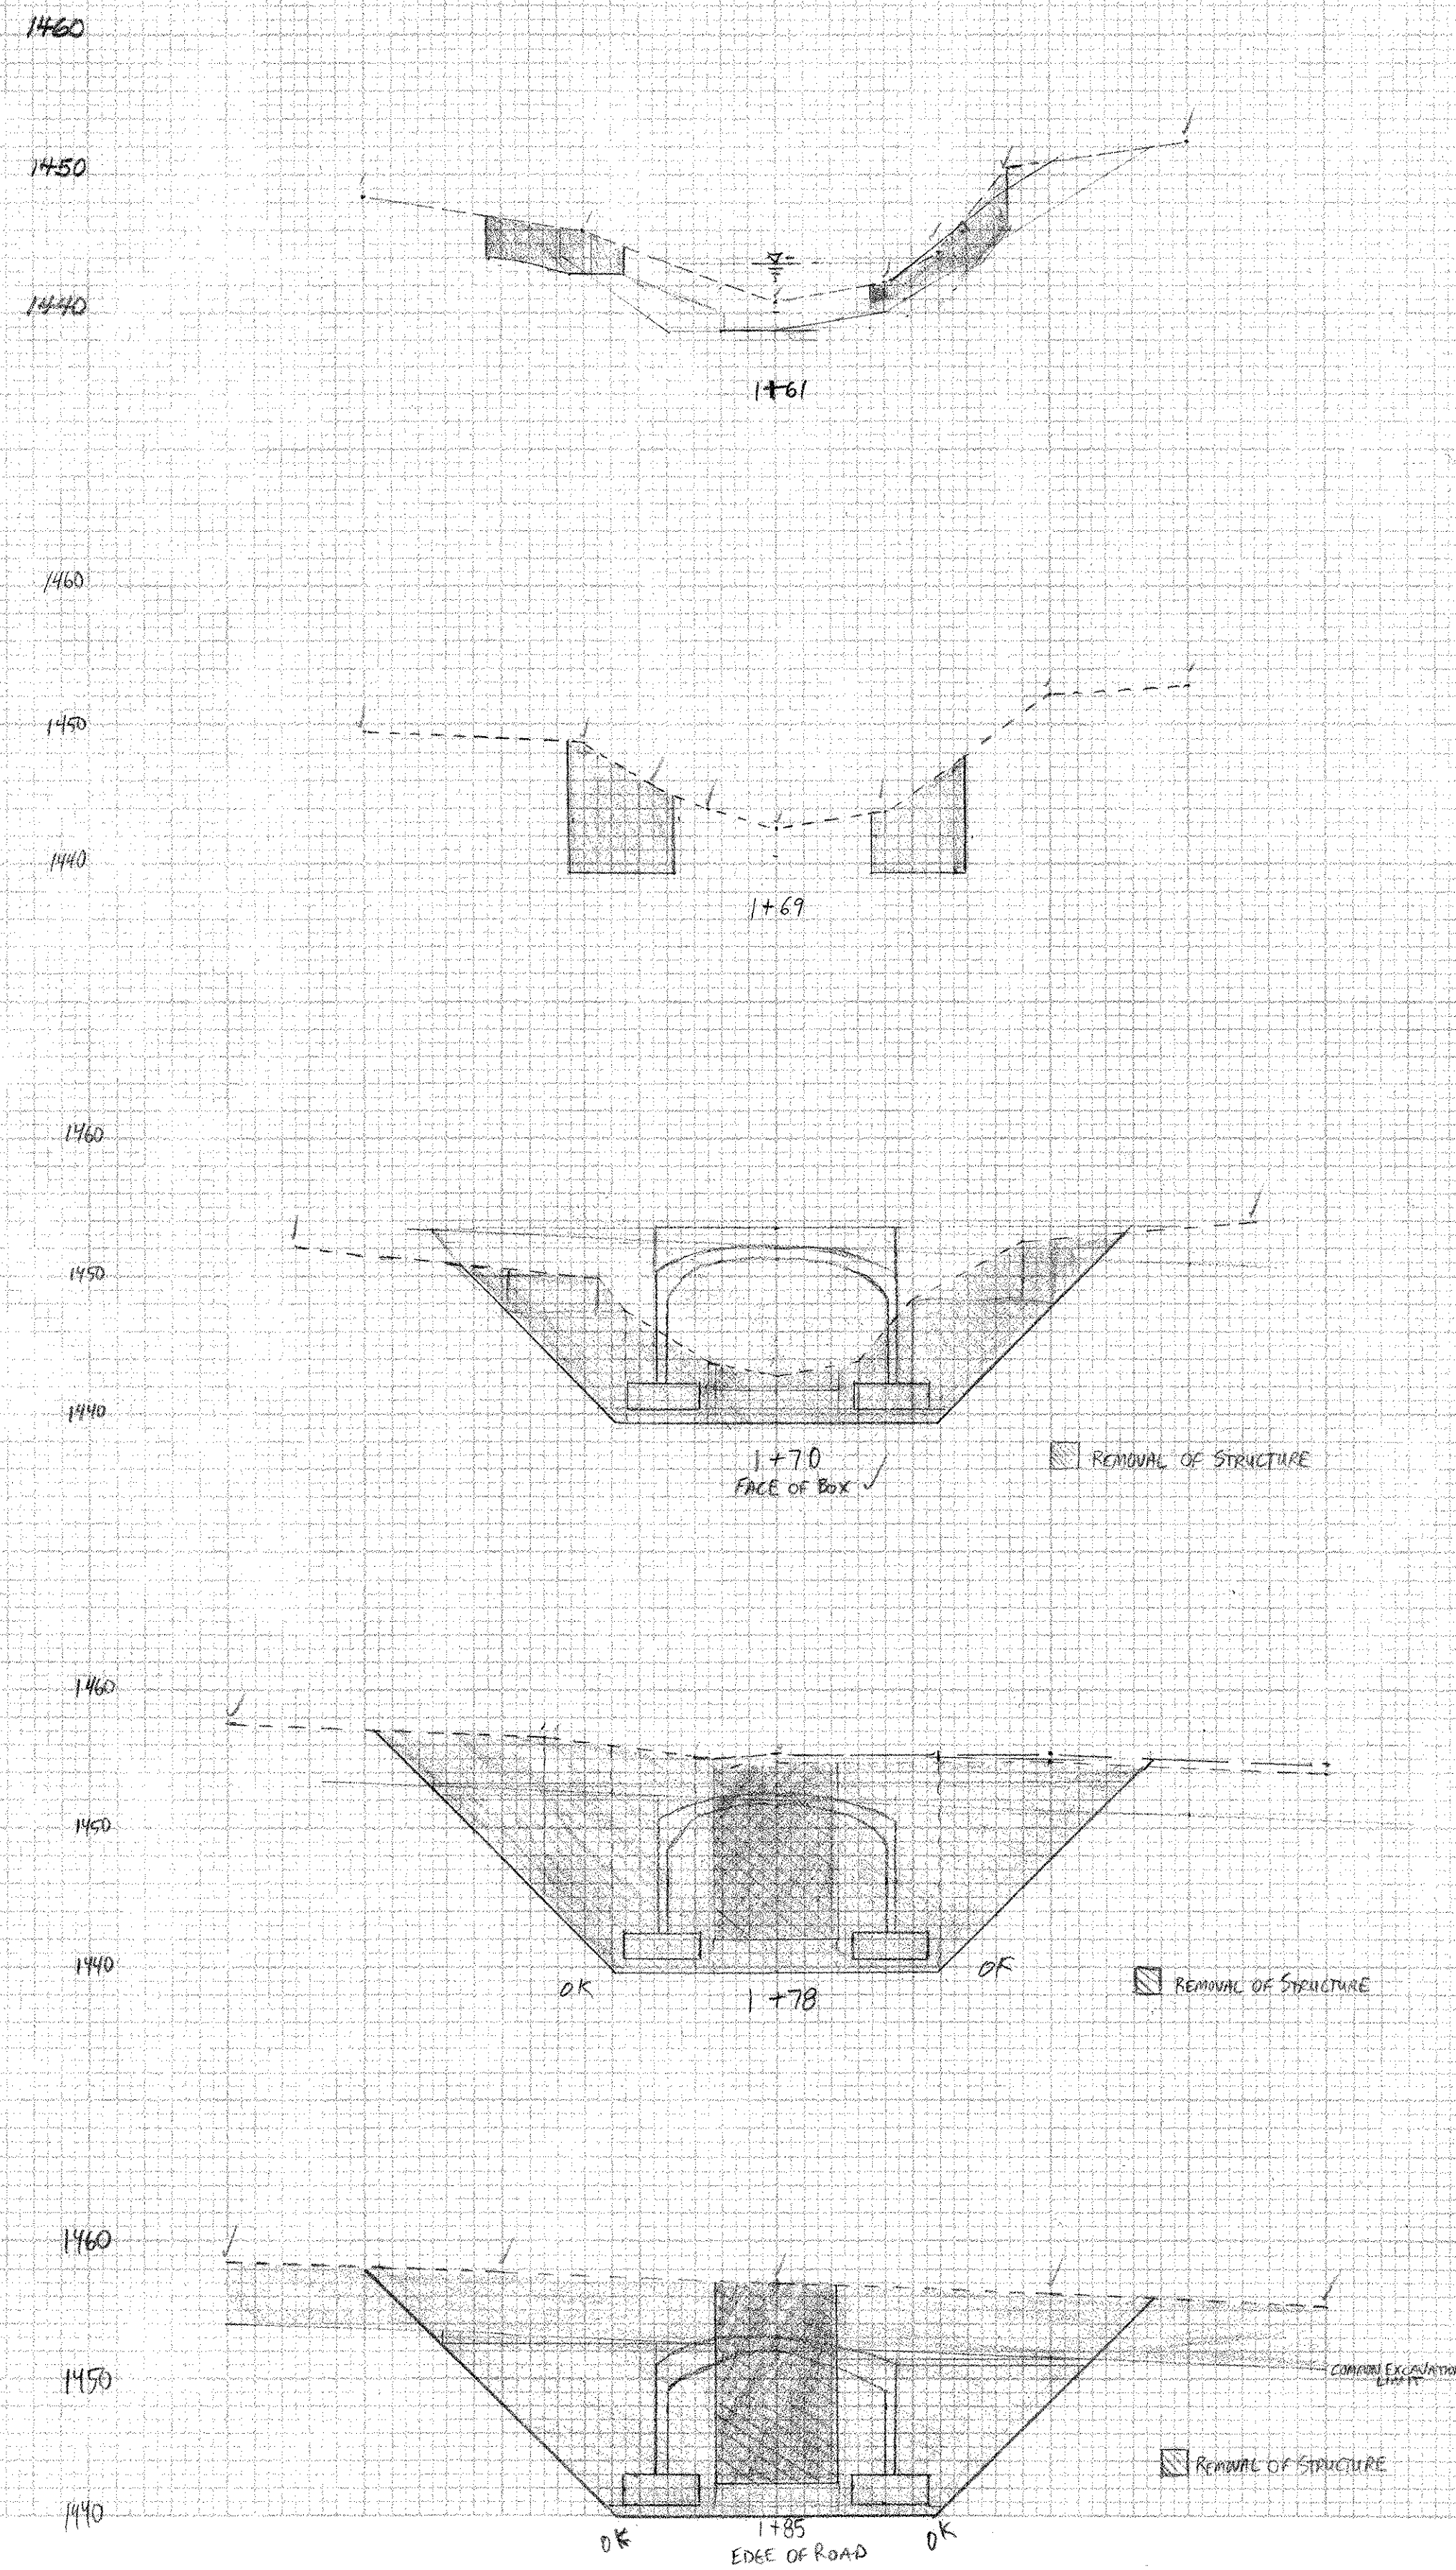

LEGEND

- STRUCTURE EXCAVATION
- WINGWALL EXCAVATION
- COMMON EXCAVATION
- REMOVAL OF STRUCTURE
- UNCLASSIFIED CHANNEL EXCAVATION

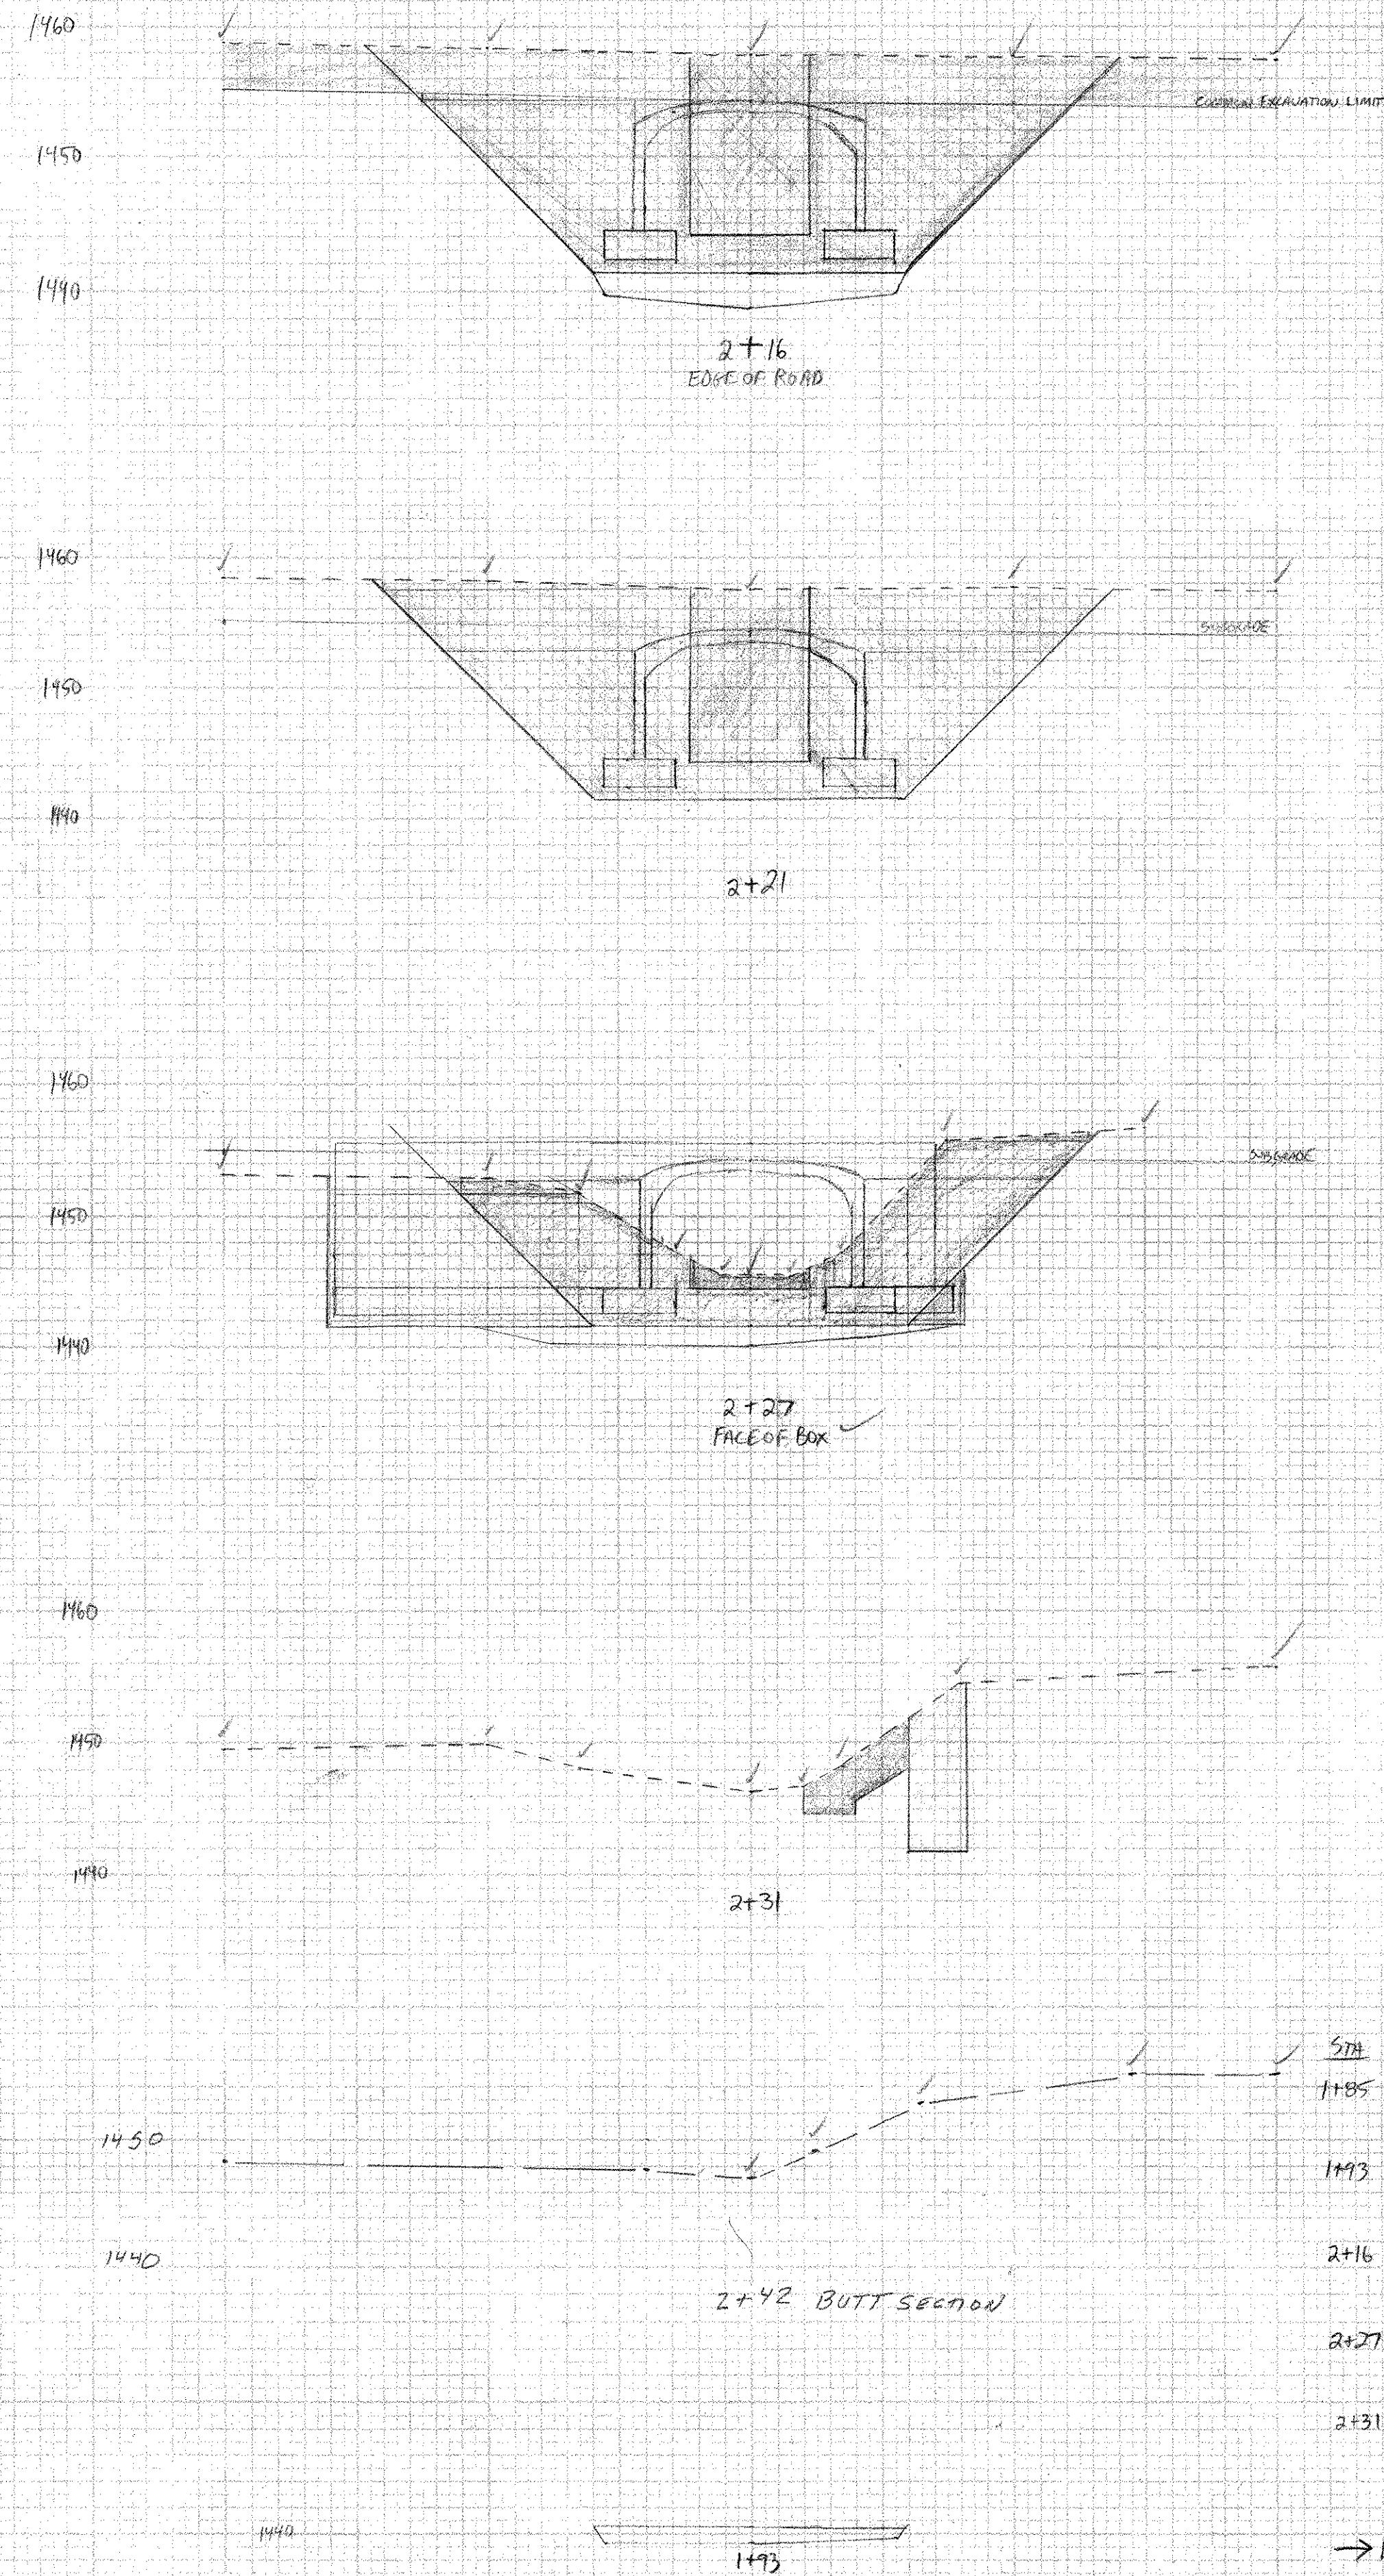

OVER EXCAVATION (EXTRA STRUCTURE EXCAVATION)				
STA	AREA	Avg AREA	LENGTH	VOLUME
1+85	0	13.23sf	8'	105.84cf
1+93	26.45sf	36.8sf	23'	846.4cf
2+16	47.15sf	42.18sf	11'	463.98cf
2+27	37.2sf	18.6sf	4'	74.4cf
2+31	0			
TOTAL = 1490.51cf = 55.2cy				
→ EXTRA SUBGRADE OF DENSE GRADED CRUSHED STONE = 55.2cy				

3000 2130B
(1) 1111 12972