


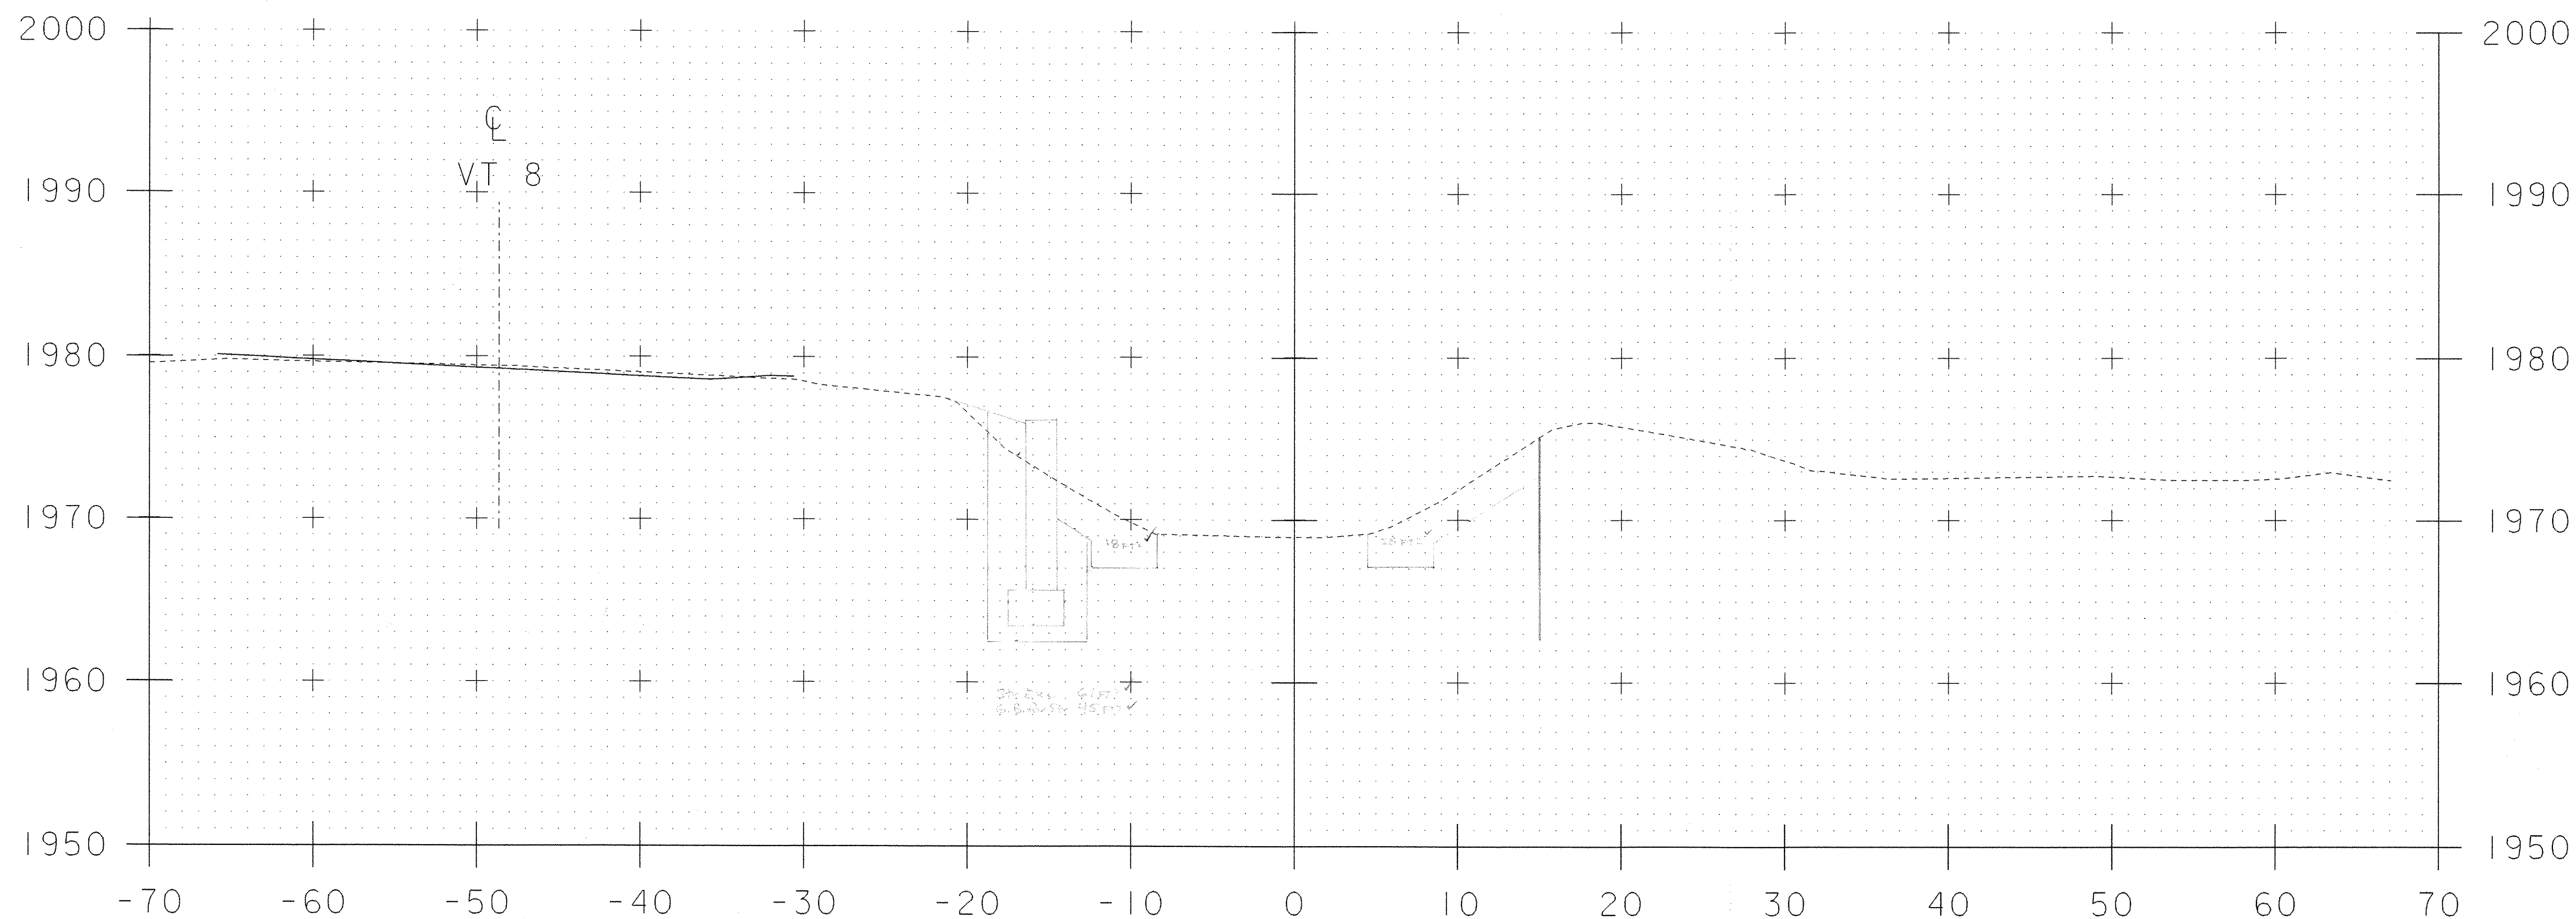

10+51

Sheet # 5 of 22

SCALE 1" = 5'-0"
5 0 5

PROJECT: READSBORO	PROJECT NO.: ST CULV (4)
DESIGN FILE NAME: 04c176/structures/s04c176resident.dgn	PLOT DATE: 19-APR-2007
IPARM FILE NAME: s04c176res5.i	DESIGNED BY: E.L.RUSTAY
SQUAD LEADER: C.P.WILLIAMS	DRAWN BY: E.L.RUSTAY
RE CHAN STA. 10+51.00	CHECKED BY:
	SHEET: 27 OF 39