




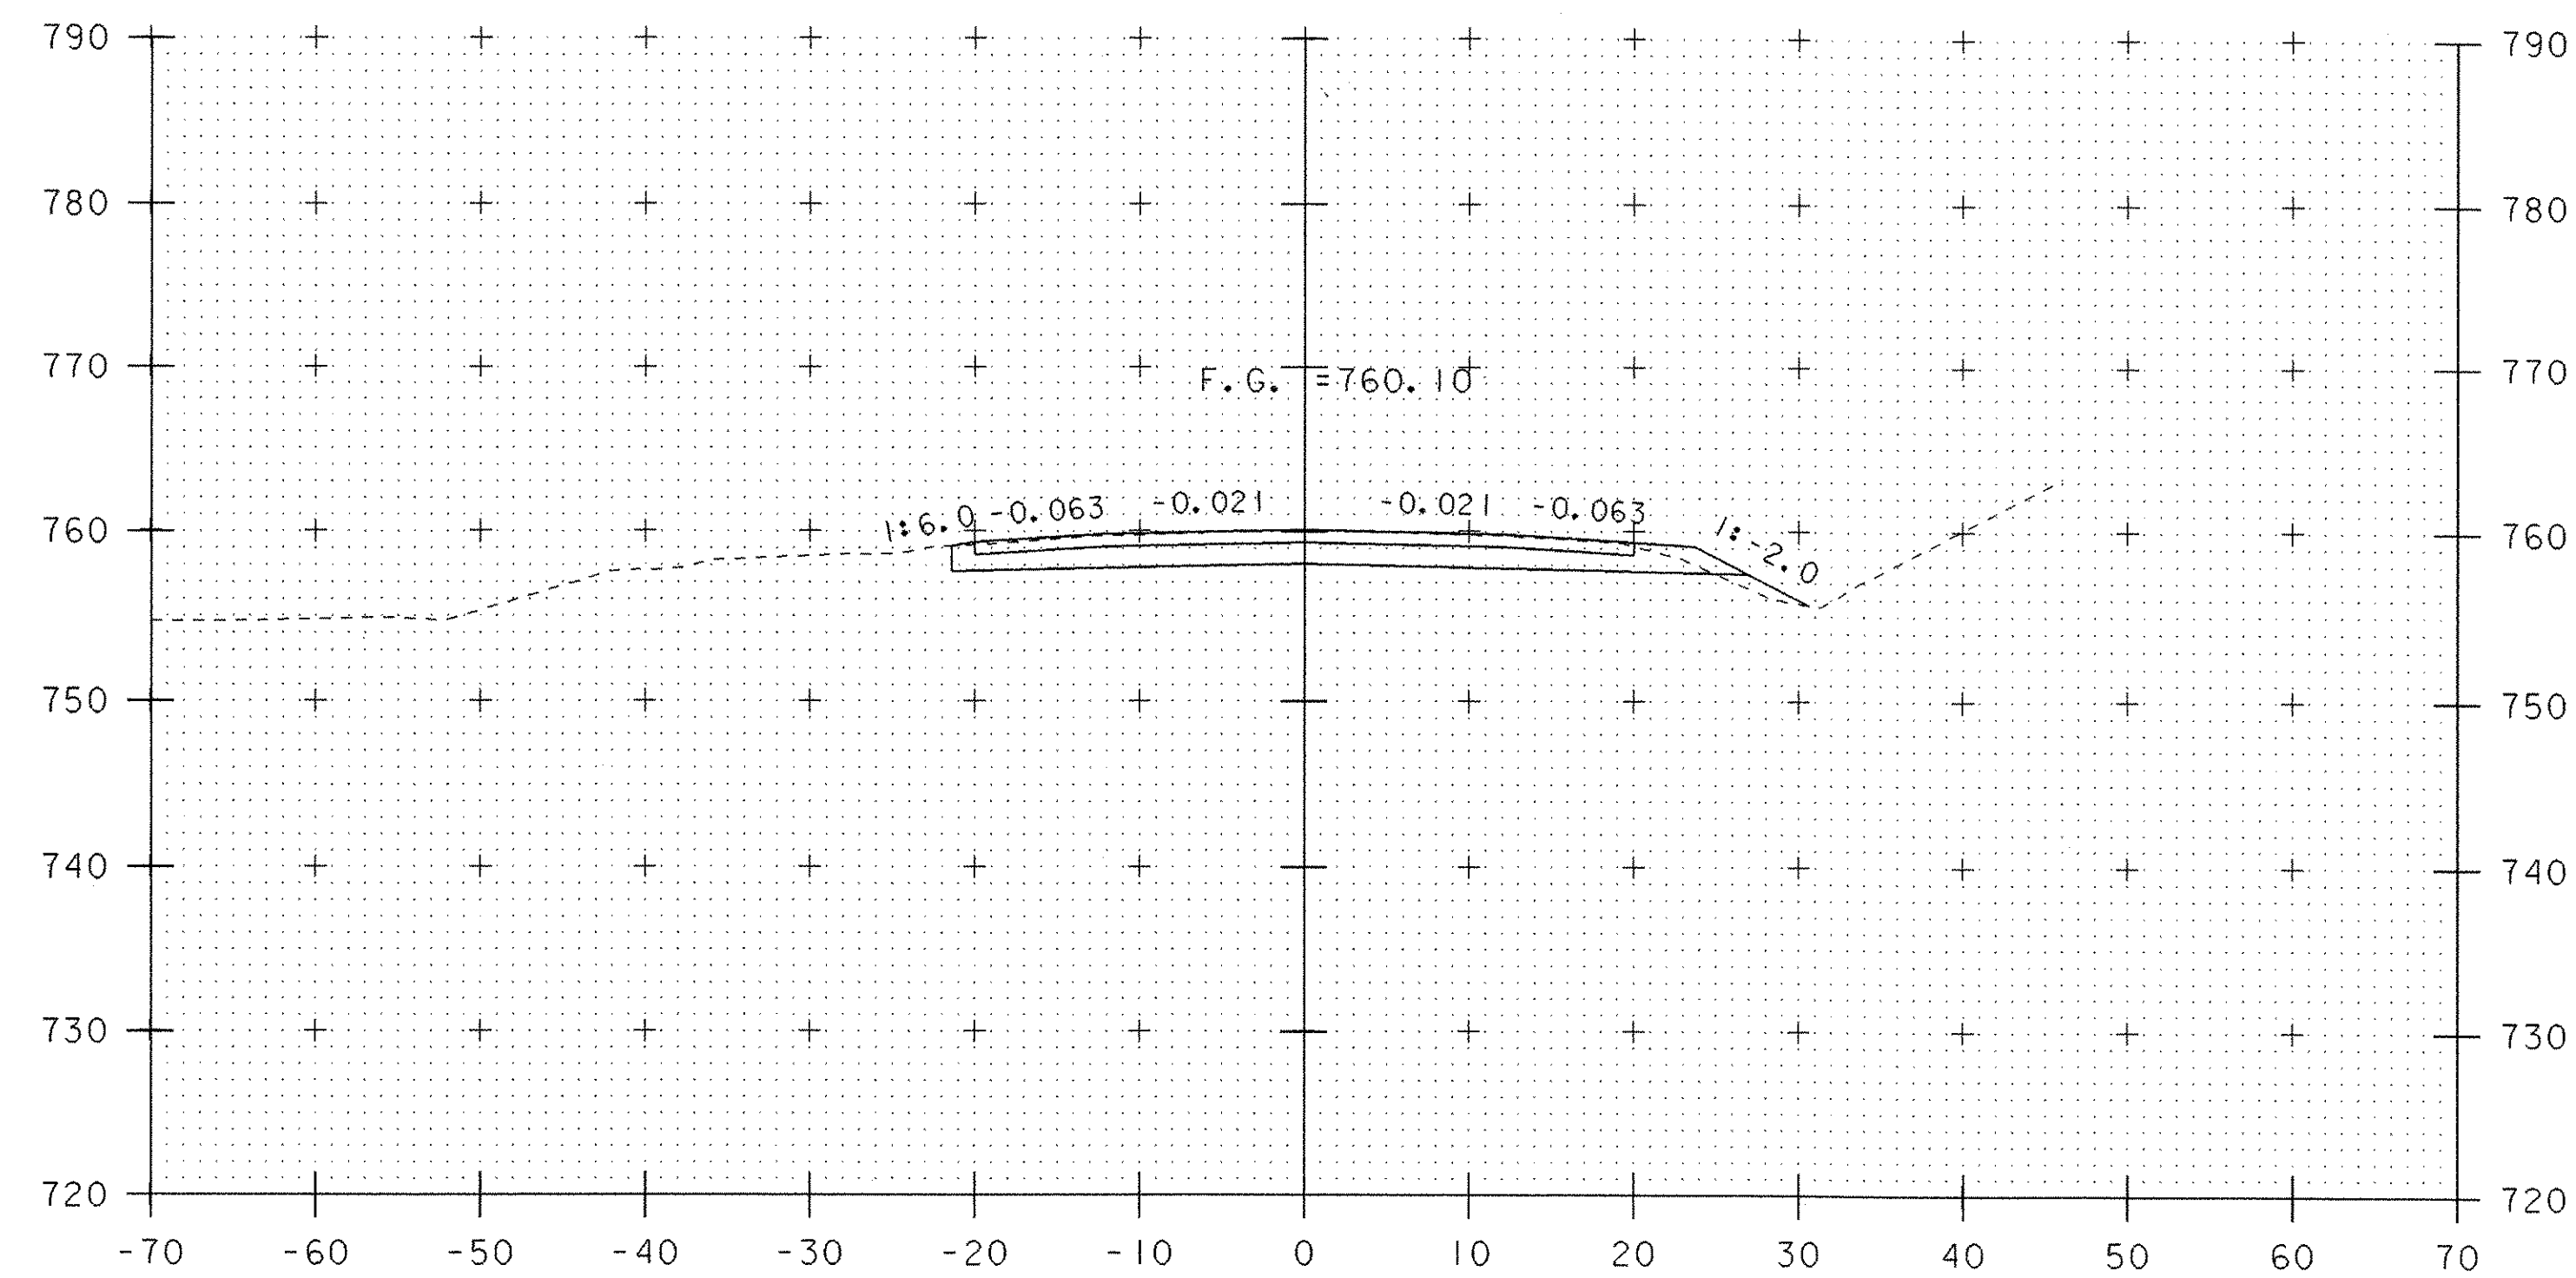


13+25

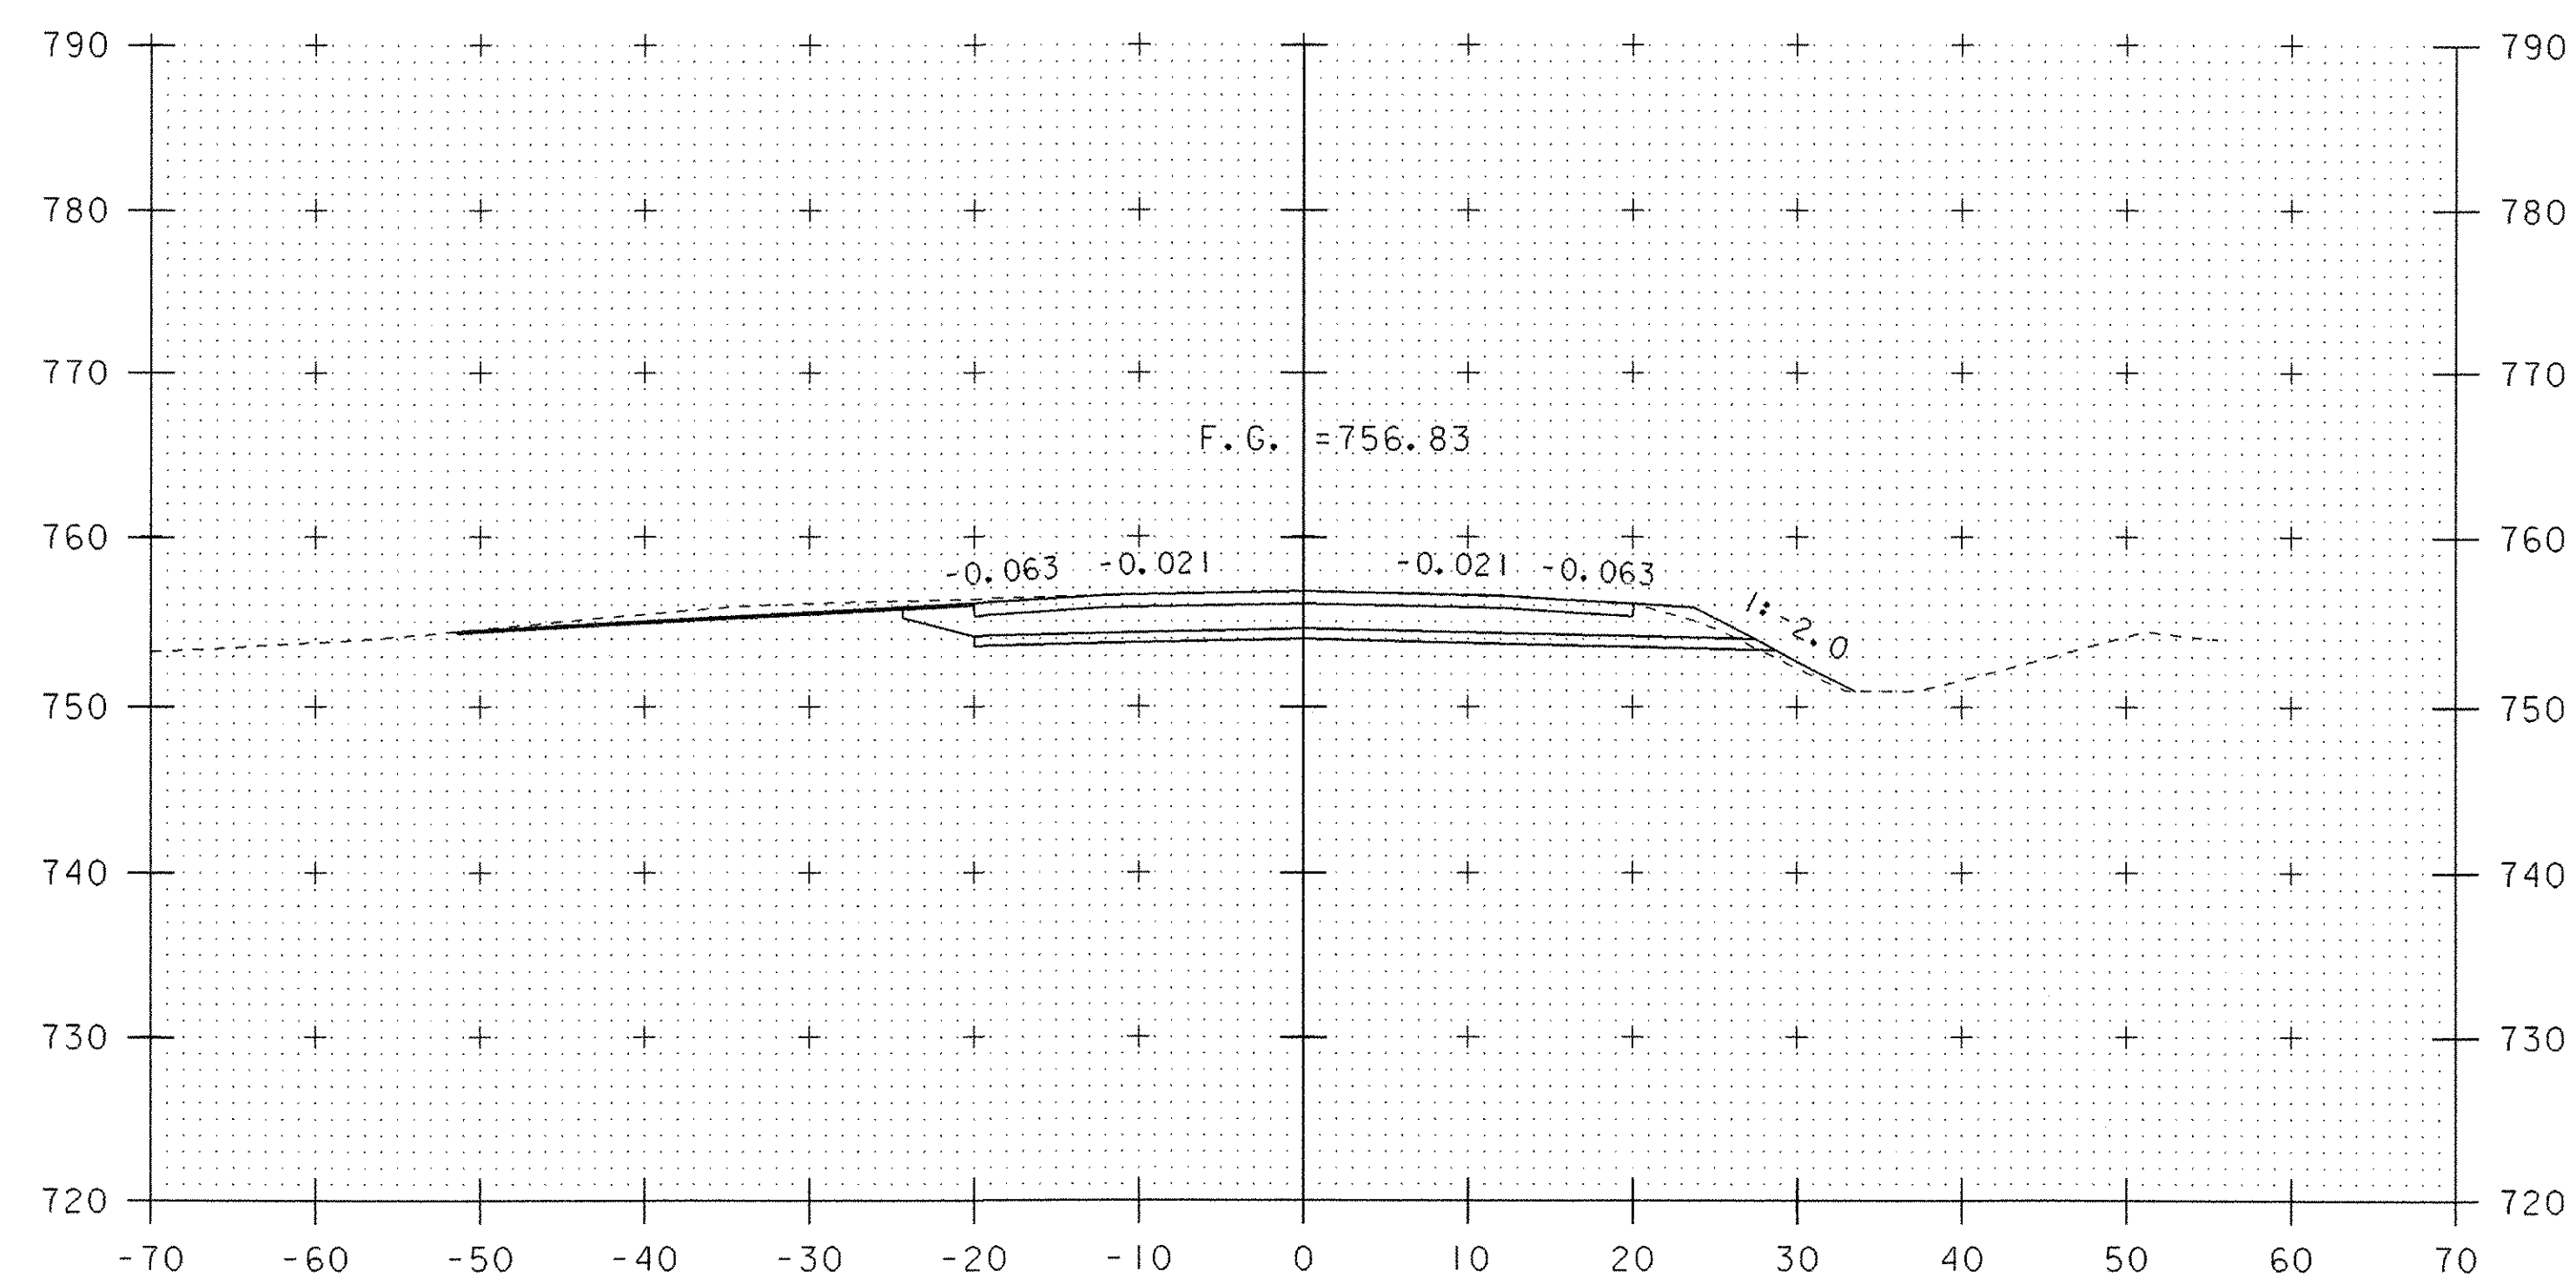

13+75

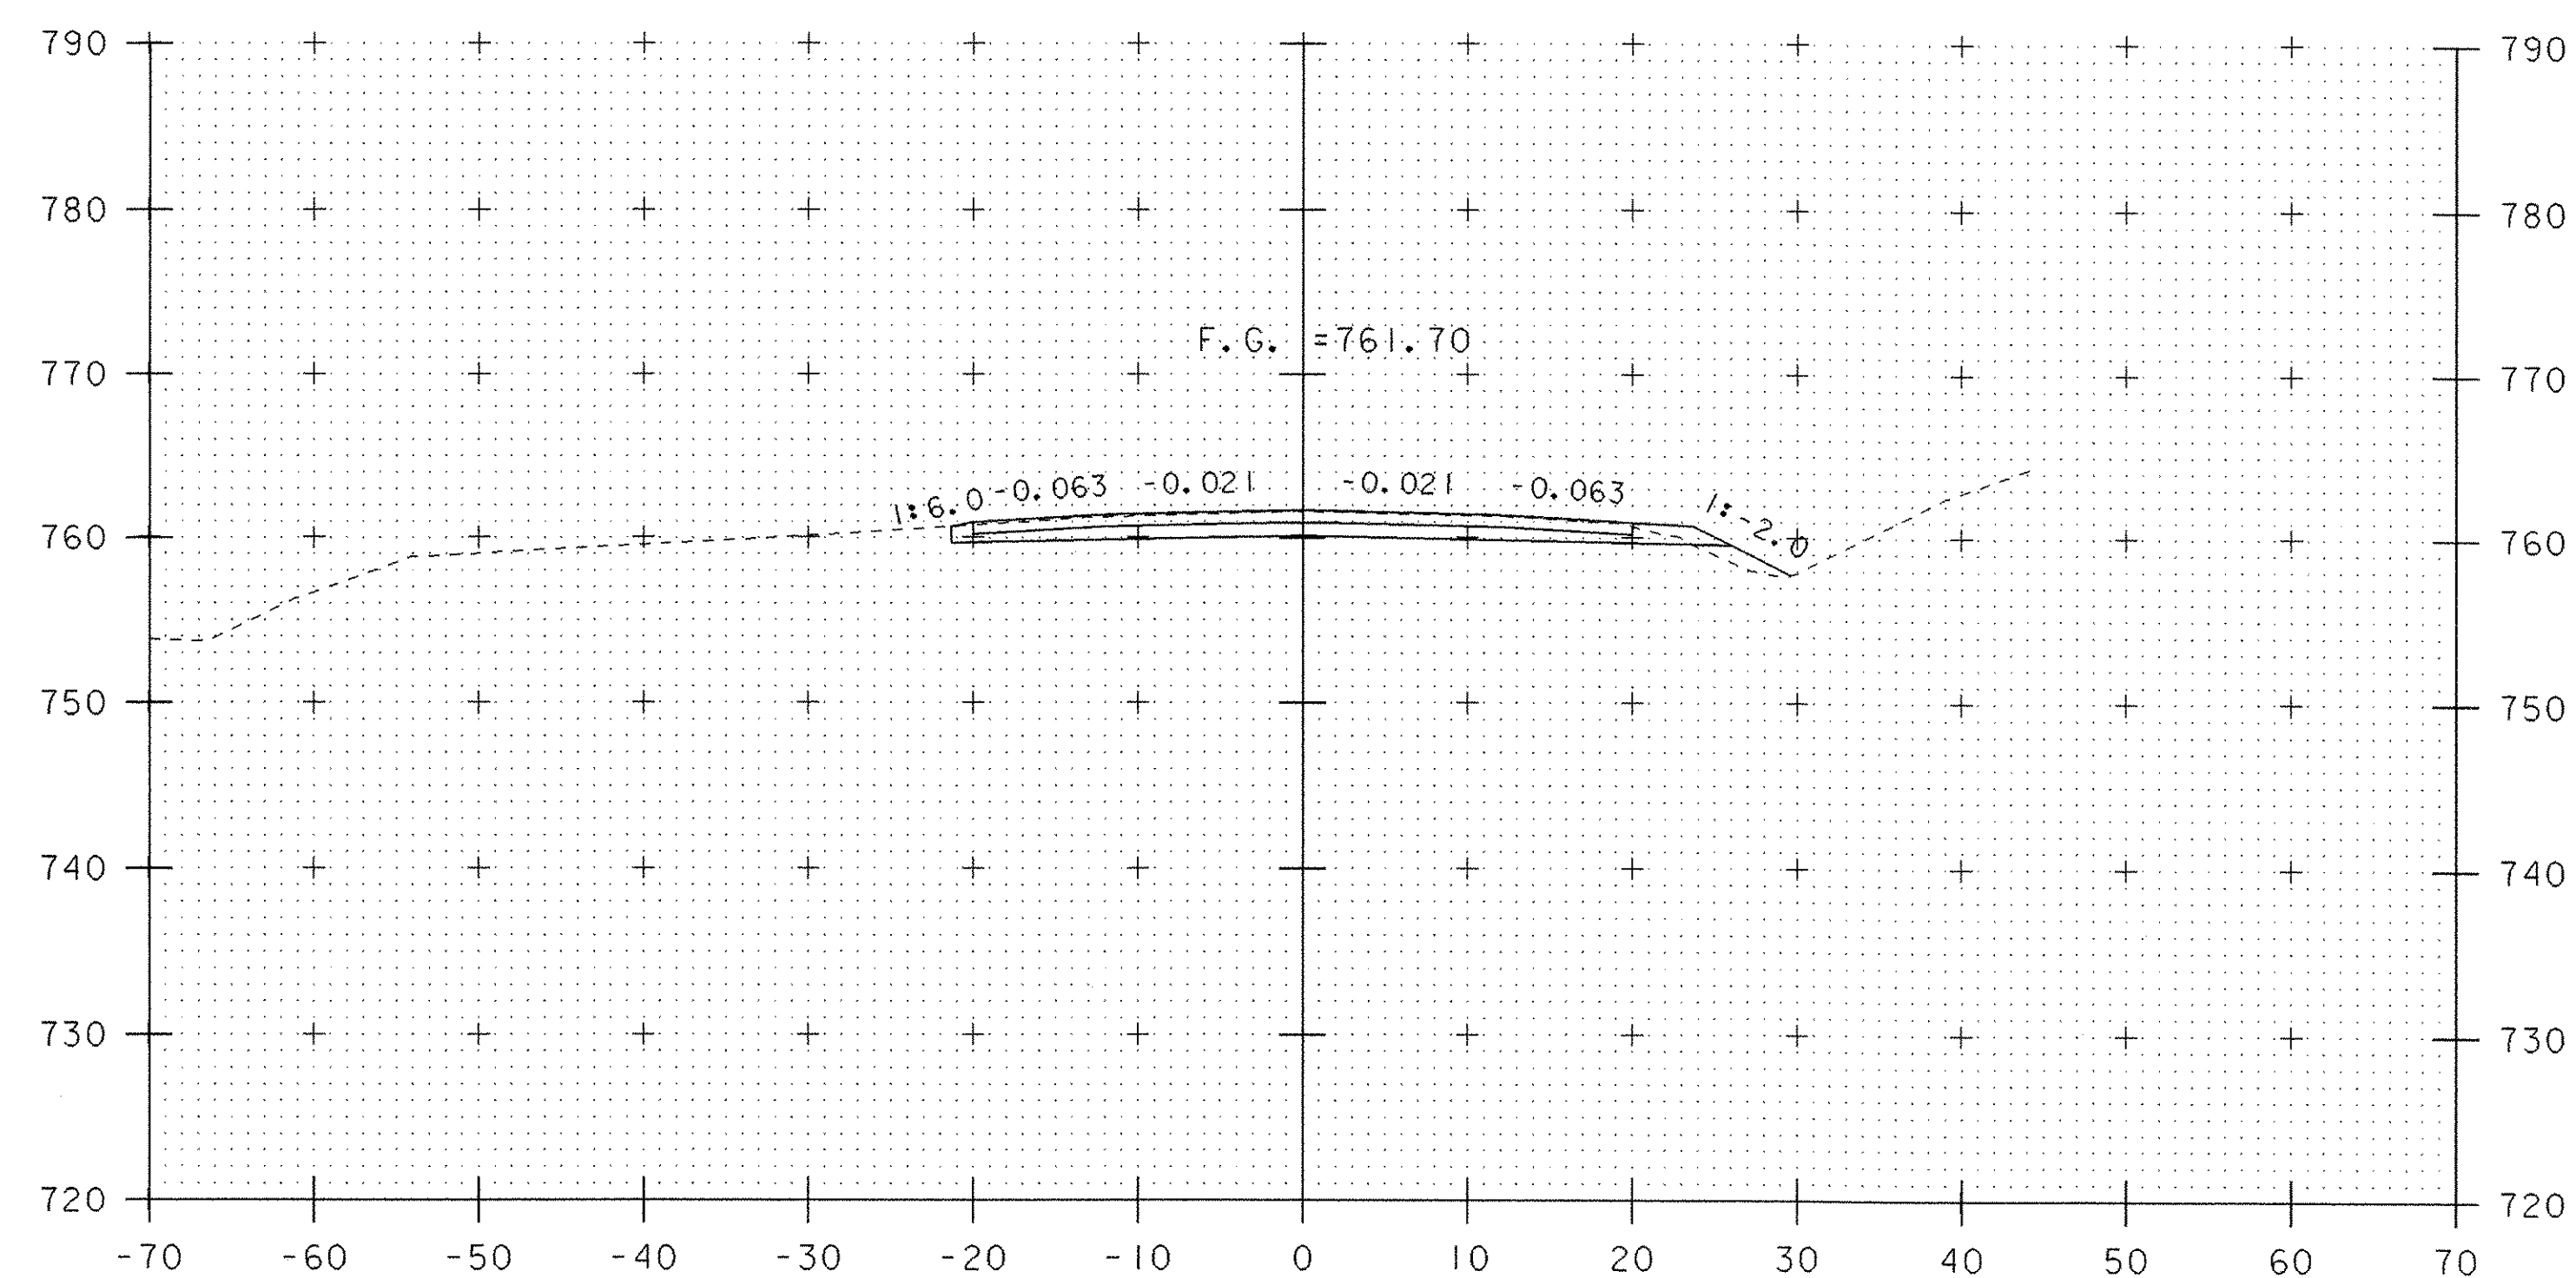

13+00

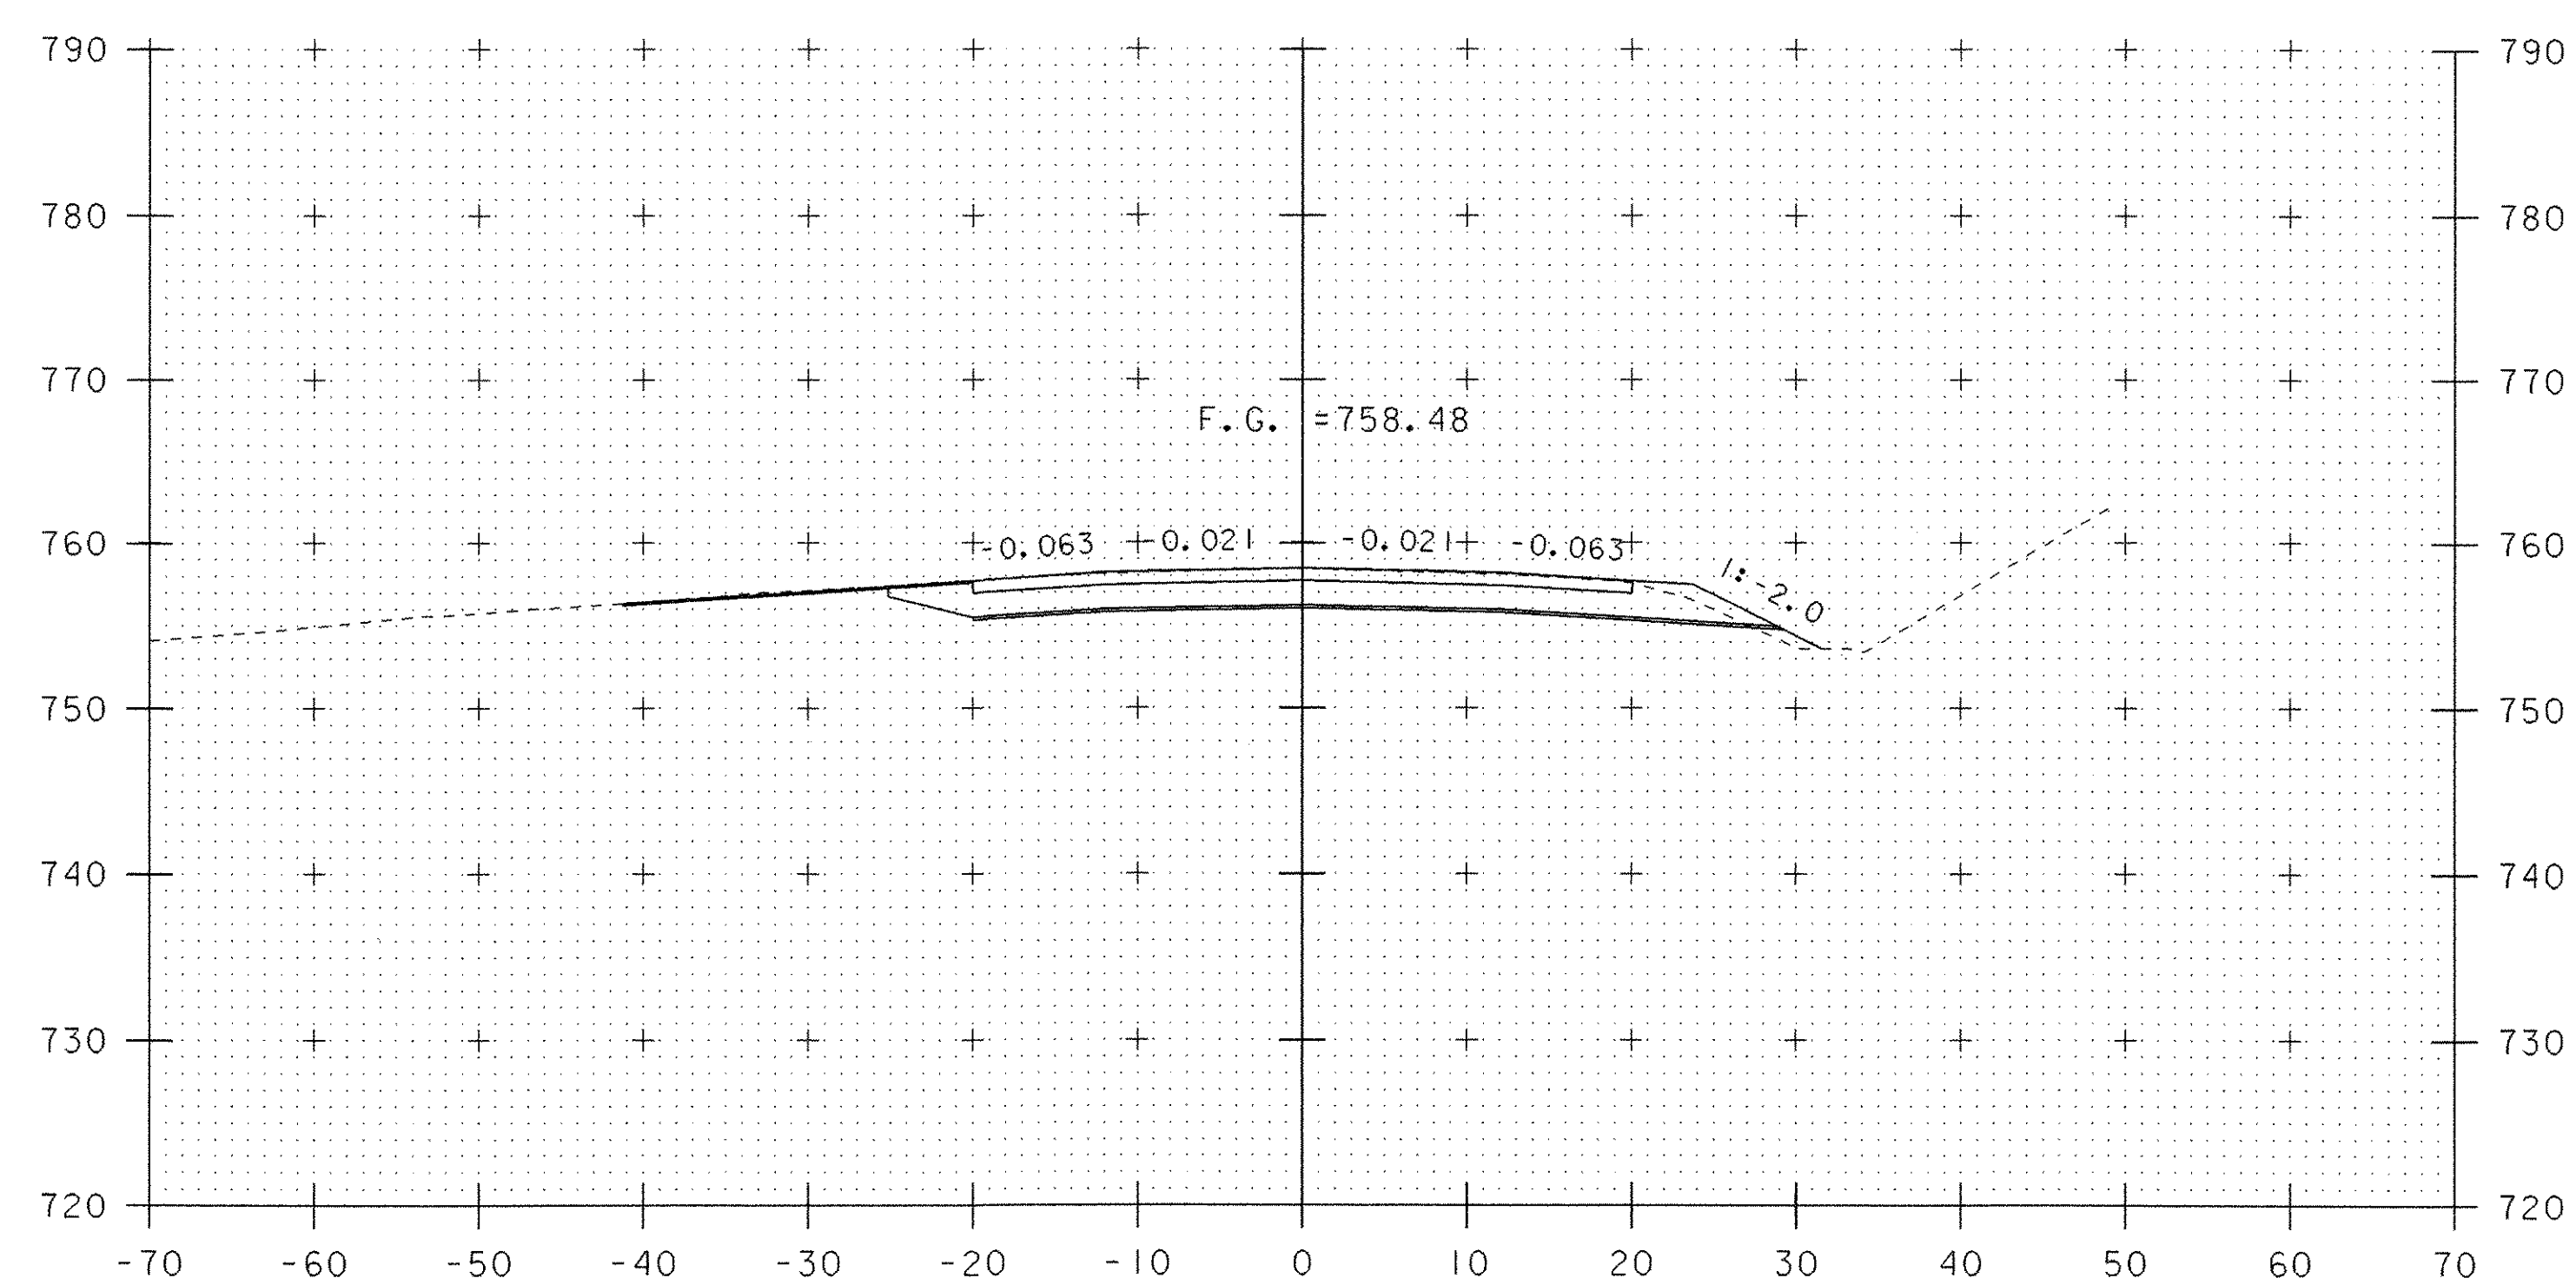

13+50

10 0 10
SCALE: 1" = 10'-0"

MAINLINE CROSS SECTIONS (2)

PROJECT NAME:	SPRINGFIELD	PLOT DATE:	21-MAY-2007
PROJECT NUMBER:	ST CULV (5)	DRAWN BY:	M. HALE
FILE NAME:	04c178\Structures\s04c178xs1.dgn	CHECKED BY:	D. PETERSON
PROJECT MANAGER:	R.R. WHITCOMB	SHEET	41 OF 52
DESIGNED BY:	J. PERRIGO		
s04c178m02.i			