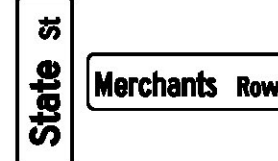
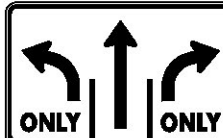


TRAFFIC SIGN SUMMARY SHEET 38

MILEMARKER, STATION, OR SIGN NUMBER	SIGN LEGEND	SIGN DIMENSIONS			NEW & SALVAGED SIGNS				EXIST POST		NO. OF POSTS	NEW SIGN POSTS															REMARKS	SIGN DETAIL																																																																																																																																																																																																																																																																																																																																																																																																																																																																																																																								
		E A	WIDTH (in)	HEIGHT (in)	"A"	"B"	SALV SIGN	SALV TIS	RET AIN	SAL VAGE		FLANGED CHANNEL			SQUARE STEEL (in)					TUBULAR ALUMINUM Ø (in)			TUBULAR STEEL Ø (in)					W-SHAPE STEEL					S I G N F R A M E N E E D E D	DETAIL IN SHS	DETAIL ON DWG. NUMBER	STD. SHEET NUMBER																																																																																																																																																																																																																																																																																																																																																																																																																																																																																																																
												lb/ft			1.75	2.0	2.5	ANCHOR SLEEVE	3.0	4.0	4.0 MOD	FOUND- ATION	3.0	3.5	4.0	5.0		FTG. SIZE		WEIGHT	POST SIZE																																																																																																																																																																																																																																																																																																																																																																																																																																																																																																																					
												1.12	2.0	3.0	1.88	2.42	3.35		1.3	1.7	1.7		7.6	9.0	10.8	14.6		24"	30"																																																																																																																																																																																																																																																																																																																																																																																																																																																																																																																							
RUTLAND CITY U.S. BR4: 74+00.0, RT		I	24	12	2.00						2					X		X												SIGN ID CODE M3-2 PROPOSED SIGN AND POST TO BE INSTALLED BY OTHERS	X																																																																																																																																																																																																																																																																																																																																																																																																																																																																																																																					
		I	24	12	2.00																									SIGN ID CODE M4-3 PROPOSED SIGN TO BE INSTALLED BY OTHERS	X																																																																																																																																																																																																																																																																																																																																																																																																																																																																																																																					
		I	24	24	4.00																									SIGN ID CODE MI-4 PROPOSED SIGN TO BE INSTALLED BY OTHERS	X																																																																																																																																																																																																																																																																																																																																																																																																																																																																																																																					
		I	21	15	2.19																									SIGN ID CODE M6-1R PROPOSED SIGN TO BE INSTALLED BY OTHERS	X																																																																																																																																																																																																																																																																																																																																																																																																																																																																																																																					
75+05.0, RT		I I	36 42	12 12	3.00 3.50						1					X		X												DOUBLE SIDED SIGN, SIGN ID CODE D3-1 DOUBLE SIDED SIGN, SIGN ID CODE D3-1 PROPOSED SIGNS AND POST TO BE INSTALLED BY OTHERS		119 120																																																																																																																																																																																																																																																																																																																																																																																																																																																																																																																				
																														TOP MOUNTING BRACKET REQUIRED TO INSTALL SIGN ON POST. COSTS ASSOCIATED WITH THIS BRACKET ARE INCIDENTAL TO THE SIGN POST.																																																																																																																																																																																																																																																																																																																																																																																																																																																																																																																						
79+88.0, RT		I	48	30	10.00						2					X		X												SIGN ID CODE VR-932 PROPOSED SIGN AND POSTS TO BE INSTALLED BY OTHERS			E-145B																																																																																																																																																																																																																																																																																																																																																																																																																																																																																																																			
		I	6	10	0.42																									SIGN ID CODE VD-700 PROPOSED SIGN TO BE INSTALLED BY OTHERS			E-138																																																																																																																																																																																																																																																																																																																																																																																																																																																																																																																			
84+10.0, LT							2				1					X		X												BACK-TO-BACK SALVAGED SIGNS TO BE MOUNTED ON NEW POST. SALVAGED SIGNS AND PROPOSED POST TO BE INSTALLED BY OTHERS.	-	-	-																																																																																																																																																																																																																																																																																																																																																																																																																																																																																																																			
84+62.0, LT		I I	36 36	12 12	3.00 3.00						2					X		X												PROPOSED SIGNS AND POSTS TO BE INSTALLED BY OTHERS BACK-TO-BACK, SIGN ID CODE R6-1R, SIGN ID CODE R6-1L	X X																																																																																																																																																																																																																																																																																																																																																																																																																																																																																																																					
FINAL POST LENGTHS ARE TO BE DETERMINED IN THE FIELD. POST SIZES ARE COMPUTED BASED ON INFORMATION FURNISHED ON THE STANDARD SHEETS AND THE VTRANS "SIGN POST DESIGN GUIDELINE."												LF	LF	LF	LF	LF 112	LF	EA	LB	LB	LB		LB	LB	LB	LB				TRAFFIC SIGN SUMMARY SHEET #38	PROJECT NAME: RUTLAND CITY - PROCTOR																																																																																																																																																																																																																																																																																																																																																																																																																																																																																																																					
																																	PROJECT NUMBER: STP 2728(1)																																																																																																																																																																																																																																																																																																																																																																																																																																																																																																																			
																																	FILE NAME: p07d282.dgn																																																																																																																																																																																																																																																																																																																																																																																																																																																																																																																			
																																	PLOT DATE: 7/19/2013																																																																																																																																																																																																																																																																																																																																																																																																																																																																																																																			
																																	DRAWN BY: W.G.P.																																																																																																																																																																																																																																																																																																																																																																																																																																																																																																																			

FILE NAME : U:\1762\CA00\N\STP 2728\p07d282.ass.38.dgn
DATE/TIME : 7/19/2013
USER : 4916