

646.406 DURABLE 4 INCH WHITE LINE, RECESSED POLYUREA
(ALL LINES WILL INCLUDE EDGE LINE BREAKS AND
RADIUS FOR TOWN HIGHWAYS)

U.S. ROUTE 7:
STA 57+00.00 - STA 60+00.00 DASHED LANE LINE RT
STA 57+00.00 - STA 60+00.00 DASHED LANE LINE LT
STA 57+00.00 - STA 60+00.00 EDGE LINE LT & RT
STA 57+00.00 - STA 57+95.00 SOLID LANE LINE RT
STA 58+34.40 SOLID LANE LINE LT, WASHINGTON STREET
STA 58+90.00 - STA 59+75.00 SOLID LANE LINE CL
STA 59+75.00 - STA 60+00.00 DOTTED LANE LINE CL
STA 59+75.00 - STA 60+00.00 DOTTED LANE LINE RT

646.602 TEMPORARY 4 INCH WHITE LINE, PAINT
(ALL LINES WILL INCLUDE EDGE LINE BREAKS AND
RADIUS FOR TOWN HIGHWAYS)

U.S. ROUTE 7:
STA 57+00.00 - STA 60+00.00 DASHED LANE LINE RT
STA 57+00.00 - STA 60+00.00 DASHED LANE LINE LT
STA 57+00.00 - STA 60+00.00 EDGE LINE LT & RT
STA 57+00.00 - STA 57+95.00 SOLID LANE LINE RT
STA 58+34.40 SOLID LANE LINE LT, WASHINGTON STREET
STA 58+90.00 - STA 59+75.00 SOLID LANE LINE CL
STA 59+75.00 - STA 60+00.00 DOTTED LANE LINE CL
STA 59+75.00 - STA 60+00.00 DOTTED LANE LINE RT

646.416 DURABLE 4 INCH YELLOW LINE, RECESSED POLYUREA
(ALL LINES WILL INCLUDE C/L BREAKS FOR
TOWN HIGHWAYS)

U.S. ROUTE 7:
STA 57+00.00 - STA 57+95.00 DOUBLE SOLID CL
STA 58+29.12 DOUBLE SOLID RT, EAST WASHINGTON STREET
STA 58+34.40 DOUBLE SOLID LT, WASHINGTON STREET
STA 58+90.00 - STA 60+00.00 DOUBLE SOLID RT

646.612 TEMPORARY 4 INCH YELLOW LINE, PAINT
(ALL LINES WILL INCLUDE C/L BREAKS FOR
TOWN HIGHWAYS)

U.S. ROUTE 7:
STA 57+00.00 - STA 57+95.00 DOUBLE SOLID CL
STA 58+29.12 DOUBLE SOLID RT, EAST WASHINGTON STREET
STA 58+34.40 DOUBLE SOLID LT, WASHINGTON STREET
STA 58+90.00 - STA 60+00.00 DOUBLE SOLID RT

604.42 CHANGING ELEVATION OF SEWER MANHOLES

U.S. ROUTE 7:
STA 58+11.0 LT
STA 58+47.0 LT

616.28 CAST-IN-PLACE CONCRETE CURB, TYPE B

U.S. ROUTE 7:
STA 58+08.0 RT (14.0 LF)
STA 58+52.0 RT (14.0 LF)

618.10 PORTLAND CEMENT CONCRETE SIDEWALK, 5 INCH


U.S. ROUTE 7:
STA 58+08.0 RT (10.6 SF)
STA 58+52.0 RT (10.6 SF)

618.30 DETECTABLE WARNING SURFACE

U.S. ROUTE 7:
STA 58+08.0 RT (10.0 SF)
STA 58+52.0 RT (10.0 SF)

629.20 ADJUST ELEVATION OF VALVE BOX

U.S. ROUTE 7:
STA 57+99.0 RT
STA 58+35.0 LT
STA 58+37.0 RT
STA 58+38.0 RT
STA 58+48.0 RT
STA 58+60.0 RT

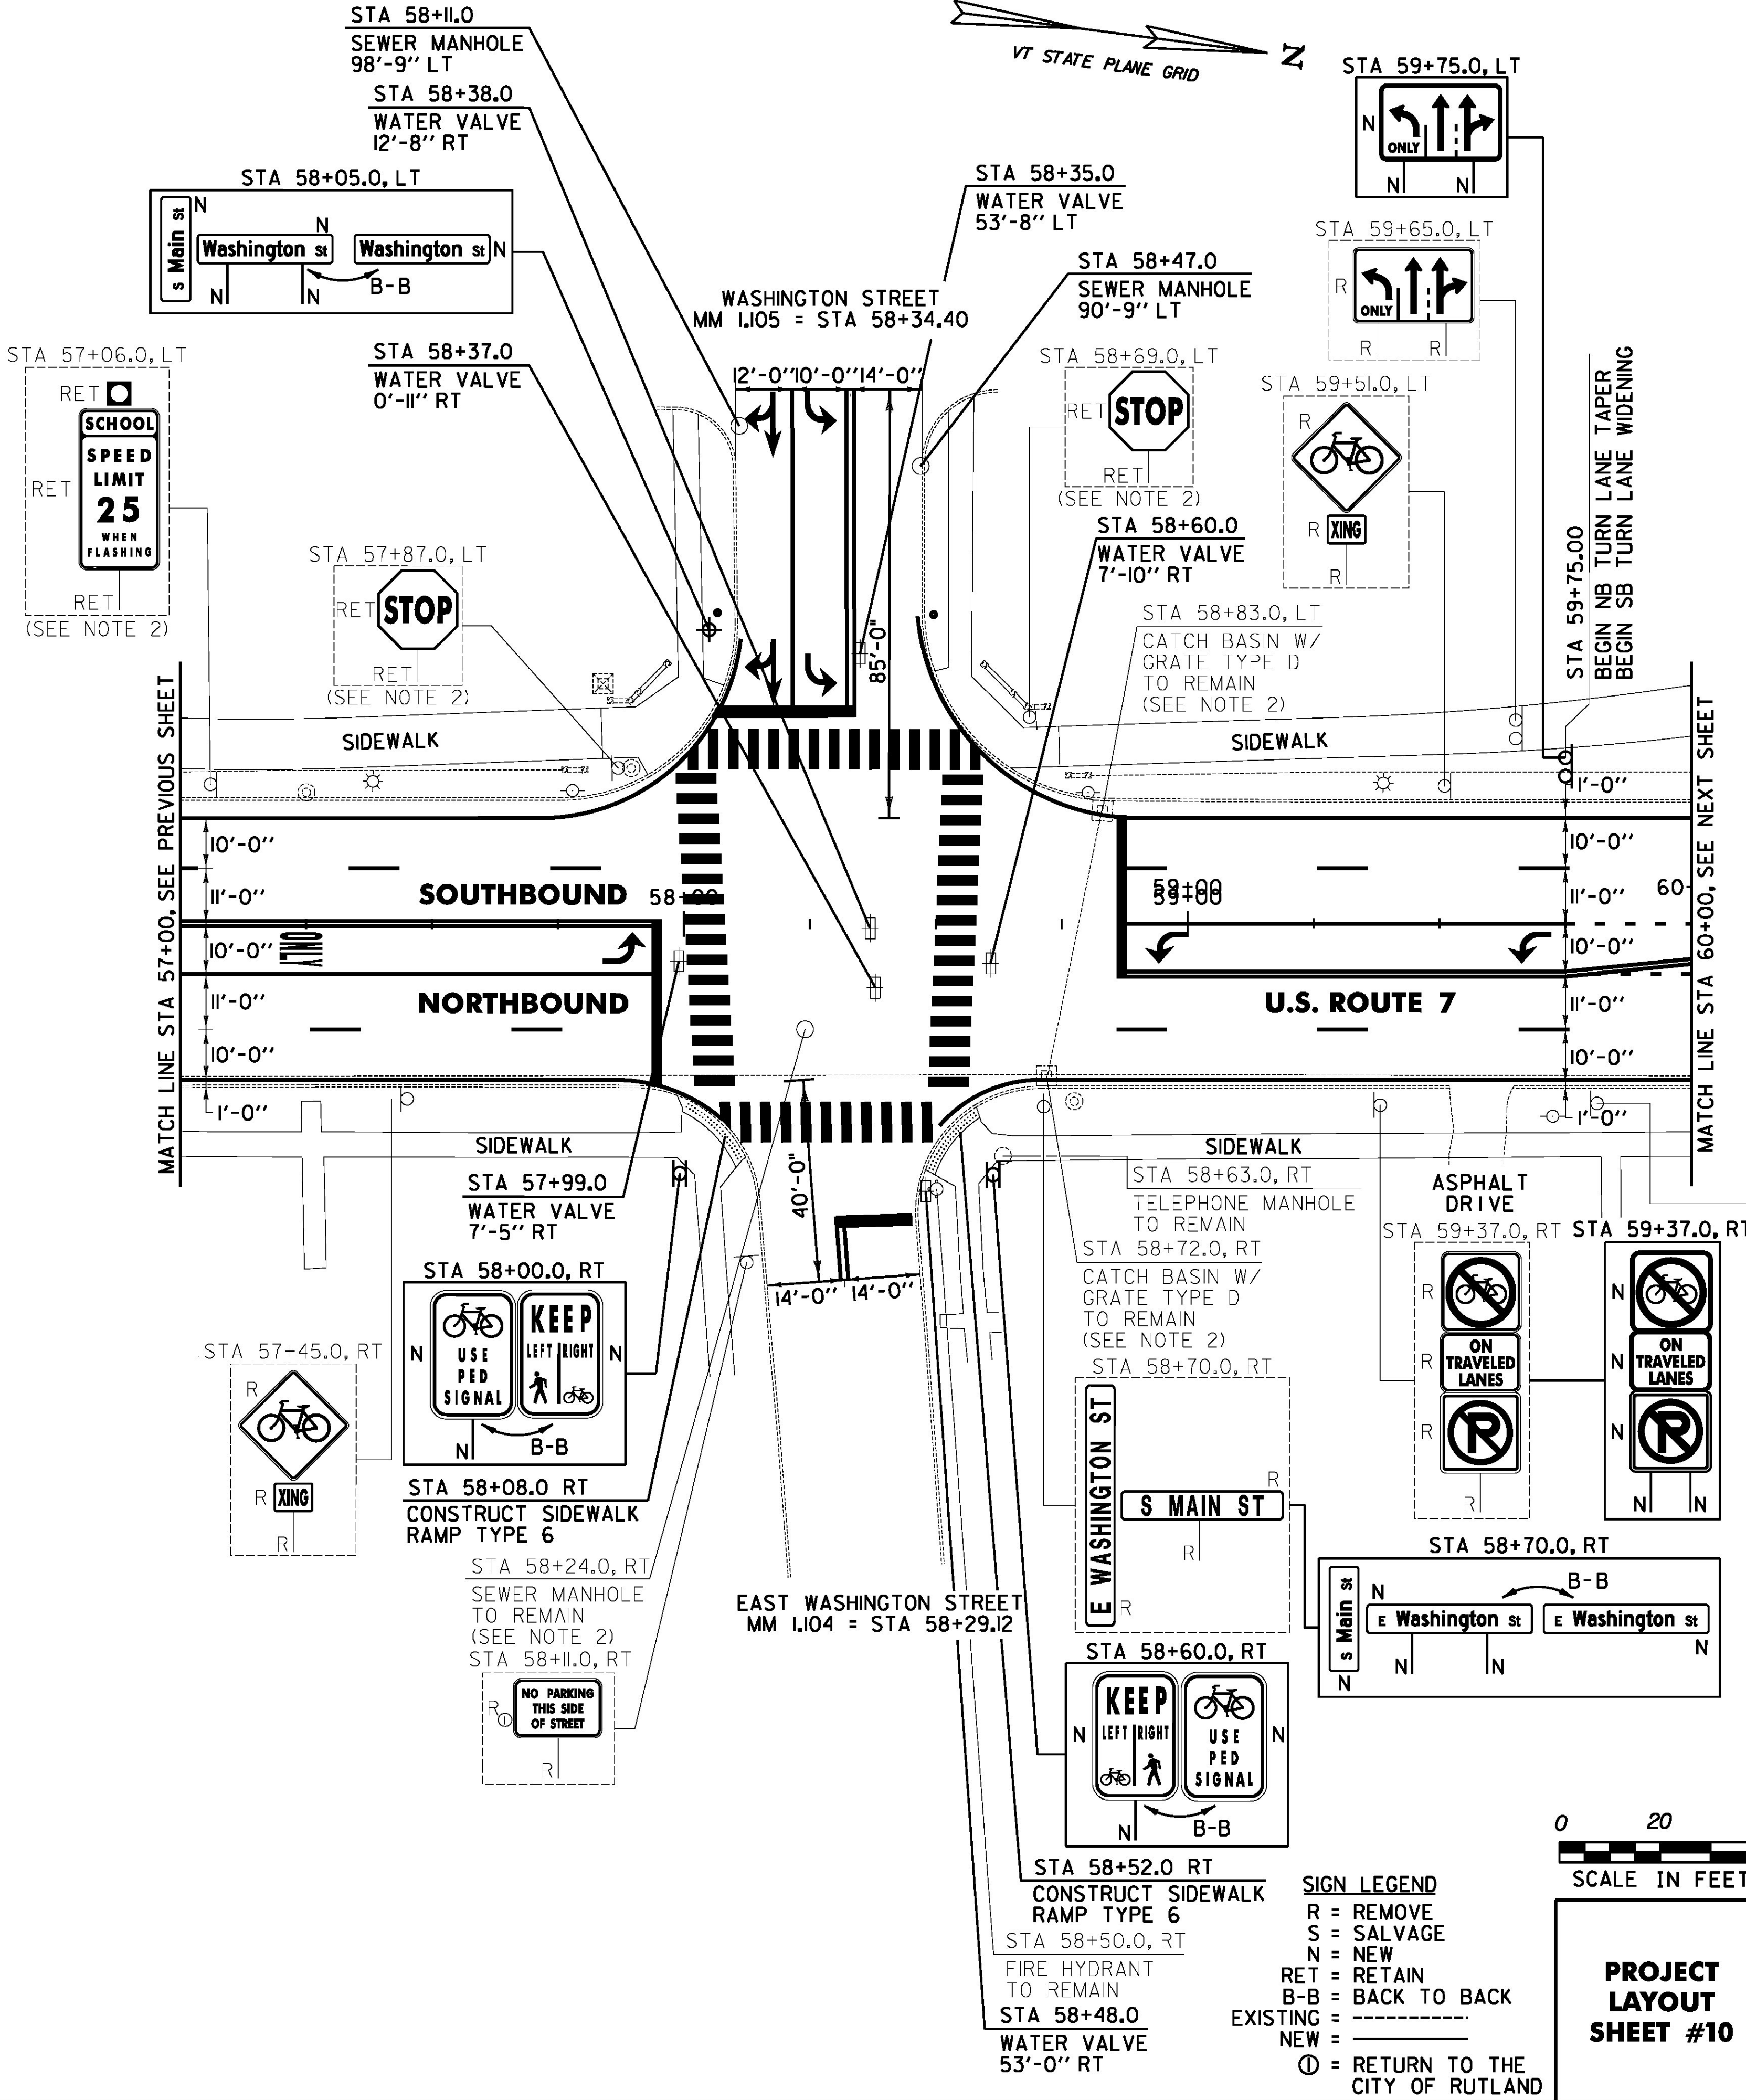

646.487 DURABLE 24 INCH STOP BAR, RECESSED TYPE I TAPE
U.S. ROUTE 7:
STA 57+96.00 RT
STA 58+29.12 RT, EAST WASHINGTON STREET
STA 58+34.40 LT, WASHINGTON STREET
STA 58+89.00 LT/RT

646.682 TEMPORARY 24 INCH STOP BAR, PAINT

U.S. ROUTE 7:
STA 57+96.00 RT
STA 58+29.12 RT, EAST WASHINGTON STREET
STA 58+34.40 LT, WASHINGTON STREET
STA 58+89.00 LT/RT

646.491 DURABLE LETTER OR SYMBOL, TYPE I TAPE

U.S. ROUTE 7:
STA 57+23.00 RT, "O,N,L,Y" (4 EA)
STA 57+86.75 RT, ARROW (1EA)
STA 58+34.40 LT, WASHINGTON STREET, ARROW (2 EA)
STA 58+34.40 LT, WASHINGTON STREET, ARROW (4 EA)
STA 58+98.25 RT, ARROW (1EA)
STA 59+70.80 RT, ARROW (1EA)

646.692 TEMPORARY LETTER OR SYMBOL, PAINT

U.S. ROUTE 7:
STA 57+86.75 RT, ARROW (2 EA)
STA 58+34.40 LT, WASHINGTON STREET, ARROW (4 EA)
STA 58+34.40 LT, WASHINGTON STREET, ARROW (8 EA)
STA 58+98.25 RT, ARROW (2 EA)
STA 59+70.80 RT, ARROW (2 EA)

646.501 DURABLE CROSSWALK MARKING, TYPE I TAPE

U.S. ROUTE 7:
STA 58+05.00 LT/RT
STA 58+29.12 RT, EAST WASHINGTON STREET
STA 58+34.40 LT, WASHINGTON STREET
STA 58+55.00 LT/RT

646.702 TEMPORARY CROSSWALK MARKING, PAINT

U.S. ROUTE 7:
STA 58+05.00 LT/RT
STA 58+29.12 RT, EAST WASHINGTON STREET
STA 58+34.40 LT, WASHINGTON STREET
STA 58+55.00 LT/RT

675.50 REMOVING SIGNS

AS SHOWN - 12

NOTES:

1. COLD PLANING AND PAVING LIMIT ON ALL CITY STREETS SHALL BE MEASURED 25 FT BACK FROM U.S. ROUTE 7 FACE OF CURB UNLESS DENOTED OTHERWISE ON THE PLANS OR AS DIRECTED BY THE ENGINEER.
2. INSTALLED OR ADJUSTED UNDER STP 019-3(57) PRIOR TO CONSTRUCTION.
3. SEE SHEET 243 FOR TRAFFIC SIGNAL PLAN SHEET.

PROJECT
LAYOUT
SHEET #10

PROJECT NAME: RUTLAND CITY

PROJECT NUMBER: NH 2716(1)

FILE NAME: p07d188.dgn

PROJECT LEADER: D.E.G.

DESIGNED BY: M.J.M.

IPARM FILE: 07d18810.1

PLOT DATE: 7/19/2013

DRAWN BY: W.G.P.

CHECKED BY: D.E.G.

SHEET 168 OF 392