
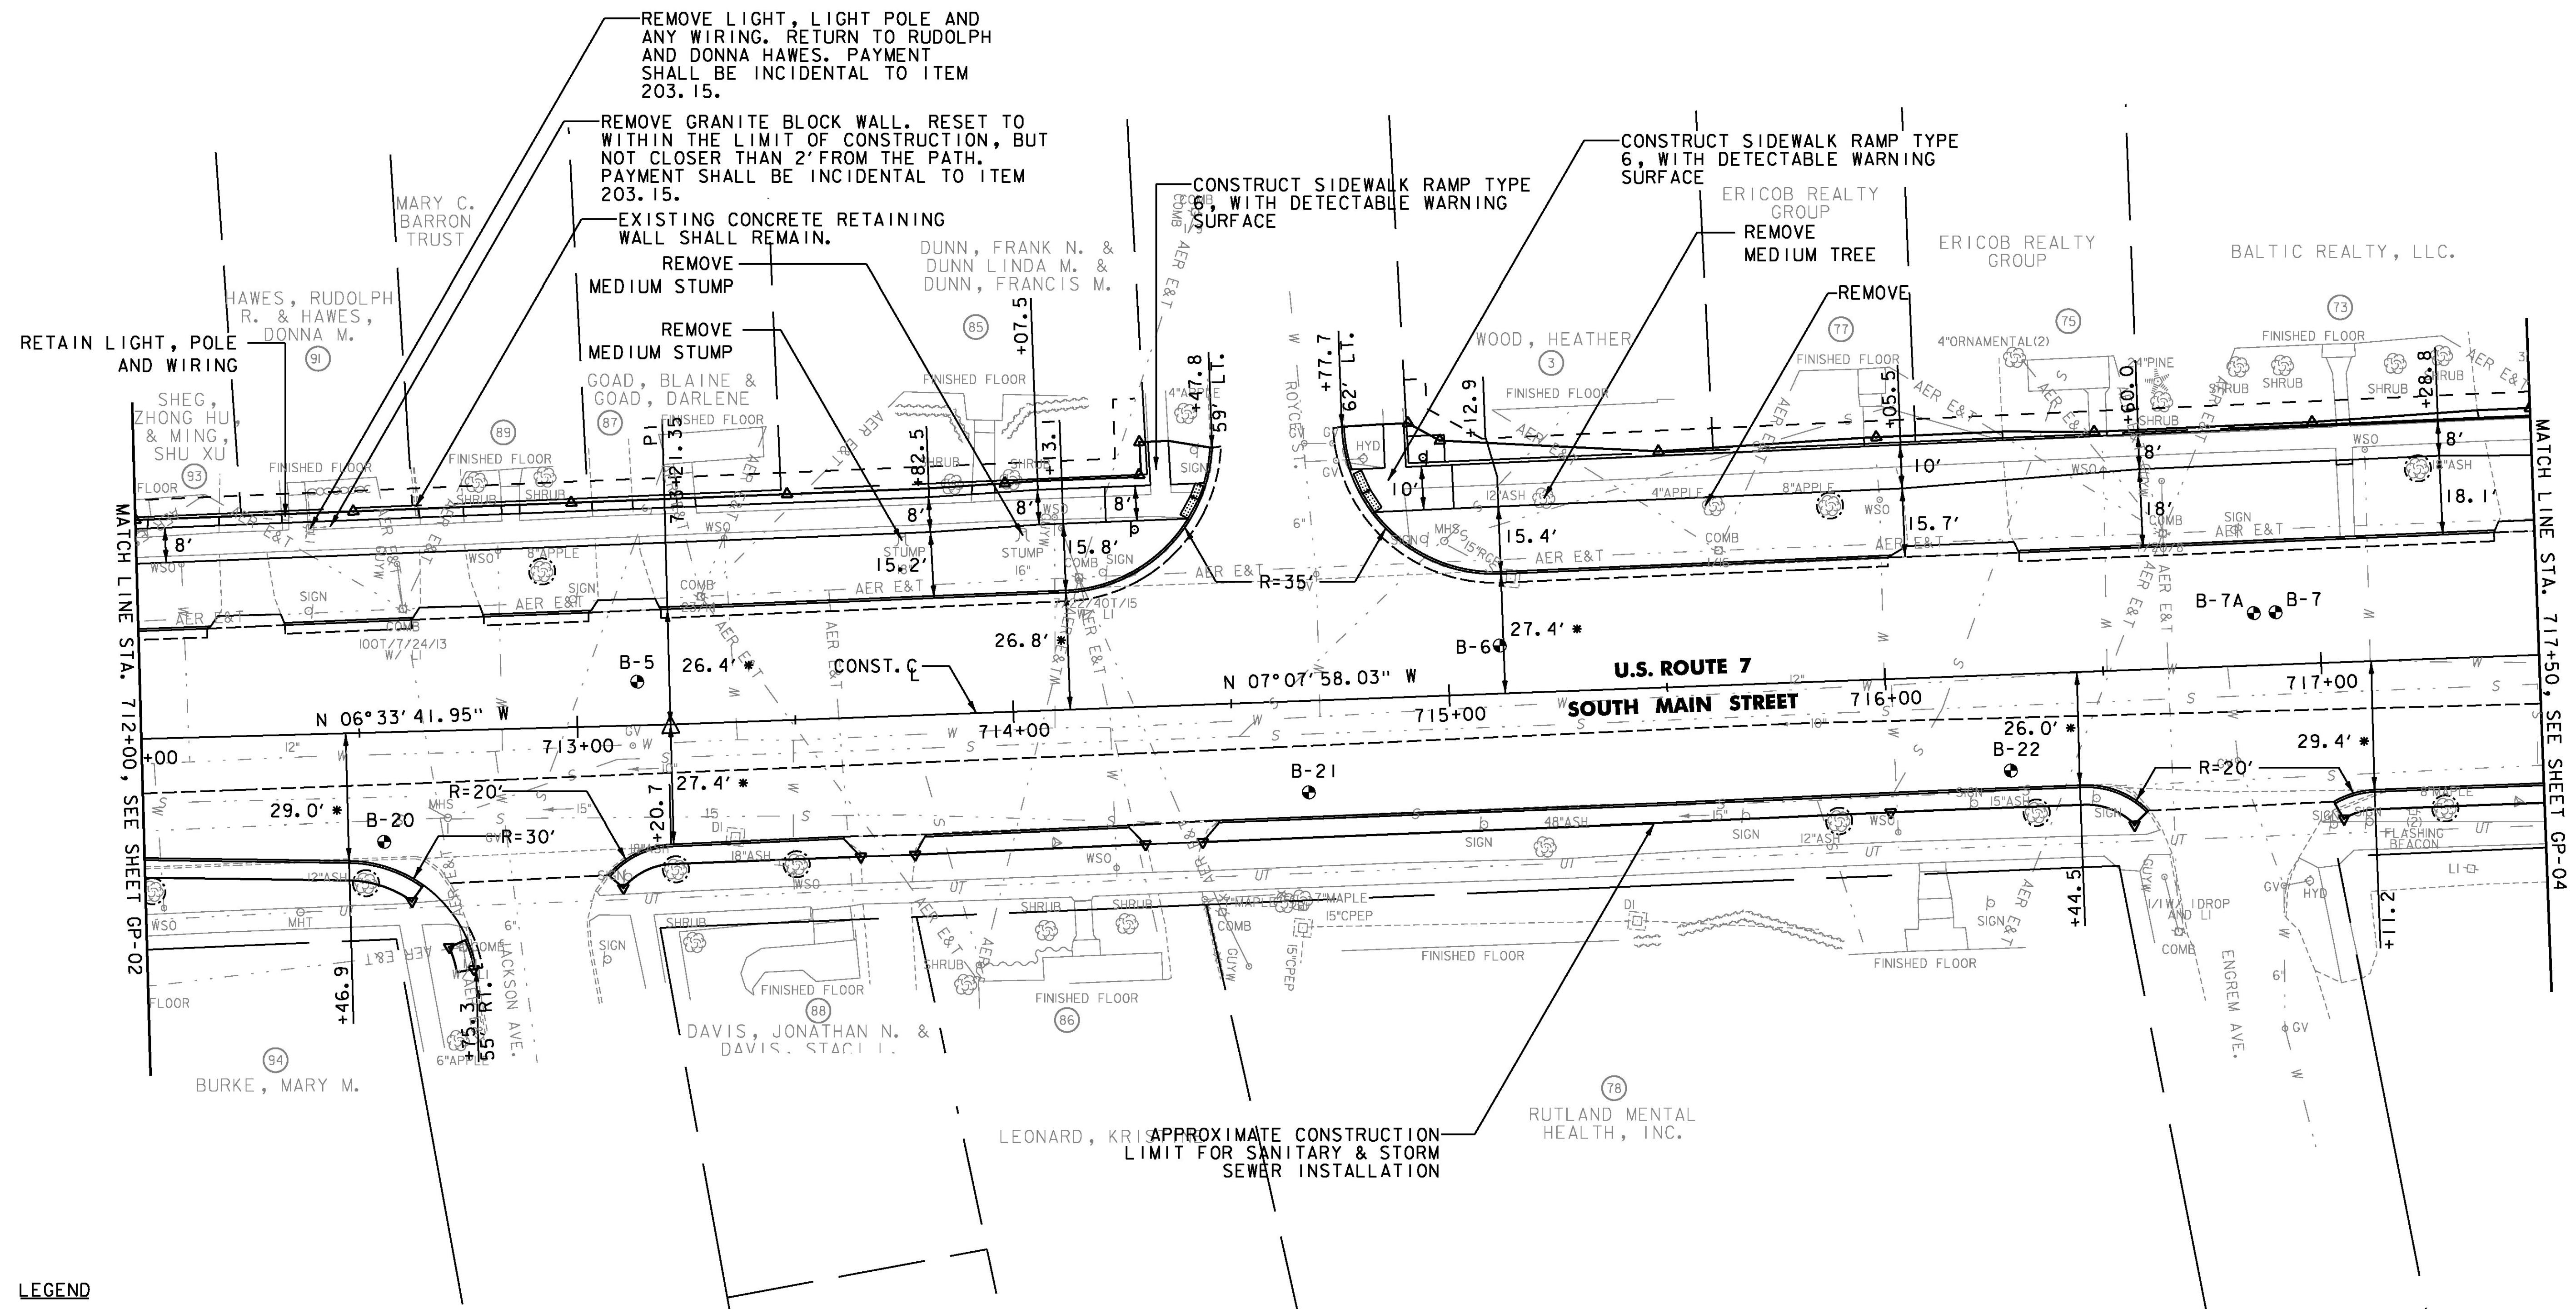



REMOVING MEDIUM TREES REMOVING MEDIUM STUMPS
 715+23, LT 713+76, LT
 714+04, LT

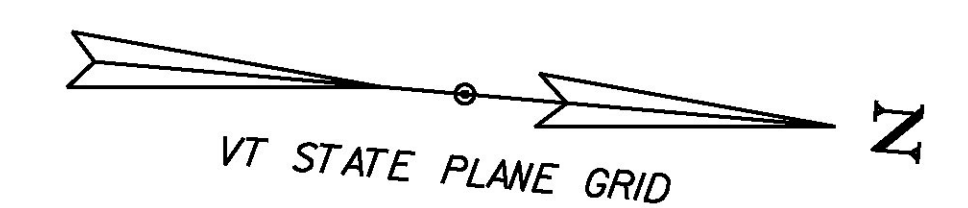

LEGEND

- ⊙ SOIL BORING (SEE GP-01, NOTE 11)
- TREE PROTECTION ZONE (SEE GP-01, NOTE 14)
- SAWCUT LINE (SEE GP-01, NOTE 15)
- ASSUMED LOCATION EXISTING CONCRETE PAVEMENT
- REMOVE EXISTING PAVEMENT

NOTE:
 1. FOR GENERAL NOTES SEE SHEET GP-01.

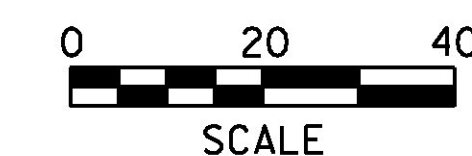

PROJECT NAME: RUTLAND CITY	
PROJECT NUMBER: STP 019-3(57)	
FILE NAME: ...\\PlotFiles\\rut_genplan.dgn	PLOT DATE: 7/12/2013
PROJECT LEADER: GAE	DRAWN BY: PZA
DESIGNED BY: TFD	CHECKED BY: GAE
GENERAL PLAN GP-03	SHEET 288 OF 392