


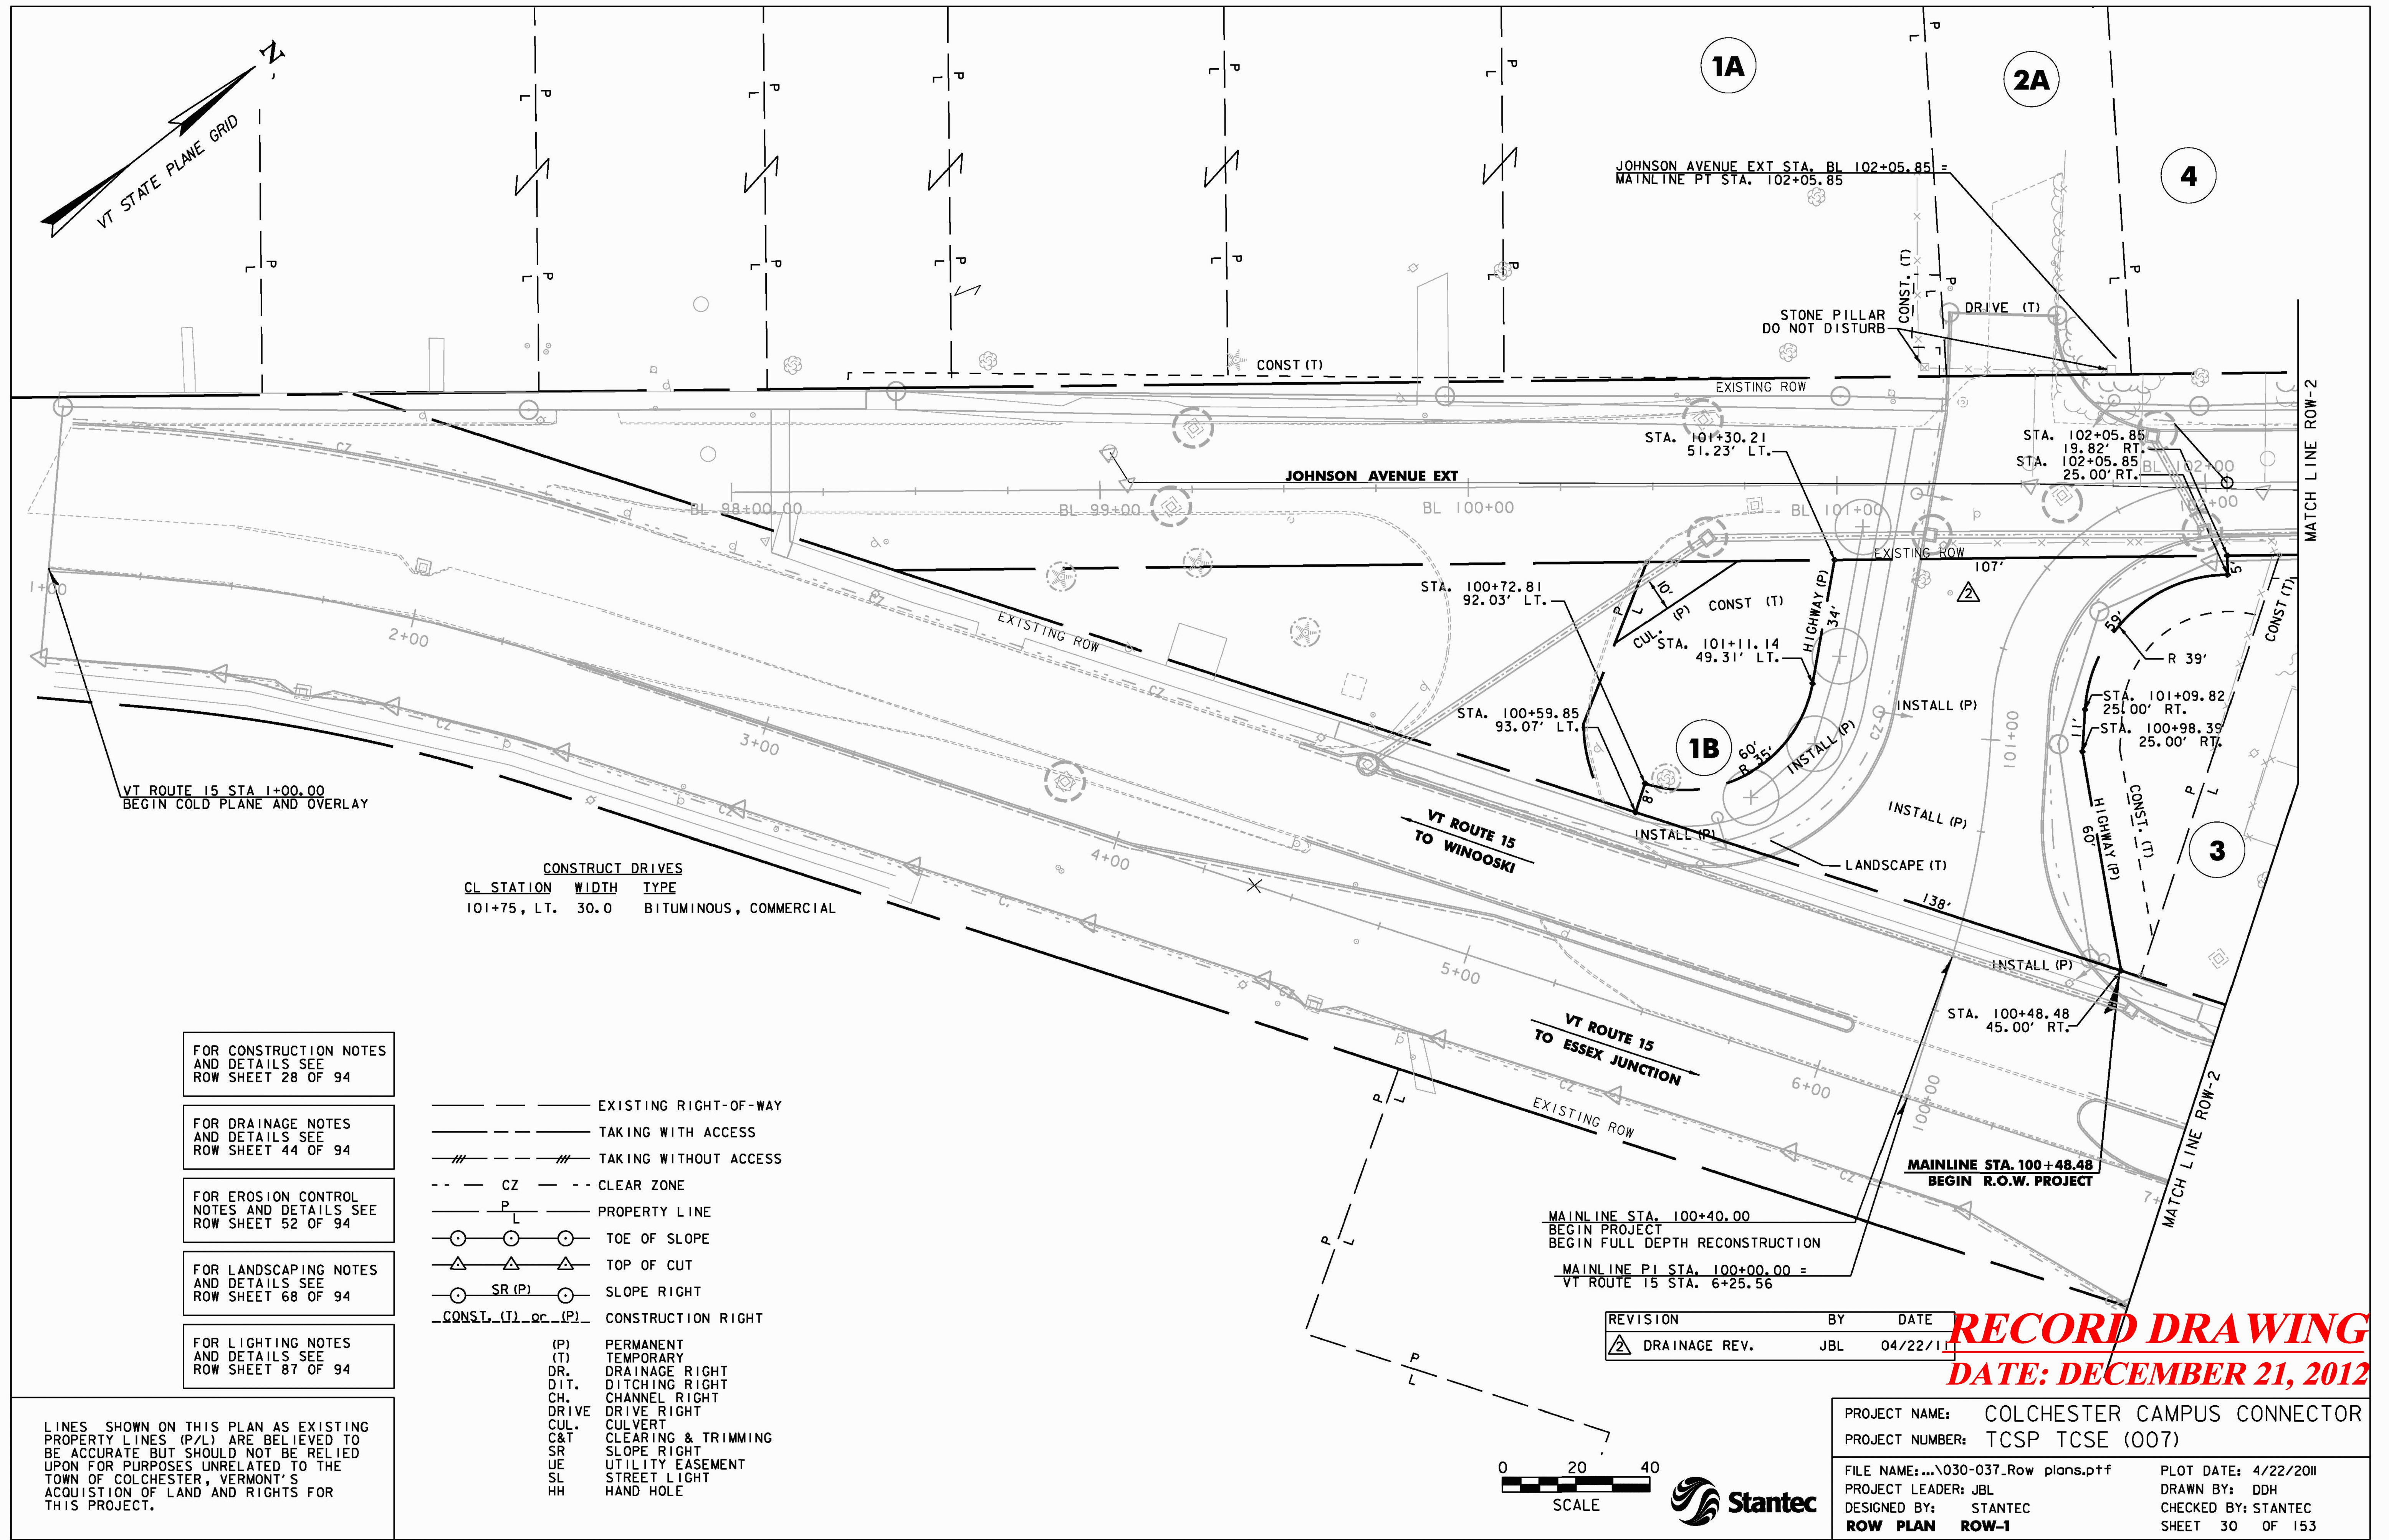

FOR CONSTRUCTION NOTES
AND DETAILS SEE
ROW SHEET 28 OF 94

FOR DRAINAGE NOTES
AND DETAILS SEE
ROW SHEET 44 OF 94

FOR EROSION CONTROL
NOTES AND DETAILS SEE
ROW SHEET 52 OF 94

FOR LANDSCAPING NOTES
AND DETAILS SEE
ROW SHEET 68 OF 94

FOR LIGHTING NOTES
AND DETAILS SEE
ROW SHEET 87 OF 94

LINES SHOWN ON THIS PLAN AS EXISTING
PROPERTY LINES (P/L) ARE BELIEVED TO
BE ACCURATE BUT SHOULD NOT BE RELIED
UPON FOR PURPOSES UNRELATED TO THE
TOWN OF COLCHESTER, VERMONT'S
ACQUISITION OF LAND AND RIGHTS FOR
THIS PROJECT.

- EXISTING RIGHT-OF-WAY
- TAKING WITH ACCESS
- TAKING WITHOUT ACCESS
- CZ CLEAR ZONE
- PROPERTY LINE
- TOE OF SLOPE
- TOP OF CUT
- SR (P) SLOPE RIGHT
- CONST. (T) or (P) CONSTRUCTION RIGHT

- (P) PERMANENT
- (T) TEMPORARY
- DR. DRAINAGE RIGHT
- DIT. DITCHING RIGHT
- CH. CHANNEL RIGHT
- DRIVE DRIVE RIGHT
- CUL. CULVERT
- C&T CLEARING & TRIMMING
- SR SLOPE RIGHT
- UE UTILITY EASEMENT
- SL STREET LIGHT
- HH HAND HOLE

REVISION	BY	DATE
DRAINAGE REV.	JBL	04/22/11

0 20 40
SCALE



PROJECT NAME:	COLCHESTER CAMPUS CONNECTOR
PROJECT NUMBER:	TCSP TCSE (007)
FILE NAME:	...030-037_Row plans.pxf
PROJECT LEADER:	JBL
DESIGNED BY:	STANTEC
ROW PLAN	ROW-1
PLOT DATE:	4/22/2011
DRAWN BY:	DDH
CHECKED BY:	STANTEC
SHEET	30 OF 153